



CITY OF WHITEHORSE SERVICE CONNECTION RECORD

FIELD BOOK


No.

ADDRESS 201 Neecheah Street BLOCK LOT 773

DATES		WATER		SEWER	
On at Main 9/17/2019		Depth at P/L: 2.38 m		2.29 m	
On at Building N/A		Depth at Main: 2.53 m		2.86 m	
Frost Plug: N/A		Pipe Size: 25 mm / 20 mm		100 mm	
Memo:		Pipe Material: HDPE Insul. <u>(Yes)</u> /No		PVC Insul. Yes/ <u>(No)</u>	
		Length from Main to P/L: 5.72 m		8.89 m	
		Squirt Test: <u>(Pass)</u> /Fail		N/A	
Booster Pump Required:	Yes/No	Frost Protection: Aquaflo/ <u>(Recirc)</u> /Heat Trace/Bleeder		N/A	
PRV Required:	Yes/No	Greased @ CC: <u>(Yes)</u> /No		N/A	
Water Meter Installed:	Yes/No	Continuity Test: <u>(N/A)</u> Pass/Fail		N/A	

CLEARLY INDICATE LOCATION OF CC AND ROUTE OF PIPES ON DRAWING BELOW

1. Show main valves required to isolate this service.
2. All dimensions to be tied to property line
3. All dimensions to be metric
4. Depth @ property line is based on elevation after construction and changes may have occurred.

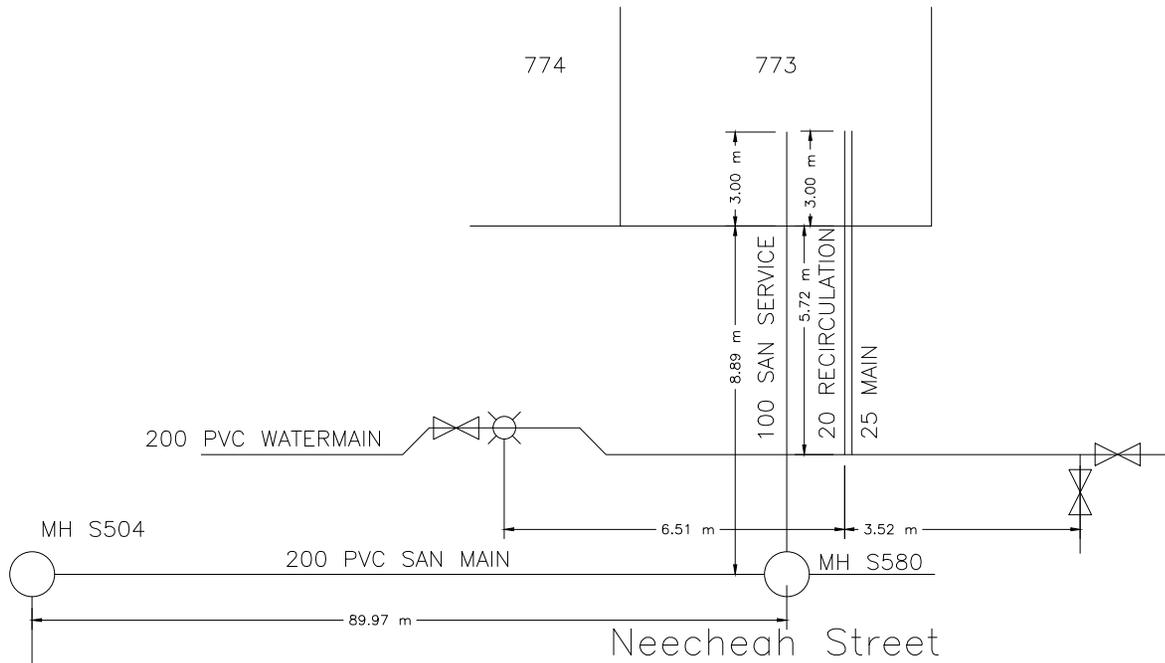



CITY OF WHITEHORSE SERVICE CONNECTION RECORD

FIELD BOOK


No.

ADDRESS 203 Neecheah Street BLOCK LOT 774

DATES		WATER		SEWER	
On at Main	9/17/2019	Depth at P/L:	2.32 m	2.28	m
On at Building	N/A	Depth at Main:	2.44 m	2.61	m
Frost Plug:	N/A	Pipe Size:	25 mm / 20 mm	100	mm
Memo:		Pipe Material:	HDPE	Insul.	(Yes/No)
		Length from Main to P/L:	5.74 m	PVC	Insul. Yes/(No)
		Squirt Test:	(Pass/Fail)		N/A
Booster Pump Required:	Yes/No	Frost Protection:	Aquaflow/(Recirc)/Heat Trace/Bleeder		N/A
PRV Required:	Yes/No	Greased @ CC:	(Yes/No)		N/A
Water Meter Installed:	Yes/No	Continuity Test:	(N/A) Pass/Fail		N/A

CLEARLY INDICATE LOCATION OF CC AND ROUTE OF PIPES ON DRAWING BELOW

1. Show main valves required to isolate this service.
2. All dimensions to be tied to property line
3. All dimensions to be metric
4. Depth @ property line is based on elevation after construction and changes may have occurred.

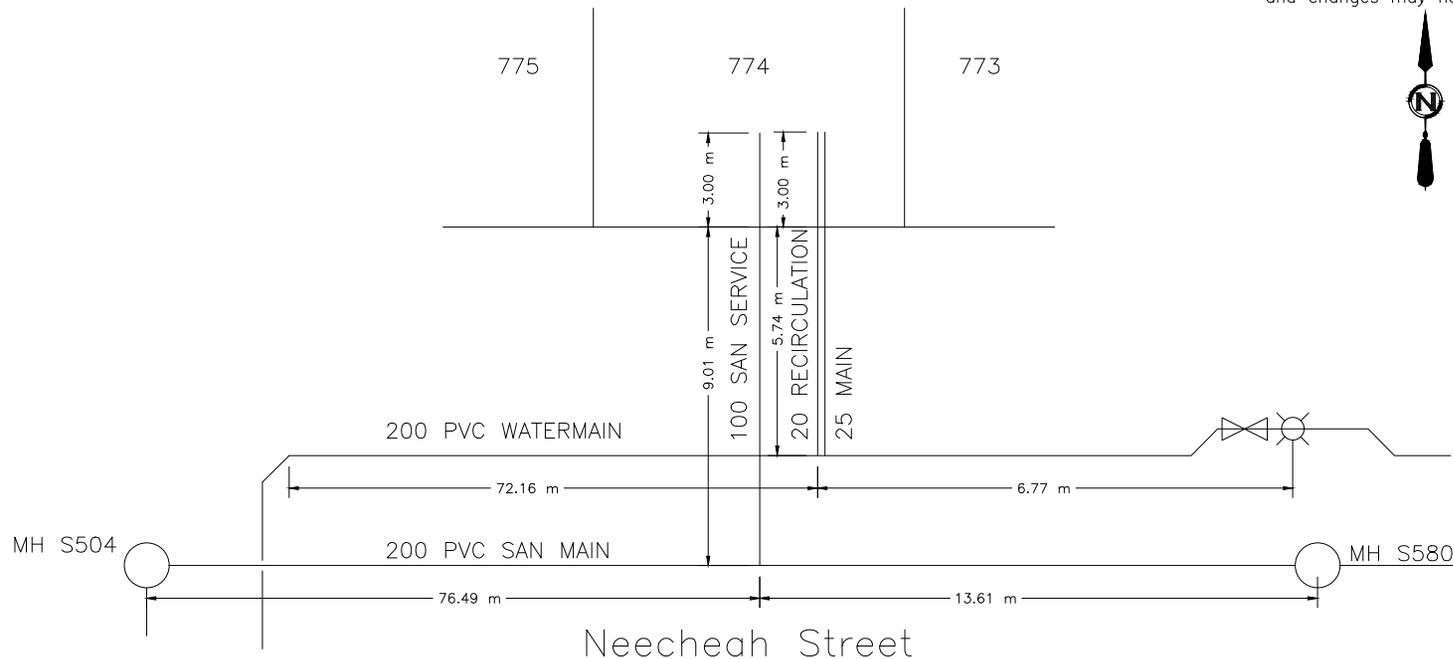



CITY OF WHITEHORSE SERVICE CONNECTION RECORD

FIELD BOOK


No.

ADDRESS 205 Neecheah Street BLOCK LOT 775

DATES		WATER		SEWER	
On at Main	9/16/2019	Depth at P/L:	2.28 m		2.25 m
On at Building	N/A	Depth at Main:	2.49 m		2.61 m
Frost Plug:	N/A	Pipe Size:	25 mm / 20 mm		100 mm
Memo:		Pipe Material:	HDPE	Insul. <u>(Yes)</u> /No	PVC
		Length from Main to P/L:	5.79 m		9.01 m
		Squirt Test:	<u>(Pass)</u> /Fail		N/A
Booster Pump Required:	Yes/No	Frost Protection:	Aquaflow/ <u>(Recirc)</u> /Heat Trace/Bleeder		N/A
PRV Required:	Yes/No	Greased @ CC:	<u>(Yes)</u> /No		N/A
Water Meter Installed:	Yes/No	Continuity Test:	<u>(N/A)</u> Pass/Fail		N/A

CLEARLY INDICATE LOCATION OF CC AND ROUTE OF PIPES ON DRAWING BELOW

1. Show main valves required to isolate this service.
2. All dimensions to be tied to property line
3. All dimensions to be metric
4. Depth @ property line is based on elevation after construction and changes may have occurred.

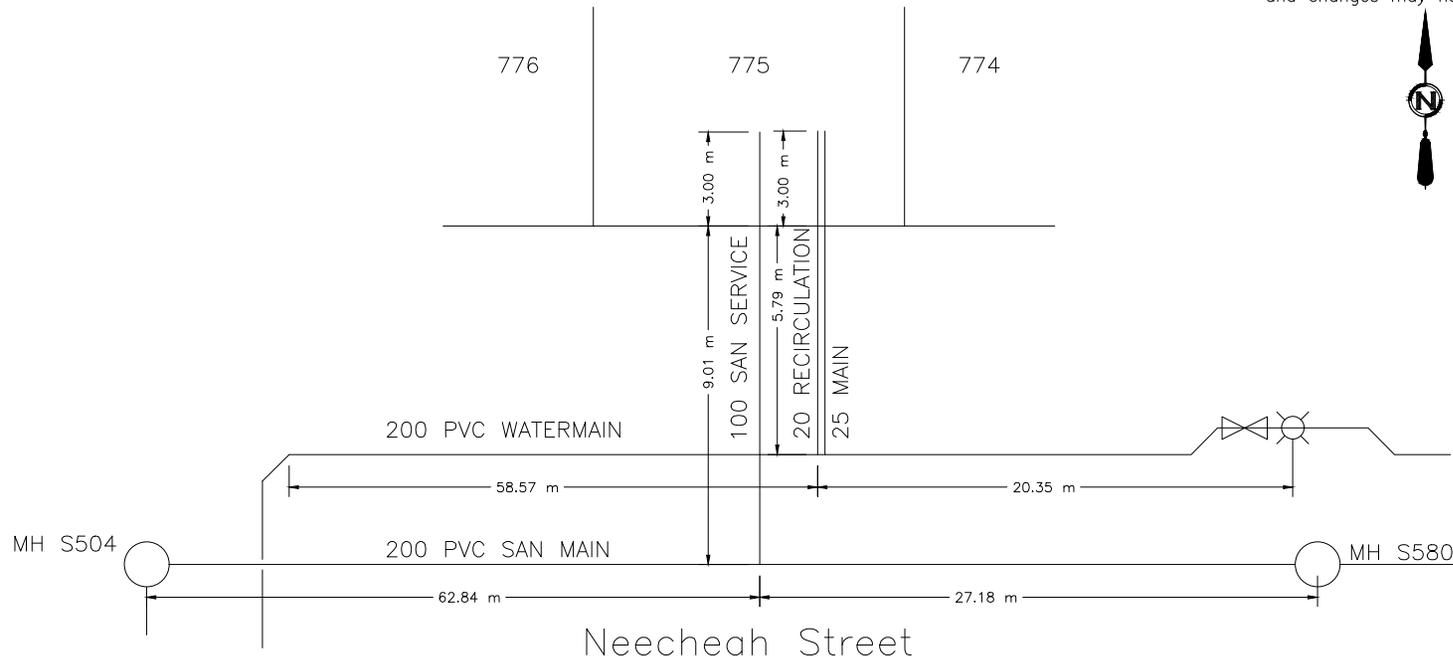



CITY OF WHITEHORSE SERVICE CONNECTION RECORD

FIELD BOOK


No. _____

ADDRESS 207 Neecheah Street BLOCK _____ LOT 776

DATES	WATER	SEWER
On at Main 9/16/2019	Depth at P/L: 2.23m	2.18 m
On at Building N/A	Depth at Main: 2.28m	2.57 m
Frost Plug: N/A	Pipe Size: 25 mm / 20 mm	100 mm
Memo:	Pipe Material: HDPE Insul. <u>Yes</u> /No	PVC Insul. Yes/ <u>No</u>
	Length from Main to P/L: 5.75 m	8.99 m
	Squirt Test: <u>Pass</u> /Fail	N/A
Booster Pump Required: Yes/No	Frost Protection: Aquaflo/ <u>Recirc</u> /Heat Trace/Bleeder	N/A
PRV Required: Yes/No	Greased @ CC: <u>Yes</u> /No	N/A
Water Meter Installed: Yes/No	Continuity Test: <u>N/A</u> Pass/Fail	N/A

CLEARLY INDICATE LOCATION OF CC AND ROUTE OF PIPES ON DRAWING BELOW

1. Show main valves required to isolate this service. 2. All dimensions to be tied to property line 3. All dimensions to be metric 4. Depth @ property line is based on elevation after construction and changes may have occurred.

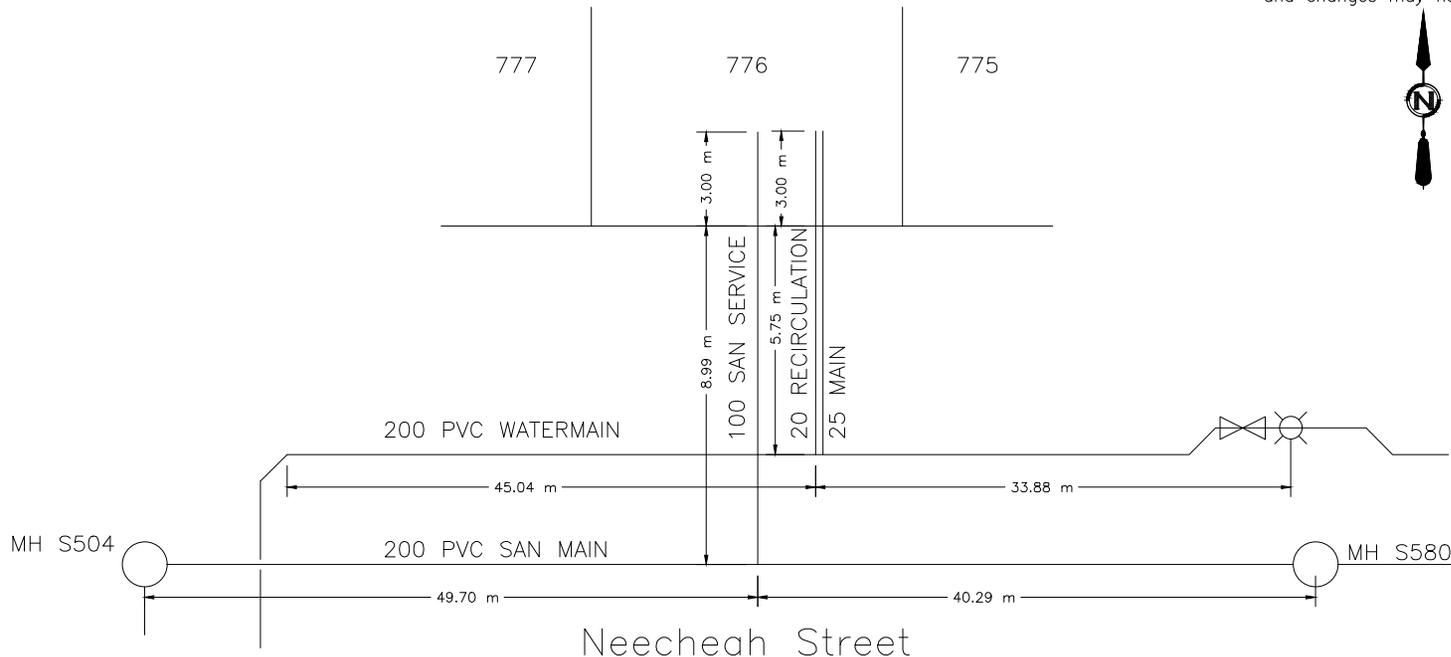



CITY OF WHITEHORSE SERVICE CONNECTION RECORD

FIELD BOOK


No. _____

ADDRESS 209 Neecheah Street BLOCK _____ LOT 777

DATES	WATER	SEWER
On at Main 9/16/2019	Depth at P/L: 2.22 m	2.18 m
On at Building N/A	Depth at Main: 2.38 m	2.5 m
Frost Plug: N/A	Pipe Size: 25 mm / 20 mm	100 mm
Memo:	Pipe Material: HDPE Insul. <u>Yes</u> /No	PVC Insul. Yes/ <u>No</u>
	Length from Main to P/L: 5.81 m	8.92 m
	Squirt Test: <u>Pass</u> /Fail	N/A
Booster Pump Required: Yes/No	Frost Protection: Aquaflo/ <u>Recirc</u> /Heat Trace/Bleeder	N/A
PRV Required: Yes/No	Greased @ CC: <u>Yes</u> /No	N/A
Water Meter Installed: Yes/No	Continuity Test: <u>N/A</u> Pass/Fail	N/A

CLEARLY INDICATE LOCATION OF CC AND ROUTE OF PIPES ON DRAWING BELOW

1. Show main valves required to isolate this service. 2. All dimensions to be tied to property line 3. All dimensions to be metric 4. Depth @ property line is based on elevation after construction and changes may have occurred.

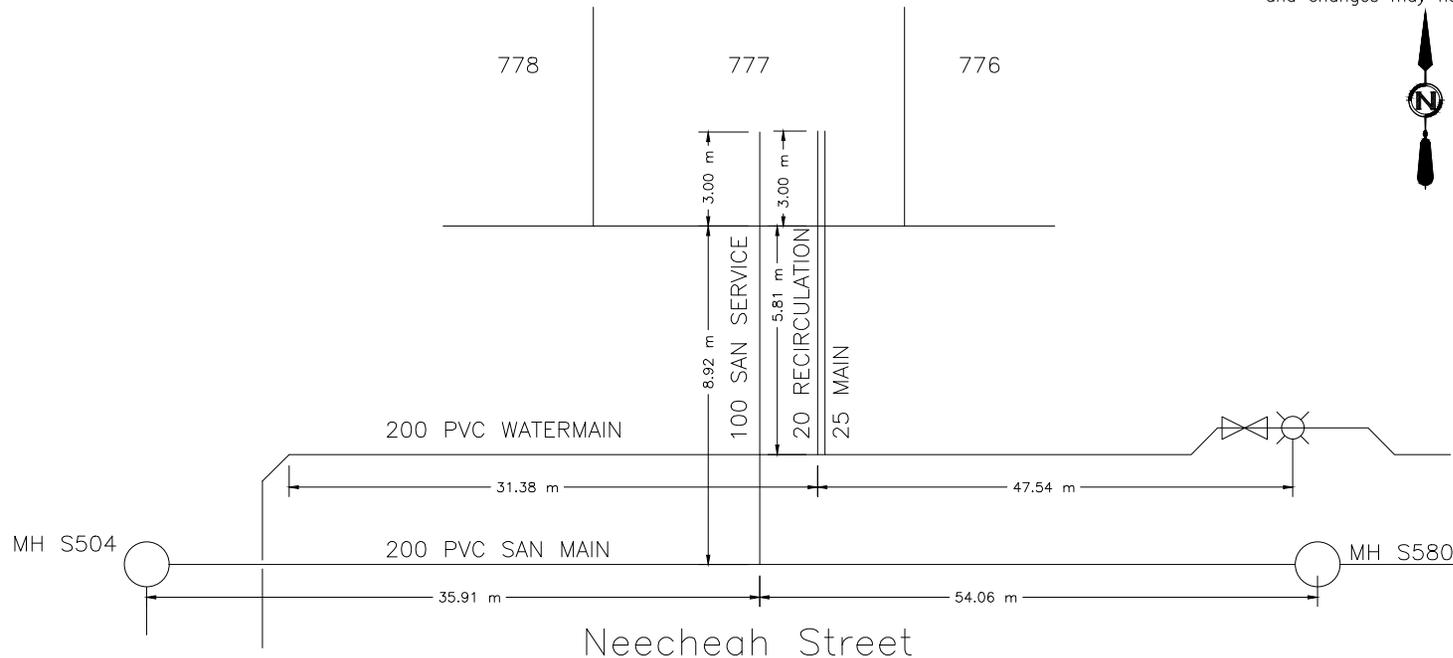



CITY OF WHITEHORSE SERVICE CONNECTION RECORD

FIELD BOOK


No.

ADDRESS 211 Neecheah Street BLOCK LOT 778

DATES	WATER	SEWER
On at Main 9/16/2019	Depth at P/L: 2.27 m	2.22 m
On at Building N/A	Depth at Main: 2.66 m	2.56 m
Frost Plug: N/A	Pipe Size: 25 mm / 20 mm	100 mm
Memo:	Pipe Material: HDPE Insul. <u>(Yes)</u> /No	PVC Insul. Yes/ <u>(No)</u>
	Length from Main to P/L: 5.78 m	9.03 m
	Squirt Test: <u>(Pass)</u> /Fail	N/A
Booster Pump Required: Yes/No	Frost Protection: Aquaflo/ <u>(Recirc)</u> /Heat Trace/Bleeder	N/A
PRV Required: Yes/No	Greased @ CC: <u>(Yes)</u> /No	N/A
Water Meter Installed: Yes/No	Continuity Test: <u>(N/A)</u> Pass/Fail	N/A

CLEARLY INDICATE LOCATION OF CC AND ROUTE OF PIPES ON DRAWING BELOW

1. Show main valves required to isolate this service. 2. All dimensions to be tied to property line 3. All dimensions to be metric 4. Depth @ property line is based on elevation after construction and changes may have occurred.

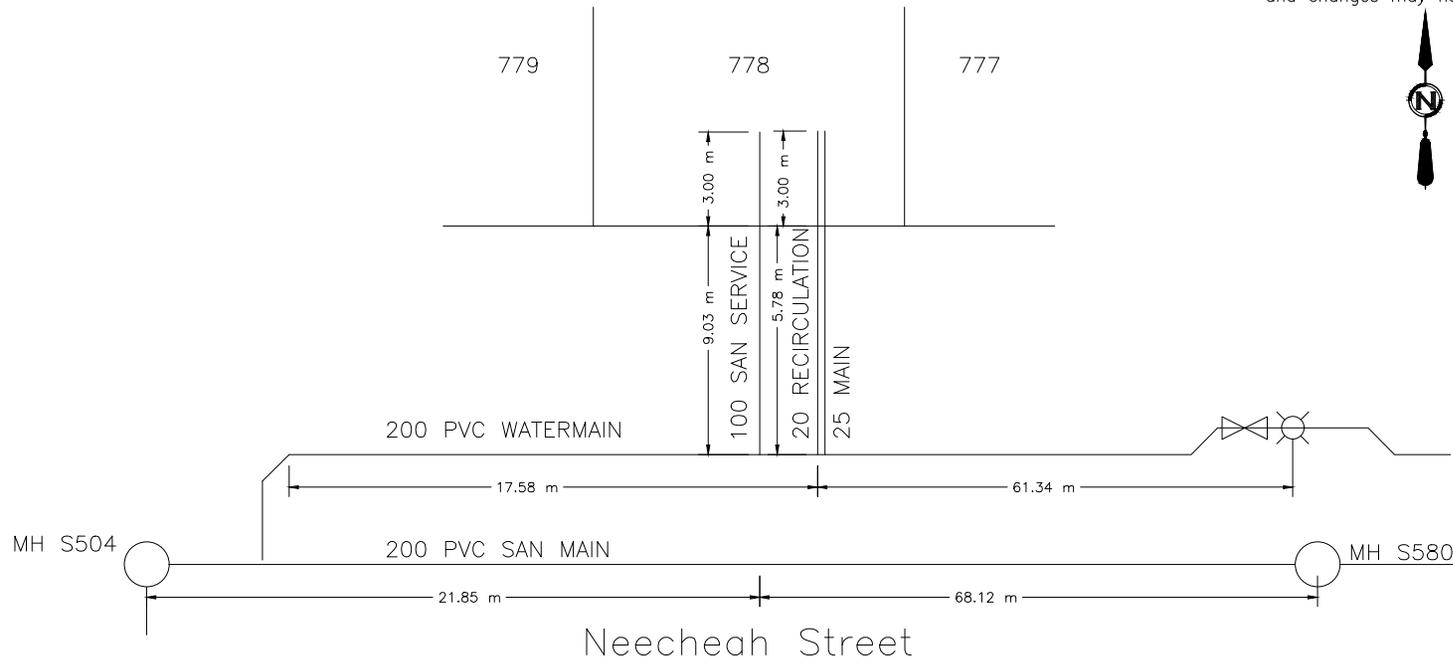



CITY OF WHITEHORSE SERVICE CONNECTION RECORD

FIELD BOOK


No.

ADDRESS 213 Neecheah Street BLOCK LOT 779

DATES		WATER		SEWER	
On at Main	9/13/2019	Depth at P/L:	2.18 m		2.12 m
On at Building	N/A	Depth at Main:	2.42 m		2.51 m
Frost Plug:	N/A	Pipe Size:	25 mm / 20 mm		100 mm
Memo:		Pipe Material:	HDPE	Insul. (Yes/No)	PVC
		Length from Main to P/L:	6.27 m		9.65 m
		Squirt Test:	(Pass/Fail)		N/A
Booster Pump Required:	Yes/No	Frost Protection:	Aquaflow/Recirc/Heat Trace/Bleeder		N/A
PRV Required:	Yes/No	Greased @ CC:	(Yes/No)		N/A
Water Meter Installed:	Yes/No	Continuity Test:	(N/A) Pass/Fail		N/A

CLEARLY INDICATE LOCATION OF CC AND ROUTE OF PIPES ON DRAWING BELOW

1. Show main valves required to isolate this service.
2. All dimensions to be tied to property line
3. All dimensions to be metric
4. Depth @ property line is based on elevation after construction and changes may have occurred.

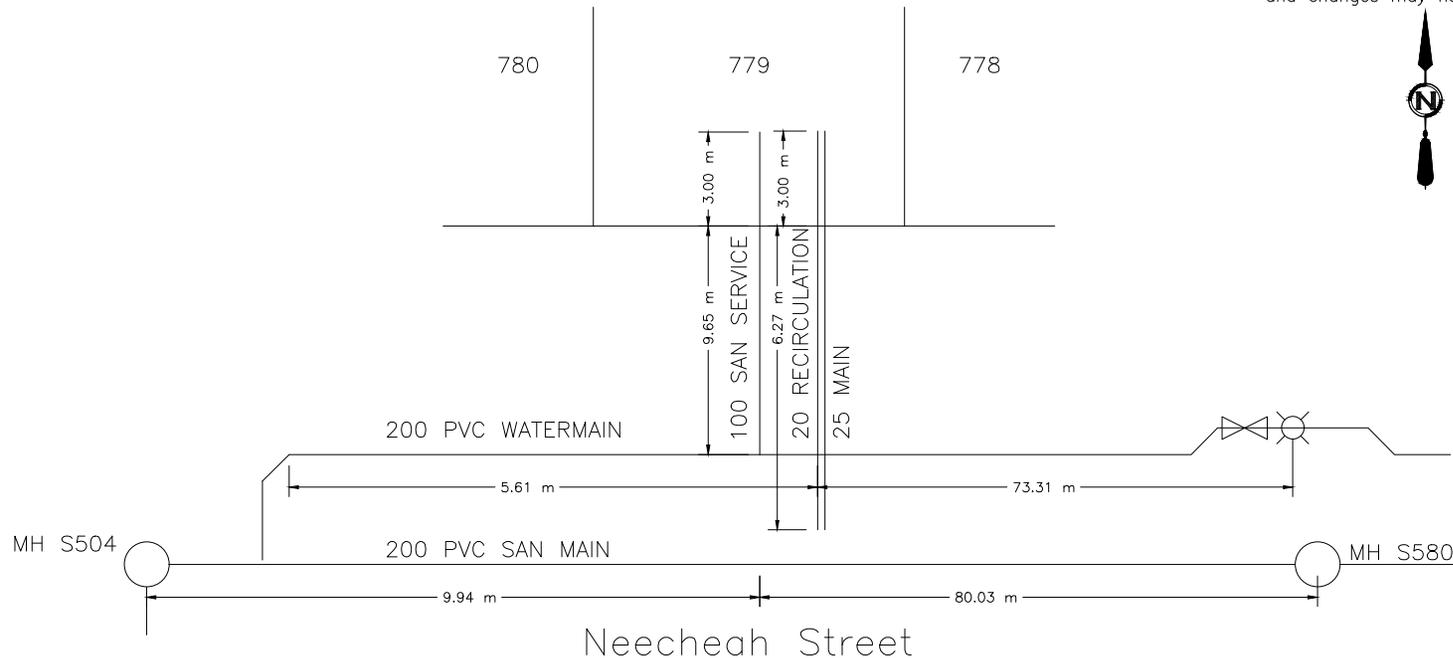



CITY OF WHITEHORSE SERVICE CONNECTION RECORD

FIELD BOOK


No.

ADDRESS 215 Neecheah Street BLOCK LOT 780

DATES		WATER		SEWER	
On at Main	9/13/2019	Depth at P/L:	2.25 m	2.25	m
On at Building	N/A	Depth at Main:	3.25 m	2.62	m
Frost Plug:	N/A	Pipe Size:	25 mm / 20 mm	100	mm
Memo:		Pipe Material:	HDPE	Insul.	(Yes/No)
		Length from Main to P/L:	8.92 m	PVC	Insul. (Yes/No)
		Squirt Test:	(Pass/Fail)		N/A
Booster Pump Required:	Yes/No	Frost Protection:	Aquaflow/Recirc/Heat Trace/Bleeder		N/A
PRV Required:	Yes/No	Greased @ CC:	(Yes/No)		N/A
Water Meter Installed:	Yes/No	Continuity Test:	(N/A) Pass/Fail		N/A

CLEARLY INDICATE LOCATION OF CC AND ROUTE OF PIPES ON DRAWING BELOW

- Show main valves required to isolate this service.
- All dimensions to be tied to property line
- All dimensions to be metric
- Depth @ property line is based on elevation after construction and changes may have occurred.

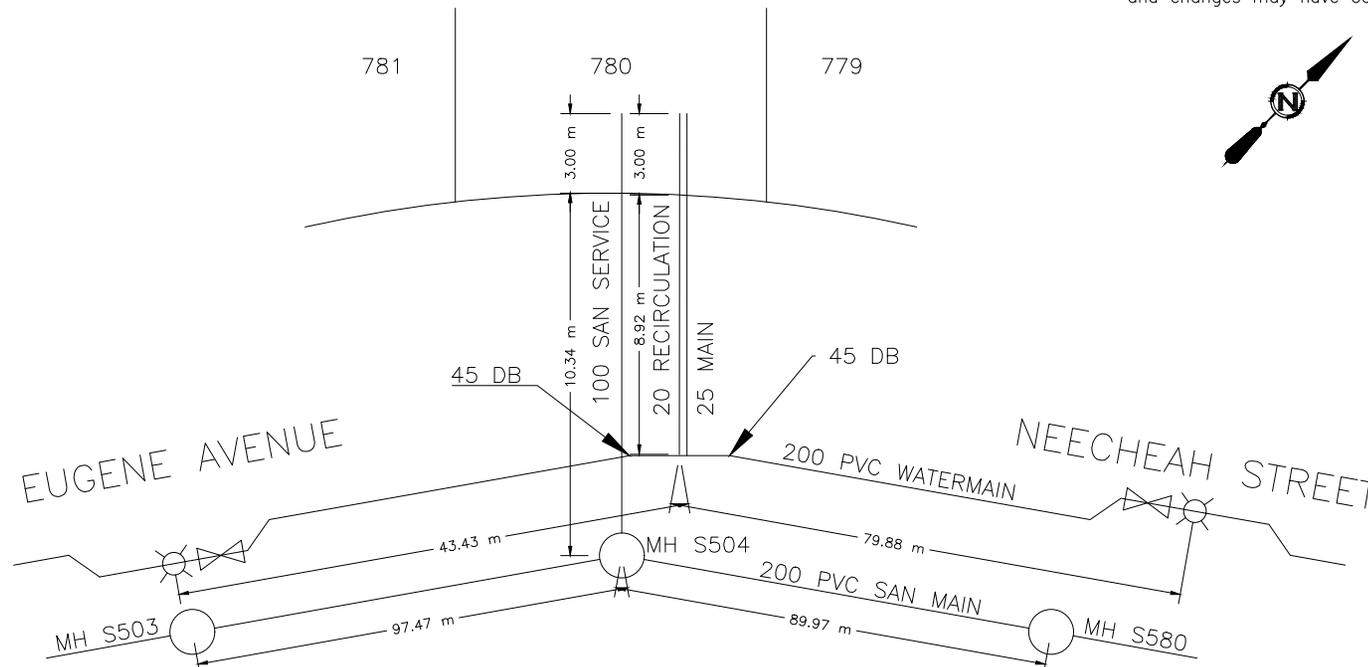



CITY OF WHITEHORSE SERVICE CONNECTION RECORD

FIELD BOOK


No.

ADDRESS 217 Neecheah Street BLOCK LOT 781

DATES	WATER	SEWER
On at Main 9/13/2019	Depth at P/L: 2.27 m	2.19 m
On at Building N/A	Depth at Main: 3.2 m	2.62 m
Frost Plug: N/A	Pipe Size: 25 mm / 20 mm	100 mm
Memo:	Pipe Material: HDPE Insul. <u>(Yes)</u> /No	PVC Insul. <u>(Yes)</u> /No
	Length from Main to P/L: 13.03 m	9.52 m
	Squirt Test: <u>(Pass)</u> /Fail	N/A
Booster Pump Required: Yes/No	Frost Protection: Aquaflo/ <u>(Recirc)</u> /Heat Trace/Bleeder	N/A
PRV Required: Yes/No	Greased @ CC: <u>(Yes)</u> /No	N/A
Water Meter Installed: Yes/No	Continuity Test: <u>(N/A)</u> Pass/Fail	N/A

CLEARLY INDICATE LOCATION OF CC AND ROUTE OF PIPES ON DRAWING BELOW

1. Show main valves required to isolate this service. 2. All dimensions to be tied to property line 3. All dimensions to be metric 4. Depth @ property line is based on elevation after construction and changes may have occurred.

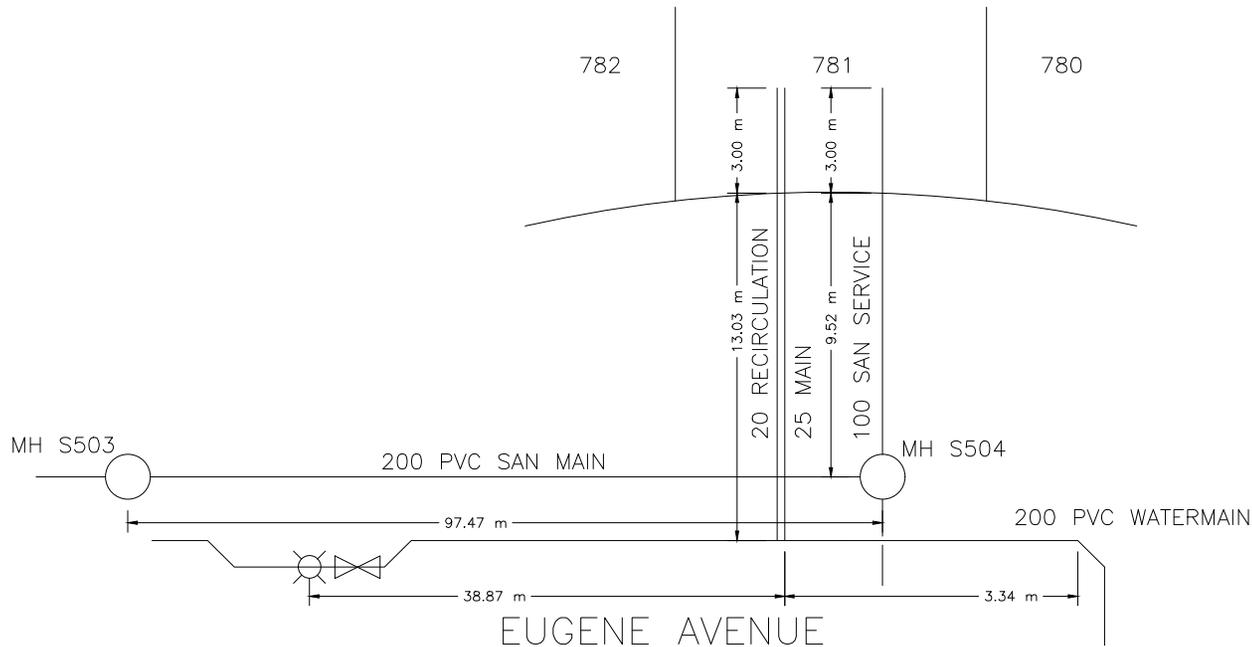



CITY OF WHITEHORSE SERVICE CONNECTION RECORD

FIELD BOOK


No. _____

ADDRESS 96 Eugene Avenue BLOCK _____ LOT 782

DATES	WATER	SEWER
On at Main N/A	Depth at P/L: N/A m	N/A m
On at Building N/A	Depth at Main: N/A m	N/A m
Frost Plug: N/A	Pipe Size: N/A mm / N/A mm	N/A mm
Memo:	Pipe Material: N/A Insul. <u>Yes</u> /No	N/A Insul. Yes/ <u>No</u>
	Length from Main to P/L: N/A m	N/A m
	Squirt Test: <u>Pass</u> /Fail	N/A
Booster Pump Required: Yes/No	Frost Protection: Aquaflow/ <u>Recirc</u> /Heat Trace/Bleeder	N/A
PRV Required: Yes/No	Greased @ CC: <u>Yes</u> /No	N/A
Water Meter Installed: Yes/No	Continuity Test: <u>N/A</u> Pass/Fail	N/A

CLEARLY INDICATE LOCATION OF CC AND ROUTE OF PIPES ON DRAWING BELOW

1. Show main valves required to isolate this service. 2. All dimensions to be tied to property line 3. All dimensions to be metric 4. Depth @ property line is based on elevation after construction and changes may have occurred.

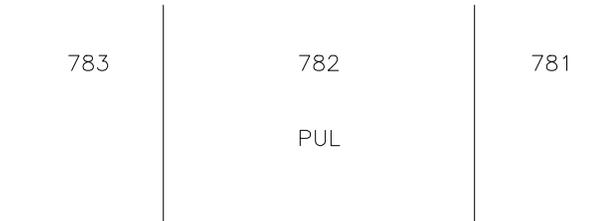

Eugene Avenue



CITY OF WHITEHORSE SERVICE CONNECTION RECORD

FIELD BOOK


No.

ADDRESS 94 Eugene Avenue BLOCK LOT 783

DATES	WATER	SEWER
On at Main 9/13/2019	Depth at P/L: 2.21 m	2.19 m
On at Building N/A	Depth at Main: 3.04 m	2.48 m
Frost Plug: N/A	Pipe Size: 25 mm / 20 mm	100 mm
Memo:	Pipe Material: HDPE Insul. <u>(Yes)</u> /No	PVC Insul. <u>(Yes)</u> /No
	Length from Main to P/L: 11.81 m	8.95 m
	Squirt Test: <u>(Pass)</u> /Fail	N/A
Booster Pump Required: Yes/No	Frost Protection: Aquaflo/ <u>(Recirc)</u> /Heat Trace/Bleeder	N/A
PRV Required: Yes/No	Greased @ CC: <u>(Yes)</u> /No	N/A
Water Meter Installed: Yes/No	Continuity Test: <u>(N/A)</u> Pass/Fail	N/A

CLEARLY INDICATE LOCATION OF CC AND ROUTE OF PIPES ON DRAWING BELOW

1. Show main valves required to isolate this service. 2. All dimensions to be tied to property line 3. All dimensions to be metric 4. Depth @ property line is based on elevation after construction and changes may have occurred.

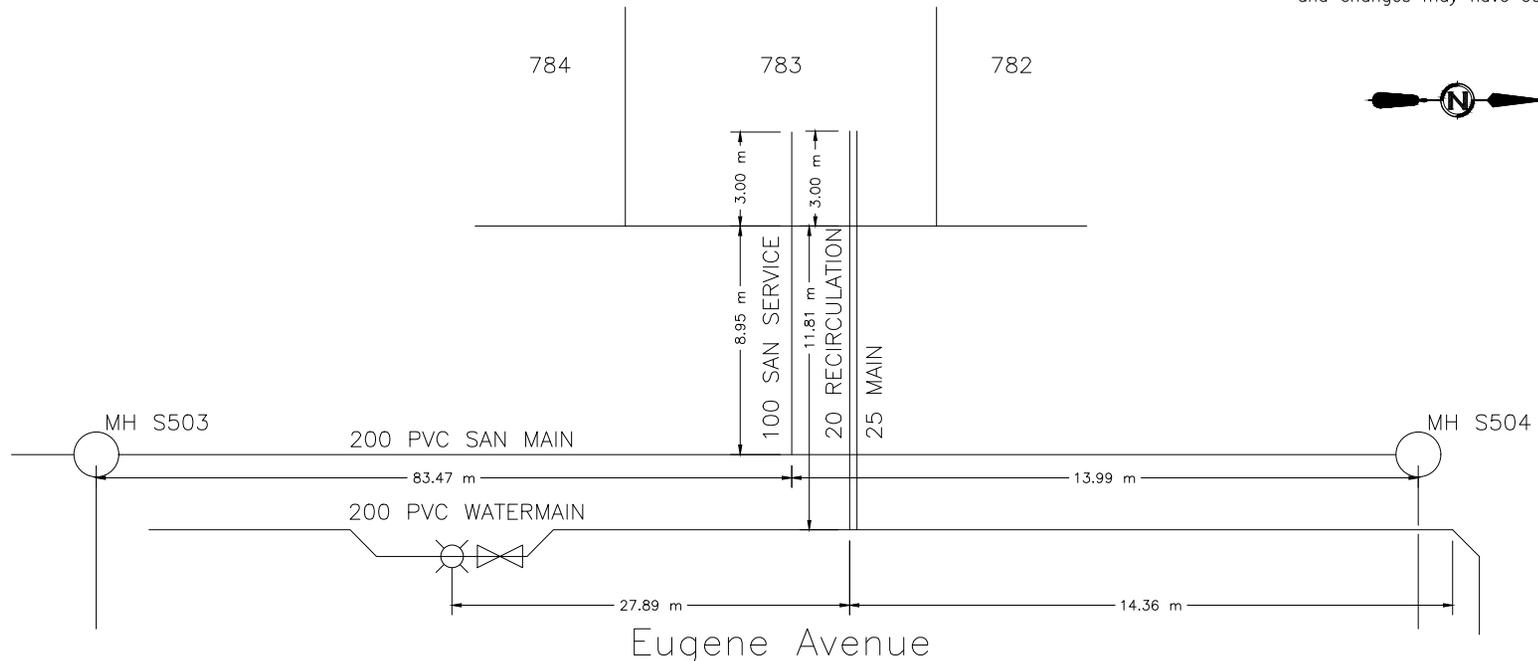



CITY OF WHITEHORSE SERVICE CONNECTION RECORD

FIELD BOOK


No.

ADDRESS 92 Eugene Avenue BLOCK LOT 784

DATES		WATER		SEWER	
On at Main	9/13/2019	Depth at P/L:	2.07 m		2.06 m
On at Building	N/A	Depth at Main:	2.97 m		2.51 m
Frost Plug:	N/A	Pipe Size:	25 mm / 20 mm		100 mm
Memo:		Pipe Material:	HDPE	Insul. (Yes/No)	PVC
					Insul. (Yes/No)
		Length from Main to P/L:	11.75 m		8.95 m
		Squirt Test:	(Pass)/Fail		N/A
Booster Pump Required:	Yes/No	Frost Protection:	Aquaflow/Recirc/Heat Trace/Bleeder		N/A
PRV Required:	Yes/No	Greased @ CC:	(Yes)/No		N/A
Water Meter Installed:	Yes/No	Continuity Test:	(N/A) Pass/Fail		N/A

CLEARLY INDICATE LOCATION OF CC AND ROUTE OF PIPES ON DRAWING BELOW

1. Show main valves required to isolate this service.
2. All dimensions to be tied to property line
3. All dimensions to be metric
4. Depth @ property line is based on elevation after construction and changes may have occurred.

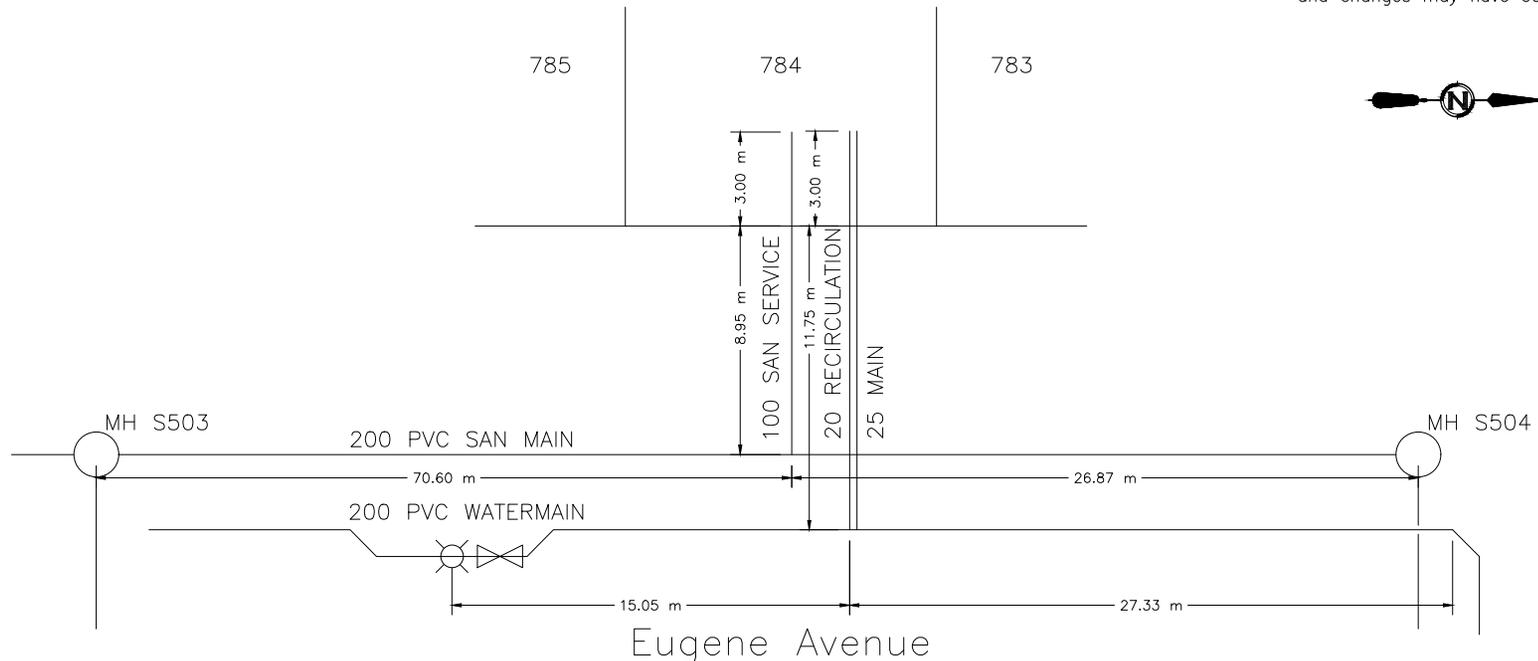



CITY OF WHITEHORSE SERVICE CONNECTION RECORD

FIELD BOOK


No.

ADDRESS 90 Eugene Avenue BLOCK LOT 785

DATES		WATER		SEWER		
On at Main	9/13/2019	Depth at P/L:	2.17 m		2.15 m	
On at Building	N/A	Depth at Main:	2.89 m		2.48 m	
Frost Plug:	N/A	Pipe Size:	25 mm / 20 mm		100 mm	
Memo:		Pipe Material:	HDPE	Insul. (Yes/No)	PVC	Insul. (Yes/No)
		Length from Main to P/L:	12.91 m		8.96 m	
		Squirt Test:	(Pass/Fail)			N/A
Booster Pump Required:	Yes/No	Frost Protection:	Aquaflow/Recirc/Heat Trace/Bleeder		N/A	
PRV Required:	Yes/No	Greased @ CC:	(Yes/No)		N/A	
Water Meter Installed:	Yes/No	Continuity Test:	(N/A) Pass/Fail		N/A	

CLEARLY INDICATE LOCATION OF CC AND ROUTE OF PIPES ON DRAWING BELOW

1. Show main valves required to isolate this service.
2. All dimensions to be tied to property line
3. All dimensions to be metric
4. Depth @ property line is based on elevation after construction and changes may have occurred.

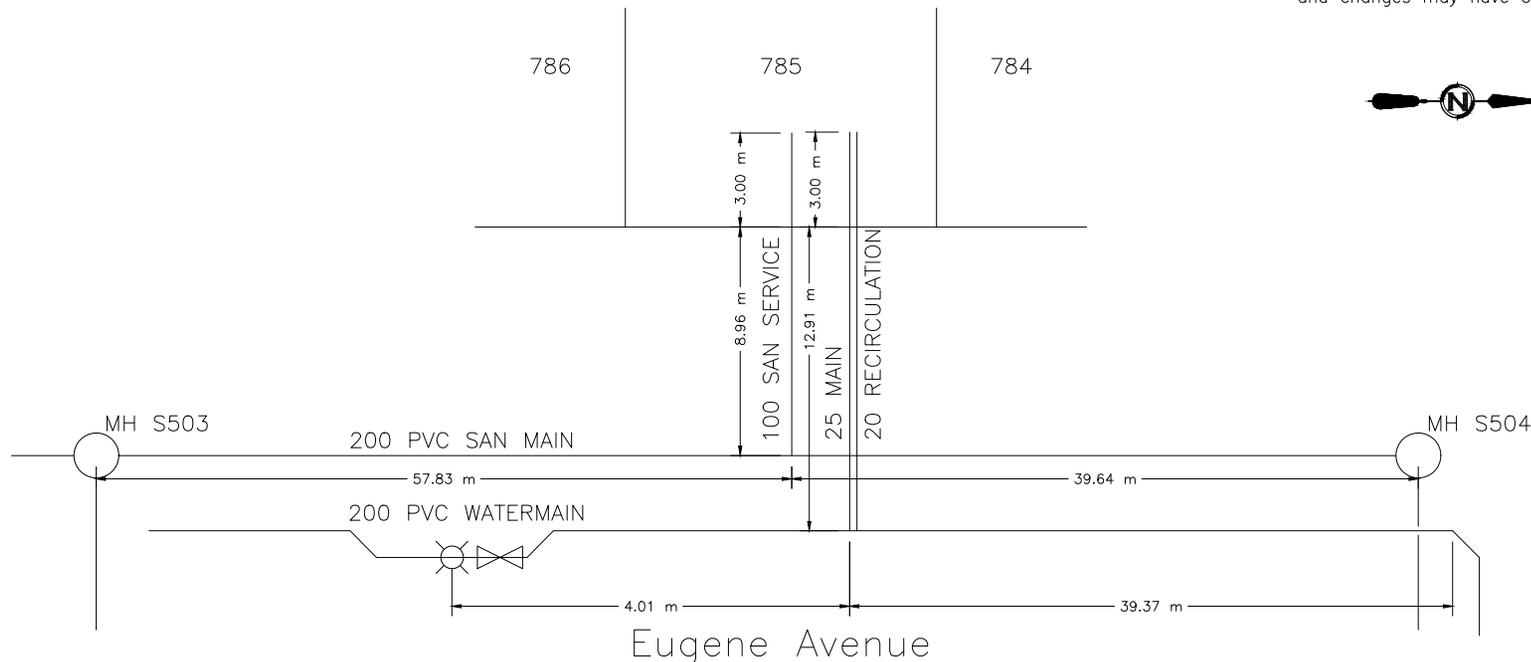



CITY OF WHITEHORSE SERVICE CONNECTION RECORD

FIELD BOOK


No.

ADDRESS 88 Eugene Avenue BLOCK LOT 786

DATES	WATER	SEWER
On at Main 9/13/2019	Depth at P/L: 2.1 m	2.07 m
On at Building N/A	Depth at Main: 2.78 m	2.46 m
Frost Plug: N/A	Pipe Size: 25 mm / 20 mm	100 mm
Memo:	Pipe Material: HDPE Insul. <u>(Yes)</u> /No	PVC Insul. <u>(Yes)</u> /No
	Length from Main to P/L: 11.77 m	8.95 m
	Squirt Test: <u>(Pass)</u> /Fail	N/A
Booster Pump Required: Yes/No	Frost Protection: Aquaflo/ <u>(Recirc)</u> /Heat Trace/Bleeder	N/A
PRV Required: Yes/No	Greased @ CC: <u>(Yes)</u> /No	N/A
Water Meter Installed: Yes/No	Continuity Test: <u>(N/A)</u> Pass/Fail	N/A

CLEARLY INDICATE LOCATION OF CC AND ROUTE OF PIPES ON DRAWING BELOW

1. Show main valves required to isolate this service. 2. All dimensions to be tied to property line 3. All dimensions to be metric 4. Depth @ property line is based on elevation after construction and changes may have occurred.

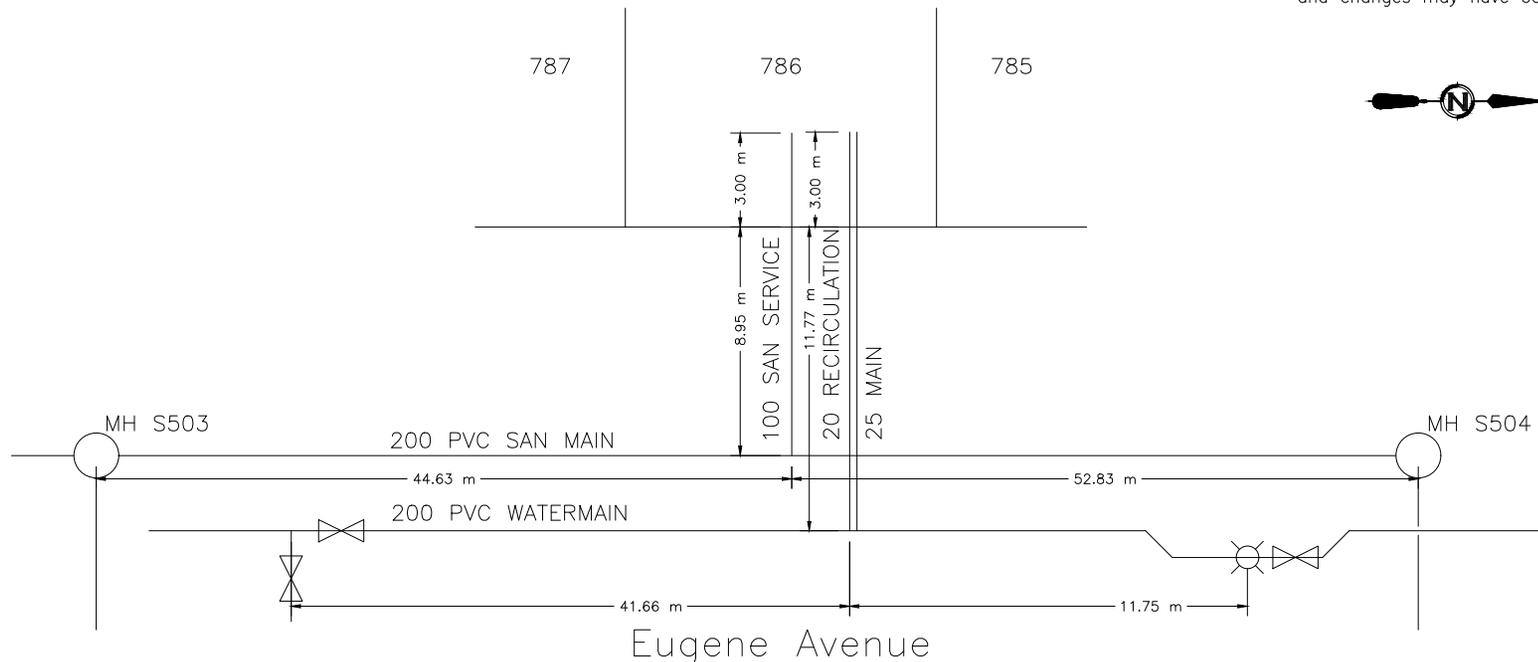



CITY OF WHITEHORSE SERVICE CONNECTION RECORD

FIELD BOOK


No.

ADDRESS 86 Eugene Avenue BLOCK LOT 787

DATES		WATER		SEWER	
On at Main	9/12/2019	Depth at P/L:	2.06 m		2.05 m
On at Building	N/A	Depth at Main:	2.81 m		2.45 m
Frost Plug:	N/A	Pipe Size:	25 mm / 20 mm		100 mm
Memo:		Pipe Material:	HDPE	Insul. (Yes/No)	PVC
		Length from Main to P/L:	11.82 m		8.94 m
		Squirt Test:	Pass/Fail		N/A
Booster Pump Required:	Yes/No	Frost Protection:	Aquaflow/Recirc/Heat Trace/Bleeder		N/A
PRV Required:	Yes/No	Greased @ CC:	Yes/No		N/A
Water Meter Installed:	Yes/No	Continuity Test:	N/A	Pass/Fail	N/A

CLEARLY INDICATE LOCATION OF CC AND ROUTE OF PIPES ON DRAWING BELOW

1. Show main valves required to isolate this service.
2. All dimensions to be tied to property line
3. All dimensions to be metric
4. Depth @ property line is based on elevation after construction and changes may have occurred.

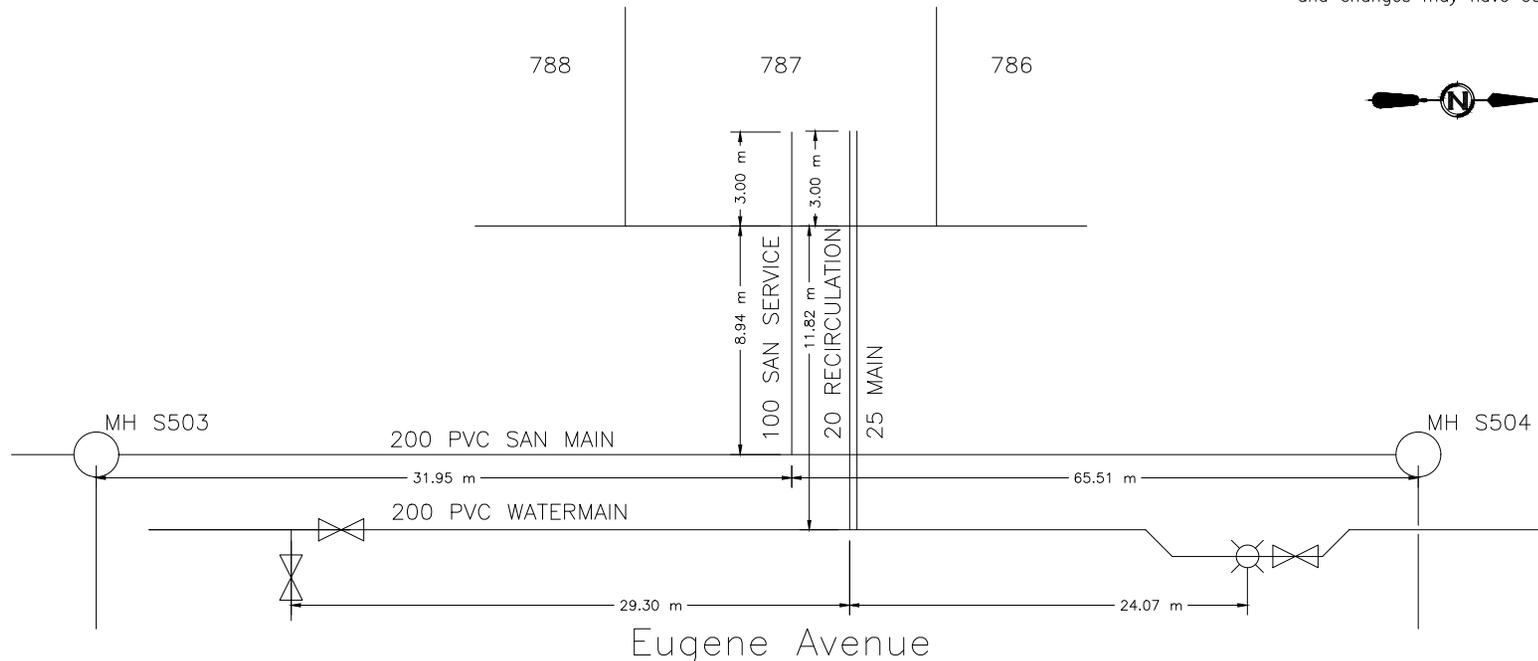



CITY OF WHITEHORSE SERVICE CONNECTION RECORD

FIELD BOOK


No.

ADDRESS 84 Eugene Avenue BLOCK LOT 788

DATES		WATER		SEWER	
On at Main	9/12/2019	Depth at P/L:	2.09 m	2.09	m
On at Building	N/A	Depth at Main:	2.86 m	2.48	m
Frost Plug:	N/A	Pipe Size:	25 mm / 20 mm	100	mm
Memo:		Pipe Material:	HDPE	Insul.	(Yes/No)
		Length from Main to P/L:	11.78 m	PVC	Insul. (Yes/No)
		Squirt Test:	(Pass/Fail)		N/A
Booster Pump Required:	Yes/No	Frost Protection:	Aquaflow/Recirc/Heat Trace/Bleeder		N/A
PRV Required:	Yes/No	Greased @ CC:	(Yes/No)		N/A
Water Meter Installed:	Yes/No	Continuity Test:	(N/A) Pass/Fail		N/A

CLEARLY INDICATE LOCATION OF CC AND ROUTE OF PIPES ON DRAWING BELOW

1. Show main valves required to isolate this service.
2. All dimensions to be tied to property line
3. All dimensions to be metric
4. Depth @ property line is based on elevation after construction and changes may have occurred.

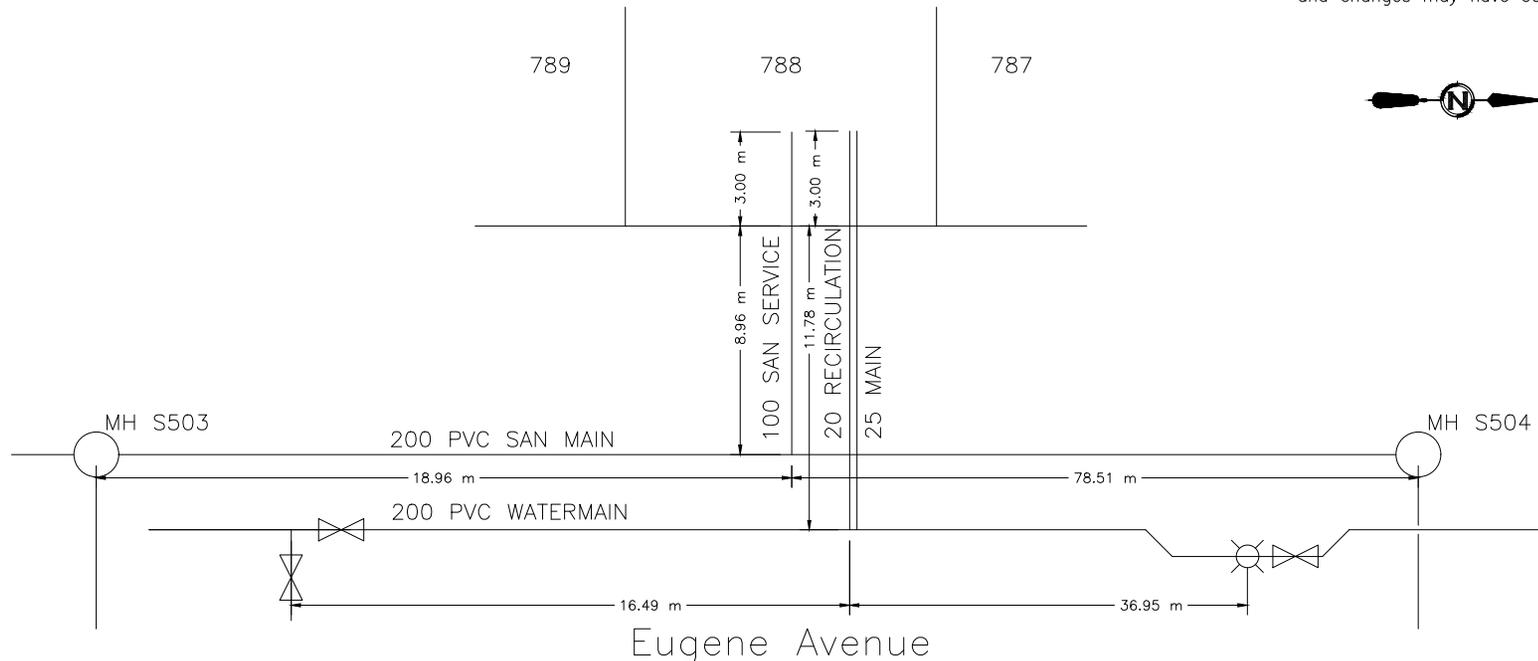



CITY OF WHITEHORSE SERVICE CONNECTION RECORD

FIELD BOOK


No.

ADDRESS 82 Eugene Avenue BLOCK LOT 789

DATES	WATER	SEWER
On at Main 9/10/2019	Depth at P/L: 2.07 m	2.06 m
On at Building N/A	Depth at Main: 2.9 m	2.43 m
Frost Plug: N/A	Pipe Size: 25 mm / 20 mm	100 mm
Memo:	Pipe Material: HDPE	PVC
	Insul. <u>(Yes)</u> /No	Insul. <u>(Yes)</u> /No
	Length from Main to P/L: 11.77 m	8.97 m
	Squirt Test: <u>(Pass)</u> /Fail	N/A
Booster Pump Required: Yes/No	Frost Protection: Aquaflo/ <u>(Recirc)</u> /Heat Trace/Bleeder	N/A
PRV Required: Yes/No	Greased @ CC: <u>(Yes)</u> /No	N/A
Water Meter Installed: Yes/No	Continuity Test: <u>(N/A)</u> Pass/Fail	N/A

CLEARLY INDICATE LOCATION OF CC AND ROUTE OF PIPES ON DRAWING BELOW

1. Show main valves required to isolate this service. 2. All dimensions to be tied to property line 3. All dimensions to be metric 4. Depth @ property line is based on elevation after construction and changes may have occurred.

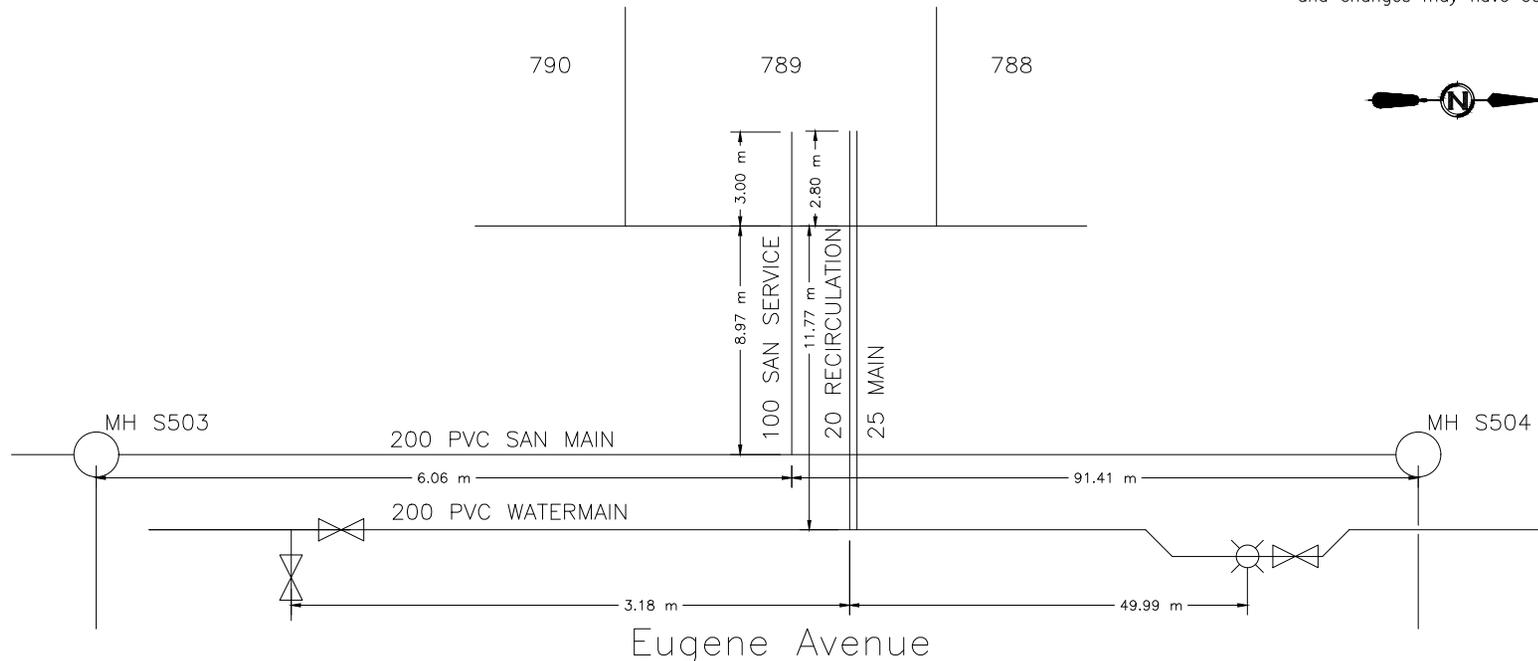



CITY OF WHITEHORSE SERVICE CONNECTION RECORD

FIELD BOOK


No.

ADDRESS 80 Eugene Avenue BLOCK LOT 790

	DATES	WATER	SEWER
On at Main	N/A	Depth at P/L: N/A m	N/A m
On at Building	N/A	Depth at Main: N/A m	N/A m
Frost Plug:	N/A	Pipe Size: N/A mm / N/A mm	N/A mm
Memo:	Pipe Material:	N/A Insul. <u>Yes</u> /No	N/A Insul. <u>Yes</u> /No
	Length from Main to P/L:	N/A m	N/A m
	Squirt Test:	<u>Pass</u> /Fail	N/A
Booster Pump Required:	Yes/No	Frost Protection: Aquaflow/ <u>Recirc</u> /Heat Trace/Bleeder	N/A
PRV Required:	Yes/No	Greased @ CC: <u>Yes</u> /No	N/A
Water Meter Installed:	Yes/No	Continuity Test: <u>N/A</u> Pass/Fail	N/A

CLEARLY INDICATE LOCATION OF CC AND ROUTE OF PIPES ON DRAWING BELOW

1. Show main valves required to isolate this service. 2. All dimensions to be tied to property line 3. All dimensions to be metric 4. Depth @ property line is based on elevation after construction and changes may have occurred.

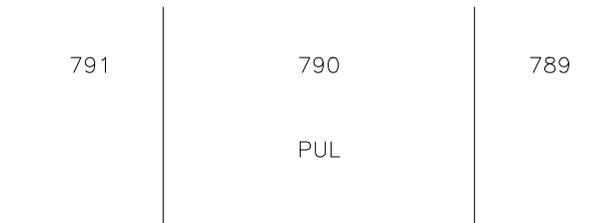



CITY OF WHITEHORSE SERVICE CONNECTION RECORD

FIELD BOOK


No.

ADDRESS 78 Eugene Avenue BLOCK LOT 791

DATES	WATER	SEWER
On at Main 9/10/2019	Depth at P/L: 2.14 m	2.14 m
On at Building N/A	Depth at Main: 2.79 m	2.47 m
Frost Plug: N/A	Pipe Size: 25 mm / 20 mm	100 mm
Memo:	Pipe Material: HDPE Insul. <u>(Yes)</u> /No	PVC Insul. <u>(Yes)</u> /No
	Length from Main to P/L: 11.72 m	8.92 m
	Squirt Test: <u>(Pass)</u> /Fail	N/A
Booster Pump Required: Yes/No	Frost Protection: Aquaflow/ <u>(Recirc)</u> /Heat Trace/Bleeder	N/A
PRV Required: Yes/No	Greased @ CC: <u>(Yes)</u> /No	N/A
Water Meter Installed: Yes/No	Continuity Test: <u>(N/A)</u> Pass/Fail	N/A

CLEARLY INDICATE LOCATION OF CC AND ROUTE OF PIPES ON DRAWING BELOW

1. Show main valves required to isolate this service. 2. All dimensions to be tied to property line 3. All dimensions to be metric 4. Depth @ property line is based on elevation after construction and changes may have occurred.

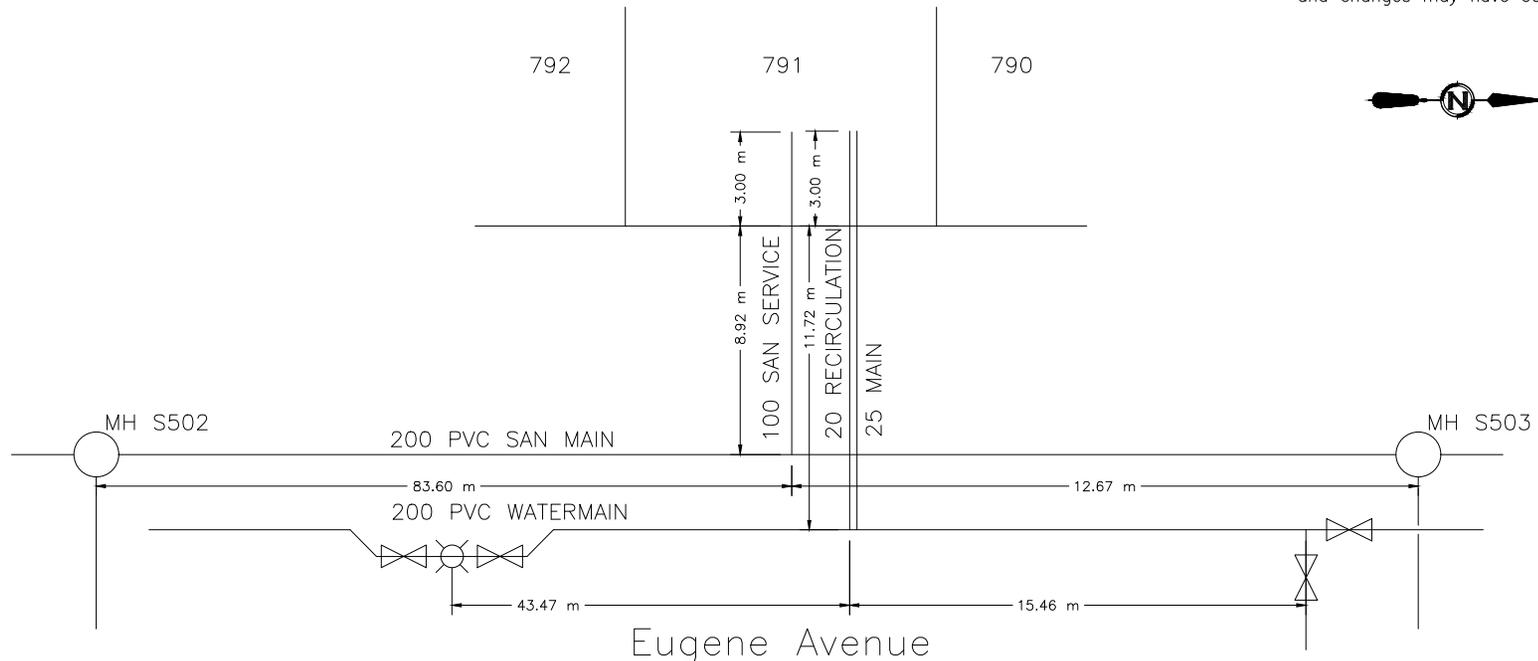



CITY OF WHITEHORSE SERVICE CONNECTION RECORD

FIELD BOOK


No.

ADDRESS 76 Eugene Avenue BLOCK LOT 792

DATES		WATER		SEWER		
On at Main	9/10/2019	Depth at P/L:	2.06 m		2.04 m	
On at Building	N/A	Depth at Main:	3.02 m		2.5 m	
Frost Plug:	N/A	Pipe Size:	25 mm / 20 mm		100 mm	
Memo:		Pipe Material:	HDPE	Insul. (Yes/No)	PVC	Insul. (Yes/No)
		Length from Main to P/L:	11.73 m		9.01 m	
		Squirt Test:	(Pass)/Fail			N/A
Booster Pump Required:	Yes/No	Frost Protection:	Aquaflow/Recirc/Heat Trace/Bleeder		N/A	
PRV Required:	Yes/No	Greased @ CC:	(Yes)/No		N/A	
Water Meter Installed:	Yes/No	Continuity Test:	(N/A) Pass/Fail		N/A	

CLEARLY INDICATE LOCATION OF CC AND ROUTE OF PIPES ON DRAWING BELOW

1. Show main valves required to isolate this service. 2. All dimensions to be tied to property line 3. All dimensions to be metric 4. Depth @ property line is based on elevation after construction and changes may have occurred.

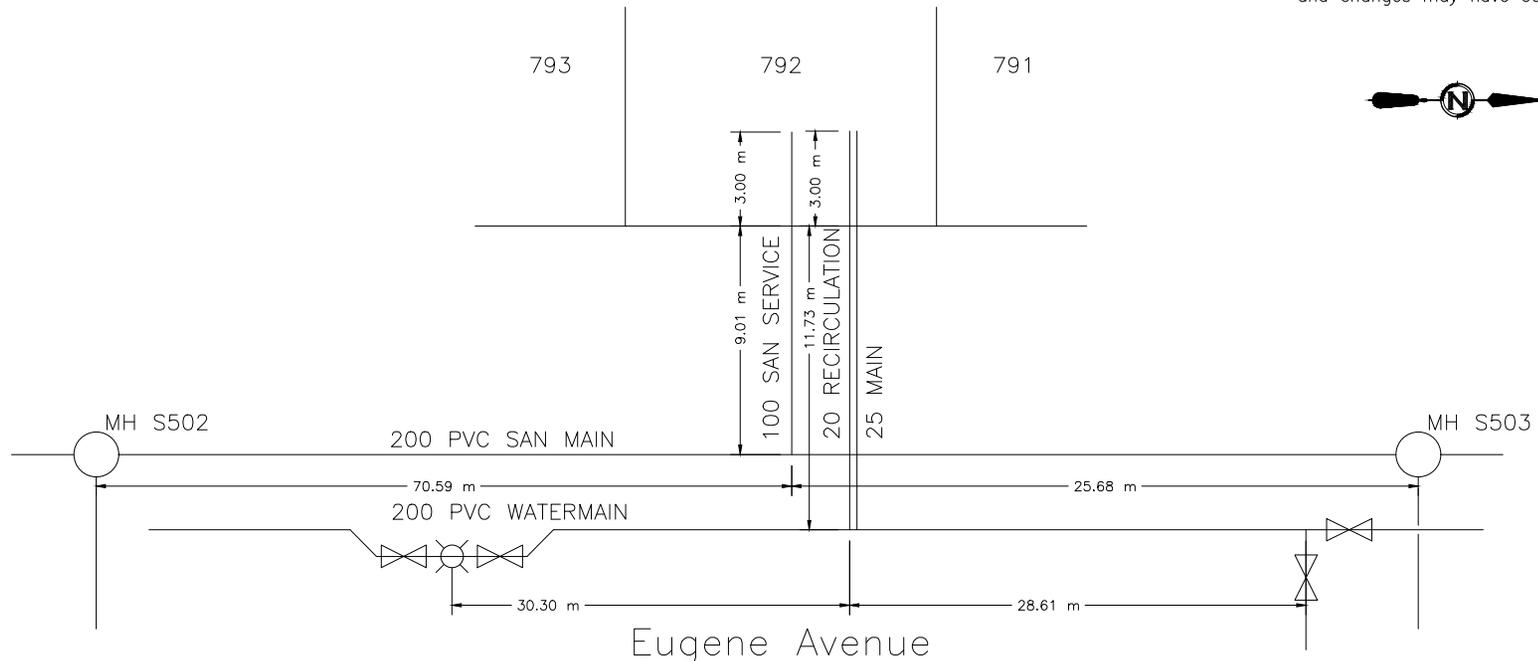



CITY OF WHITEHORSE SERVICE CONNECTION RECORD

FIELD BOOK


No.

ADDRESS 74 Eugene Avenue BLOCK LOT 793

DATES	WATER	SEWER
On at Main 9/10/2019	Depth at P/L: 2.05 m	2.04 m
On at Building N/A	Depth at Main: 3.13 m	2.4 m
Frost Plug: N/A	Pipe Size: 25 mm / 20 mm	100 mm
Memo:	Pipe Material: HDPE Insul. <u>(Yes)</u> /No	PVC Insul. <u>(Yes)</u> /No
	Length from Main to P/L: 11.77 m	8.97 m
	Squirt Test: <u>(Pass)</u> /Fail	N/A
Booster Pump Required: Yes/No	Frost Protection: Aquaflow/ <u>(Recirc)</u> /Heat Trace/Bleeder	N/A
PRV Required: Yes/No	Greased @ CC: <u>(Yes)</u> /No	N/A
Water Meter Installed: Yes/No	Continuity Test: <u>(N/A)</u> Pass/Fail	N/A

CLEARLY INDICATE LOCATION OF CC AND ROUTE OF PIPES ON DRAWING BELOW

1. Show main valves required to isolate this service. 2. All dimensions to be tied to property line 3. All dimensions to be metric 4. Depth @ property line is based on elevation after construction and changes may have occurred.

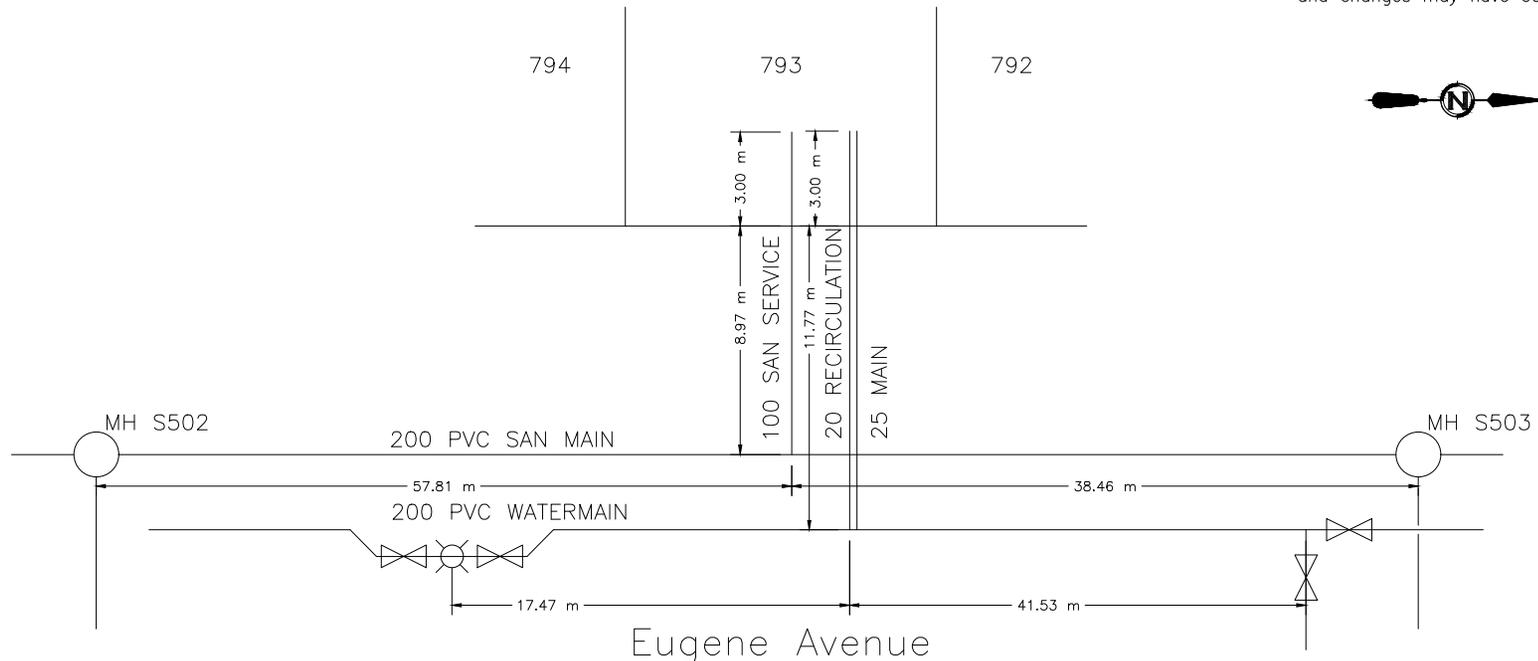



CITY OF WHITEHORSE SERVICE CONNECTION RECORD

FIELD BOOK


No.

ADDRESS 72 Eugene Avenue BLOCK LOT 794

DATES	WATER	SEWER
On at Main 9/10/2019	Depth at P/L: 2.06 m	2.06 m
On at Building N/A	Depth at Main: 3.32 m	2.43 m
Frost Plug: N/A	Pipe Size: 25 mm / 20 mm	100 mm
Memo:	Pipe Material: HDPE Insul. <u>(Yes)</u> /No	PVC Insul. <u>(Yes)</u> /No
	Length from Main to P/L: 11.72 m	8.96 m
	Squirt Test: <u>(Pass)</u> /Fail	N/A
Booster Pump Required: Yes/No	Frost Protection: Aquaflo/ <u>(Recirc)</u> /Heat Trace/Bleeder	N/A
PRV Required: Yes/No	Greased @ CC: <u>(Yes)</u> /No	N/A
Water Meter Installed: Yes/No	Continuity Test: <u>(N/A)</u> Pass/Fail	N/A

CLEARLY INDICATE LOCATION OF CC AND ROUTE OF PIPES ON DRAWING BELOW

1. Show main valves required to isolate this service. 2. All dimensions to be tied to property line 3. All dimensions to be metric 4. Depth @ property line is based on elevation after construction and changes may have occurred.

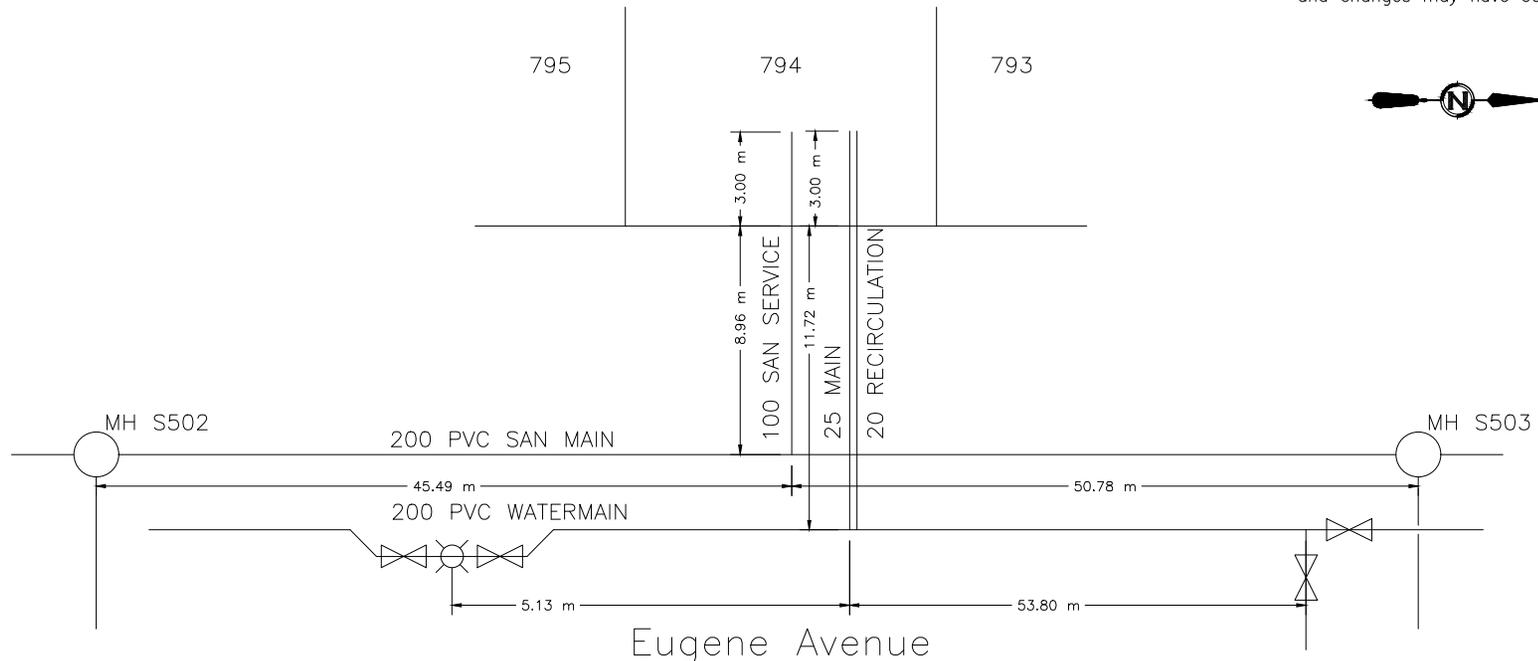



CITY OF WHITEHORSE SERVICE CONNECTION RECORD

FIELD BOOK


No.

ADDRESS 70 Eugene Avenue BLOCK LOT 795

DATES		WATER		SEWER	
On at Main	9/10/2019	Depth at P/L:	2.05 m		2.05 m
On at Building	N/A	Depth at Main:	3.22 m		2.38 m
Frost Plug:	N/A	Pipe Size:	25 mm / 20 mm		100 mm
Memo:		Pipe Material:	HDPE	Insul. <u>Yes</u> /No	PVC
		Length from Main to P/L:	11.75 m		8.97 m
		Squirt Test:	<u>Pass</u> /Fail		N/A
Booster Pump Required:	Yes/No	Frost Protection:	Aquaflow/ <u>Recirc</u> /Heat Trace/Bleeder		N/A
PRV Required:	Yes/No	Greased @ CC:	<u>Yes</u> /No		N/A
Water Meter Installed:	Yes/No	Continuity Test:	<u>N/A</u> Pass/Fail		N/A

CLEARLY INDICATE LOCATION OF CC AND ROUTE OF PIPES ON DRAWING BELOW

1. Show main valves required to isolate this service. 2. All dimensions to be tied to property line 3. All dimensions to be metric 4. Depth @ property line is based on elevation after construction and changes may have occurred.

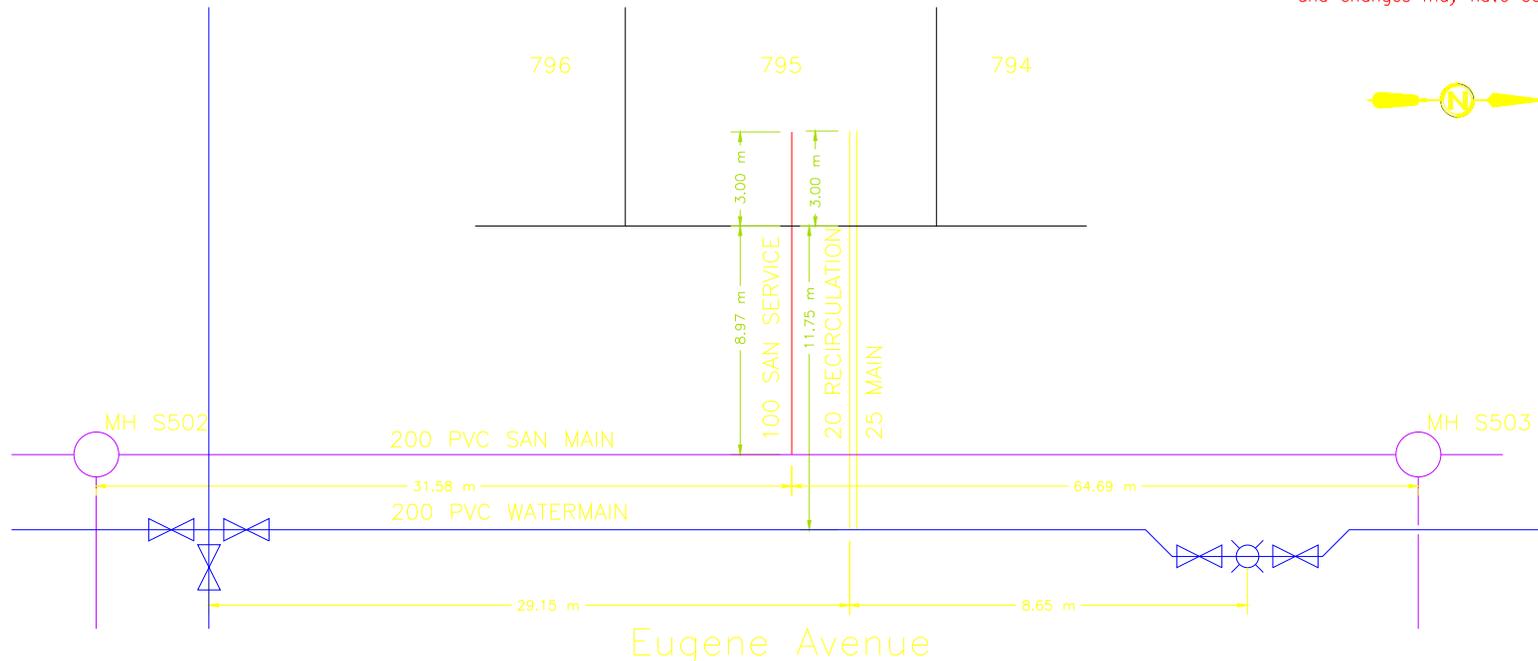



CITY OF WHITEHORSE SERVICE CONNECTION RECORD

FIELD BOOK


No.

ADDRESS 68 Eugene Avenue BLOCK LOT 796

DATES		WATER		SEWER	
On at Main	9/10/2019	Depth at P/L:	1.98 m		1.99 m
On at Building	N/A	Depth at Main:	3 m		2.32 m
Frost Plug:	N/A	Pipe Size:	25 mm / 20 mm		100 mm
Memo:		Pipe Material:	HDPE	Insul. <u>Yes</u> /No	PVC
		Length from Main to P/L:	11.7 m		8.97 m
		Squirt Test:	Pass/Fail		N/A
Booster Pump Required:	Yes/No	Frost Protection:	Aquaflow/Recirc/Heat Trace/Bleeder		N/A
PRV Required:	Yes/No	Greased @ CC:	Yes/No		N/A
Water Meter Installed:	Yes/No	Continuity Test:	N/A Pass/Fail		N/A

CLEARLY INDICATE LOCATION OF CC AND ROUTE OF PIPES ON DRAWING BELOW

1. Show main valves required to isolate this service.
2. All dimensions to be tied to property line
3. All dimensions to be metric
4. Depth @ property line is based on elevation after construction and changes may have occurred.

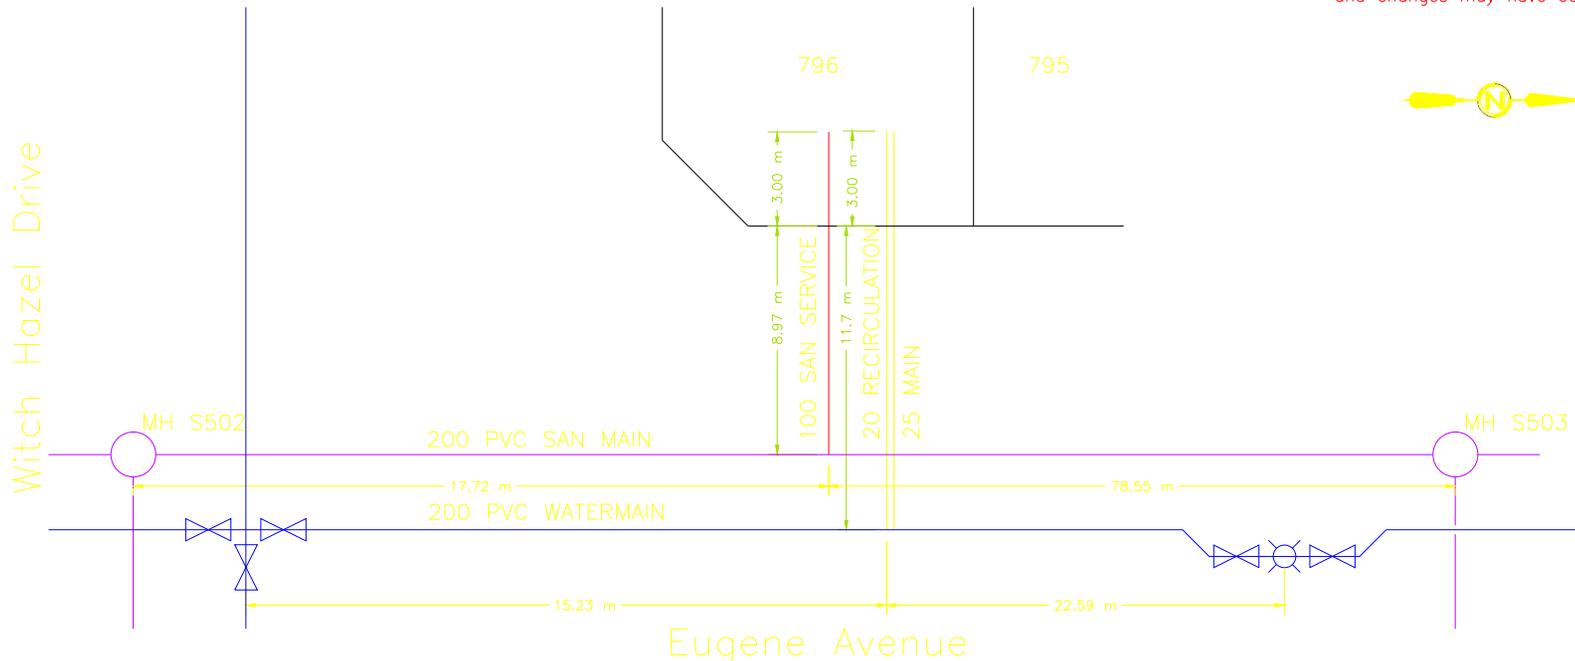



CITY OF WHITEHORSE

SERVICE CONNECTION RECORD

FIELD BOOK


No.

ADDRESS 212 Neecheah Street BLOCK LOT 797

DATES		WATER		SEWER	
On at Main	9/17/2019	Depth at P/L:	2.23 m		2.15 m
On at Building	N/A	Depth at Main:	2.94 m		2.54 m
Frost Plug:	N/A	Pipe Size:	25 mm / 20 mm		100 mm
Memo:		Pipe Material:	HDPE	Insul. <u>Yes</u> /No	PVC
		Length from Main to P/L:	11.78 m		8.9 m
		Squirt Test:	Pass/Fail		N/A
Booster Pump Required:	Yes/No	Frost Protection:	Aquaflow/Recirc/Heat Trace/Bleeder		N/A
PRV Required:	Yes/No	Greased @ CC:	<u>Yes</u> /No		N/A
Water Meter Installed:	Yes/No	Continuity Test:	<u>N/A</u> Pass/Fail		N/A

CLEARLY INDICATE LOCATION OF CC AND ROUTE OF PIPES ON DRAWING BELOW

- Show main valves required to isolate this service.
- All dimensions to be tied to property line
- All dimensions to be metric
- Depth @ property line is based on elevation after construction and changes may have occurred.

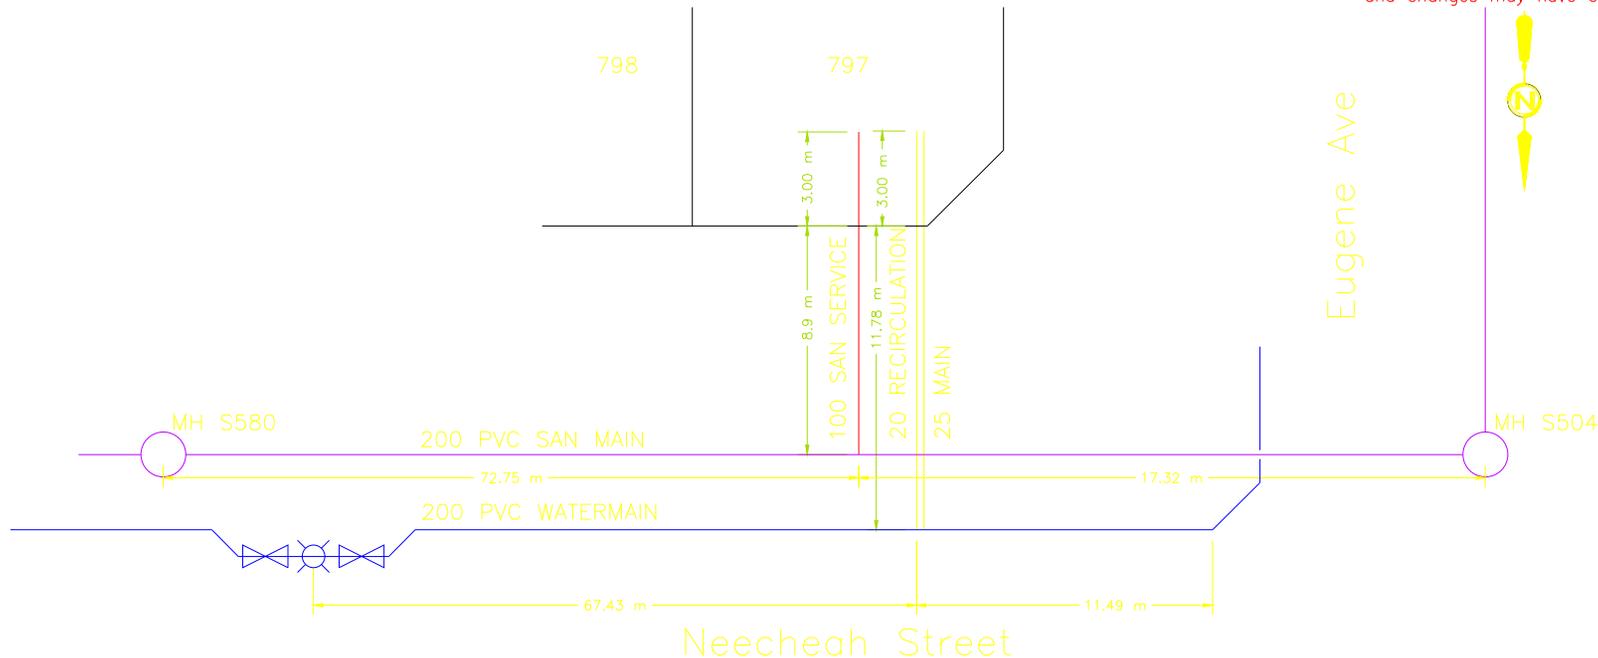



CITY OF WHITEHORSE

SERVICE CONNECTION RECORD

FIELD BOOK


No.

ADDRESS 210 Neecheah Street BLOCK LOT 798

DATES		WATER		SEWER
On at Main <u>9/17/2019</u>		Depth at P/L: <u>2.17 m</u>	<u>2.16</u> m	
On at Building <u>N/A</u>		Depth at Main: <u>3.08 m</u>	<u>2.55</u> m	
Frost Plug: <u>N/A</u>		Pipe Size: <u>25 mm / 20 mm</u>	<u>100</u> mm	
Memo:	Pipe Material: <u>HDPE</u>	Insul. <u>Yes/No</u>	<u>PVC</u>	Insul. <u>Yes/No</u>
	Length from Main to P/L: <u>11.76 m</u>		<u>8.98</u> m	
	Squirt Test: <u>Pass/Fail</u>			N/A
Booster Pump Required:	Yes/No	Frost Protection: <u>Aquaflow/Recirc/Heat Trace/Bleeder</u>		N/A
PRV Required:	Yes/No	Greased @ CC: <u>Yes/No</u>		N/A
Water Meter Installed:	Yes/No	Continuity Test: <u>N/A</u>	<u>Pass/Fail</u>	N/A

CLEARLY INDICATE LOCATION OF CC AND ROUTE OF PIPES ON DRAWING BELOW

1. Show main valves required to isolate this service. 2. All dimensions to be tied to property line 3. All dimensions to be metric 4. Depth @ property line is based on elevation after construction and changes may have occurred.

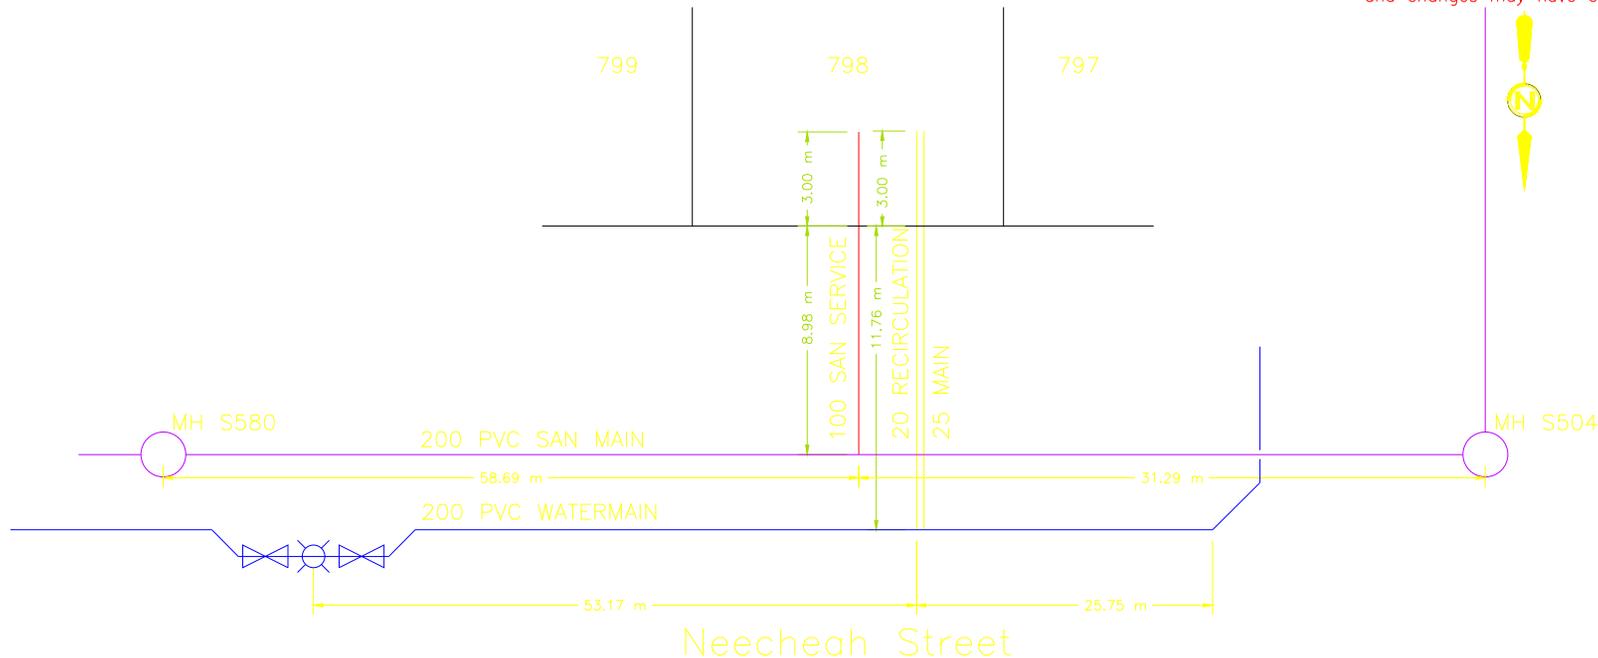



CITY OF WHITEHORSE SERVICE CONNECTION RECORD

FIELD BOOK


No. _____

ADDRESS 208 Neecheah Street BLOCK _____ LOT 799

DATES	WATER	SEWER
On at Main 9/17/2019	Depth at P/L: 2.17 m	2.15 m
On at Building N/A	Depth at Main: 3.04 m	2.55 m
Frost Plug: N/A	Pipe Size: 25 mm / 20 mm	100 mm
Memo:	Pipe Material: HDPE Insul. <u>(Yes)</u> /No	PVC Insul. <u>(Yes)</u> /No
	Length from Main to P/L: 11.85 m	8.94 m
	Squirt Test: <u>(Pass)</u> /Fail	N/A
Booster Pump Required: Yes/No	Frost Protection: Aquaflo/ <u>(Recirc)</u> /Heat Trace/Bleeder	N/A
PRV Required: Yes/No	Greased @ CC: <u>(Yes)</u> /No	N/A
Water Meter Installed: Yes/No	Continuity Test: <u>(N/A)</u> Pass/Fail	N/A

CLEARLY INDICATE LOCATION OF CC AND ROUTE OF PIPES ON DRAWING BELOW

1. Show main valves required to isolate this service. 2. All dimensions to be tied to property line 3. All dimensions to be metric 4. Depth @ property line is based on elevation after construction and changes may have occurred.

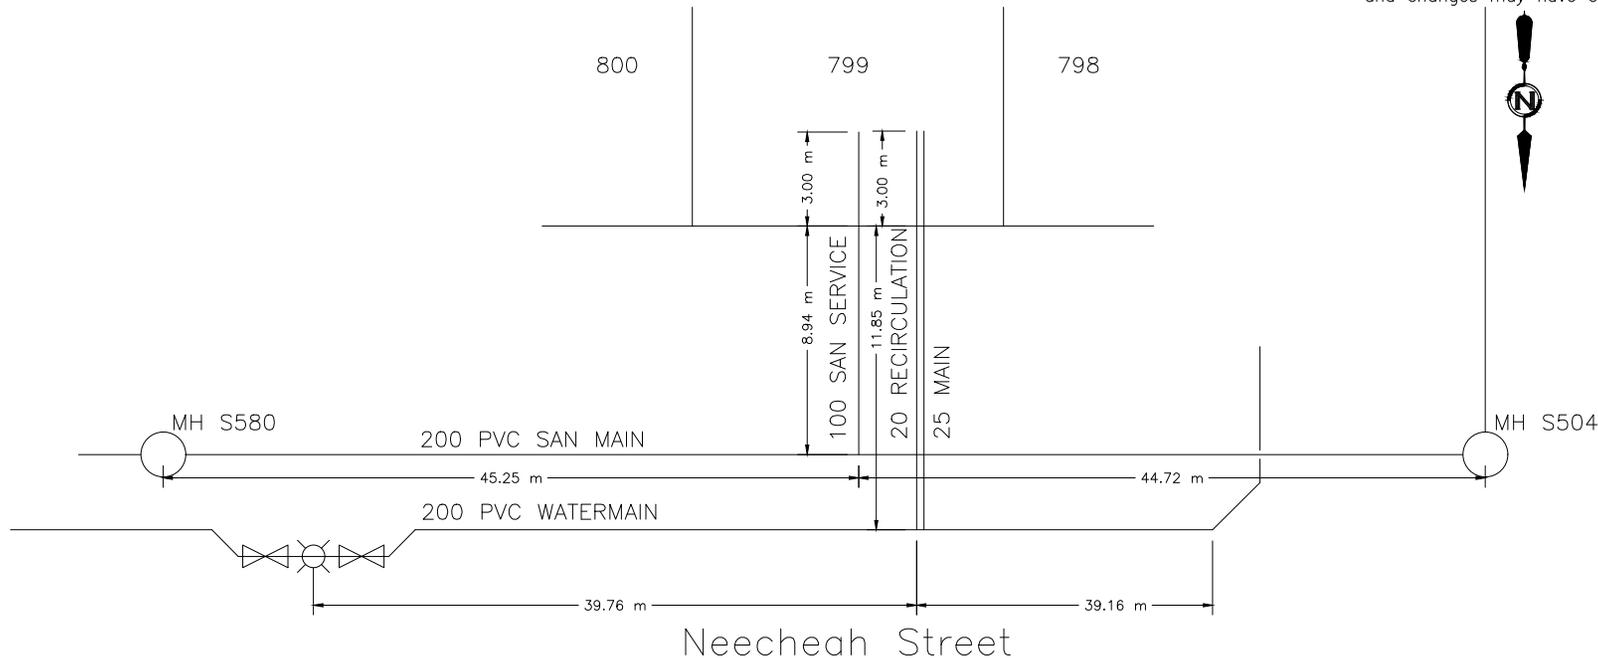



CITY OF WHITEHORSE SERVICE CONNECTION RECORD

FIELD BOOK


No.

ADDRESS 206 Neecheah Street BLOCK LOT 800

DATES		WATER		SEWER	
On at Main	9/17/2019	Depth at P/L:	2.19 m	2.19	m
On at Building	N/A	Depth at Main:	2.85 m	2.58	m
Frost Plug:	N/A	Pipe Size:	25 mm / 20 mm	100	mm
Memo:		Pipe Material:	HDPE	Insul.	(Yes/No)
		Length from Main to P/L:	11.69 m	PVC	Insul. (Yes/No)
		Squirt Test:	(Pass/Fail)		N/A
Booster Pump Required:	Yes/No	Frost Protection:	Aquaflow/Recirc/Heat Trace/Bleeder		N/A
PRV Required:	Yes/No	Greased @ CC:	(Yes/No)		N/A
Water Meter Installed:	Yes/No	Continuity Test:	(N/A) Pass/Fail		N/A

CLEARLY INDICATE LOCATION OF CC AND ROUTE OF PIPES ON DRAWING BELOW

1. Show main valves required to isolate this service.
2. All dimensions to be tied to property line
3. All dimensions to be metric
4. Depth @ property line is based on elevation after construction and changes may have occurred.

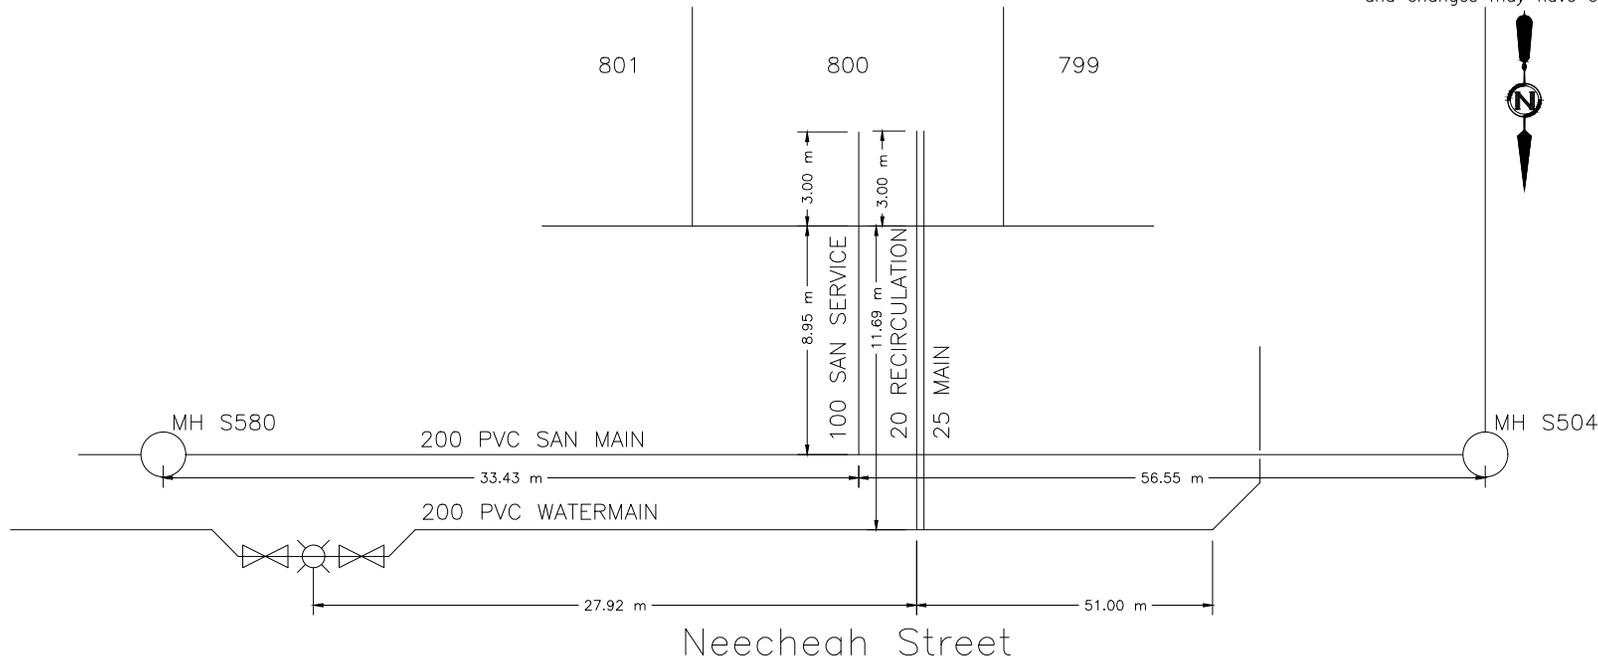



CITY OF WHITEHORSE SERVICE CONNECTION RECORD

FIELD BOOK


No.

ADDRESS 204 Neecheah Street BLOCK LOT 801

DATES		WATER		SEWER	
On at Main	9/18/2019	Depth at P/L:	2.23 m	2.23	m
On at Building	N/A	Depth at Main:	2.91 m	2.63	m
Frost Plug:	N/A	Pipe Size:	25 mm / 20 mm	100	mm
Memo:		Pipe Material:	HDPE	Insul.	(Yes/No)
		Length from Main to P/L:	11.78 m	PVC	Insul. (Yes/No)
		Squirt Test:	(Pass/Fail)		N/A
Booster Pump Required:	Yes/No	Frost Protection:	Aquaflow/Recirc/Heat Trace/Bleeder		N/A
PRV Required:	Yes/No	Greased @ CC:	(Yes/No)		N/A
Water Meter Installed:	Yes/No	Continuity Test:	(N/A) Pass/Fail		N/A

CLEARLY INDICATE LOCATION OF CC AND ROUTE OF PIPES ON DRAWING BELOW

1. Show main valves required to isolate this service.
2. All dimensions to be tied to property line
3. All dimensions to be metric
4. Depth @ property line is based on elevation after construction and changes may have occurred.

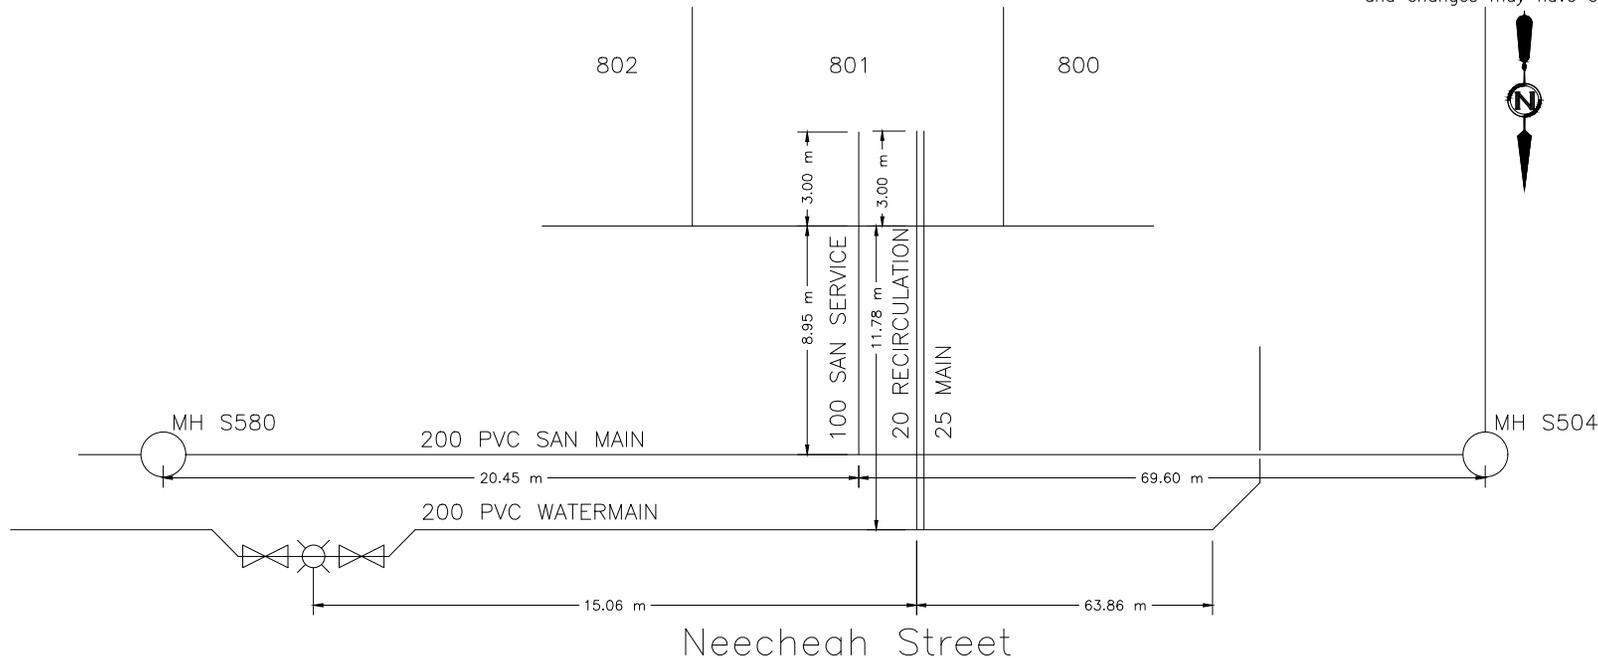



CITY OF WHITEHORSE SERVICE CONNECTION RECORD

FIELD BOOK


No.

ADDRESS 202 Neecheah Street BLOCK LOT 802

DATES		WATER		SEWER	
On at Main 9/18/2019		Depth at P/L: 2.25 m		2.23 m	
On at Building N/A		Depth at Main: 2.85 m		2.64 m	
Frost Plug: N/A		Pipe Size: 25 mm / 20 mm		100 mm	
Memo:		Pipe Material: HDPE		PVC	
		Insul. <u>(Yes/No)</u>		Insul. <u>(Yes/No)</u>	
		Length from Main to P/L: 13.1 m		8.97 m	
		Squirt Test: <u>(Pass/Fail)</u>		N/A	
Booster Pump Required: Yes/No		Frost Protection: Aquaflo/ <u>(Recirc)</u> /Heat Trace/Bleeder		N/A	
PRV Required: Yes/No		Greased @ CC: <u>(Yes/No)</u>		N/A	
Water Meter Installed: Yes/No		Continuity Test: <u>(N/A)</u>		Pass/Fail	
				N/A	

CLEARLY INDICATE LOCATION OF CC AND ROUTE OF PIPES ON DRAWING BELOW

1. Show main valves required to isolate this service.
2. All dimensions to be tied to property line
3. All dimensions to be metric
4. Depth @ property line is based on elevation after construction and changes may have occurred.

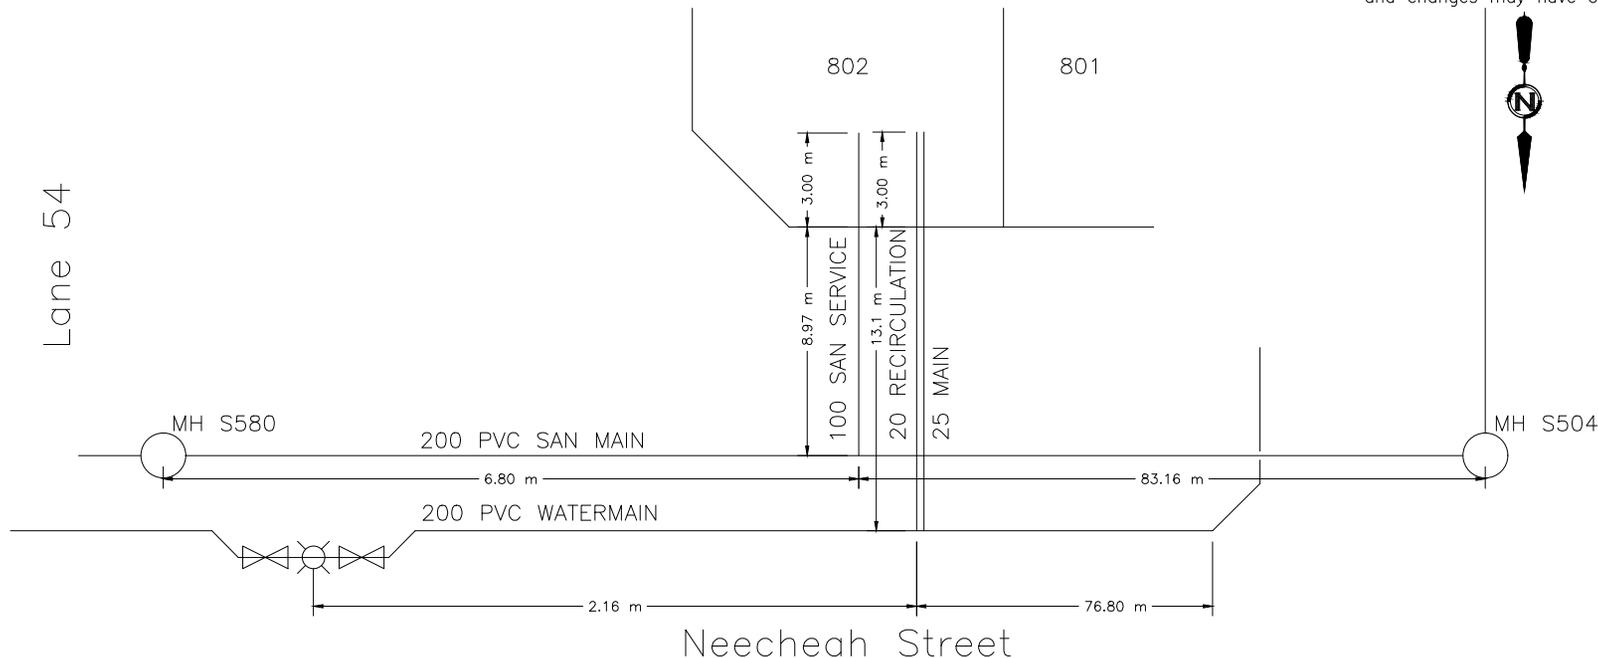



CITY OF WHITEHORSE SERVICE CONNECTION RECORD

FIELD BOOK


No.

ADDRESS 209 Sadie Lane BLOCK LOT 803

DATES	WATER	SEWER
On at Main 9/14/2019	Depth at P/L: 2.18 m	2 m
On at Building N/A	Depth at Main: 2.32 m	2.36 m
Frost Plug: N/A	Pipe Size: 25 mm / 20 mm	100 mm
Memo:	Pipe Material: HDPE Insul. (Yes/No)	PVC Insul. (Yes/No)
	Length from Main to P/L: 4.38 m	7.46 m
	Squirt Test: (Pass/Fail)	N/A
Booster Pump Required: Yes/No	Frost Protection: Aquaflow/ (Recirc) /Heat Trace/Bleeder	N/A
PRV Required: Yes/No	Greased @ CC: (Yes/No)	N/A
Water Meter Installed: Yes/No	Continuity Test: (N/A) Pass/Fail	N/A

CLEARLY INDICATE LOCATION OF CC AND ROUTE OF PIPES ON DRAWING BELOW

1. Show main valves required to isolate this service. 2. All dimensions to be tied to property line 3. All dimensions to be metric 4. Depth @ property line is based on elevation after construction and changes may have occurred.

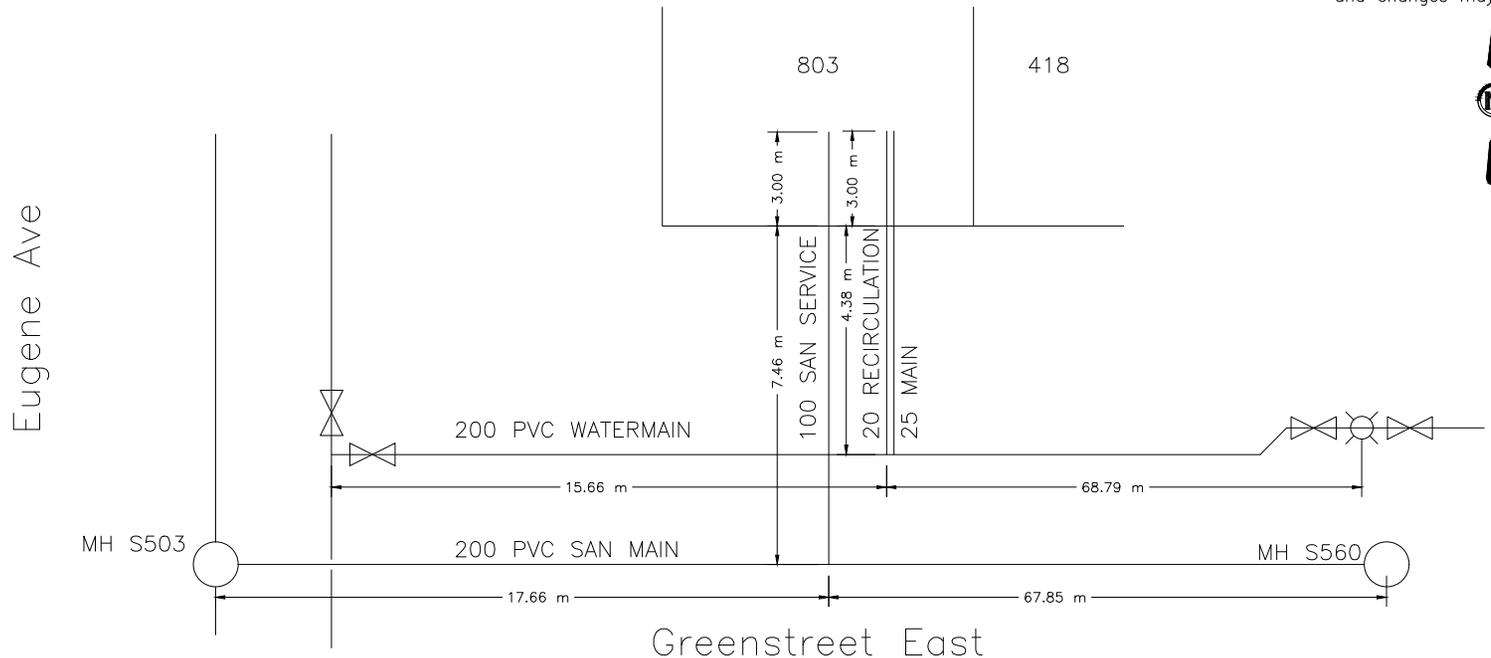



CITY OF WHITEHORSE SERVICE CONNECTION RECORD

FIELD BOOK


No.

ADDRESS 207 Sadie Lane BLOCK LOT 804

DATES	WATER	SEWER
On at Main 9/14/2019	Depth at P/L: 2.25 m	2.08 m
On at Building N/A	Depth at Main: 2.38 m	2.57 m
Frost Plug: N/A	Pipe Size: 25 mm / 20 mm	100 mm
Memo:	Pipe Material: HDPE Insul. <u>(Yes)</u> /No	PVC Insul. <u>(Yes)</u> /No
	Length from Main to P/L: 4.31 m	7.48 m
	Squirt Test: <u>(Pass)</u> /Fail	N/A
Booster Pump Required: Yes/No	Frost Protection: Aquaflo/ <u>(Recirc)</u> /Heat Trace/Bleeder	N/A
PRV Required: Yes/No	Greased @ CC: <u>(Yes)</u> /No	N/A
Water Meter Installed: Yes/No	Continuity Test: <u>(N/A)</u> Pass/Fail	N/A

CLEARLY INDICATE LOCATION OF CC AND ROUTE OF PIPES ON DRAWING BELOW

1. Show main valves required to isolate this service. 2. All dimensions to be tied to property line 3. All dimensions to be metric 4. Depth @ property line is based on elevation after construction and changes may have occurred.

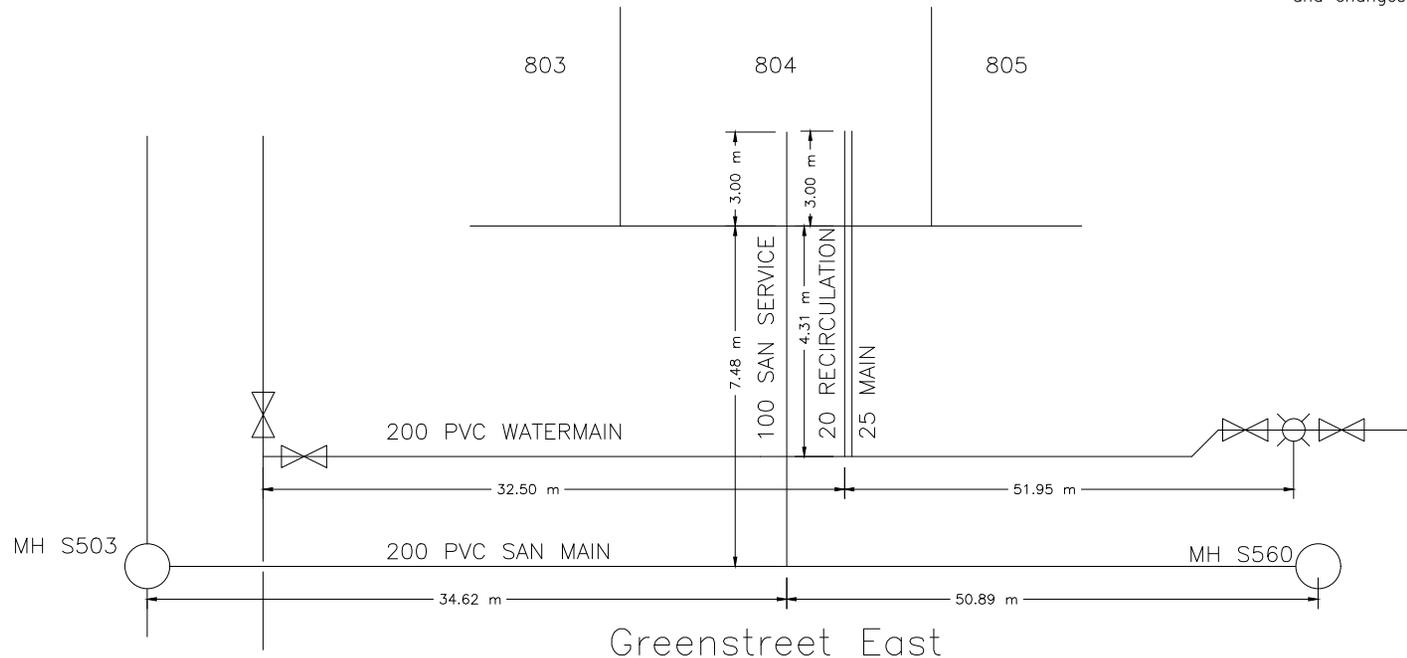



CITY OF WHITEHORSE SERVICE CONNECTION RECORD

FIELD BOOK


No.

ADDRESS 205 Sadie Lane BLOCK LOT 805

DATES		WATER		SEWER	
On at Main	9/16/2019	Depth at P/L:	2.18 m		2.13 m
On at Building	N/A	Depth at Main:	2.58 m		2.59 m
Frost Plug:	N/A	Pipe Size:	25 mm / 20 mm		100 mm
Memo:		Pipe Material:	HDPE	Insul. (Yes/No)	PVC
		Length from Main to P/L:	4.26 m		7.45 m
		Squirt Test:	(Pass)/Fail		N/A
Booster Pump Required:	Yes/No	Frost Protection:	Aquaflow/Recirc/Heat Trace/Bleeder		N/A
PRV Required:	Yes/No	Greased @ CC:	(Yes)/No		N/A
Water Meter Installed:	Yes/No	Continuity Test:	(N/A) Pass/Fail		N/A

CLEARLY INDICATE LOCATION OF CC AND ROUTE OF PIPES ON DRAWING BELOW

1. Show main valves required to isolate this service.
2. All dimensions to be tied to property line
3. All dimensions to be metric
4. Depth @ property line is based on elevation after construction and changes may have occurred.

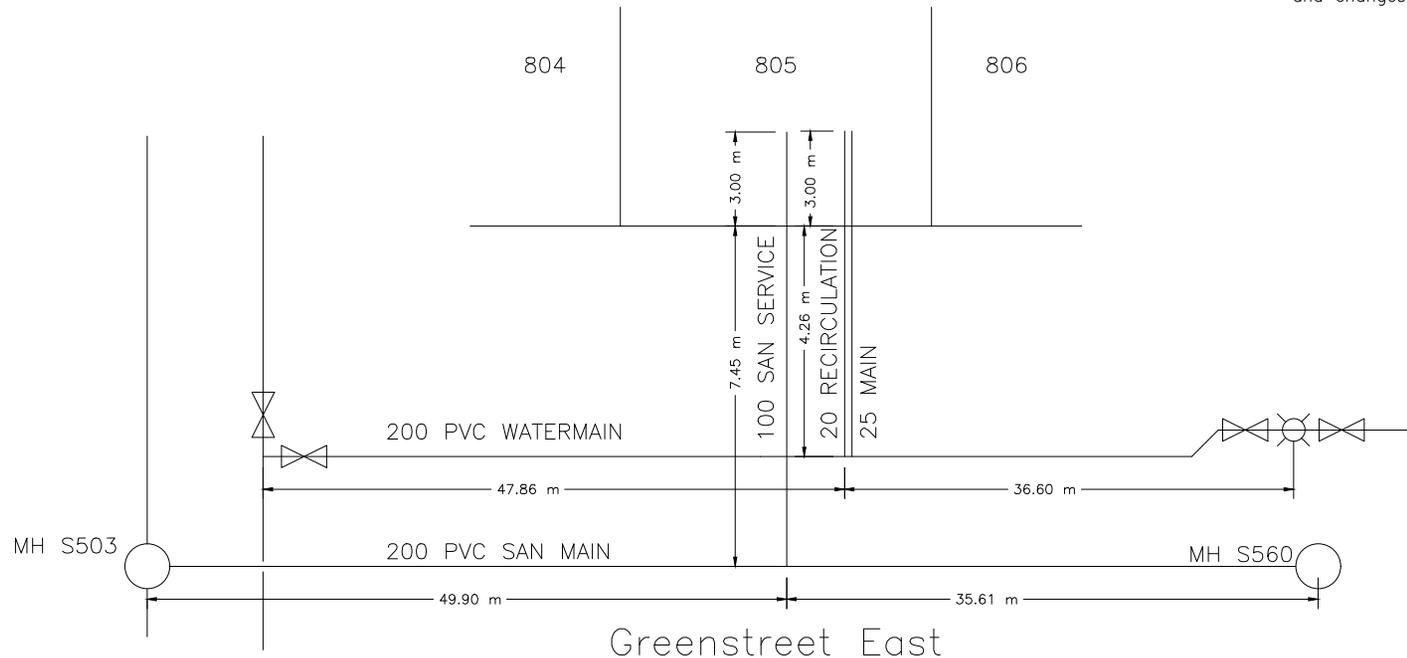



CITY OF WHITEHORSE SERVICE CONNECTION RECORD

FIELD BOOK


No.

ADDRESS 203 Sadie Lane BLOCK LOT 806

DATES	WATER	SEWER
On at Main 9/16/2019	Depth at P/L: 2.31 m	2.23 m
On at Building N/A	Depth at Main: 2.5 m	2.64 m
Frost Plug: N/A	Pipe Size: 25 mm / 20 mm	100 mm
Memo:	Pipe Material: HDPE Insul. <u>(Yes)</u> /No	PVC Insul. <u>(Yes)</u> /No
	Length from Main to P/L: 4.26 m	7.46 m
	Squirt Test: <u>(Pass)</u> /Fail	N/A
Booster Pump Required: Yes/No	Frost Protection: Aquaflo/ <u>(Recirc)</u> /Heat Trace/Bleeder	N/A
PRV Required: Yes/No	Greased @ CC: <u>(Yes)</u> /No	N/A
Water Meter Installed: Yes/No	Continuity Test: <u>(N/A)</u> Pass/Fail	N/A

CLEARLY INDICATE LOCATION OF CC AND ROUTE OF PIPES ON DRAWING BELOW

1. Show main valves required to isolate this service. 2. All dimensions to be tied to property line 3. All dimensions to be metric 4. Depth @ property line is based on elevation after construction and changes may have occurred.

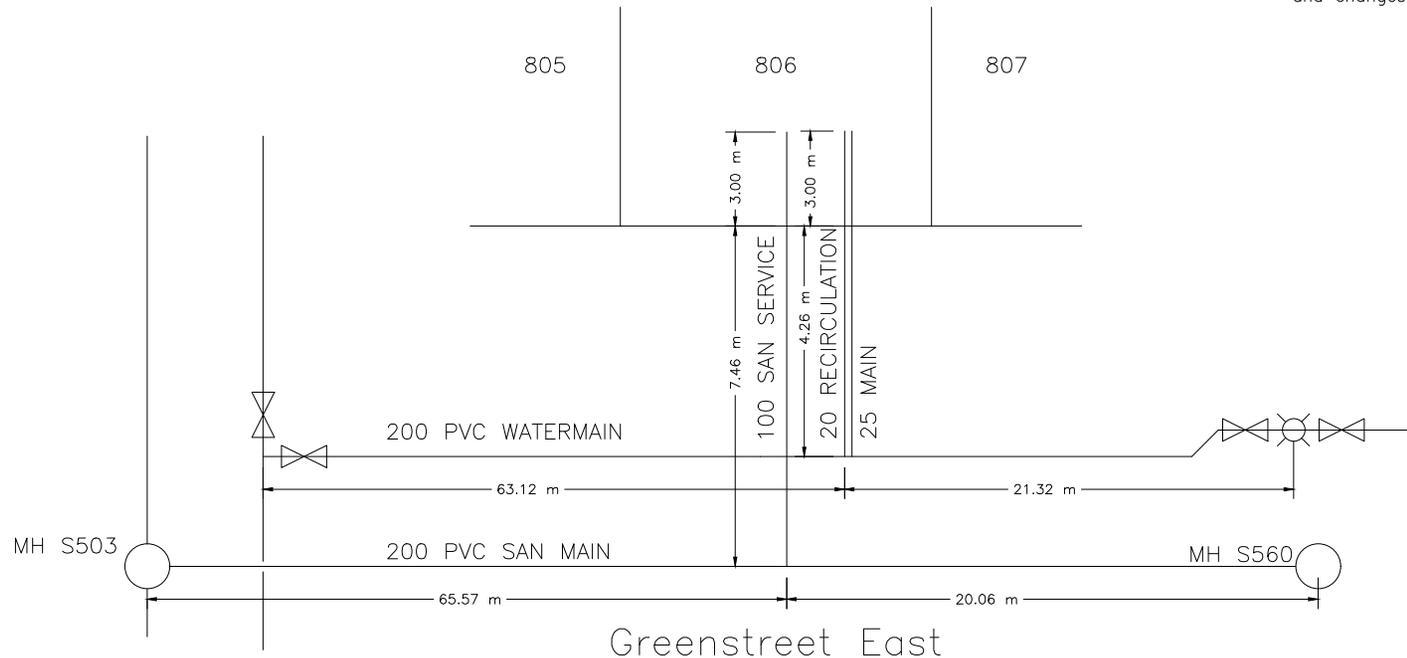



CITY OF WHITEHORSE SERVICE CONNECTION RECORD

FIELD BOOK

No.

ADDRESS 201 Sadie Lane BLOCK LOT 807

DATES	WATER	SEWER
On at Main 9/16/2019	Depth at P/L: 2.29 m	2.12 m
On at Building N/A	Depth at Main: 2.51 m	2.52 m
Frost Plug: N/A	Pipe Size: 25 mm / 20 mm	100 mm
Memo:	Pipe Material: HDPE Insul. <u>(Yes)</u> /No	PVC Insul. <u>(Yes)</u> /No
	Length from Main to P/L: 4.29 m	7.37 m
	Squirt Test: <u>(Pass)</u> /Fail	N/A
Booster Pump Required: Yes/No	Frost Protection: Aquaflo/ <u>(Recirc)</u> /Heat Trace/Bleeder	N/A
PRV Required: Yes/No	Greased @ CC: <u>(Yes)</u> /No	N/A
Water Meter Installed: Yes/No	Continuity Test: <u>(N/A)</u> Pass/Fail	N/A

CLEARLY INDICATE LOCATION OF CC AND ROUTE OF PIPES ON DRAWING BELOW

1. Show main valves required to isolate this service. 2. All dimensions to be tied to property line 3. All dimensions to be metric 4. Depth @ property line is based on elevation after construction and changes may have occurred.





CITY OF WHITEHORSE SERVICE CONNECTION RECORD

FIELD BOOK


No.

ADDRESS 210 Luella Lane BLOCK LOT 808

DATES	WATER	SEWER
On at Main 9/14/2019	Depth at P/L: 2.04 m	2.02 m
On at Building N/A	Depth at Main: 2.27 m	2.43 m
Frost Plug: N/A	Pipe Size: 25 mm / 20 mm	100 mm
Memo:	Pipe Material: HDPE Insul. <u>(Yes)</u> /No	PVC Insul. <u>(Yes)</u> /No
	Length from Main to P/L: 9.27 m	6.49 m
	Squirt Test: <u>(Pass)</u> /Fail	N/A
Booster Pump Required: Yes/No	Frost Protection: Aquaflow/ <u>(Recirc)</u> /Heat Trace/Bleeder	N/A
PRV Required: Yes/No	Greased @ CC: <u>(Yes)</u> /No	N/A
Water Meter Installed: Yes/No	Continuity Test: <u>(N/A)</u> Pass/Fail	N/A

CLEARLY INDICATE LOCATION OF CC AND ROUTE OF PIPES ON DRAWING BELOW

1. Show main valves required to isolate this service. 2. All dimensions to be tied to property line 3. All dimensions to be metric 4. Depth @ property line is based on elevation after construction and changes may have occurred.

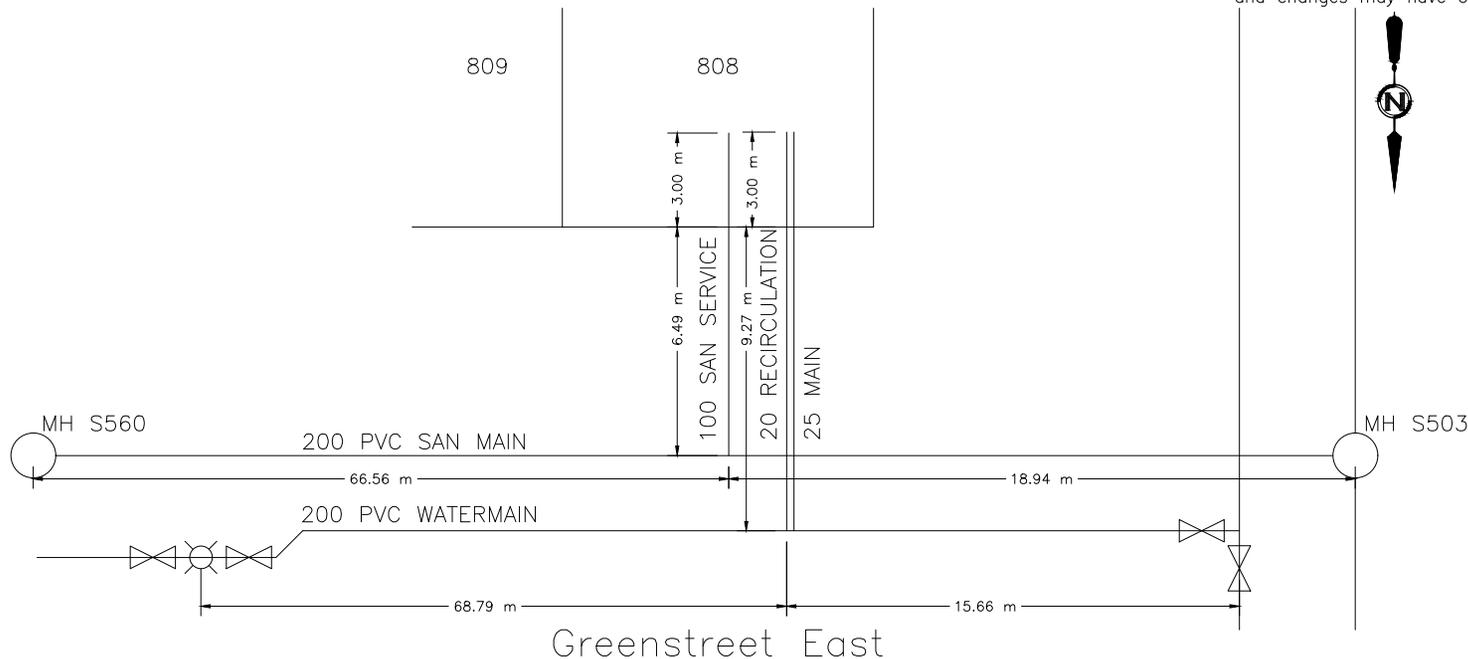



CITY OF WHITEHORSE SERVICE CONNECTION RECORD

FIELD BOOK


No.

ADDRESS 208 Luella Lane BLOCK LOT 809

DATES	WATER	SEWER
On at Main 9/14/2019	Depth at P/L: 2.24 m	2.16 m
On at Building N/A	Depth at Main: 2.39 m	2.59 m
Frost Plug: N/A	Pipe Size: 25 mm / 20 mm	100 mm
Memo:	Pipe Material: HDPE Insul. <u>(Yes)</u> /No	PVC Insul. <u>(Yes)</u> /No
	Length from Main to P/L: 9.25 m	6.48 m
	Squirt Test: <u>(Pass)</u> /Fail	N/A
Booster Pump Required: Yes/No	Frost Protection: Aquaflo/ <u>(Recirc)</u> /Heat Trace/Bleeder	N/A
PRV Required: Yes/No	Greased @ CC: <u>(Yes)</u> /No	N/A
Water Meter Installed: Yes/No	Continuity Test: <u>(N/A)</u> Pass/Fail	N/A

CLEARLY INDICATE LOCATION OF CC AND ROUTE OF PIPES ON DRAWING BELOW

1. Show main valves required to isolate this service. 2. All dimensions to be tied to property line 3. All dimensions to be metric 4. Depth @ property line is based on elevation after construction and changes may have occurred.

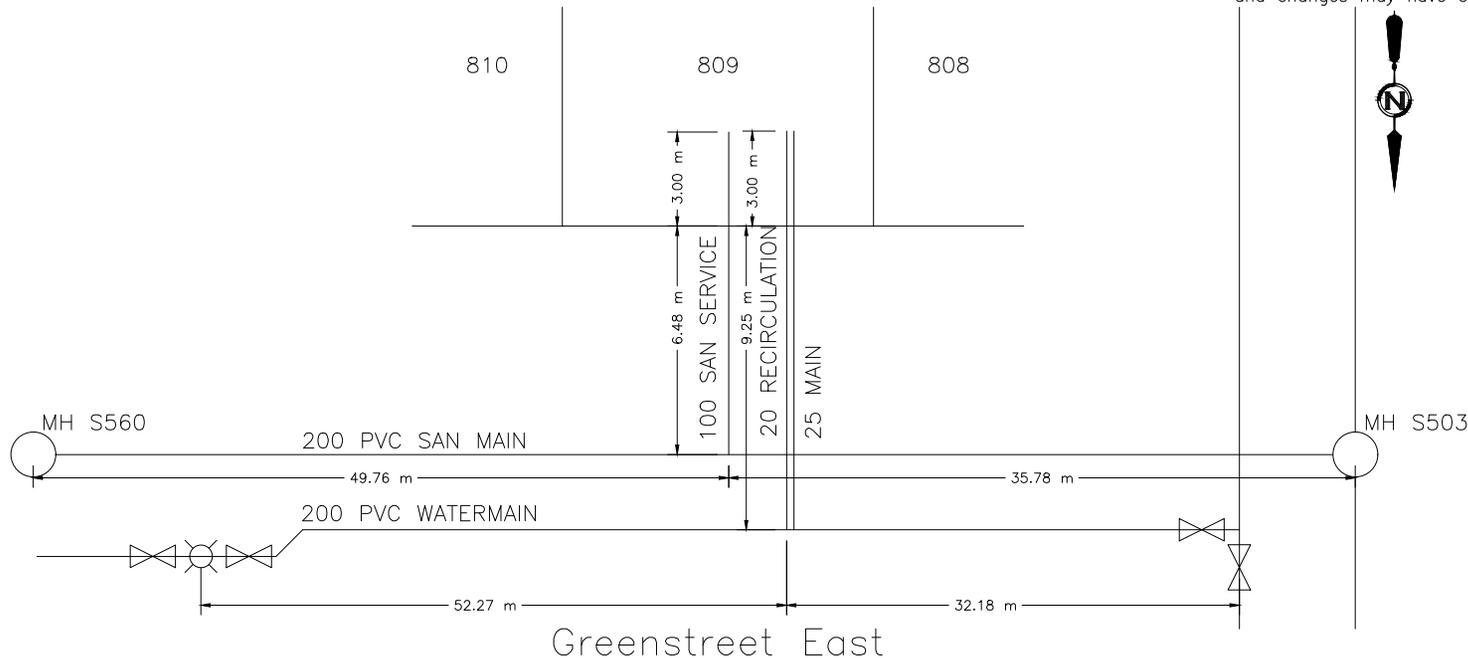



CITY OF WHITEHORSE SERVICE CONNECTION RECORD

FIELD BOOK


No.

ADDRESS 206 Luella Lane BLOCK LOT 810

DATES	WATER	SEWER
On at Main 9/16/2019	Depth at P/L: 2.2 m	2.17 m
On at Building N/A	Depth at Main: 2.47m	2.58 m
Frost Plug:N/A	Pipe Size: 25 mm / 20 mm	100 mm
Memo:	Pipe Material:HDPE Insul. <u>(Yes)</u> /No	PVC Insul. <u>(Yes)</u> /No
	Length from Main to P/L:9.28 m	6.49 m
	Squirt Test: <u>(Pass)</u> /Fail	N/A
Booster Pump Required: Yes/No	Frost Protection: Aquaflow/ <u>(Recirc)</u> /Heat Trace/Bleeder	N/A
PRV Required: Yes/No	Greased @ CC: <u>(Yes)</u> /No	N/A
Water Meter Installed: Yes/No	Continuity Test: <u>(N/A)</u> Pass/Fail	N/A

CLEARLY INDICATE LOCATION OF CC AND ROUTE OF PIPES ON DRAWING BELOW

1. Show main valves required to isolate this service. 2. All dimensions to be tied to property line 3. All dimensions to be metric 4. Depth @ property line is based on elevation after construction and changes may have occurred.

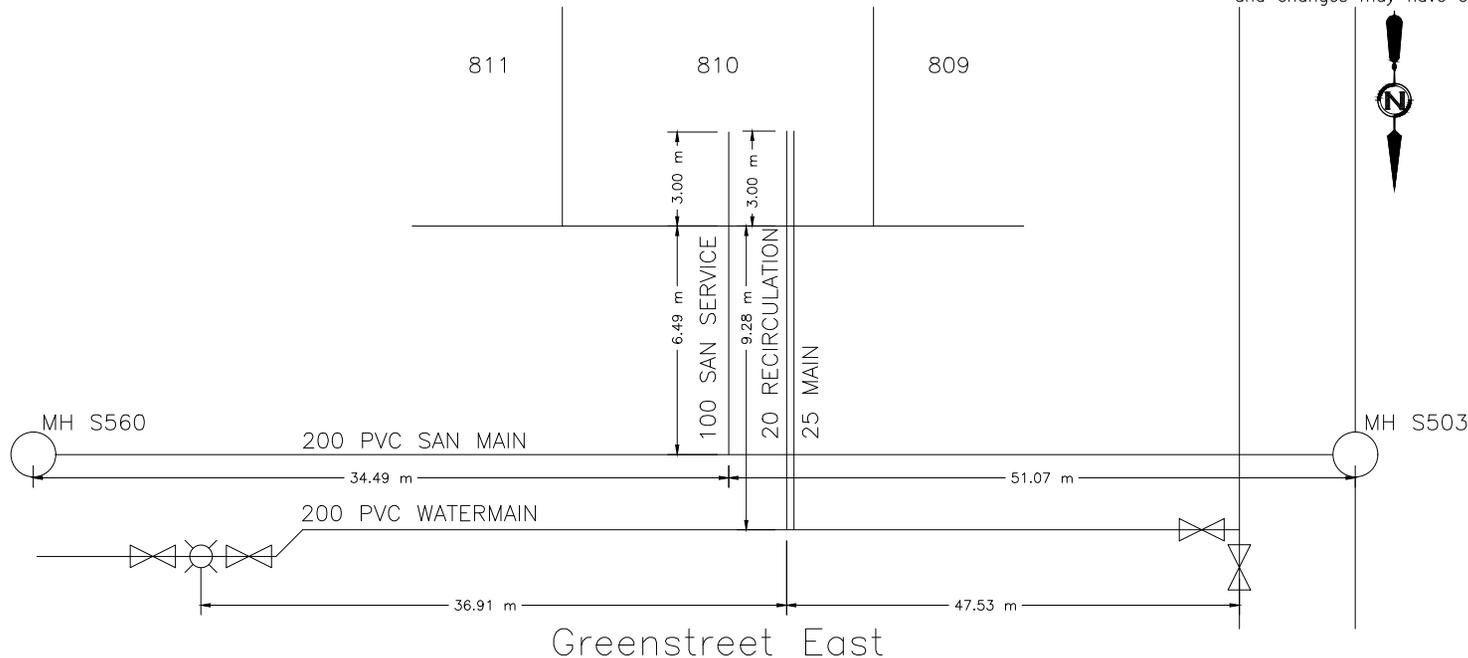



CITY OF WHITEHORSE SERVICE CONNECTION RECORD

FIELD BOOK


No.

ADDRESS 204 Luella Lane BLOCK LOT 811

DATES	WATER	SEWER
On at Main 9/16/2019	Depth at P/L: 2.23m	2.21 m
On at Building N/A	Depth at Main: 2.47m	2.57 m
Frost Plug:N/A	Pipe Size: 25 mm / 20 mm	100 mm
Memo:	Pipe Material:HDPE Insul. <u>(Yes)</u> /No	PVC Insul. <u>(Yes)</u> /No
	Length from Main to P/L:9.29 m	6.44 m
	Squirt Test: <u>(Pass)</u> /Fail	N/A
Booster Pump Required: Yes/No	Frost Protection: Aquaflow/ <u>(Recirc)</u> /Heat Trace/Bleeder	N/A
PRV Required: Yes/No	Greased @ CC: <u>(Yes)</u> /No	N/A
Water Meter Installed: Yes/No	Continuity Test: <u>(N/A)</u> Pass/Fail	N/A

CLEARLY INDICATE LOCATION OF CC AND ROUTE OF PIPES ON DRAWING BELOW

1. Show main valves required to isolate this service. 2. All dimensions to be tied to property line 3. All dimensions to be metric 4. Depth @ property line is based on elevation after construction and changes may have occurred.

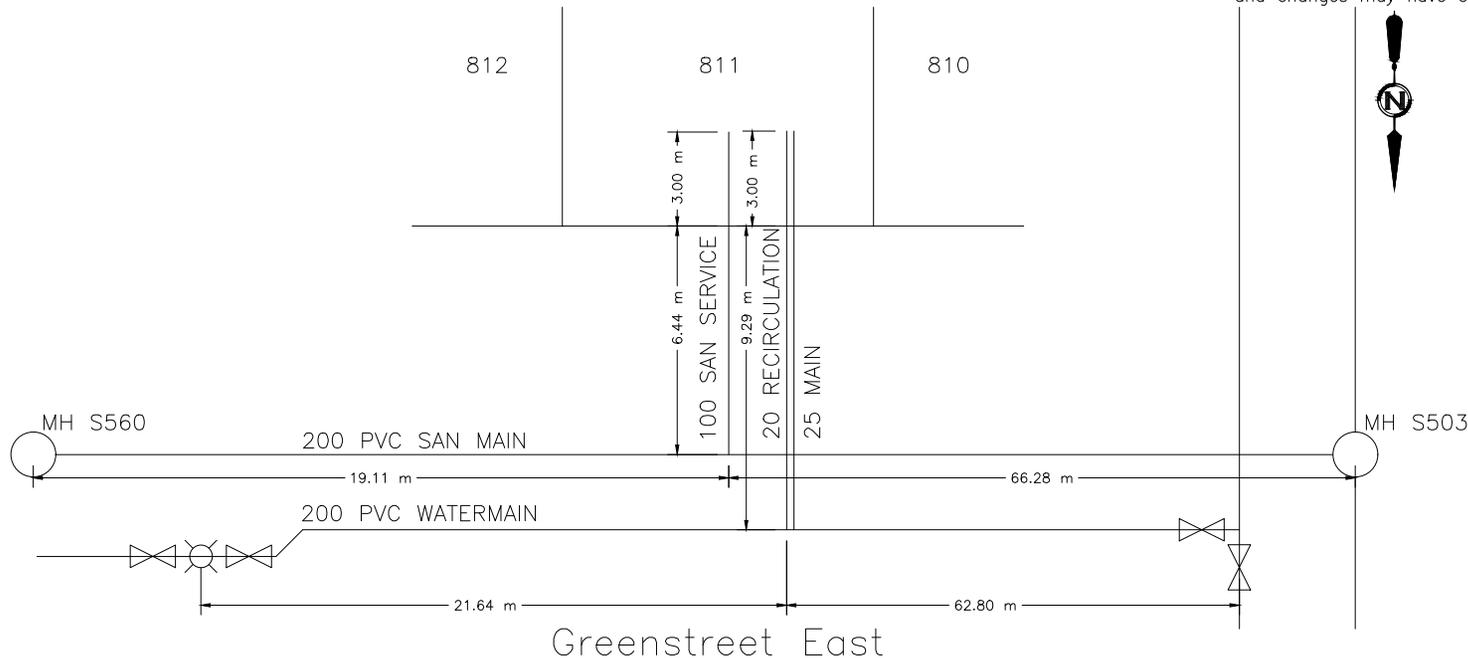



CITY OF WHITEHORSE SERVICE CONNECTION RECORD

FIELD BOOK


No.

ADDRESS 202 Luella Lane BLOCK LOT 812

DATES	WATER	SEWER
On at Main 9/16/2019	Depth at P/L: 2.26 m	2.23 m
On at Building N/A	Depth at Main: 2.48 m	2.6 m
Frost Plug: N/A	Pipe Size: 25 mm / 20 mm	100 mm
Memo:	Pipe Material: HDPE Insul. <u>(Yes)</u> /No	PVC Insul. <u>(Yes)</u> /No
	Length from Main to P/L: 9.25 m	6.4 m
	Squirt Test: <u>(Pass)</u> /Fail	N/A
Booster Pump Required: Yes/No	Frost Protection: Aquaflo/ <u>(Recirc)</u> /Heat Trace/Bleeder	N/A
PRV Required: Yes/No	Greased @ CC: <u>(Yes)</u> /No	N/A
Water Meter Installed: Yes/No	Continuity Test: <u>(N/A)</u> Pass/Fail	N/A

CLEARLY INDICATE LOCATION OF CC AND ROUTE OF PIPES ON DRAWING BELOW

1. Show main valves required to isolate this service. 2. All dimensions to be tied to property line 3. All dimensions to be metric 4. Depth @ property line is based on elevation after construction and changes may have occurred.

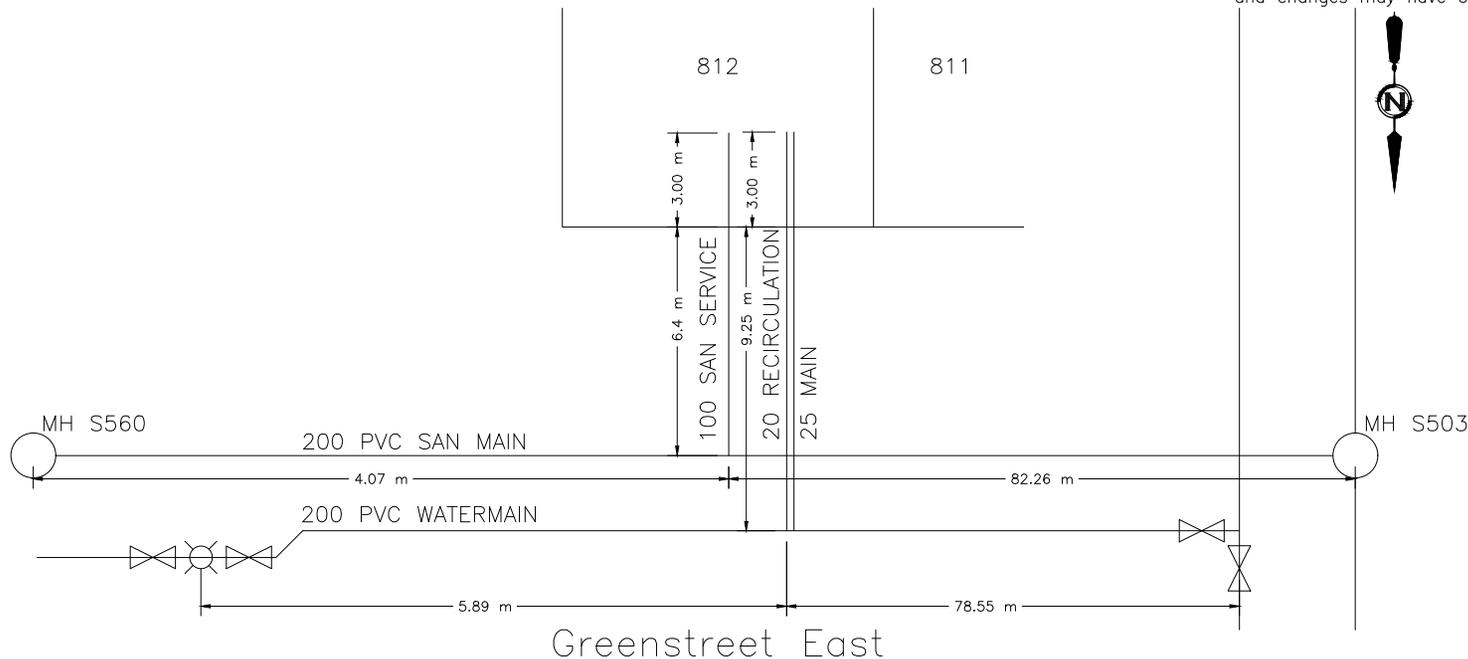



CITY OF WHITEHORSE SERVICE CONNECTION RECORD

FIELD BOOK


No.

ADDRESS 103 Witch Hazel Drive BLOCK LOT 813

DATES		WATER		SEWER
On at Main	7/27/2019	Depth at P/L:	2.32 m	2.05 m
On at Building	N/A	Depth at Main:	2.98 m	2.49 m
Frost Plug:	N/A	Pipe Size:	25 mm / 20 mm	100 mm
Memo:		Pipe Material:	HDPE Insul. <u>(Yes)</u> /No	PVC Insul. <u>(Yes)</u> /No
		Length from Main to P/L:	2.54 m	10.3 m
		Squirt Test:	<u>(Pass)</u> /Fail	N/A
Booster Pump Required:	Yes/No	Frost Protection:	Aquaflow/ <u>(Recirc)</u> /Heat Trace/Bleeder	N/A
PRV Required:	Yes/No	Greased @ CC:	<u>(Yes)</u> /No	N/A
Water Meter Installed:	Yes/No	Continuity Test:	<u>(N/A)</u> Pass/Fail	N/A

CLEARLY INDICATE LOCATION OF CC AND ROUTE OF PIPES ON DRAWING BELOW

- Show main valves required to isolate this service.
- All dimensions to be tied to property line
- All dimensions to be metric
- Depth @ property line is based on elevation after construction and changes may have occurred.

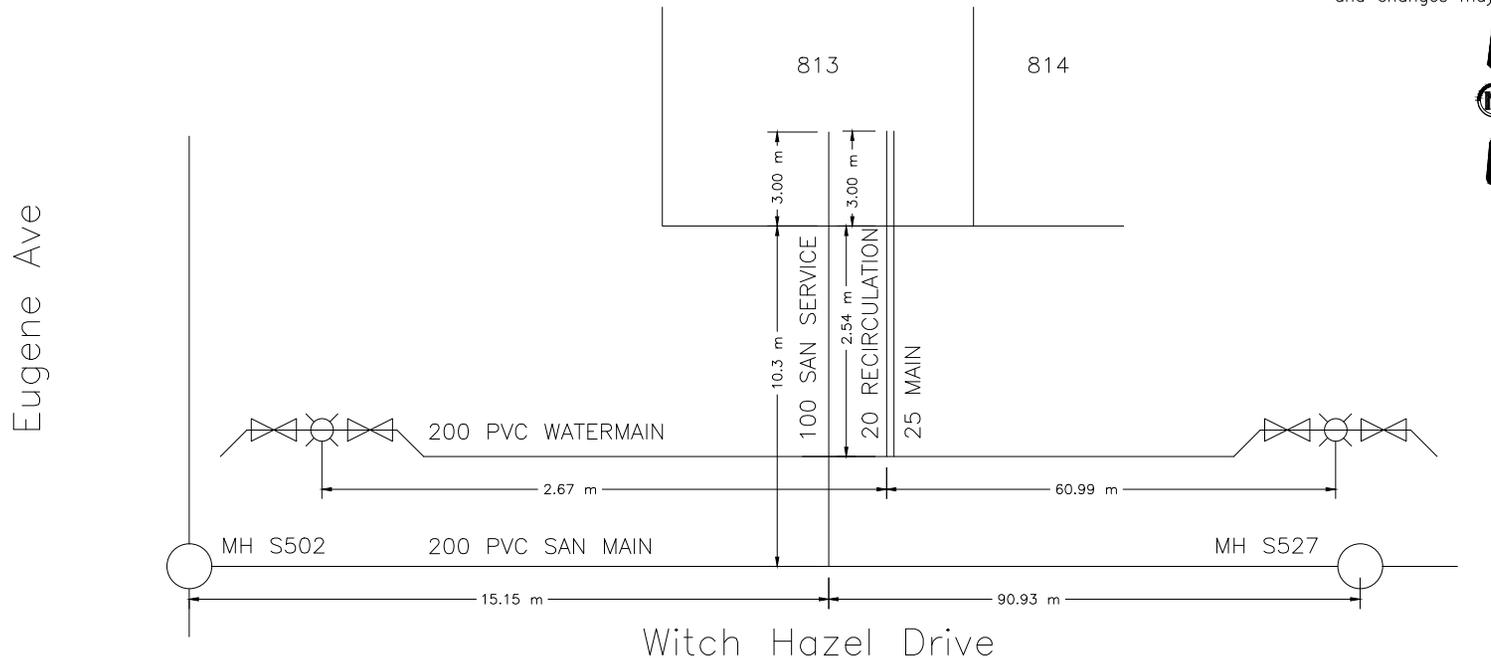



CITY OF WHITEHORSE SERVICE CONNECTION RECORD

FIELD BOOK


No.

ADDRESS 101 Witch Hazel Drive BLOCK LOT 814

DATES		WATER		SEWER
On at Main	7/24/2019	Depth at P/L:	2.11 m	1.99 m
On at Building	N/A	Depth at Main:	3.16 m	2.61 m
Frost Plug:	N/A	Pipe Size:	25 mm / 20 mm	100 mm
Memo:		Pipe Material:	HDPE Insul. <u>(Yes)</u> /No	PVC Insul. <u>(Yes)</u> /No
		Length from Main to P/L:	7 m	10.29 m
		Squirt Test:	<u>(Pass)</u> /Fail	N/A
Booster Pump Required:	Yes/No	Frost Protection:	Aquaflow/ <u>(Recirc)</u> /Heat Trace/Bleeder	N/A
PRV Required:	Yes/No	Greased @ CC:	<u>(Yes)</u> /No	N/A
Water Meter Installed:	Yes/No	Continuity Test:	<u>(N/A)</u> Pass/Fail	N/A

CLEARLY INDICATE LOCATION OF CC AND ROUTE OF PIPES ON DRAWING BELOW

- Show main valves required to isolate this service.
- All dimensions to be tied to property line
- All dimensions to be metric
- Depth @ property line is based on elevation after construction and changes may have occurred.

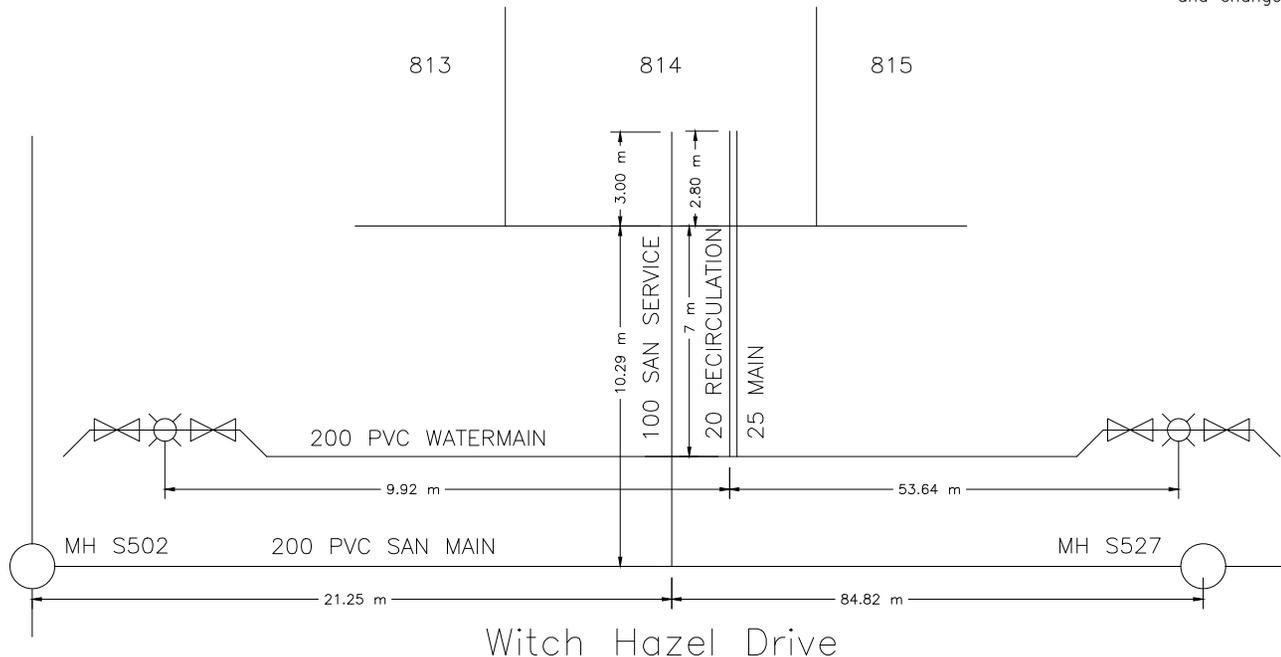



CITY OF WHITEHORSE SERVICE CONNECTION RECORD

FIELD BOOK


No.

ADDRESS 99 Witch Hazel Drive BLOCK LOT 815

DATES		WATER		SEWER
On at Main	7/30/2019	Depth at P/L:	2.32 m	2.11 m
On at Building	N/A	Depth at Main:	3.18 m	2.7 m
Frost Plug:	N/A	Pipe Size:	25 mm / 20 mm	100 mm
Memo:		Pipe Material:	HDPE	PVC
		Insul.:	(Yes)/No	Insul. (Yes)/No
		Length from Main to P/L:	7.01 m	10.33 m
		Squirt Test:	(Pass)/Fail	N/A
Booster Pump Required:	Yes/No	Frost Protection:	Aquaflow/(Recirc)/Heat Trace/Bleeder	N/A
PRV Required:	Yes/No	Greased @ CC:	(Yes)/No	N/A
Water Meter Installed:	Yes/No	Continuity Test:	(N/A) Pass/Fail	N/A

CLEARLY INDICATE LOCATION OF CC AND ROUTE OF PIPES ON DRAWING BELOW

1. Show main valves required to isolate this service. 2. All dimensions to be tied to property line 3. All dimensions to be metric 4. Depth @ property line is based on elevation after construction and changes may have occurred.

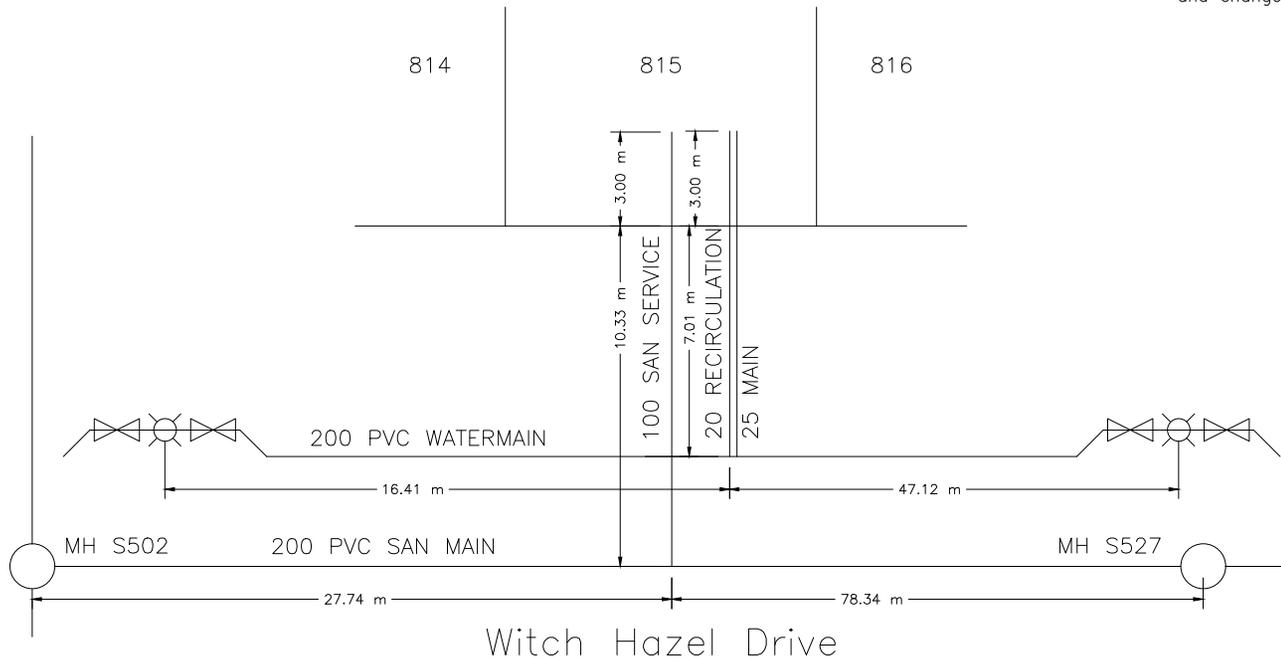



CITY OF WHITEHORSE SERVICE CONNECTION RECORD

FIELD BOOK


No.

ADDRESS 97 Witch Hazel Drive BLOCK LOT 816

DATES	WATER	SEWER
On at Main 7/27/2019	Depth at P/L: 2.37 m	2.43 m
On at Building N/A	Depth at Main: 3.17 m	2.74 m
Frost Plug: N/A	Pipe Size: 25 mm / 20 mm	100 mm
Memo:	Pipe Material: HDPE Insul. <u>(Yes)</u> /No	PVC Insul. Yes/ <u>(No)</u>
	Length from Main to P/L: 7.01 m	10.26 m
	Squirt Test: <u>(Pass)</u> /Fail	N/A
Booster Pump Required: Yes/No	Frost Protection: Aquaflo/ <u>(Recirc)</u> /Heat Trace/Bleeder	N/A
PRV Required: Yes/No	Greased @ CC: <u>(Yes)</u> /No	N/A
Water Meter Installed: Yes/No	Continuity Test: <u>(N/A)</u> Pass/Fail	N/A

CLEARLY INDICATE LOCATION OF CC AND ROUTE OF PIPES ON DRAWING BELOW

1. Show main valves required to isolate this service. 2. All dimensions to be tied to property line 3. All dimensions to be metric 4. Depth @ property line is based on elevation after construction and changes may have occurred.

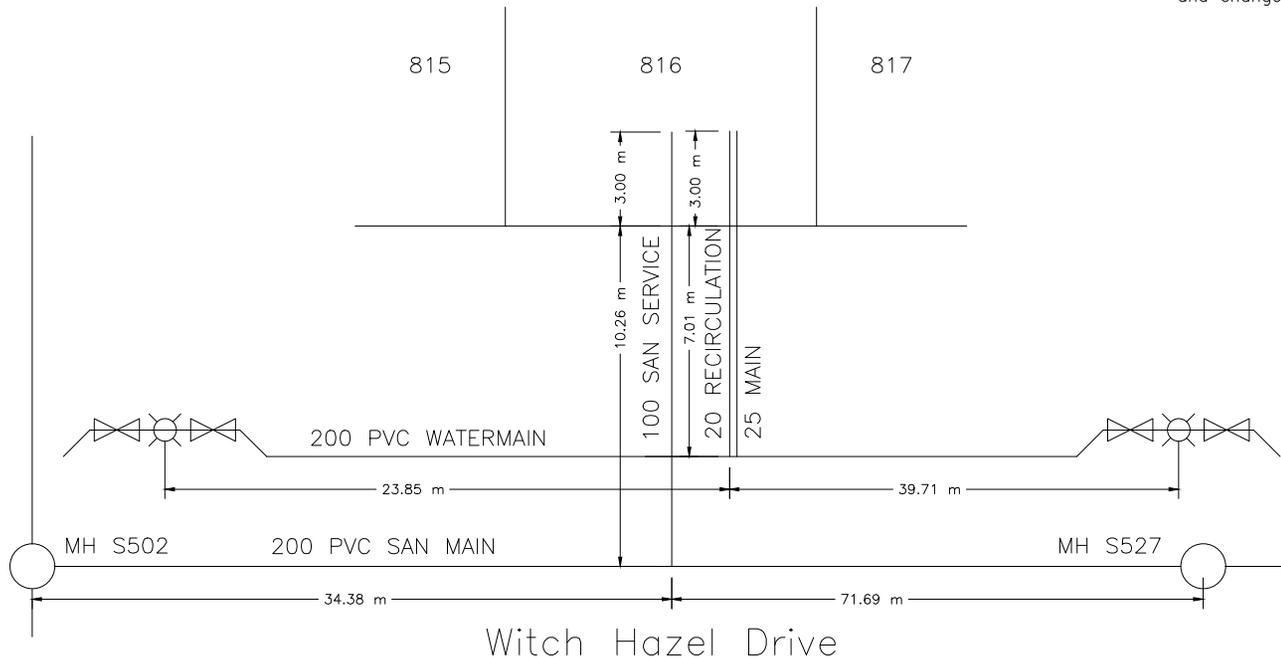



CITY OF WHITEHORSE SERVICE CONNECTION RECORD

FIELD BOOK


No.

ADDRESS 95 Witch Hazel Drive BLOCK LOT 817

DATES	WATER	SEWER
On at Main 7/25/2019	Depth at P/L: 2.21 m	2.23 m
On at Building N/A	Depth at Main: 3.12 m	2.65 m
Frost Plug: N/A	Pipe Size: 25 mm / 20 mm	100 mm
Memo:	Pipe Material: HDPE Insul. <u>(Yes)</u> /No	PVC Insul. Yes/ <u>(No)</u>
	Length from Main to P/L: 6.82 m	10.17 m
	Squirt Test: <u>(Pass)</u> /Fail	N/A
Booster Pump Required: Yes/No	Frost Protection: Aquaflo/ <u>(Recirc)</u> /Heat Trace/Bleeder	N/A
PRV Required: Yes/No	Greased @ CC: <u>(Yes)</u> /No	N/A
Water Meter Installed: Yes/No	Continuity Test: <u>(N/A)</u> Pass/Fail	N/A

CLEARLY INDICATE LOCATION OF CC AND ROUTE OF PIPES ON DRAWING BELOW

1. Show main valves required to isolate this service. 2. All dimensions to be tied to property line 3. All dimensions to be metric 4. Depth @ property line is based on elevation after construction and changes may have occurred.

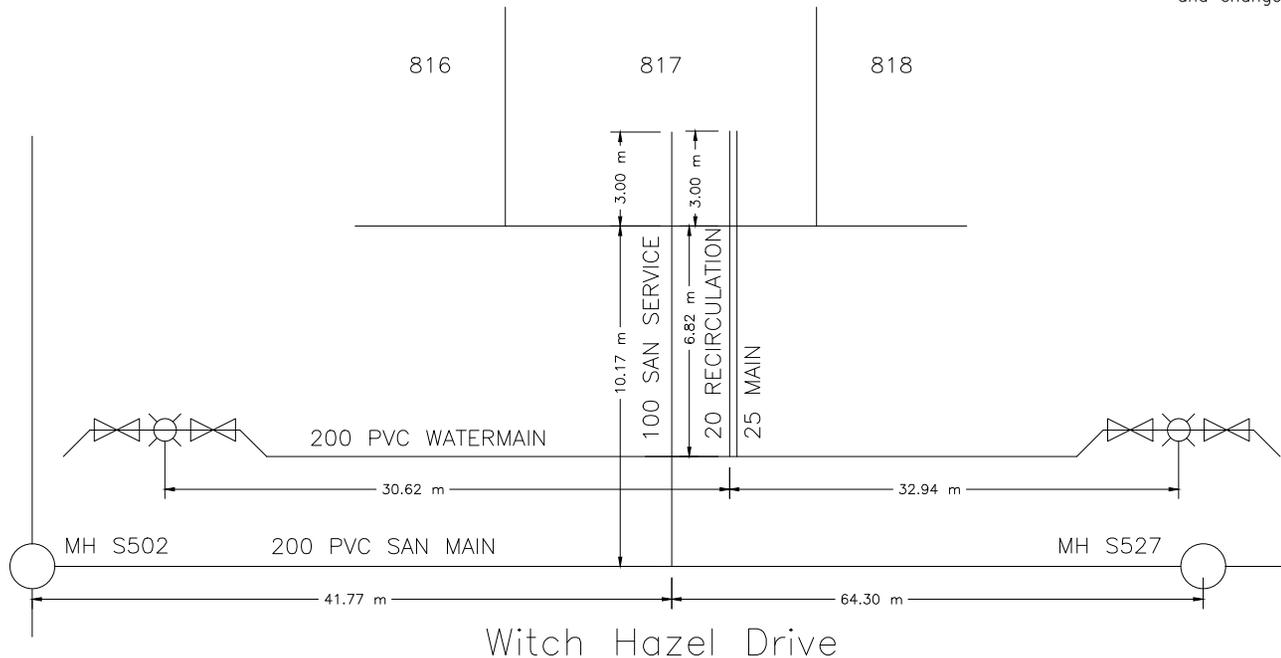



CITY OF WHITEHORSE SERVICE CONNECTION RECORD

FIELD BOOK


No.

ADDRESS 93 Witch Hazel Drive BLOCK LOT 818

DATES	WATER	SEWER
On at Main 7/30/2019	Depth at P/L: 2.42 m	2.33 m
On at Building N/A	Depth at Main: 3.11 m	2.78 m
Frost Plug: N/A	Pipe Size: 25 mm / 20 mm	100 mm
Memo:	Pipe Material: HDPE Insul. <u>(Yes)</u> /No	PVC Insul. Yes/ <u>(No)</u>
	Length from Main to P/L: 7.02 m	10.38 m
	Squirt Test: <u>(Pass)</u> /Fail	N/A
Booster Pump Required: Yes/No	Frost Protection: Aquaflow/ <u>(Recirc)</u> /Heat Trace/Bleeder	N/A
PRV Required: Yes/No	Greased @ CC: <u>(Yes)</u> /No	N/A
Water Meter Installed: Yes/No	Continuity Test: <u>(N/A)</u> Pass/Fail	N/A

CLEARLY INDICATE LOCATION OF CC AND ROUTE OF PIPES ON DRAWING BELOW

1. Show main valves required to isolate this service. 2. All dimensions to be tied to property line 3. All dimensions to be metric 4. Depth @ property line is based on elevation after construction and changes may have occurred.

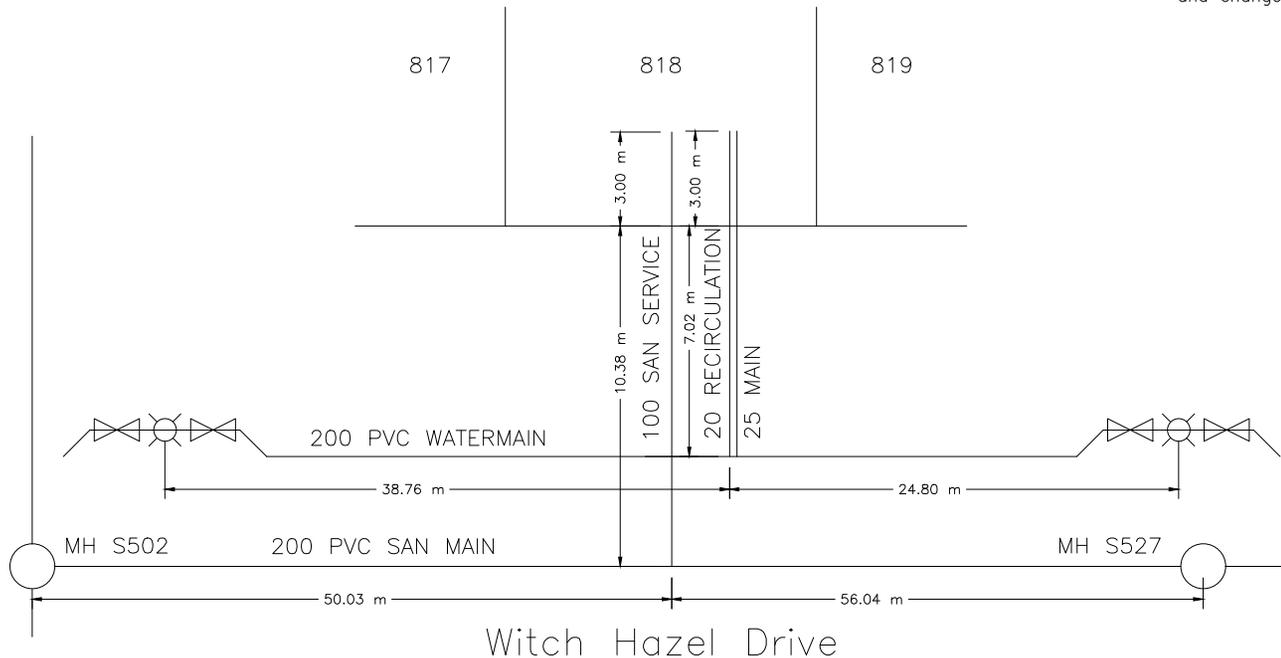



CITY OF WHITEHORSE SERVICE CONNECTION RECORD

FIELD BOOK


No.

ADDRESS 91 Witch Hazel Drive BLOCK LOT 819

DATES		WATER		SEWER
On at Main	7/27/2019	Depth at P/L:	2.5 m	2.32 m
On at Building	N/A	Depth at Main:	3.07m	2.84 m
Frost Plug:	N/A	Pipe Size:	25 mm / 20 mm	100 mm
Memo:		Pipe Material:	HDPE Insul. <u>(Yes)</u> /No	PVC Insul. Yes/ <u>(No)</u>
		Length from Main to P/L:	6.98 m	10.35 m
		Squirt Test:	<u>(Pass)</u> /Fail	N/A
Booster Pump Required:	Yes/No	Frost Protection:	Aquaflow/ <u>(Recirc)</u> /Heat Trace/Bleeder	N/A
PRV Required:	Yes/No	Greased @ CC:	<u>(Yes)</u> /No	N/A
Water Meter Installed:	Yes/No	Continuity Test:	<u>(N/A)</u> Pass/Fail	N/A

CLEARLY INDICATE LOCATION OF CC AND ROUTE OF PIPES ON DRAWING BELOW

- Show main valves required to isolate this service.
- All dimensions to be tied to property line
- All dimensions to be metric
- Depth @ property line is based on elevation after construction and changes may have occurred.

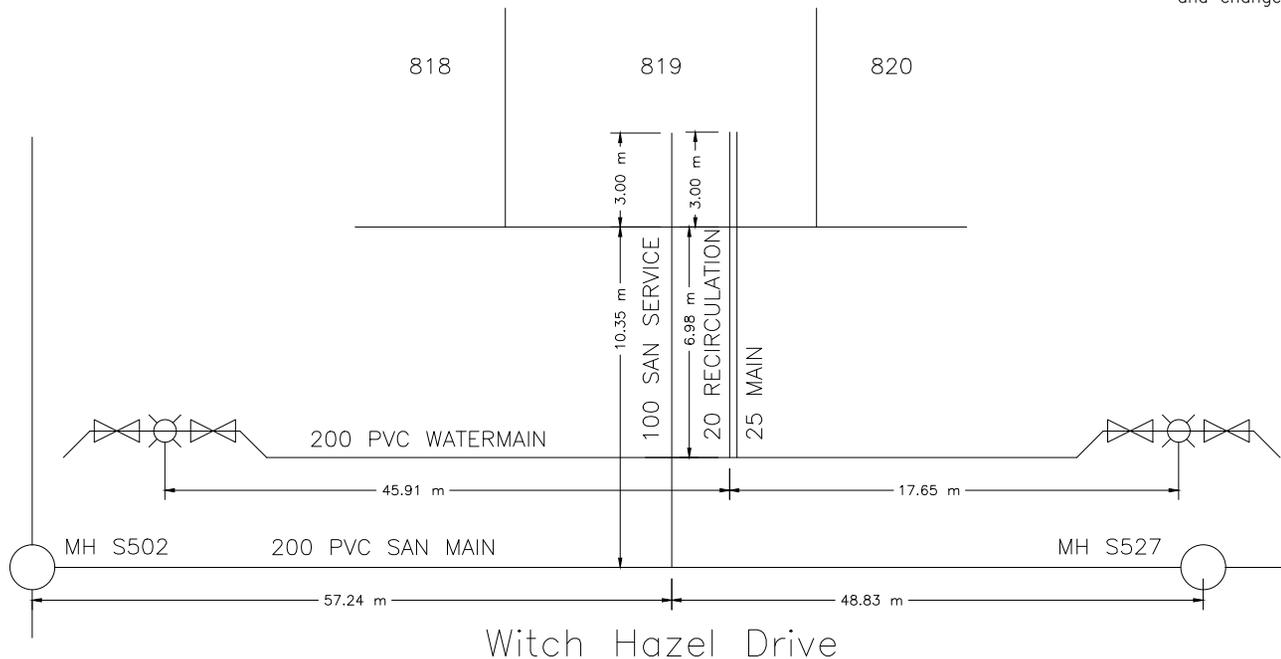



CITY OF WHITEHORSE SERVICE CONNECTION RECORD

FIELD BOOK


No.

ADDRESS 89 Witch Hazel Drive BLOCK LOT 820

DATES	WATER	SEWER
On at Main 7/25/2019	Depth at P/L: 2.27 m	2.29 m
On at Building N/A	Depth at Main: 2.99 m	2.78 m
Frost Plug: N/A	Pipe Size: 25 mm / 20 mm	100 mm
Memo:	Pipe Material: HDPE Insul. <u>(Yes)</u> /No	PVC Insul. Yes/ <u>(No)</u>
	Length from Main to P/L: 6.9 m	9.97 m
	Squirt Test: <u>(Pass)</u> /Fail	N/A
Booster Pump Required: Yes/No	Frost Protection: Aquaflow/ <u>(Recirc)</u> /Heat Trace/Bleeder	N/A
PRV Required: Yes/No	Greased @ CC: <u>(Yes)</u> /No	N/A
Water Meter Installed: Yes/No	Continuity Test: <u>(N/A)</u> Pass/Fail	N/A

CLEARLY INDICATE LOCATION OF CC AND ROUTE OF PIPES ON DRAWING BELOW

1. Show main valves required to isolate this service. 2. All dimensions to be tied to property line 3. All dimensions to be metric 4. Depth @ property line is based on elevation after construction and changes may have occurred.

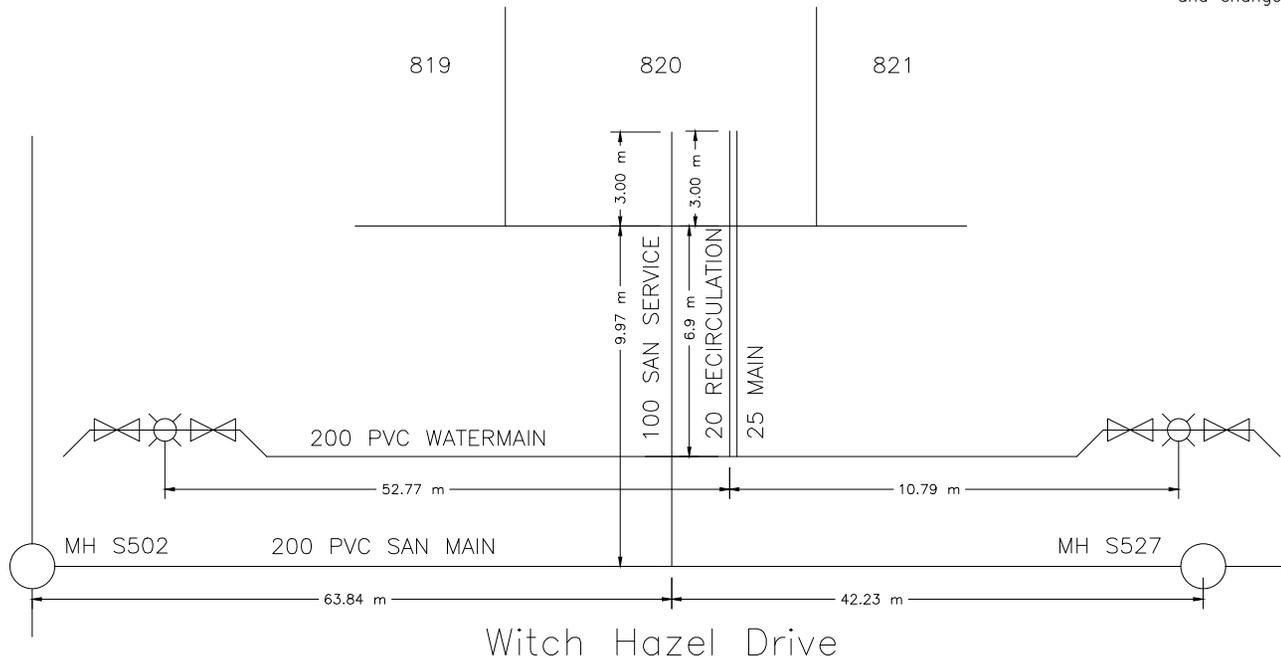



CITY OF WHITEHORSE SERVICE CONNECTION RECORD

FIELD BOOK


No.

ADDRESS 87 Witch Hazel Drive BLOCK LOT 821

DATES	WATER	SEWER
On at Main 7/30/2019	Depth at P/L: 2.49 m	2.38 m
On at Building N/A	Depth at Main: 2.94 m	2.77 m
Frost Plug: N/A	Pipe Size: 25 mm / 20 mm	100 mm
Memo:	Pipe Material: HDPE Insul. <u>(Yes)</u> /No	PVC Insul. Yes/ <u>(No)</u>
	Length from Main to P/L: 5.94 m	10.31 m
	Squirt Test: <u>(Pass)</u> /Fail	N/A
Booster Pump Required: Yes/No	Frost Protection: Aquaflow/ <u>(Recirc)</u> /Heat Trace/Bleeder	N/A
PRV Required: Yes/No	Greased @ CC: <u>(Yes)</u> /No	N/A
Water Meter Installed: Yes/No	Continuity Test: <u>(N/A)</u> Pass/Fail	N/A

CLEARLY INDICATE LOCATION OF CC AND ROUTE OF PIPES ON DRAWING BELOW

1. Show main valves required to isolate this service. 2. All dimensions to be tied to property line 3. All dimensions to be metric 4. Depth @ property line is based on elevation after construction and changes may have occurred.

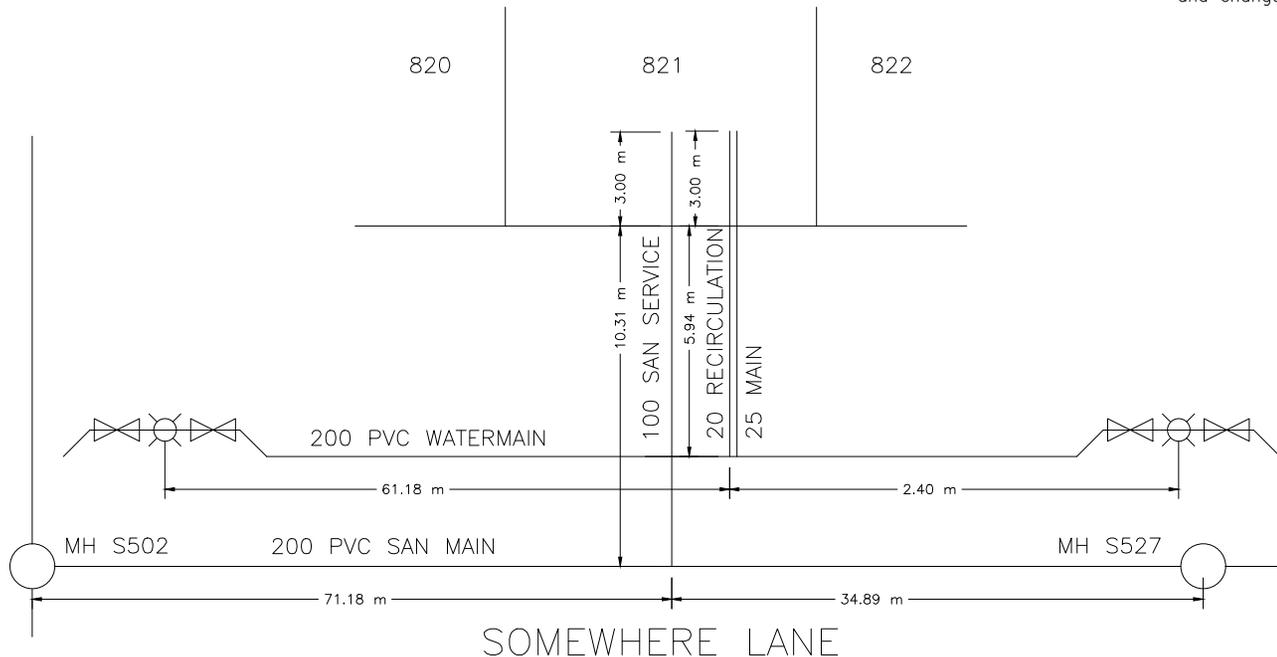



CITY OF WHITEHORSE SERVICE CONNECTION RECORD

FIELD BOOK


No.

ADDRESS 85 Witch Hazel Drive BLOCK LOT 822

DATES		WATER		SEWER	
On at Main 7/27/2019		Depth at P/L: 2.5 m		2.39 m	
On at Building N/A		Depth at Main: 2.94 m		2.75 m	
Frost Plug: N/A		Pipe Size: 25 mm / 20 mm		100 mm	
Memo:		Pipe Material: HDPE Insul. <u>(Yes/No)</u>		PVC Insul. Yes/ <u>(No)</u>	
		Length from Main to P/L: 7.11 m		10.3 m	
		Squirt Test: <u>(Pass)</u> /Fail		N/A	
Booster Pump Required: Yes/No		Frost Protection: Aquaflow/ <u>(Recirc)</u> /Heat Trace/Bleeder		N/A	
PRV Required: Yes/No		Greased @ CC: <u>(Yes/No)</u>		N/A	
Water Meter Installed: Yes/No		Continuity Test: <u>(N/A)</u> Pass/Fail		N/A	

CLEARLY INDICATE LOCATION OF CC AND ROUTE OF PIPES ON DRAWING BELOW

- Show main valves required to isolate this service.
- All dimensions to be tied to property line
- All dimensions to be metric
- Depth @ property line is based on elevation after construction and changes may have occurred.

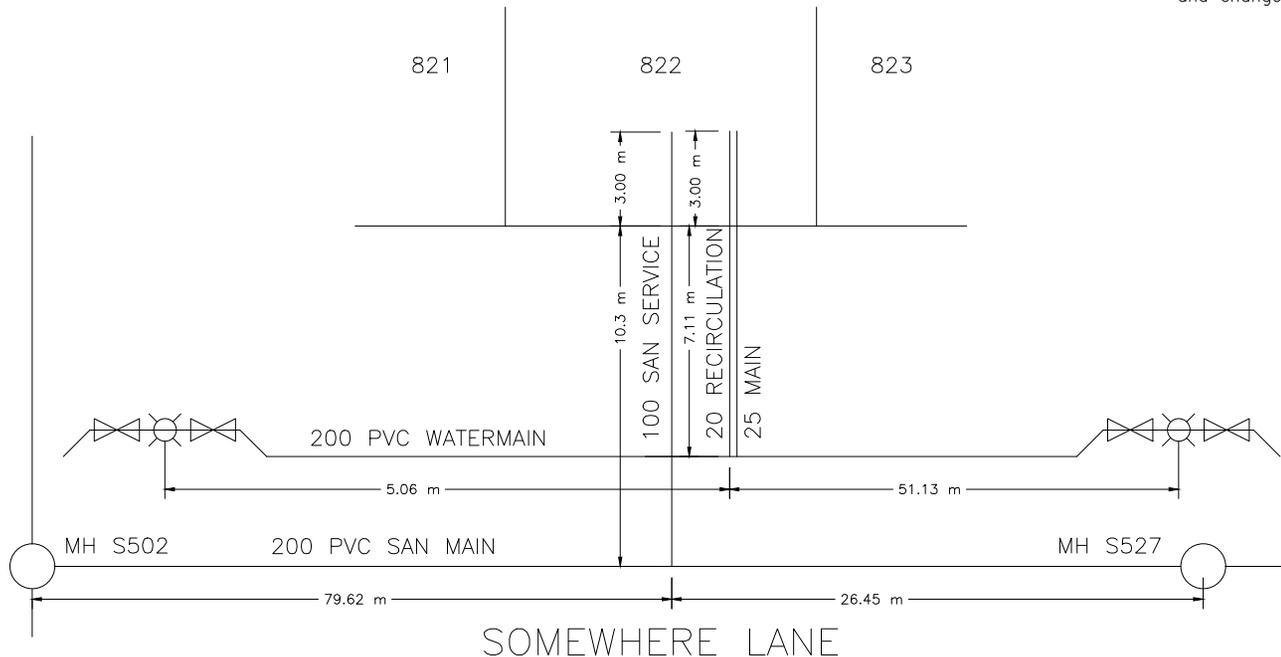



CITY OF WHITEHORSE SERVICE CONNECTION RECORD

FIELD BOOK


No.

ADDRESS 83 Witch Hazel Drive BLOCK LOT 823

DATES	WATER	SEWER
On at Main 7/25/2019	Depth at P/L: 2.47 m	2.29 m
On at Building N/A	Depth at Main: 2.99 m	2.81 m
Frost Plug: N/A	Pipe Size: 25 mm / 20 mm	100 mm
Memo:	Pipe Material: HDPE Insul. <u>(Yes)</u> /No	PVC Insul. Yes/ <u>(No)</u>
	Length from Main to P/L: 7.06 m	10.12 m
	Squirt Test: <u>(Pass)</u> /Fail	N/A
Booster Pump Required: Yes/No	Frost Protection: Aquaflo/ <u>(Recirc)</u> /Heat Trace/Bleeder	N/A
PRV Required: Yes/No	Greased @ CC: <u>(Yes)</u> /No	N/A
Water Meter Installed: Yes/No	Continuity Test: <u>(N/A)</u> Pass/Fail	N/A

CLEARLY INDICATE LOCATION OF CC AND ROUTE OF PIPES ON DRAWING BELOW

1. Show main valves required to isolate this service. 2. All dimensions to be tied to property line 3. All dimensions to be metric 4. Depth @ property line is based on elevation after construction and changes may have occurred.

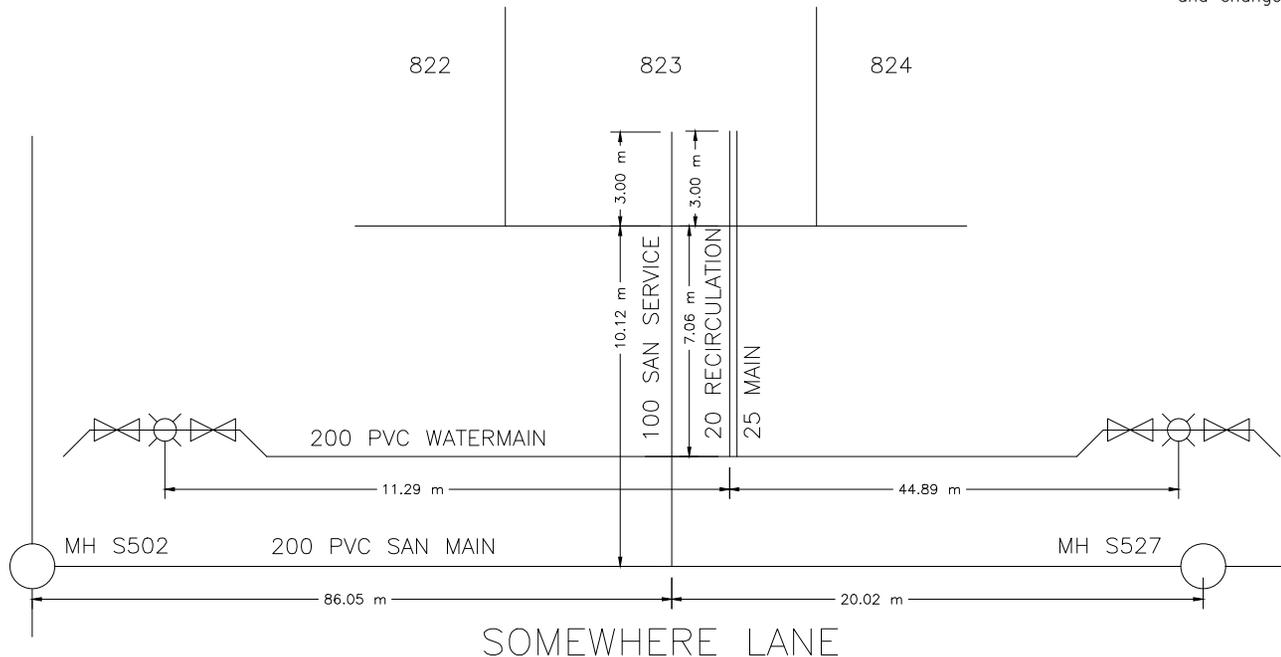



CITY OF WHITEHORSE SERVICE CONNECTION RECORD

FIELD BOOK


No.

ADDRESS 81 Witch Hazel Drive BLOCK LOT 824

	DATES	WATER	SEWER
On at Main	7/30/2019	Depth at P/L: 2.39 m	2.36 m
On at Building		Depth at Main: 3.00 m	2.90 m
Frost Plug:		Pipe Size: 25 mm / 20 mm	100 mm
Memo:		Pipe Material: HDPE	PVC
		Insul. <input checked="" type="checkbox"/> Yes / <input type="checkbox"/> No	Insul. <input type="checkbox"/> Yes / <input checked="" type="checkbox"/> No
		Length from Main to P/L: 6.98 m	10.28 m
		Squirt Test: <input checked="" type="checkbox"/> Pass / <input type="checkbox"/> Fail	N/A
Booster Pump Required:	<input type="checkbox"/> Yes / <input type="checkbox"/> No	Frost Protection: Aquaflo / <input checked="" type="checkbox"/> Recirc / Heat Trace / Bleeder	N/A
PRV Required:	<input type="checkbox"/> Yes / <input type="checkbox"/> No	Greased @ CC: <input checked="" type="checkbox"/> Yes / <input type="checkbox"/> No	N/A
Water Meter Installed:	<input type="checkbox"/> Yes / <input type="checkbox"/> No	Continuity Test: <input checked="" type="checkbox"/> N/A	N/A

CLEARLY INDICATE LOCATION OF CC AND ROUTE OF PIPES ON DRAWING BELOW

1. Show main valves required to isolate this service. 2. All dimensions to be tied to property line 3. All dimensions to be metric 4. Depth @ property line is based on elevation after construction and changes may have occurred.

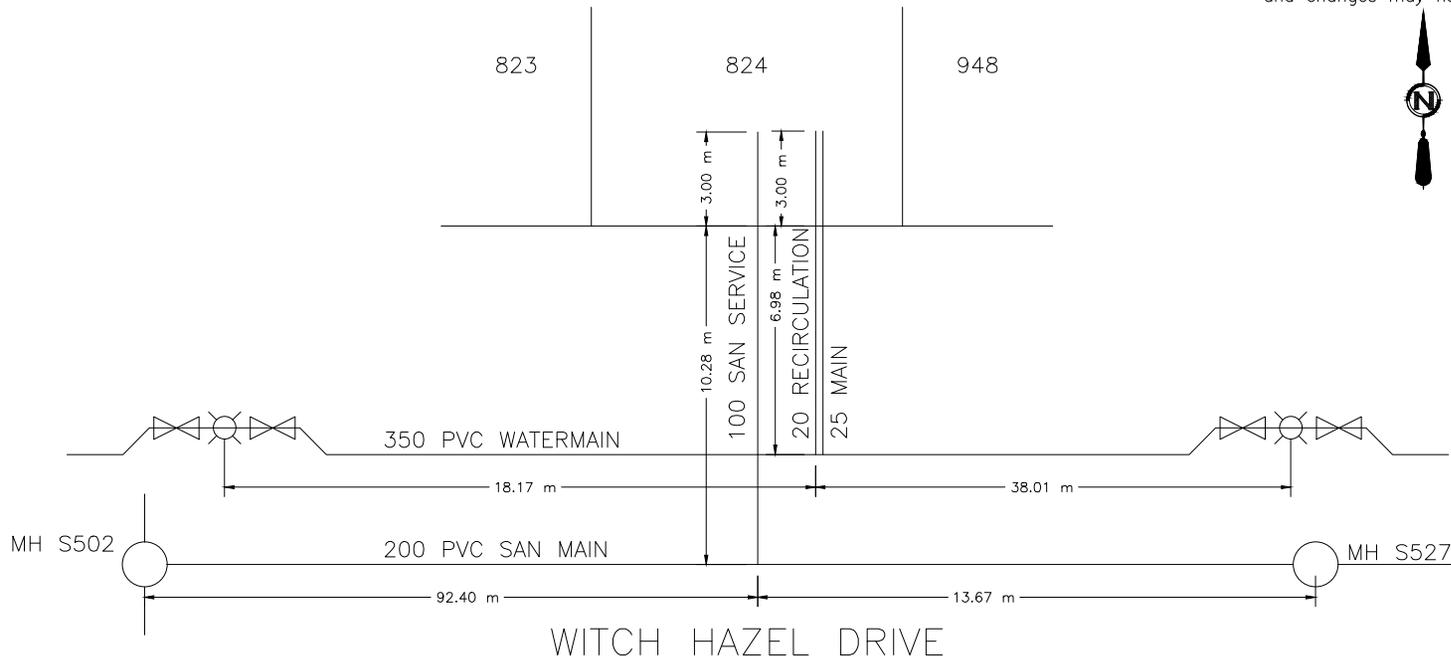



CITY OF WHITEHORSE SERVICE CONNECTION RECORD

FIELD BOOK


No.

ADDRESS 40 Witch Hazel Drive BLOCK LOT 825

DATES		WATER		SEWER
On at Main	7/19/2019	Depth at P/L:	3.22 m	2.15 m
On at Building		Depth at Main:	3.33 m	2.84 m
Frost Plug:		Pipe Size:	150 mm / 50 mm	150 mm
Memo:		Pipe Material:	HDPE Insul. <u>(Yes)</u> /No	PVC Insul. Yes/ <u>(No)</u>
		Length from Main to P/L:	14.70 m	11.71 m
		Squirt Test:	<u>(Pass)</u> /Fail	N/A
Booster Pump Required:	Yes/No	Frost Protection:	Aquaflow/ <u>(Recirc)</u> /Heat Trace/Bleeder	N/A
PRV Required:	Yes/No	Greased @ CC:	<u>(Yes)</u> /No	N/A
Water Meter Installed:	Yes/No	Continuity Test:	<u>(N/A)</u> Pass/Fail	N/A

CLEARLY INDICATE LOCATION OF CC AND ROUTE OF PIPES ON DRAWING BELOW

1. Show main valves required to isolate this service.
2. All dimensions to be tied to property line
3. All dimensions to be metric
4. Depth @ property line is based on elevation after construction and changes may have occurred.

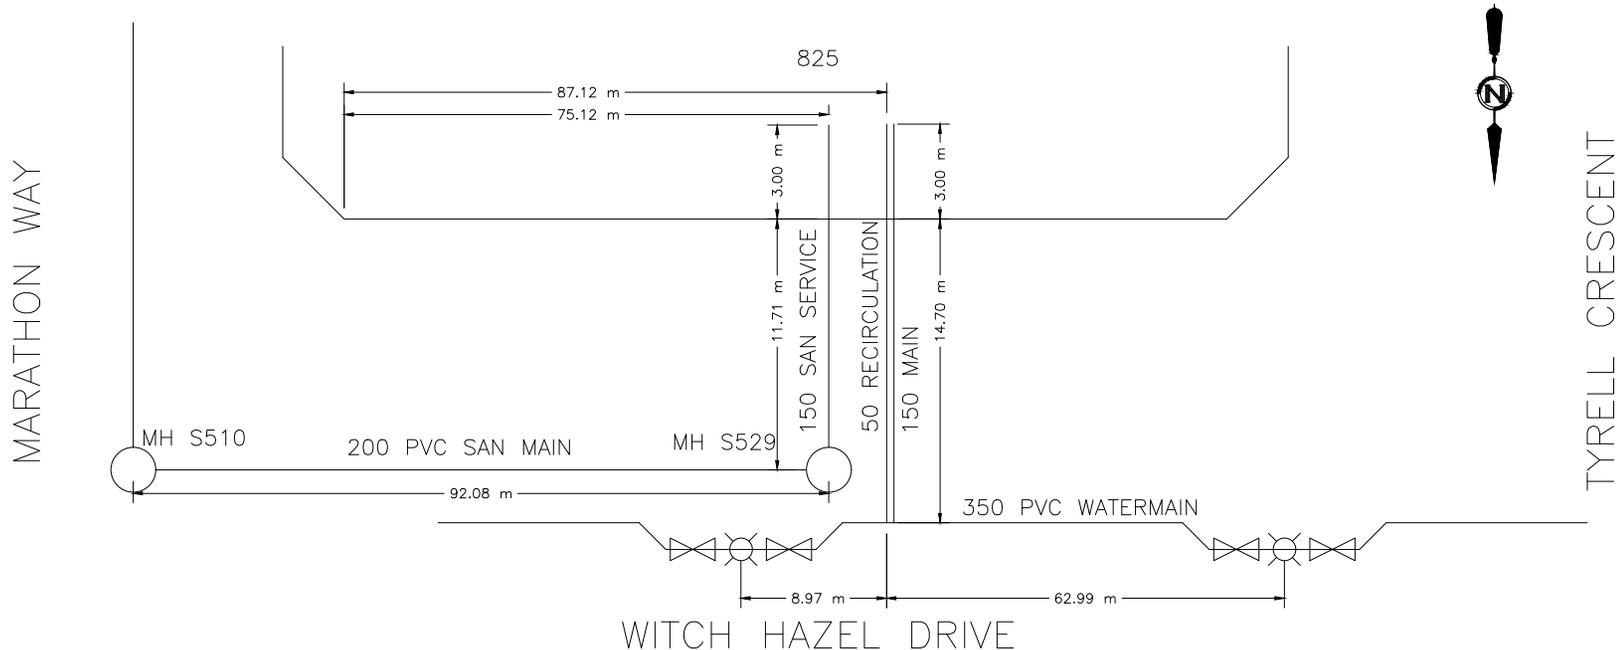



CITY OF WHITEHORSE SERVICE CONNECTION RECORD

FIELD BOOK

No.

ADDRESS 29 Eugene Avenue BLOCK LOT 826

	DATES	WATER	SEWER
On at Main		Depth at P/L: m	m
On at Building		Depth at Main: m	m
Frost Plug:		Pipe Size: mm / mm	mm
Memo:	Pipe Material:	Insul. <input checked="" type="checkbox"/> Yes/No	Insul. Yes/ <input checked="" type="checkbox"/> No
	Length from Main to P/L:	m	m
	Squirt Test:	<input checked="" type="checkbox"/> Pass/Fail	N/A
Booster Pump Required:	Yes/No	Frost Protection: Aquaflow/ <input checked="" type="checkbox"/> Recirc/Heat Trace/Bleeder	N/A
PRV Required:	Yes/No	Greased @ CC: <input checked="" type="checkbox"/> Yes/No	N/A
Water Meter Installed:	Yes/No	Continuity Test: <input checked="" type="checkbox"/> N/A Pass/Fail	N/A

CLEARLY INDICATE LOCATION OF CC AND ROUTE OF PIPES ON DRAWING BELOW

1. Show main valves required to isolate this service. 2. All dimensions to be tied to property line 3. All dimensions to be metric 4. Depth @ property line is based on elevation after construction and changes may have occurred.

826

PUL / PARK





CITY OF WHITEHORSE SERVICE CONNECTION RECORD

FIELD BOOK


No.

ADDRESS 76 Tyrell Crescent BLOCK LOT 827

DATES	WATER	SEWER
On at Main 8/6/2019	Depth at P/L: 2.67 m	2.04 m
On at Building	Depth at Main: 2.95 m	2.56 m
Frost Plug:	Pipe Size: 25 mm / 20 mm	100 mm
Memo:	Pipe Material: HDPE Insul. <u>(Yes)</u> /No	PVC Insul. <u>(Yes)</u> /No
	Length from Main to P/L: 11.75 m	8.98 m
	Squirt Test: <u>(Pass)</u> /Fail	N/A
Booster Pump Required: Yes/No	Frost Protection: Aquaflo/ <u>(Recirc)</u> /Heat Trace/Bleeder	N/A
PRV Required: Yes/No	Greased @ CC: <u>(Yes)</u> /No	N/A
Water Meter Installed: Yes/No	Continuity Test: <u>(N/A)</u> Pass/Fail	N/A

CLEARLY INDICATE LOCATION OF CC AND ROUTE OF PIPES ON DRAWING BELOW

1. Show main valves required to isolate this service. 2. All dimensions to be tied to property line 3. All dimensions to be metric 4. Depth @ property line is based on elevation after construction and changes may have occurred.

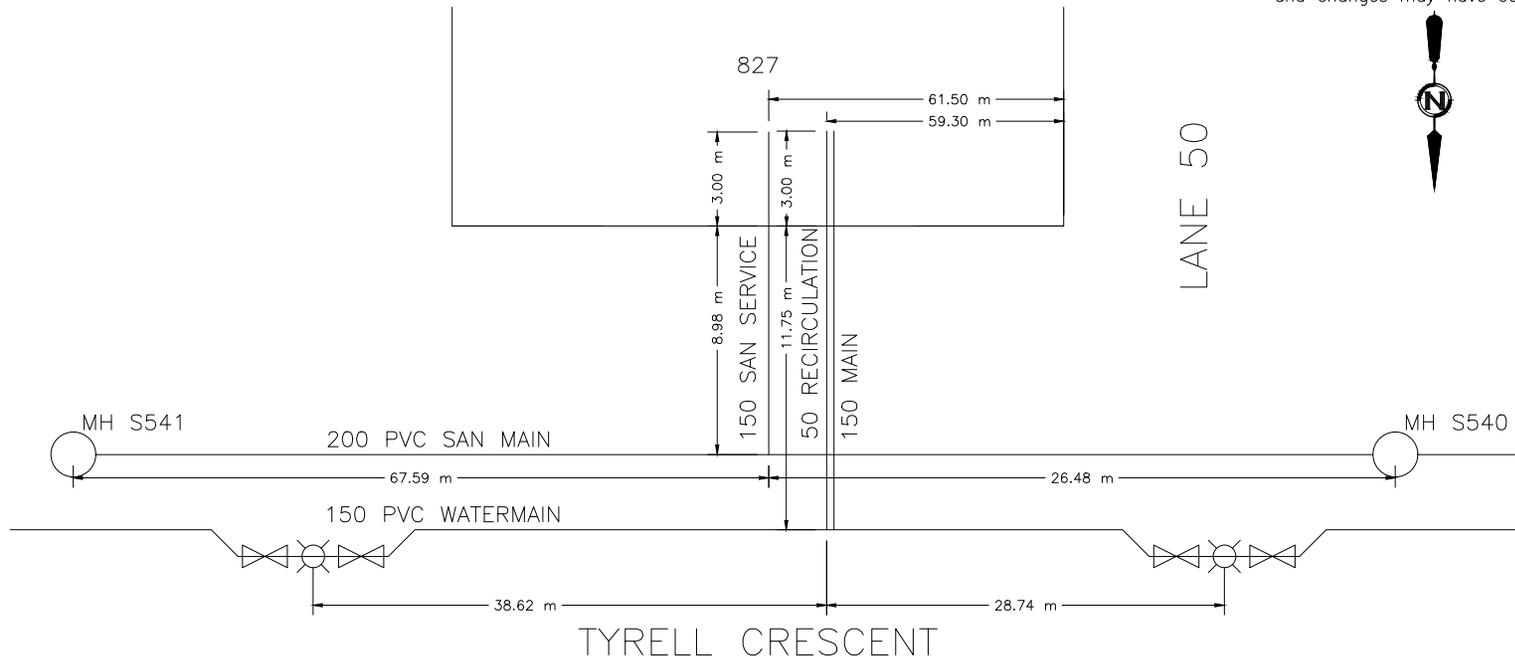



CITY OF WHITEHORSE SERVICE CONNECTION RECORD

FIELD BOOK


No. _____

ADDRESS 30 Eugene Avenue BLOCK _____ LOT 828

	DATES	WATER	SEWER
On at Main		Depth at P/L: m	m
On at Building		Depth at Main: m	m
Frost Plug:		Pipe Size: mm / mm	mm
Memo:		Pipe Material: _____ Insul. <u>Yes</u> /No	Insul. Yes/ <u>No</u>
		Length from Main to P/L: m	m
		Squirt Test: <u>Pass</u> /Fail	N/A
Booster Pump Required:	Yes/No	Frost Protection: Aquaflow/ <u>Recirc</u> /Heat Trace/Bleeder	N/A
PRV Required:	Yes/No	Greased @ CC: <u>Yes</u> /No	N/A
Water Meter Installed:	Yes/No	Continuity Test: <u>N/A</u> Pass/Fail	N/A

CLEARLY INDICATE LOCATION OF CC AND ROUTE OF PIPES ON DRAWING BELOW

1. Show main valves required to isolate this service. 2. All dimensions to be tied to property line 3. All dimensions to be metric 4. Depth @ property line is based on elevation after construction and changes may have occurred.

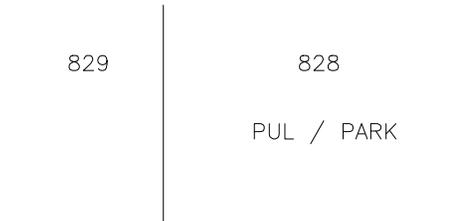



CITY OF WHITEHORSE SERVICE CONNECTION RECORD

FIELD BOOK


No.

ADDRESS 140 Witch Hazel Drive BLOCK LOT 829

DATES		WATER		SEWER		
On at Main	7/5/2019	Depth at P/L:	3.09 m		2.47 m	
On at Building		Depth at Main:	3.13 m		2.70 m	
Frost Plug:		Pipe Size:	150 mm / 50 mm		150 mm	
Memo:		Pipe Material:	HDPE	Insul. <input checked="" type="checkbox"/> Yes/ <input type="checkbox"/> No	PVC	Insul. <input type="checkbox"/> Yes/ <input checked="" type="checkbox"/> No
		Length from Main to P/L:	11.39 m		5.97 m	
		Squirt Test:	<input checked="" type="checkbox"/> Pass/ <input type="checkbox"/> Fail			N/A
Booster Pump Required:	<input type="checkbox"/> Yes/ <input type="checkbox"/> No	Frost Protection:	Aquaflow/ <input checked="" type="checkbox"/> Recirc/ <input type="checkbox"/> Heat Trace/Bleeder			N/A
PRV Required:	<input type="checkbox"/> Yes/ <input type="checkbox"/> No	Greased @ CC:	<input checked="" type="checkbox"/> Yes/ <input type="checkbox"/> No			N/A
Water Meter Installed:	<input type="checkbox"/> Yes/ <input type="checkbox"/> No	Continuity Test:	<input checked="" type="checkbox"/> N/A	<input type="checkbox"/> Pass/ <input type="checkbox"/> Fail		N/A

CLEARLY INDICATE LOCATION OF CC AND ROUTE OF PIPES ON DRAWING BELOW

1. Show main valves required to isolate this service.
2. All dimensions to be tied to property line
3. All dimensions to be metric
4. Depth @ property line is based on elevation after construction and changes may have occurred.

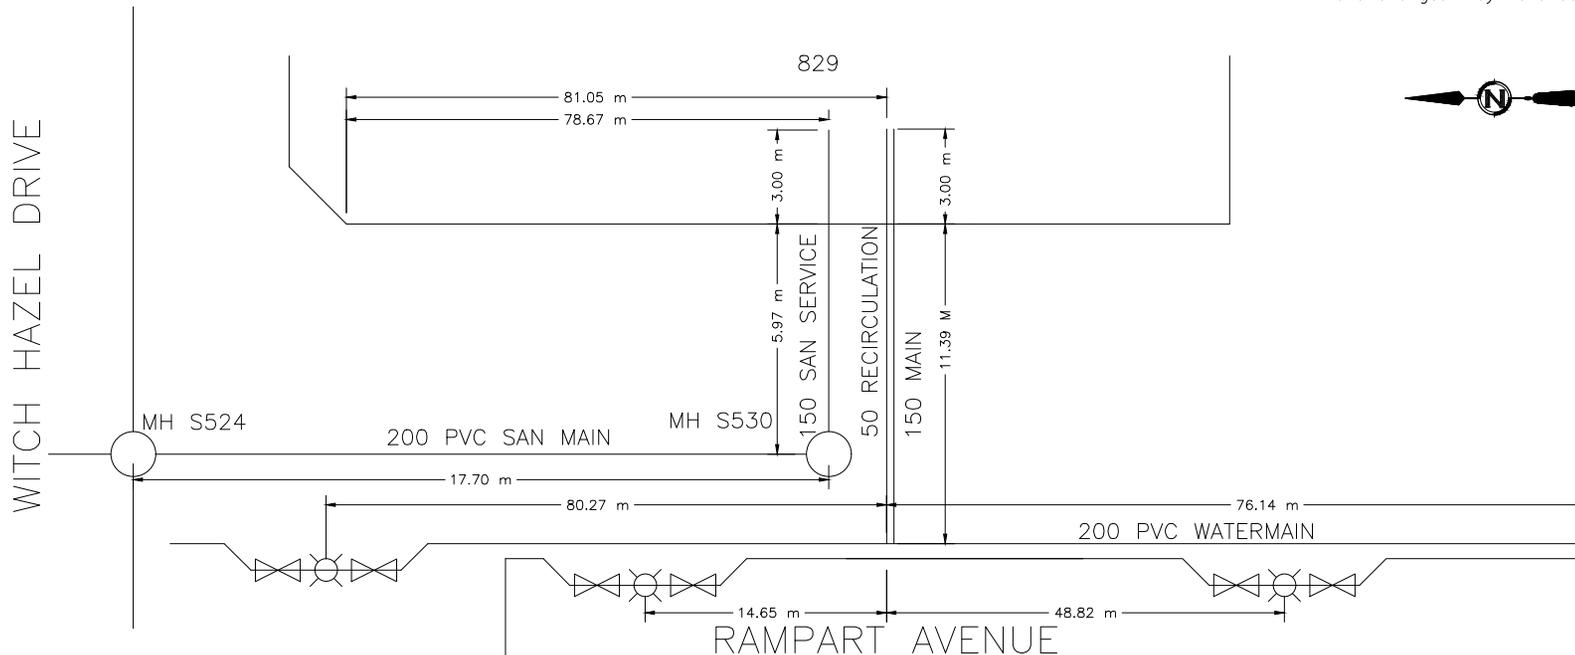



CITY OF WHITEHORSE SERVICE CONNECTION RECORD

FIELD BOOK


No. _____

ADDRESS 60 Witch Hazel Drive BLOCK LOT 830

DATES	WATER	SEWER
On at Main 7/25/2019	Depth at P/L: 2.46 m	2.42 m
On at Building	Depth at Main: 3.02 m	2.98 m
Frost Plug:	Pipe Size: 25 mm / 20 mm	100 mm
Memo:	Pipe Material: HDPE Insul. <u>(Yes)</u> /No	PVC Insul. Yes/ <u>(No)</u>
	Length from Main to P/L: 14.83 m	12.20 m
	Squirt Test: <u>(Pass)</u> /Fail	N/A
Booster Pump Required: Yes/No	Frost Protection: Aquaflow/ <u>(Recirc)</u> /Heat Trace/Bleeder	N/A
PRV Required: Yes/No	Greased @ CC: <u>(Yes)</u> /No	N/A
Water Meter Installed: Yes/No	Continuity Test: <u>(N/A)</u> Pass/Fail	N/A

CLEARLY INDICATE LOCATION OF CC AND ROUTE OF PIPES ON DRAWING BELOW

1. Show main valves required to isolate this service. 2. All dimensions to be tied to property line 3. All dimensions to be metric 4. Depth @ property line is based on elevation after construction and changes may have occurred.

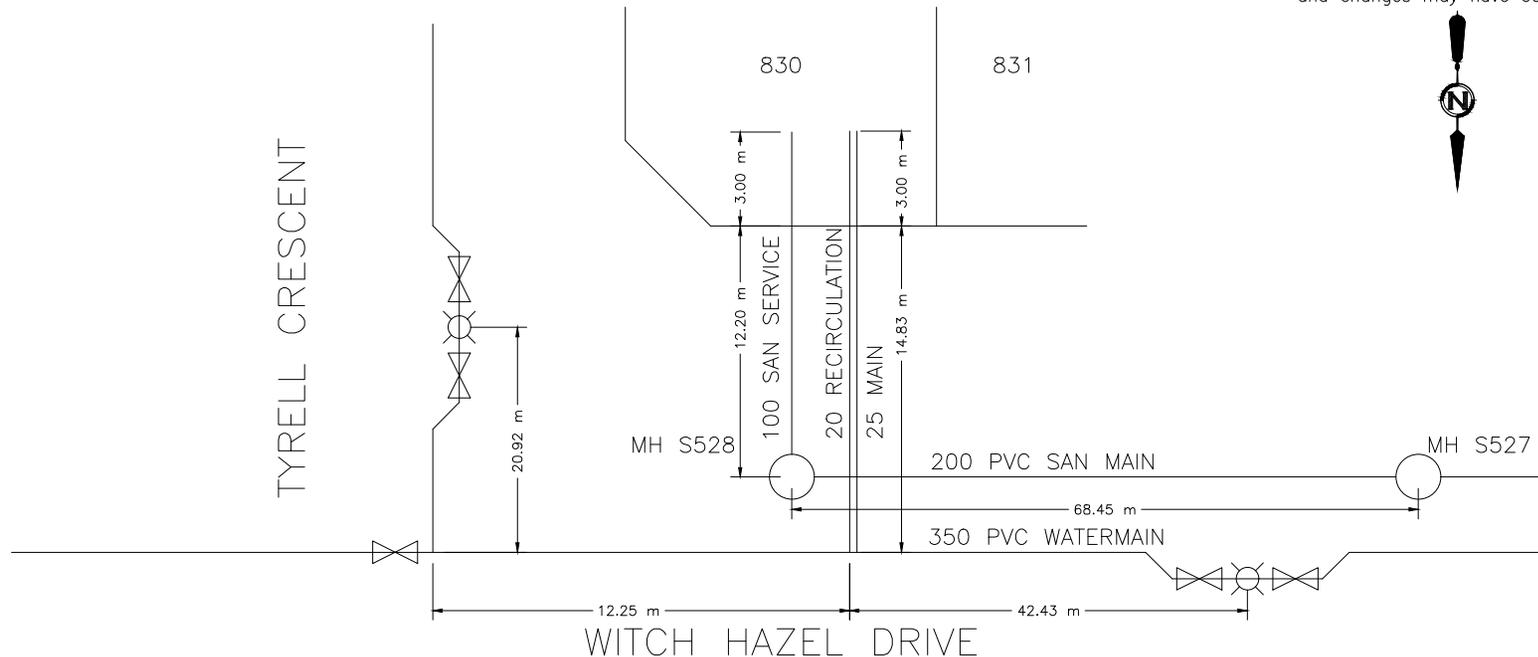



CITY OF WHITEHORSE SERVICE CONNECTION RECORD

FIELD BOOK


No.

ADDRESS 62 Witch Hazel Drive BLOCK LOT 831

	DATES	WATER	SEWER
On at Main	7/26/2019	Depth at P/L: 2.39 m	2.38 m
On at Building		Depth at Main: 3.11 m	2.83 m
Frost Plug:		Pipe Size: 25 mm / 20 mm	100 mm
Memo:		Pipe Material: HDPE	PVC
		Insul. <input checked="" type="checkbox"/> Yes / <input type="checkbox"/> No	Insul. <input type="checkbox"/> Yes / <input checked="" type="checkbox"/> No
		Length from Main to P/L: 14.96 m	12.12 m
		Squirt Test: <input checked="" type="checkbox"/> Pass / <input type="checkbox"/> Fail	N/A
Booster Pump Required:	<input type="checkbox"/> Yes / <input type="checkbox"/> No	Frost Protection: Aquaflo / <input checked="" type="checkbox"/> Recirc / Heat Trace / Bleeder	N/A
PRV Required:	<input type="checkbox"/> Yes / <input type="checkbox"/> No	Greased @ CC: <input checked="" type="checkbox"/> Yes / <input type="checkbox"/> No	N/A
Water Meter Installed:	<input type="checkbox"/> Yes / <input type="checkbox"/> No	Continuity Test: <input checked="" type="checkbox"/> N/A	N/A

CLEARLY INDICATE LOCATION OF CC AND ROUTE OF PIPES ON DRAWING BELOW

1. Show main valves required to isolate this service. 2. All dimensions to be tied to property line 3. All dimensions to be metric 4. Depth @ property line is based on elevation after construction and changes may have occurred.

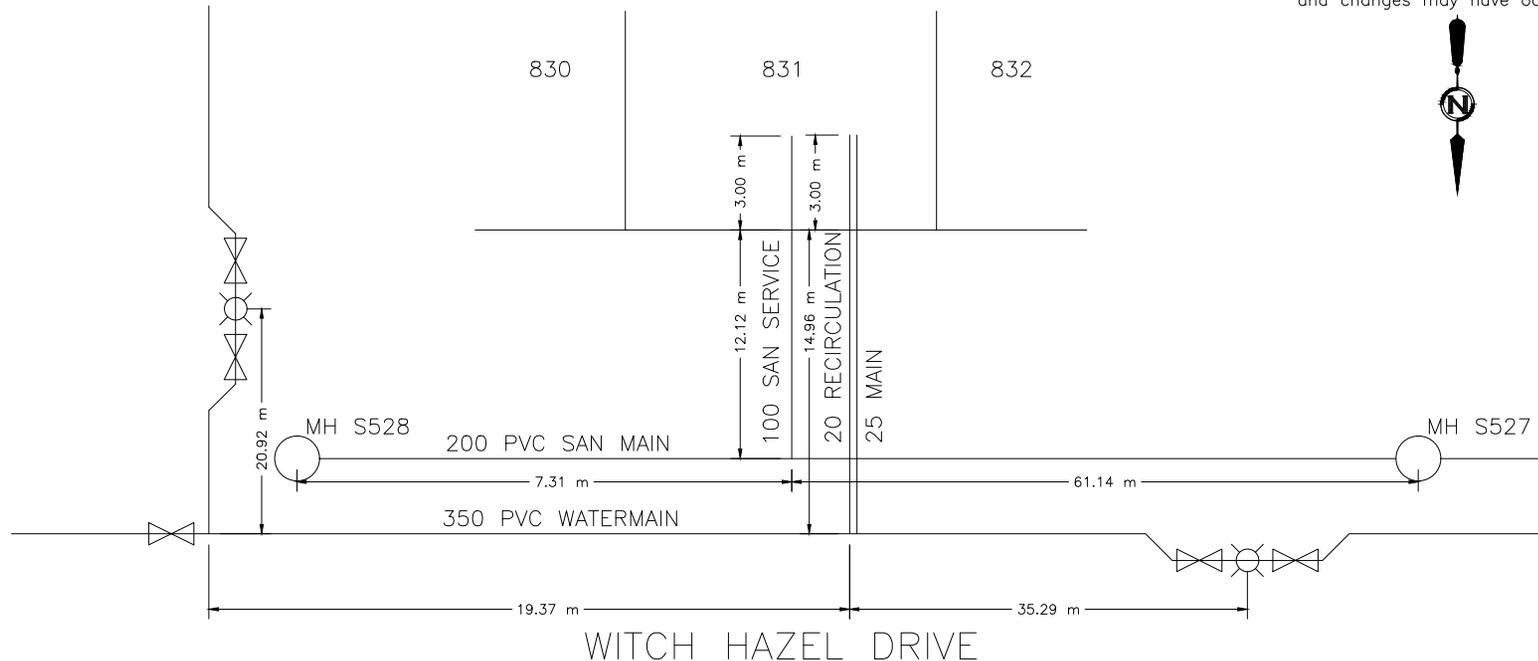



CITY OF WHITEHORSE SERVICE CONNECTION RECORD

FIELD BOOK


No.

ADDRESS 64 Witch Hazel Drive BLOCK LOT 832

DATES		WATER		SEWER	
On at Main	7/29/2019	Depth at P/L:	2.43 m		2.36 m
On at Building		Depth at Main:	3.15 m		2.84 m
Frost Plug:		Pipe Size:	25 mm / 20 mm		100 mm
Memo:		Pipe Material:	HDPE	Insul. <u>(Yes)</u> /No	PVC
		Length from Main to P/L:	14.89 m		12.14 m
		Squirt Test:	<u>(Pass)</u> /Fail		N/A
Booster Pump Required:	Yes/No	Frost Protection:	Aquaflow/ <u>(Recirc)</u> /Heat Trace/Bleeder		N/A
PRV Required:	Yes/No	Greased @ CC:	<u>(Yes)</u> /No		N/A
Water Meter Installed:	Yes/No	Continuity Test:	<u>(N/A)</u> Pass/Fail		N/A

CLEARLY INDICATE LOCATION OF CC AND ROUTE OF PIPES ON DRAWING BELOW

1. Show main valves required to isolate this service. 2. All dimensions to be tied to property line 3. All dimensions to be metric 4. Depth @ property line is based on elevation after construction and changes may have occurred.

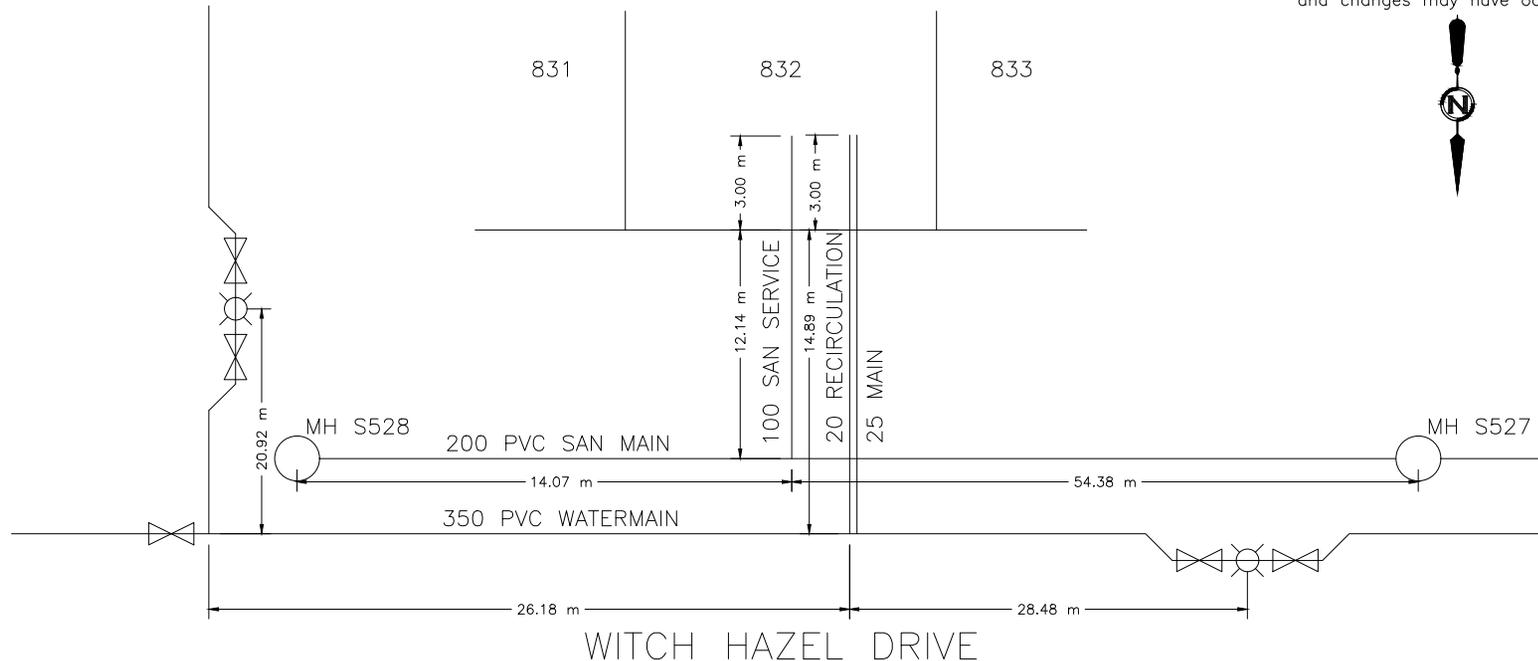



CITY OF WHITEHORSE SERVICE CONNECTION RECORD

FIELD BOOK


No.

ADDRESS 66 Witch Hazel Drive BLOCK LOT 833

	DATES	WATER	SEWER
On at Main	7/24/2019	Depth at P/L: 2.35 m	2.37 m
On at Building		Depth at Main: 3.02 m	2.81 m
Frost Plug:		Pipe Size: 25 mm / 20 mm	100 mm
Memo:		Pipe Material: HDPE	PVC
		Insul. <input checked="" type="checkbox"/> Yes / <input type="checkbox"/> No	Insul. <input type="checkbox"/> Yes / <input checked="" type="checkbox"/> No
		Length from Main to P/L: 14.76 m	11.71 m
		Squirt Test: <input checked="" type="checkbox"/> Pass / <input type="checkbox"/> Fail	N/A
Booster Pump Required:	<input type="checkbox"/> Yes / <input type="checkbox"/> No	Frost Protection: Aquaflo / <input checked="" type="checkbox"/> Recirc / Heat Trace / Bleeder	N/A
PRV Required:	<input type="checkbox"/> Yes / <input type="checkbox"/> No	Greased @ CC: <input checked="" type="checkbox"/> Yes / <input type="checkbox"/> No	N/A
Water Meter Installed:	<input type="checkbox"/> Yes / <input type="checkbox"/> No	Continuity Test: <input checked="" type="checkbox"/> N/A	N/A

CLEARLY INDICATE LOCATION OF CC AND ROUTE OF PIPES ON DRAWING BELOW

1. Show main valves required to isolate this service. 2. All dimensions to be tied to property line 3. All dimensions to be metric 4. Depth @ property line is based on elevation after construction and changes may have occurred.

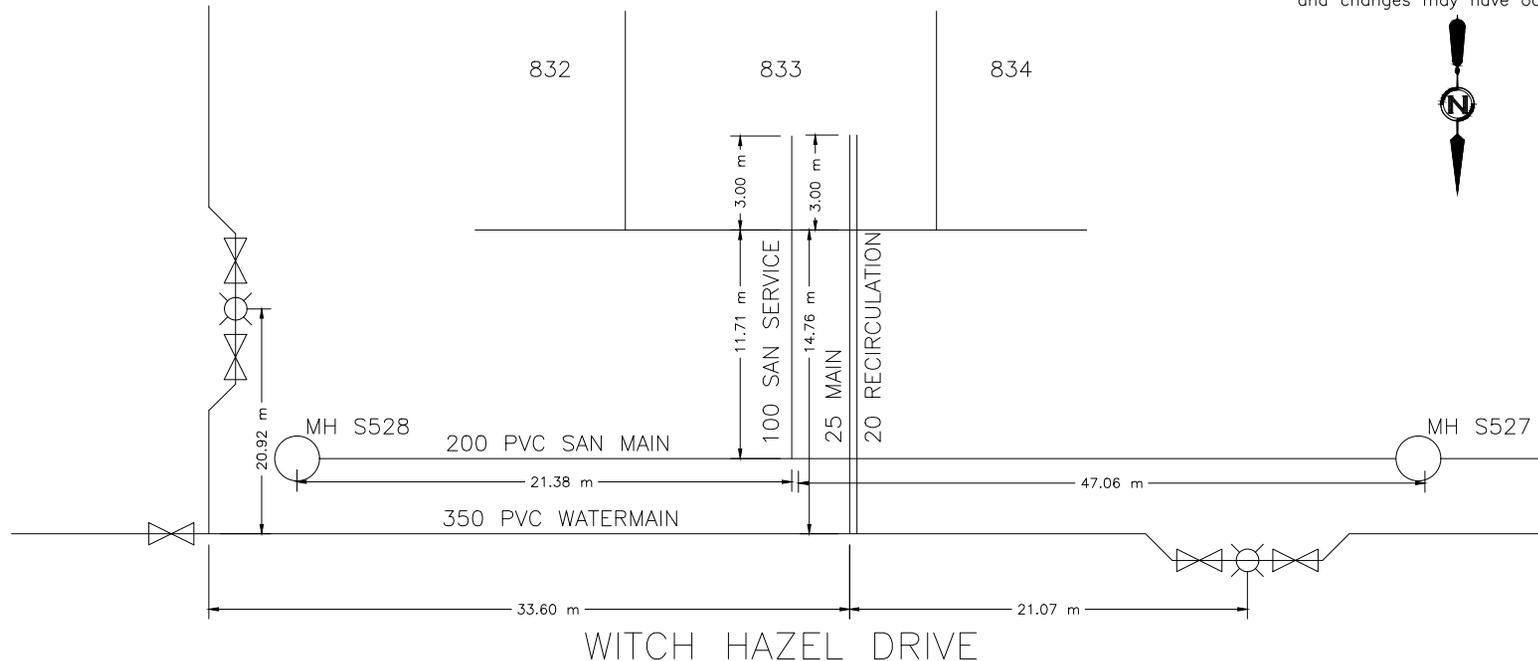



CITY OF WHITEHORSE SERVICE CONNECTION RECORD

FIELD BOOK


No.

ADDRESS 68 Witch Hazel Drive BLOCK LOT 834

	DATES	WATER	SEWER
On at Main	7/26/2019	Depth at P/L: 2.45 m	2.38 m
On at Building		Depth at Main: 3.12 m	2.84 m
Frost Plug:		Pipe Size: 25 mm / 20 mm	100 mm
Memo:		Pipe Material: HDPE	Insul. <input checked="" type="checkbox"/> Yes / <input type="checkbox"/> No
		Length from Main to P/L: 14.84 m	PVC
		Squirt Test: <input checked="" type="checkbox"/> Pass / <input type="checkbox"/> Fail	Insul. Yes / <input checked="" type="checkbox"/> No
Booster Pump Required:	Yes/No	Frost Protection: Aquaflo / <input checked="" type="checkbox"/> Recirc / Heat Trace / Bleeder	N/A
PRV Required:	Yes/No	Greased @ CC: <input checked="" type="checkbox"/> Yes / <input type="checkbox"/> No	N/A
Water Meter Installed:	Yes/No	Continuity Test: <input checked="" type="checkbox"/> N/A	Pass/Fail

CLEARLY INDICATE LOCATION OF CC AND ROUTE OF PIPES ON DRAWING BELOW

1. Show main valves required to isolate this service. 2. All dimensions to be tied to property line 3. All dimensions to be metric 4. Depth @ property line is based on elevation after construction and changes may have occurred.

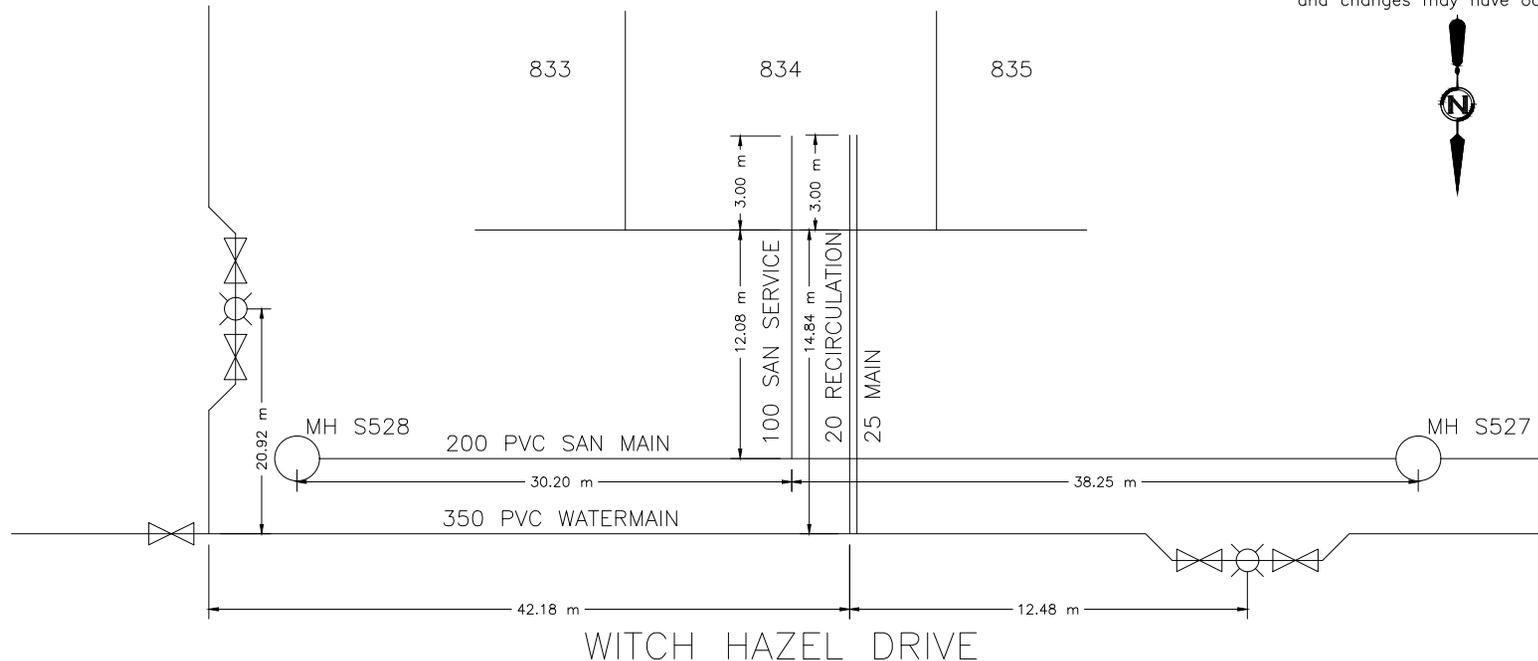



CITY OF WHITEHORSE SERVICE CONNECTION RECORD

FIELD BOOK


No.

ADDRESS 70 Witch Hazel Drive BLOCK LOT 835

	DATES	WATER	SEWER
On at Main	7/29/2019	Depth at P/L: 2.34 m	2.36 m
On at Building		Depth at Main: 3.12 m	2.86 m
Frost Plug:		Pipe Size: 25 mm / 20 mm	100 mm
Memo:		Pipe Material: HDPE	PVC
		Insul. <input checked="" type="checkbox"/> Yes / <input type="checkbox"/> No	Insul. <input type="checkbox"/> Yes / <input checked="" type="checkbox"/> No
		Length from Main to P/L: 16.21 m	12.09 m
		Squirt Test: <input checked="" type="checkbox"/> Pass / <input type="checkbox"/> Fail	N/A
Booster Pump Required:	<input type="checkbox"/> Yes / <input type="checkbox"/> No	Frost Protection: Aquaflo / <input checked="" type="checkbox"/> Recirc / Heat Trace / Bleeder	N/A
PRV Required:	<input type="checkbox"/> Yes / <input type="checkbox"/> No	Greased @ CC: <input checked="" type="checkbox"/> Yes / <input type="checkbox"/> No	N/A
Water Meter Installed:	<input type="checkbox"/> Yes / <input type="checkbox"/> No	Continuity Test: <input checked="" type="checkbox"/> N/A	N/A

CLEARLY INDICATE LOCATION OF CC AND ROUTE OF PIPES ON DRAWING BELOW

1. Show main valves required to isolate this service. 2. All dimensions to be tied to property line 3. All dimensions to be metric 4. Depth @ property line is based on elevation after construction and changes may have occurred.

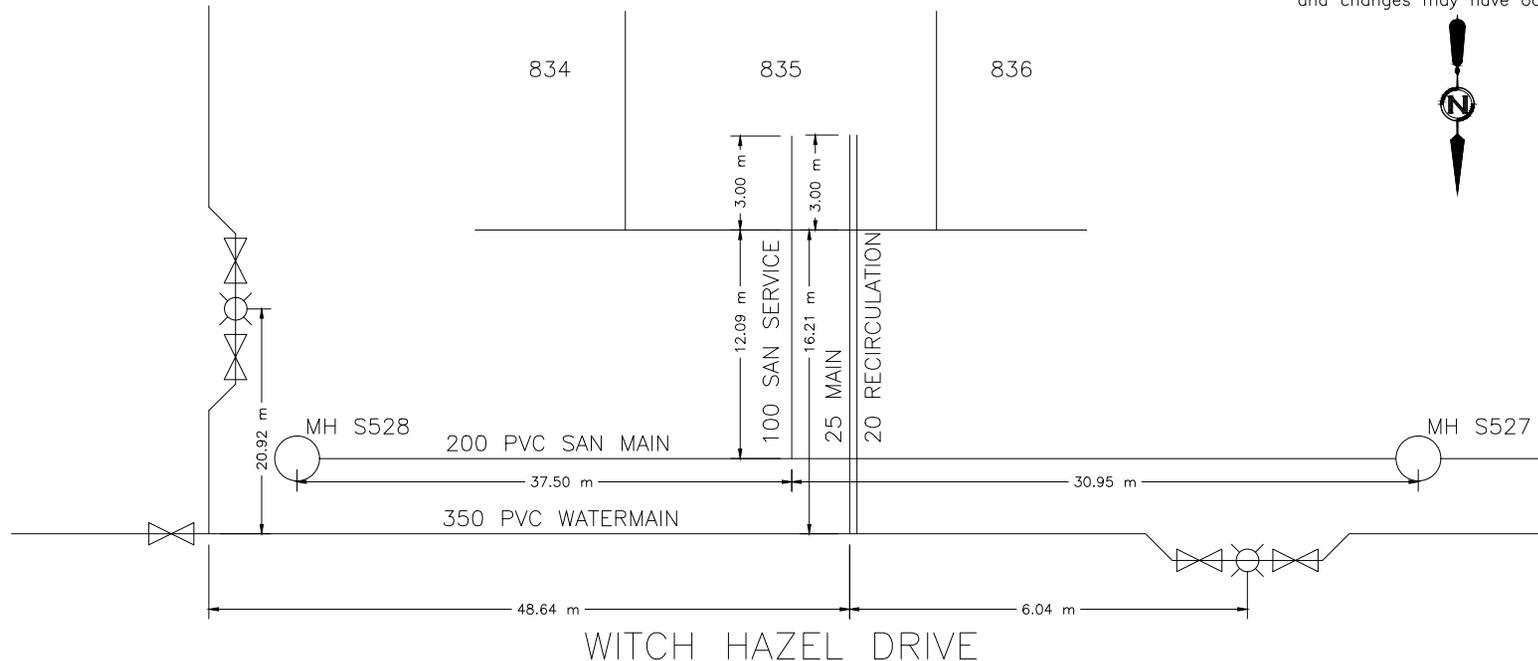



CITY OF WHITEHORSE SERVICE CONNECTION RECORD

FIELD BOOK


No.

ADDRESS 72 Witch Hazel Drive BLOCK LOT 836

DATES	WATER	SEWER
On at Main 7/24/2019	Depth at P/L: 2.09 m	2.08 m
On at Building	Depth at Main: 2.96 m	2.80 m
Frost Plug:	Pipe Size: 25 mm / 20 mm	100 mm
Memo:	Pipe Material: HDPE Insul. <u>(Yes)</u> /No	PVC Insul. <u>(Yes)</u> /No
	Length from Main to P/L: 18.70 m	12.24 m
	Squirt Test: <u>(Pass)</u> /Fail	N/A
Booster Pump Required: Yes/No	Frost Protection: Aquaflo/ <u>(Recirc)</u> /Heat Trace/Bleeder	N/A
PRV Required: Yes/No	Greased @ CC: <u>(Yes)</u> /No	N/A
Water Meter Installed: Yes/No	Continuity Test: <u>(N/A)</u> Pass/Fail	N/A

CLEARLY INDICATE LOCATION OF CC AND ROUTE OF PIPES ON DRAWING BELOW

1. Show main valves required to isolate this service. 2. All dimensions to be tied to property line 3. All dimensions to be metric 4. Depth @ property line is based on elevation after construction and changes may have occurred.

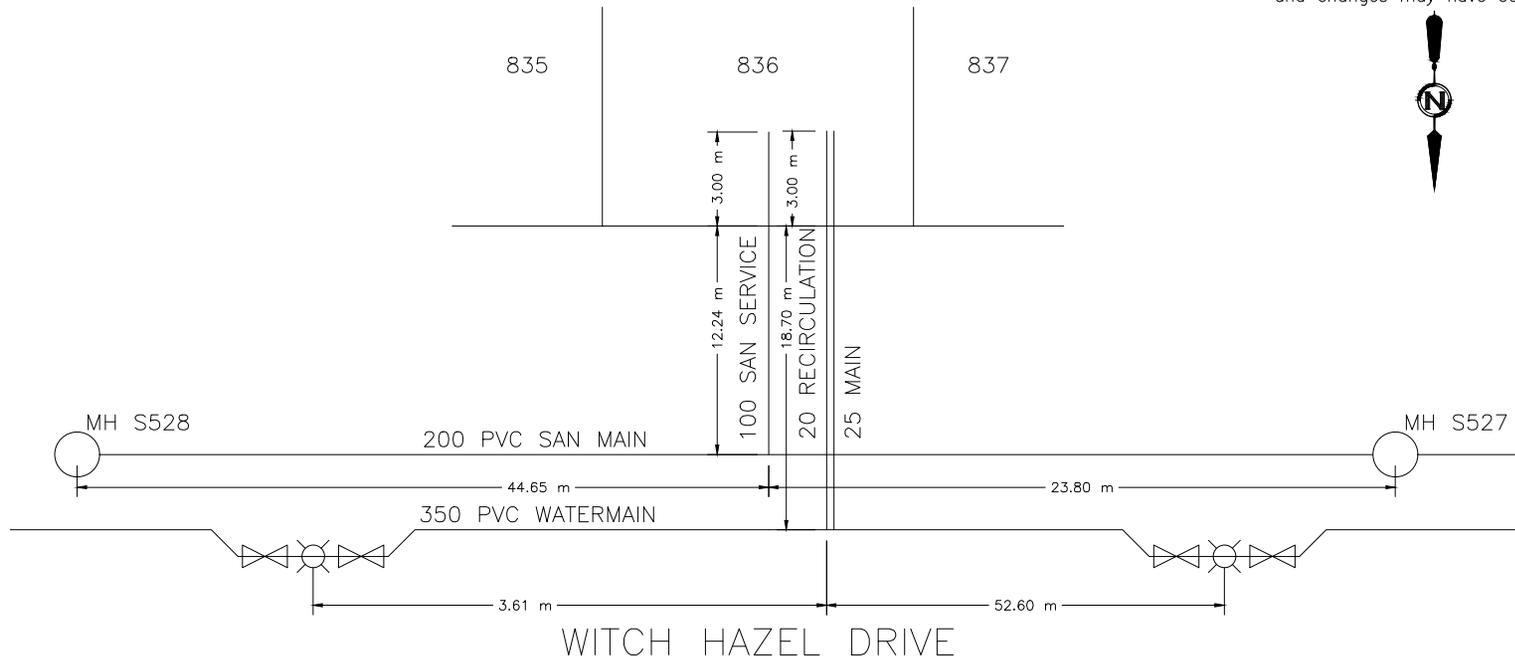



CITY OF WHITEHORSE SERVICE CONNECTION RECORD

FIELD BOOK


No.

ADDRESS 74 Witch Hazel Drive BLOCK LOT 837

DATES		WATER		SEWER	
On at Main	7/26/2019	Depth at P/L:	2.39 m		2.33 m
On at Building		Depth at Main:	3.02 m		2.77 m
Frost Plug:		Pipe Size:	25 mm / 20 mm		100 mm
Memo:		Pipe Material:	HDPE	Insul. (Yes/No)	PVC
		Length from Main to P/L:	14.87 m		12.15 m
		Squirt Test:	(Pass)/Fail		N/A
Booster Pump Required:	Yes/No	Frost Protection:	Aquaflow/Recirc/Heat Trace/Bleeder		N/A
PRV Required:	Yes/No	Greased @ CC:	(Yes)/No		N/A
Water Meter Installed:	Yes/No	Continuity Test:	(N/A) Pass/Fail		N/A

CLEARLY INDICATE LOCATION OF CC AND ROUTE OF PIPES ON DRAWING BELOW

1. Show main valves required to isolate this service. 2. All dimensions to be tied to property line 3. All dimensions to be metric 4. Depth @ property line is based on elevation after construction and changes may have occurred.

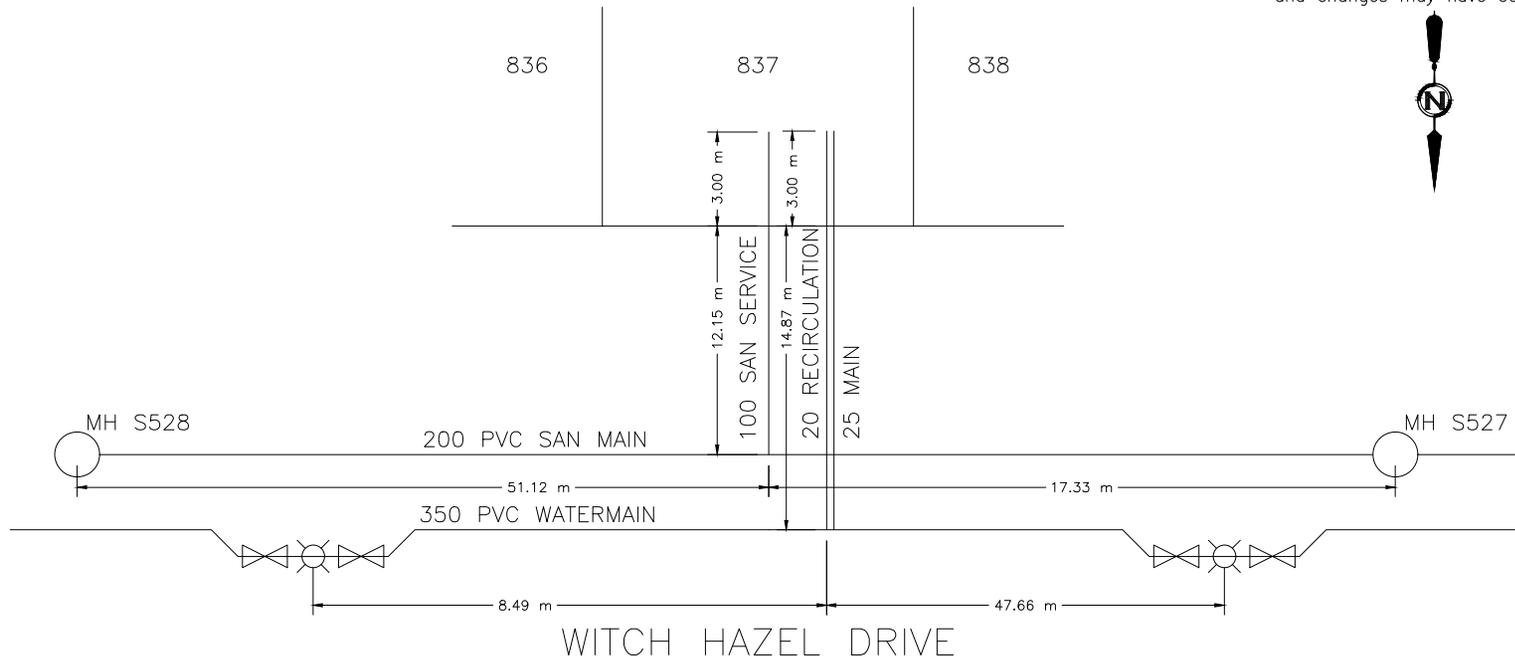



CITY OF WHITEHORSE SERVICE CONNECTION RECORD

FIELD BOOK


No.

ADDRESS 76 Witch Hazel Drive BLOCK LOT 838

DATES	WATER	SEWER
On at Main 7/29/2019	Depth at P/L: 2.53m	2.36 m
On at Building	Depth at Main: 3.06m	2.86 m
Frost Plug:	Pipe Size: 25 mm / 20 mm	100 mm
Memo:	Pipe Material: HDPE	Insul. <input checked="" type="checkbox"/> Yes / <input type="checkbox"/> No
	Length from Main to P/L: 14.76 m	PVC
	Squirt Test: <input checked="" type="checkbox"/> Pass / <input type="checkbox"/> Fail	Insul. Yes / <input checked="" type="checkbox"/> No
Booster Pump Required: Yes/No	Frost Protection: Aquaflo / <input checked="" type="checkbox"/> Recirc / Heat Trace / Bleeder	N/A
PRV Required: Yes/No	Greased @ CC: <input checked="" type="checkbox"/> Yes / <input type="checkbox"/> No	N/A
Water Meter Installed: Yes/No	Continuity Test: <input checked="" type="checkbox"/> N/A	Pass/Fail

CLEARLY INDICATE LOCATION OF CC AND ROUTE OF PIPES ON DRAWING BELOW

1. Show main valves required to isolate this service. 2. All dimensions to be tied to property line 3. All dimensions to be metric 4. Depth @ property line is based on elevation after construction and changes may have occurred.

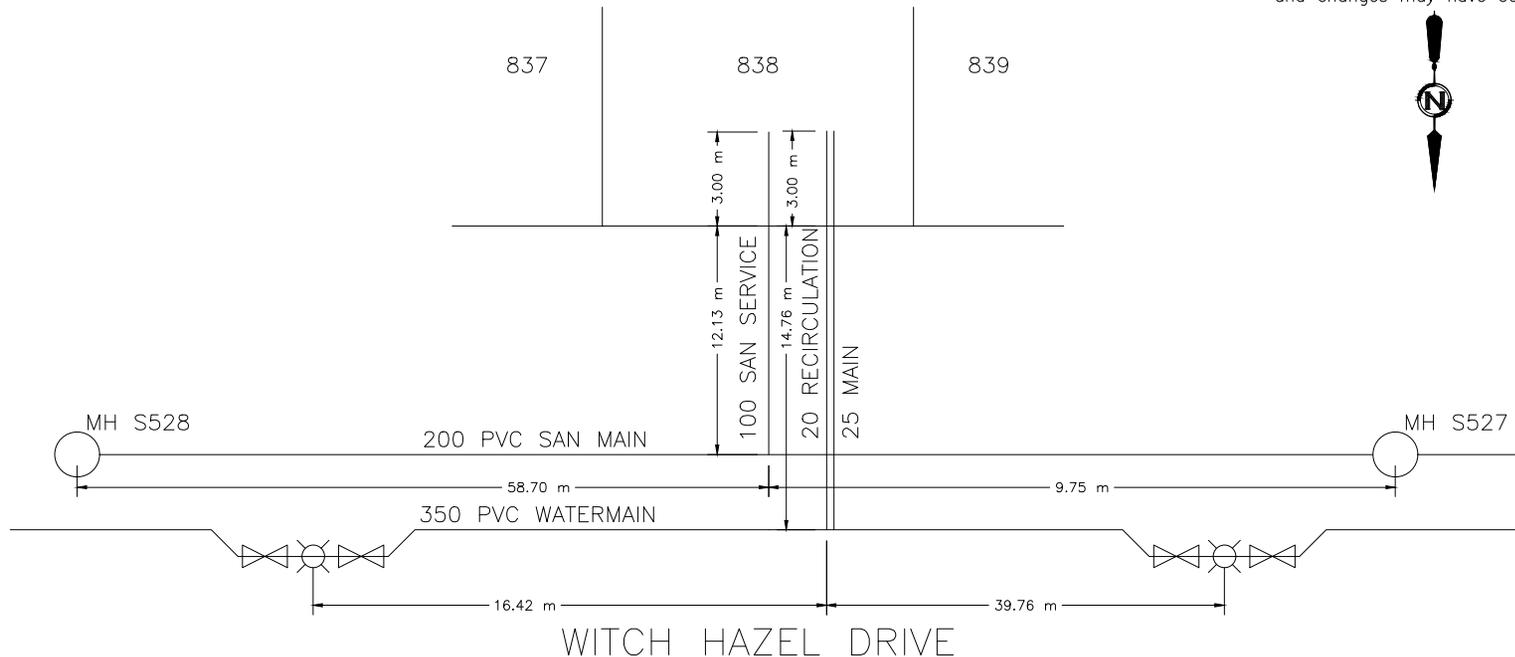



CITY OF WHITEHORSE SERVICE CONNECTION RECORD

FIELD BOOK


No.

ADDRESS 78 Witch Hazel Drive BLOCK LOT 839

DATES	WATER	SEWER
On at Main 7/24/2019	Depth at P/L: 2.36 m	2.25 m
On at Building	Depth at Main: 3.08 m	2.85 m
Frost Plug:	Pipe Size: 25 mm / 20 mm	100 mm
Memo:	Pipe Material: HDPE Insul. <u>(Yes)</u> /No	PVC Insul. <u>(Yes)</u> /No
	Length from Main to P/L: 14.78 m	12.14 m
	Squirt Test: <u>(Pass)</u> /Fail	N/A
Booster Pump Required: Yes/No	Frost Protection: Aquaflo/ <u>(Recirc)</u> /Heat Trace/Bleeder	N/A
PRV Required: Yes/No	Greased @ CC: <u>(Yes)</u> /No	N/A
Water Meter Installed: Yes/No	Continuity Test: <u>(N/A)</u> Pass/Fail	N/A

CLEARLY INDICATE LOCATION OF CC AND ROUTE OF PIPES ON DRAWING BELOW

1. Show main valves required to isolate this service. 2. All dimensions to be tied to property line 3. All dimensions to be metric 4. Depth @ property line is based on elevation after construction and changes may have occurred.

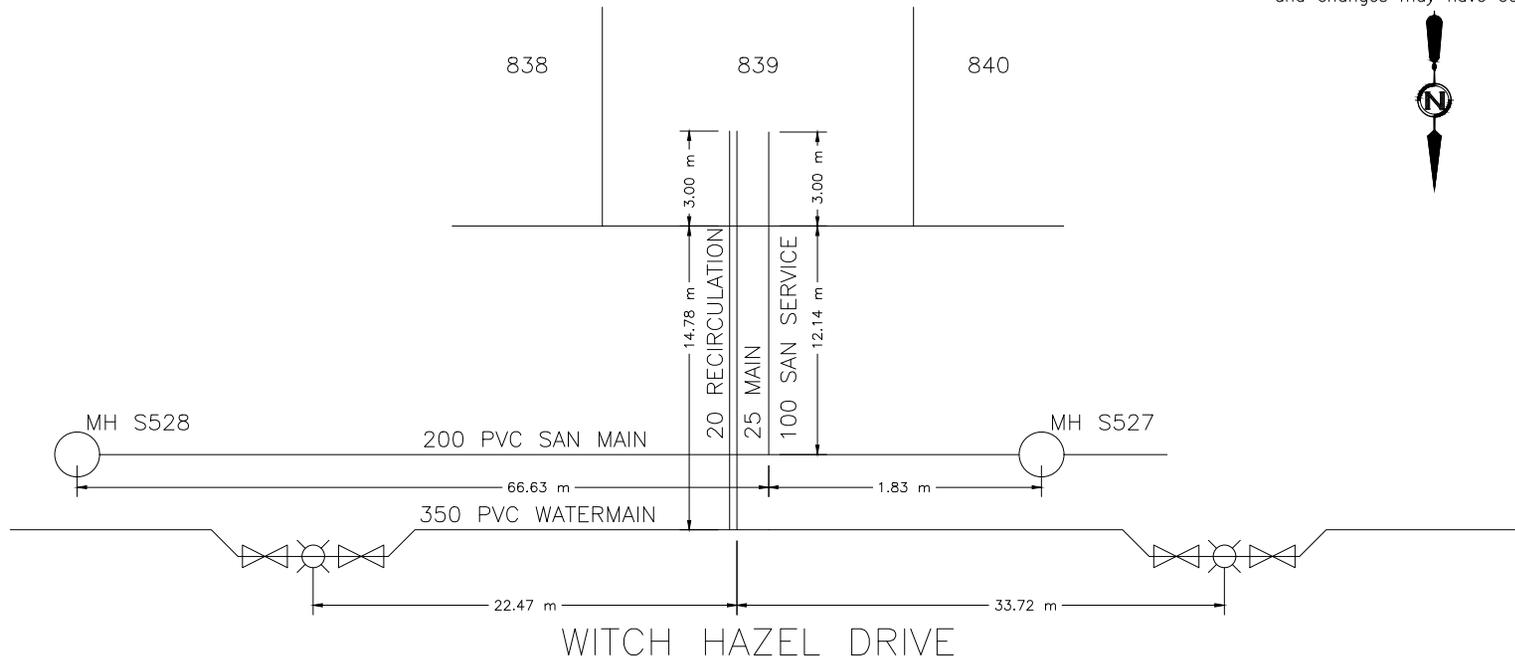



CITY OF WHITEHORSE SERVICE CONNECTION RECORD

FIELD BOOK


No.

ADDRESS 80 Witch Hazel Drive BLOCK LOT 840

DATES		WATER		SEWER	
On at Main 7/26/2019		Depth at P/L: 2.55 m		2.53 m	
On at Building		Depth at Main: 3.06 m		2.90 m	
Frost Plug:		Pipe Size: 25 mm / 20 mm		100 mm	
Memo:	Pipe Material: HDPE		Insul. <u>(Yes)</u> /No		PVC
	Length from Main to P/L: 14.80 m				12.01 m
	Squirt Test:		<u>(Pass)</u> /Fail		N/A
Booster Pump Required:	Yes/No	Frost Protection: Aquaflow/ <u>(Recirc)</u> /Heat Trace/Bleeder		N/A	
PRV Required:	Yes/No	Greased @ CC:		<u>(Yes)</u> /No	
Water Meter Installed:	Yes/No	Continuity Test: <u>(N/A)</u>		Pass/Fail	

CLEARLY INDICATE LOCATION OF CC AND ROUTE OF PIPES ON DRAWING BELOW

1. Show main valves required to isolate this service. 2. All dimensions to be tied to property line 3. All dimensions to be metric 4. Depth @ property line is based on elevation after construction and changes may have occurred.

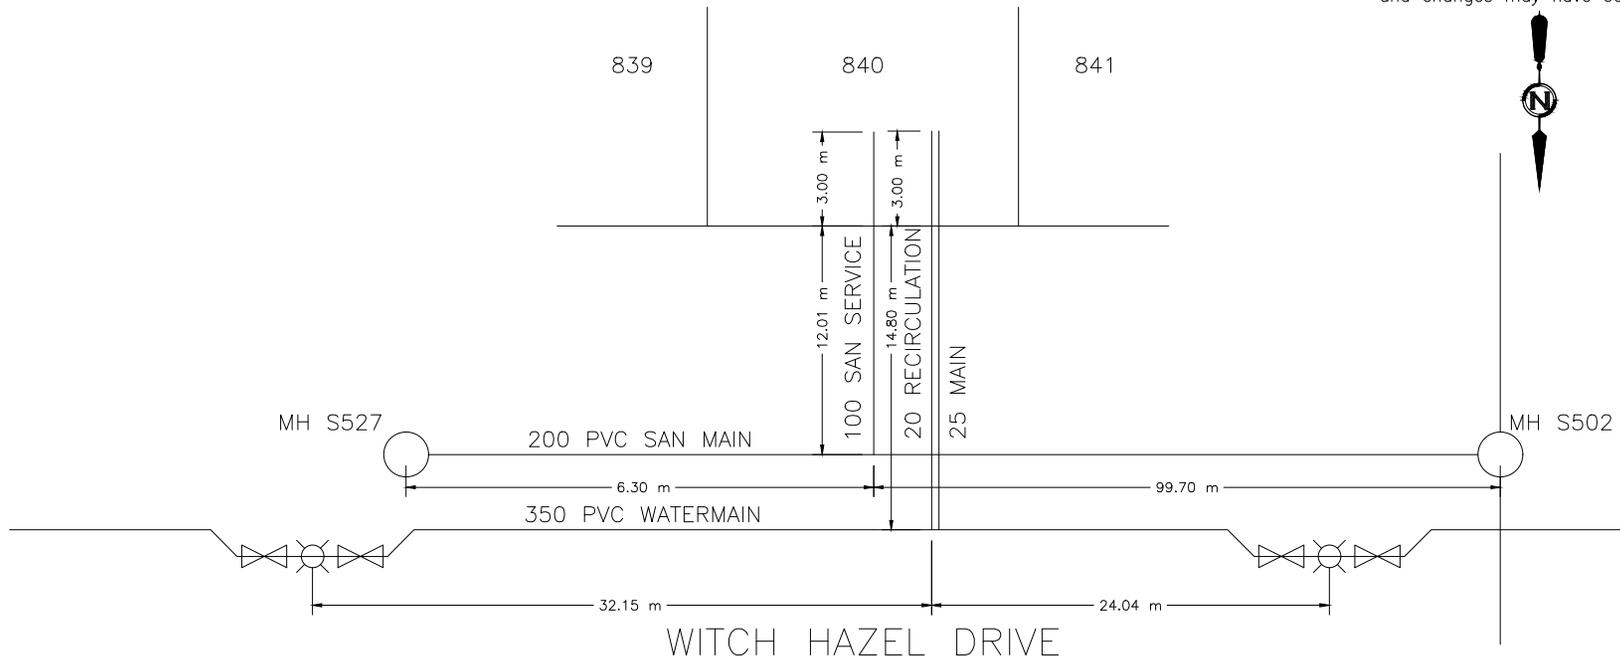



CITY OF WHITEHORSE SERVICE CONNECTION RECORD

FIELD BOOK


No.

ADDRESS 82 Witch Hazel Drive BLOCK LOT 841

DATES		WATER		SEWER	
On at Main	7/29/2019	Depth at P/L:	2.40 m		2.35 m
On at Building		Depth at Main:	3.02 m		2.88 m
Frost Plug:		Pipe Size:	25 mm / 20 mm		100 mm
Memo:		Pipe Material:	HDPE	Insul. <u>(Yes)</u> /No	PVC
		Length from Main to P/L:	14.82 m		12.08 m
		Squirt Test:	<u>(Pass)</u> /Fail		N/A
Booster Pump Required:	Yes/No	Frost Protection:	Aquaflow/ <u>(Recirc)</u> /Heat Trace/Bleeder		N/A
PRV Required:	Yes/No	Greased @ CC:	<u>(Yes)</u> /No		N/A
Water Meter Installed:	Yes/No	Continuity Test:	<u>(N/A)</u> Pass/Fail		N/A

CLEARLY INDICATE LOCATION OF CC AND ROUTE OF PIPES ON DRAWING BELOW

1. Show main valves required to isolate this service.
2. All dimensions to be tied to property line
3. All dimensions to be metric
4. Depth @ property line is based on elevation after construction and changes may have occurred.

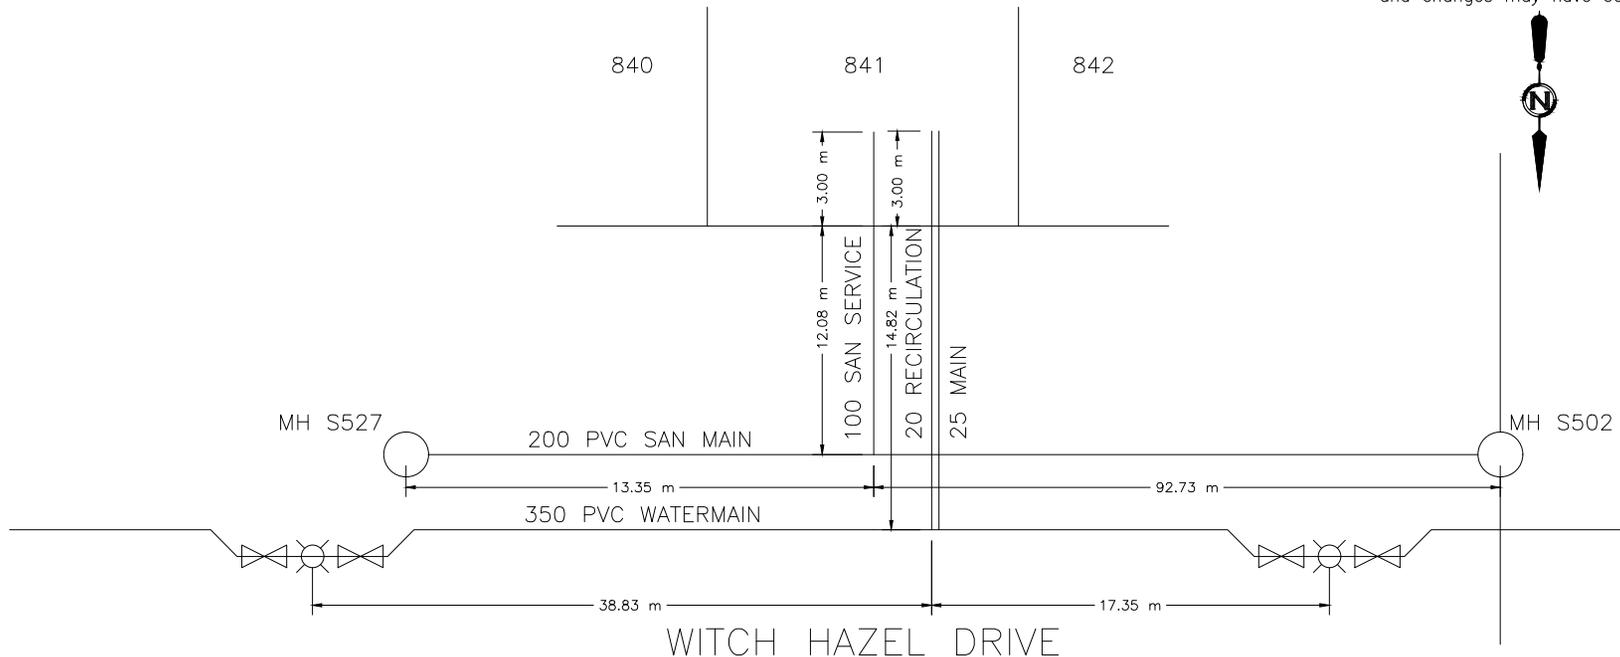



CITY OF WHITEHORSE SERVICE CONNECTION RECORD

FIELD BOOK


No.

ADDRESS 84 Witch Hazel Drive BLOCK LOT 842

DATES		WATER		SEWER
On at Main	7/24/2019	Depth at P/L:	2.16 m	2.38 m
On at Building		Depth at Main:	3.03 m	2.80 m
Frost Plug:		Pipe Size:	25 mm / 20 mm	100 mm
Memo:		Pipe Material:	HDPE Insul. <u>(Yes)</u> /No	PVC Insul. Yes/ <u>(No)</u>
		Length from Main to P/L:	14.82 m	12.03 m
		Squirt Test:	<u>(Pass)</u> /Fail	N/A
Booster Pump Required:	Yes/No	Frost Protection:	Aquaflow/ <u>(Recirc)</u> /Heat Trace/Bleeder	N/A
PRV Required:	Yes/No	Greased @ CC:	<u>(Yes)</u> /No	N/A
Water Meter Installed:	Yes/No	Continuity Test:	<u>(N/A)</u> Pass/Fail	N/A

CLEARLY INDICATE LOCATION OF CC AND ROUTE OF PIPES ON DRAWING BELOW

1. Show main valves required to isolate this service. 2. All dimensions to be tied to property line 3. All dimensions to be metric 4. Depth @ property line is based on elevation after construction and changes may have occurred.

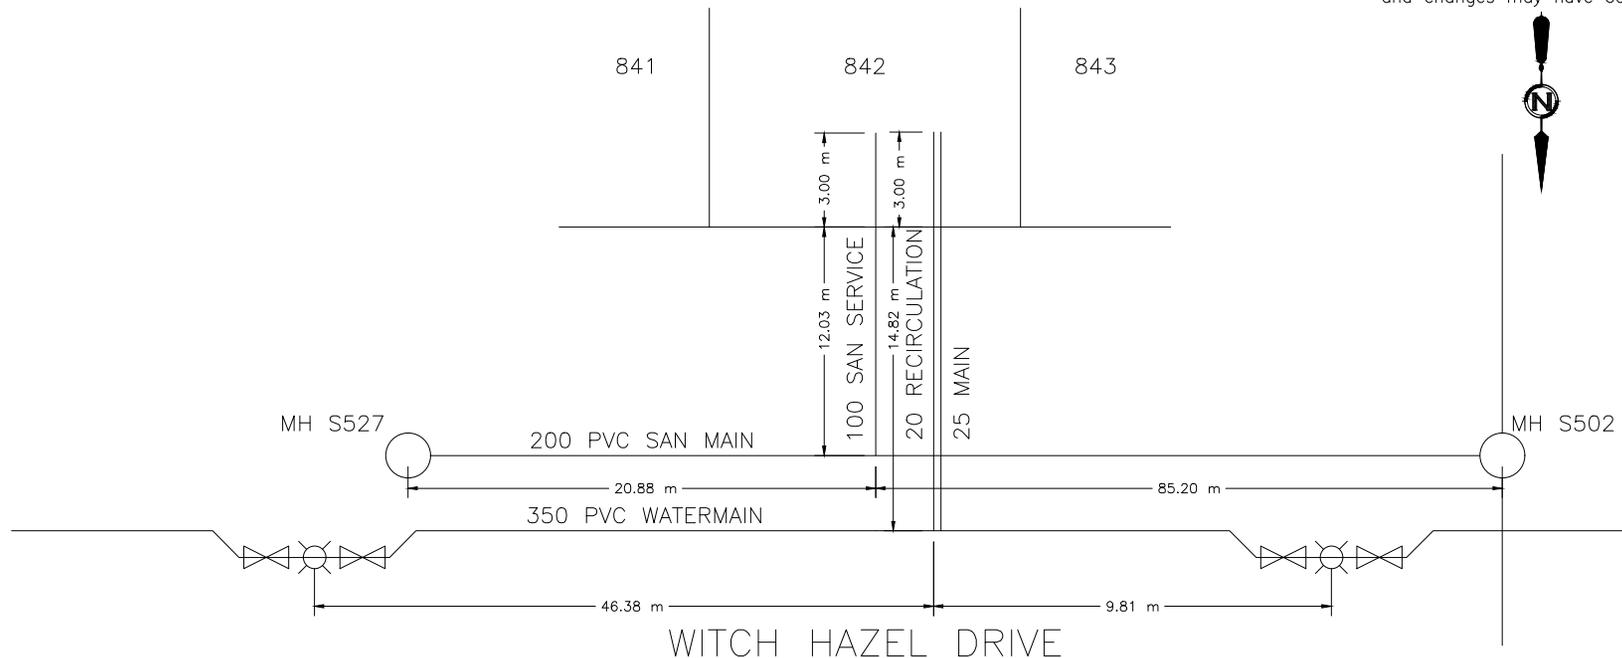



CITY OF WHITEHORSE SERVICE CONNECTION RECORD

FIELD BOOK


No.

ADDRESS 86 Witch Hazel Drive BLOCK LOT 843

DATES	WATER	SEWER
On at Main 7/27/2019	Depth at P/L: 2.43 m	2.36 m
On at Building	Depth at Main: 2.95 m	2.79 m
Frost Plug:	Pipe Size: 25 mm / 20 mm	100 mm
Memo:	Pipe Material: HDPE	Insul. <input checked="" type="checkbox"/> Yes / <input type="checkbox"/> No
	Length from Main to P/L: 16.36 m	PVC
	Squirt Test:	Insul. Yes / <input checked="" type="checkbox"/> No
Booster Pump Required: Yes/No	Frost Protection: Aquaflo / <input checked="" type="checkbox"/> Recirc / Heat Trace / Bleeder	N/A
PRV Required: Yes/No	Greased @ CC: <input checked="" type="checkbox"/> Yes / <input type="checkbox"/> No	N/A
Water Meter Installed: Yes/No	Continuity Test: <input checked="" type="checkbox"/> N/A	Pass/Fail

CLEARLY INDICATE LOCATION OF CC AND ROUTE OF PIPES ON DRAWING BELOW

1. Show main valves required to isolate this service. 2. All dimensions to be tied to property line 3. All dimensions to be metric 4. Depth @ property line is based on elevation after construction and changes may have occurred.

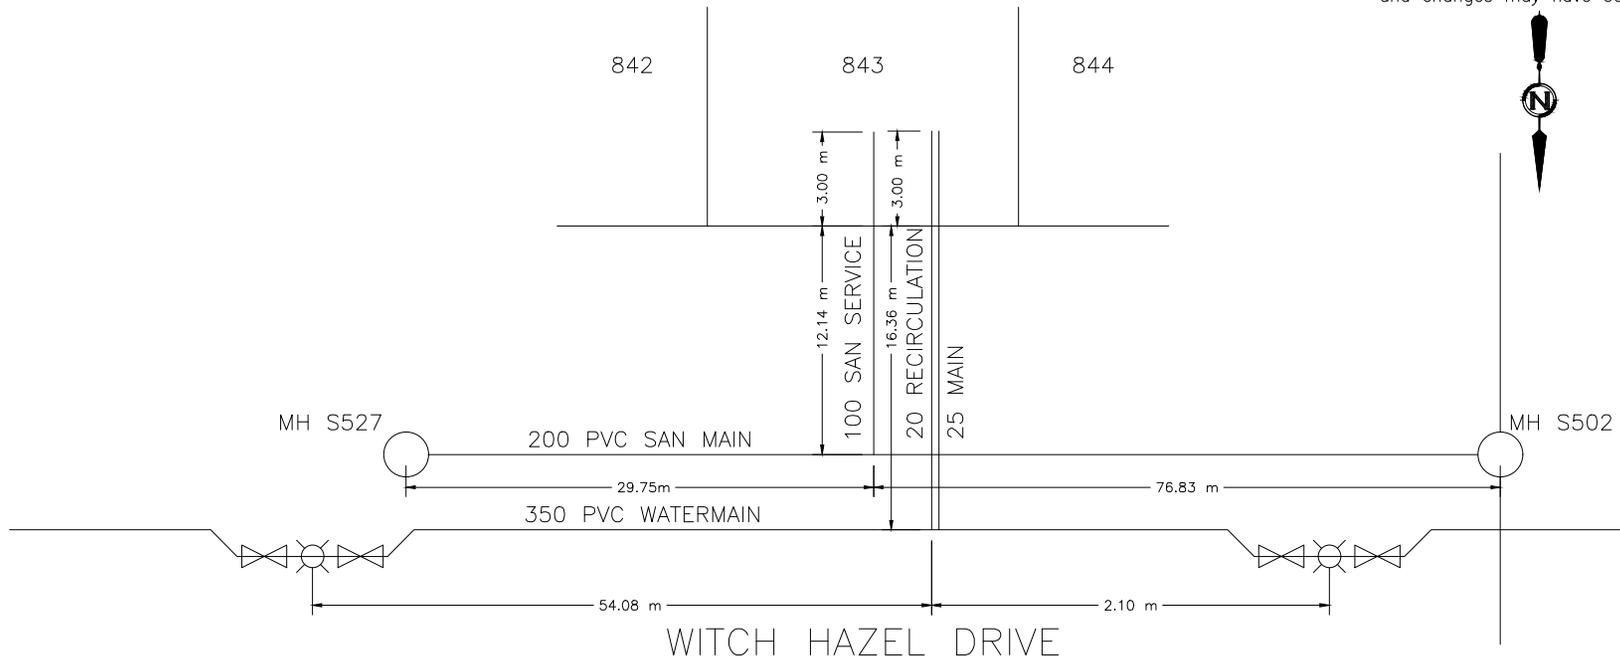



CITY OF WHITEHORSE SERVICE CONNECTION RECORD

FIELD BOOK


No.

ADDRESS 88 Witch Hazel Drive BLOCK LOT 844

DATES	WATER	SEWER
On at Main 7/30/2019	Depth at P/L: 2.45 m	2.37 m
On at Building	Depth at Main: 2.95 m	2.77 m
Frost Plug:	Pipe Size: 25 mm / 20 mm	100 mm
Memo:	Pipe Material: HDPE	Insul. <input checked="" type="checkbox"/> Yes / <input type="checkbox"/> No
	Length from Main to P/L: 14.80 m	PVC
	Squirt Test: <input checked="" type="checkbox"/> Pass / <input type="checkbox"/> Fail	Insul. Yes / <input checked="" type="checkbox"/> No
Booster Pump Required: <input type="checkbox"/> Yes / <input checked="" type="checkbox"/> No	Frost Protection: Aquaflo / <input checked="" type="checkbox"/> Recirc / Heat Trace / Bleeder	N/A
PRV Required: <input type="checkbox"/> Yes / <input checked="" type="checkbox"/> No	Greased @ CC: <input checked="" type="checkbox"/> Yes / <input type="checkbox"/> No	N/A
Water Meter Installed: <input type="checkbox"/> Yes / <input checked="" type="checkbox"/> No	Continuity Test: <input checked="" type="checkbox"/> N/A	Pass / Fail

CLEARLY INDICATE LOCATION OF CC AND ROUTE OF PIPES ON DRAWING BELOW

1. Show main valves required to isolate this service. 2. All dimensions to be tied to property line 3. All dimensions to be metric 4. Depth @ property line is based on elevation after construction and changes may have occurred.

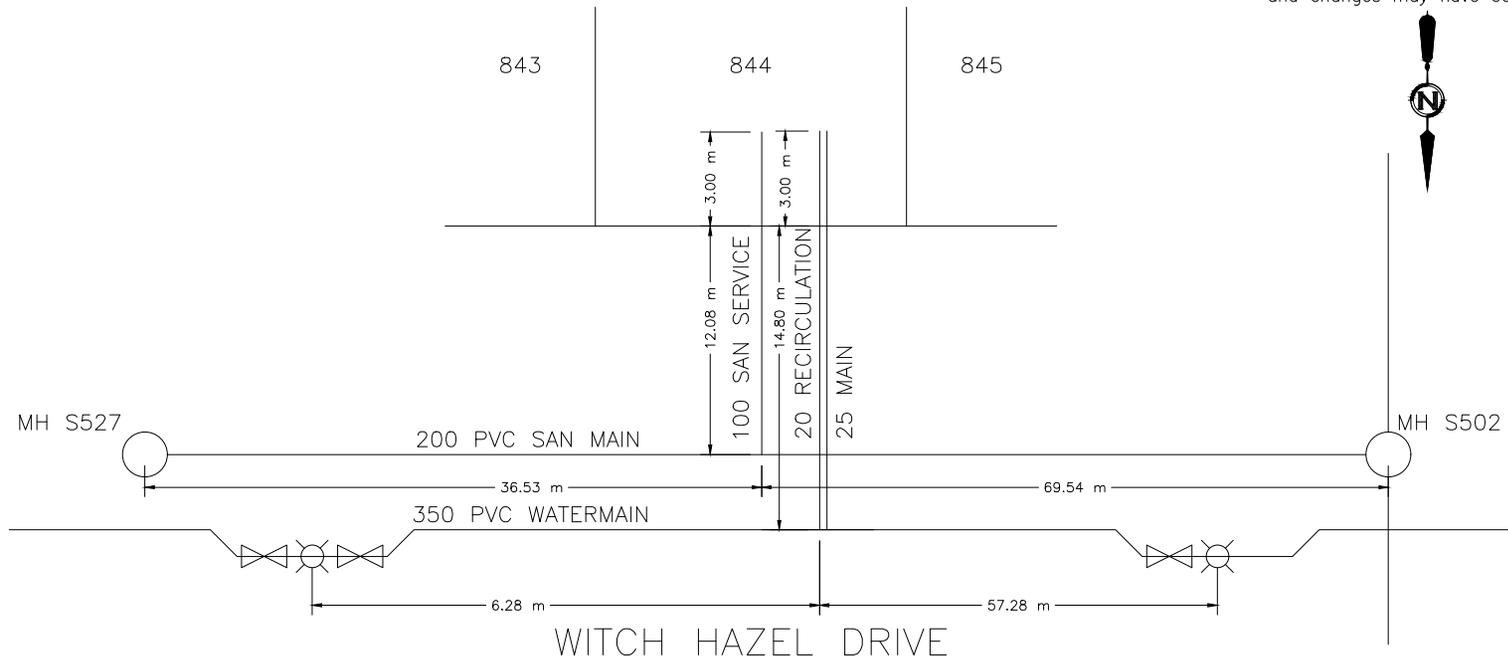



CITY OF WHITEHORSE SERVICE CONNECTION RECORD

FIELD BOOK


No.

ADDRESS 90 Witch Hazel Drive BLOCK LOT 845

DATES	WATER	SEWER
On at Main 7/25/2019	Depth at P/L: 2.19 m	2.20 m
On at Building	Depth at Main: 3.09 m	2.80 m
Frost Plug:	Pipe Size: 25 mm / 20 mm	100 mm
Memo:	Pipe Material: HDPE	Insul. (Yes/No) PVC
	Length from Main to P/L: 14.70 m	12.04 m
	Squirt Test: (Pass/Fail)	N/A
Booster Pump Required: Yes/No	Frost Protection: Aquaflo/Recirc/Heat Trace/Bleeder	N/A
PRV Required: Yes/No	Greased @ CC: (Yes/No)	N/A
Water Meter Installed: Yes/No	Continuity Test: (N/A)	N/A

CLEARLY INDICATE LOCATION OF CC AND ROUTE OF PIPES ON DRAWING BELOW

1. Show main valves required to isolate this service. 2. All dimensions to be tied to property line 3. All dimensions to be metric 4. Depth @ property line is based on elevation after construction and changes may have occurred.

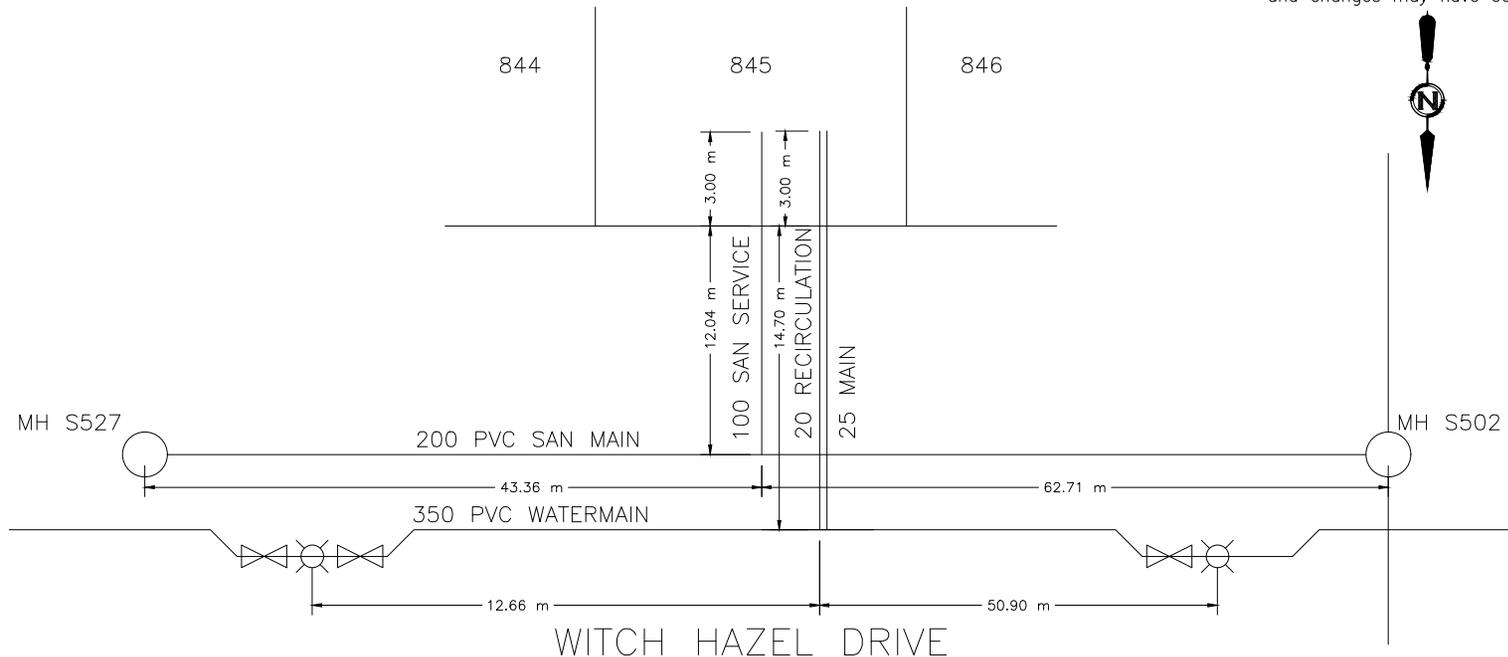



CITY OF WHITEHORSE SERVICE CONNECTION RECORD

FIELD BOOK


No. _____

ADDRESS 92 Witch Hazel Drive BLOCK LOT 846

DATES	WATER	SEWER
On at Main 7/30/2019	Depth at P/L: 2.38 m	2.30 m
On at Building	Depth at Main: 3.10 m	2.83 m
Frost Plug:	Pipe Size: 25 mm / 20 mm	100 mm
Memo:	Pipe Material: HDPE Insul. (Yes/No)	PVC Insul. (Yes/No)
	Length from Main to P/L: 14.88 m	12.13 m
	Squirt Test: (Pass/Fail)	N/A
Booster Pump Required: Yes/No	Frost Protection: Aquaflo/Recirc/Heat Trace/Bleeder	N/A
PRV Required: Yes/No	Greased @ CC: (Yes/No)	N/A
Water Meter Installed: Yes/No	Continuity Test: (N/A) Pass/Fail	N/A

CLEARLY INDICATE LOCATION OF CC AND ROUTE OF PIPES ON DRAWING BELOW

1. Show main valves required to isolate this service. 2. All dimensions to be tied to property line 3. All dimensions to be metric 4. Depth @ property line is based on elevation after construction and changes may have occurred.

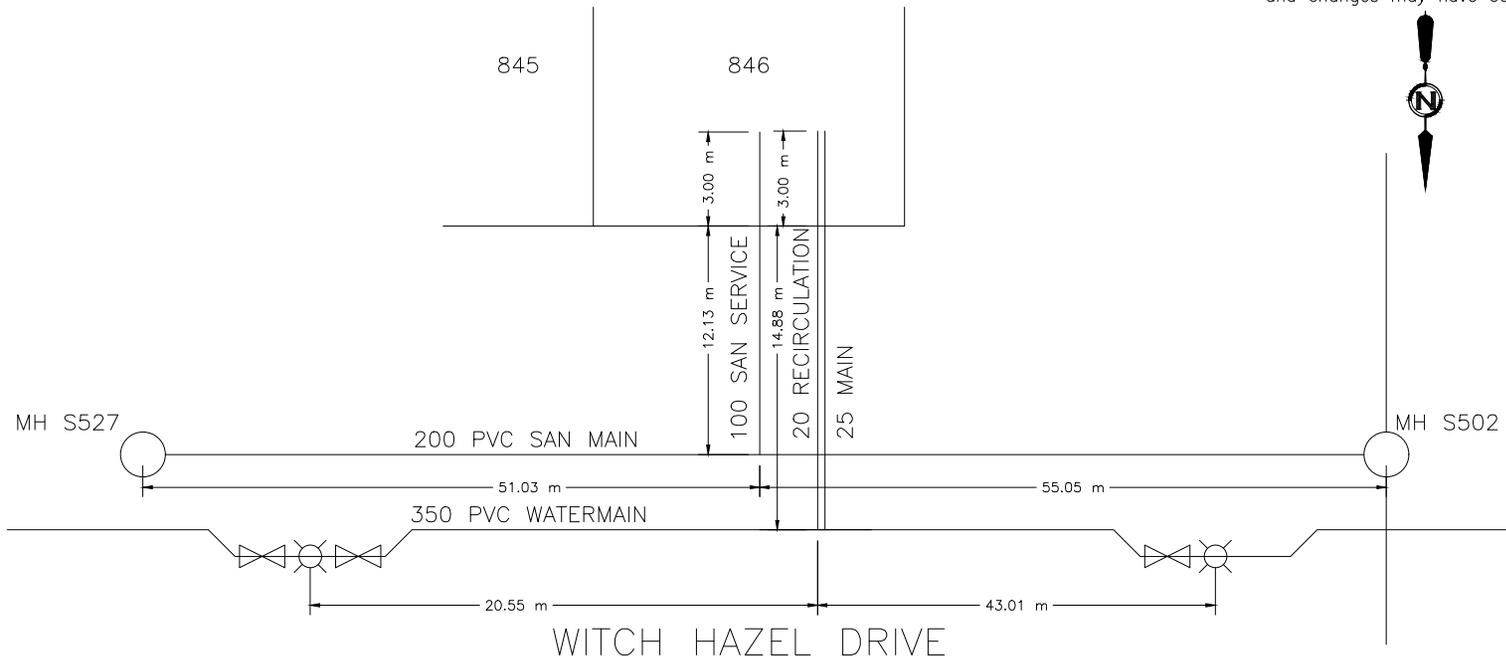



CITY OF WHITEHORSE SERVICE CONNECTION RECORD

FIELD BOOK


No.

ADDRESS 61 Tyrell Crescent BLOCK LOT 847

DATES	WATER	SEWER
On at Main 9/4/2019	Depth at P/L: 2.25 m	2.22 m
On at Building	Depth at Main: 2.32 m	2.47 m
Frost Plug:	Pipe Size: 25 mm / 20 mm	100 mm
Memo:	Pipe Material: HDPE Insul. <u>(Yes)</u> /No	PVC Insul. <u>(Yes)</u> /No
	Length from Main to P/L: 5.78 m	8.97 m
	Squirt Test: <u>(Pass)</u> /Fail	N/A
Booster Pump Required: Yes/No	Frost Protection: Aquaflo/ <u>(Recirc)</u> /Heat Trace/Bleeder	N/A
PRV Required: Yes/No	Greased @ CC: <u>(Yes)</u> /No	N/A
Water Meter Installed: Yes/No	Continuity Test: <u>(N/A)</u> Pass/Fail	N/A

CLEARLY INDICATE LOCATION OF CC AND ROUTE OF PIPES ON DRAWING BELOW

1. Show main valves required to isolate this service. 2. All dimensions to be tied to property line 3. All dimensions to be metric 4. Depth @ property line is based on elevation after construction and changes may have occurred.

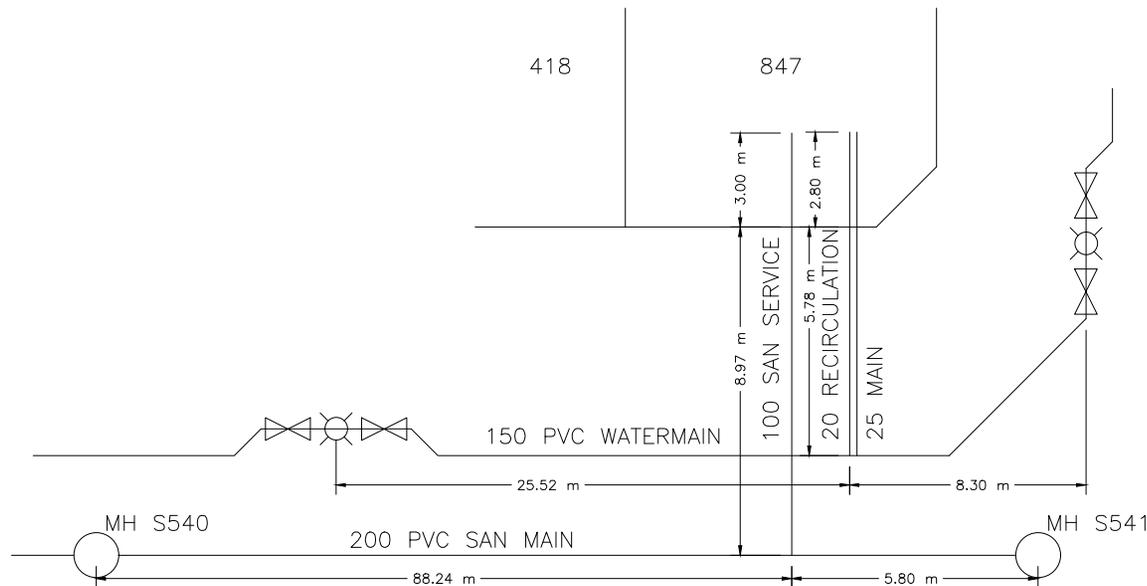

TYRELL CRESCENT

TYRELL CRESCENT



CITY OF WHITEHORSE SERVICE CONNECTION RECORD

FIELD BOOK


No.

ADDRESS 63 Tyrell Crescent BLOCK LOT 848

DATES	WATER	SEWER
On at Main 9/5/2019	Depth at P/L: 2.10 m	2.05 m
On at Building	Depth at Main: 2.24 m	2.47 m
Frost Plug:	Pipe Size: 25 mm / 20 mm	100 mm
Memo:	Pipe Material: HDPE Insul. <u>(Yes)</u> /No	PVC Insul. <u>(Yes)</u> /No
	Length from Main to P/L: 5.79 m	8.94 m
	Squirt Test: <u>(Pass)</u> /Fail	N/A
Booster Pump Required: Yes/No	Frost Protection: Aquaflo/ <u>(Recirc)</u> /Heat Trace/Bleeder	N/A
PRV Required: Yes/No	Greased @ CC: <u>(Yes)</u> /No	N/A
Water Meter Installed: Yes/No	Continuity Test: <u>(N/A)</u> Pass/Fail	N/A

CLEARLY INDICATE LOCATION OF CC AND ROUTE OF PIPES ON DRAWING BELOW

1. Show main valves required to isolate this service. 2. All dimensions to be tied to property line 3. All dimensions to be metric 4. Depth @ property line is based on elevation after construction and changes may have occurred.

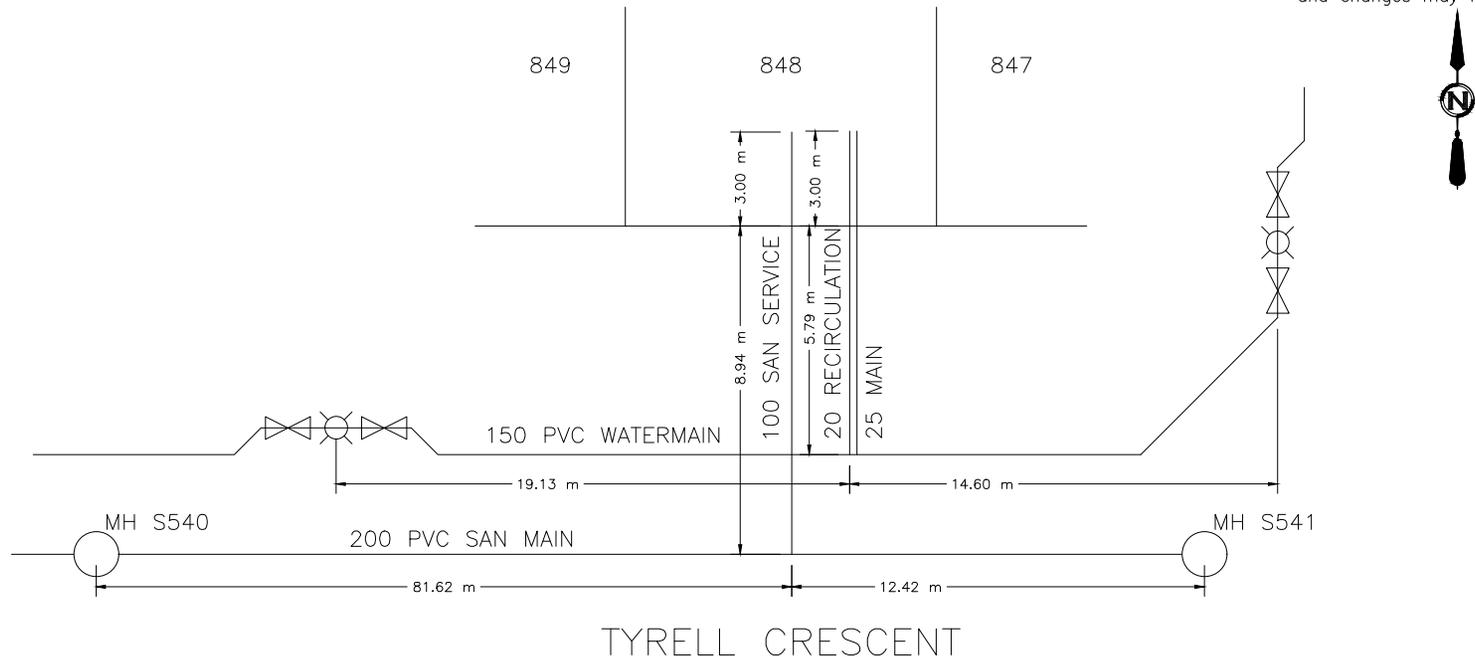



CITY OF WHITEHORSE SERVICE CONNECTION RECORD

FIELD BOOK


No.

ADDRESS 65 Tyrell Crescent BLOCK LOT 849

DATES	WATER	SEWER
On at Main 9/7/2019	Depth at P/L: 2.16 m	2.12 m
On at Building	Depth at Main: 2.24 m	2.49 m
Frost Plug:	Pipe Size: 25 mm / 20 mm	100 mm
Memo:	Pipe Material: HDPE Insul. <u>(Yes)</u> /No	PVC Insul. <u>(Yes)</u> /No
	Length from Main to P/L: 5.78 m	8.96 m
	Squirt Test: <u>(Pass)</u> /Fail	N/A
Booster Pump Required: Yes/No	Frost Protection: Aquaflow/ <u>(Recirc)</u> /Heat Trace/Bleeder	N/A
PRV Required: Yes/No	Greased @ CC: <u>(Yes)</u> /No	N/A
Water Meter Installed: Yes/No	Continuity Test: <u>(N/A)</u> Pass/Fail	N/A

CLEARLY INDICATE LOCATION OF CC AND ROUTE OF PIPES ON DRAWING BELOW

1. Show main valves required to isolate this service. 2. All dimensions to be tied to property line 3. All dimensions to be metric 4. Depth @ property line is based on elevation after construction and changes may have occurred.

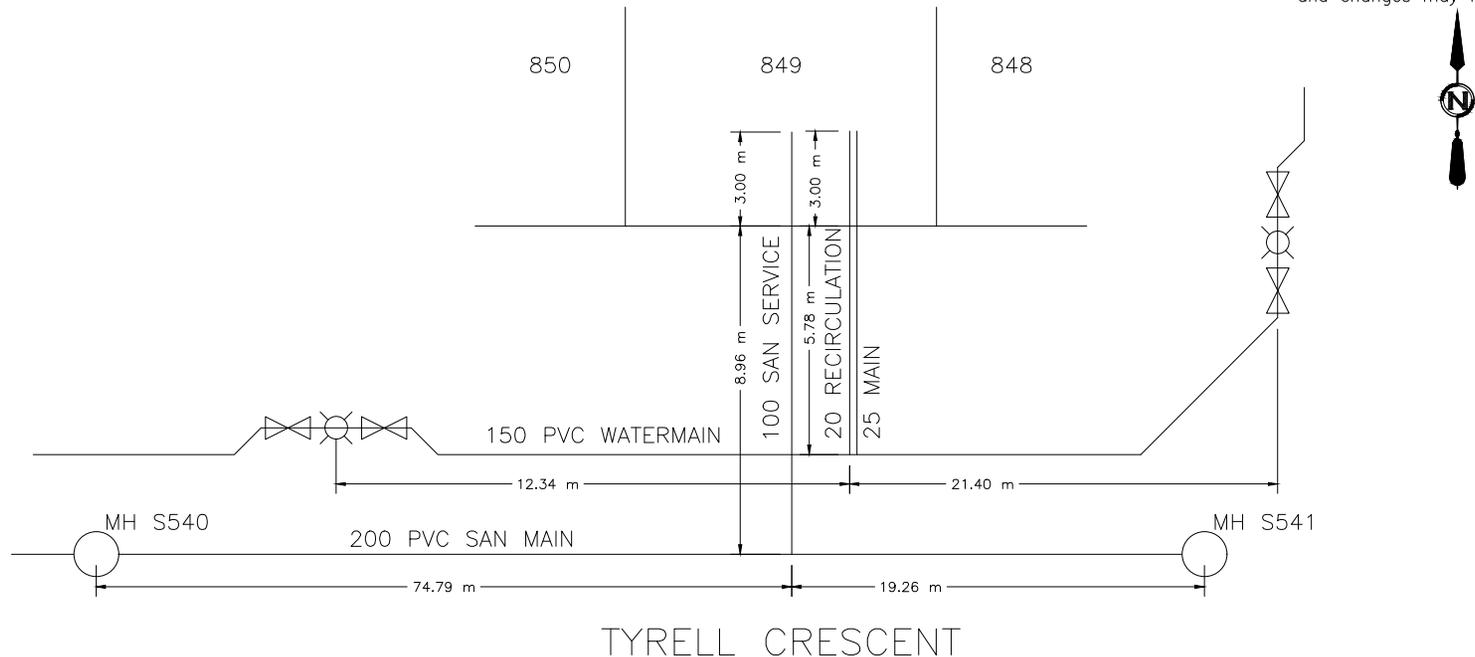

TYRELL CRESCENT



CITY OF WHITEHORSE SERVICE CONNECTION RECORD

FIELD BOOK


No.

ADDRESS 67 Tyrell Crescent BLOCK LOT 850

DATES		WATER	SEWER
On at Main 9/4/2019		Depth at P/L: 2.15 m	2.14 m
On at Building		Depth at Main: 2.24 m	2.47 m
Frost Plug:		Pipe Size: 25 mm / 20 mm	100 mm
Memo:	Pipe Material: HDPE	Insul. <u>(Yes)</u> /No	PVC Insul. <u>(Yes)</u> /No
	Length from Main to P/L: 5.68 m		8.99 m
	Squirt Test:	<u>(Pass)</u> /Fail	N/A
Booster Pump Required:	Yes/No	Frost Protection: Aquaflow/ <u>(Recirc)</u> /Heat Trace/Bleeder	N/A
PRV Required:	Yes/No	Greased @ CC: <u>(Yes)</u> /No	N/A
Water Meter Installed:	Yes/No	Continuity Test: <u>(N/A)</u> Pass/Fail	N/A

CLEARLY INDICATE LOCATION OF CC AND ROUTE OF PIPES ON DRAWING BELOW

1. Show main valves required to isolate this service. 2. All dimensions to be tied to property line 3. All dimensions to be metric 4. Depth @ property line is based on elevation after construction and changes may have occurred.

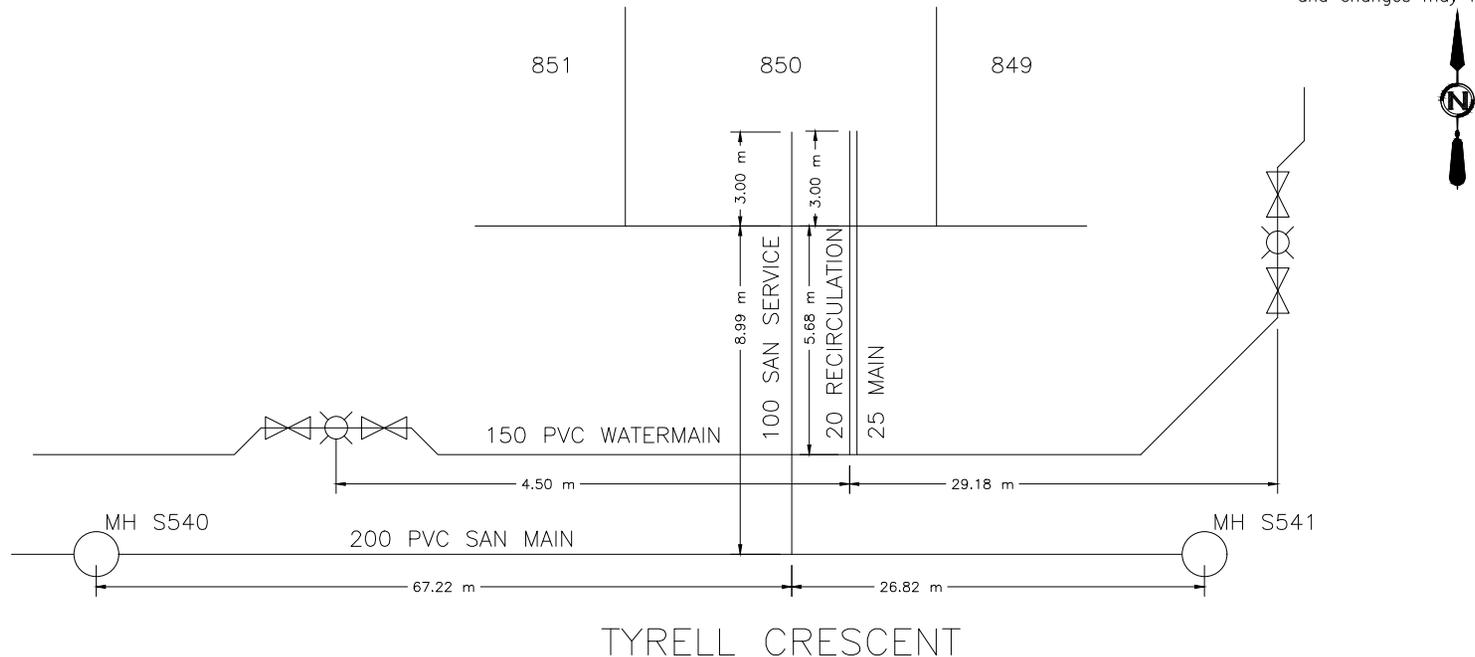



CITY OF WHITEHORSE SERVICE CONNECTION RECORD

FIELD BOOK


No. _____

ADDRESS 69 Tyrell Crescent BLOCK _____ LOT 851

DATES	WATER	SEWER
On at Main 9/5/2019	Depth at P/L: 2.14 m	2.13 m
On at Building	Depth at Main: 2.24 m	2.49 m
Frost Plug:	Pipe Size: 25 mm / 20 mm	100 mm
Memo:	Pipe Material: HDPE Insul. <u>(Yes)</u> /No	PVC Insul. <u>(Yes)</u> /No
	Length from Main to P/L: 5.76 m	9.02 m
	Squirt Test: <u>(Pass)</u> /Fail	N/A
Booster Pump Required: Yes/No	Frost Protection: Aquaflow/ <u>(Recirc)</u> /Heat Trace/Bleeder	N/A
PRV Required: Yes/No	Greased @ CC: <u>(Yes)</u> /No	N/A
Water Meter Installed: Yes/No	Continuity Test: <u>(N/A)</u> Pass/Fail	N/A

CLEARLY INDICATE LOCATION OF CC AND ROUTE OF PIPES ON DRAWING BELOW

1. Show main valves required to isolate this service. 2. All dimensions to be tied to property line 3. All dimensions to be metric 4. Depth @ property line is based on elevation after construction and changes may have occurred.

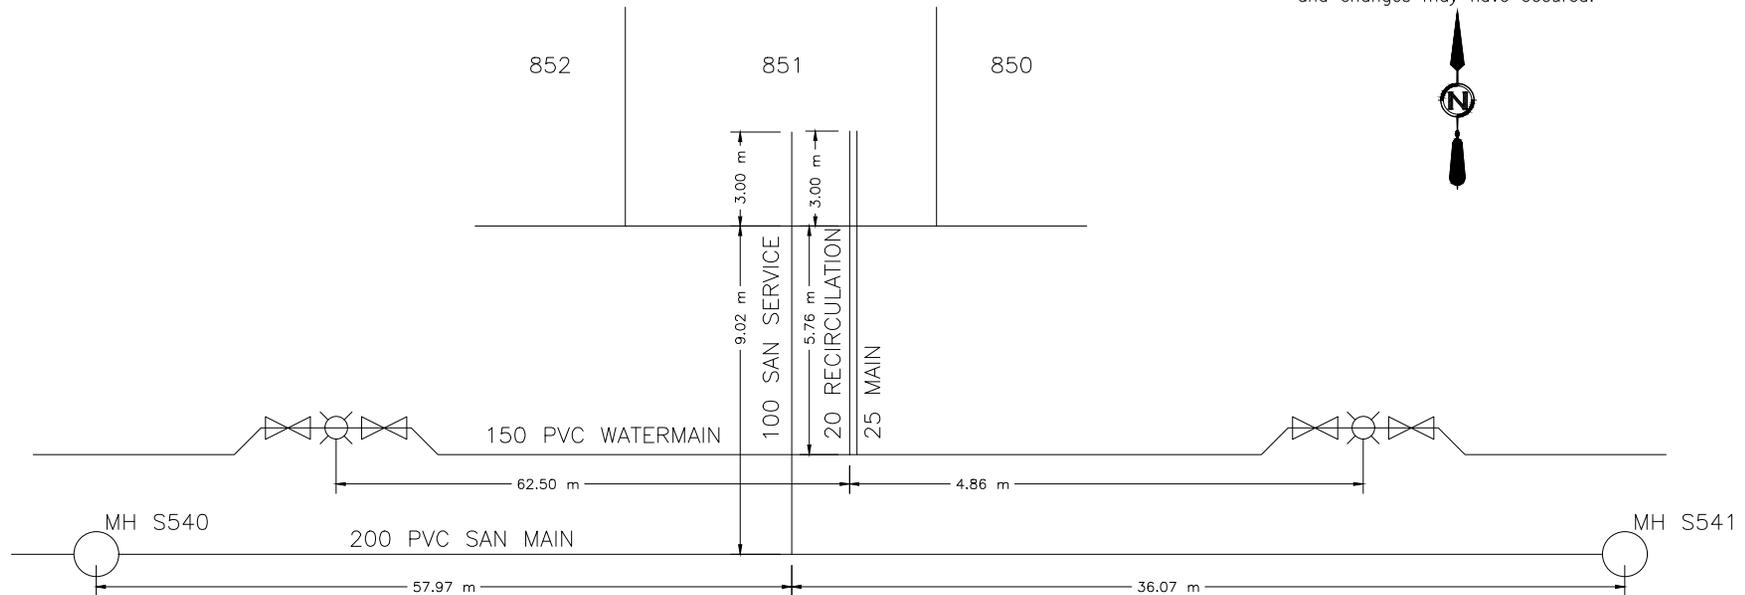

TYRELL CRESCENT



CITY OF WHITEHORSE SERVICE CONNECTION RECORD

FIELD BOOK


No.

ADDRESS 71 Tyrell Crescent BLOCK LOT 852

DATES		WATER		SEWER	
On at Main 9/6/2019		Depth at P/L: 2.15 m		2.10 m	
On at Building		Depth at Main: 2.22 m		2.45 m	
Frost Plug:		Pipe Size: 25 mm / 20 mm		100 mm	
Memo:		Pipe Material: HDPE Insul. <u>(Yes)</u> /No		PVC Insul. <u>(Yes)</u> /No	
		Length from Main to P/L: 5.80 m		9.01 m	
		Squirt Test: <u>(Pass)</u> /Fail		N/A	
Booster Pump Required:	Yes/No	Frost Protection: Aquaflo/ <u>(Recirc)</u> /Heat Trace/Bleeder		N/A	
PRV Required:	Yes/No	Greased @ CC: <u>(Yes)</u> /No		N/A	
Water Meter Installed:	Yes/No	Continuity Test: <u>(N/A)</u> Pass/Fail		N/A	

CLEARLY INDICATE LOCATION OF CC AND ROUTE OF PIPES ON DRAWING BELOW

1. Show main valves required to isolate this service. 2. All dimensions to be tied to property line 3. All dimensions to be metric 4. Depth @ property line is based on elevation after construction and changes may have occurred.

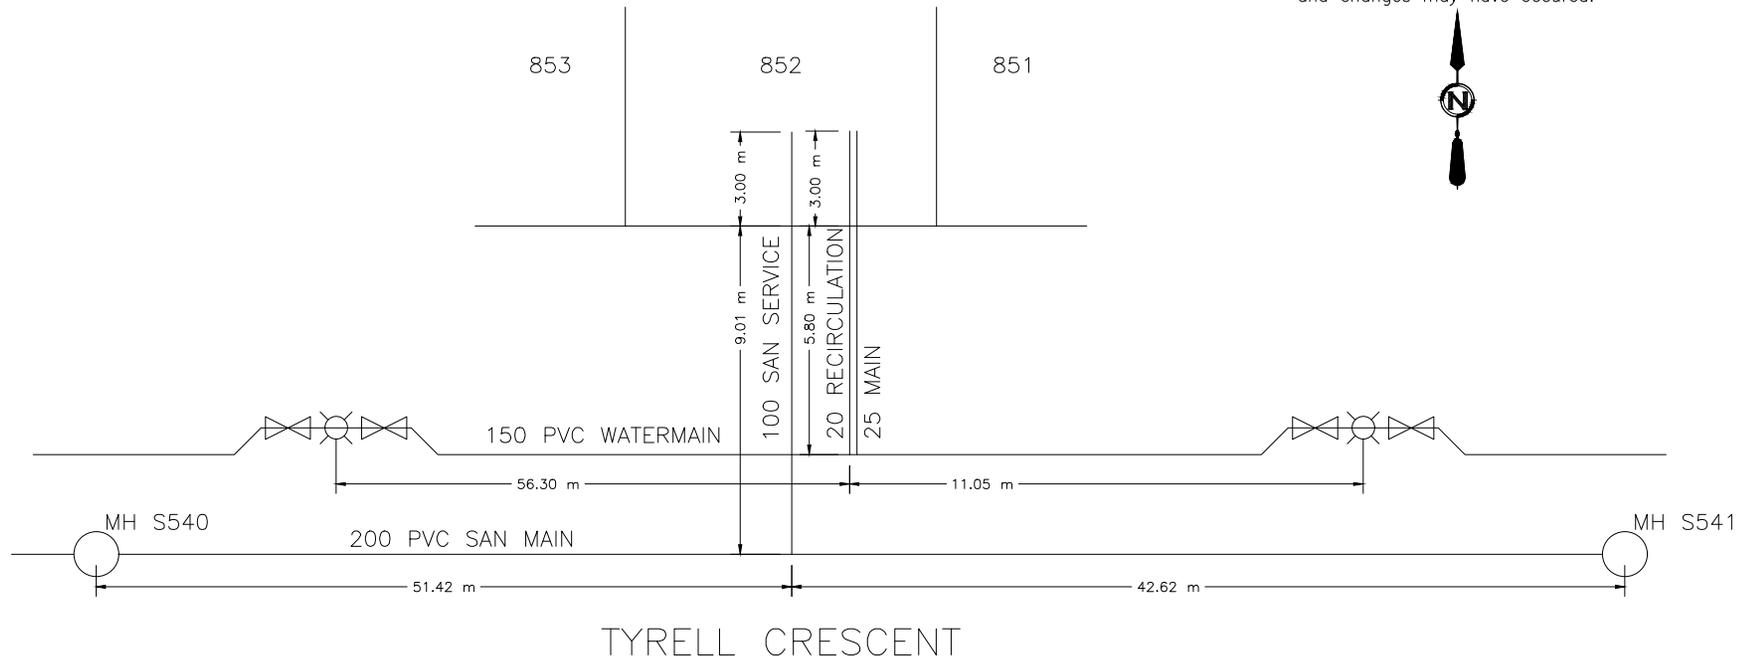



CITY OF WHITEHORSE SERVICE CONNECTION RECORD

FIELD BOOK


No.

ADDRESS 73 Tyrell Crescent BLOCK LOT 853

DATES	WATER	SEWER
On at Main 9/4/2019	Depth at P/L: 2.14 m	2.17 m
On at Building	Depth at Main: 2.07 m	2.53 m
Frost Plug:	Pipe Size: 25 mm / 20 mm	100 mm
Memo:	Pipe Material: HDPE Insul. <u>(Yes)</u> /No	PVC Insul. <u>(Yes)</u> /No
	Length from Main to P/L: 5.78 m	8.89 m
	Squirt Test: <u>(Pass)</u> /Fail	N/A
Booster Pump Required: Yes/No	Frost Protection: Aquaflo/ <u>(Recirc)</u> /Heat Trace/Bleeder	N/A
PRV Required: Yes/No	Greased @ CC: <u>(Yes)</u> /No	N/A
Water Meter Installed: Yes/No	Continuity Test: <u>(N/A)</u> Pass/Fail	N/A

CLEARLY INDICATE LOCATION OF CC AND ROUTE OF PIPES ON DRAWING BELOW

1. Show main valves required to isolate this service. 2. All dimensions to be tied to property line 3. All dimensions to be metric 4. Depth @ property line is based on elevation after construction and changes may have occurred.

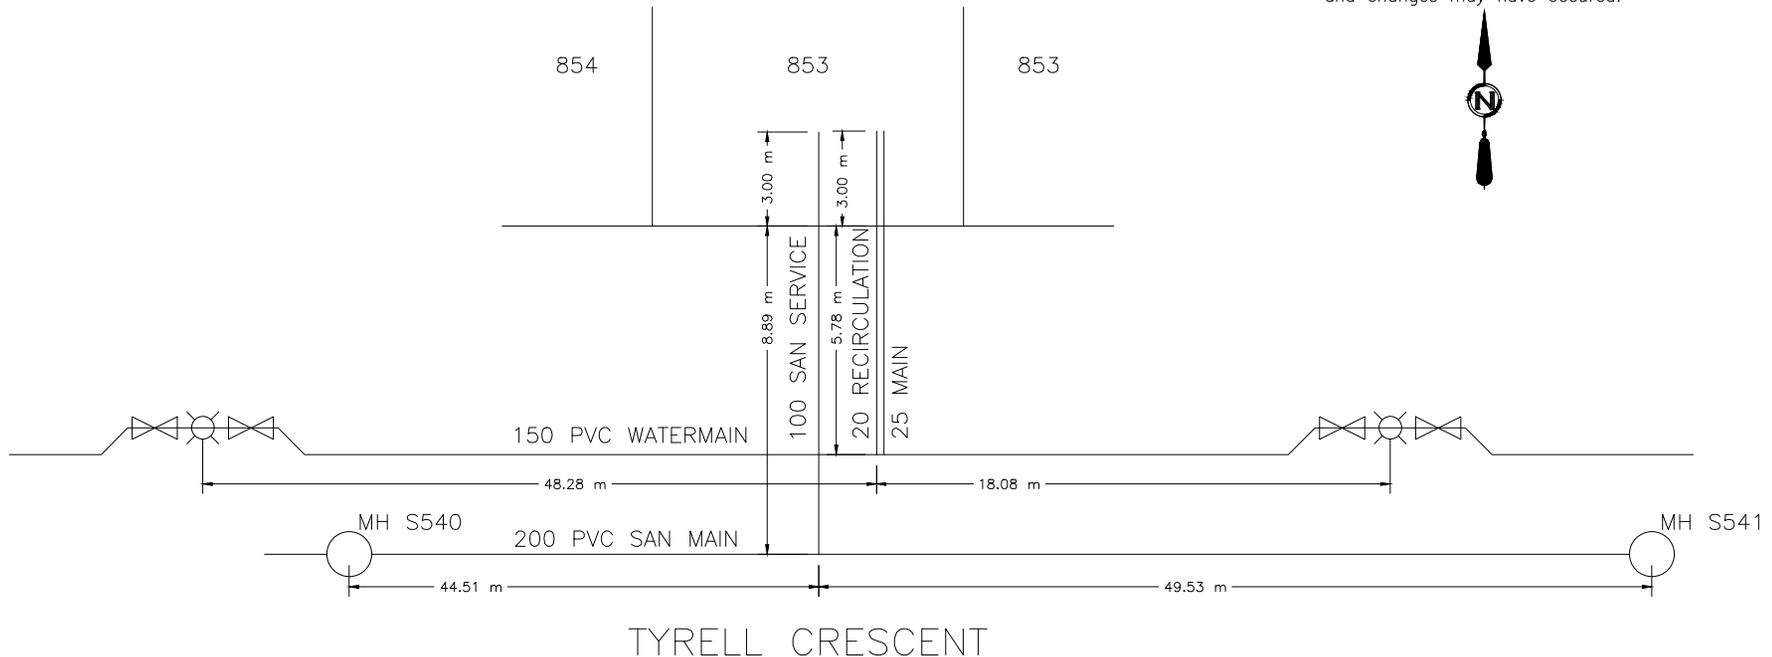



CITY OF WHITEHORSE SERVICE CONNECTION RECORD

FIELD BOOK


No.

ADDRESS 75 Tyrell Crescent BLOCK LOT 854

	DATES	WATER	SEWER
On at Main	9/5/2019	Depth at P/L: 2.15 m	2.14 m
On at Building		Depth at Main: 2.24 m	2.51 m
Frost Plug:		Pipe Size: 25 mm / 20 mm	100 mm
Memo:		Pipe Material: HDPE	PVC
		Insul. <input checked="" type="checkbox"/> Yes/No	Insul. <input checked="" type="checkbox"/> Yes/No
		Length from Main to P/L: 5.79 m	8.99 m
		Squirt Test: <input checked="" type="checkbox"/> Pass/Fail	N/A
Booster Pump Required:	Yes/No	Frost Protection: Aquaflo/ <input checked="" type="checkbox"/> Recirc/Heat Trace/Bleeder	N/A
PRV Required:	Yes/No	Greased @ CC: <input checked="" type="checkbox"/> Yes/No	N/A
Water Meter Installed:	Yes/No	Continuity Test: <input checked="" type="checkbox"/> N/A	N/A

CLEARLY INDICATE LOCATION OF CC AND ROUTE OF PIPES ON DRAWING BELOW

1. Show main valves required to isolate this service. 2. All dimensions to be tied to property line 3. All dimensions to be metric 4. Depth @ property line is based on elevation after construction and changes may have occurred.

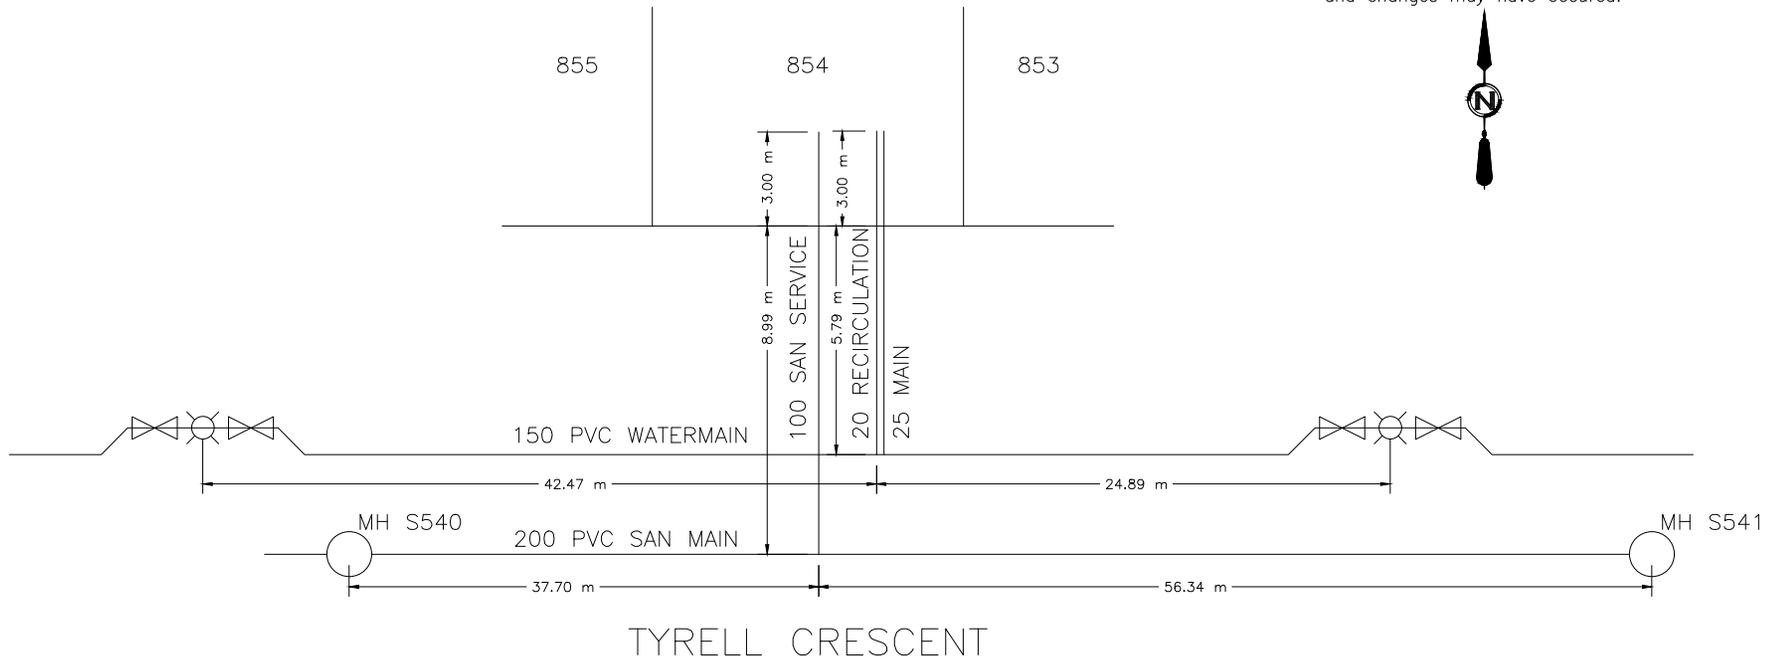



CITY OF WHITEHORSE SERVICE CONNECTION RECORD

FIELD BOOK


No.

ADDRESS 77 Tyrell Crescent BLOCK LOT 855

DATES		WATER		SEWER	
On at Main 9/6/2019		Depth at P/L: 2.21 m		2.21 m	
On at Building		Depth at Main: 2.29 m		2.54 m	
Frost Plug:		Pipe Size: 25 mm / 20 mm		100 mm	
Memo:		Pipe Material: HDPE Insul. <u>(Yes)</u> /No		PVC Insul. <u>(Yes)</u> /No	
		Length from Main to P/L: 5.79 m		8.97 m	
		Squirt Test: <u>(Pass)</u> /Fail		N/A	
Booster Pump Required:	Yes/No	Frost Protection: Aquaflow/ <u>(Recirc)</u> /Heat Trace/Bleeder		N/A	
PRV Required:	Yes/No	Greased @ CC: <u>(Yes)</u> /No		N/A	
Water Meter Installed:	Yes/No	Continuity Test: <u>(N/A)</u> Pass/Fail		N/A	

CLEARLY INDICATE LOCATION OF CC AND ROUTE OF PIPES ON DRAWING BELOW

1. Show main valves required to isolate this service. 2. All dimensions to be tied to property line 3. All dimensions to be metric 4. Depth @ property line is based on elevation after construction and changes may have occurred.

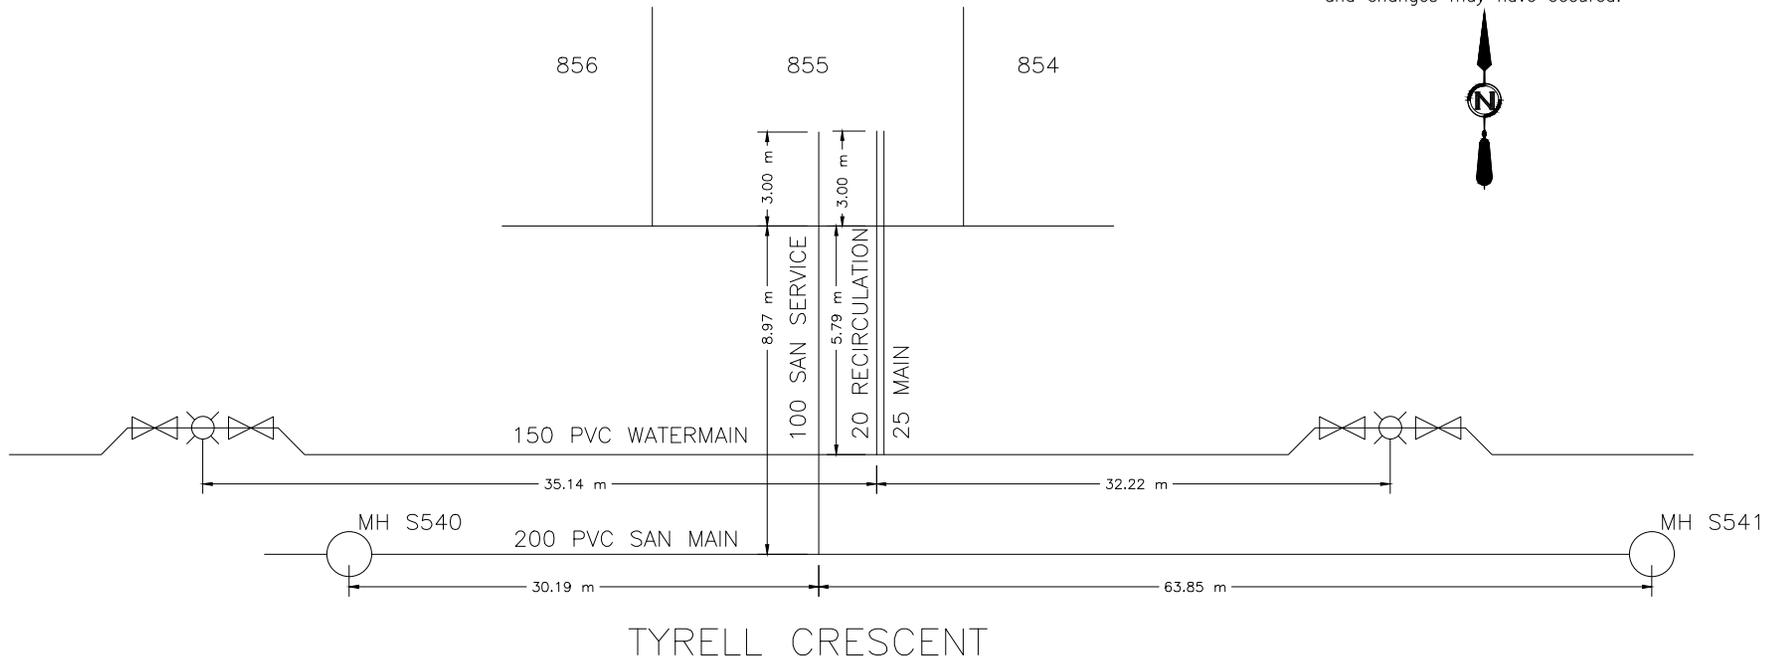



CITY OF WHITEHORSE SERVICE CONNECTION RECORD

FIELD BOOK


No. _____

ADDRESS 79 Tyrell Crescent BLOCK _____ LOT 856

	DATES	WATER	SEWER
On at Main	9/3/2019	Depth at P/L: 2.17 m	2.17 m
On at Building		Depth at Main: 2.48 m	2.54 m
Frost Plug:		Pipe Size: 25 mm / 20 mm	100 mm
Memo:		Pipe Material: HDPE Insul. <u>(Yes)</u> /No	PVC Insul. <u>(Yes)</u> /No
		Length from Main to P/L: 5.83 m	9.03 m
		Squirt Test: <u>(Pass)</u> /Fail	N/A
Booster Pump Required:	Yes/No	Frost Protection: Aquaflow/ <u>(Recirc)</u> /Heat Trace/Bleeder	N/A
PRV Required:	Yes/No	Greased @ CC: <u>(Yes)</u> /No	N/A
Water Meter Installed:	Yes/No	Continuity Test: <u>(N/A)</u> Pass/Fail	N/A

CLEARLY INDICATE LOCATION OF CC AND ROUTE OF PIPES ON DRAWING BELOW

1. Show main valves required to isolate this service. 2. All dimensions to be tied to property line 3. All dimensions to be metric 4. Depth @ property line is based on elevation after construction and changes may have occurred.

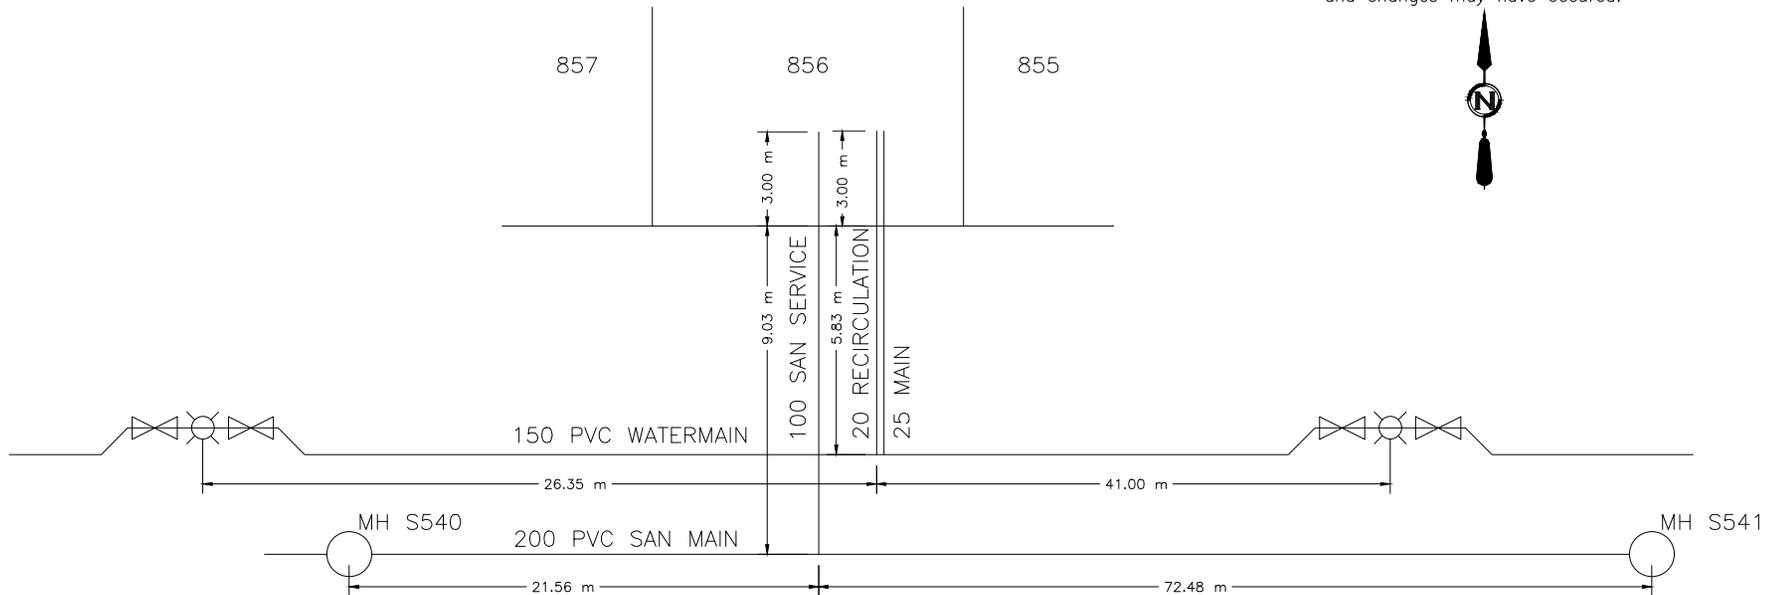

TYRELL CRESCENT



CITY OF WHITEHORSE SERVICE CONNECTION RECORD

FIELD BOOK


No.

ADDRESS 81 Tyrell Crescent BLOCK LOT 857

DATES		WATER	SEWER
On at Main 9/5/2019		Depth at P/L: 2.28 m	2.28 m
On at Building		Depth at Main: 2.35 m	2.56 m
Frost Plug:		Pipe Size: 25 mm / 20 mm	100 mm
Memo:	Pipe Material: HDPE Insul. <u>(Yes)</u> /No		PVC Insul. <u>(Yes)</u> /No
	Length from Main to P/L: 5.83 m		8.96 m
	Squirt Test: <u>(Pass)</u> /Fail		N/A
Booster Pump Required:	Yes/No	Frost Protection: Aquaflow/ <u>(Recirc)</u> /Heat Trace/Bleeder	N/A
PRV Required:	Yes/No	Greased @ CC: <u>(Yes)</u> /No	N/A
Water Meter Installed:	Yes/No	Continuity Test: <u>(N/A)</u> Pass/Fail	N/A

CLEARLY INDICATE LOCATION OF CC AND ROUTE OF PIPES ON DRAWING BELOW

1. Show main valves required to isolate this service. 2. All dimensions to be tied to property line 3. All dimensions to be metric 4. Depth @ property line is based on elevation after construction and changes may have occurred.

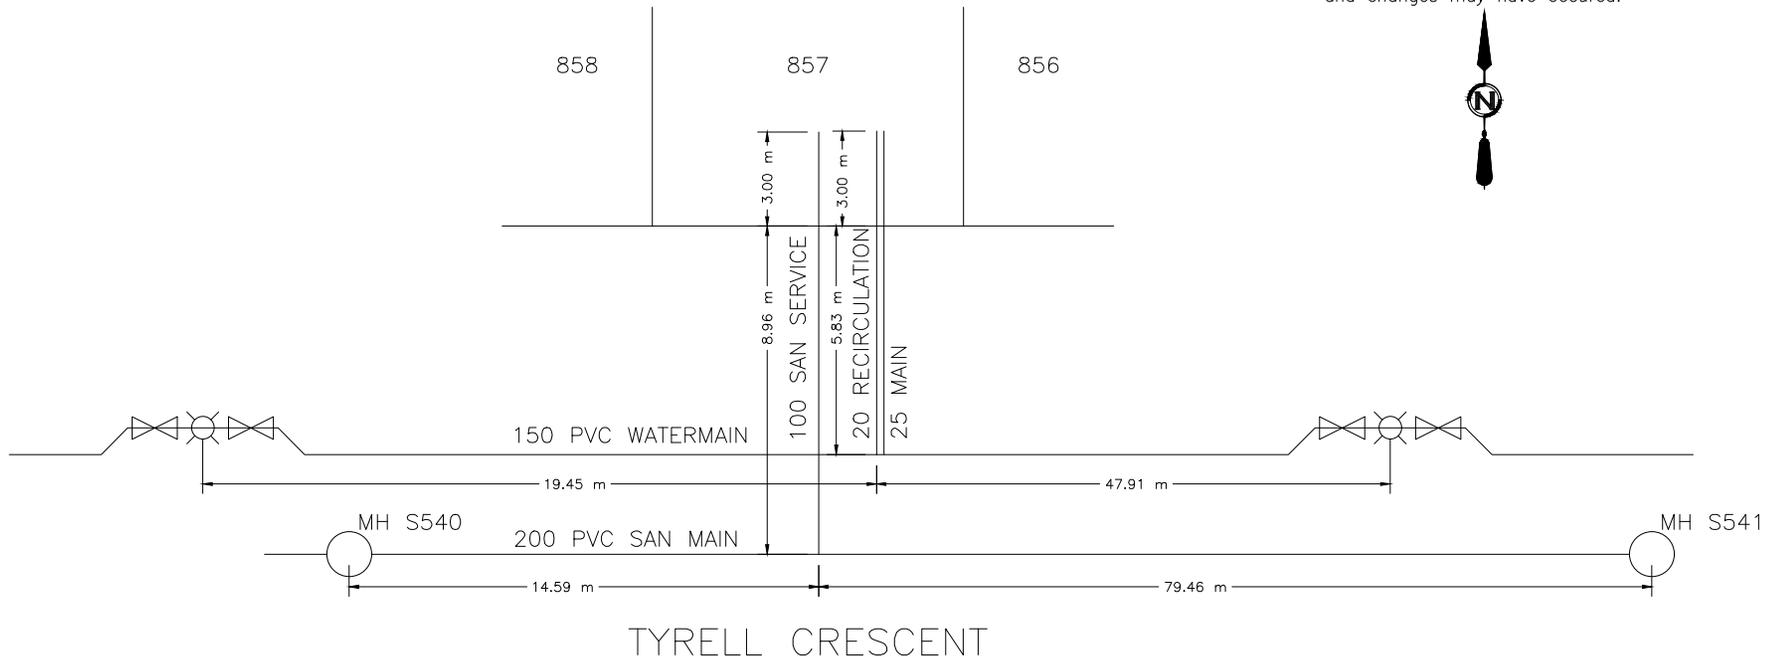



CITY OF WHITEHORSE SERVICE CONNECTION RECORD

FIELD BOOK


No.

ADDRESS 83 Tyrell Crescent BLOCK LOT 858

DATES		WATER		SEWER	
On at Main	9/6/2019	Depth at P/L:	2.20 m		2.15 m
On at Building		Depth at Main:	2.30 m		2.56 m
Frost Plug:		Pipe Size:	25 mm / 20 mm		100 mm
Memo:		Pipe Material:	HDPE	Insul. (Yes/No)	PVC
		Length from Main to P/L:	5.80 m		9.04 m
		Squirt Test:	(Pass)/Fail		N/A
Booster Pump Required:	Yes/No	Frost Protection:	Aquaflow/Recirc/Heat Trace/Bleeder		N/A
PRV Required:	Yes/No	Greased @ CC:	(Yes)/No		N/A
Water Meter Installed:	Yes/No	Continuity Test:	(N/A) Pass/Fail		N/A

CLEARLY INDICATE LOCATION OF CC AND ROUTE OF PIPES ON DRAWING BELOW

- Show main valves required to isolate this service.
- All dimensions to be tied to property line
- All dimensions to be metric
- Depth @ property line is based on elevation after construction and changes may have occurred.

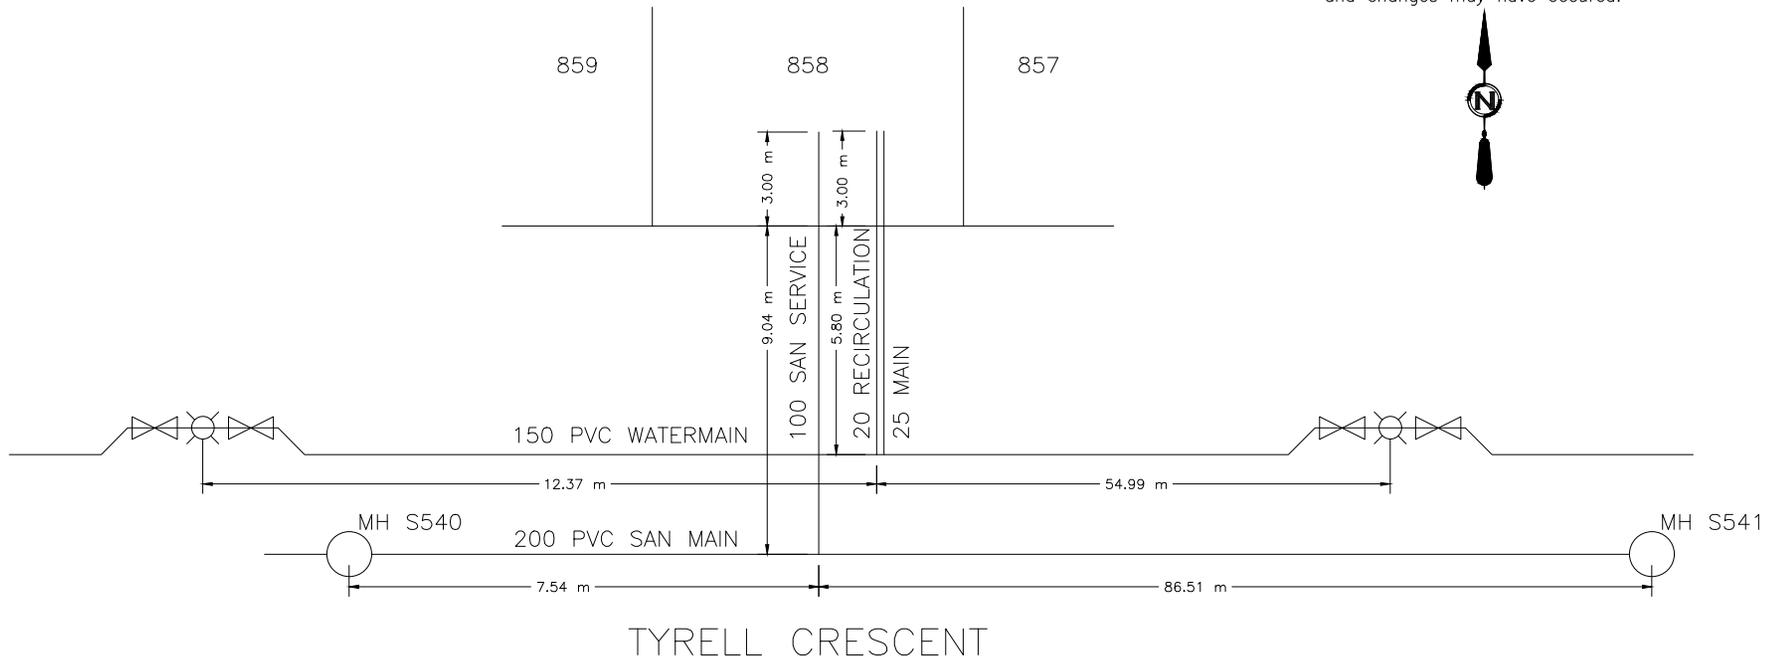



CITY OF WHITEHORSE SERVICE CONNECTION RECORD

FIELD BOOK


No.

ADDRESS 85 Tyrell Crescent BLOCK LOT 859

DATES		WATER		SEWER	
On at Main 9/3/2019		Depth at P/L: 2.43 m		2.45 m	
On at Building		Depth at Main: 2.52 m		2.85 m	
Frost Plug:		Pipe Size: 25 mm / 20 mm		100 mm	
Memo:		Pipe Material: HDPE Insul. <u>Yes</u> /No		PVC Insul. Yes/ <u>No</u>	
		Length from Main to P/L: 5.70 m		8.98 m	
		Squirt Test: <u>Pass</u> /Fail		N/A	
Booster Pump Required: Yes/No		Frost Protection: Aquaflow/ <u>Recirc</u> /Heat Trace/Bleeder		N/A	
PRV Required: Yes/No		Greased @ CC: <u>Yes</u> /No		N/A	
Water Meter Installed: Yes/No		Continuity Test: <u>N/A</u> Pass/Fail		N/A	

CLEARLY INDICATE LOCATION OF CC AND ROUTE OF PIPES ON DRAWING BELOW

- Show main valves required to isolate this service.
- All dimensions to be tied to property line
- All dimensions to be metric
- Depth @ property line is based on elevation after construction and changes may have occurred.

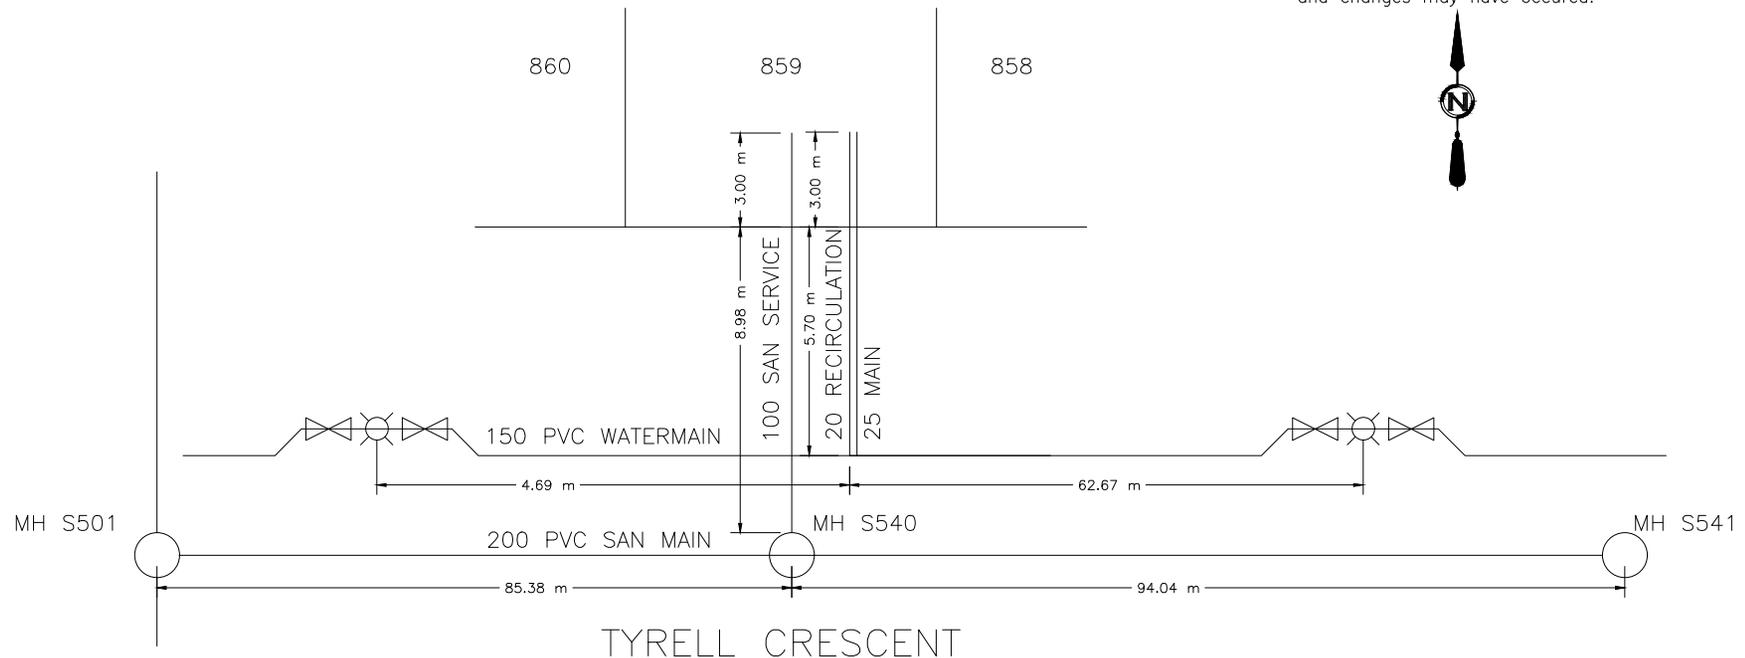



CITY OF WHITEHORSE SERVICE CONNECTION RECORD

FIELD BOOK


No.

ADDRESS 87 Tyrell Crescent BLOCK LOT 860

DATES	WATER	SEWER
On at Main 9/4/2019	Depth at P/L: 2.42 m	2.43 m
On at Building	Depth at Main: 2.52 m	2.81 m
Frost Plug:	Pipe Size: 25 mm / 20 mm	100 mm
Memo:	Pipe Material: HDPE Insul. <u>(Yes)</u> /No	PVC Insul. Yes/ <u>(No)</u>
	Length from Main to P/L: 5.80 m	8.97 m
	Squirt Test: <u>(Pass)</u> /Fail	N/A
Booster Pump Required: Yes/No	Frost Protection: Aquaflo/ <u>(Recirc)</u> /Heat Trace/Bleeder	N/A
PRV Required: Yes/No	Greased @ CC: <u>(Yes)</u> /No	N/A
Water Meter Installed: Yes/No	Continuity Test: <u>(N/A)</u> Pass/Fail	N/A

CLEARLY INDICATE LOCATION OF CC AND ROUTE OF PIPES ON DRAWING BELOW

1. Show main valves required to isolate this service. 2. All dimensions to be tied to property line 3. All dimensions to be metric 4. Depth @ property line is based on elevation after construction and changes may have occurred.

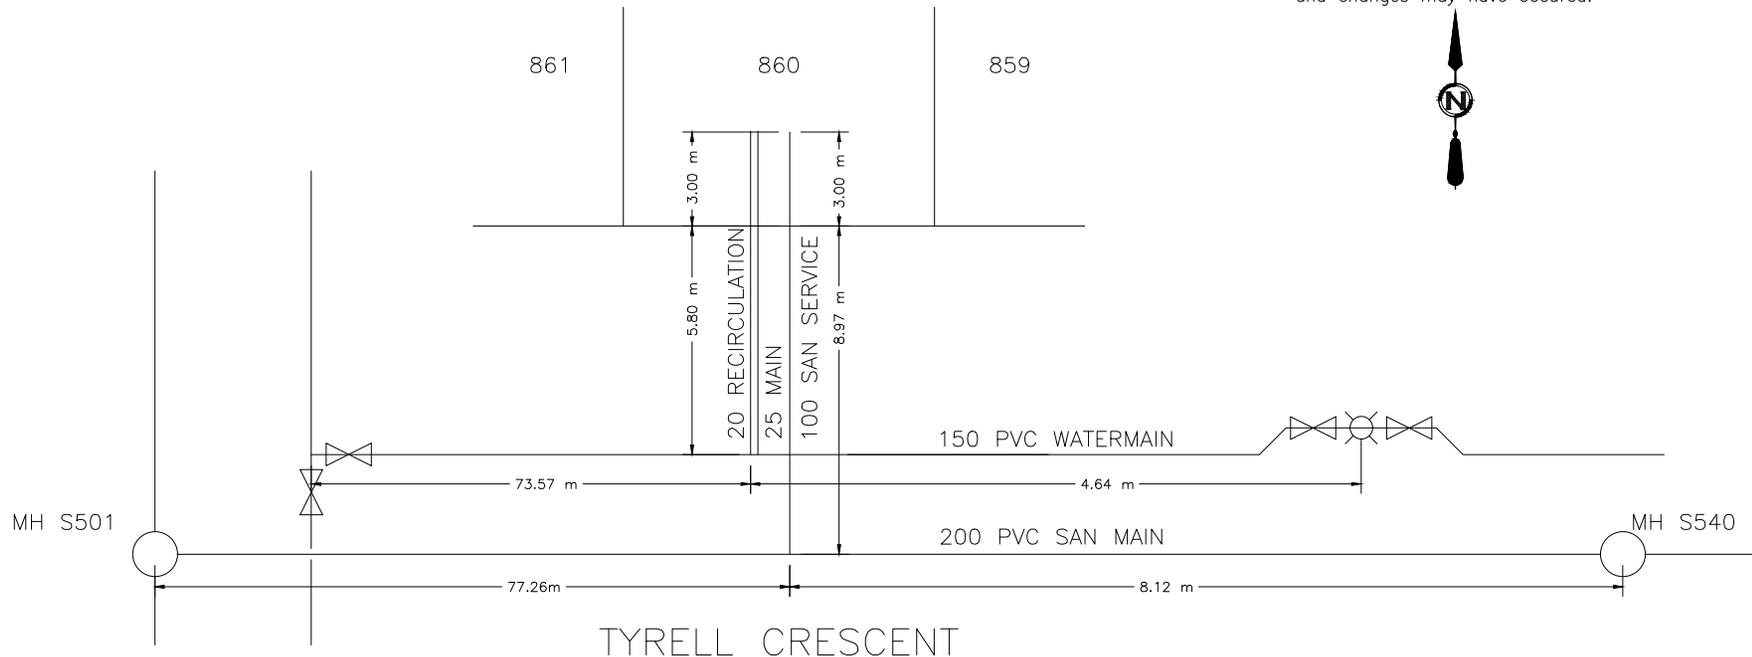



CITY OF WHITEHORSE SERVICE CONNECTION RECORD

FIELD BOOK


No. _____

ADDRESS 89 Tyrell Crescent BLOCK LOT 861

DATES	WATER	SEWER
On at Main 9/6/2019	Depth at P/L: 2.41 m	2.42 m
On at Building	Depth at Main: 2.50 m	2.78 m
Frost Plug:	Pipe Size: 25 mm / 20 mm	100 mm
Memo:	Pipe Material: HDPE Insul. <u>(Yes)</u> /No	PVC Insul. Yes/ <u>(No)</u>
	Length from Main to P/L: 5.78 m	8.98 m
	Squirt Test: <u>(Pass)</u> /Fail	N/A
Booster Pump Required: Yes/No	Frost Protection: Aquaflo/ <u>(Recirc)</u> /Heat Trace/Bleeder	N/A
PRV Required: Yes/No	Greased @ CC: <u>(Yes)</u> /No	N/A
Water Meter Installed: Yes/No	Continuity Test: <u>(N/A)</u> Pass/Fail	N/A

CLEARLY INDICATE LOCATION OF CC AND ROUTE OF PIPES ON DRAWING BELOW

1. Show main valves required to isolate this service. 2. All dimensions to be tied to property line 3. All dimensions to be metric 4. Depth @ property line is based on elevation after construction and changes may have occurred.

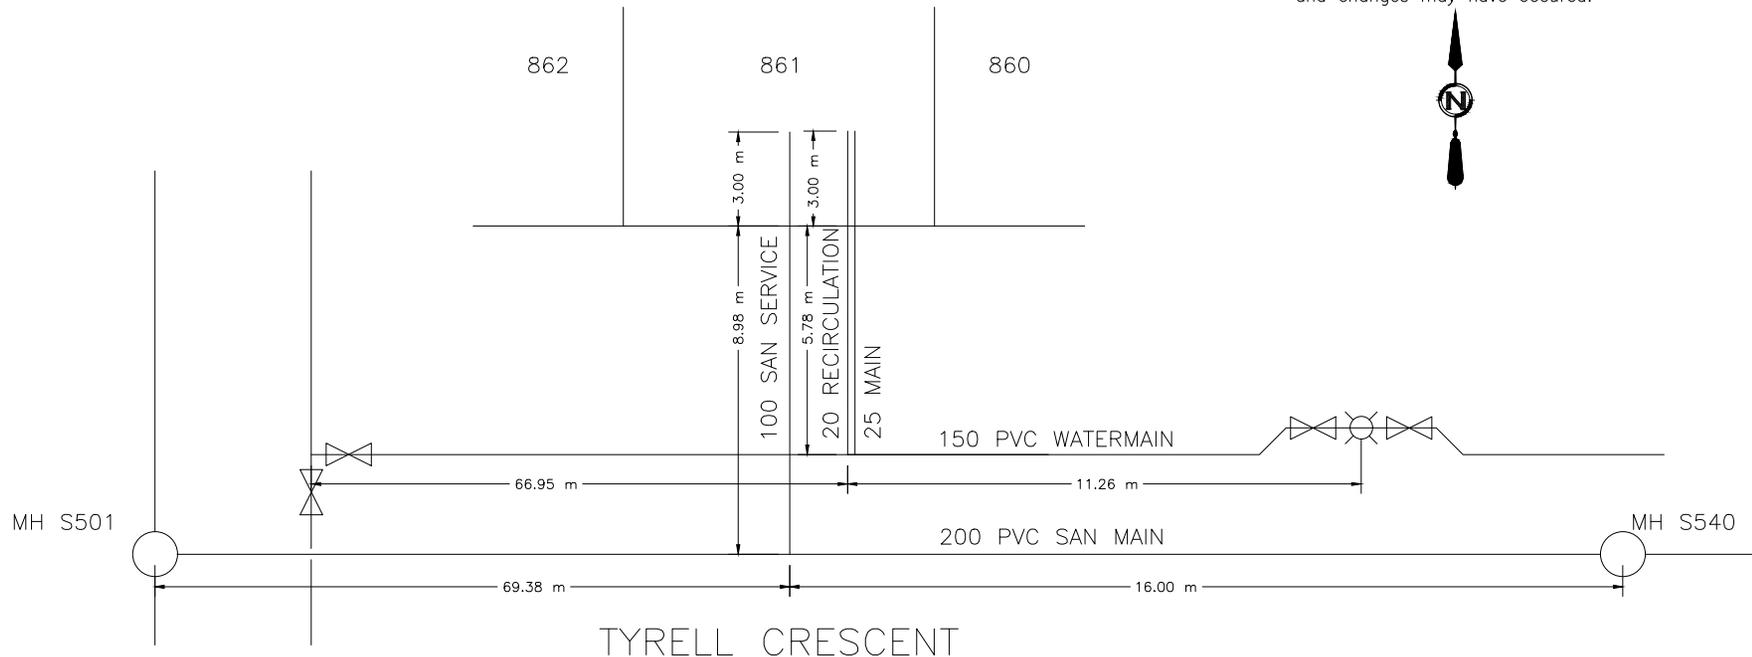



CITY OF WHITEHORSE SERVICE CONNECTION RECORD

FIELD BOOK


No.

ADDRESS 91 Tyrell Crescent BLOCK LOT 862

DATES	WATER	SEWER
On at Main 9/3/2019	Depth at P/L: 2.39 m	2.38 m
On at Building	Depth at Main: 2.55 m	2.77 m
Frost Plug:	Pipe Size: 25 mm / 20 mm	100 mm
Memo:	Pipe Material: HDPE Insul. <u>(Yes/No)</u>	PVC Insul. <u>Yes/No</u>
	Length from Main to P/L: 5.81 m	8.96 m
	Squirt Test: <u>(Pass/Fail)</u>	N/A
Booster Pump Required: Yes/No	Frost Protection: <u>Aquaflow/Recirc/Heat Trace/Bleeder</u>	N/A
PRV Required: Yes/No	Greased @ CC: <u>(Yes/No)</u>	N/A
Water Meter Installed: Yes/No	Continuity Test: <u>(N/A)</u> Pass/Fail	N/A

CLEARLY INDICATE LOCATION OF CC AND ROUTE OF PIPES ON DRAWING BELOW

1. Show main valves required to isolate this service. 2. All dimensions to be tied to property line 3. All dimensions to be metric 4. Depth @ property line is based on elevation after construction and changes may have occurred.

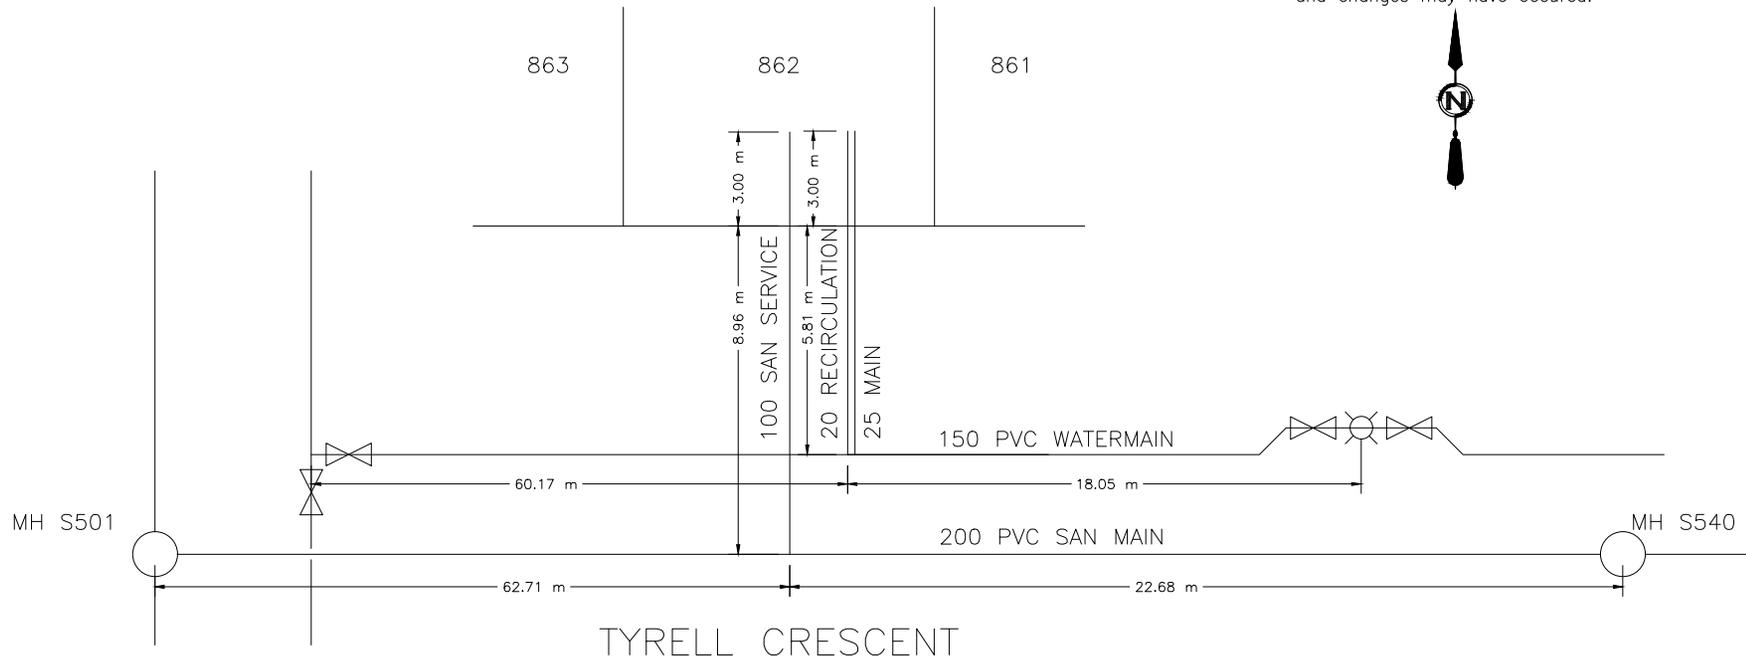



CITY OF WHITEHORSE SERVICE CONNECTION RECORD

FIELD BOOK


No. _____

ADDRESS 93 Tyrell Crescent BLOCK LOT 863

DATES	WATER	SEWER
On at Main 9/4/2019	Depth at P/L: 2.36 m	2.35 m
On at Building	Depth at Main: 2.47 m	2.72 m
Frost Plug:	Pipe Size: 25 mm / 20 mm	100 mm
Memo:	Pipe Material: HDPE Insul. <u>(Yes)</u> /No	PVC Insul. Yes/ <u>(No)</u>
	Length from Main to P/L: 5.84 m	8.95 m
	Squirt Test: <u>(Pass)</u> /Fail	N/A
Booster Pump Required: Yes/No	Frost Protection: Aquaflow/ <u>(Recirc)</u> /Heat Trace/Bleeder	N/A
PRV Required: Yes/No	Greased @ CC: <u>(Yes)</u> /No	N/A
Water Meter Installed: Yes/No	Continuity Test: <u>(N/A)</u> Pass/Fail	N/A

CLEARLY INDICATE LOCATION OF CC AND ROUTE OF PIPES ON DRAWING BELOW

1. Show main valves required to isolate this service. 2. All dimensions to be tied to property line 3. All dimensions to be metric 4. Depth @ property line is based on elevation after construction and changes may have occurred.

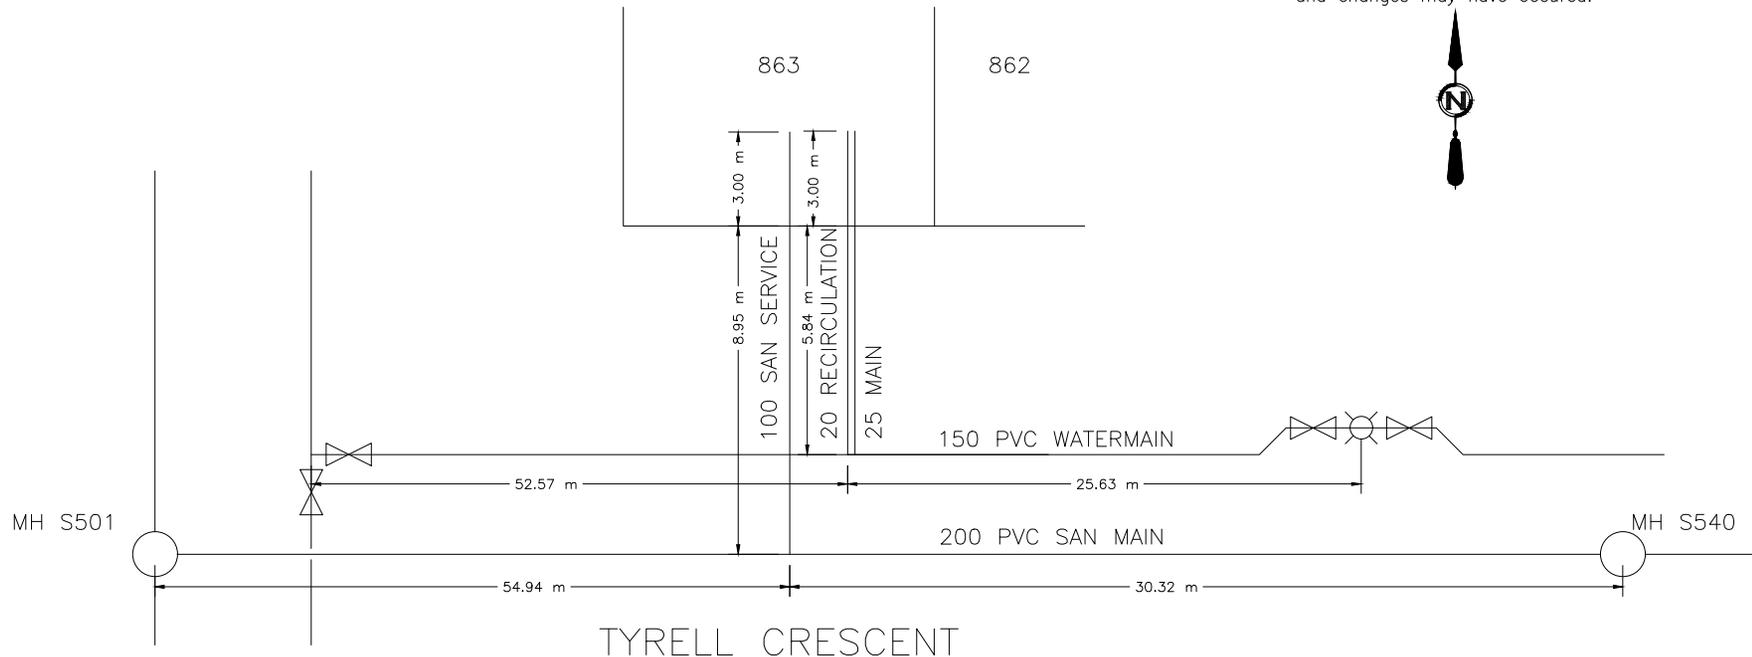



CITY OF WHITEHORSE SERVICE CONNECTION RECORD

FIELD BOOK


No.

ADDRESS 61 Eugene Avenue BLOCK LOT 864

DATES		WATER		SEWER	
On at Main	8/27/2019	Depth at P/L:	2.16 m		2.15 m
On at Building		Depth at Main:	2.23 m		2.40 m
Frost Plug:		Pipe Size:	25 mm / 20 mm		100 mm
Memo:		Pipe Material:	HDPE	Insul. <input checked="" type="checkbox"/> Yes/No	PVC
		Length from Main to P/L:	5.73 m		8.90 m
		Squirt Test:	<input checked="" type="checkbox"/> Pass/Fail		N/A
Booster Pump Required:	Yes/No	Frost Protection:	Aquaflow/ <input checked="" type="checkbox"/> Recirc/Heat Trace/Bleeder		N/A
PRV Required:	Yes/No	Greased @ CC:	<input checked="" type="checkbox"/> Yes/No		N/A
Water Meter Installed:	Yes/No	Continuity Test:	<input checked="" type="checkbox"/> N/A	Pass/Fail	N/A

CLEARLY INDICATE LOCATION OF CC AND ROUTE OF PIPES ON DRAWING BELOW

1. Show main valves required to isolate this service.
2. All dimensions to be tied to property line
3. All dimensions to be metric
4. Depth @ property line is based on elevation after construction and changes may have occurred.

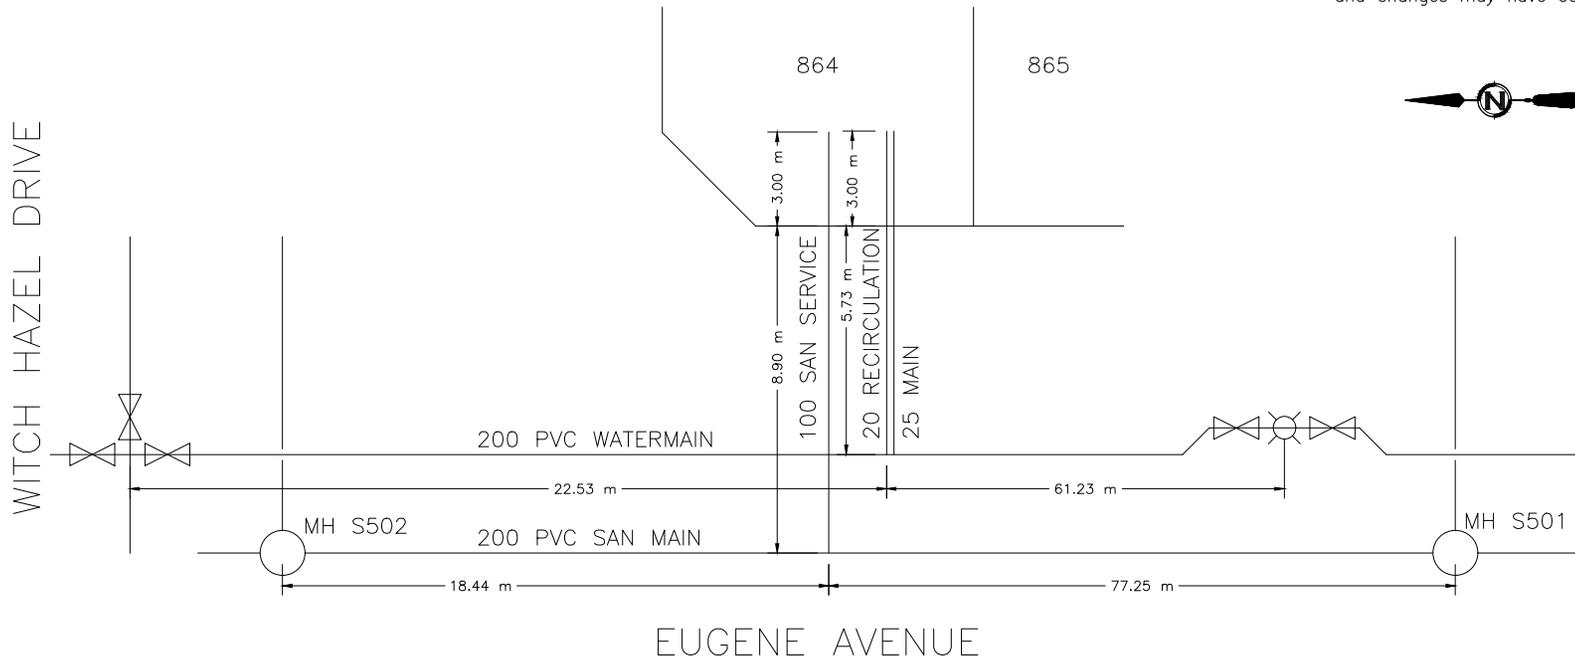



CITY OF WHITEHORSE SERVICE CONNECTION RECORD

FIELD BOOK


No. _____

ADDRESS 59 Eugene Avenue BLOCK LOT 865

DATES	WATER	SEWER
On at Main 8/25/2019	Depth at P/L: 2.46 m	2.39 m
On at Building	Depth at Main: 2.96 m	2.60 m
Frost Plug:	Pipe Size: 25 mm / 20 mm	100 mm
Memo:	Pipe Material: HDPE Insul. <u>(Yes)</u> /No	PVC Insul. Yes/ <u>(No)</u>
	Length from Main to P/L: 5.77 m	8.89 m
	Squirt Test: <u>(Pass)</u> /Fail	N/A
Booster Pump Required: Yes/No	Frost Protection: Aquaflow/ <u>(Recirc)</u> /Heat Trace/Bleeder	N/A
PRV Required: Yes/No	Greased @ CC: <u>(Yes)</u> /No	N/A
Water Meter Installed: Yes/No	Continuity Test: <u>(N/A)</u> Pass/Fail	N/A

CLEARLY INDICATE LOCATION OF CC AND ROUTE OF PIPES ON DRAWING BELOW

1. Show main valves required to isolate this service. 2. All dimensions to be tied to property line 3. All dimensions to be metric 4. Depth @ property line is based on elevation after construction and changes may have occurred.

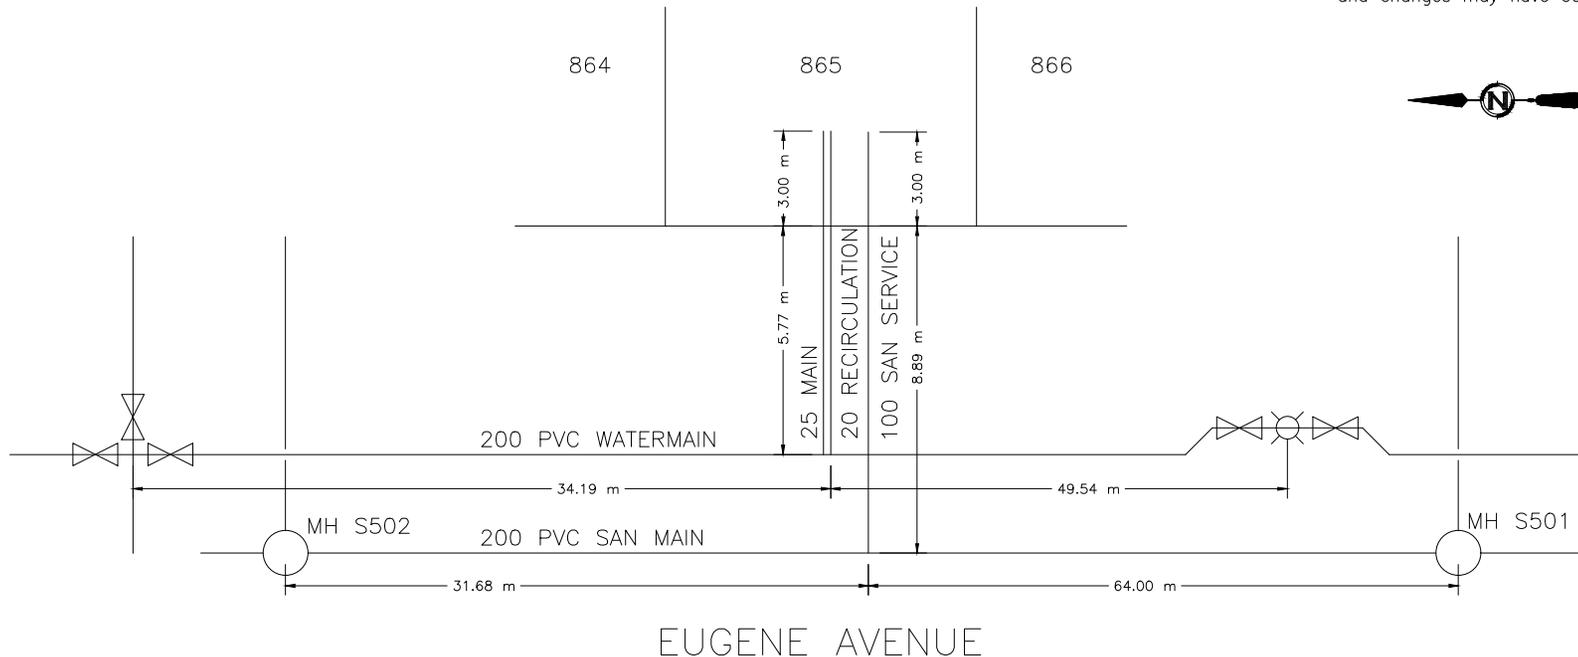



CITY OF WHITEHORSE SERVICE CONNECTION RECORD

FIELD BOOK


No.

ADDRESS 57 Eugene Avenue BLOCK LOT 866

DATES		WATER		SEWER	
On at Main	8/28/2019	Depth at P/L:	2.32 m		2.31 m
On at Building		Depth at Main:	2.45 m		2.72 m
Frost Plug:		Pipe Size:	25 mm / 20 mm		100 mm
Memo:		Pipe Material:	HDPE	Insul. <u>(Yes)</u> /No	PVC
		Length from Main to P/L:	5.77 m		8.91 m
		Squirt Test:	<u>(Pass)</u> /Fail		N/A
Booster Pump Required:	Yes/No	Frost Protection:	Aquaflow/ <u>(Recirc)</u> /Heat Trace/Bleeder		N/A
PRV Required:	Yes/No	Greased @ CC:	<u>(Yes)</u> /No		N/A
Water Meter Installed:	Yes/No	Continuity Test:	<u>(N/A)</u> Pass/Fail		N/A

CLEARLY INDICATE LOCATION OF CC AND ROUTE OF PIPES ON DRAWING BELOW

1. Show main valves required to isolate this service.
2. All dimensions to be tied to property line
3. All dimensions to be metric
4. Depth @ property line is based on elevation after construction and changes may have occurred.

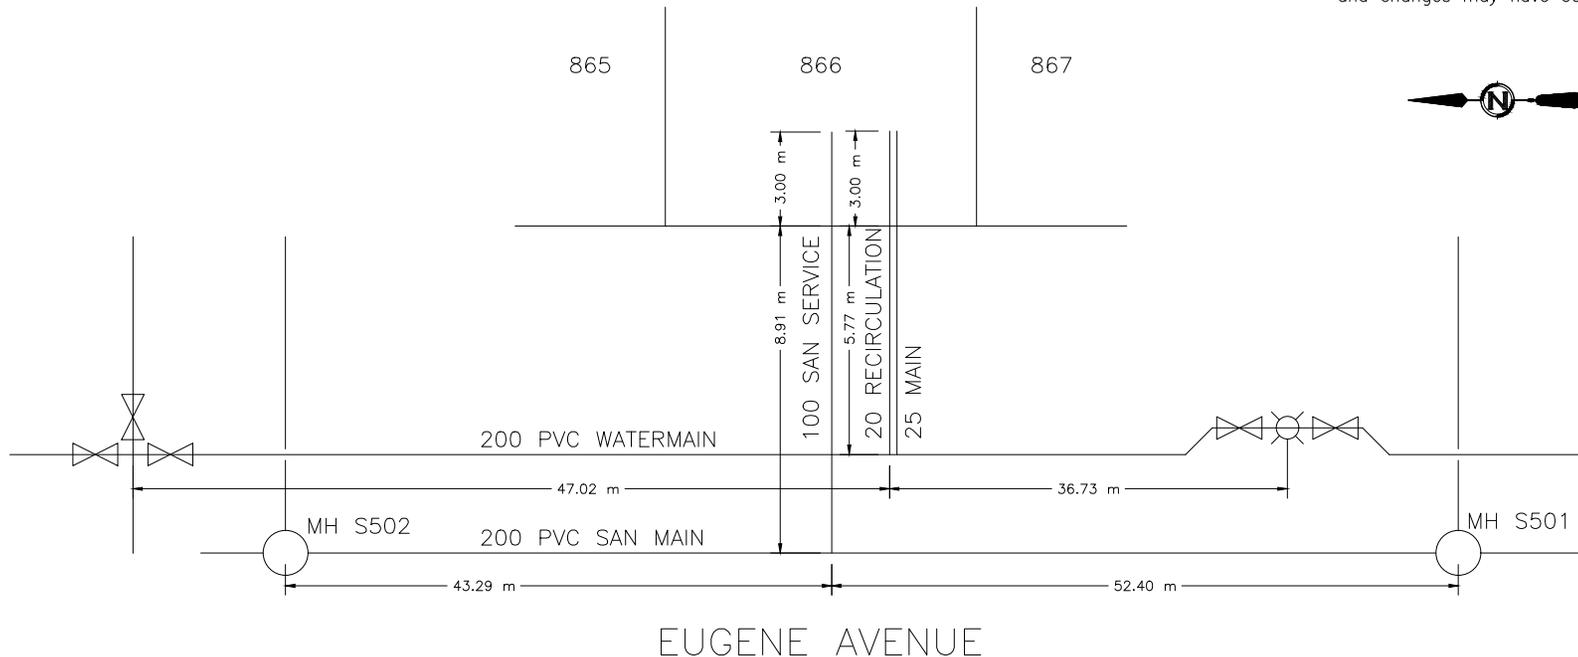



CITY OF WHITEHORSE SERVICE CONNECTION RECORD

FIELD BOOK


No. _____

ADDRESS 55 Eugene Avenue BLOCK _____ LOT 867

DATES	WATER	SEWER
On at Main 8/26/2019	Depth at P/L: 2.45 m	2.44 m
On at Building	Depth at Main: 2.58 m	2.83 m
Frost Plug:	Pipe Size: 25 mm / 20 mm	100 mm
Memo:	Pipe Material: HDPE Insul. <u>Yes</u> /No	PVC Insul. Yes/ <u>No</u>
	Length from Main to P/L: 5.77 m	8.94 m
	Squirt Test: <u>Pass</u> /Fail	N/A
Booster Pump Required: Yes/No	Frost Protection: Aquaflo/ <u>Recirc</u> /Heat Trace/Bleeder	N/A
PRV Required: Yes/No	Greased @ CC: <u>Yes</u> /No	N/A
Water Meter Installed: Yes/No	Continuity Test: <u>N/A</u> Pass/Fail	N/A

CLEARLY INDICATE LOCATION OF CC AND ROUTE OF PIPES ON DRAWING BELOW

1. Show main valves required to isolate this service. 2. All dimensions to be tied to property line 3. All dimensions to be metric 4. Depth @ property line is based on elevation after construction and changes may have occurred.

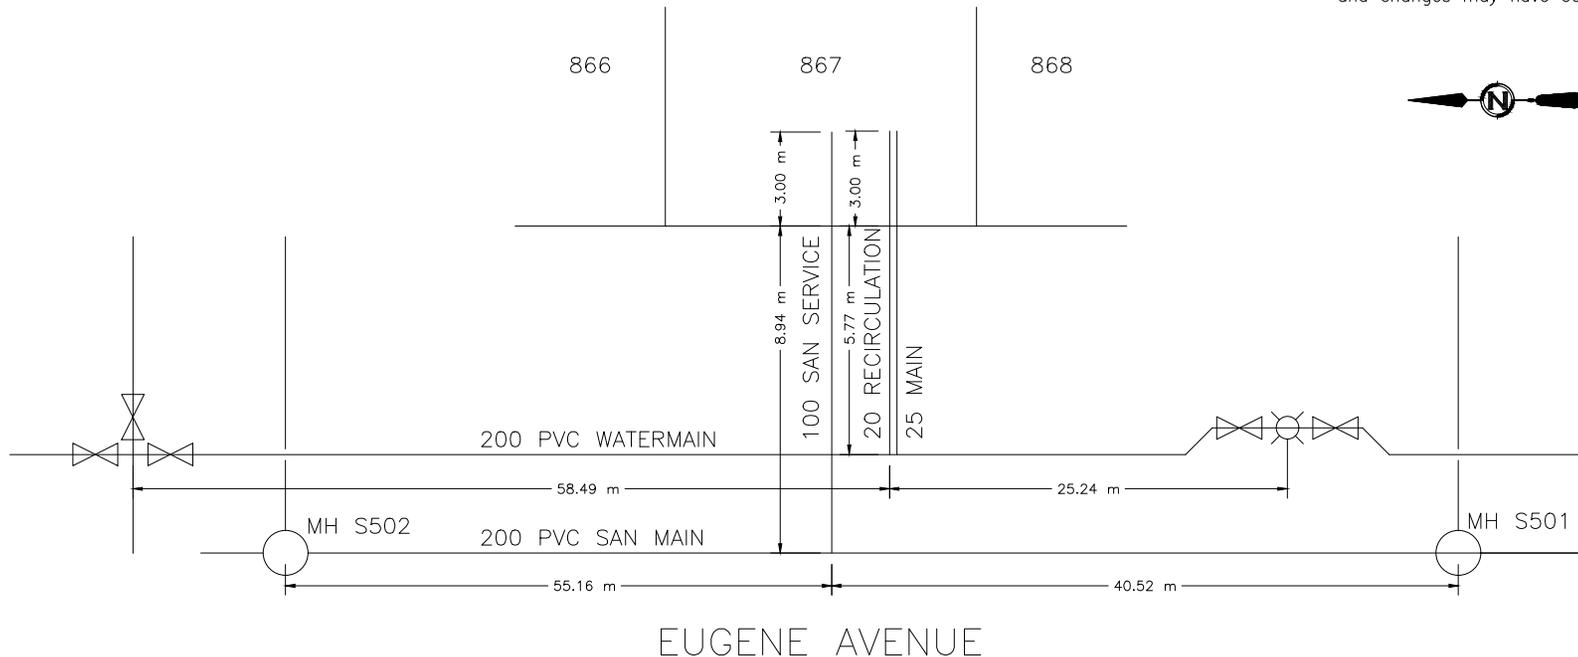



CITY OF WHITEHORSE SERVICE CONNECTION RECORD

FIELD BOOK


No.

ADDRESS 53 Eugene Avenue BLOCK LOT 868

DATES	WATER	SEWER
On at Main 8/28/2019	Depth at P/L: 2.43m	2.42 m
On at Building	Depth at Main: 2.65m	2.95 m
Frost Plug:	Pipe Size: 25 mm / 20 mm	100 mm
Memo:	Pipe Material: HDPE Insul. <u>(Yes)</u> /No	PVC Insul. Yes/ <u>(No)</u>
	Length from Main to P/L: 5.77 m	8.94 m
	Squirt Test: <u>(Pass)</u> /Fail	N/A
Booster Pump Required: Yes/No	Frost Protection: Aquaflo/ <u>(Recirc)</u> /Heat Trace/Bleeder	N/A
PRV Required: Yes/No	Greased @ CC: <u>(Yes)</u> /No	N/A
Water Meter Installed: Yes/No	Continuity Test: <u>(N/A)</u> Pass/Fail	N/A

CLEARLY INDICATE LOCATION OF CC AND ROUTE OF PIPES ON DRAWING BELOW

1. Show main valves required to isolate this service. 2. All dimensions to be tied to property line 3. All dimensions to be metric 4. Depth @ property line is based on elevation after construction and changes may have occurred.

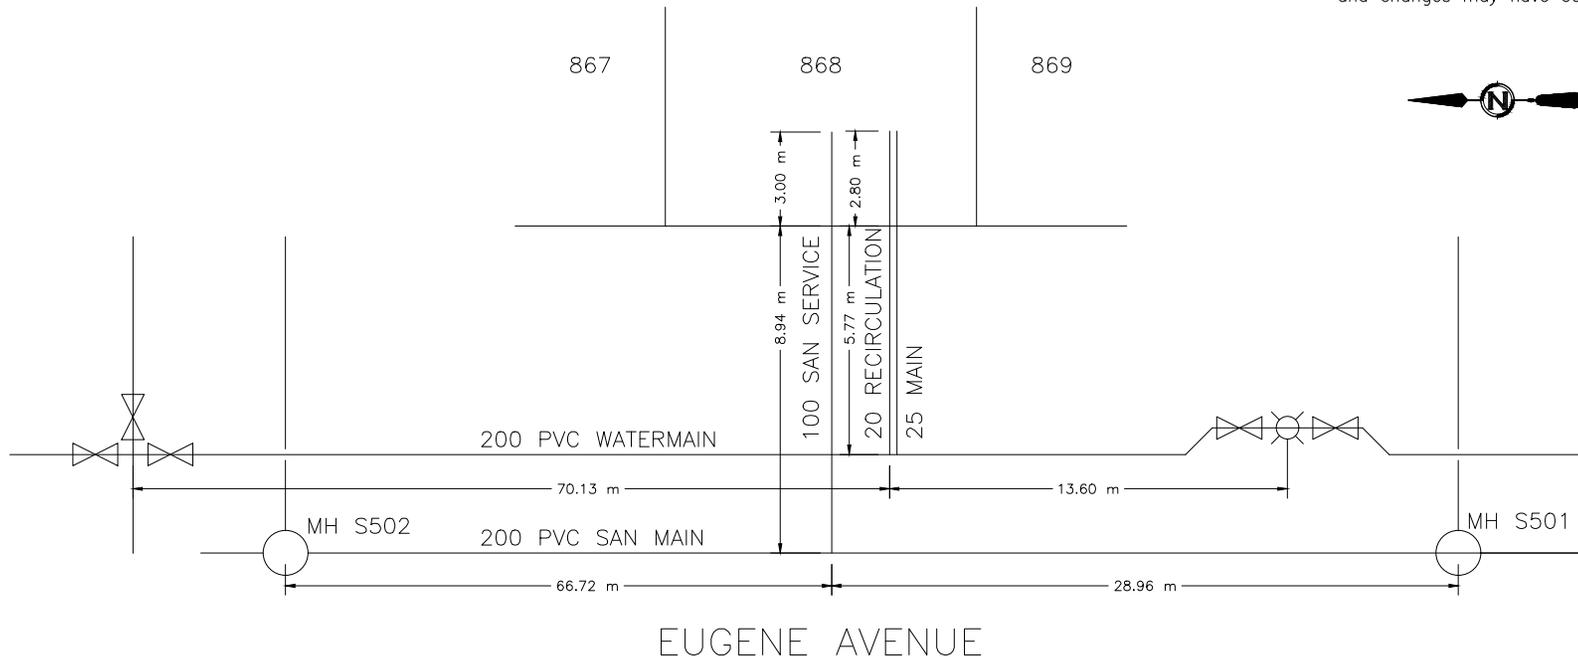



CITY OF WHITEHORSE SERVICE CONNECTION RECORD

FIELD BOOK


No.

ADDRESS 51 Eugene Avenue BLOCK LOT 869

DATES		WATER		SEWER
On at Main	9/4/2019	Depth at P/L:	2.39 m	2.38 m
On at Building		Depth at Main:	2.45 m	2.64 m
Frost Plug:		Pipe Size:	25 mm / 20 mm	100 mm
Memo:		Pipe Material:	HDPE Insul. <u>(Yes/No)</u>	PVC Insul. <u>(Yes/No)</u>
		Length from Main to P/L:	5.80 m	9.03 m
		Squirt Test:	<u>(Pass/Fail)</u>	N/A
Booster Pump Required:	Yes/No	Frost Protection:	Aquaflow/ <u>(Recirc)</u> /Heat Trace/Bleeder	N/A
PRV Required:	Yes/No	Greased @ CC:	<u>(Yes/No)</u>	N/A
Water Meter Installed:	Yes/No	Continuity Test:	<u>(N/A)</u> Pass/Fail	N/A

CLEARLY INDICATE LOCATION OF CC AND ROUTE OF PIPES ON DRAWING BELOW

1. Show main valves required to isolate this service.
2. All dimensions to be tied to property line
3. All dimensions to be metric
4. Depth @ property line is based on elevation after construction and changes may have occurred.

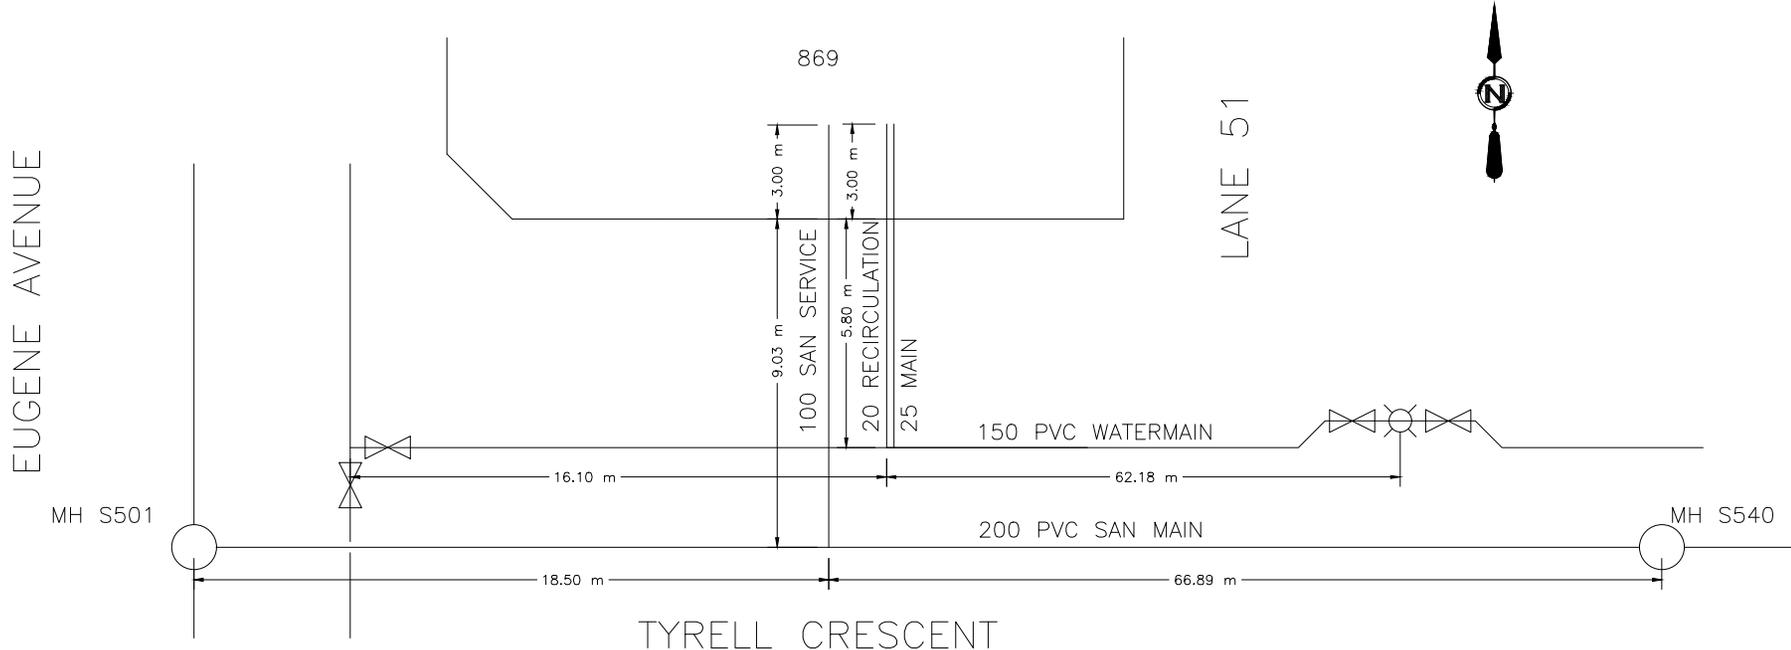



CITY OF WHITEHORSE SERVICE CONNECTION RECORD

FIELD BOOK


No.

ADDRESS 45 Eugene Avenue BLOCK LOT 870

DATES		WATER		SEWER	
On at Main	8/26/2019	Depth at P/L:	2.69 m		2.67 m
On at Building		Depth at Main:	2.89 m		3.50 m
Frost Plug:		Pipe Size:	25 mm / 20 mm		100 mm
Memo:		Pipe Material:	HDPE	Insul. <u>(Yes)</u> /No	PVC
		Length from Main to P/L:	5.76 m		9.02 m
		Squirt Test:	<u>(Pass)</u> /Fail		N/A
Booster Pump Required:	Yes/No	Frost Protection:	Aquaflow/ <u>(Recirc)</u> /Heat Trace/Bleeder		N/A
PRV Required:	Yes/No	Greased @ CC:	<u>(Yes)</u> /No		N/A
Water Meter Installed:	Yes/No	Continuity Test:	<u>(N/A)</u> Pass/Fail		N/A

CLEARLY INDICATE LOCATION OF CC AND ROUTE OF PIPES ON DRAWING BELOW

- Show main valves required to isolate this service.
- All dimensions to be tied to property line
- All dimensions to be metric
- Depth @ property line is based on elevation after construction and changes may have occurred.

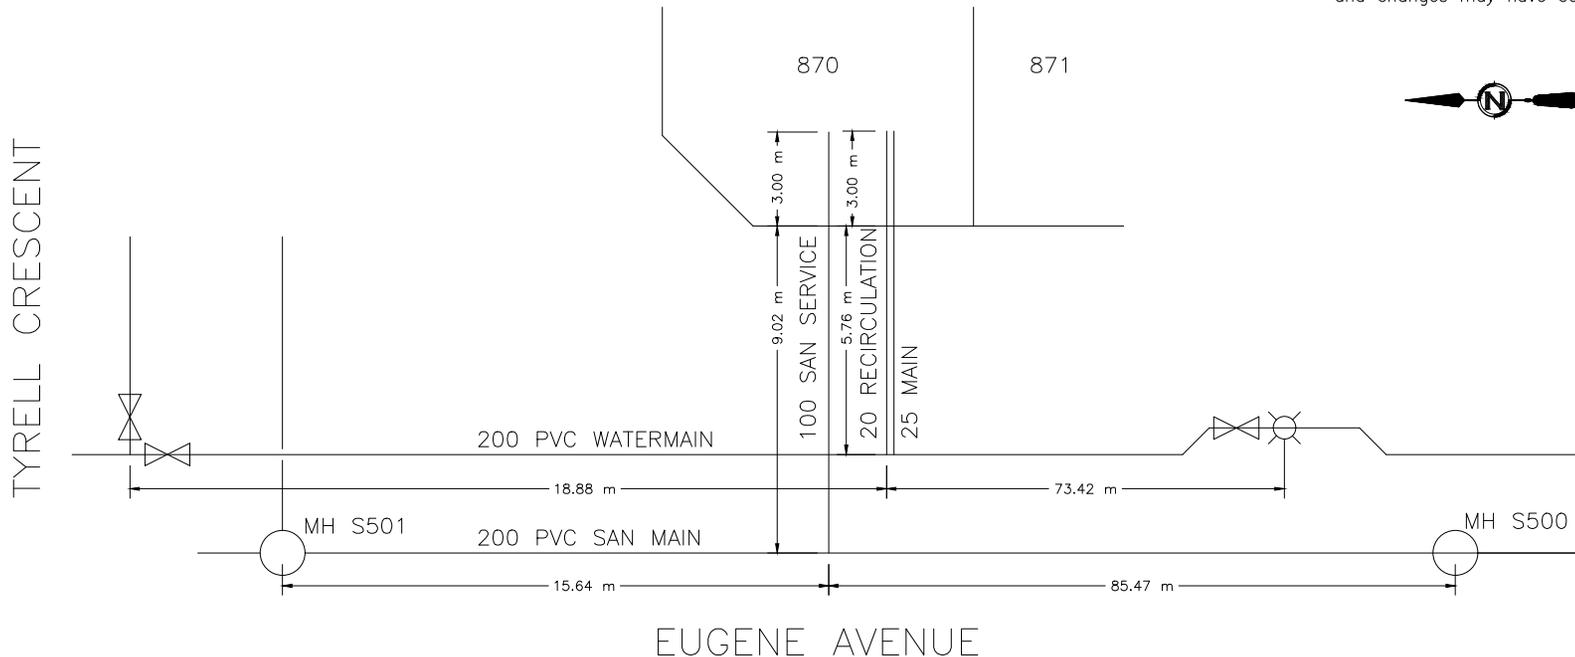



CITY OF WHITEHORSE SERVICE CONNECTION RECORD

FIELD BOOK


No. _____

ADDRESS 43 Eugene Avenue BLOCK _____ LOT 871

DATES	WATER	SEWER
On at Main 8/29/2019	Depth at P/L: 2.88 m	2.87 m
On at Building	Depth at Main: 2.88 m	3.66 m
Frost Plug:	Pipe Size: 25 mm / 20 mm	100 mm
Memo:	Pipe Material: HDPE Insul. <u>(Yes)</u> /No	PVC Insul. Yes/ <u>(No)</u>
	Length from Main to P/L: 5.72 m	8.98 m
	Squirt Test: <u>(Pass)</u> /Fail	N/A
Booster Pump Required: Yes/No	Frost Protection: Aquaflo/ <u>(Recirc)</u> /Heat Trace/Bleeder	N/A
PRV Required: Yes/No	Greased @ CC: <u>(Yes)</u> /No	N/A
Water Meter Installed: Yes/No	Continuity Test: <u>(N/A)</u> Pass/Fail	N/A

CLEARLY INDICATE LOCATION OF CC AND ROUTE OF PIPES ON DRAWING BELOW

1. Show main valves required to isolate this service. 2. All dimensions to be tied to property line 3. All dimensions to be metric 4. Depth @ property line is based on elevation after construction and changes may have occurred.

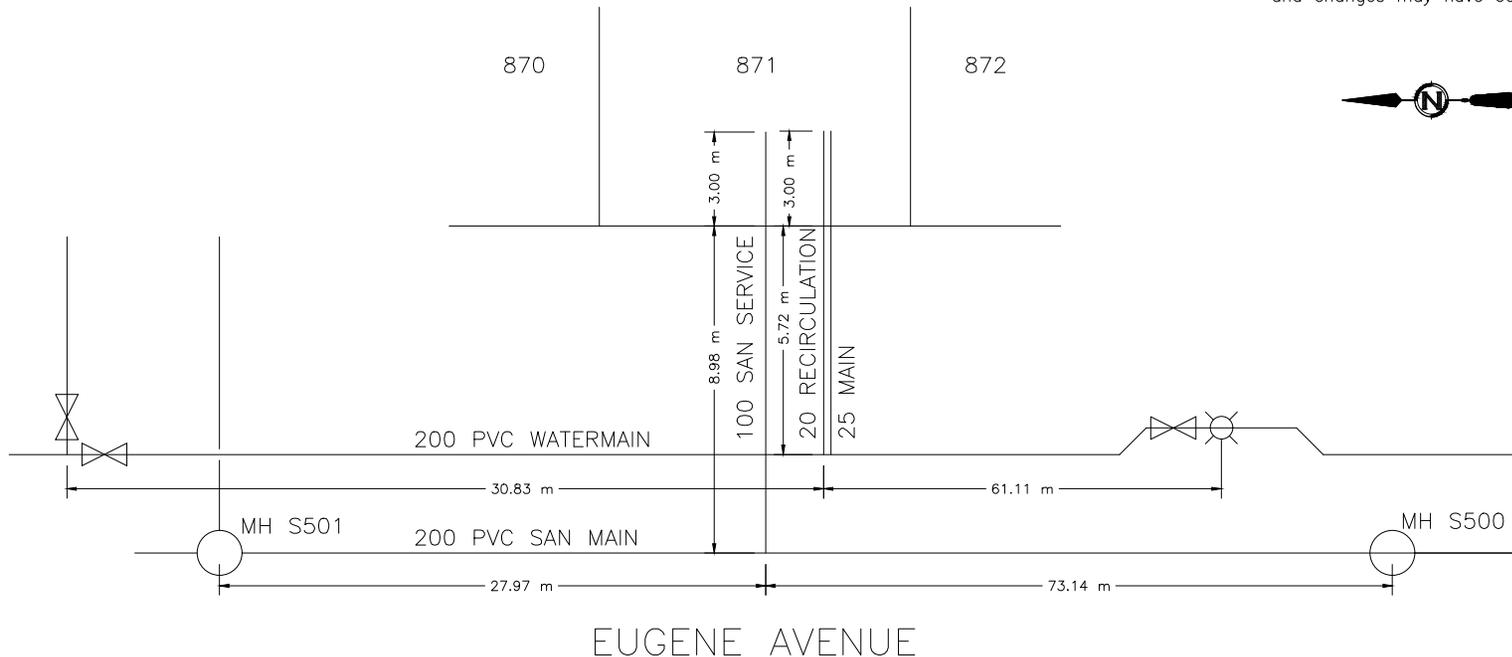



CITY OF WHITEHORSE SERVICE CONNECTION RECORD

FIELD BOOK


No.

ADDRESS 41 Eugene Avenue BLOCK LOT 872

DATES		WATER		SEWER	
On at Main	8/26/2019	Depth at P/L:	2.84 m		2.83 m
On at Building		Depth at Main:	3.05 m		3.82 m
Frost Plug:		Pipe Size:	25 mm / 20 mm		100 mm
Memo:		Pipe Material:	HDPE	Insul. <input checked="" type="checkbox"/> Yes/No	PVC
		Length from Main to P/L:	5.76 m		8.97 m
		Squirt Test:	<input checked="" type="checkbox"/> Pass/Fail		N/A
Booster Pump Required:	Yes/No	Frost Protection:	Aquaflow/ <input checked="" type="checkbox"/> Recirc/Heat Trace/Bleeder		N/A
PRV Required:	Yes/No	Greased @ CC:	<input checked="" type="checkbox"/> Yes/No		N/A
Water Meter Installed:	Yes/No	Continuity Test:	<input checked="" type="checkbox"/> N/A	Pass/Fail	N/A

CLEARLY INDICATE LOCATION OF CC AND ROUTE OF PIPES ON DRAWING BELOW

1. Show main valves required to isolate this service. 2. All dimensions to be tied to property line 3. All dimensions to be metric 4. Depth @ property line is based on elevation after construction and changes may have occurred.

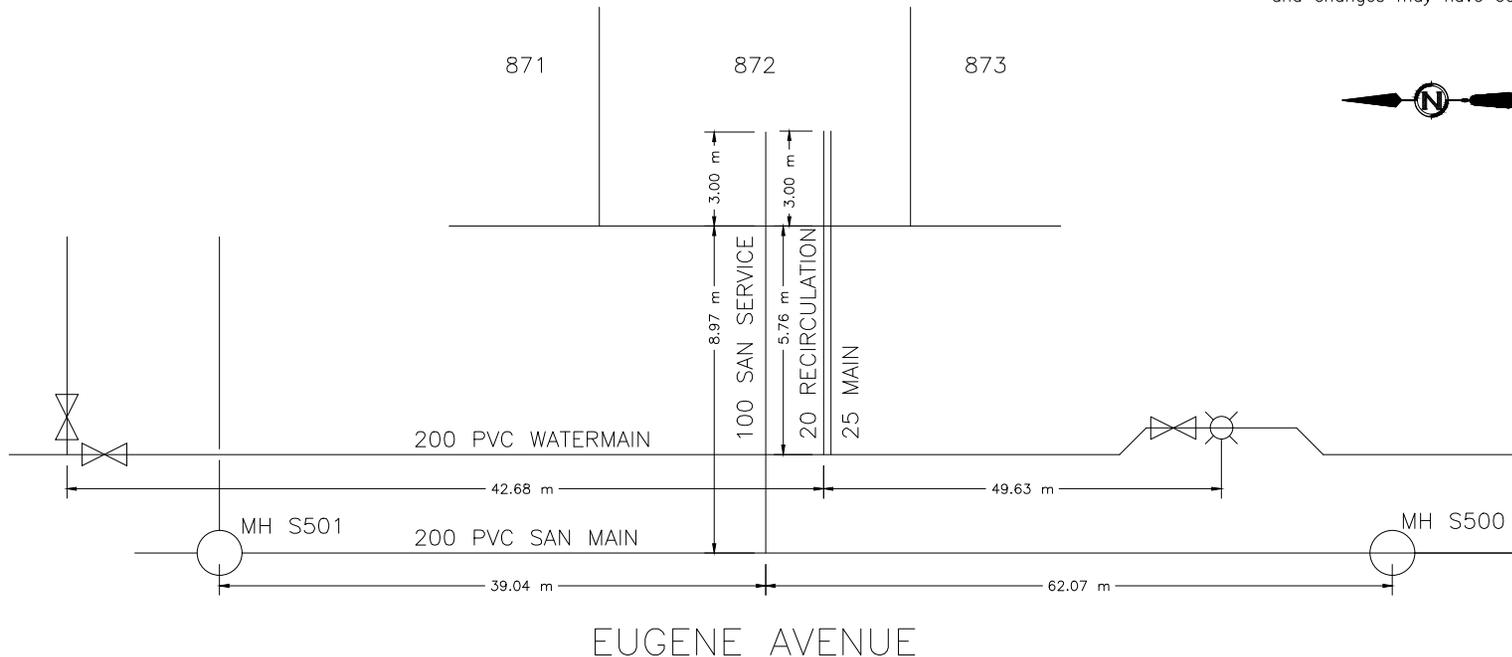



CITY OF WHITEHORSE SERVICE CONNECTION RECORD

FIELD BOOK


No.

ADDRESS 39 Eugene Avenue BLOCK LOT 873

	DATES	WATER	SEWER
On at Main	8/28/2019	Depth at P/L: 2.91 m	2.90 m
On at Building		Depth at Main: 3.06 m	3.97 m
Frost Plug:		Pipe Size: 25 mm / 20 mm	100 mm
Memo:		Pipe Material: HDPE	PVC
		Insul. <u>(Yes)</u> /No	Insul. Yes/ <u>(No)</u>
		Length from Main to P/L: 5.75 m	9.06 m
		Squirt Test: <u>(Pass)</u> /Fail	N/A
Booster Pump Required:	Yes/No	Frost Protection: Aquaflo/ <u>(Recirc)</u> /Heat Trace/Bleeder	N/A
PRV Required:	Yes/No	Greased @ CC: <u>(Yes)</u> /No	N/A
Water Meter Installed:	Yes/No	Continuity Test: <u>(N/A)</u> Pass/Fail	N/A

CLEARLY INDICATE LOCATION OF CC AND ROUTE OF PIPES ON DRAWING BELOW

1. Show main valves required to isolate this service. 2. All dimensions to be tied to property line 3. All dimensions to be metric 4. Depth @ property line is based on elevation after construction and changes may have occurred.

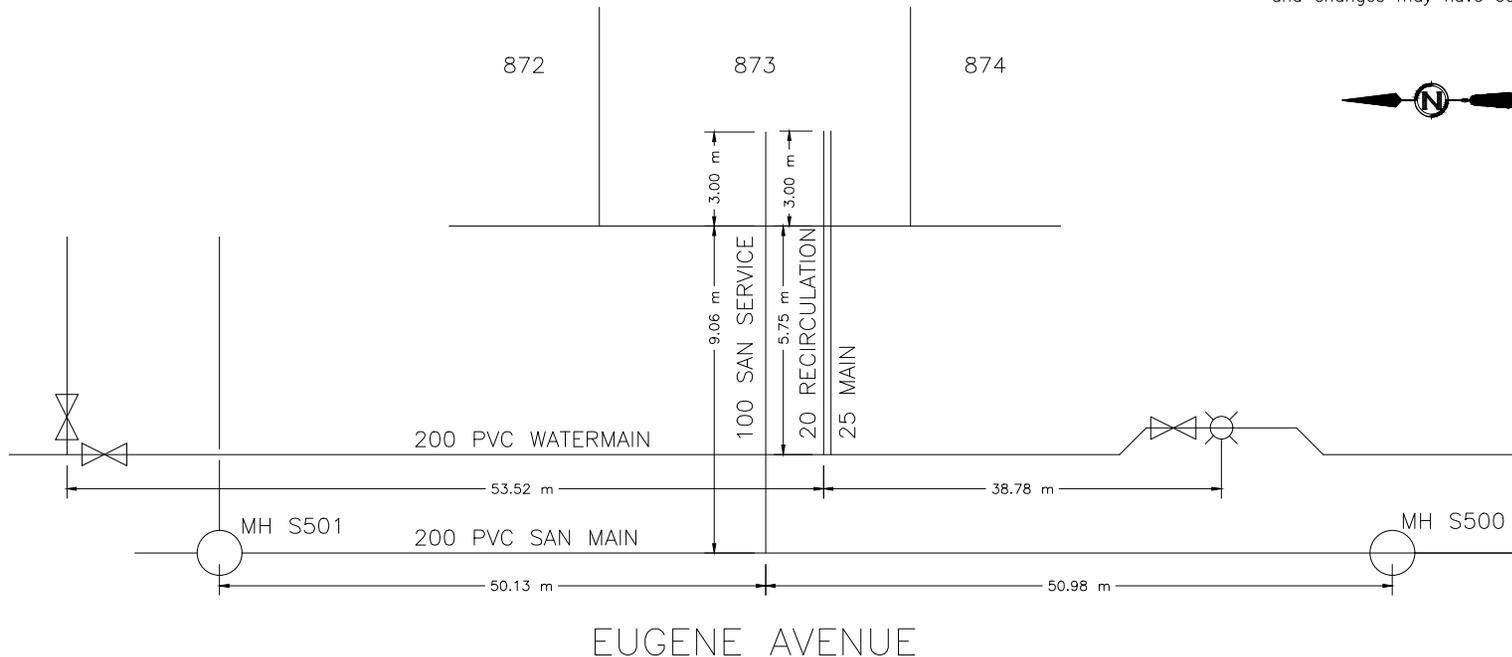



CITY OF WHITEHORSE SERVICE CONNECTION RECORD

FIELD BOOK


No.

ADDRESS 37 Eugene Avenue BLOCK LOT 874

	DATES	WATER	SEWER
On at Main	8/27/2019	Depth at P/L: 2.87 m	2.86 m
On at Building		Depth at Main: 3.12 m	4.14 m
Frost Plug:		Pipe Size: 25 mm / 20 mm	100 mm
Memo:		Pipe Material: HDPE Insul. <u>(Yes)</u> /No	PVC Insul. Yes/ <u>(No)</u>
		Length from Main to P/L: 5.71 m	8.97 m
		Squirt Test: <u>(Pass)</u> /Fail	N/A
Booster Pump Required:	Yes/No	Frost Protection: Aquaflo/ <u>(Recirc)</u> /Heat Trace/Bleeder	N/A
PRV Required:	Yes/No	Greased @ CC: <u>(Yes)</u> /No	N/A
Water Meter Installed:	Yes/No	Continuity Test: <u>(N/A)</u> Pass/Fail	N/A

CLEARLY INDICATE LOCATION OF CC AND ROUTE OF PIPES ON DRAWING BELOW

1. Show main valves required to isolate this service. 2. All dimensions to be tied to property line 3. All dimensions to be metric 4. Depth @ property line is based on elevation after construction and changes may have occurred.

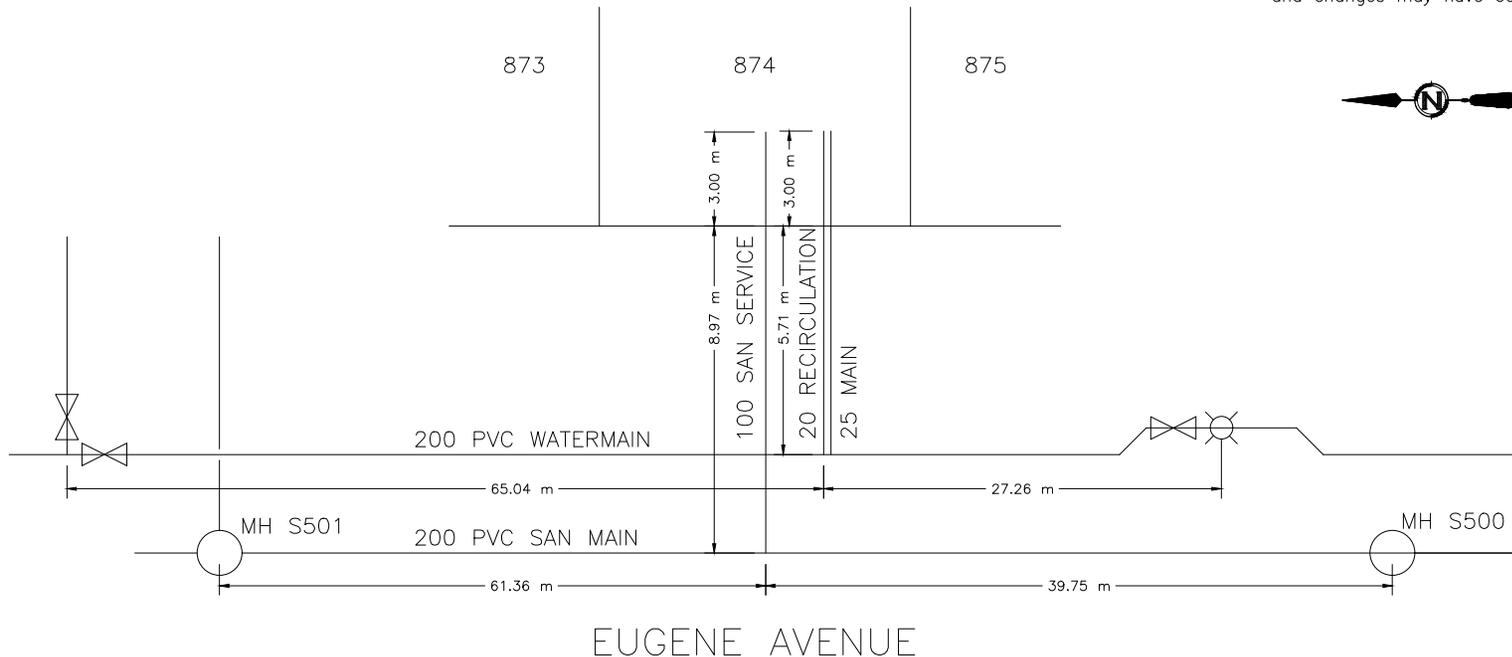



CITY OF WHITEHORSE SERVICE CONNECTION RECORD

FIELD BOOK


No.

ADDRESS 35 Eugene Avenue BLOCK LOT 875

DATES		WATER		SEWER	
On at Main	8/28/2019	Depth at P/L:	3.06 m		
On at Building		Depth at Main:	3.13 m		
Frost Plug:		Pipe Size:	25 mm / 20 mm		
Memo:		Pipe Material:	HDPE	Insul. <u>(Yes/No)</u>	PVC
		Length from Main to P/L:	5.71 m		8.98 m
		Squirt Test:	<u>(Pass)</u> /Fail		N/A
Booster Pump Required:	Yes/No	Frost Protection:	Aquaflow/ <u>(Recirc)</u> /Heat Trace/Bleeder		N/A
PRV Required:	Yes/No	Greased @ CC:	<u>(Yes)</u> /No		N/A
Water Meter Installed:	Yes/No	Continuity Test:	<u>(N/A)</u>	Pass/Fail	N/A

CLEARLY INDICATE LOCATION OF CC AND ROUTE OF PIPES ON DRAWING BELOW

1. Show main valves required to isolate this service.
2. All dimensions to be tied to property line
3. All dimensions to be metric
4. Depth @ property line is based on elevation after construction and changes may have occurred.

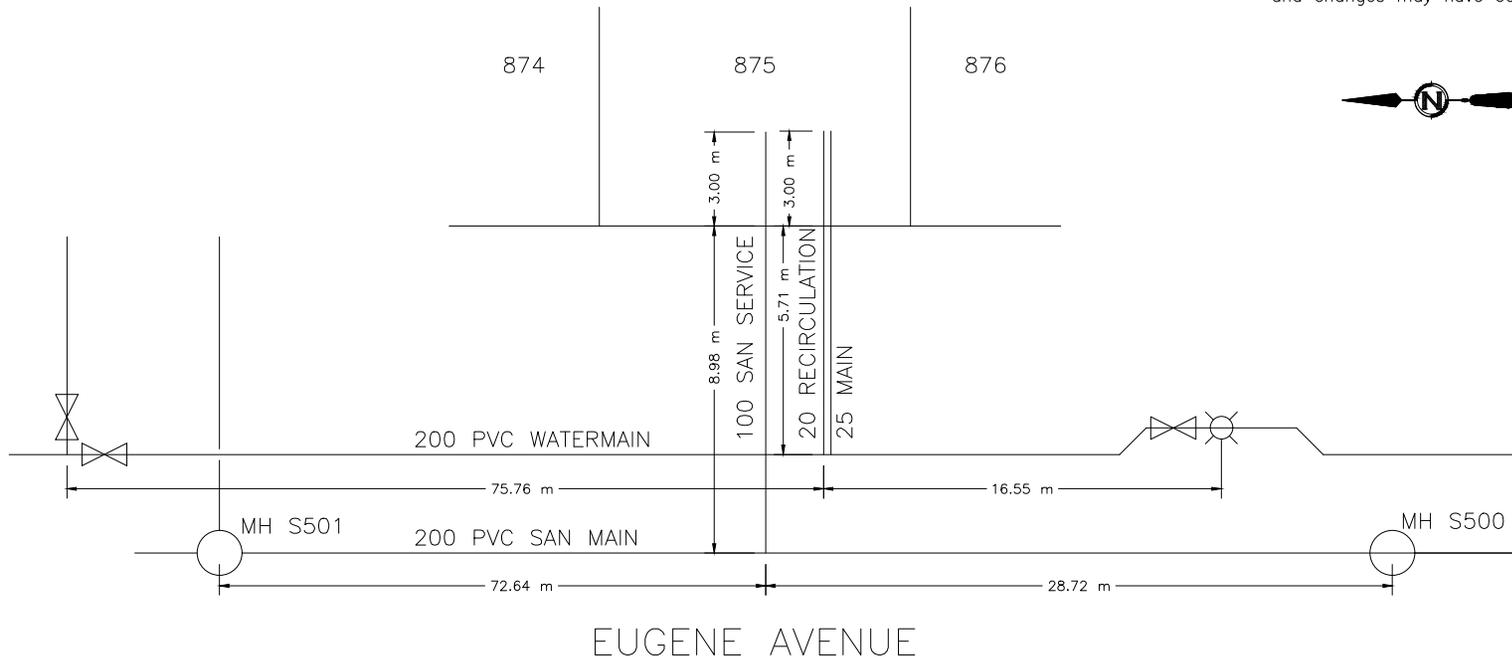



CITY OF WHITEHORSE SERVICE CONNECTION RECORD

FIELD BOOK


No.

ADDRESS 33 Eugene Avenue BLOCK LOT 876

DATES		WATER		SEWER	
On at Main	8/27/2019	Depth at P/L:	2.95 m		2.75 m
On at Building		Depth at Main:	3.12 m		4.43 m
Frost Plug:		Pipe Size:	25 mm / 20 mm		100 mm
Memo:		Pipe Material:	HDPE	Insul. <u>(Yes/No)</u>	PVC
		Length from Main to P/L:	5.46 m		8.96 m
		Squirt Test:	<u>(Pass)</u> /Fail		N/A
Booster Pump Required:	Yes/No	Frost Protection:	Aquaflow/ <u>(Recirc)</u> /Heat Trace/Bleeder		N/A
PRV Required:	Yes/No	Greased @ CC:	<u>(Yes)</u> /No		N/A
Water Meter Installed:	Yes/No	Continuity Test:	<u>(N/A)</u> Pass/Fail		N/A

CLEARLY INDICATE LOCATION OF CC AND ROUTE OF PIPES ON DRAWING BELOW

- Show main valves required to isolate this service.
- All dimensions to be tied to property line
- All dimensions to be metric
- Depth @ property line is based on elevation after construction and changes may have occurred.

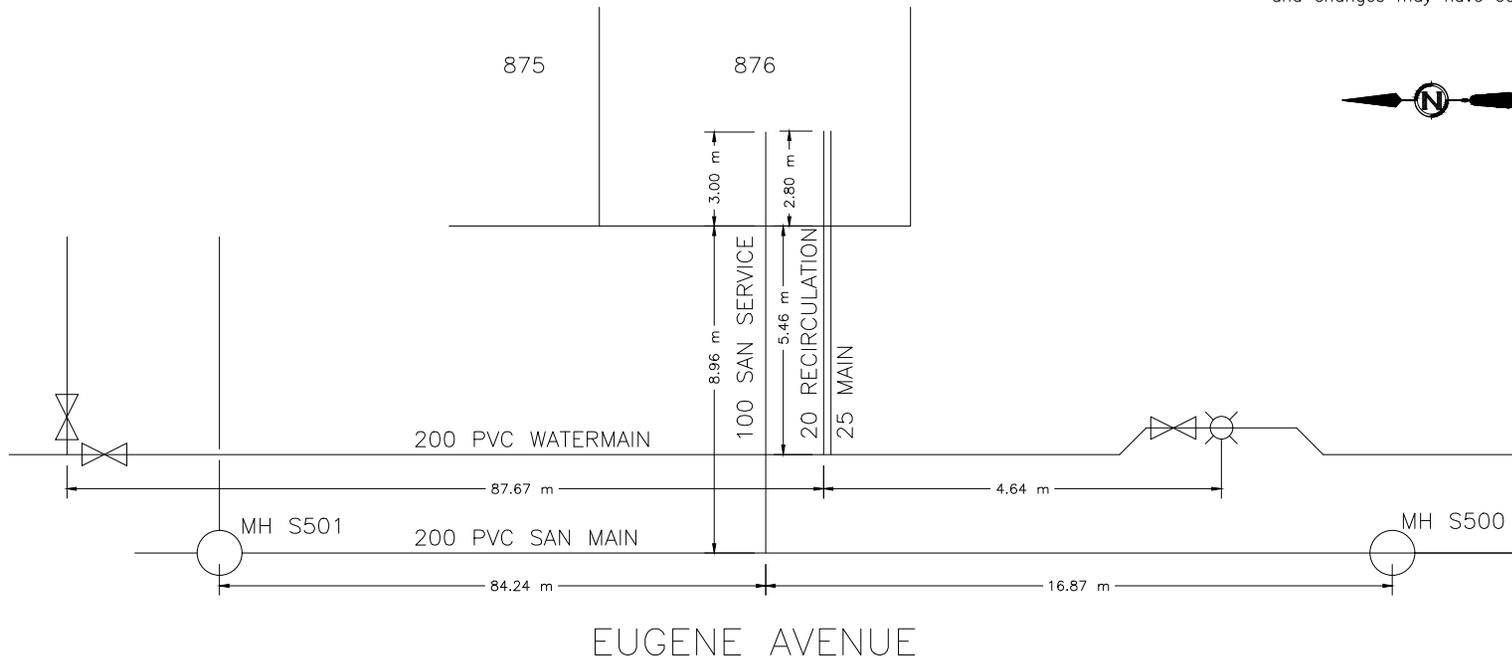



CITY OF WHITEHORSE SERVICE CONNECTION RECORD

FIELD BOOK


No.

ADDRESS 60 Eugene Avenue BLOCK LOT 877

DATES		WATER		SEWER	
On at Main	8/27/2019	Depth at P/L:	2.04 m		2.03 m
On at Building		Depth at Main:	2.23 m		2.44 m
Frost Plug:		Pipe Size:	25 mm / 20 mm		100 mm
Memo:		Pipe Material:	HDPE	Insul. (Yes/No)	PVC
		Length from Main to P/L:	11.78 m		9.01 m
		Squirt Test:	(Pass)/Fail		N/A
Booster Pump Required:	Yes/No	Frost Protection:	Aquaflow/Recirc/Heat Trace/Bleeder		N/A
PRV Required:	Yes/No	Greased @ CC:	(Yes)/No		N/A
Water Meter Installed:	Yes/No	Continuity Test:	(N/A) Pass/Fail		N/A

CLEARLY INDICATE LOCATION OF CC AND ROUTE OF PIPES ON DRAWING BELOW

1. Show main valves required to isolate this service.
2. All dimensions to be tied to property line
3. All dimensions to be metric
4. Depth @ property line is based on elevation after construction and changes may have occurred.

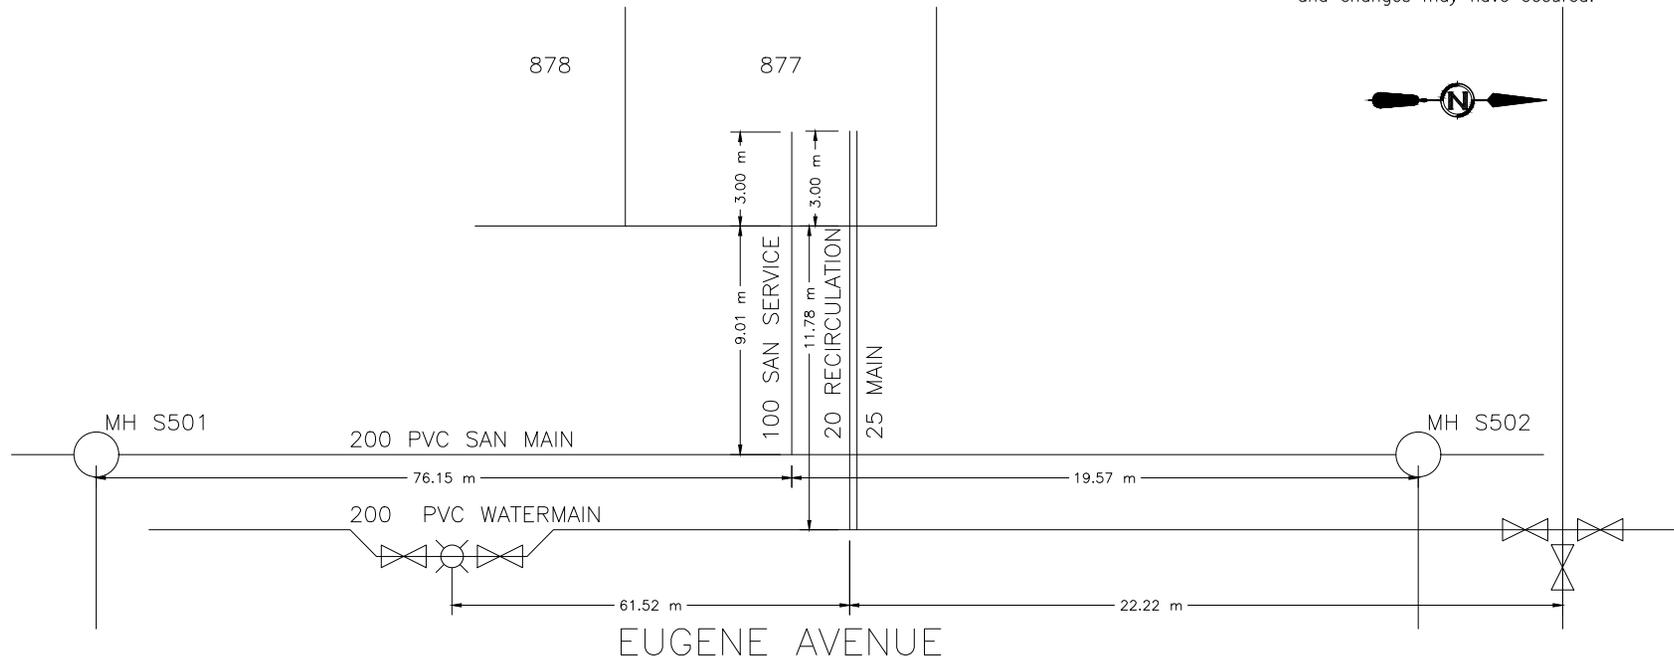



CITY OF WHITEHORSE SERVICE CONNECTION RECORD

FIELD BOOK


No.

ADDRESS 58 Eugene Avenue BLOCK LOT 878

DATES		WATER		SEWER	
On at Main	8/26/2019	Depth at P/L:	2.3 m	2.31 m	
On at Building		Depth at Main:	2.47 m	2.62 m	
Frost Plug:		Pipe Size:	25 mm / 20 mm	100 mm	
Memo:		Pipe Material:	HDPE	Insul. <input checked="" type="checkbox"/> Yes/No	PVC
		Length from Main to P/L:	11.79 m	8.96 m	Insul. <input checked="" type="checkbox"/> Yes/No
		Squirt Test:	<input checked="" type="checkbox"/> Pass/Fail		N/A
Booster Pump Required:	Yes/No	Frost Protection:	Aquaflow/ <input checked="" type="checkbox"/> Recirc/Heat Trace/Bleeder		N/A
PRV Required:	Yes/No	Greased @ CC:	<input checked="" type="checkbox"/> Yes/No		N/A
Water Meter Installed:	Yes/No	Continuity Test:	<input checked="" type="checkbox"/> N/A	Pass/Fail	N/A

CLEARLY INDICATE LOCATION OF CC AND ROUTE OF PIPES ON DRAWING BELOW

1. Show main valves required to isolate this service.
2. All dimensions to be tied to property line
3. All dimensions to be metric
4. Depth @ property line is based on elevation after construction and changes may have occurred.

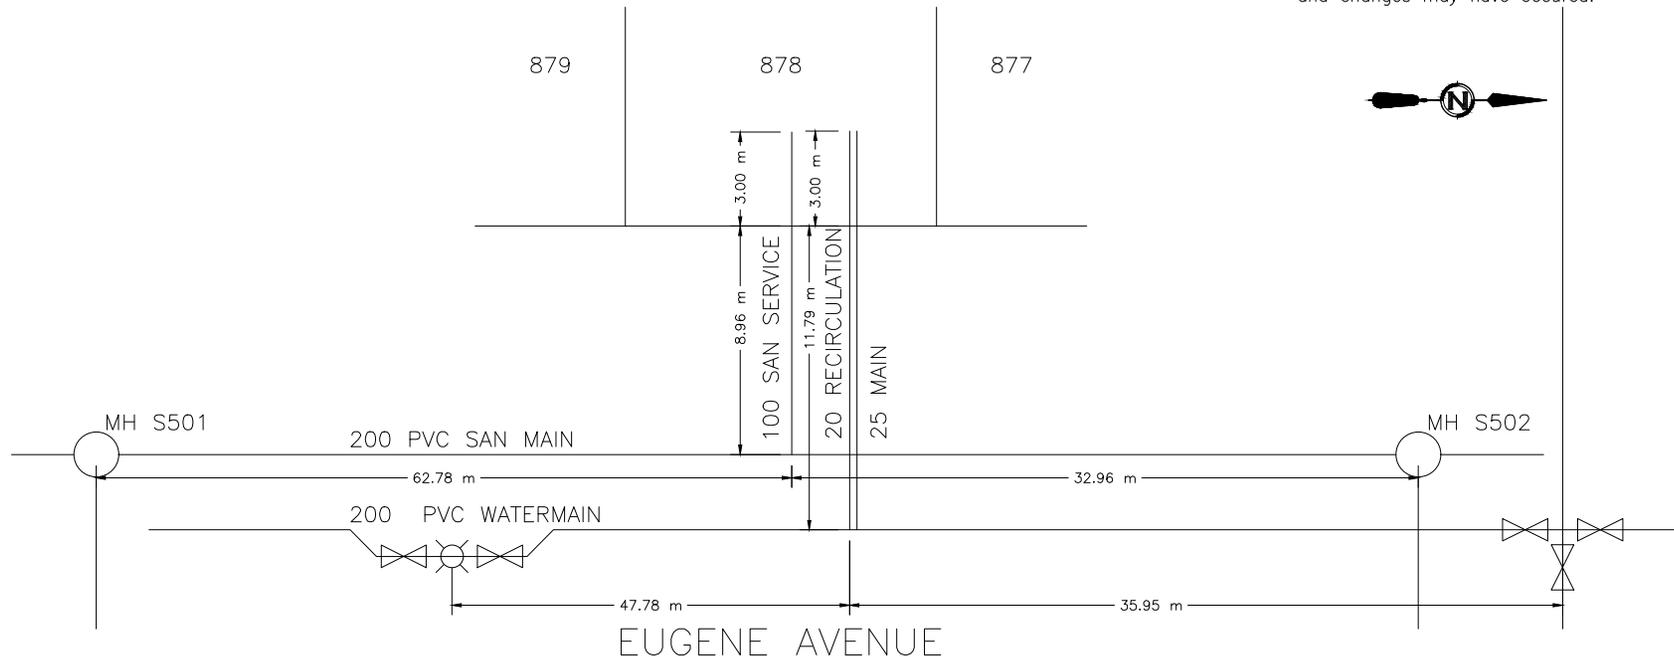



CITY OF WHITEHORSE SERVICE CONNECTION RECORD

FIELD BOOK


No.

ADDRESS 56 Eugene Avenue BLOCK LOT 879

DATES		WATER		SEWER	
On at Main	8/29/2019	Depth at P/L:	2.43 m	2.43	m
On at Building		Depth at Main:	2.48 m	2.71	m
Frost Plug:		Pipe Size:	25 mm / 20 mm	100	mm
Memo:		Pipe Material:	HDPE	Insul.	(Yes/No)
		Length from Main to P/L:	11.76 m	PVC	Insul. Yes/(No)
		Squirt Test:	(Pass/Fail)		N/A
Booster Pump Required:	Yes/No	Frost Protection:	Aquaflow/(Recirc)/Heat Trace/Bleeder		N/A
PRV Required:	Yes/No	Greased @ CC:	(Yes/No)		N/A
Water Meter Installed:	Yes/No	Continuity Test:	(N/A) Pass/Fail		N/A

CLEARLY INDICATE LOCATION OF CC AND ROUTE OF PIPES ON DRAWING BELOW

1. Show main valves required to isolate this service.
2. All dimensions to be tied to property line
3. All dimensions to be metric
4. Depth @ property line is based on elevation after construction and changes may have occurred.

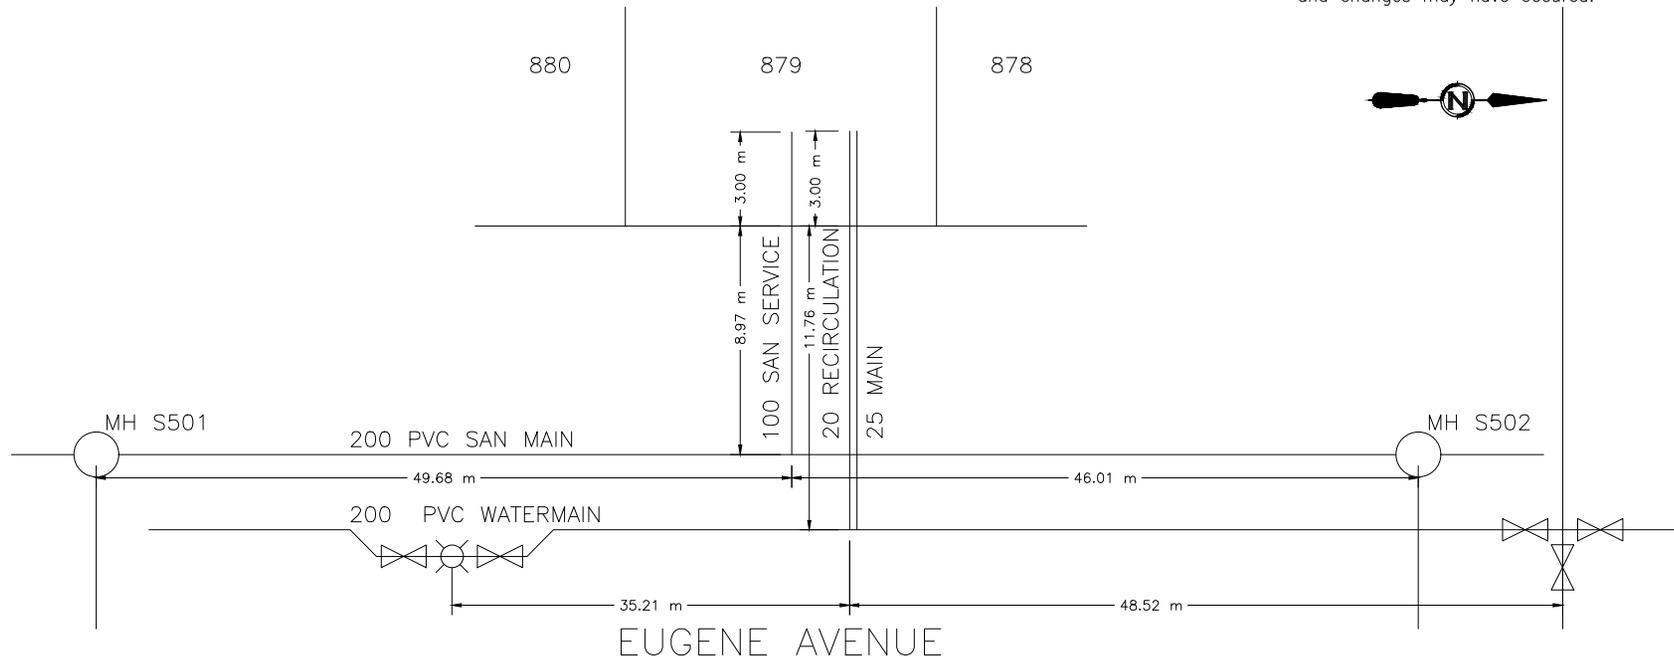



CITY OF WHITEHORSE SERVICE CONNECTION RECORD

FIELD BOOK


No.

ADDRESS 54 Eugene Avenue BLOCK LOT 880

DATES		WATER		SEWER	
On at Main	8/26/2019	Depth at P/L:	2.43 m	2.43	m
On at Building		Depth at Main:	2.62 m	2.85	m
Frost Plug:		Pipe Size:	25 mm / 20 mm	100	mm
Memo:		Pipe Material:	HDPE	Insul.	(Yes/No)
		Length from Main to P/L:	11.78 m	PVC	Insul. Yes/(No)
		Squirt Test:	(Pass/Fail)		N/A
Booster Pump Required:	Yes/No	Frost Protection:	Aquaflow/(Recirc)/Heat Trace/Bleeder		N/A
PRV Required:	Yes/No	Greased @ CC:	(Yes/No)		N/A
Water Meter Installed:	Yes/No	Continuity Test:	(N/A) Pass/Fail		N/A

CLEARLY INDICATE LOCATION OF CC AND ROUTE OF PIPES ON DRAWING BELOW

1. Show main valves required to isolate this service.
2. All dimensions to be tied to property line
3. All dimensions to be metric
4. Depth @ property line is based on elevation after construction and changes may have occurred.

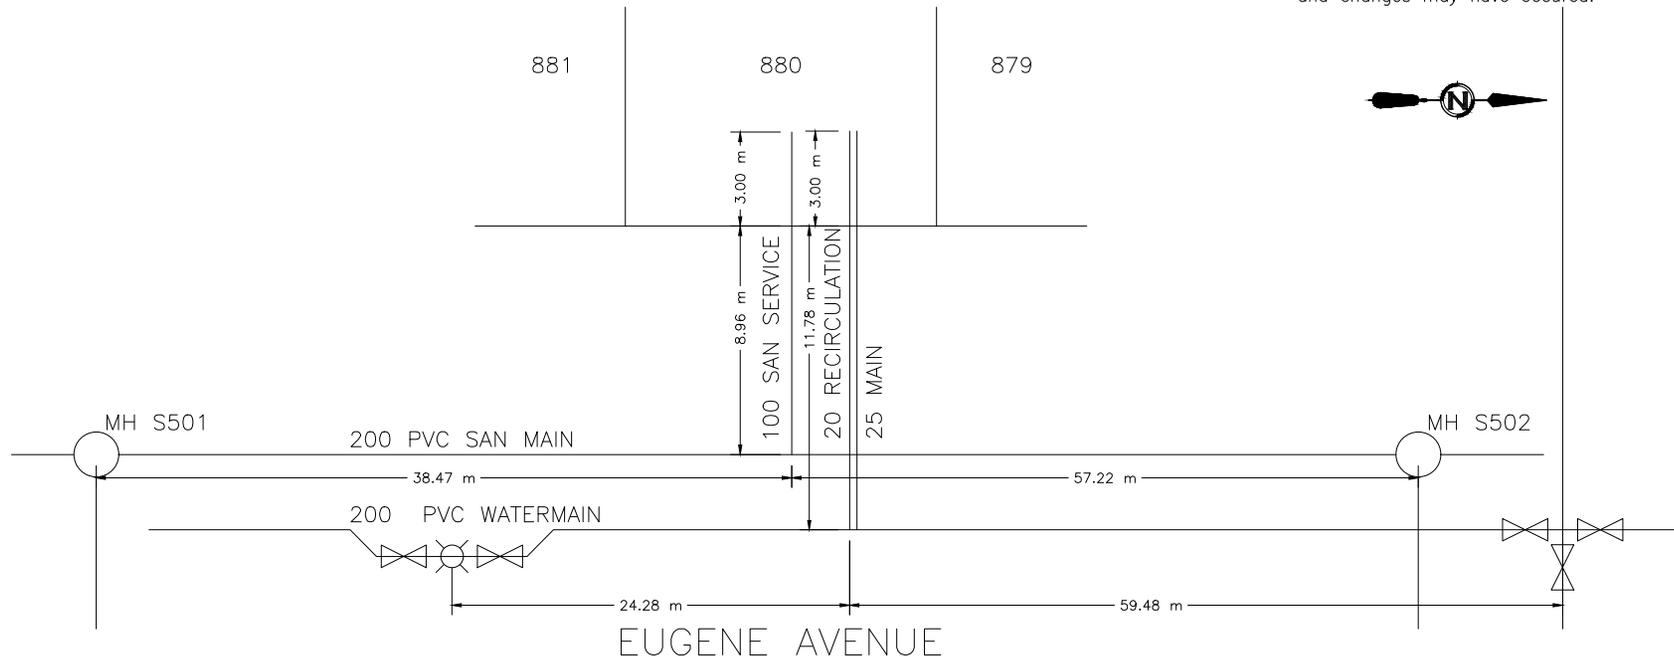



CITY OF WHITEHORSE SERVICE CONNECTION RECORD

FIELD BOOK


No.

ADDRESS 52 Eugene Avenue BLOCK LOT 881

DATES		WATER		SEWER	
On at Main	8/29/2019	Depth at P/L:	2.43 m	2.43	m
On at Building		Depth at Main:	2.78 m	2.99	m
Frost Plug:		Pipe Size:	25 mm / 20 mm	100	mm
Memo:		Pipe Material:	HDPE	Insul.	(Yes/No)
		Length from Main to P/L:	11.76 m	PVC	Insul. Yes/(No)
		Squirt Test:	(Pass/Fail)		N/A
Booster Pump Required:	Yes/No	Frost Protection:	Aquaflow/(Recirc)/Heat Trace/Bleeder		N/A
PRV Required:	Yes/No	Greased @ CC:	(Yes/No)		N/A
Water Meter Installed:	Yes/No	Continuity Test:	(N/A) Pass/Fail		N/A

CLEARLY INDICATE LOCATION OF CC AND ROUTE OF PIPES ON DRAWING BELOW

1. Show main valves required to isolate this service. 2. All dimensions to be tied to property line 3. All dimensions to be metric 4. Depth @ property line is based on elevation after construction and changes may have occurred.

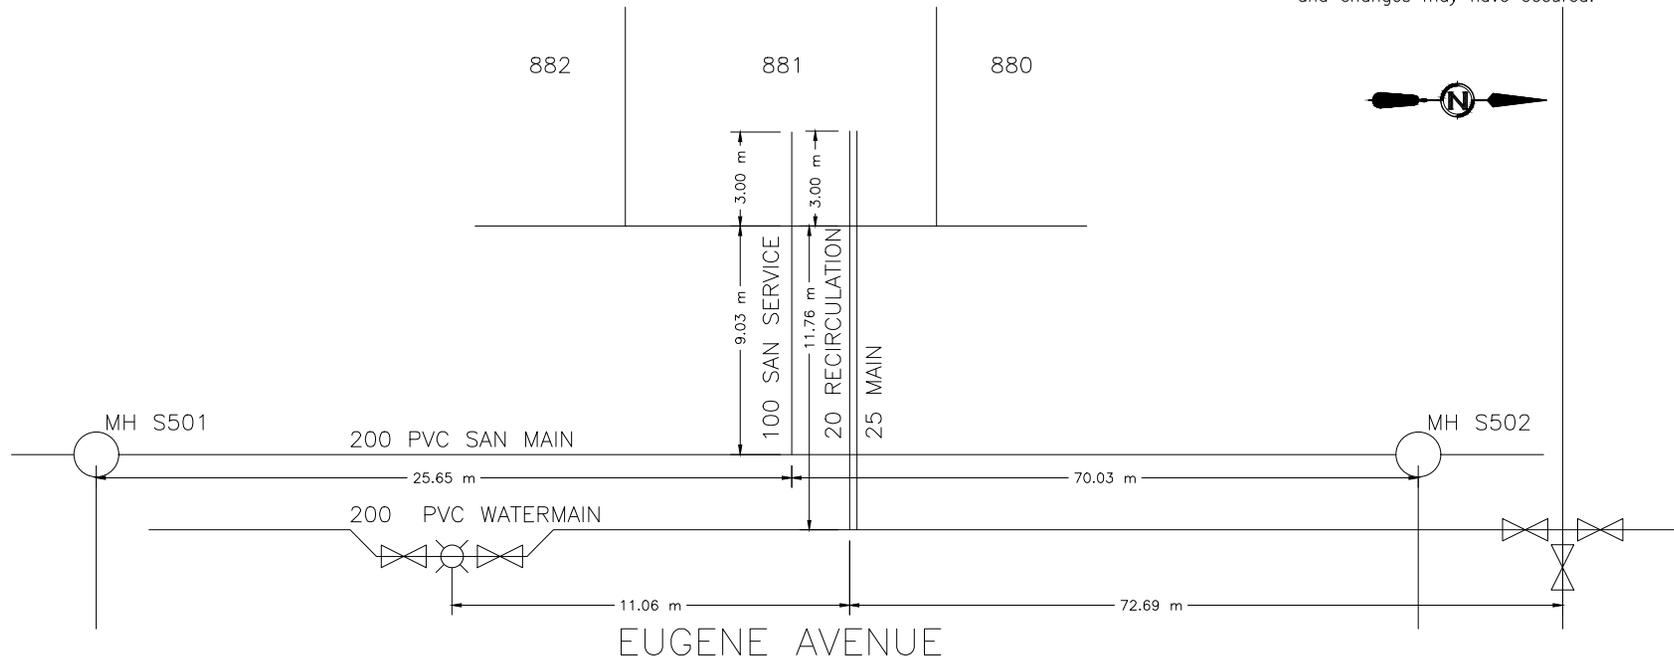



CITY OF WHITEHORSE SERVICE CONNECTION RECORD

FIELD BOOK


No.

ADDRESS 50 Eugene Avenue BLOCK LOT 882

DATES		WATER		SEWER	
On at Main	8/28/2019	Depth at P/L:	2.58 m	2.58	m
On at Building		Depth at Main:	2.84 m	3.08	m
Frost Plug:		Pipe Size:	25 mm / 20 mm	100	mm
Memo:		Pipe Material:	HDPE	Insul.	(Yes/No)
		Length from Main to P/L:	13.78 m	PVC	Insul. Yes/(No)
		Squirt Test:	(Pass/Fail)		N/A
Booster Pump Required:	Yes/No	Frost Protection:	Aquaflow/(Recirc)/Heat Trace/Bleeder		N/A
PRV Required:	Yes/No	Greased @ CC:	(Yes/No)		N/A
Water Meter Installed:	Yes/No	Continuity Test:	(N/A) Pass/Fail		N/A

CLEARLY INDICATE LOCATION OF CC AND ROUTE OF PIPES ON DRAWING BELOW

1. Show main valves required to isolate this service. 2. All dimensions to be tied to property line 3. All dimensions to be metric 4. Depth @ property line is based on elevation after construction and changes may have occurred.

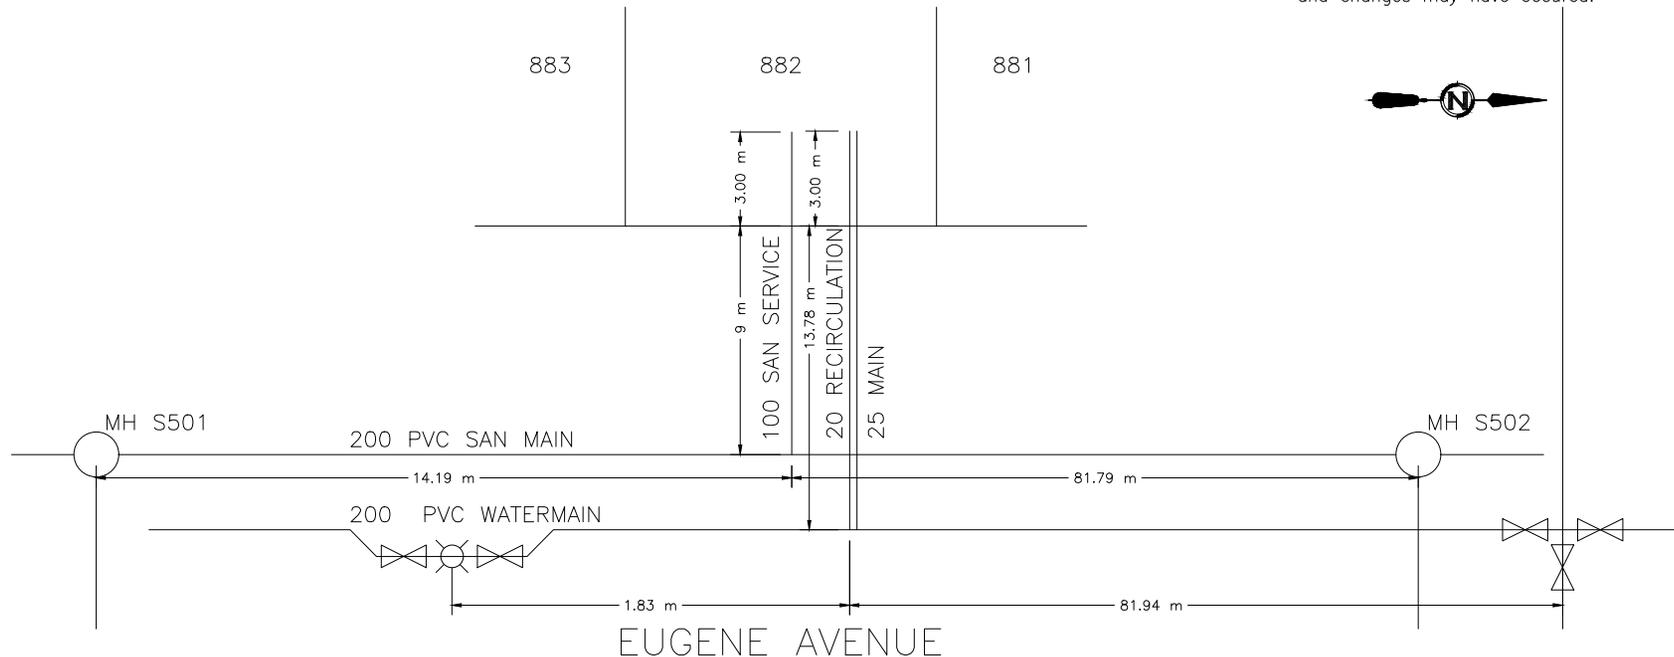



CITY OF WHITEHORSE SERVICE CONNECTION RECORD

FIELD BOOK


No.

ADDRESS 48 Eugene Avenue BLOCK LOT 883

DATES		WATER		SEWER	
On at Main	8/29/2019	Depth at P/L:	2.84 m	2.84	m
On at Building		Depth at Main:	3.08 m	3.33	m
Frost Plug:		Pipe Size:	25 mm / 20 mm	100	mm
Memo:		Pipe Material:	HDPE	Insul.	(Yes/No)
		Length from Main to P/L:	11.92 m	PVC	Insul. Yes/(No)
		Squirt Test:	(Pass/Fail)		N/A
Booster Pump Required:	Yes/No	Frost Protection:	Aquaflow/(Recirc)/Heat Trace/Bleeder		N/A
PRV Required:	Yes/No	Greased @ CC:	(Yes/No)		N/A
Water Meter Installed:	Yes/No	Continuity Test:	(N/A) Pass/Fail		N/A

CLEARLY INDICATE LOCATION OF CC AND ROUTE OF PIPES ON DRAWING BELOW

1. Show main valves required to isolate this service.
2. All dimensions to be tied to property line
3. All dimensions to be metric
4. Depth @ property line is based on elevation after construction and changes may have occurred.

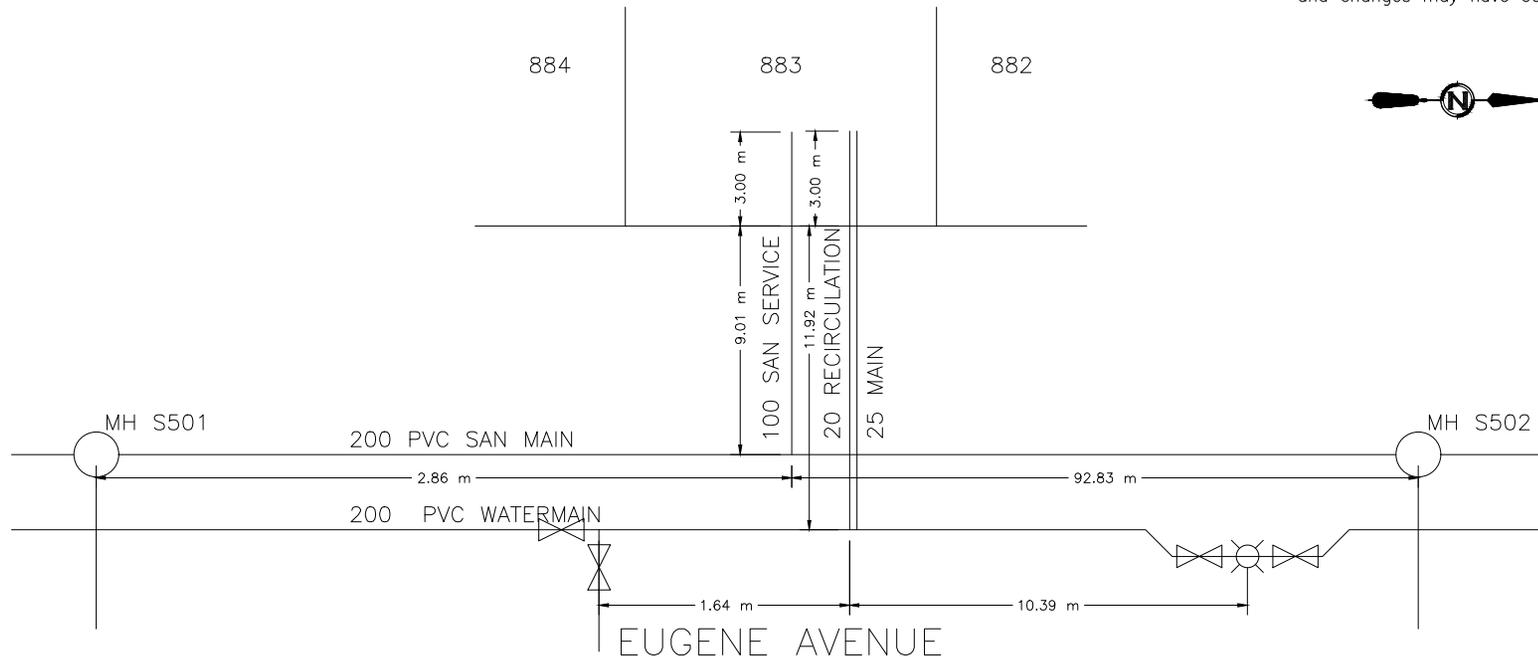



CITY OF WHITEHORSE SERVICE CONNECTION RECORD

FIELD BOOK


No. _____

ADDRESS 46 Eugene Avenue BLOCK LOT 884

	DATES	WATER	SEWER
On at Main		Depth at P/L: m	m
On at Building		Depth at Main: m	m
Frost Plug:		Pipe Size: mm / mm	mm
Memo:		Pipe Material: Insul. <input checked="" type="radio"/> Yes/No	Insul. Yes/ <input checked="" type="radio"/> No
		Length from Main to P/L: m	m
		Squirt Test: <input checked="" type="radio"/> Pass/Fail	N/A
Booster Pump Required:	Yes/No	Frost Protection: Aquaflow/ <input checked="" type="radio"/> Recirc/Heat Trace/Bleeder	N/A
PRV Required:	Yes/No	Greased @ CC: <input checked="" type="radio"/> Yes/No	N/A
Water Meter Installed:	Yes/No	Continuity Test: <input checked="" type="radio"/> N/A Pass/Fail	N/A

CLEARLY INDICATE LOCATION OF CC AND ROUTE OF PIPES ON DRAWING BELOW

1. Show main valves required to isolate this service. 2. All dimensions to be tied to property line 3. All dimensions to be metric 4. Depth @ property line is based on elevation after construction and changes may have occurred.

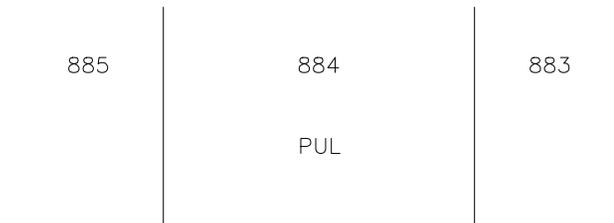

EUGENE AVENUE



CITY OF WHITEHORSE SERVICE CONNECTION RECORD

FIELD BOOK


No. _____

ADDRESS 44 Eugene Avenue BLOCK _____ LOT 885

DATES	WATER	SEWER
On at Main 8/28/2019	Depth at P/L: 2.59 m	2.56 m
On at Building	Depth at Main: 3.03 m	3.52 m
Frost Plug:	Pipe Size: 25 mm / 20 mm	100 mm
Memo:	Pipe Material: HDPE Insul. <u>(Yes)</u> /No	PVC Insul. Yes/ <u>(No)</u>
	Length from Main to P/L: 11.79 m	9 m
	Squirt Test: <u>(Pass)</u> /Fail	N/A
Booster Pump Required: Yes/No	Frost Protection: Aquaflo/ <u>(Recirc)</u> /Heat Trace/Bleeder	N/A
PRV Required: Yes/No	Greased @ CC: <u>(Yes)</u> /No	N/A
Water Meter Installed: Yes/No	Continuity Test: <u>(N/A)</u> Pass/Fail	N/A

CLEARLY INDICATE LOCATION OF CC AND ROUTE OF PIPES ON DRAWING BELOW

1. Show main valves required to isolate this service. 2. All dimensions to be tied to property line 3. All dimensions to be metric 4. Depth @ property line is based on elevation after construction and changes may have occurred.

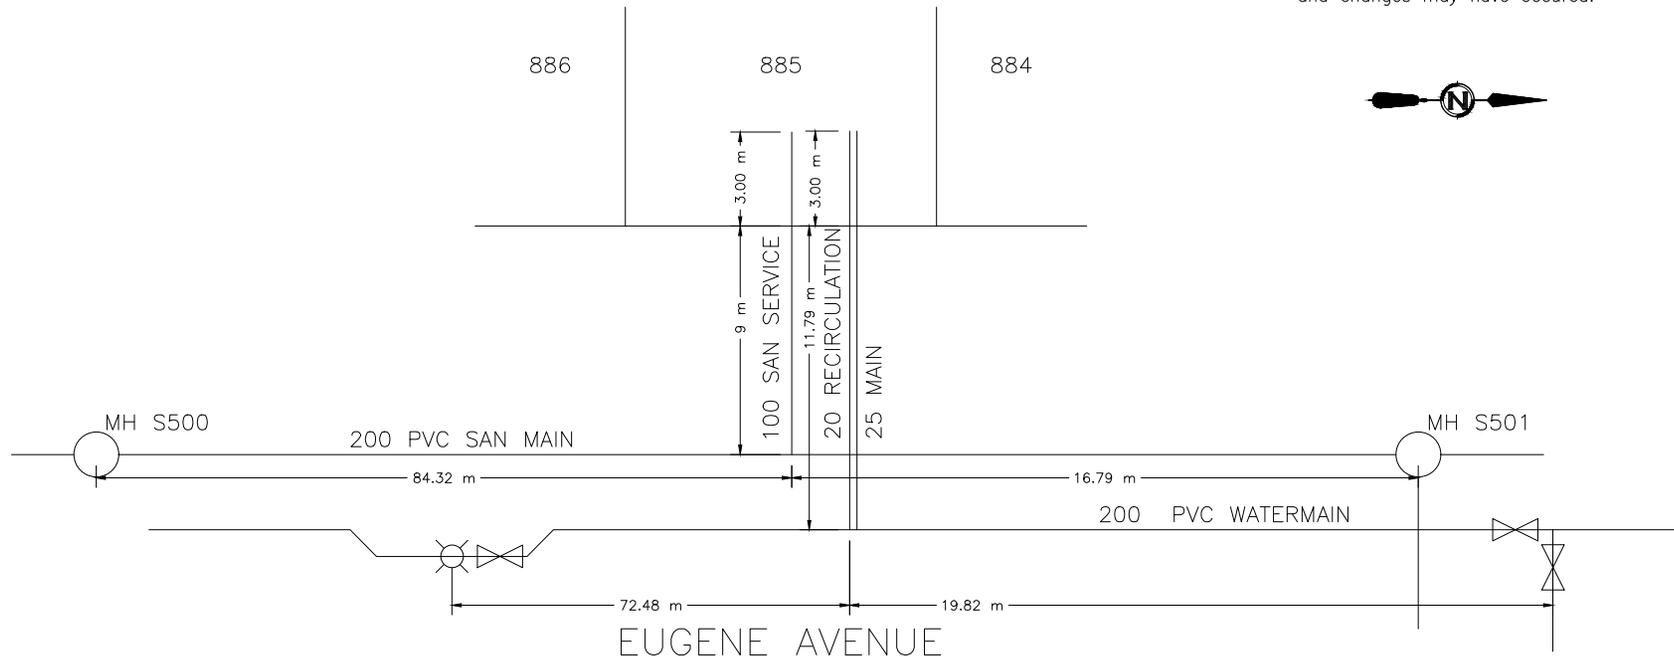



CITY OF WHITEHORSE SERVICE CONNECTION RECORD

FIELD BOOK


No.

ADDRESS 42 Eugene Avenue BLOCK LOT 886

DATES		WATER		SEWER	
On at Main	8/29/2019	Depth at P/L:	2.88 m	2.88	m
On at Building		Depth at Main:	2.93 m	3.68	m
Frost Plug:		Pipe Size:	25 mm / 20 mm	100	mm
Memo:		Pipe Material:	HDPE	Insul.	(Yes/No)
		Length from Main to P/L:	11.79 m	PVC	Insul. Yes/(No)
		Squirt Test:	(Pass/Fail)		N/A
Booster Pump Required:	Yes/No	Frost Protection:	Aquaflow/(Recirc)/Heat Trace/Bleeder		N/A
PRV Required:	Yes/No	Greased @ CC:	(Yes/No)		N/A
Water Meter Installed:	Yes/No	Continuity Test:	(N/A) Pass/Fail		N/A

CLEARLY INDICATE LOCATION OF CC AND ROUTE OF PIPES ON DRAWING BELOW

1. Show main valves required to isolate this service.
2. All dimensions to be tied to property line
3. All dimensions to be metric
4. Depth @ property line is based on elevation after construction and changes may have occurred.

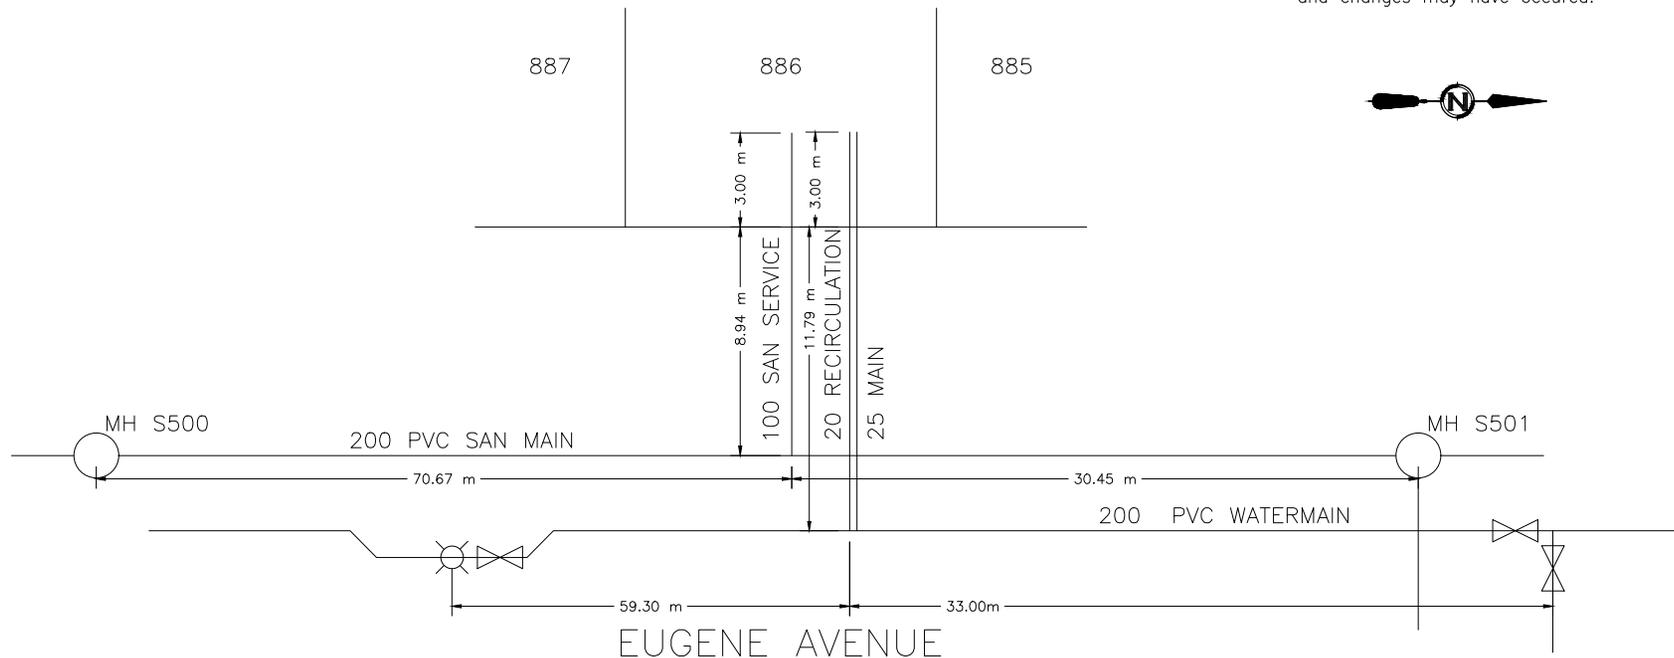



CITY OF WHITEHORSE SERVICE CONNECTION RECORD

FIELD BOOK


No.

ADDRESS 40 Eugene Avenue BLOCK LOT 887

DATES		WATER		SEWER	
On at Main	8/31/2019	Depth at P/L:	2.9 m		2.89 m
On at Building		Depth at Main:	3.42 m		3.84 m
Frost Plug:		Pipe Size:	25 mm / 20 mm		100 mm
Memo:		Pipe Material:	HDPE	Insul. <u>(Yes/No)</u>	PVC
		Length from Main to P/L:	11.74 m		8.97 m
		Squirt Test:	<u>(Pass)</u> /Fail		N/A
Booster Pump Required:	Yes/No	Frost Protection:	Aquaflow/ <u>(Recirc)</u> /Heat Trace/Bleeder		N/A
PRV Required:	Yes/No	Greased @ CC:	<u>(Yes)</u> /No		N/A
Water Meter Installed:	Yes/No	Continuity Test:	<u>(N/A)</u>	Pass/Fail	N/A

CLEARLY INDICATE LOCATION OF CC AND ROUTE OF PIPES ON DRAWING BELOW

1. Show main valves required to isolate this service. 2. All dimensions to be tied to property line 3. All dimensions to be metric 4. Depth @ property line is based on elevation after construction and changes may have occurred.

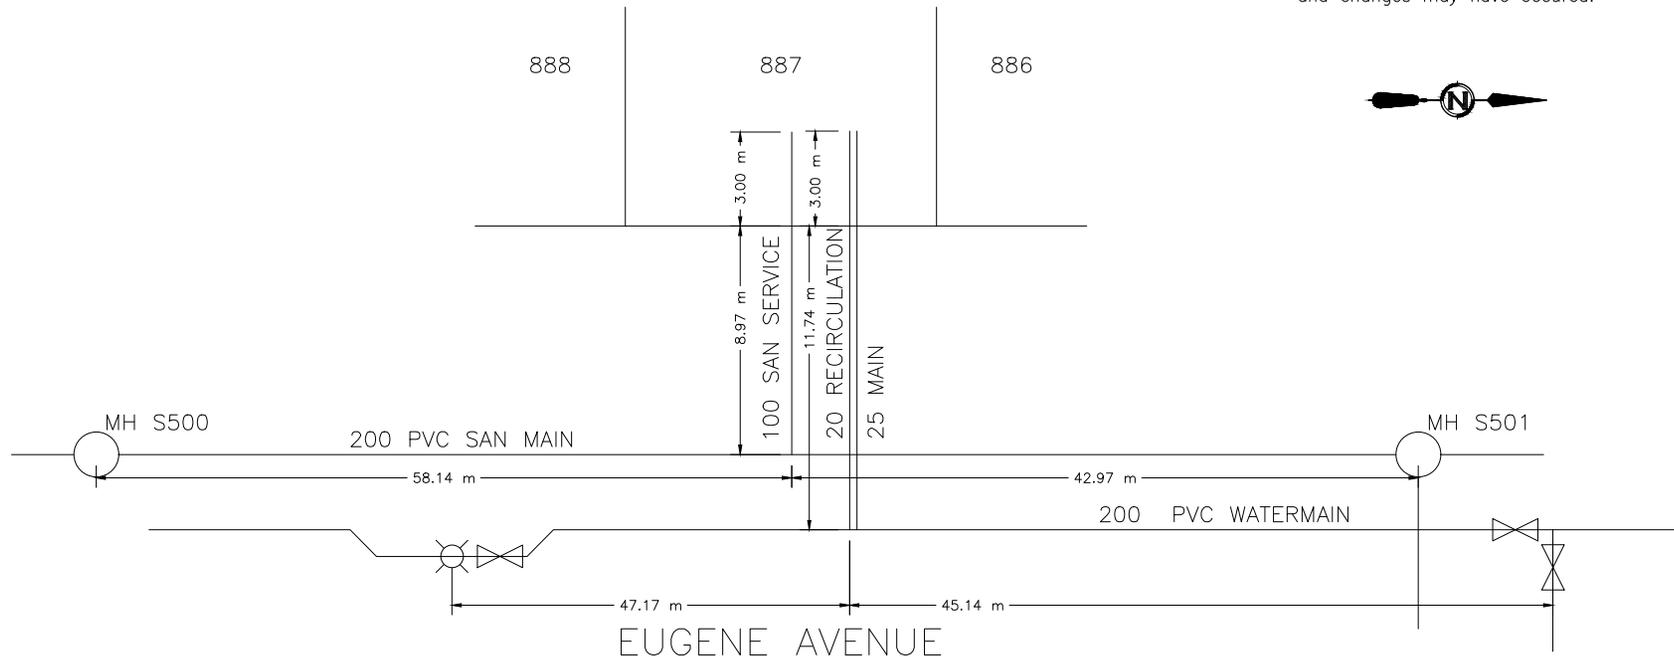



CITY OF WHITEHORSE SERVICE CONNECTION RECORD

FIELD BOOK


No.

ADDRESS 38 Eugene Avenue BLOCK LOT 888

DATES	WATER	SEWER
On at Main 9/3/2019	Depth at P/L: 2.94 m	2.9 m
On at Building	Depth at Main: 3.65 m	4.05 m
Frost Plug:	Pipe Size: 25 mm / 20 mm	100 mm
Memo:	Pipe Material: HDPE	Insul. <input checked="" type="checkbox"/> Yes/No
	Length from Main to P/L: 11.71 m	PVC
	Squirt Test:	Insul. Yes/ <input checked="" type="checkbox"/> No
Booster Pump Required: Yes/No	Frost Protection: Aquaflo/ <input checked="" type="checkbox"/> Recirc/Heat Trace/Bleeder	N/A
PRV Required: Yes/No	Greased @ CC: <input checked="" type="checkbox"/> Yes/No	N/A
Water Meter Installed: Yes/No	Continuity Test: <input checked="" type="checkbox"/> N/A	Pass/Fail

CLEARLY INDICATE LOCATION OF CC AND ROUTE OF PIPES ON DRAWING BELOW

1. Show main valves required to isolate this service. 2. All dimensions to be tied to property line 3. All dimensions to be metric 4. Depth @ property line is based on elevation after construction and changes may have occurred.

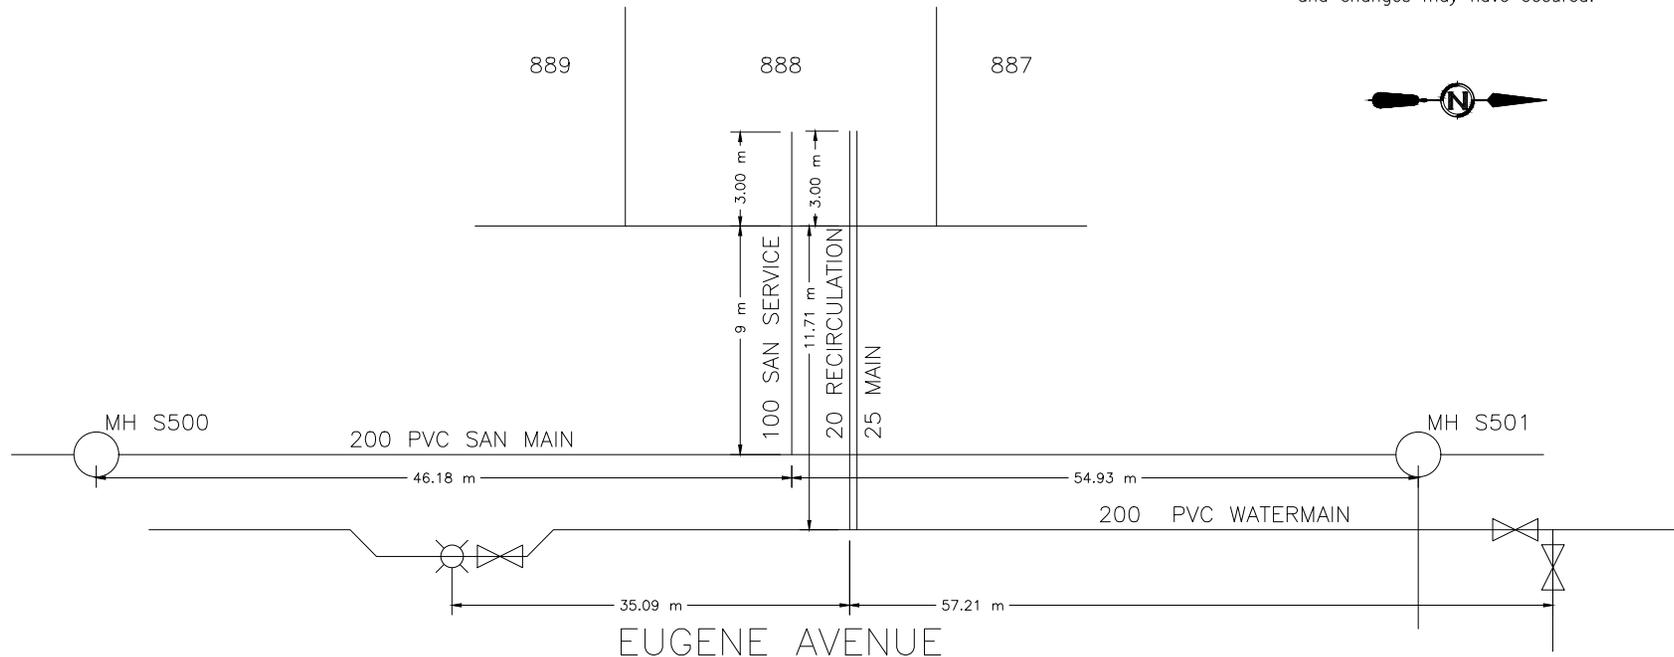



CITY OF WHITEHORSE SERVICE CONNECTION RECORD

FIELD BOOK

No.

ADDRESS 36 Eugene Avenue BLOCK LOT 889

DATES	WATER	SEWER
On at Main 8/30/2019	Depth at P/L: 2.96 m	2.95 m
On at Building	Depth at Main: 3.61 m	4.21 m
Frost Plug:	Pipe Size: 25 mm / 20 mm	100 mm
Memo:	Pipe Material: HDPE Insul. <u>(Yes)</u> /No	PVC Insul. Yes/ <u>(No)</u>
	Length from Main to P/L: 11.8 m	8.97 m
	Squirt Test: <u>(Pass)</u> /Fail	N/A
Booster Pump Required: Yes/No	Frost Protection: Aquaflo/ <u>(Recirc)</u> /Heat Trace/Bleeder	N/A
PRV Required: Yes/No	Greased @ CC: <u>(Yes)</u> /No	N/A
Water Meter Installed: Yes/No	Continuity Test: <u>(N/A)</u> Pass/Fail	N/A

CLEARLY INDICATE LOCATION OF CC AND ROUTE OF PIPES ON DRAWING BELOW

1. Show main valves required to isolate this service. 2. All dimensions to be tied to property line 3. All dimensions to be metric 4. Depth @ property line is based on elevation after construction and changes may have occurred.





CITY OF WHITEHORSE SERVICE CONNECTION RECORD

FIELD BOOK


No.

ADDRESS 34 Eugene Avenue BLOCK LOT 890

DATES		WATER		SEWER	
On at Main	8/30/2019	Depth at P/L:	2.97 m	2.96 m	
On at Building		Depth at Main:	3.64 m	4.36 m	
Frost Plug:		Pipe Size:	25 mm / 20 mm	100 mm	
Memo:		Pipe Material:	HDPE	Insul. <input checked="" type="checkbox"/> Yes/No	PVC
		Length from Main to P/L:	11.93 m	8.9 m	Insul. Yes/ <input checked="" type="checkbox"/> No
		Squirt Test:	<input checked="" type="checkbox"/> Pass/Fail		N/A
Booster Pump Required:	Yes/No	Frost Protection:	Aquaflow/ <input checked="" type="checkbox"/> Recirc/Heat Trace/Bleeder		N/A
PRV Required:	Yes/No	Greased @ CC:	<input checked="" type="checkbox"/> Yes/No		N/A
Water Meter Installed:	Yes/No	Continuity Test:	<input checked="" type="checkbox"/> N/A	Pass/Fail	N/A

CLEARLY INDICATE LOCATION OF CC AND ROUTE OF PIPES ON DRAWING BELOW

1. Show main valves required to isolate this service.
2. All dimensions to be tied to property line
3. All dimensions to be metric
4. Depth @ property line is based on elevation after construction and changes may have occurred.

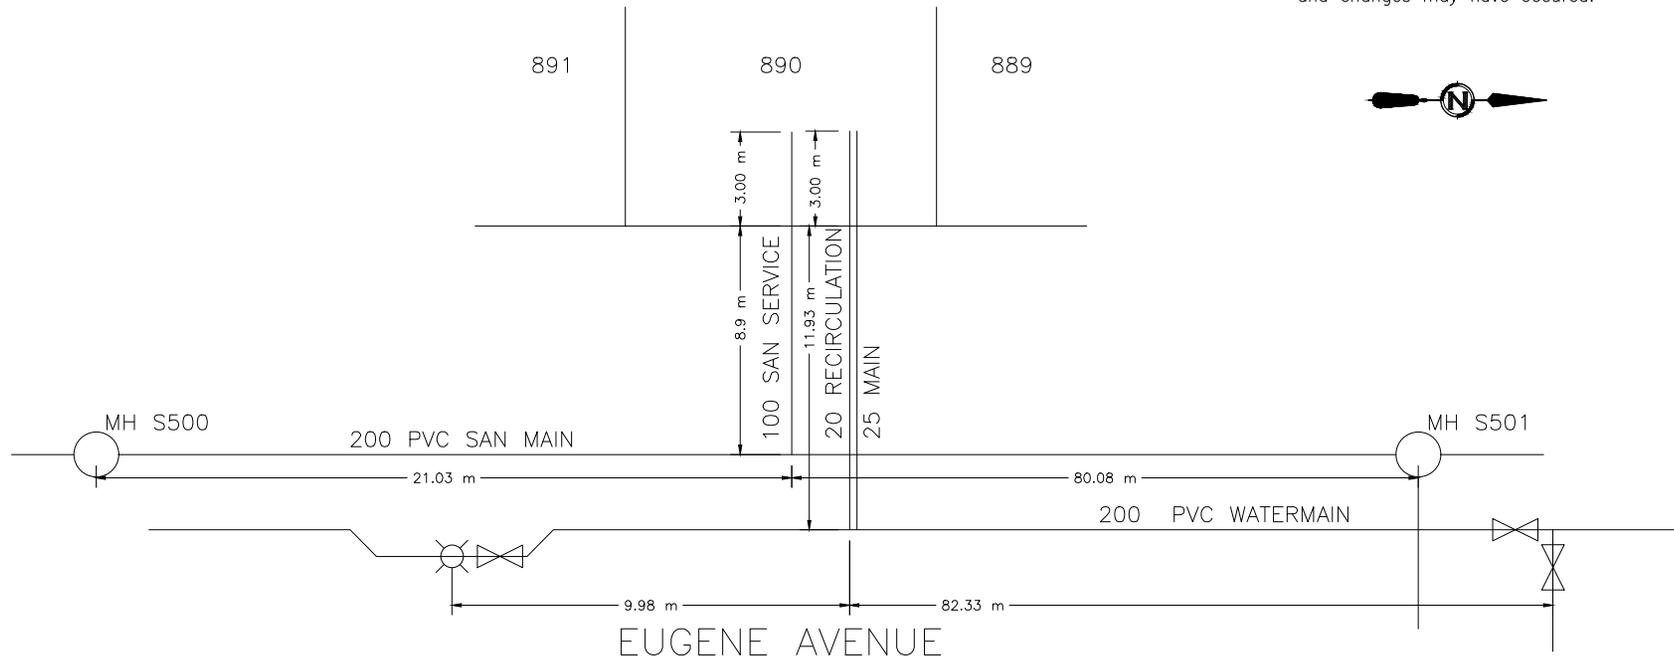



CITY OF WHITEHORSE SERVICE CONNECTION RECORD

FIELD BOOK

No.

ADDRESS 32 Eugene Avenue BLOCK LOT 891

DATES	WATER	SEWER
On at Main 8/27/2019	Depth at P/L: 3.04 m	2.84 m
On at Building	Depth at Main: 4.09 m	4.5 m
Frost Plug:	Pipe Size: 25 mm / 20 mm	100 mm
Memo:	Pipe Material: HDPE Insul. <u>(Yes)</u> /No	PVC Insul. Yes/ <u>(No)</u>
	Length from Main to P/L: 11.84 m	9.14 m
	Squirt Test: <u>(Pass)</u> /Fail	N/A
Booster Pump Required: Yes/No	Frost Protection: Aquaflow/ <u>(Recirc)</u> /Heat Trace/Bleeder	N/A
PRV Required: Yes/No	Greased @ CC: <u>(Yes)</u> /No	N/A
Water Meter Installed: Yes/No	Continuity Test: <u>(N/A)</u> Pass/Fail	N/A

CLEARLY INDICATE LOCATION OF CC AND ROUTE OF PIPES ON DRAWING BELOW

1. Show main valves required to isolate this service. 2. All dimensions to be tied to property line 3. All dimensions to be metric 4. Depth @ property line is based on elevation after construction and changes may have occurred.





CITY OF WHITEHORSE SERVICE CONNECTION RECORD

FIELD BOOK


No.

ADDRESS 164 Witch Hazel Drive BLOCK LOT 943

DATES	WATER	SEWER
On at Main 8/5/2019	Depth at P/L: 2.44 m	2.35 m
On at Building	Depth at Main: 2.88 m	4.45 m
Frost Plug:	Pipe Size: 25 mm / 20 mm	100 mm
Memo:	Pipe Material: HDPE Insul. <u>(Yes)</u> /No	PVC Insul. Yes/ <u>(No)</u>
	Length from Main to P/L: 7.16 m	10.35 m
	Squirt Test: <u>(Pass)</u> /Fail	N/A
Booster Pump Required: Yes/No	Frost Protection: Aquaflo/ <u>(Recirc)</u> /Heat Trace/Bleeder	N/A
PRV Required: Yes/No	Greased @ CC: <u>(Yes)</u> /No	N/A
Water Meter Installed: Yes/No	Continuity Test: <u>(N/A)</u> Pass/Fail	N/A

CLEARLY INDICATE LOCATION OF CC AND ROUTE OF PIPES ON DRAWING BELOW

1. Show main valves required to isolate this service. 2. All dimensions to be tied to property line 3. All dimensions to be metric 4. Depth @ property line is based on elevation after construction and changes may have occurred.

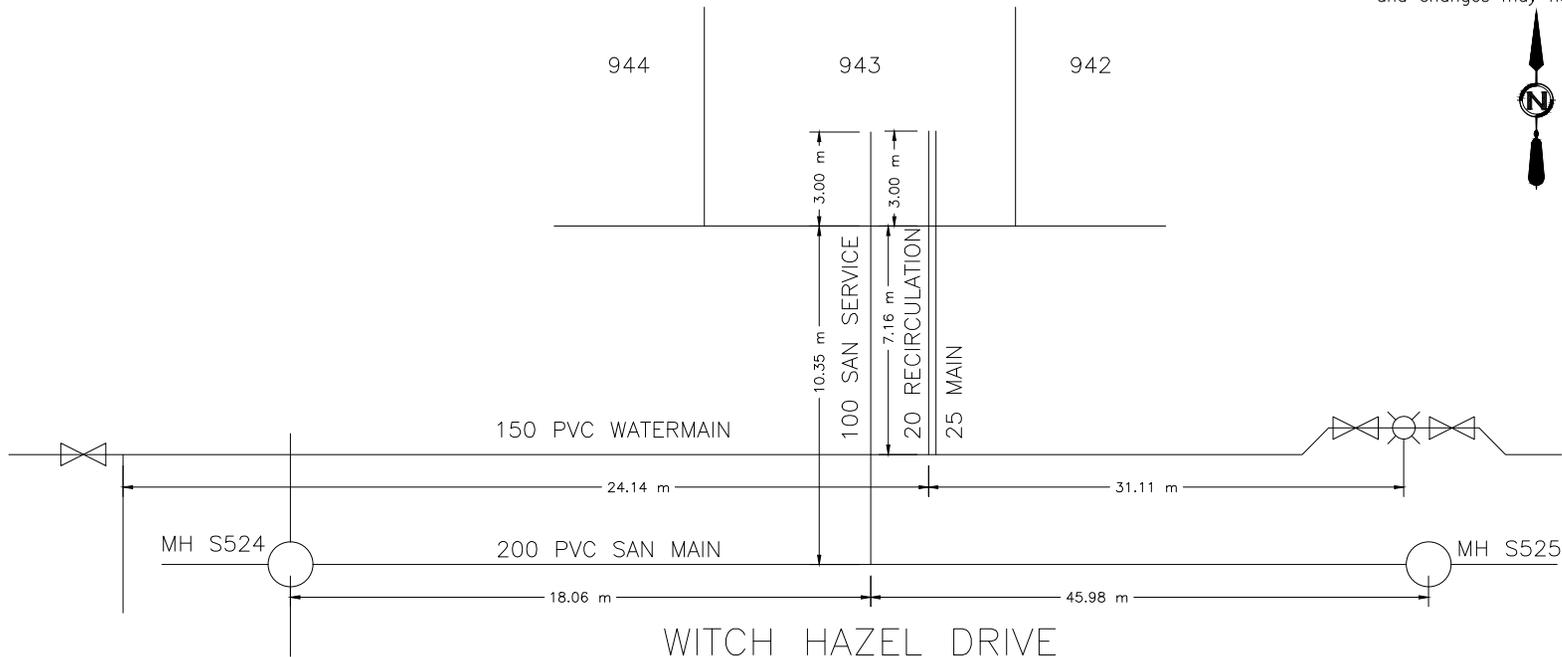



CITY OF WHITEHORSE SERVICE CONNECTION RECORD

FIELD BOOK


No.

ADDRESS 165 Witch Hazel Drive BLOCK LOT 944

DATES	WATER	SEWER
On at Main 8/7/2019	Depth at P/L: 2.46 m	2.51 m
On at Building	Depth at Main: 2.84 m	4.47 m
Frost Plug:	Pipe Size: 25 mm / 20 mm	100 mm
Memo:	Pipe Material: HDPE Insul. <u>(Yes)</u> /No	PVC Insul. Yes/ <u>(No)</u>
	Length from Main to P/L: 7.32 m	10.4 m
	Squirt Test: <u>(Pass)</u> /Fail	N/A
Booster Pump Required: Yes/No	Frost Protection: Aquaflow/ <u>(Recirc)</u> /Heat Trace/Bleeder	N/A
PRV Required: Yes/No	Greased @ CC: <u>(Yes)</u> /No	N/A
Water Meter Installed: Yes/No	Continuity Test: <u>(N/A)</u> Pass/Fail	N/A

CLEARLY INDICATE LOCATION OF CC AND ROUTE OF PIPES ON DRAWING BELOW

1. Show main valves required to isolate this service. 2. All dimensions to be tied to property line 3. All dimensions to be metric 4. Depth @ property line is based on elevation after construction and changes may have occurred.

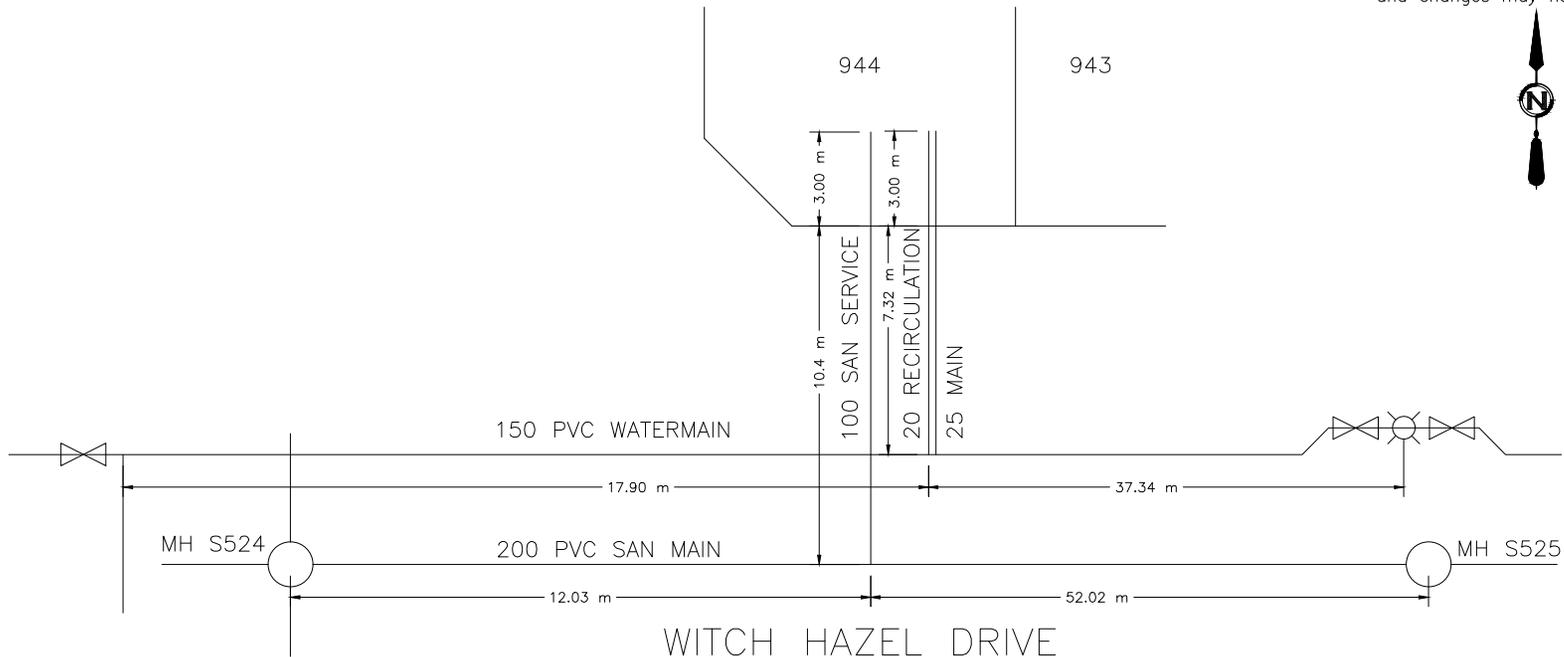



CITY OF WHITEHORSE SERVICE CONNECTION RECORD

FIELD BOOK


No.

ADDRESS 125 Witch Hazel Drive BLOCK LOT 945

DATES		WATER		SEWER
On at Main	8/2/2019	Depth at P/L:	2.68 m	#N/A m
On at Building		Depth at Main:	3.28 m	#N/A m
Frost Plug:		Pipe Size:	50 mm / mm	mm
Memo:		Pipe Material:	HDPE Insul. <u>(Yes)</u> /No	PVC Insul. Yes/ <u>(No)</u>
		Length from Main to P/L:	7.22 m	#N/A m
		Squirt Test:	<u>(Pass)</u> /Fail	N/A
Booster Pump Required:	Yes/No	Frost Protection:	Aquaflow/ <u>(Recirc)</u> /Heat Trace/Bleeder	N/A
PRV Required:	Yes/No	Greased @ CC:	<u>(Yes)</u> /No	N/A
Water Meter Installed:	Yes/No	Continuity Test:	<u>(N/A)</u> Pass/Fail	N/A

CLEARLY INDICATE LOCATION OF CC AND ROUTE OF PIPES ON DRAWING BELOW

1. Show main valves required to isolate this service. 2. All dimensions to be tied to property line 3. All dimensions to be metric 4. Depth @ property line is based on elevation after construction and changes may have occurred.

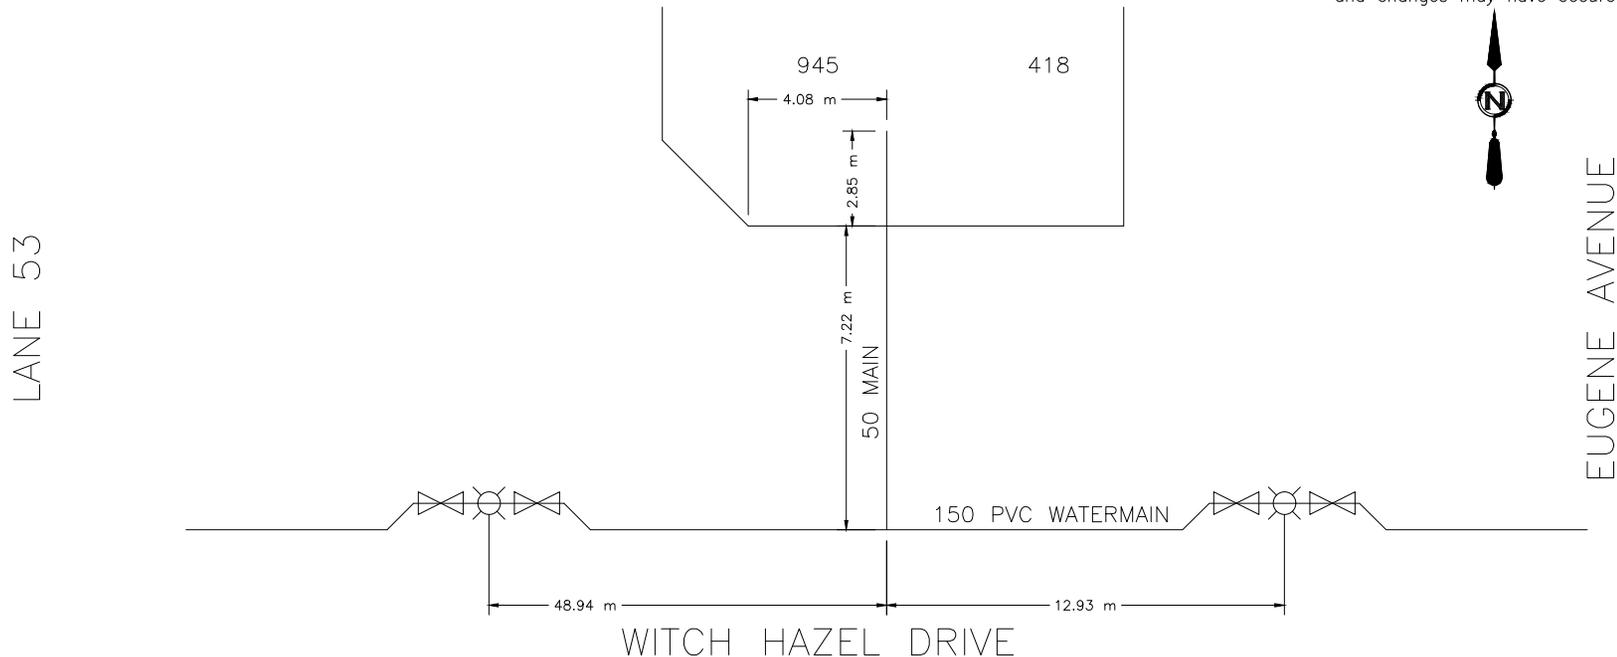



CITY OF WHITEHORSE SERVICE CONNECTION RECORD

FIELD BOOK


No.

ELEMENT 1 ADDRESS 1234 SOMEWHERE LANE ELEMENT 2
 ELEMENT 3 BLOCK ELEMENT 4 LOT 200

DATES		WATER		SEWER	
On at Main	YYYYMMDD	Depth at P/L:	#N/Am	#N/A	m
On at Building		Depth at Main:	#N/Am	#N/A	m
Frost Plug:		Pipe Size:	25 mm / 20 mm	100	mm
Memo:		Pipe Material:	HDPE	PVC	
		Insul.	(Yes/No)	Insul.	(Yes/No)
		Length from Main to P/L:	#N/A m	#N/A	m
		Squirt Test:	(Pass/Fail)		N/A
Booster Pump Required:	Yes/No	Frost Protection:	Aquaflow/Recirc/Heat Trace/Bleeder		N/A
PRV Required:	Yes/No	Greased @ CC:	(Yes/No)		N/A
Water Meter Installed:	Yes/No	Continuity Test:	(N/A) Pass/Fail		N/A

CLEARLY INDICATE LOCATION OF CC AND ROUTE OF PIPES ON DRAWING BELOW

- Show main valves required to isolate this service.
- All dimensions to be tied to property line
- All dimensions to be metric
- Depth @ property line is based on elevation after construction and changes may have occurred.

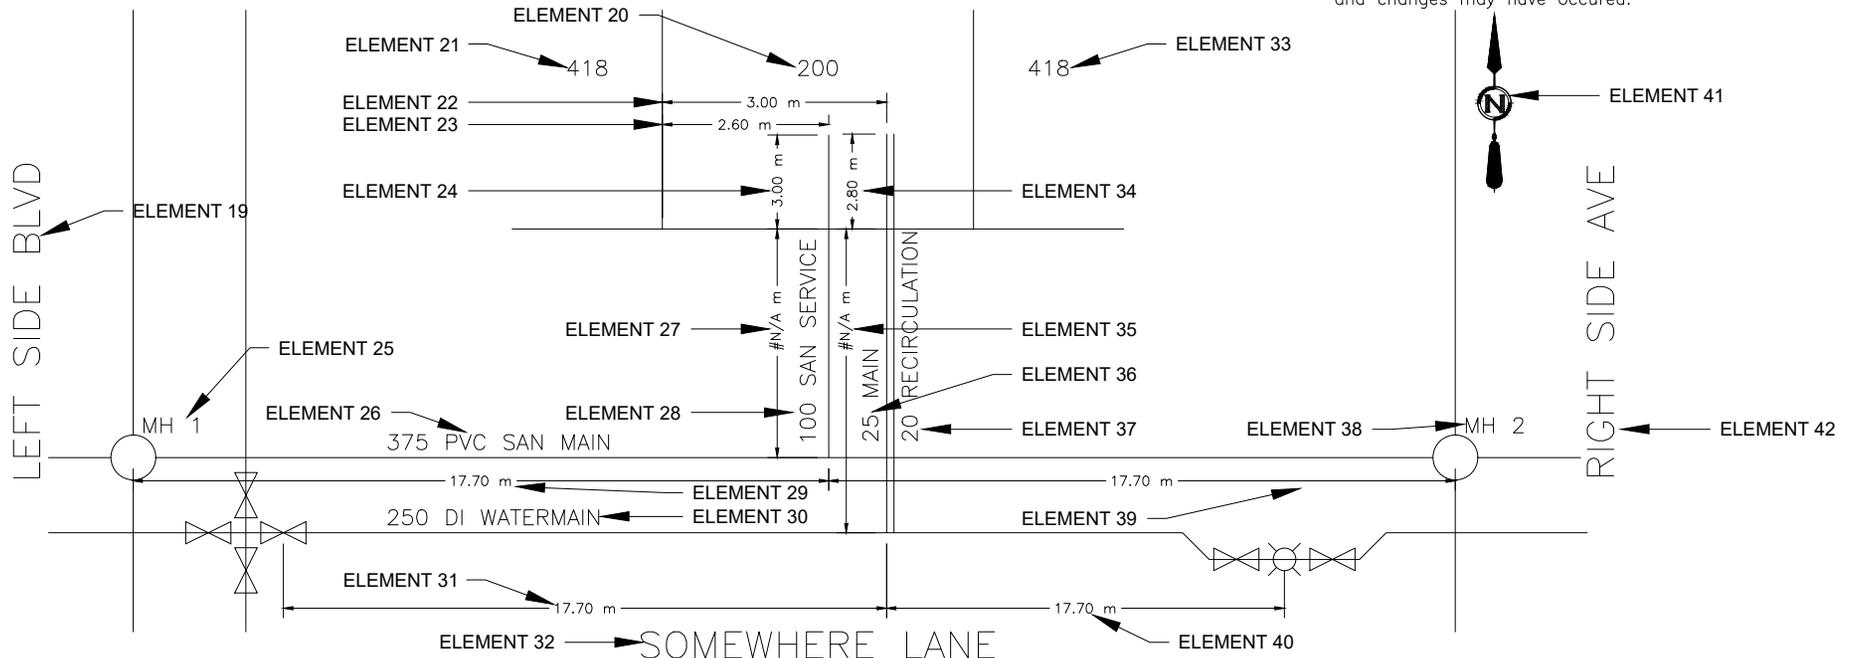



CITY OF WHITEHORSE SERVICE CONNECTION RECORD

FIELD BOOK


No.

ADDRESS 1 Reliance Street BLOCK LOT 892

DATES		WATER	SEWER
On at Main 2019		Depth at P/L: 2.19 m	2.13 m
On at Building		Depth at Main: 3.78 m	2.57 m
Frost Plug:		Pipe Size: 25 mm / 20 mm	100 mm
Memo:	Pipe Material: HDPE Insul. <u>(Yes)</u> /No		PVC Insul. <u>(Yes)</u> /No
	Length from Main to P/L: 5.91 m		8.97 m
	Squirt Test: <u>(Pass)</u> /Fail		N/A
Booster Pump Required:	Yes/No	Frost Protection: Aquaflow/ <u>(Recirc)</u> /Heat Trace/Bleeder	N/A
PRV Required:	Yes/No	Greased @ CC: <u>(Yes)</u> /No	N/A
Water Meter Installed:	Yes/No	Continuity Test: <u>(N/A)</u> Pass/Fail	N/A

CLEARLY INDICATE LOCATION OF CC AND ROUTE OF PIPES ON DRAWING BELOW

1. Show main valves required to isolate this service. 2. All dimensions to be tied to property line 3. All dimensions to be metric 4. Depth @ property line is based on elevation after construction and changes may have occurred.

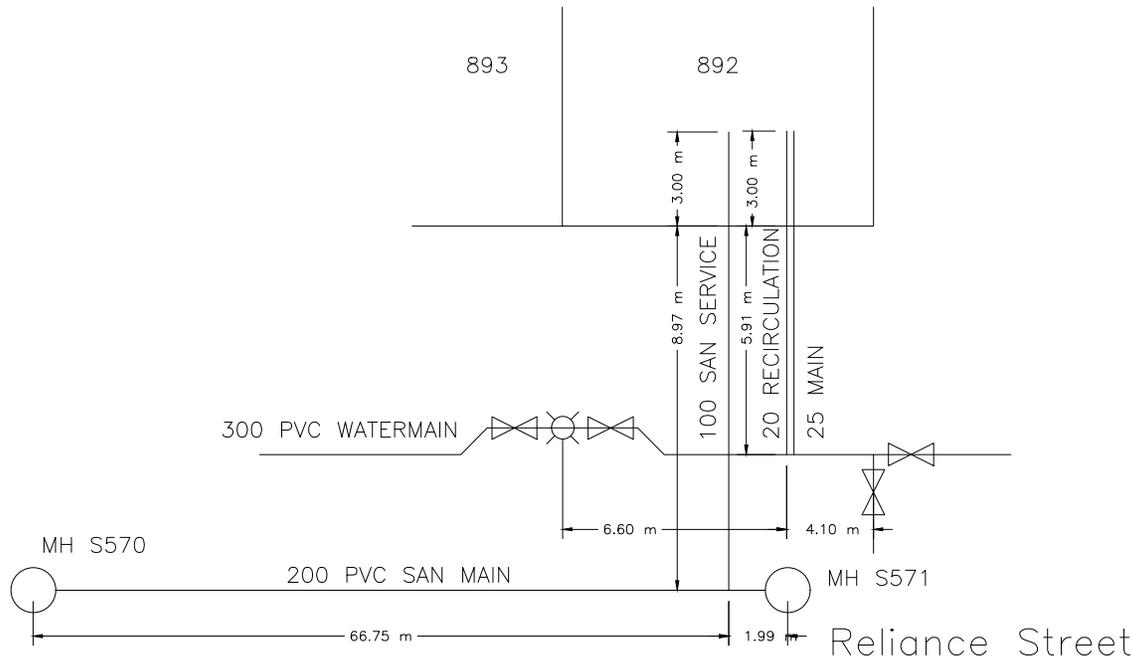



CITY OF WHITEHORSE SERVICE CONNECTION RECORD

FIELD BOOK


No.

ADDRESS 3 Reliance Street BLOCK LOT 893

	DATES	WATER	SEWER
On at Main	2019	Depth at P/L: 2.28 m	2.31 m
On at Building		Depth at Main: 3.78 m	2.68 m
Frost Plug:		Pipe Size: 25 mm / 20 mm	100 mm
Memo:		Pipe Material: HDPE	PVC
		Insul. (Yes/No)	Insul. (Yes/No)
		Length from Main to P/L: 5.88 m	9.01 m
		Squirt Test: (Pass/Fail)	N/A
Booster Pump Required:	Yes/No	Frost Protection: Aquaflo/(Recirc)/Heat Trace/Bleeder	N/A
PRV Required:	Yes/No	Greased @ CC: (Yes/No)	N/A
Water Meter Installed:	Yes/No	Continuity Test: (N/A)	N/A

CLEARLY INDICATE LOCATION OF CC AND ROUTE OF PIPES ON DRAWING BELOW

1. Show main valves required to isolate this service. 2. All dimensions to be tied to property line 3. All dimensions to be metric 4. Depth @ property line is based on elevation after construction and changes may have occurred.

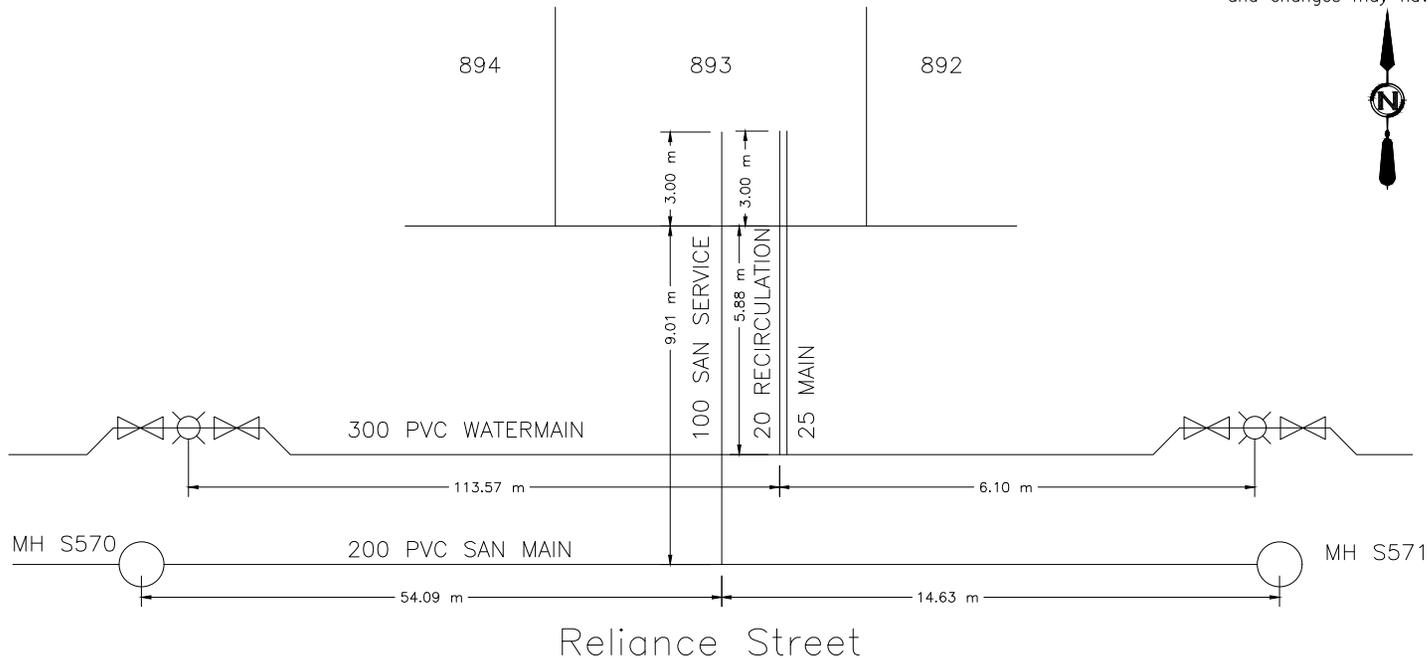



CITY OF WHITEHORSE SERVICE CONNECTION RECORD

FIELD BOOK


No.

ADDRESS 5 Reliance Street BLOCK LOT 894

DATES	WATER	SEWER
On at Main 2019	Depth at P/L: 2.4 m	2.39 m
On at Building	Depth at Main: 3.64 m	2.8 m
Frost Plug:	Pipe Size: 25 mm / 20 mm	100 mm
Memo:	Pipe Material: HDPE Insul. <u>(Yes)</u> /No	PVC Insul. Yes/ <u>(No)</u>
	Length from Main to P/L: 5.71 m	8.99 m
	Squirt Test: <u>(Pass)</u> /Fail	N/A
Booster Pump Required: Yes/No	Frost Protection: Aquaflo/ <u>(Recirc)</u> /Heat Trace/Bleeder	N/A
PRV Required: Yes/No	Greased @ CC: <u>(Yes)</u> /No	N/A
Water Meter Installed: Yes/No	Continuity Test: <u>(N/A)</u> Pass/Fail	N/A

CLEARLY INDICATE LOCATION OF CC AND ROUTE OF PIPES ON DRAWING BELOW

1. Show main valves required to isolate this service. 2. All dimensions to be tied to property line 3. All dimensions to be metric 4. Depth @ property line is based on elevation after construction and changes may have occurred.

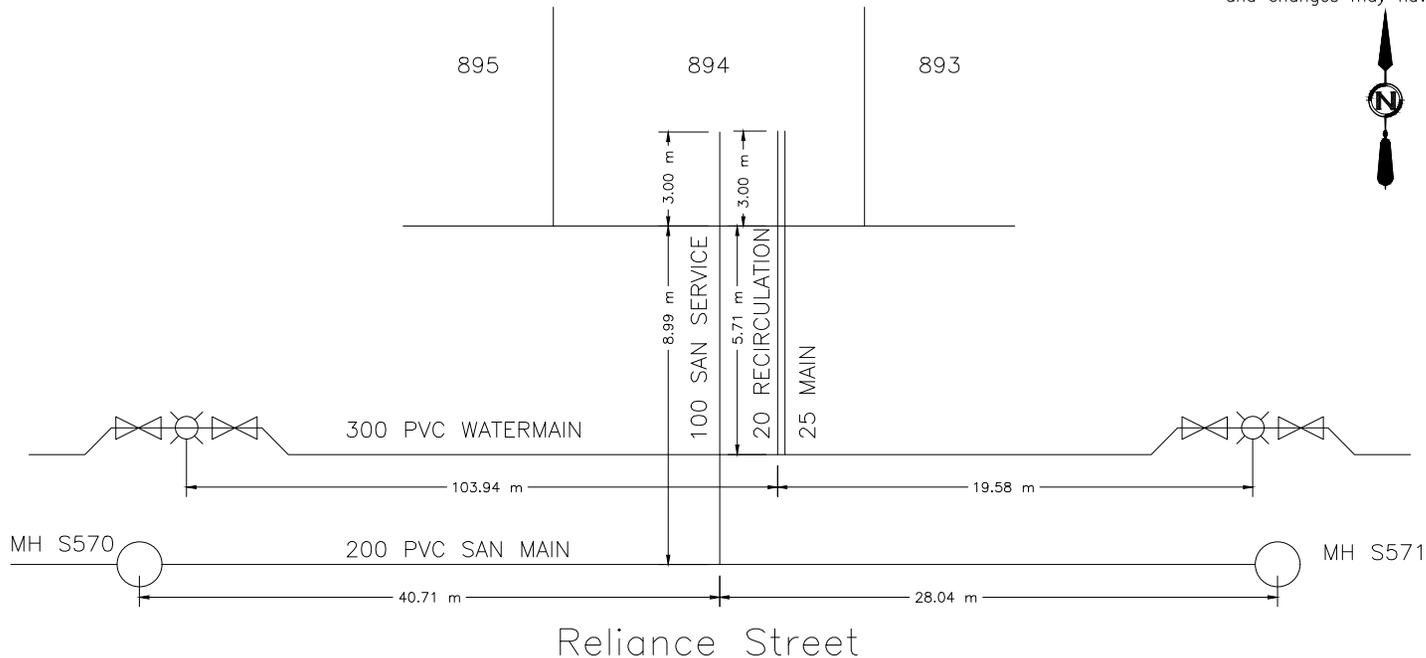



CITY OF WHITEHORSE SERVICE CONNECTION RECORD

FIELD BOOK


No.

ADDRESS 7 Reliance Street BLOCK LOT 895

DATES	WATER	SEWER
On at Main 2019	Depth at P/L: 2.7 m	2.59 m
On at Building	Depth at Main: 3.58 m	2.98 m
Frost Plug:	Pipe Size: 25 mm / 20 mm	100 mm
Memo:	Pipe Material: HDPE Insul. <u>(Yes)</u> /No	PVC Insul. Yes/ <u>(No)</u>
	Length from Main to P/L: 5.7 m	8.97 m
	Squirt Test: <u>(Pass)</u> /Fail	N/A
Booster Pump Required: Yes/No	Frost Protection: Aquaflow/ <u>(Recirc)</u> /Heat Trace/Bleeder	N/A
PRV Required: Yes/No	Greased @ CC: <u>(Yes)</u> /No	N/A
Water Meter Installed: Yes/No	Continuity Test: <u>(N/A)</u> Pass/Fail	N/A

CLEARLY INDICATE LOCATION OF CC AND ROUTE OF PIPES ON DRAWING BELOW

1. Show main valves required to isolate this service. 2. All dimensions to be tied to property line 3. All dimensions to be metric 4. Depth @ property line is based on elevation after construction and changes may have occurred.

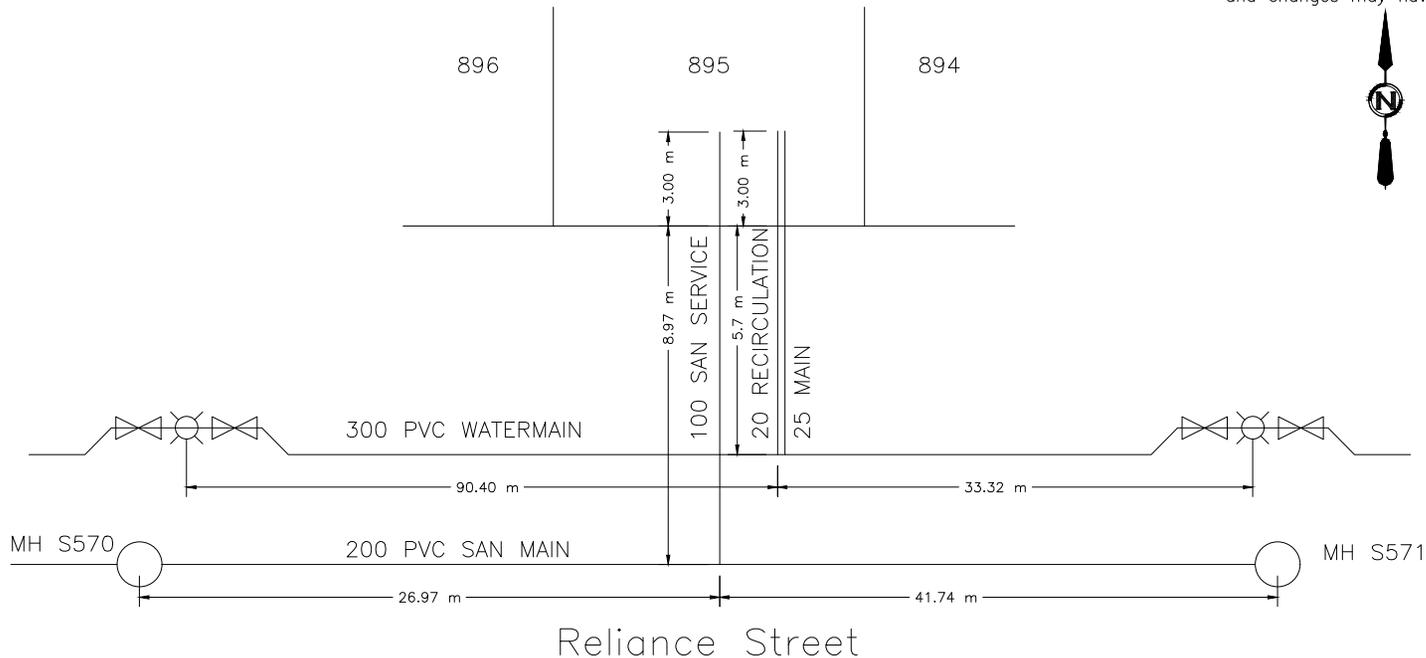



CITY OF WHITEHORSE SERVICE CONNECTION RECORD

FIELD BOOK


No.

ADDRESS 9 Reliance Street BLOCK LOT 896

DATES		WATER		SEWER	
On at Main	2019	Depth at P/L:	2.75 m		2.76 m
On at Building		Depth at Main:	3.52 m		3.13 m
Frost Plug:		Pipe Size:	25 mm / 20 mm		100 mm
Memo:		Pipe Material:	HDPE	Insul. <u>(Yes/No)</u>	PVC
		Length from Main to P/L:	5.74 m		8.98 m
		Squirt Test:	<u>(Pass)</u> /Fail		N/A
Booster Pump Required:	Yes/No	Frost Protection:	Aquaflow/ <u>(Recirc)</u> /Heat Trace/Bleeder		N/A
PRV Required:	Yes/No	Greased @ CC:	<u>(Yes)</u> /No		N/A
Water Meter Installed:	Yes/No	Continuity Test:	<u>(N/A)</u> Pass/Fail		N/A

CLEARLY INDICATE LOCATION OF CC AND ROUTE OF PIPES ON DRAWING BELOW

1. Show main valves required to isolate this service. 2. All dimensions to be tied to property line 3. All dimensions to be metric 4. Depth @ property line is based on elevation after construction and changes may have occurred.

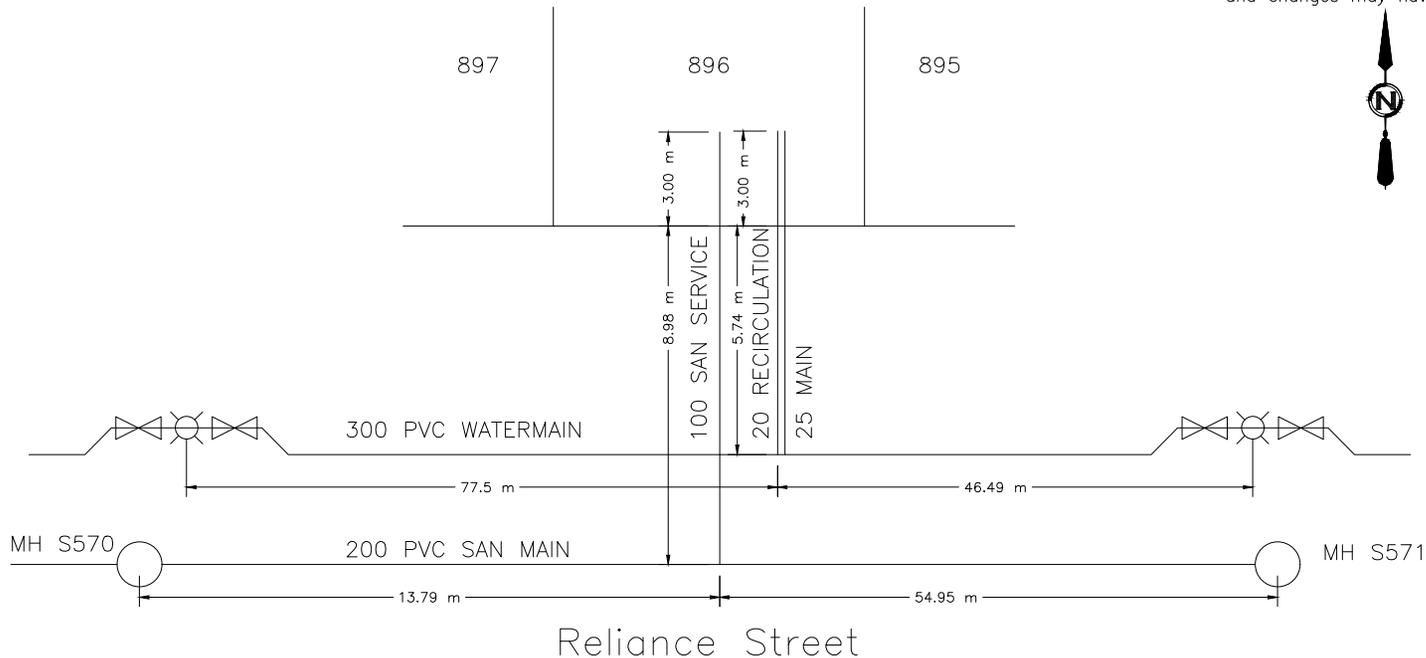



CITY OF WHITEHORSE SERVICE CONNECTION RECORD

FIELD BOOK


No.

ADDRESS 11 Reliance Street BLOCK LOT 897

DATES		WATER		SEWER	
On at Main	2019	Depth at P/L:	3.08 m	2.98 m	
On at Building		Depth at Main:	3.45 m	3.54 m	
Frost Plug:		Pipe Size:	25 mm / 20 mm	100 mm	
Memo:		Pipe Material:	HDPE	Insul. <u>(Yes/No)</u>	PVC
		Length from Main to P/L:	5.72 m	8.97 m	Insul. <u>Yes/No</u>
		Squirt Test:	<u>(Pass)</u> /Fail		N/A
Booster Pump Required:	Yes/No	Frost Protection:	Aquaflow/ <u>(Recirc)</u> /Heat Trace/Bleeder		N/A
PRV Required:	Yes/No	Greased @ CC:	<u>(Yes)</u> /No		N/A
Water Meter Installed:	Yes/No	Continuity Test:	<u>(N/A)</u>	Pass/Fail	N/A

CLEARLY INDICATE LOCATION OF CC AND ROUTE OF PIPES ON DRAWING BELOW

- Show main valves required to isolate this service.
- All dimensions to be tied to property line
- All dimensions to be metric
- Depth @ property line is based on elevation after construction and changes may have occurred.

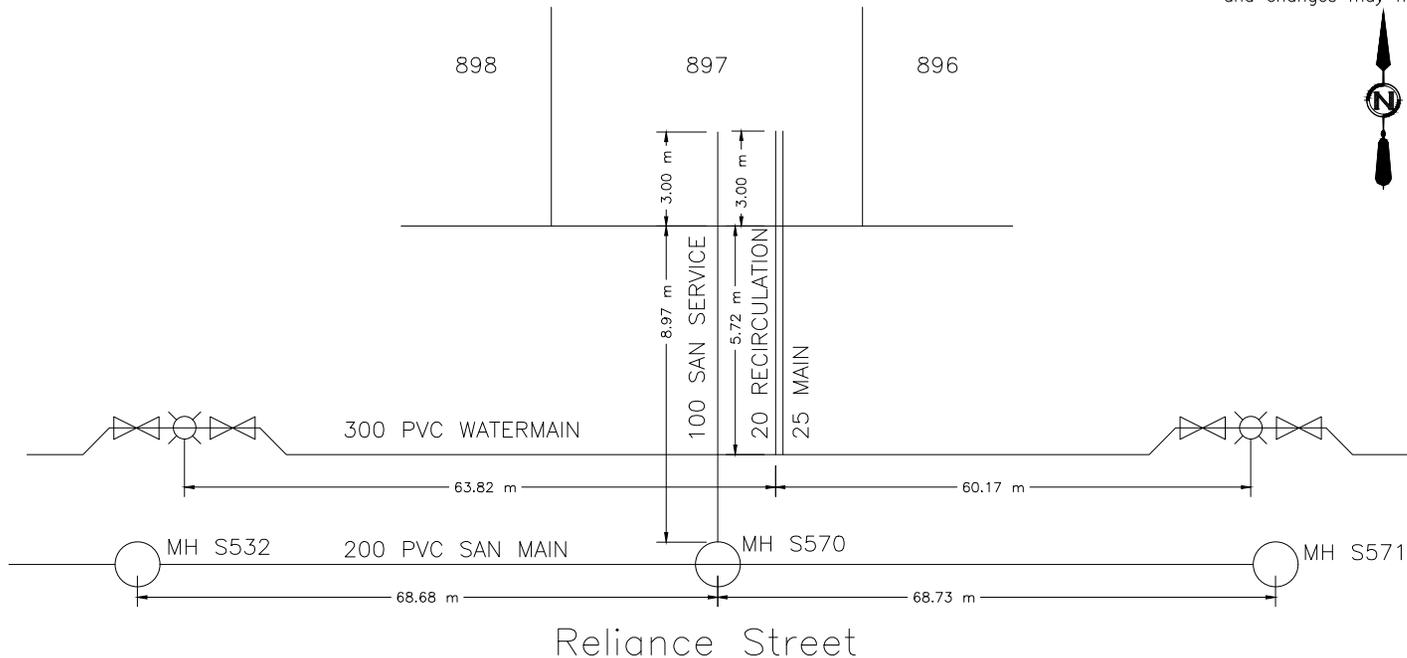



CITY OF WHITEHORSE SERVICE CONNECTION RECORD

FIELD BOOK


No.

ADDRESS 13 Reliance Street BLOCK LOT 898

DATES		WATER	SEWER
On at Main 2019		Depth at P/L: 2.94 m	2.86 m
On at Building		Depth at Main: 3.31 m	3.43 m
Frost Plug:		Pipe Size: 25 mm / 20 mm	100 mm
Memo:	Pipe Material: HDPE Insul. <u>(Yes)</u> /No		PVC Insul. Yes/ <u>(No)</u>
	Length from Main to P/L: 5.71 m		9.07 m
	Squirt Test: <u>(Pass)</u> /Fail		N/A
Booster Pump Required:	Yes/No	Frost Protection: Aquaflow/ <u>(Recirc)</u> /Heat Trace/Bleeder	N/A
PRV Required:	Yes/No	Greased @ CC: <u>(Yes)</u> /No	N/A
Water Meter Installed:	Yes/No	Continuity Test: <u>(N/A)</u> Pass/Fail	N/A

CLEARLY INDICATE LOCATION OF CC AND ROUTE OF PIPES ON DRAWING BELOW

1. Show main valves required to isolate this service. 2. All dimensions to be tied to property line 3. All dimensions to be metric 4. Depth @ property line is based on elevation after construction and changes may have occurred.

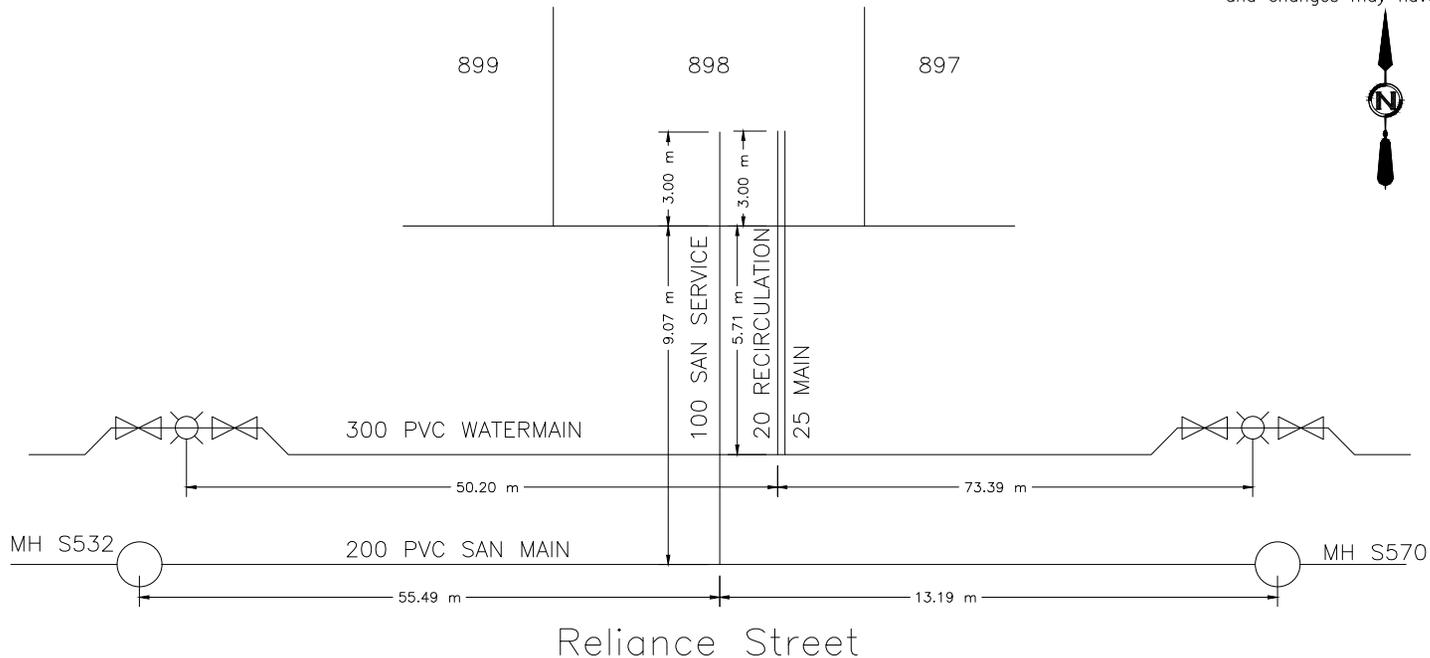



CITY OF WHITEHORSE SERVICE CONNECTION RECORD

FIELD BOOK


No.

ADDRESS 15 Reliance Street BLOCK LOT 899

DATES		WATER		SEWER	
On at Main	2019	Depth at P/L:	2.95 m		3.00 m
On at Building		Depth at Main:	3.21 m		3.52 m
Frost Plug:		Pipe Size:	25 mm / 20 mm		100 mm
Memo:		Pipe Material:	HDPE	Insul. <u>(Yes)</u> /No	PVC
		Length from Main to P/L:	5.71 m		8.99 m
		Squirt Test:	<u>(Pass)</u> /Fail		N/A
Booster Pump Required:	Yes/No	Frost Protection:	Aquaflow/ <u>(Recirc)</u> /Heat Trace/Bleeder		N/A
PRV Required:	Yes/No	Greased @ CC:	<u>(Yes)</u> /No		N/A
Water Meter Installed:	Yes/No	Continuity Test:	<u>(N/A)</u> Pass/Fail		N/A

CLEARLY INDICATE LOCATION OF CC AND ROUTE OF PIPES ON DRAWING BELOW

- Show main valves required to isolate this service.
- All dimensions to be tied to property line
- All dimensions to be metric
- Depth @ property line is based on elevation after construction and changes may have occurred.

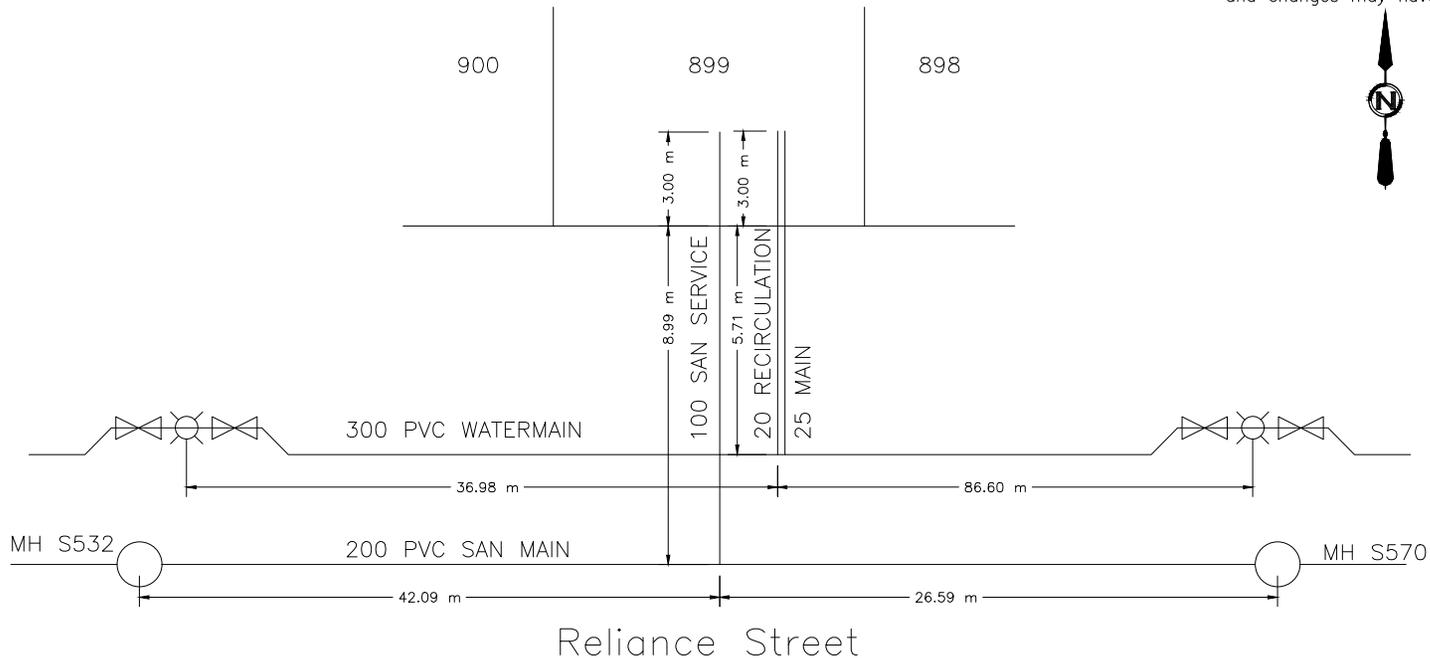



CITY OF WHITEHORSE SERVICE CONNECTION RECORD

FIELD BOOK


No.

ADDRESS 17 Reliance Street BLOCK LOT 900

DATES		WATER		SEWER	
On at Main	2019	Depth at P/L:	2.73 m	2.63	m
On at Building		Depth at Main:	3.06 m	3.64	m
Frost Plug:		Pipe Size:	25 mm / 20 mm	100	mm
Memo:		Pipe Material:	HDPE	Insul. (Yes/No)	PVC
		Length from Main to P/L:	5.71 m	9.04	m
		Squirt Test:	(Pass/Fail)		N/A
Booster Pump Required:	Yes/No	Frost Protection:	Aquaflow/Recirc/Heat Trace/Bleeder		N/A
PRV Required:	Yes/No	Greased @ CC:	(Yes/No)		N/A
Water Meter Installed:	Yes/No	Continuity Test:	(N/A) Pass/Fail		N/A

CLEARLY INDICATE LOCATION OF CC AND ROUTE OF PIPES ON DRAWING BELOW

1. Show main valves required to isolate this service.
2. All dimensions to be tied to property line
3. All dimensions to be metric
4. Depth @ property line is based on elevation after construction and changes may have occurred.

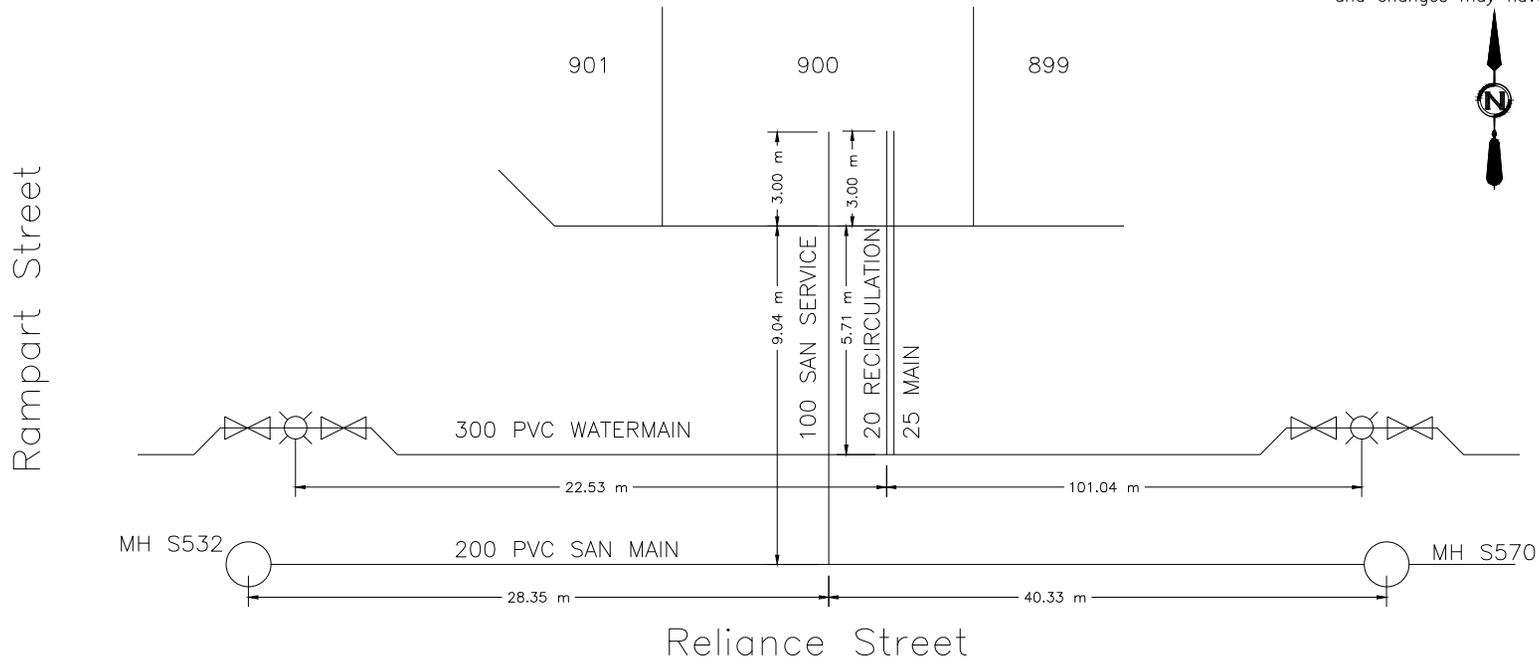



CITY OF WHITEHORSE SERVICE CONNECTION RECORD

FIELD BOOK


No.

ADDRESS 19 Reliance Street BLOCK LOT 901

DATES		WATER		SEWER
On at Main	2019	Depth at P/L:	2.69 m	2.64 m
On at Building		Depth at Main:	3.05 m	3.8 m
Frost Plug:		Pipe Size:	25 mm / 20 mm	100 mm
Memo:		Pipe Material:	HDPE Insul. <u>(Yes)</u> /No	PVC Insul. Yes/ <u>(No)</u>
		Length from Main to P/L:	5.73 m	9.05 m
		Squirt Test:	<u>(Pass)</u> /Fail	N/A
Booster Pump Required:	Yes/No	Frost Protection:	Aquaflow/ <u>(Recirc)</u> /Heat Trace/Bleeder	N/A
PRV Required:	Yes/No	Greased @ CC:	<u>(Yes)</u> /No	N/A
Water Meter Installed:	Yes/No	Continuity Test:	<u>(N/A)</u> Pass/Fail	N/A

CLEARLY INDICATE LOCATION OF CC AND ROUTE OF PIPES ON DRAWING BELOW

1. Show main valves required to isolate this service.
2. All dimensions to be tied to property line
3. All dimensions to be metric
4. Depth @ property line is based on elevation after construction and changes may have occurred.

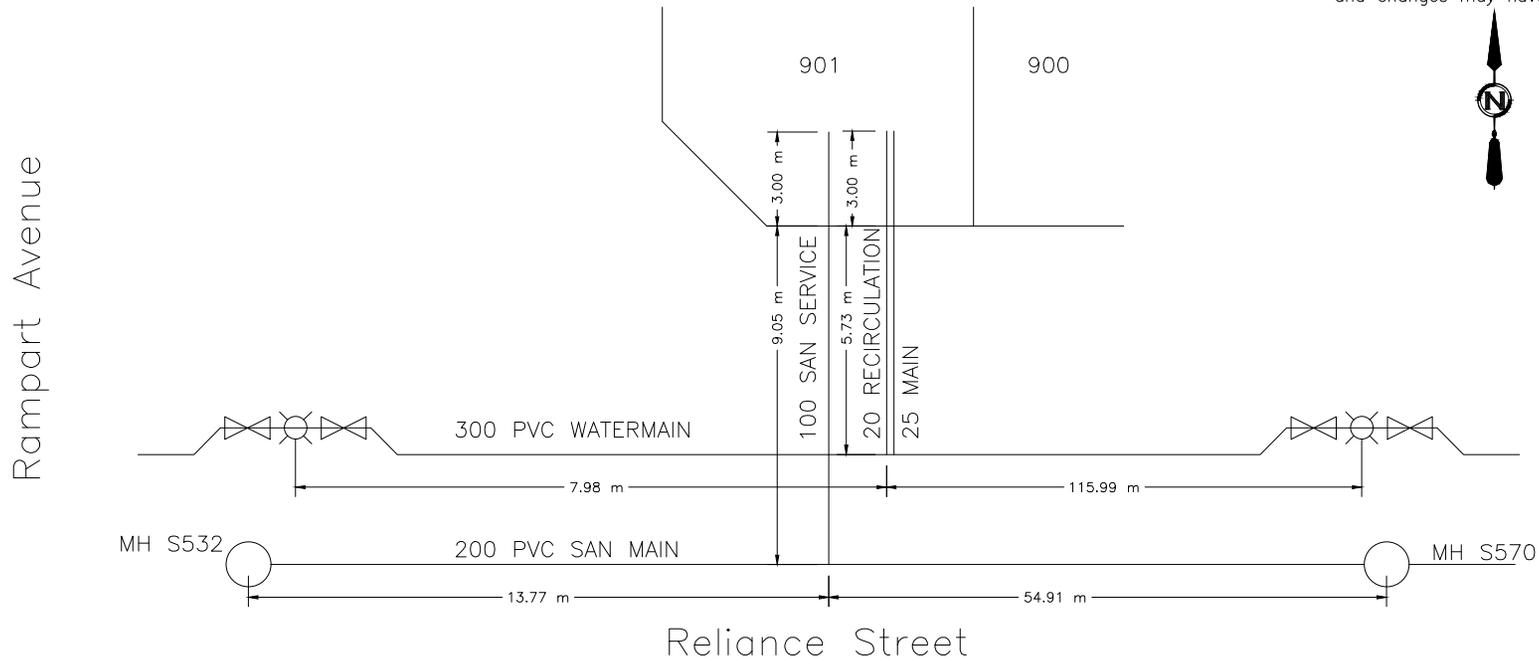



CITY OF WHITEHORSE SERVICE CONNECTION RECORD

FIELD BOOK


No.

ADDRESS 2 Reliance Street BLOCK LOT 902

DATES		WATER		SEWER	
On at Main	2019	Depth at P/L:	2.21 m	2.19 m	
On at Building		Depth at Main:	3.83 m	2.61 m	
Frost Plug:		Pipe Size:	25 mm / 20 mm	100 mm	
Memo:		Pipe Material:	HDPE	Insul. (Yes/No)	PVC
		Length from Main to P/L:	12.99 m	8.94 m	Insul. (Yes/No)
		Squirt Test:	(Pass/Fail)		N/A
Booster Pump Required:	Yes/No	Frost Protection:	Aquaflow/Recirc/Heat Trace/Bleeder		N/A
PRV Required:	Yes/No	Greased @ CC:	(Yes/No)		N/A
Water Meter Installed:	Yes/No	Continuity Test:	(N/A)	Pass/Fail	N/A

CLEARLY INDICATE LOCATION OF CC AND ROUTE OF PIPES ON DRAWING BELOW

1. Show main valves required to isolate this service.
2. All dimensions to be tied to property line
3. All dimensions to be metric
4. Depth @ property line is based on elevation after construction and changes may have occurred.

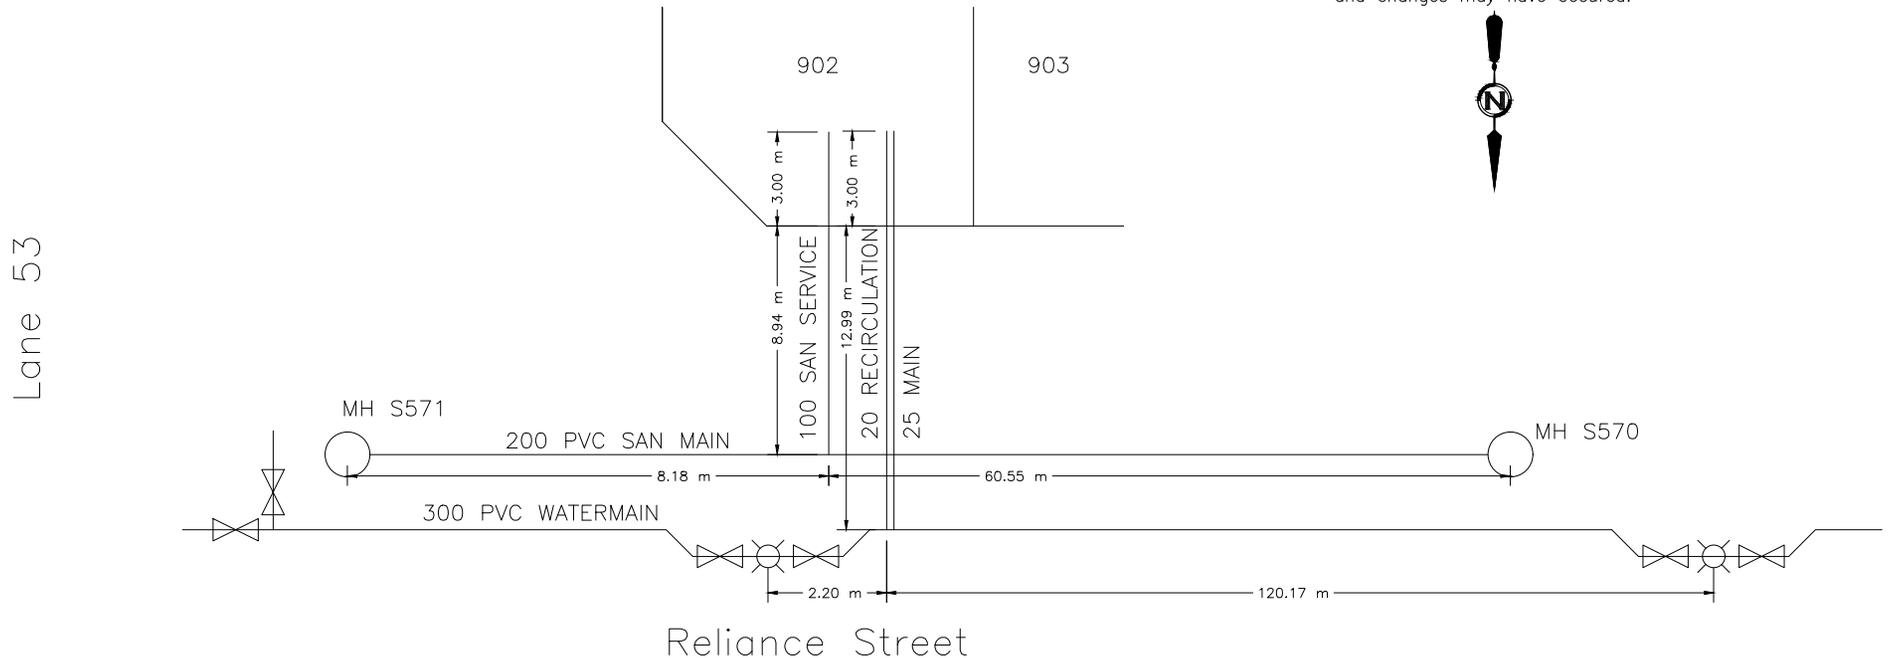



CITY OF WHITEHORSE SERVICE CONNECTION RECORD

FIELD BOOK


No.

ADDRESS 4 Reliance Street BLOCK LOT 903

DATES	WATER	SEWER
On at Main 2019	Depth at P/L: 2.51 m	2.38 m
On at Building	Depth at Main: 3.7 m	2.77 m
Frost Plug:	Pipe Size: 25 mm / 20 mm	100 mm
Memo:	Pipe Material: HDPE Insul. <u>(Yes)</u> /No	PVC Insul. Yes/ <u>(No)</u>
	Length from Main to P/L: 11.75 m	8.96 m
	Squirt Test: <u>(Pass)</u> /Fail	N/A
Booster Pump Required: Yes/No	Frost Protection: Aquaflo/ <u>(Recirc)</u> /Heat Trace/Bleeder	N/A
PRV Required: Yes/No	Greased @ CC: <u>(Yes)</u> /No	N/A
Water Meter Installed: Yes/No	Continuity Test: <u>(N/A)</u> Pass/Fail	N/A

CLEARLY INDICATE LOCATION OF CC AND ROUTE OF PIPES ON DRAWING BELOW

1. Show main valves required to isolate this service. 2. All dimensions to be tied to property line 3. All dimensions to be metric 4. Depth @ property line is based on elevation after construction and changes may have occurred.

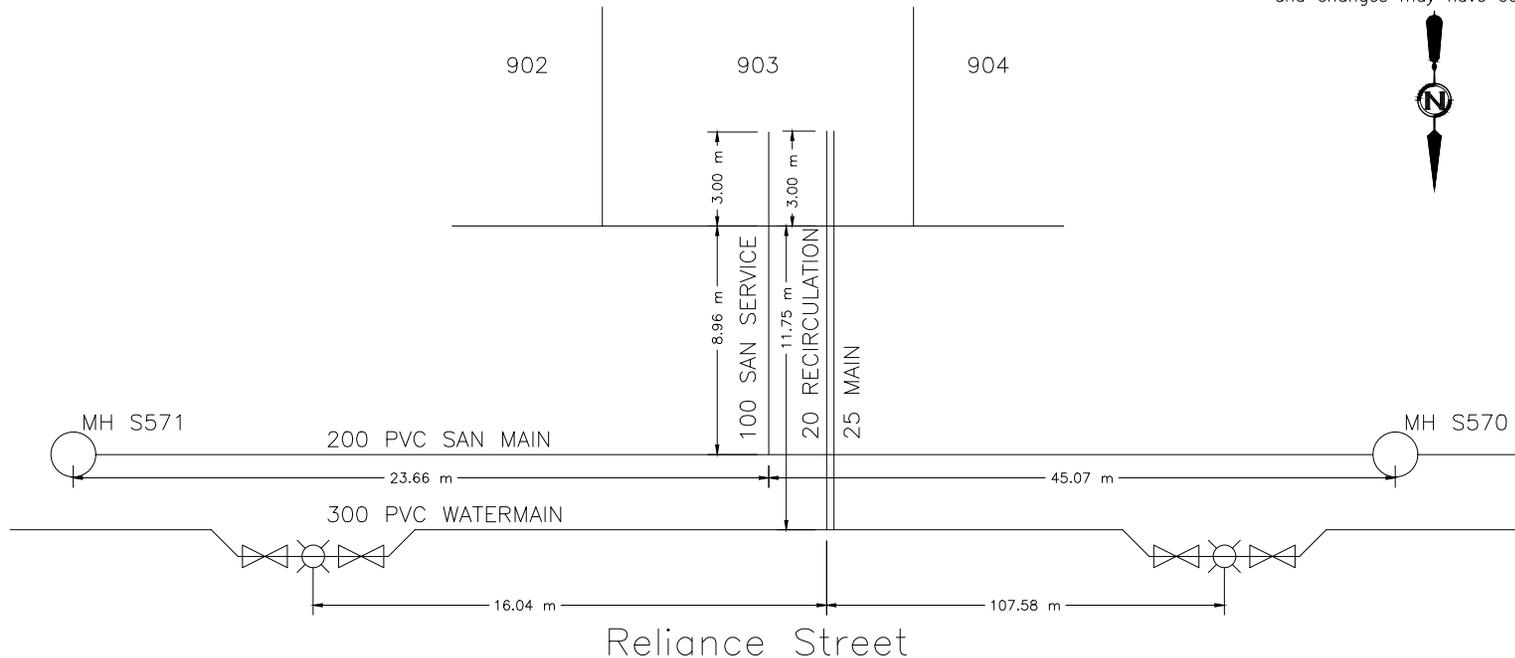



CITY OF WHITEHORSE SERVICE CONNECTION RECORD

FIELD BOOK


No.

ADDRESS 6 Reliance Street BLOCK LOT 904

DATES	WATER	SEWER
On at Main 2019	Depth at P/L: 2.41 m	2.41 m
On at Building	Depth at Main: 3.63 m	2.95 m
Frost Plug:	Pipe Size: 25 mm / 20 mm	100 mm
Memo:	Pipe Material: HDPE Insul. <u>(Yes)</u> /No	PVC Insul. Yes/ <u>(No)</u>
	Length from Main to P/L: 11.75 m	9.02 m
	Squirt Test: <u>(Pass)</u> /Fail	N/A
Booster Pump Required: Yes/No	Frost Protection: Aquaflo/ <u>(Recirc)</u> /Heat Trace/Bleeder	N/A
PRV Required: Yes/No	Greased @ CC: <u>(Yes)</u> /No	N/A
Water Meter Installed: Yes/No	Continuity Test: <u>(N/A)</u> Pass/Fail	N/A

CLEARLY INDICATE LOCATION OF CC AND ROUTE OF PIPES ON DRAWING BELOW

1. Show main valves required to isolate this service. 2. All dimensions to be tied to property line 3. All dimensions to be metric 4. Depth @ property line is based on elevation after construction and changes may have occurred.

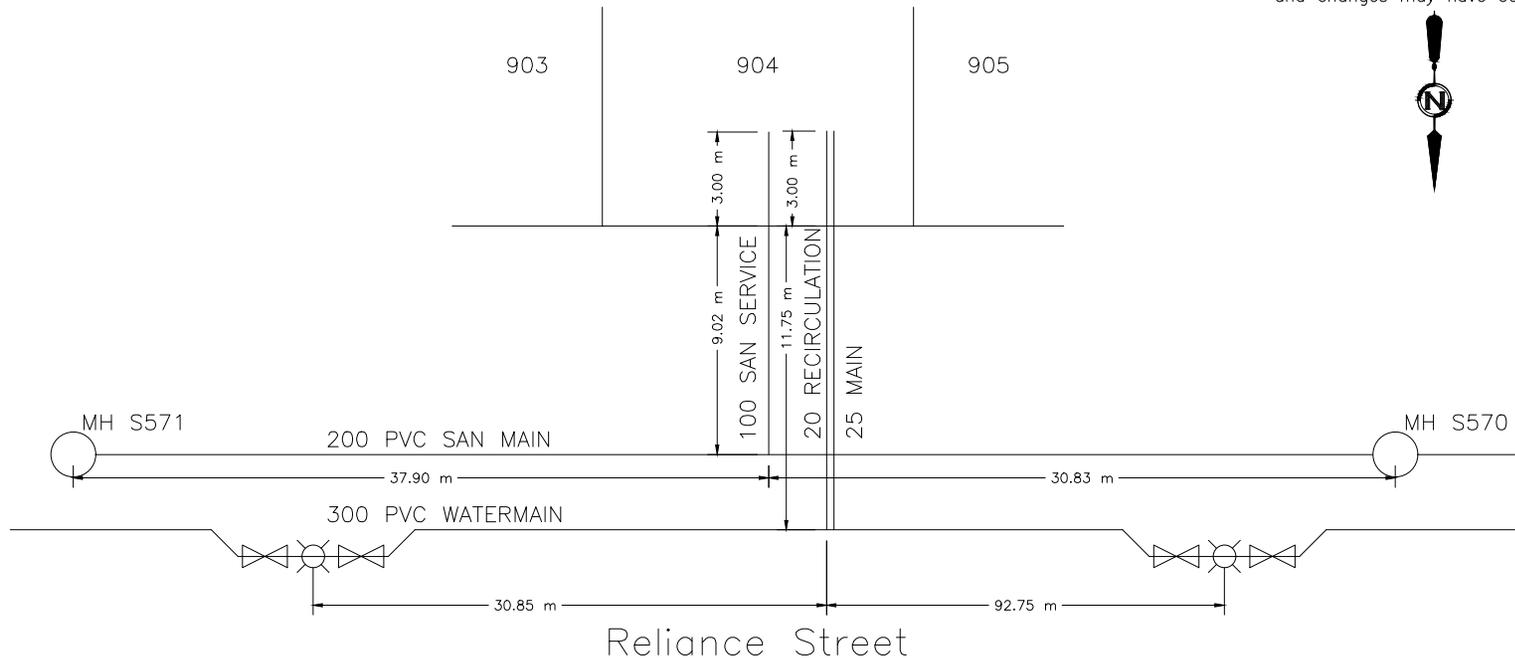



CITY OF WHITEHORSE SERVICE CONNECTION RECORD

FIELD BOOK


No.

ADDRESS 8 Reliance Street BLOCK LOT 905

DATES	WATER	SEWER
On at Main 2019	Depth at P/L: 2.35 m	2.36 m
On at Building	Depth at Main: 3.55 m	3.08 m
Frost Plug:	Pipe Size: 25 mm / 20 mm	100 mm
Memo:	Pipe Material: HDPE Insul. <u>(Yes)</u> /No	PVC Insul. Yes/ <u>(No)</u>
	Length from Main to P/L: 11.79 m	8.99 m
	Squirt Test: <u>(Pass)</u> /Fail	N/A
Booster Pump Required: Yes/No	Frost Protection: Aquaflo/ <u>(Recirc)</u> /Heat Trace/Bleeder	N/A
PRV Required: Yes/No	Greased @ CC: <u>(Yes)</u> /No	N/A
Water Meter Installed: Yes/No	Continuity Test: <u>(N/A)</u> Pass/Fail	N/A

CLEARLY INDICATE LOCATION OF CC AND ROUTE OF PIPES ON DRAWING BELOW

1. Show main valves required to isolate this service. 2. All dimensions to be tied to property line 3. All dimensions to be metric 4. Depth @ property line is based on elevation after construction and changes may have occurred.

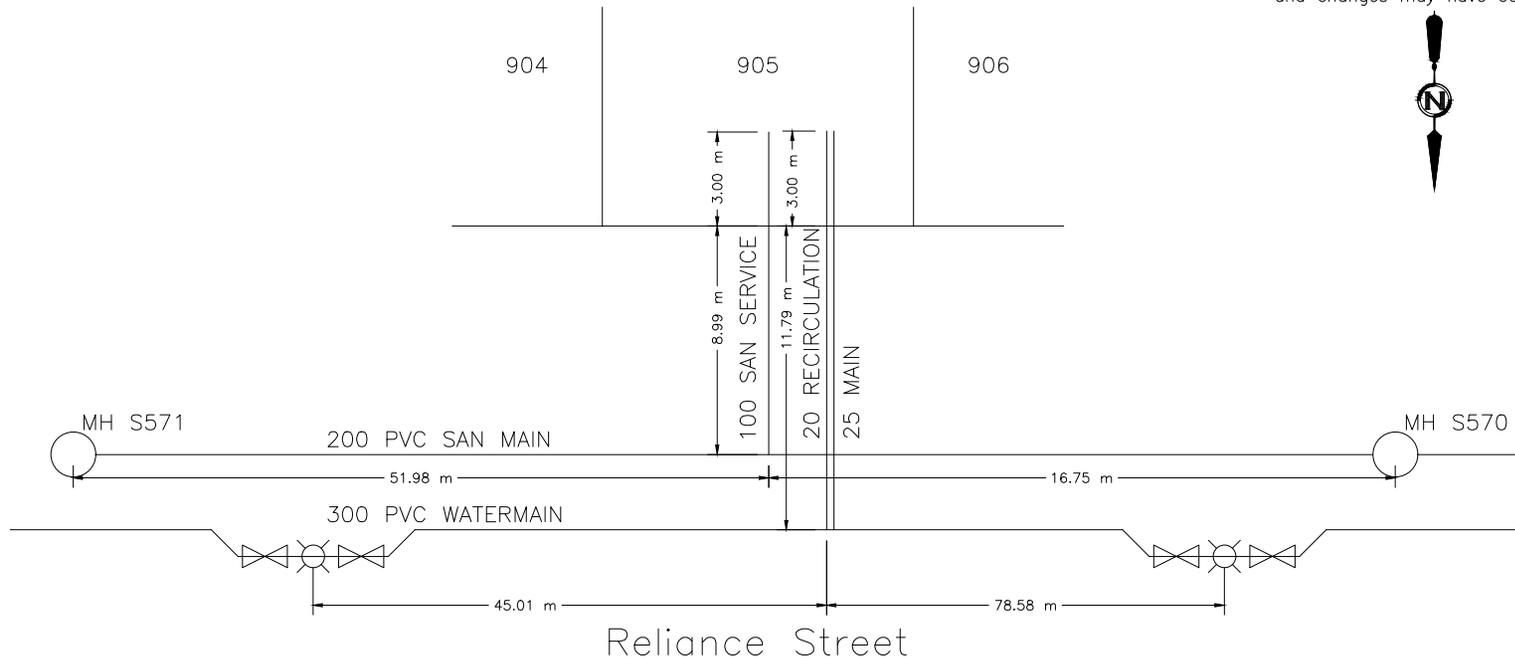



CITY OF WHITEHORSE SERVICE CONNECTION RECORD

FIELD BOOK


No.

ADDRESS 10 Reliance Street BLOCK LOT 906

DATES	WATER	SEWER
On at Main 2019	Depth at P/L: 2.81 m	2.82 m
On at Building	Depth at Main: 3.43 m	3.27 m
Frost Plug:	Pipe Size: 25 mm / 20 mm	100 mm
Memo:	Pipe Material: HDPE	PVC
	Insul. <u>(Yes)</u> /No	Insul. <u>(Yes)</u> /No
	Length from Main to P/L: 11.69 m	8.98 m
	Squirt Test: <u>(Pass)</u> /Fail	N/A
Booster Pump Required: Yes/No	Frost Protection: Aquaflo/ <u>(Recirc)</u> /Heat Trace/Bleeder	N/A
PRV Required: Yes/No	Greased @ CC: <u>(Yes)</u> /No	N/A
Water Meter Installed: Yes/No	Continuity Test: <u>(N/A)</u> Pass/Fail	N/A

CLEARLY INDICATE LOCATION OF CC AND ROUTE OF PIPES ON DRAWING BELOW

1. Show main valves required to isolate this service. 2. All dimensions to be tied to property line 3. All dimensions to be metric 4. Depth @ property line is based on elevation after construction and changes may have occurred.

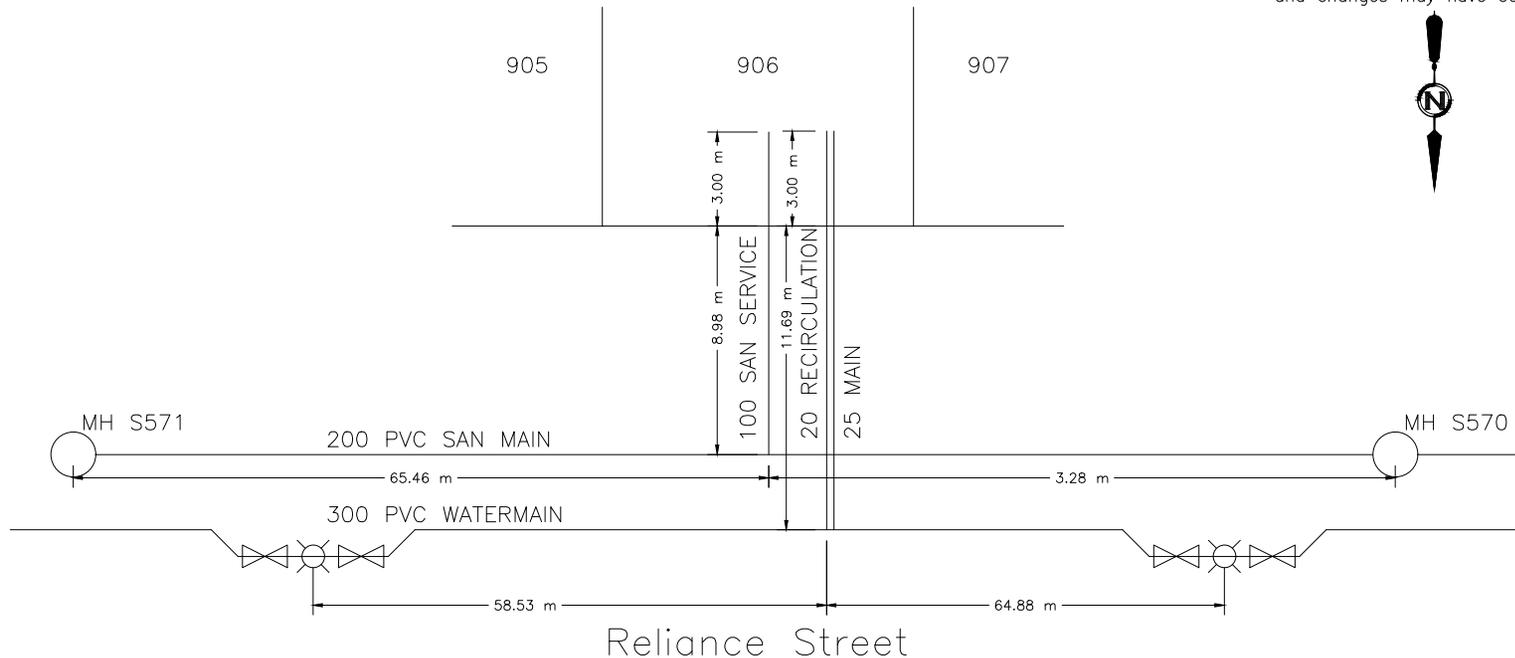



CITY OF WHITEHORSE SERVICE CONNECTION RECORD

FIELD BOOK


No.

ADDRESS 12 Reliance Street BLOCK LOT 907

DATES	WATER	SEWER
On at Main 2019	Depth at P/L: 2.96 m	2.83 m
On at Building	Depth at Main: 3.38 m	3.41 m
Frost Plug:	Pipe Size: 25 mm / 20 mm	100 mm
Memo:	Pipe Material: HDPE Insul. <u>(Yes)</u> /No	PVC Insul. Yes/ <u>(No)</u>
	Length from Main to P/L: 11.75 m	8.97 m
	Squirt Test: <u>(Pass)</u> /Fail	N/A
Booster Pump Required: Yes/No	Frost Protection: Aquaflo/ <u>(Recirc)</u> /Heat Trace/Bleeder	N/A
PRV Required: Yes/No	Greased @ CC: <u>(Yes)</u> /No	N/A
Water Meter Installed: Yes/No	Continuity Test: <u>(N/A)</u> Pass/Fail	N/A

CLEARLY INDICATE LOCATION OF CC AND ROUTE OF PIPES ON DRAWING BELOW

1. Show main valves required to isolate this service. 2. All dimensions to be tied to property line 3. All dimensions to be metric 4. Depth @ property line is based on elevation after construction and changes may have occurred.

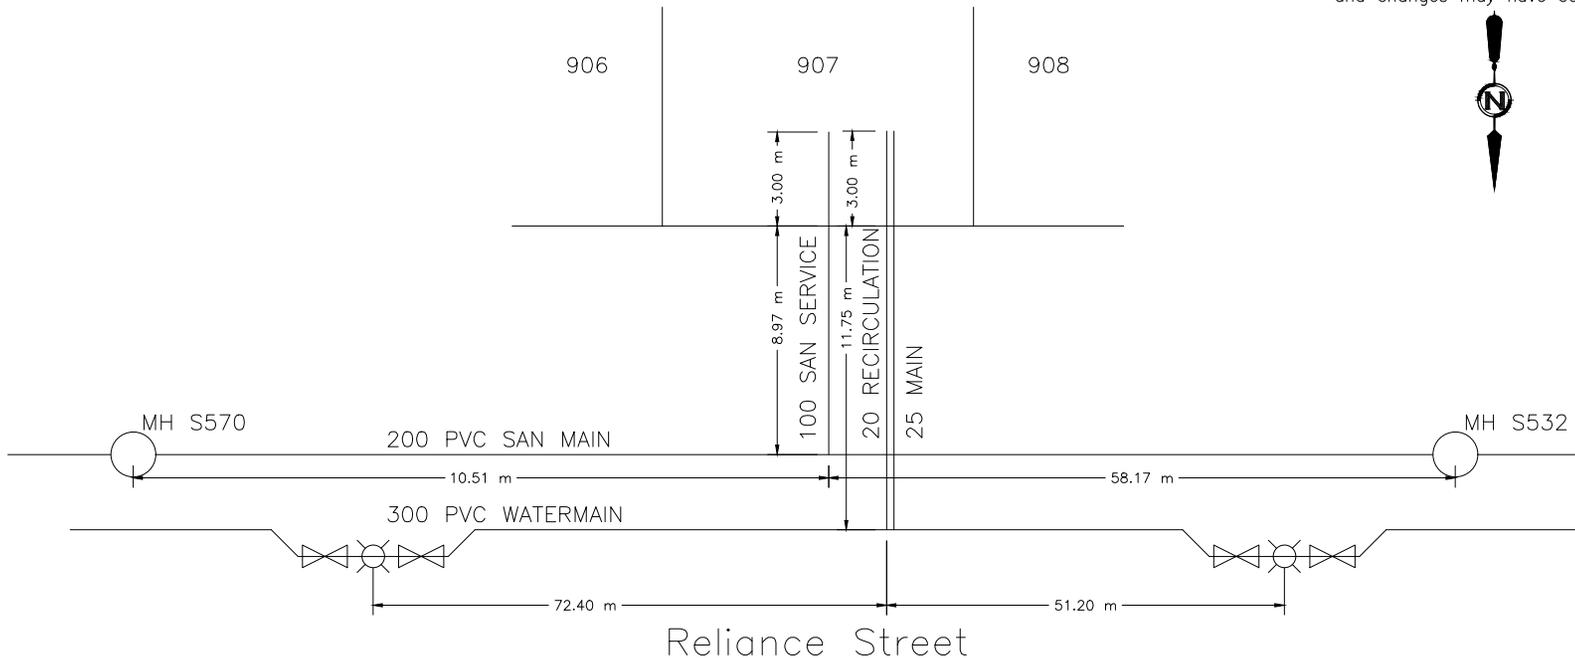



CITY OF WHITEHORSE SERVICE CONNECTION RECORD

FIELD BOOK


No.

ADDRESS 14 Reliance Street BLOCK LOT 908

DATES	WATER	SEWER
On at Main 2019	Depth at P/L: 2.99 m	2.9 m
On at Building	Depth at Main: 3.18 m	3.51 m
Frost Plug:	Pipe Size: 25 mm / 20 mm	100 mm
Memo:	Pipe Material: HDPE Insul. <u>(Yes/No)</u>	PVC Insul. <u>Yes/No</u>
	Length from Main to P/L: 11.77 m	8.98 m
	Squirt Test: <u>(Pass/Fail)</u>	N/A
Booster Pump Required: Yes/No	Frost Protection: Aquaflo/ <u>(Recirc)</u> /Heat Trace/Bleeder	N/A
PRV Required: Yes/No	Greased @ CC: <u>(Yes/No)</u>	N/A
Water Meter Installed: Yes/No	Continuity Test: <u>(N/A)</u> Pass/Fail	N/A

CLEARLY INDICATE LOCATION OF CC AND ROUTE OF PIPES ON DRAWING BELOW

1. Show main valves required to isolate this service. 2. All dimensions to be tied to property line 3. All dimensions to be metric 4. Depth @ property line is based on elevation after construction and changes may have occurred.

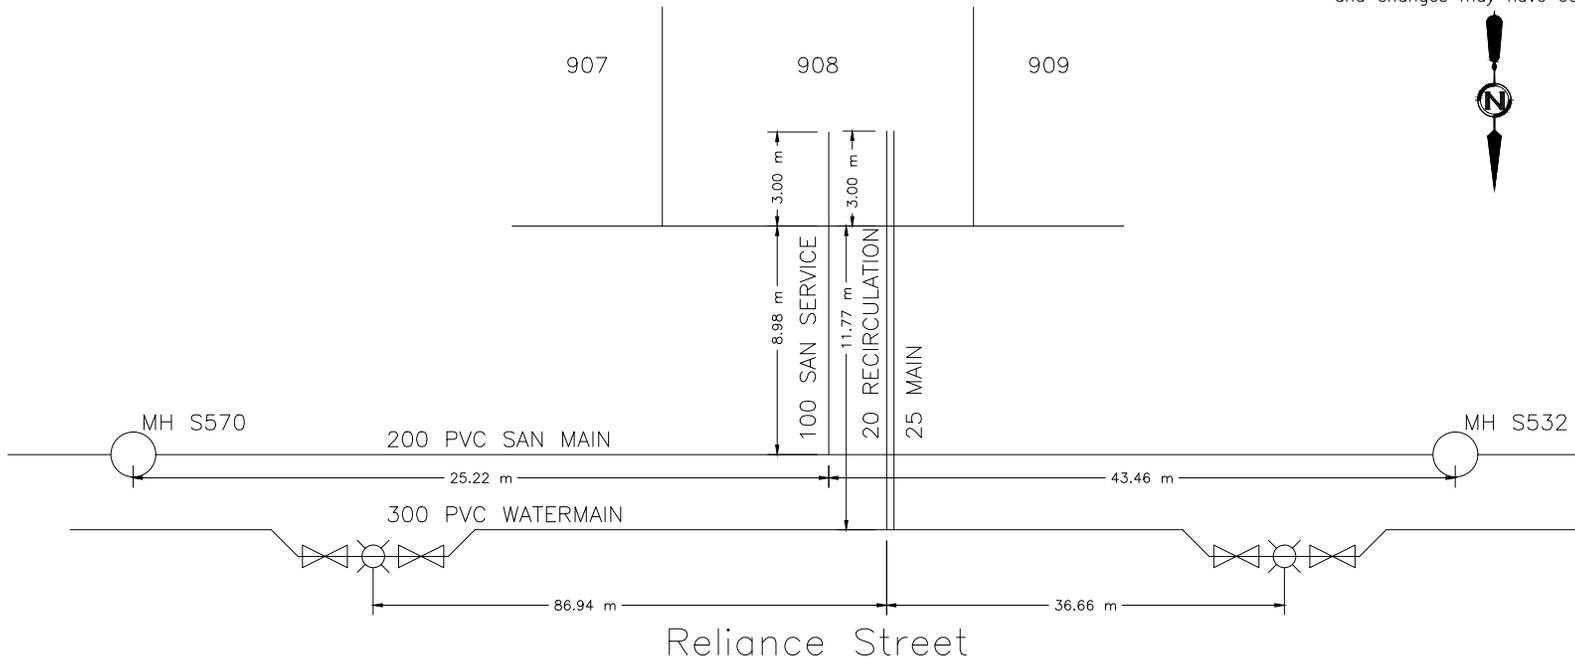



CITY OF WHITEHORSE SERVICE CONNECTION RECORD

FIELD BOOK


No.

ADDRESS 16 Reliance Street BLOCK LOT 909

DATES	WATER	SEWER
On at Main 2019	Depth at P/L: 2.73 m	2.69 m
On at Building	Depth at Main: 3.1 m	3.66 m
Frost Plug:	Pipe Size: 25 mm / 20 mm	100 mm
Memo:	Pipe Material: HDPE Insul. <u>(Yes)</u> /No	PVC Insul. Yes/ <u>(No)</u>
	Length from Main to P/L: 11.73 m	9.01 m
	Squirt Test: <u>(Pass)</u> /Fail	N/A
Booster Pump Required: Yes/No	Frost Protection: Aquaflo/ <u>(Recirc)</u> /Heat Trace/Bleeder	N/A
PRV Required: Yes/No	Greased @ CC: <u>(Yes)</u> /No	N/A
Water Meter Installed: Yes/No	Continuity Test: <u>(N/A)</u> Pass/Fail	N/A

CLEARLY INDICATE LOCATION OF CC AND ROUTE OF PIPES ON DRAWING BELOW

1. Show main valves required to isolate this service. 2. All dimensions to be tied to property line 3. All dimensions to be metric 4. Depth @ property line is based on elevation after construction and changes may have occurred.

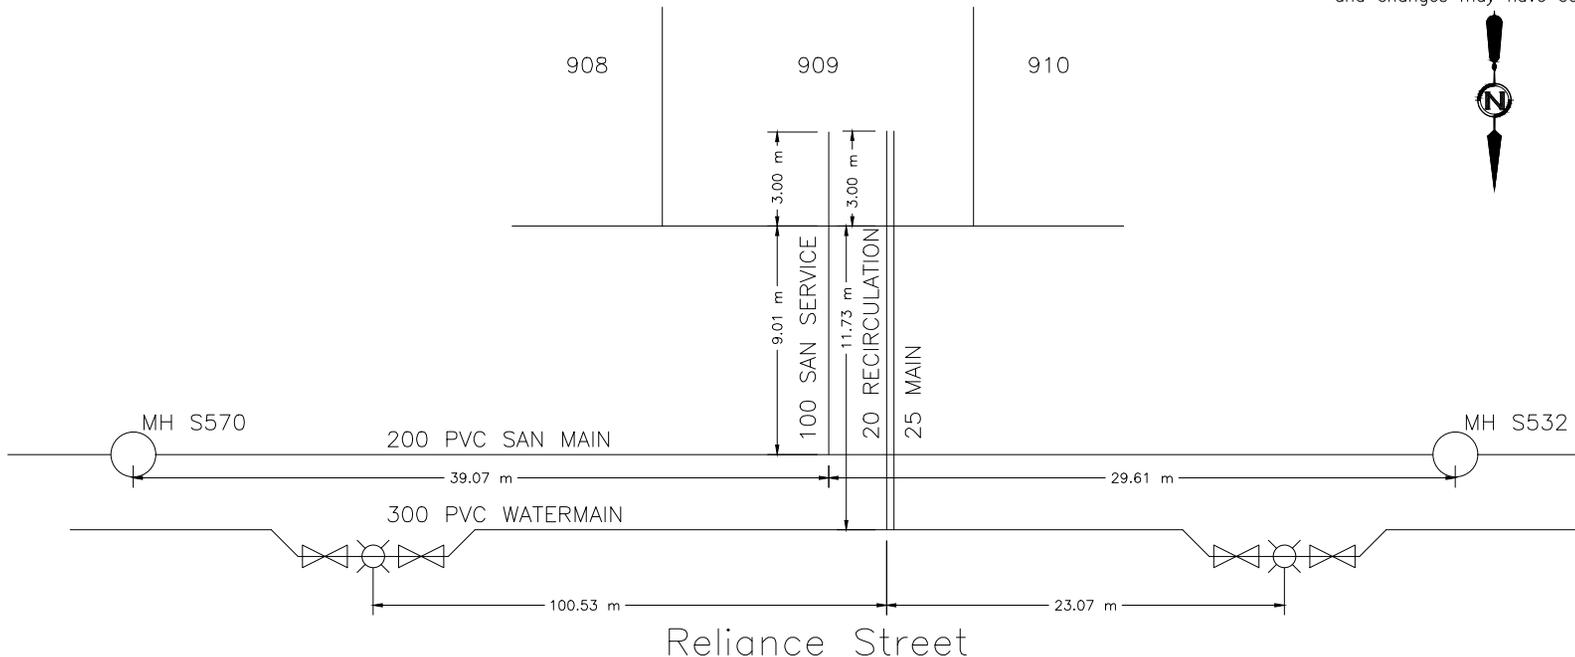



CITY OF WHITEHORSE SERVICE CONNECTION RECORD

FIELD BOOK


No.

ADDRESS 18 Reliance Street BLOCK LOT 910

DATES		WATER		SEWER	
On at Main	2019	Depth at P/L:	2.92 m	2.91 m	
On at Building		Depth at Main:	3.08 m	3.77 m	
Frost Plug:		Pipe Size:	25 mm / 20 mm	100 mm	
Memo:		Pipe Material:	HDPE	Insul. <input checked="" type="checkbox"/> Yes/ <input type="checkbox"/> No	PVC
		Length from Main to P/L:	11.68 m	8.91 m	Insul. Yes/ <input checked="" type="checkbox"/> No
		Squirt Test:	<input checked="" type="checkbox"/> Pass/ <input type="checkbox"/> Fail		N/A
Booster Pump Required:	Yes/No	Frost Protection:	Aquaflow/ <input checked="" type="checkbox"/> Recirc/ <input type="checkbox"/> Heat Trace/Bleeder		N/A
PRV Required:	Yes/No	Greased @ CC:	<input checked="" type="checkbox"/> Yes/ <input type="checkbox"/> No		N/A
Water Meter Installed:	Yes/No	Continuity Test:	<input checked="" type="checkbox"/> N/A	<input type="checkbox"/> Pass/ <input type="checkbox"/> Fail	N/A

CLEARLY INDICATE LOCATION OF CC AND ROUTE OF PIPES ON DRAWING BELOW

1. Show main valves required to isolate this service. 2. All dimensions to be tied to property line 3. All dimensions to be metric 4. Depth @ property line is based on elevation after construction and changes may have occurred.

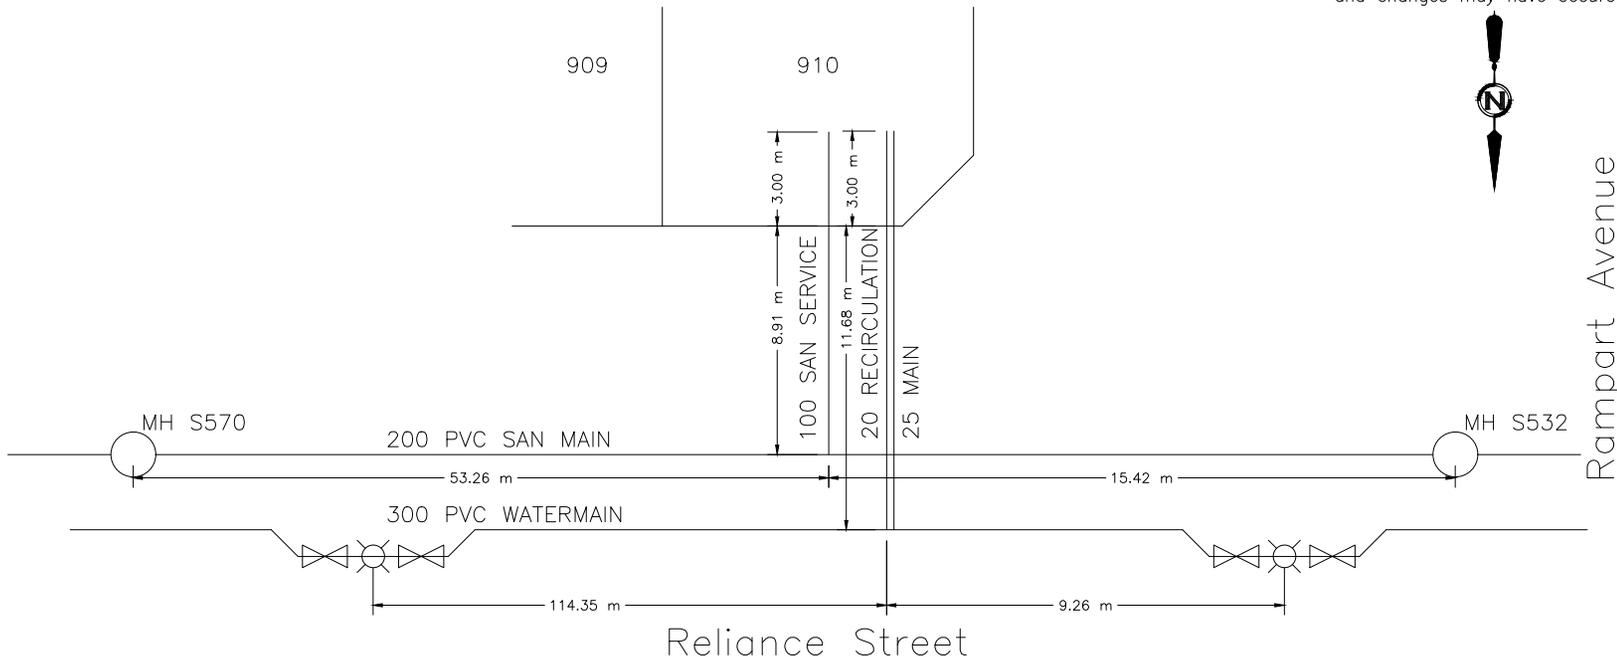



CITY OF WHITEHORSE SERVICE CONNECTION RECORD

FIELD BOOK


No.

ADDRESS 1 Chance Lane BLOCK LOT 911

DATES		WATER		SEWER	
On at Main	2019	Depth at P/L:	2.25 m	2.08	m
On at Building		Depth at Main:	2.71 m	2.78	m
Frost Plug:		Pipe Size:	25 mm / 20 mm	100	mm
Memo:		Pipe Material:	HDPE	Insul.	(Yes/No)
		Length from Main to P/L:	4.37 m	PVC	Insul. (Yes/No)
		Squirt Test:	(Pass/Fail)		N/A
Booster Pump Required:	Yes/No	Frost Protection:	Aquaflow/Recirc/Heat Trace/Bleeder		N/A
PRV Required:	Yes/No	Greased @ CC:	(Yes/No)		N/A
Water Meter Installed:	Yes/No	Continuity Test:	(N/A) Pass/Fail		N/A

CLEARLY INDICATE LOCATION OF CC AND ROUTE OF PIPES ON DRAWING BELOW

1. Show main valves required to isolate this service. 2. All dimensions to be tied to property line 3. All dimensions to be metric 4. Depth @ property line is based on elevation after construction and changes may have occurred.

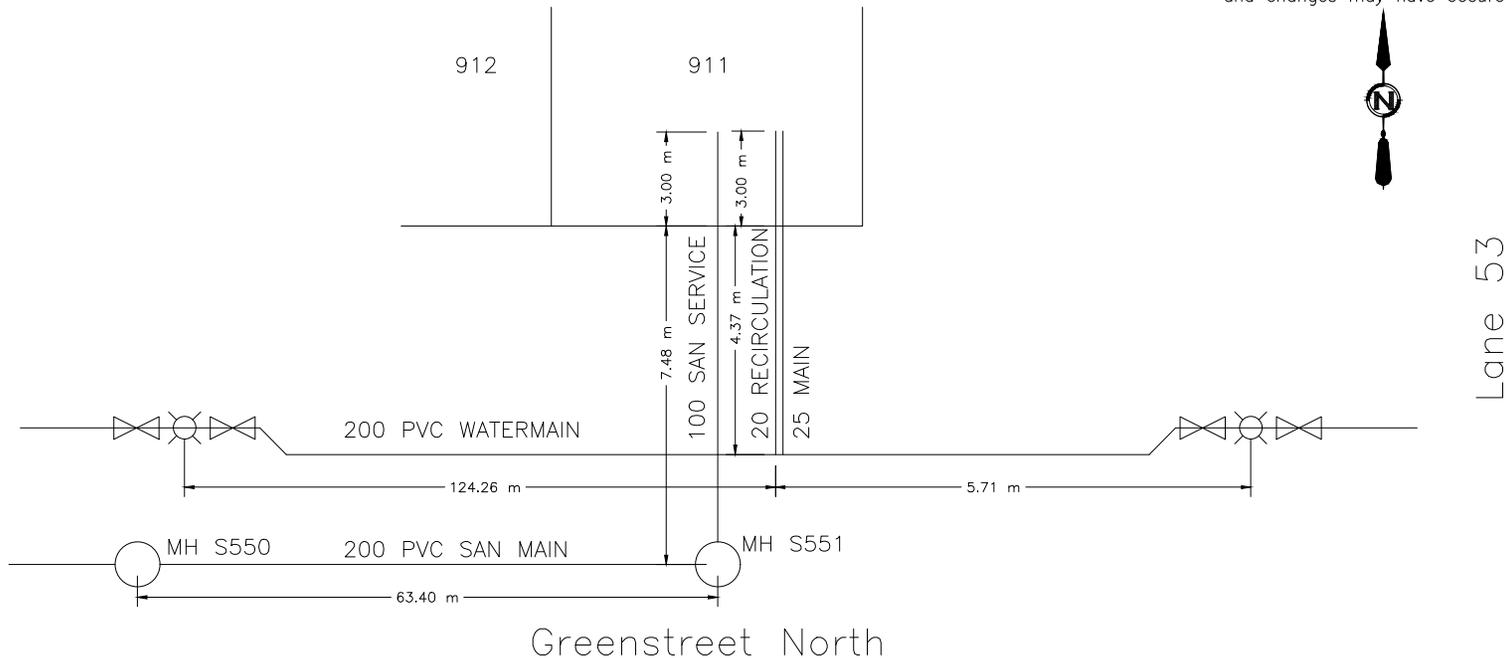



CITY OF WHITEHORSE SERVICE CONNECTION RECORD

FIELD BOOK


No.

ADDRESS 3 Chance Lane BLOCK LOT 912

DATES		WATER		SEWER	
On at Main	2019	Depth at P/L:	2.34 m	2.34	m
On at Building		Depth at Main:	2.91 m	3.01	m
Frost Plug:		Pipe Size:	25 mm / 20 mm	100	mm
Memo:		Pipe Material:	HDPE	Insul.	(Yes/No)
		Length from Main to P/L:	4.32 m	7.48	m
		Squirt Test:	(Pass/Fail)		N/A
Booster Pump Required:	Yes/No	Frost Protection:	Aquaflow/Recirc/Heat Trace/Bleeder		N/A
PRV Required:	Yes/No	Greased @ CC:	(Yes/No)		N/A
Water Meter Installed:	Yes/No	Continuity Test:	(N/A) Pass/Fail		N/A

CLEARLY INDICATE LOCATION OF CC AND ROUTE OF PIPES ON DRAWING BELOW

- Show main valves required to isolate this service.
- All dimensions to be tied to property line
- All dimensions to be metric
- Depth @ property line is based on elevation after construction and changes may have occurred.

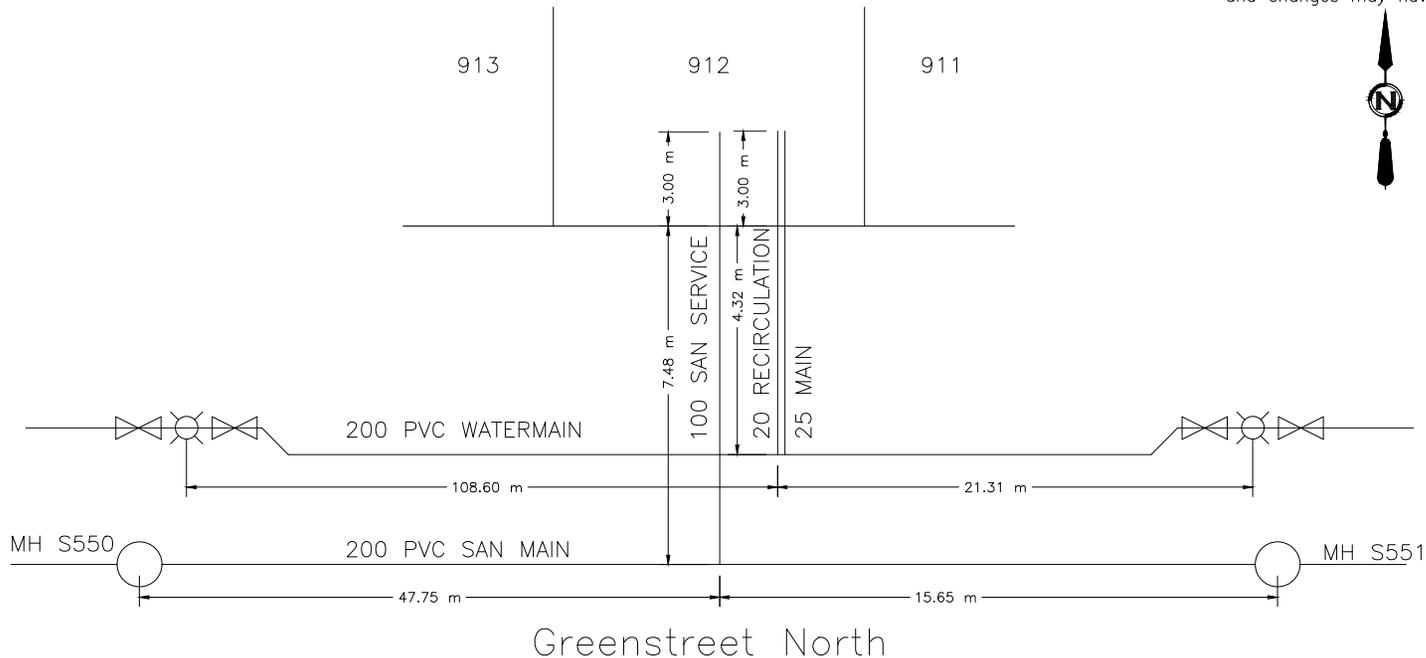



CITY OF WHITEHORSE SERVICE CONNECTION RECORD

FIELD BOOK


No.

ADDRESS 5 Chance Lane BLOCK LOT 913

DATES		WATER		SEWER	
On at Main	2019	Depth at P/L:	2.35 m		2.36 m
On at Building		Depth at Main:	2.98 m		3.23 m
Frost Plug:		Pipe Size:	25 mm / 20 mm		100 mm
Memo:		Pipe Material:	HDPE	Insul. <u>(Yes/No)</u>	PVC
		Length from Main to P/L:	4.26 m		7.48 m
		Squirt Test:	<u>(Pass)</u> /Fail		N/A
Booster Pump Required:	Yes/No	Frost Protection:	Aquaflow/ <u>(Recirc)</u> /Heat Trace/Bleeder		N/A
PRV Required:	Yes/No	Greased @ CC:	<u>(Yes)</u> /No		N/A
Water Meter Installed:	Yes/No	Continuity Test:	<u>(N/A)</u> Pass/Fail		N/A

CLEARLY INDICATE LOCATION OF CC AND ROUTE OF PIPES ON DRAWING BELOW

1. Show main valves required to isolate this service. 2. All dimensions to be tied to property line 3. All dimensions to be metric 4. Depth @ property line is based on elevation after construction and changes may have occurred.

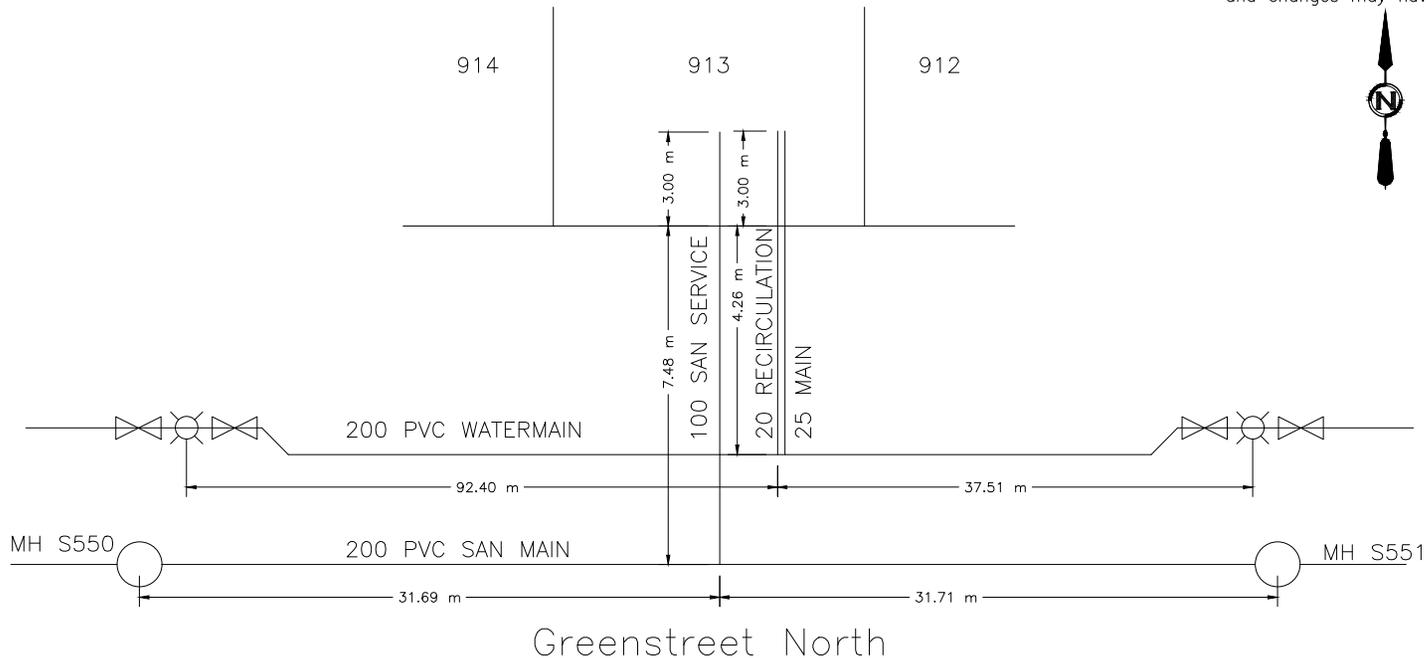



CITY OF WHITEHORSE SERVICE CONNECTION RECORD

FIELD BOOK


No.

ADDRESS 7 Chance Lane BLOCK LOT 914

	DATES	WATER	SEWER
On at Main	2019	Depth at P/L: 2.44 m	2.39 m
On at Building		Depth at Main: 3 m	3.48 m
Frost Plug:		Pipe Size: 25 mm / 20 mm	100 mm
Memo:		Pipe Material: HDPE Insul. <u>(Yes/No)</u>	PVC Insul. <u>Yes/No</u>
		Length from Main to P/L: 4.27 m	7.48 m
		Squirt Test: <u>(Pass/Fail)</u>	N/A
Booster Pump Required:	Yes/No	Frost Protection: Aquaflow/ <u>(Recirc)</u> /Heat Trace/Bleeder	N/A
PRV Required:	Yes/No	Greased @ CC: <u>(Yes/No)</u>	N/A
Water Meter Installed:	Yes/No	Continuity Test: <u>(N/A)</u> Pass/Fail	N/A

CLEARLY INDICATE LOCATION OF CC AND ROUTE OF PIPES ON DRAWING BELOW

1. Show main valves required to isolate this service. 2. All dimensions to be tied to property line 3. All dimensions to be metric 4. Depth @ property line is based on elevation after construction and changes may have occurred.

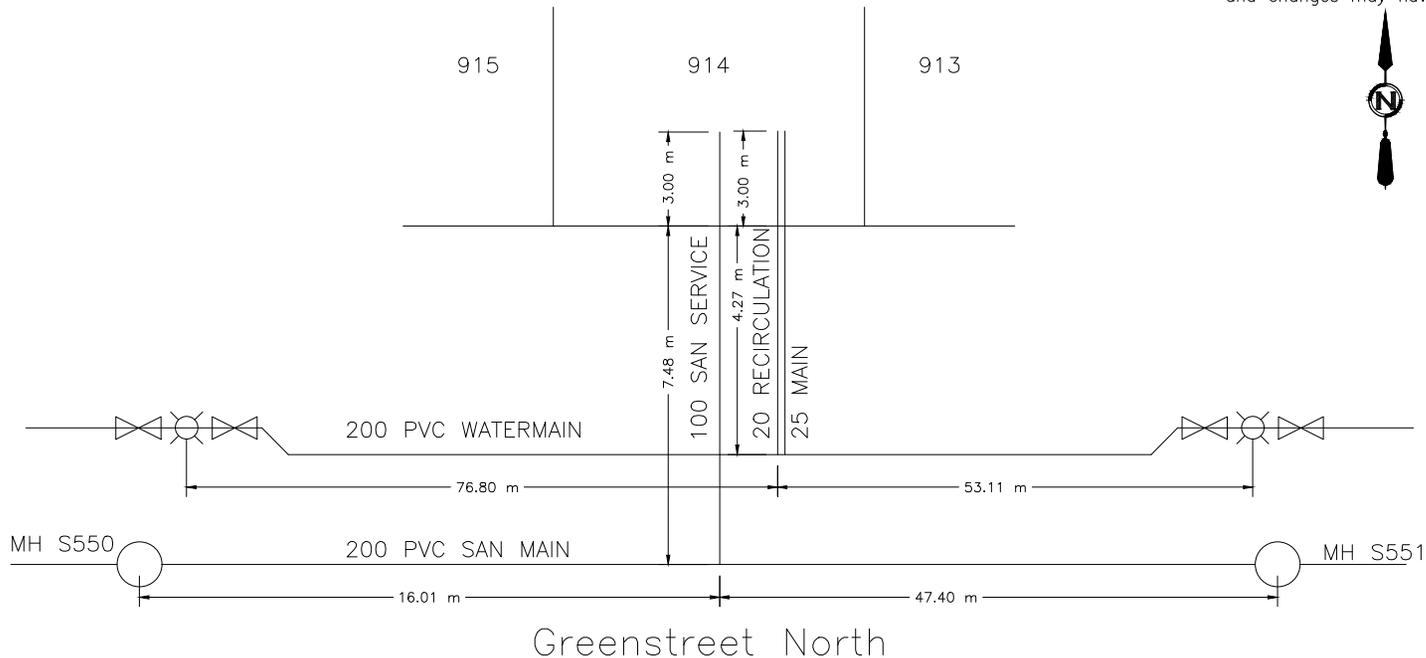



CITY OF WHITEHORSE SERVICE CONNECTION RECORD

FIELD BOOK


No.

ADDRESS 9 Chance Lane BLOCK LOT 915

DATES	WATER	SEWER
On at Main 2019	Depth at P/L: 2.28 m	2.24 m
On at Building	Depth at Main: 3.04 m	3.64 m
Frost Plug:	Pipe Size: 25 mm / 20 mm	100 mm
Memo:	Pipe Material: HDPE Insul. <u>(Yes)</u> /No	PVC Insul. <u>(Yes)</u> /No
	Length from Main to P/L: 4.28 m	7.48 m
	Squirt Test: <u>(Pass)</u> /Fail	N/A
Booster Pump Required: Yes/No	Frost Protection: Aquaflo/ <u>(Recirc)</u> /Heat Trace/Bleeder	N/A
PRV Required: Yes/No	Greased @ CC: <u>(Yes)</u> /No	N/A
Water Meter Installed: Yes/No	Continuity Test: <u>(N/A)</u> Pass/Fail	N/A

CLEARLY INDICATE LOCATION OF CC AND ROUTE OF PIPES ON DRAWING BELOW

1. Show main valves required to isolate this service. 2. All dimensions to be tied to property line 3. All dimensions to be metric 4. Depth @ property line is based on elevation after construction and changes may have occurred.

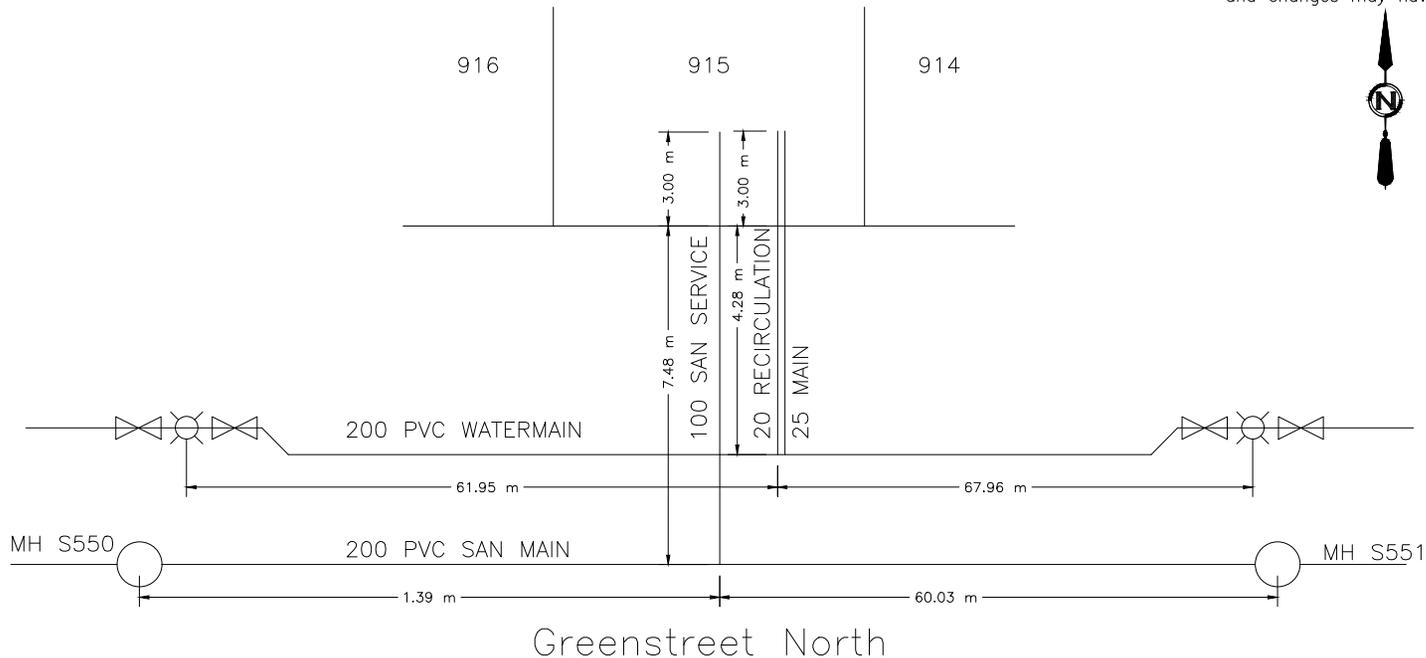



CITY OF WHITEHORSE SERVICE CONNECTION RECORD

FIELD BOOK


No.

ADDRESS 11 Chance Lane BLOCK LOT 916

DATES	WATER	SEWER
On at Main 2019	Depth at P/L: 2.28 m	2.26 m
On at Building	Depth at Main: 3.06 m	3.94 m
Frost Plug:	Pipe Size: 25 mm / 20 mm	100 mm
Memo:	Pipe Material: HDPE Insul. <u>(Yes)</u> /No	PVC Insul. <u>(Yes)</u> /No
	Length from Main to P/L: 4.3 m	7.46 m
	Squirt Test: <u>(Pass)</u> /Fail	N/A
Booster Pump Required: Yes/No	Frost Protection: Aquaflo/ <u>(Recirc)</u> /Heat Trace/Bleeder	N/A
PRV Required: Yes/No	Greased @ CC: <u>(Yes)</u> /No	N/A
Water Meter Installed: Yes/No	Continuity Test: <u>(N/A)</u> Pass/Fail	N/A

CLEARLY INDICATE LOCATION OF CC AND ROUTE OF PIPES ON DRAWING BELOW

1. Show main valves required to isolate this service. 2. All dimensions to be tied to property line 3. All dimensions to be metric 4. Depth @ property line is based on elevation after construction and changes may have occurred.

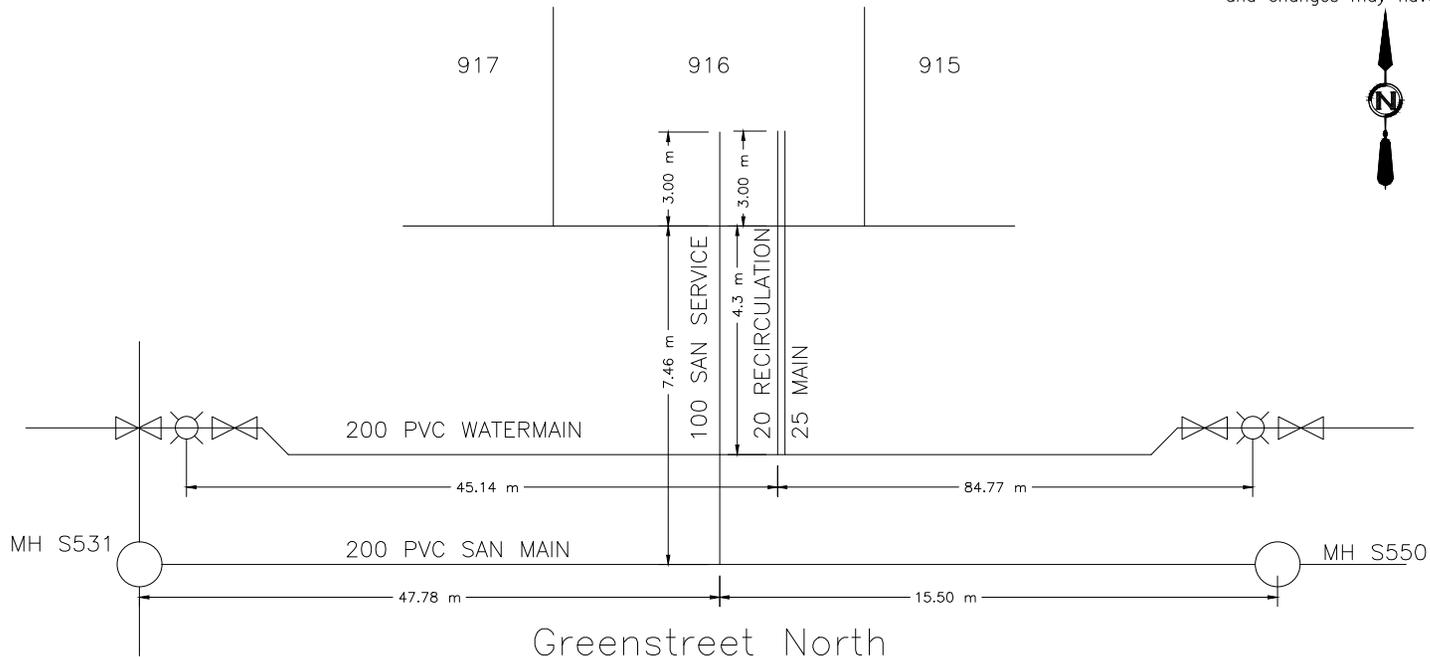



CITY OF WHITEHORSE SERVICE CONNECTION RECORD

FIELD BOOK


No. _____

ADDRESS 13 Chance Lane BLOCK _____ LOT 917

DATES		WATER	SEWER
On at Main 2019		Depth at P/L: 2.24 m	2.24 m
On at Building		Depth at Main: 2.97 m	4.04 m
Frost Plug:		Pipe Size: 25 mm / 20 mm	100 mm
Memo:	Pipe Material: HDPE Insul. <u>(Yes)</u> /No		PVC Insul. <u>(Yes)</u> /No
	Length from Main to P/L: 4.31 m		7.56 m
	Squirt Test: <u>(Pass)</u> /Fail		N/A
Booster Pump Required:	Yes/No	Frost Protection: Aquaflow/ <u>(Recirc)</u> /Heat Trace/Bleeder	N/A
PRV Required:	Yes/No	Greased @ CC: <u>(Yes)</u> /No	N/A
Water Meter Installed:	Yes/No	Continuity Test: <u>(N/A)</u> Pass/Fail	N/A

CLEARLY INDICATE LOCATION OF CC AND ROUTE OF PIPES ON DRAWING BELOW

1. Show main valves required to isolate this service. 2. All dimensions to be tied to property line 3. All dimensions to be metric 4. Depth @ property line is based on elevation after construction and changes may have occurred.

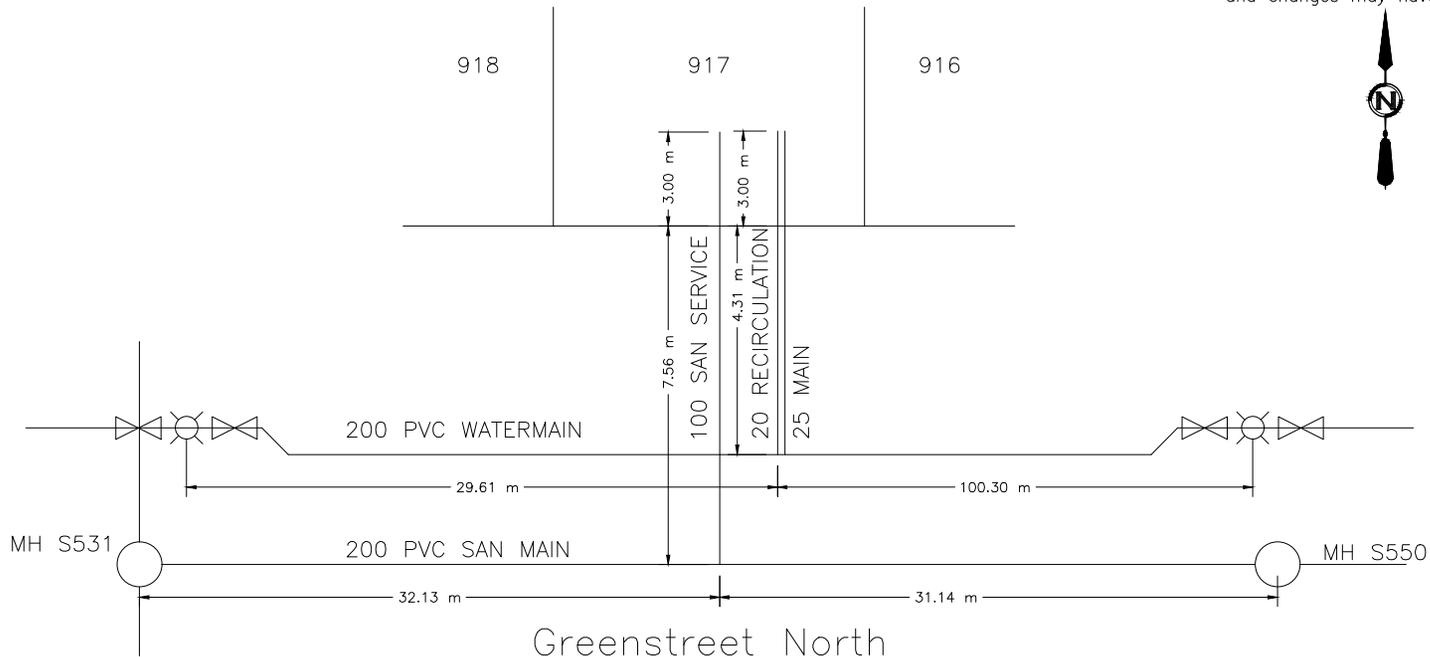



CITY OF WHITEHORSE SERVICE CONNECTION RECORD

FIELD BOOK


No.

ADDRESS 15 Chance Lane BLOCK LOT 918

DATES		WATER		SEWER		
On at Main	2019	Depth at P/L:	2.27 m		2.15 m	
On at Building		Depth at Main:	2.9 m		4.27 m	
Frost Plug:		Pipe Size:	25 mm / 20 mm		100 mm	
Memo:		Pipe Material:	HDPE	Insul. (Yes/No)	PVC	Insul. (Yes/No)
		Length from Main to P/L:	4.3 m		7.52 m	
		Squirt Test:	(Pass/Fail)			N/A
Booster Pump Required:	Yes/No	Frost Protection:	Aquaflow/Recirc/Heat Trace/Bleeder		N/A	
PRV Required:	Yes/No	Greased @ CC:	(Yes/No)		N/A	
Water Meter Installed:	Yes/No	Continuity Test:	(N/A) Pass/Fail		N/A	

CLEARLY INDICATE LOCATION OF CC AND ROUTE OF PIPES ON DRAWING BELOW

1. Show main valves required to isolate this service.
2. All dimensions to be tied to property line
3. All dimensions to be metric
4. Depth @ property line is based on elevation after construction and changes may have occurred.

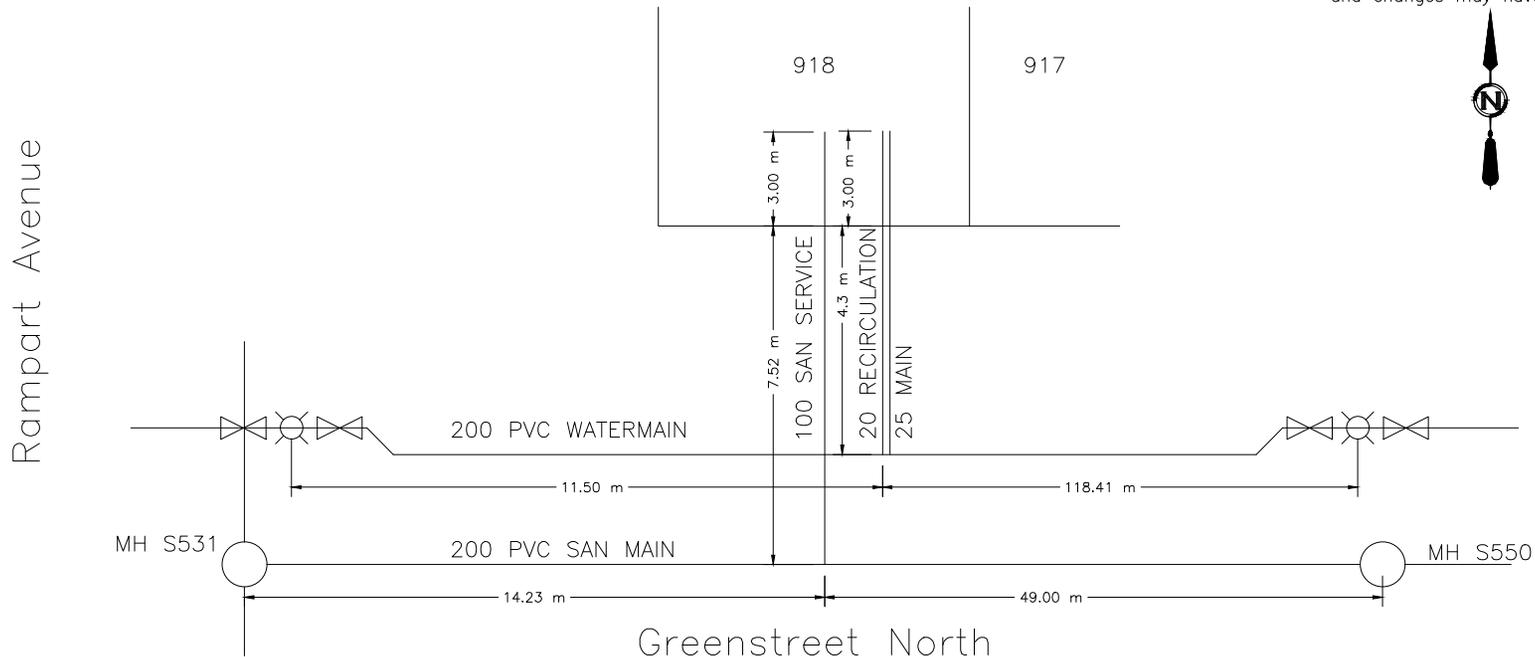



CITY OF WHITEHORSE SERVICE CONNECTION RECORD

FIELD BOOK


No.

ADDRESS 2 Gypsy Queen Lane BLOCK LOT 919

DATES		WATER		SEWER	
On at Main	2019	Depth at P/L:	2.3 m	2.33	m
On at Building		Depth at Main:	2.82 m	2.78	m
Frost Plug:		Pipe Size:	25 mm / 20 mm	100	mm
Memo:		Pipe Material:	HDPE	Insul.	(Yes/No)
		Length from Main to P/L:	9.25 m	PVC	Insul. (Yes/No)
		Squirt Test:	(Pass/Fail)		N/A
Booster Pump Required:	Yes/No	Frost Protection:	Aquaflow/Recirc/Heat Trace/Bleeder		N/A
PRV Required:	Yes/No	Greased @ CC:	(Yes/No)		N/A
Water Meter Installed:	Yes/No	Continuity Test:	(N/A) Pass/Fail		N/A

CLEARLY INDICATE LOCATION OF CC AND ROUTE OF PIPES ON DRAWING BELOW

- Show main valves required to isolate this service.
- All dimensions to be tied to property line
- All dimensions to be metric
- Depth @ property line is based on elevation after construction and changes may have occurred.

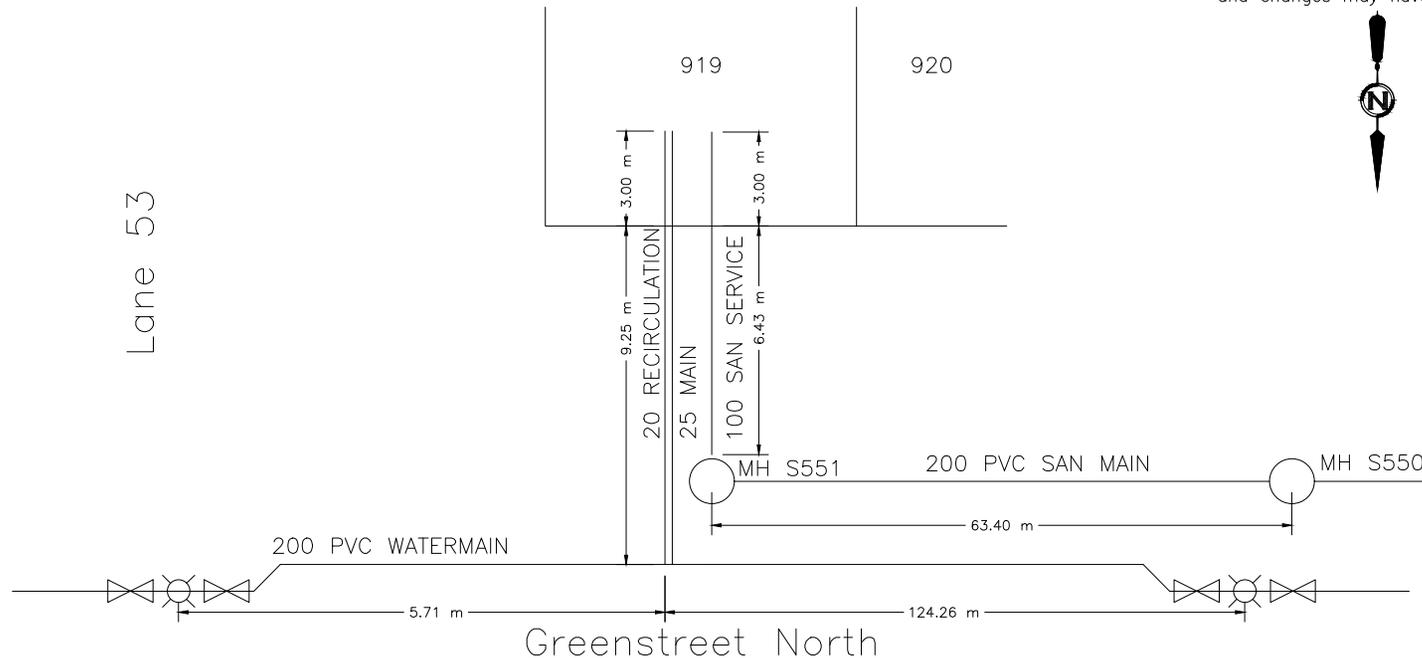



CITY OF WHITEHORSE SERVICE CONNECTION RECORD

FIELD BOOK

No.

ADDRESS 4 Gypsy Queen Lane BLOCK LOT 920

DATES		WATER		SEWER	
On at Main	2019	Depth at P/L:	2.36 m	2.35	m
On at Building		Depth at Main:	2.94 m	3	m
Frost Plug:		Pipe Size:	25 mm / 20 mm	100	mm
Memo:		Pipe Material:	HDPE	Insul. <u>(Yes/No)</u>	PVC
		Length from Main to P/L:	9.26 m	6.59	m
		Squirt Test:	<u>(Pass)</u> /Fail		N/A
Booster Pump Required:	Yes/No	Frost Protection:	Aquaflow/ <u>(Recirc)</u> /Heat Trace/Bleeder		N/A
PRV Required:	Yes/No	Greased @ CC:	<u>(Yes)</u> /No		N/A
Water Meter Installed:	Yes/No	Continuity Test:	<u>(N/A)</u> Pass/Fail		N/A

CLEARLY INDICATE LOCATION OF CC AND ROUTE OF PIPES ON DRAWING BELOW

1. Show main valves required to isolate this service. 2. All dimensions to be tied to property line 3. All dimensions to be metric 4. Depth @ property line is based on elevation after construction and changes may have occurred.





CITY OF WHITEHORSE SERVICE CONNECTION RECORD

FIELD BOOK


No.

ADDRESS 6 Gypsy Queen Lane BLOCK LOT 921

	DATES	WATER	SEWER
On at Main	2019	Depth at P/L: 2.26 m	2.31 m
On at Building		Depth at Main: 2.96 m	3.22 m
Frost Plug:		Pipe Size: 25 mm / 20 mm	100 mm
Memo:		Pipe Material: HDPE Insul. <u>(Yes/No)</u>	PVC Insul. <u>Yes/No</u>
		Length from Main to P/L: 9.29 m	6.52 m
		Squirt Test: <u>(Pass/Fail)</u>	N/A
Booster Pump Required:	Yes/No	Frost Protection: Aquaflo/ <u>(Recirc)</u> /Heat Trace/Bleeder	N/A
PRV Required:	Yes/No	Greased @ CC: <u>(Yes/No)</u>	N/A
Water Meter Installed:	Yes/No	Continuity Test: <u>(N/A)</u> Pass/Fail	N/A

CLEARLY INDICATE LOCATION OF CC AND ROUTE OF PIPES ON DRAWING BELOW

1. Show main valves required to isolate this service. 2. All dimensions to be tied to property line 3. All dimensions to be metric 4. Depth @ property line is based on elevation after construction and changes may have occurred.

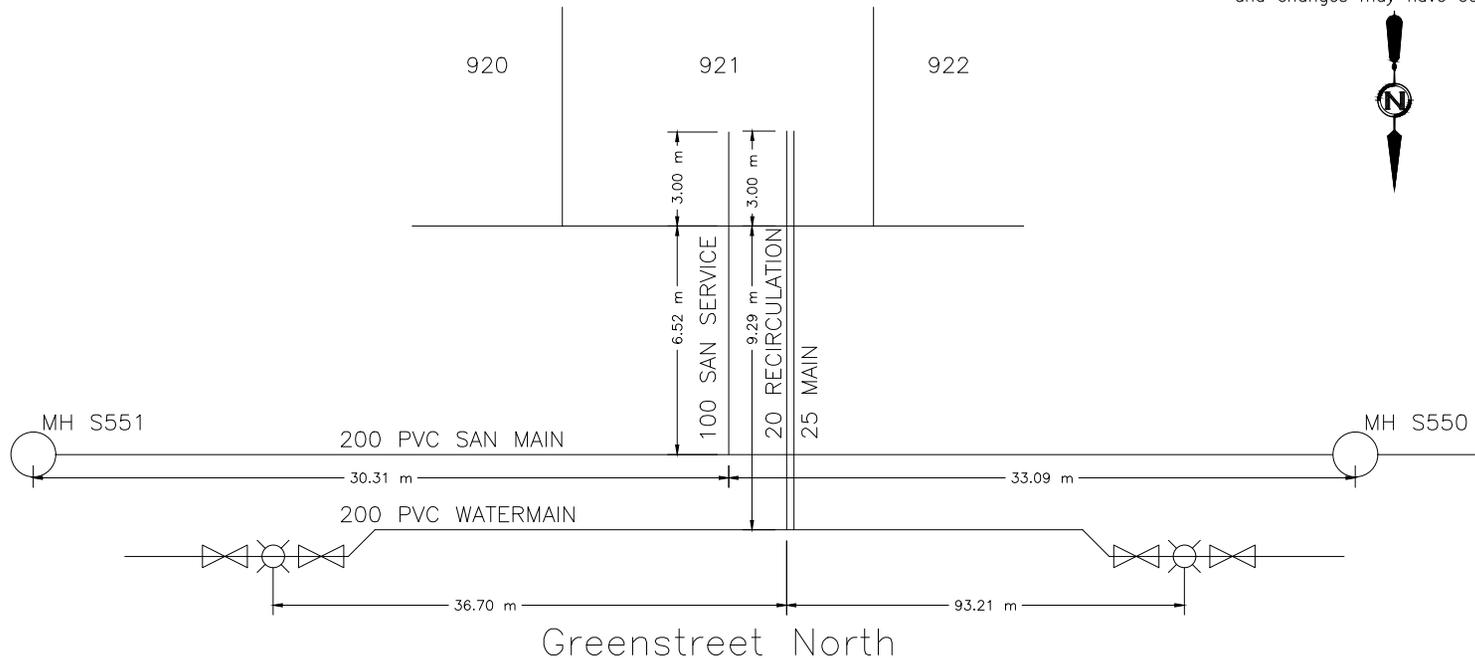



CITY OF WHITEHORSE SERVICE CONNECTION RECORD

FIELD BOOK


No.

ADDRESS 8 Gypsy Queen Lane BLOCK LOT 922

DATES	WATER	SEWER
On at Main 2019	Depth at P/L: 2.4 m	2.34 m
On at Building	Depth at Main: 2.98 m	3.39 m
Frost Plug:	Pipe Size: 25 mm / 20 mm	100 mm
Memo:	Pipe Material: HDPE Insul. <u>(Yes)</u> /No	PVC Insul. Yes/ <u>(No)</u>
	Length from Main to P/L: 9.34 m	6.47 m
	Squirt Test: <u>(Pass)</u> /Fail	N/A
Booster Pump Required: Yes/No	Frost Protection: Aquaflo/ <u>(Recirc)</u> /Heat Trace/Bleeder	N/A
PRV Required: Yes/No	Greased @ CC: <u>(Yes)</u> /No	N/A
Water Meter Installed: Yes/No	Continuity Test: <u>(N/A)</u> Pass/Fail	N/A

CLEARLY INDICATE LOCATION OF CC AND ROUTE OF PIPES ON DRAWING BELOW

1. Show main valves required to isolate this service. 2. All dimensions to be tied to property line 3. All dimensions to be metric 4. Depth @ property line is based on elevation after construction and changes may have occurred.

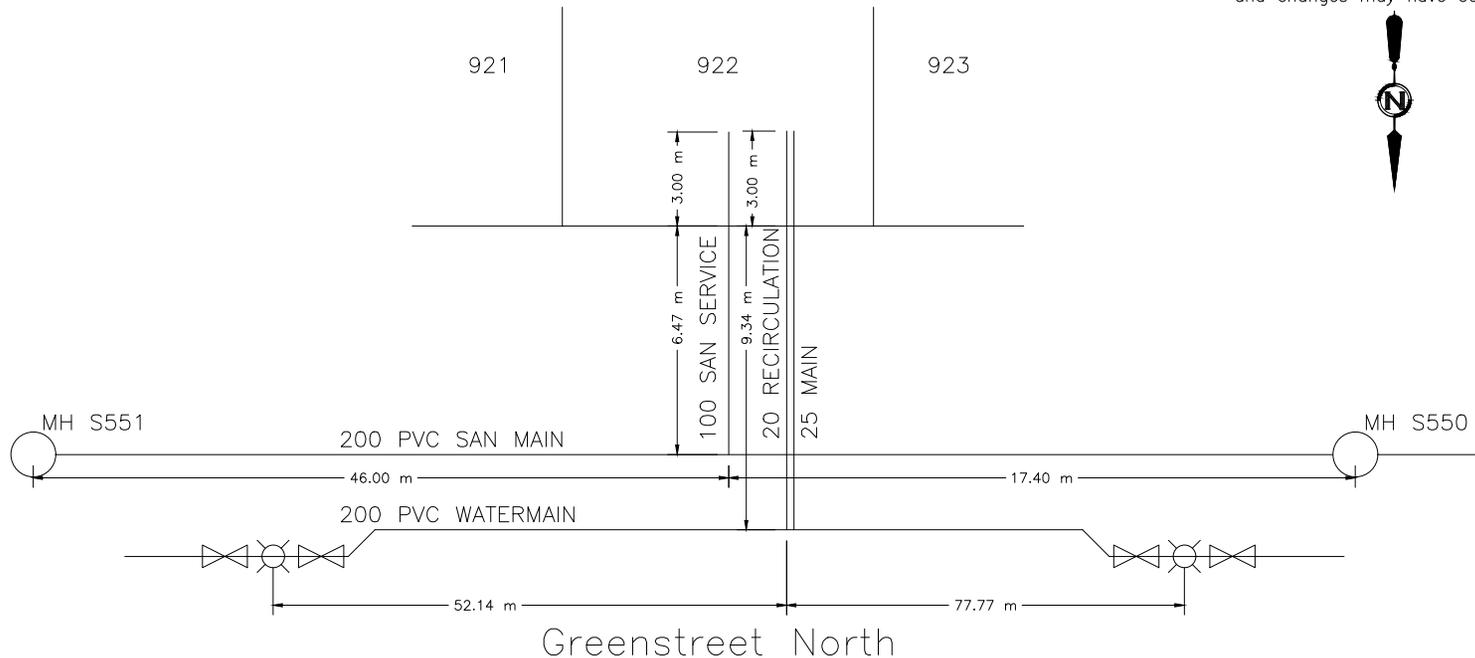



CITY OF WHITEHORSE SERVICE CONNECTION RECORD

FIELD BOOK

No.

ADDRESS 10 Gypsy Queen Lane BLOCK LOT 923

DATES	WATER	SEWER
On at Main 2019	Depth at P/L: 2.36 m	2.28 m
On at Building	Depth at Main: 3.05 m	3.67 m
Frost Plug:	Pipe Size: 25 mm / 20 mm	100 mm
Memo:	Pipe Material: HDPE Insul. <u>(Yes)</u> /No	PVC Insul. <u>(Yes)</u> /No
	Length from Main to P/L: 9.27 m	6.45 m
	Squirt Test: <u>(Pass)</u> /Fail	N/A
Booster Pump Required: Yes/No	Frost Protection: Aquaflo/ <u>(Recirc)</u> /Heat Trace/Bleeder	N/A
PRV Required: Yes/No	Greased @ CC: <u>(Yes)</u> /No	N/A
Water Meter Installed: Yes/No	Continuity Test: <u>(N/A)</u> Pass/Fail	N/A

CLEARLY INDICATE LOCATION OF CC AND ROUTE OF PIPES ON DRAWING BELOW

1. Show main valves required to isolate this service. 2. All dimensions to be tied to property line 3. All dimensions to be metric 4. Depth @ property line is based on elevation after construction and changes may have occurred.





CITY OF WHITEHORSE SERVICE CONNECTION RECORD

FIELD BOOK


No.

ADDRESS 12 Gypsy Queen Lane BLOCK LOT 924

	DATES	WATER	SEWER
On at Main	2019	Depth at P/L: 2.36 m	2.32 m
On at Building		Depth at Main: 3.09 m	3.96 m
Frost Plug:		Pipe Size: 25 mm / 20 mm	100 mm
Memo:		Pipe Material: HDPE Insul. <u>(Yes)</u> /No	PVC Insul. Yes/ <u>(No)</u>
		Length from Main to P/L: 9.23 m	6.48 m
		Squirt Test: <u>(Pass)</u> /Fail	N/A
Booster Pump Required:	Yes/No	Frost Protection: Aquaflo/ <u>(Recirc)</u> /Heat Trace/Bleeder	N/A
PRV Required:	Yes/No	Greased @ CC: <u>(Yes)</u> /No	N/A
Water Meter Installed:	Yes/No	Continuity Test: <u>(N/A)</u> Pass/Fail	N/A

CLEARLY INDICATE LOCATION OF CC AND ROUTE OF PIPES ON DRAWING BELOW

1. Show main valves required to isolate this service. 2. All dimensions to be tied to property line 3. All dimensions to be metric 4. Depth @ property line is based on elevation after construction and changes may have occurred.

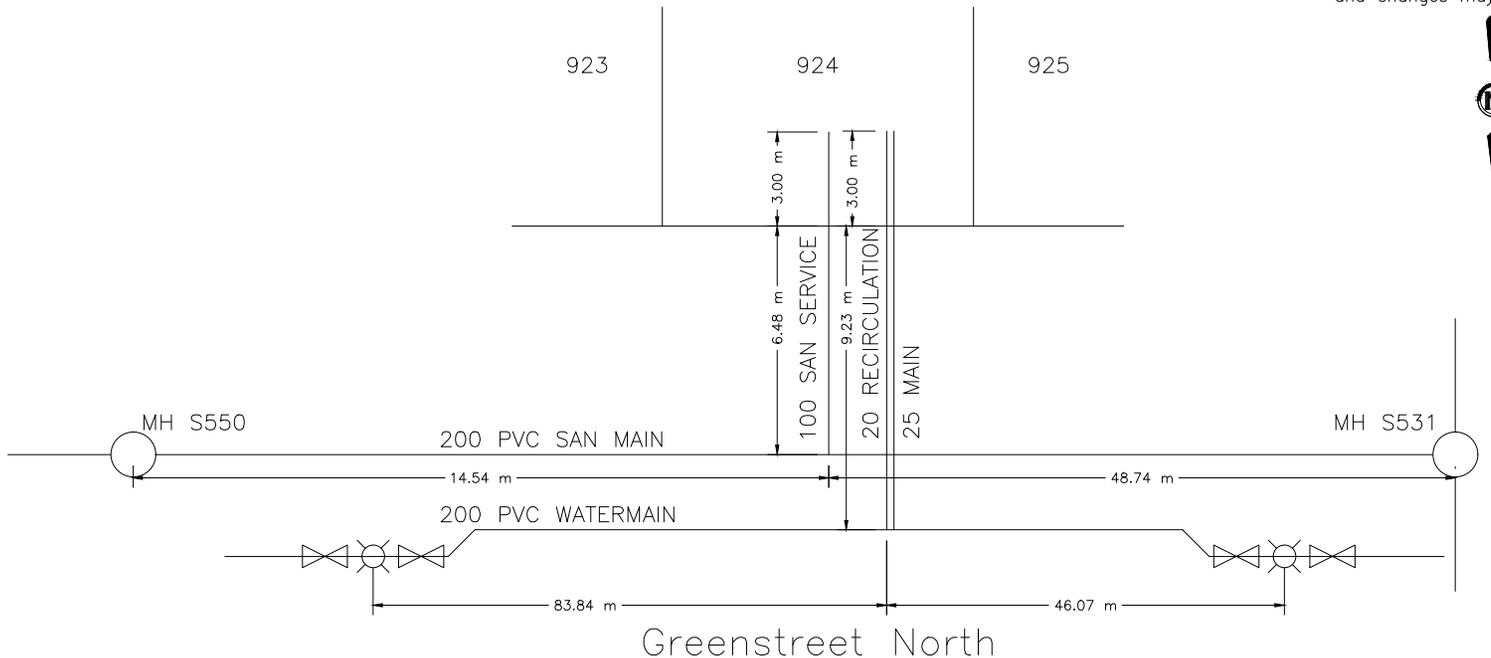



CITY OF WHITEHORSE SERVICE CONNECTION RECORD

FIELD BOOK


No.

ADDRESS 14 Gypsy Queen Lane BLOCK LOT 925

	DATES	WATER	SEWER
On at Main	2019	Depth at P/L: 2.34 m	2.19 m
On at Building		Depth at Main: 3.02 m	4.04 m
Frost Plug:		Pipe Size: 25 mm / 20 mm	100 mm
Memo:		Pipe Material: HDPE	PVC
		Insul. <input checked="" type="checkbox"/> Yes / <input type="checkbox"/> No	Insul. Yes / <input checked="" type="checkbox"/> No
		Length from Main to P/L: 9.26 m	6.43 m
		Squirt Test: <input checked="" type="checkbox"/> Pass / <input type="checkbox"/> Fail	N/A
Booster Pump Required:	Yes/No	Frost Protection: Aquaflo / <input checked="" type="checkbox"/> Recirc / Heat Trace / Bleeder	N/A
PRV Required:	Yes/No	Greased @ CC: <input checked="" type="checkbox"/> Yes / <input type="checkbox"/> No	N/A
Water Meter Installed:	Yes/No	Continuity Test: <input checked="" type="checkbox"/> N/A	N/A

CLEARLY INDICATE LOCATION OF CC AND ROUTE OF PIPES ON DRAWING BELOW

1. Show main valves required to isolate this service. 2. All dimensions to be tied to property line 3. All dimensions to be metric 4. Depth @ property line is based on elevation after construction and changes may have occurred.

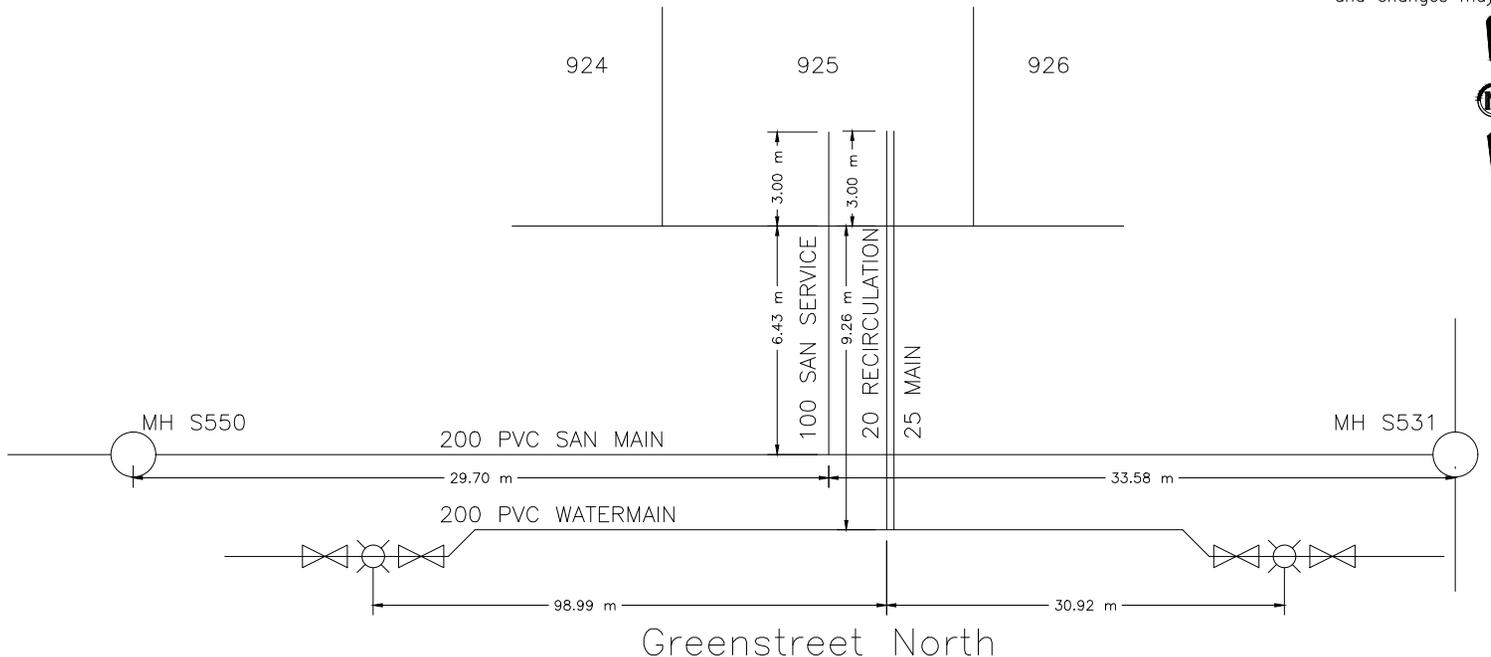



CITY OF WHITEHORSE SERVICE CONNECTION RECORD

FIELD BOOK


No.

ADDRESS 16 Gypsy Queen Lane BLOCK LOT 926

DATES	WATER	SEWER
On at Main 2019	Depth at P/L: 2.27 m	2.26 m
On at Building	Depth at Main: 3.03 m	4.11 m
Frost Plug:	Pipe Size: 25 mm / 20 mm	100 mm
Memo:	Pipe Material: HDPE Insul. <u>(Yes)</u> /No	PVC Insul. <u>(Yes)</u> /No
	Length from Main to P/L: 9.11 m	6.43 m
	Squirt Test: <u>(Pass)</u> /Fail	N/A
Booster Pump Required: Yes/No	Frost Protection: Aquaflo/ <u>(Recirc)</u> /Heat Trace/Bleeder	N/A
PRV Required: Yes/No	Greased @ CC: <u>(Yes)</u> /No	N/A
Water Meter Installed: Yes/No	Continuity Test: <u>(N/A)</u> Pass/Fail	N/A

CLEARLY INDICATE LOCATION OF CC AND ROUTE OF PIPES ON DRAWING BELOW

1. Show main valves required to isolate this service. 2. All dimensions to be tied to property line 3. All dimensions to be metric 4. Depth @ property line is based on elevation after construction and changes may have occurred.

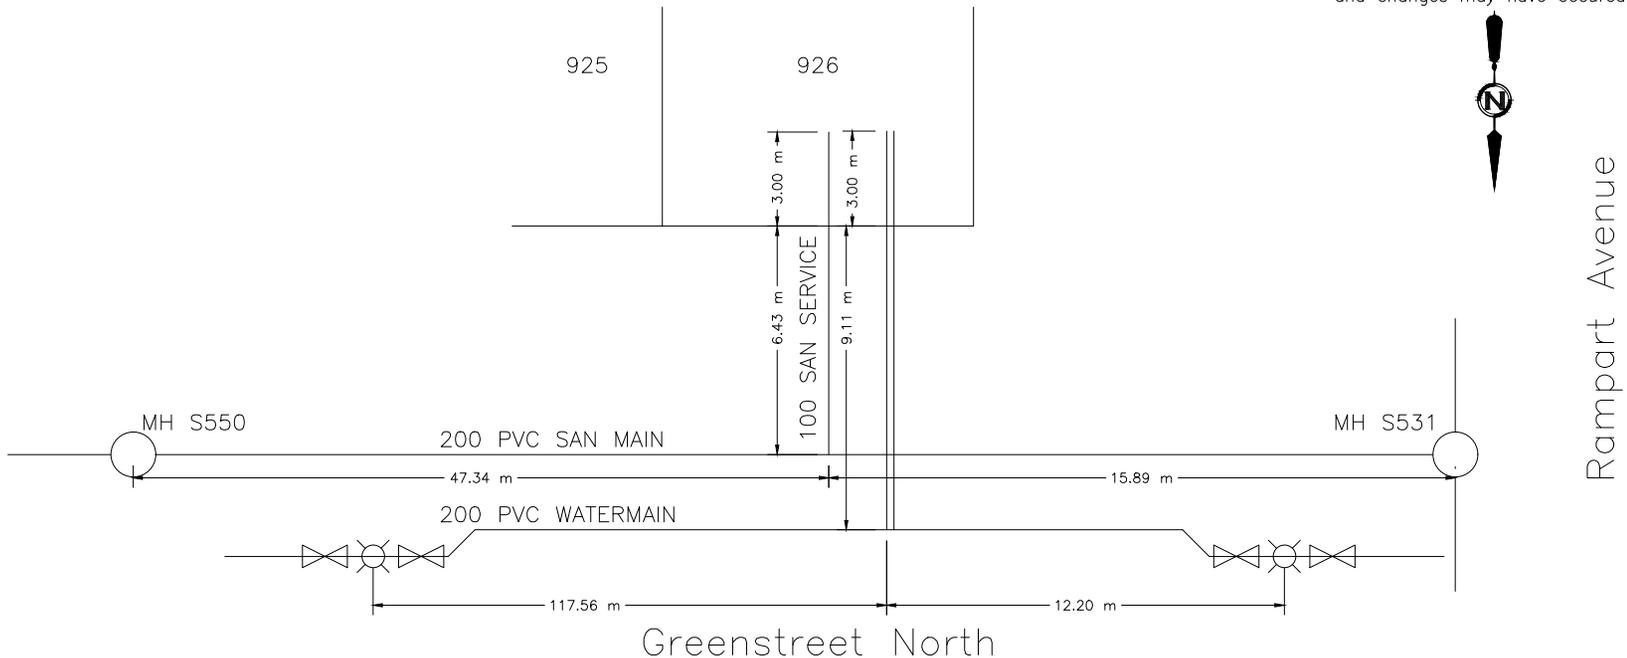



CITY OF WHITEHORSE SERVICE CONNECTION RECORD

FIELD BOOK


No.

ADDRESS 131 Witch Hazel Drive BLOCK LOT 927

DATES		WATER		SEWER	
On at Main	2019	Depth at P/L:	2.41 m		2.46 m
On at Building		Depth at Main:	3.14 m		3.02 m
Frost Plug:		Pipe Size:	25 mm / 20 mm		100 mm
Memo:		Pipe Material:	HDPE	Insul. <u>(Yes)</u> /No	PVC
		Length from Main to P/L:	7.26 m		10.3 m
		Squirt Test:	<u>(Pass)</u> /Fail		N/A
Booster Pump Required:	Yes/No	Frost Protection:	Aquaflow/ <u>(Recirc)</u> /Heat Trace/Bleeder		N/A
PRV Required:	Yes/No	Greased @ CC:	<u>(Yes)</u> /No		N/A
Water Meter Installed:	Yes/No	Continuity Test:	<u>(N/A)</u> Pass/Fail		N/A

CLEARLY INDICATE LOCATION OF CC AND ROUTE OF PIPES ON DRAWING BELOW

1. Show main valves required to isolate this service.
2. All dimensions to be tied to property line
3. All dimensions to be metric
4. Depth @ property line is based on elevation after construction and changes may have occurred.

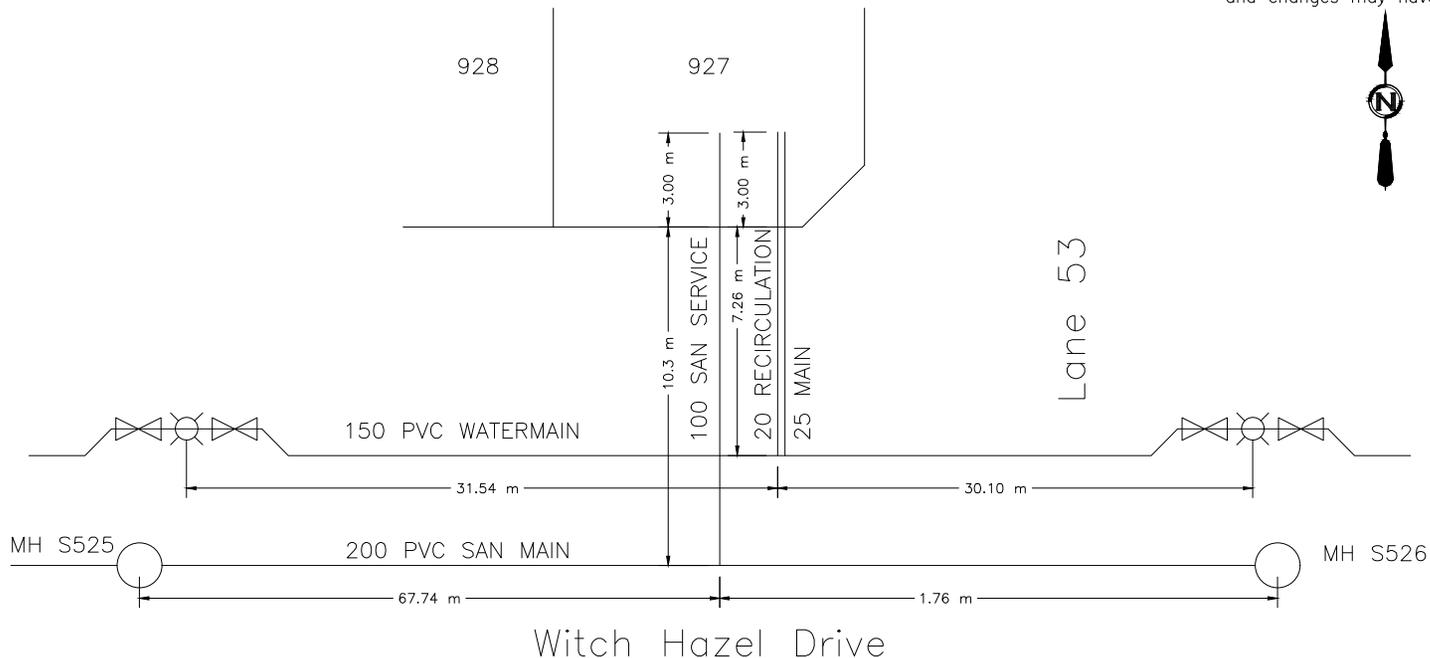



CITY OF WHITEHORSE SERVICE CONNECTION RECORD

FIELD BOOK


No.

ADDRESS 133 Witch Hazel Drive BLOCK LOT 928

	DATES	WATER		SEWER
On at Main	2019	Depth at P/L: 2.58 m	2.5	m
On at Building		Depth at Main: 3.11 m	3.12	m
Frost Plug:		Pipe Size: 25 mm / 20 mm	100	mm
Memo:		Pipe Material: HDPE	Insul. <input checked="" type="checkbox"/> Yes / <input type="checkbox"/> No	PVC
		Length from Main to P/L: 7.14 m	10.3	m
		Squirt Test: <input checked="" type="checkbox"/> Pass / <input type="checkbox"/> Fail		N/A
Booster Pump Required:	<input type="checkbox"/> Yes / <input type="checkbox"/> No	Frost Protection: Aquaflo / <input checked="" type="checkbox"/> Recirc / Heat Trace / Bleeder		N/A
PRV Required:	<input type="checkbox"/> Yes / <input type="checkbox"/> No	Greased @ CC: <input checked="" type="checkbox"/> Yes / <input type="checkbox"/> No		N/A
Water Meter Installed:	<input type="checkbox"/> Yes / <input type="checkbox"/> No	Continuity Test: <input checked="" type="checkbox"/> N/A	<input type="checkbox"/> Pass / <input type="checkbox"/> Fail	N/A

CLEARLY INDICATE LOCATION OF CC AND ROUTE OF PIPES ON DRAWING BELOW

1. Show main valves required to isolate this service. 2. All dimensions to be tied to property line 3. All dimensions to be metric 4. Depth @ property line is based on elevation after construction and changes may have occurred.

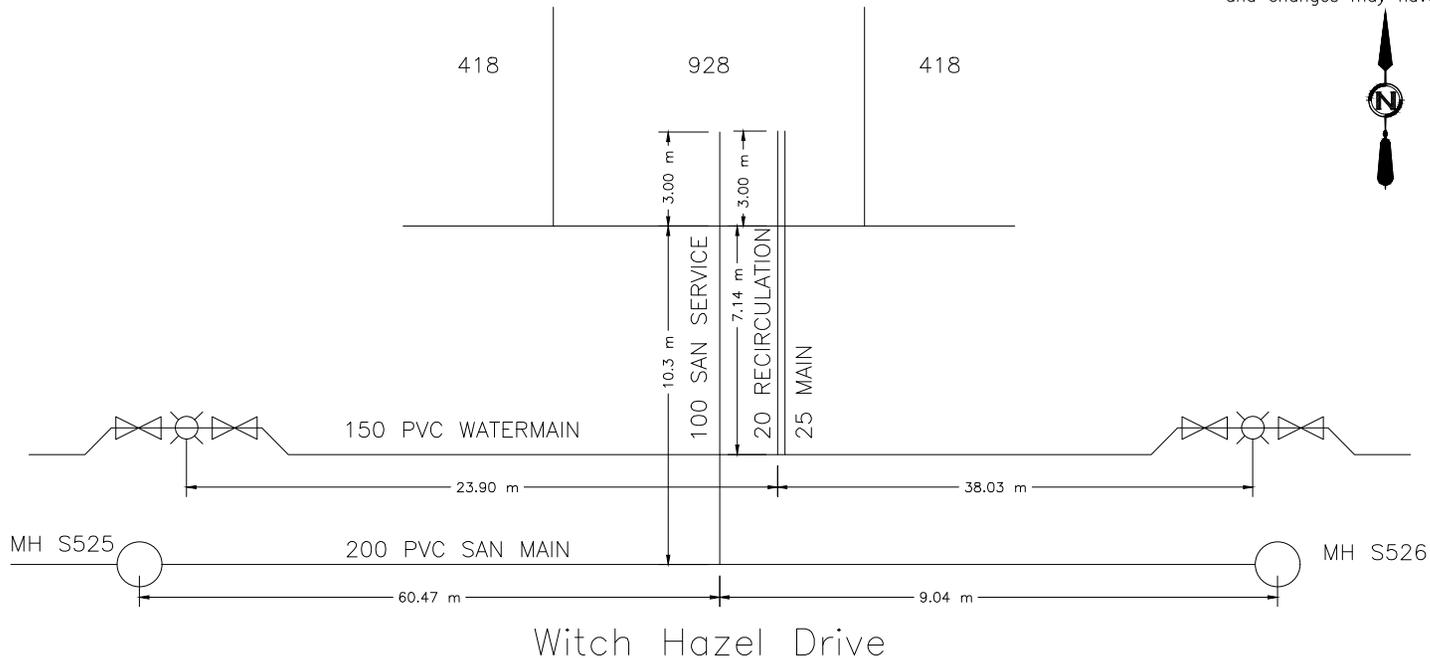



CITY OF WHITEHORSE SERVICE CONNECTION RECORD

FIELD BOOK


No.

ADDRESS 135 Witch Hazel Drive BLOCK LOT 929

DATES	WATER	SEWER
On at Main 2019	Depth at P/L: 2.57 m	2.5 m
On at Building	Depth at Main: 3.1 m	3.19 m
Frost Plug:	Pipe Size: 25 mm / 20 mm	100 mm
Memo:	Pipe Material: HDPE Insul. <u>(Yes)</u> /No	PVC Insul. Yes/ <u>(No)</u>
	Length from Main to P/L: 7.13 m	10.34 m
	Squirt Test: <u>(Pass)</u> /Fail	N/A
Booster Pump Required: Yes/No	Frost Protection: Aquaflo/ <u>(Recirc)</u> /Heat Trace/Bleeder	N/A
PRV Required: Yes/No	Greased @ CC: <u>(Yes)</u> /No	N/A
Water Meter Installed: Yes/No	Continuity Test: <u>(N/A)</u> Pass/Fail	N/A

CLEARLY INDICATE LOCATION OF CC AND ROUTE OF PIPES ON DRAWING BELOW

1. Show main valves required to isolate this service. 2. All dimensions to be tied to property line 3. All dimensions to be metric 4. Depth @ property line is based on elevation after construction and changes may have occurred.

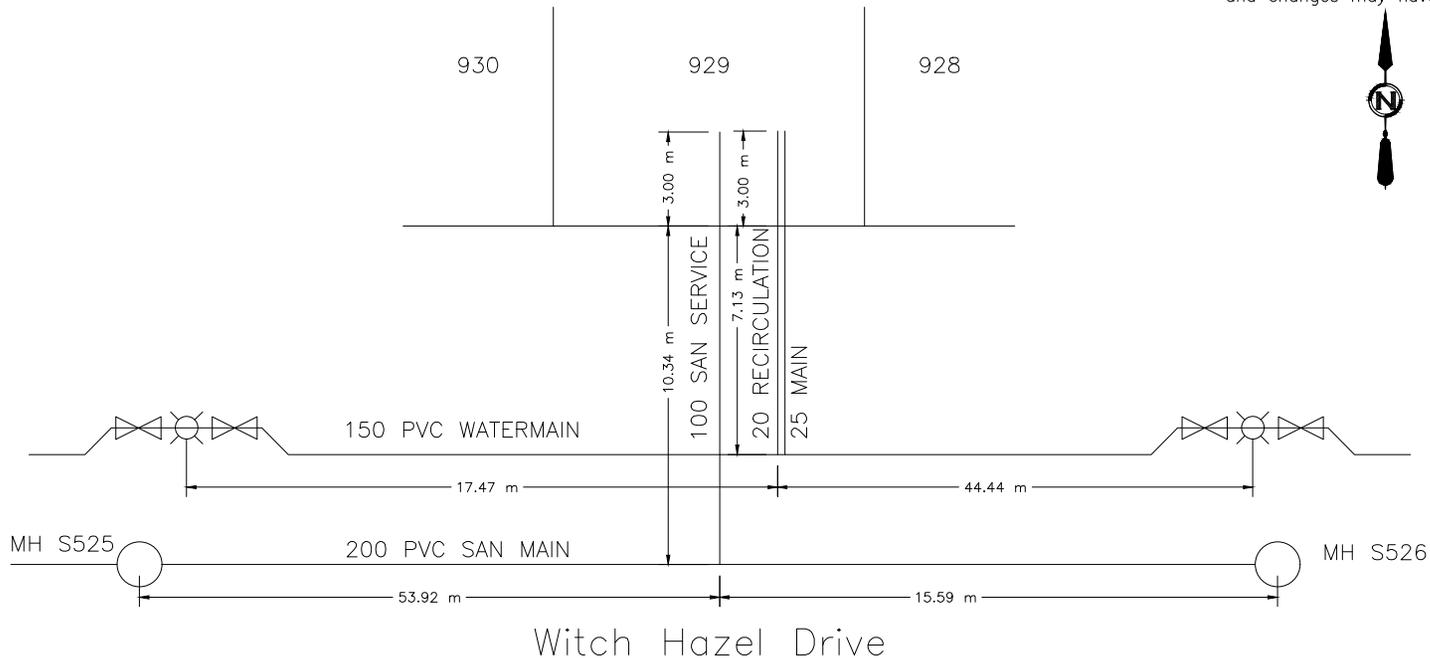



CITY OF WHITEHORSE SERVICE CONNECTION RECORD

FIELD BOOK


No.

ADDRESS 137 Witch Hazel Drive BLOCK LOT 930

DATES	WATER	SEWER
On at Main 2019	Depth at P/L: 2.57 m	2.42 m
On at Building	Depth at Main: 3.08 m	3.28 m
Frost Plug:	Pipe Size: 25 mm / 20 mm	100 mm
Memo:	Pipe Material: HDPE Insul. <u>(Yes)</u> /No	PVC Insul. Yes/ <u>(No)</u>
	Length from Main to P/L: 7.11 m	10.36 m
	Squirt Test: <u>(Pass)</u> /Fail	N/A
Booster Pump Required: Yes/No	Frost Protection: Aquaflo/ <u>(Recirc)</u> /Heat Trace/Bleeder	N/A
PRV Required: Yes/No	Greased @ CC: <u>(Yes)</u> /No	N/A
Water Meter Installed: Yes/No	Continuity Test: <u>(N/A)</u> Pass/Fail	N/A

CLEARLY INDICATE LOCATION OF CC AND ROUTE OF PIPES ON DRAWING BELOW

1. Show main valves required to isolate this service. 2. All dimensions to be tied to property line 3. All dimensions to be metric 4. Depth @ property line is based on elevation after construction and changes may have occurred.

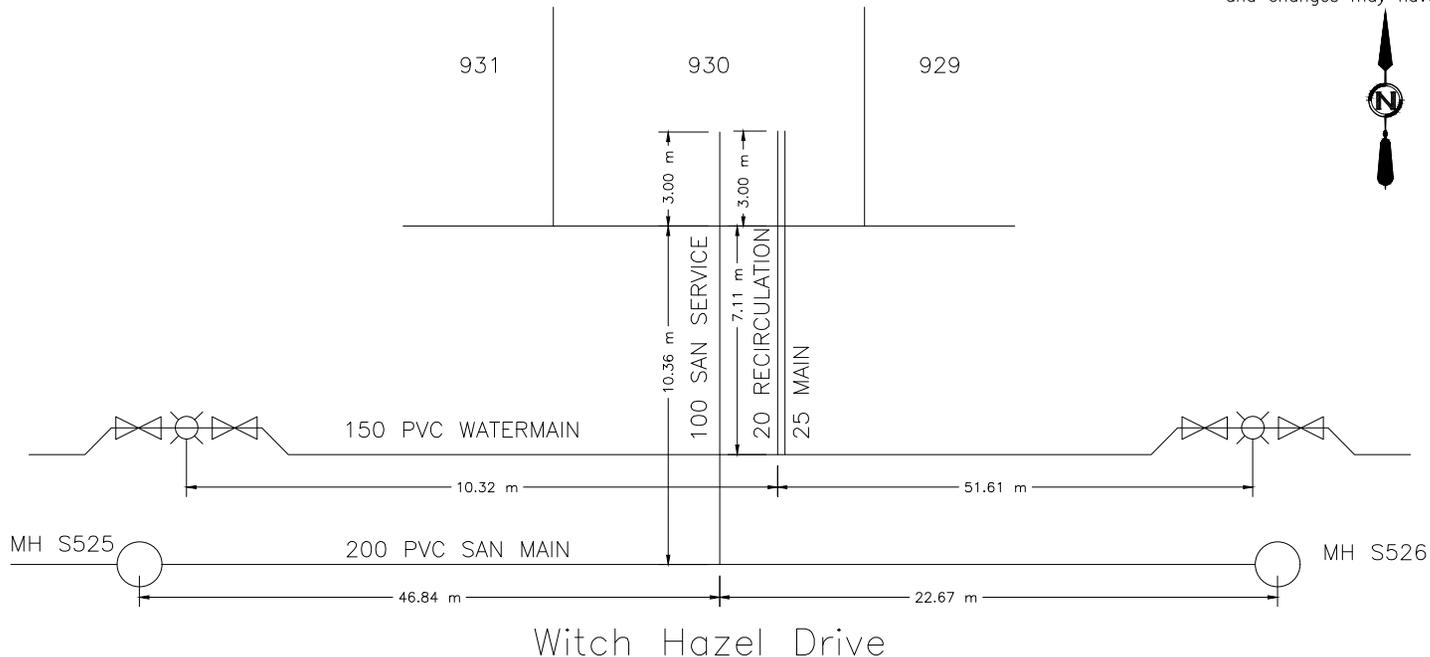



CITY OF WHITEHORSE SERVICE CONNECTION RECORD

FIELD BOOK


No.

ADDRESS 139 Witch Hazel Drive BLOCK LOT 931

DATES		WATER		SEWER
On at Main	2019	Depth at P/L:	2.44 m	2.33 m
On at Building		Depth at Main:	2.97 m	3.24 m
Frost Plug:		Pipe Size:	25 mm / 20 mm	100 mm
Memo:		Pipe Material:	HDPE Insul. <u>(Yes)</u> /No	PVC Insul. Yes/ <u>(No)</u>
		Length from Main to P/L:	7.12 m	10.37 m
		Squirt Test:	<u>(Pass)</u> /Fail	N/A
Booster Pump Required:	Yes/No	Frost Protection:	Aquaflow/ <u>(Recirc)</u> /Heat Trace/Bleeder	N/A
PRV Required:	Yes/No	Greased @ CC:	<u>(Yes)</u> /No	N/A
Water Meter Installed:	Yes/No	Continuity Test:	<u>(N/A)</u> Pass/Fail	N/A

CLEARLY INDICATE LOCATION OF CC AND ROUTE OF PIPES ON DRAWING BELOW

1. Show main valves required to isolate this service.
2. All dimensions to be tied to property line
3. All dimensions to be metric
4. Depth @ property line is based on elevation after construction and changes may have occurred.

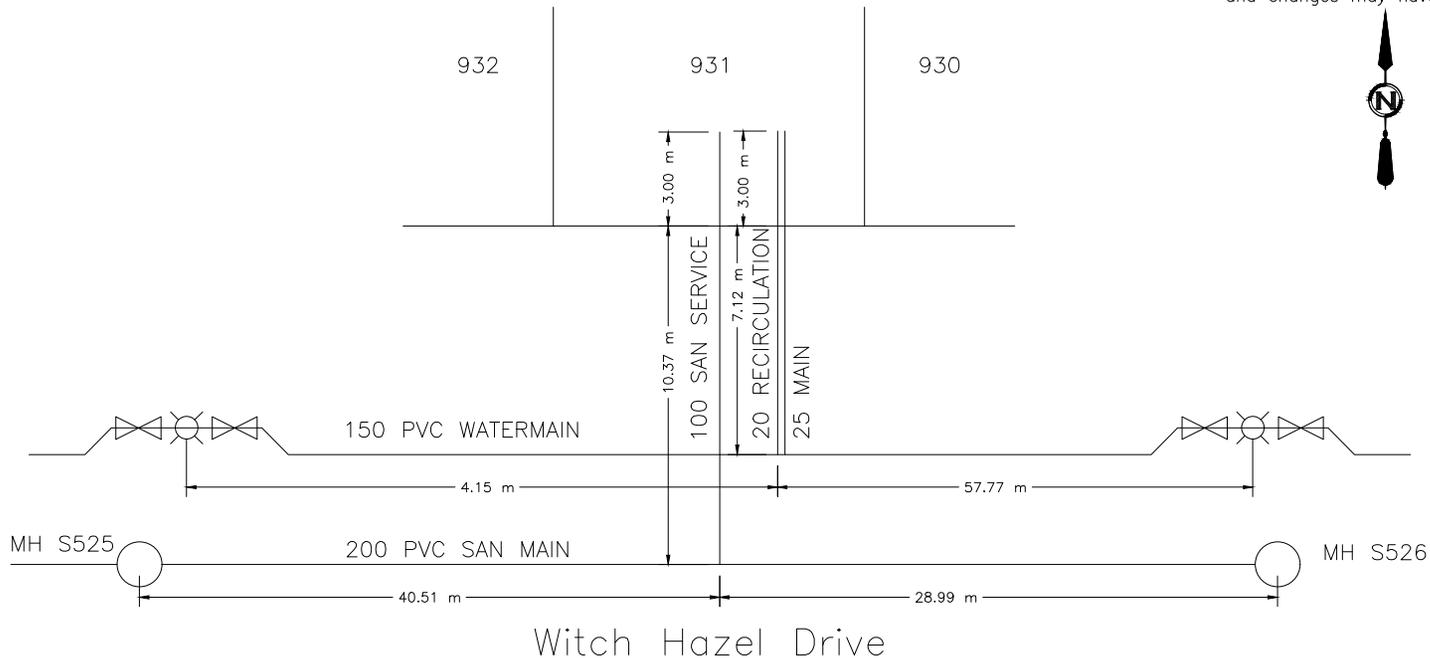



CITY OF WHITEHORSE SERVICE CONNECTION RECORD

FIELD BOOK


No.

ADDRESS 141 Witch Hazel Drive BLOCK LOT 932

DATES	WATER	SEWER
On at Main 2019	Depth at P/L: 2.62 m	2.64 m
On at Building	Depth at Main: 3.05 m	3.29 m
Frost Plug:	Pipe Size: 25 mm / 20 mm	100 mm
Memo:	Pipe Material: HDPE Insul. <u>(Yes)</u> /No	PVC Insul. Yes/ <u>(No)</u>
	Length from Main to P/L: 7.26 m	10.33 m
	Squirt Test: <u>(Pass)</u> /Fail	N/A
Booster Pump Required: Yes/No	Frost Protection: Aquaflo/ <u>(Recirc)</u> /Heat Trace/Bleeder	N/A
PRV Required: Yes/No	Greased @ CC: <u>(Yes)</u> /No	N/A
Water Meter Installed: Yes/No	Continuity Test: <u>(N/A)</u> Pass/Fail	N/A

CLEARLY INDICATE LOCATION OF CC AND ROUTE OF PIPES ON DRAWING BELOW

1. Show main valves required to isolate this service. 2. All dimensions to be tied to property line 3. All dimensions to be metric 4. Depth @ property line is based on elevation after construction and changes may have occurred.

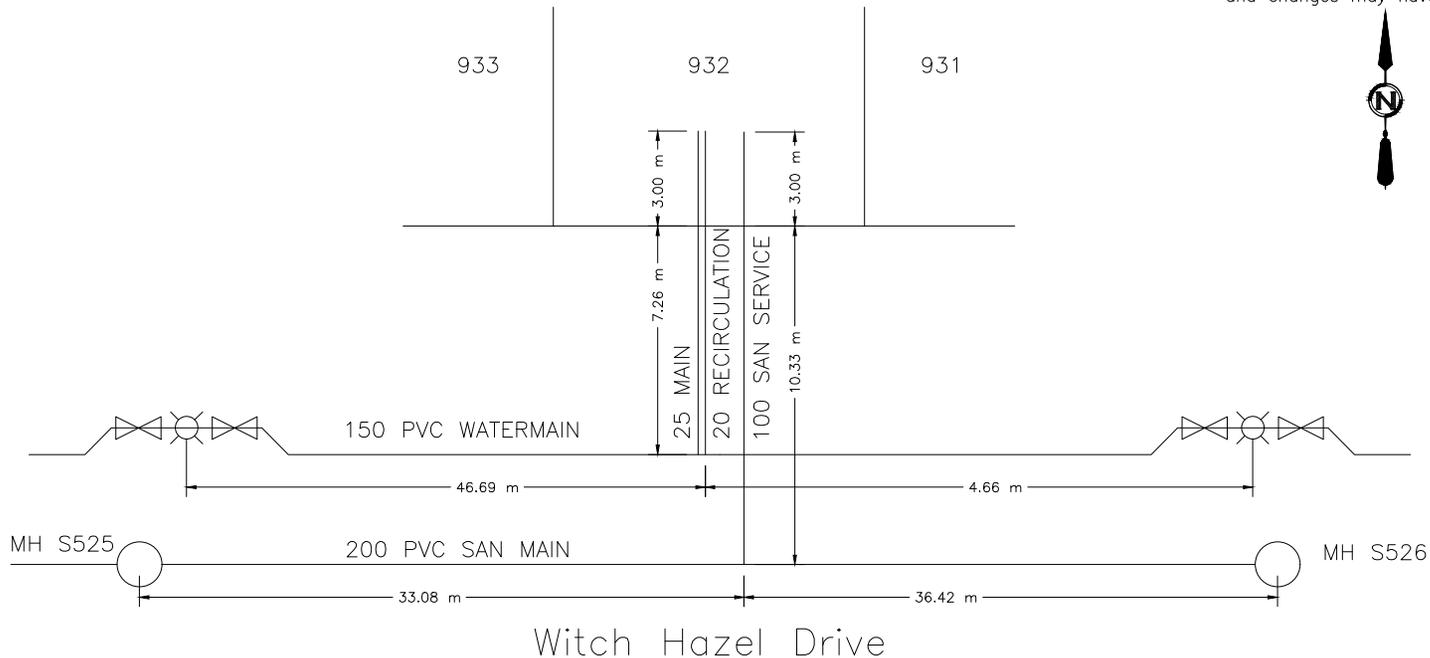



CITY OF WHITEHORSE SERVICE CONNECTION RECORD

FIELD BOOK


No.

ADDRESS 143 Witch Hazel Drive BLOCK LOT 933

DATES	WATER	SEWER
On at Main 2019	Depth at P/L: 2.66 m	2.64 m
On at Building	Depth at Main: 3.06 m	3.52 m
Frost Plug:	Pipe Size: 25 mm / 20 mm	100 mm
Memo:	Pipe Material: HDPE Insul. <u>Yes</u> /No	PVC Insul. Yes/ <u>No</u>
	Length from Main to P/L: 7.14 m	10.3 m
	Squirt Test: <u>Pass</u> /Fail	N/A
Booster Pump Required: Yes/No	Frost Protection: Aquaflo/ <u>Recirc</u> /Heat Trace/Bleeder	N/A
PRV Required: Yes/No	Greased @ CC: <u>Yes</u> /No	N/A
Water Meter Installed: Yes/No	Continuity Test: <u>N/A</u> Pass/Fail	N/A

CLEARLY INDICATE LOCATION OF CC AND ROUTE OF PIPES ON DRAWING BELOW

1. Show main valves required to isolate this service. 2. All dimensions to be tied to property line 3. All dimensions to be metric 4. Depth @ property line is based on elevation after construction and changes may have occurred.

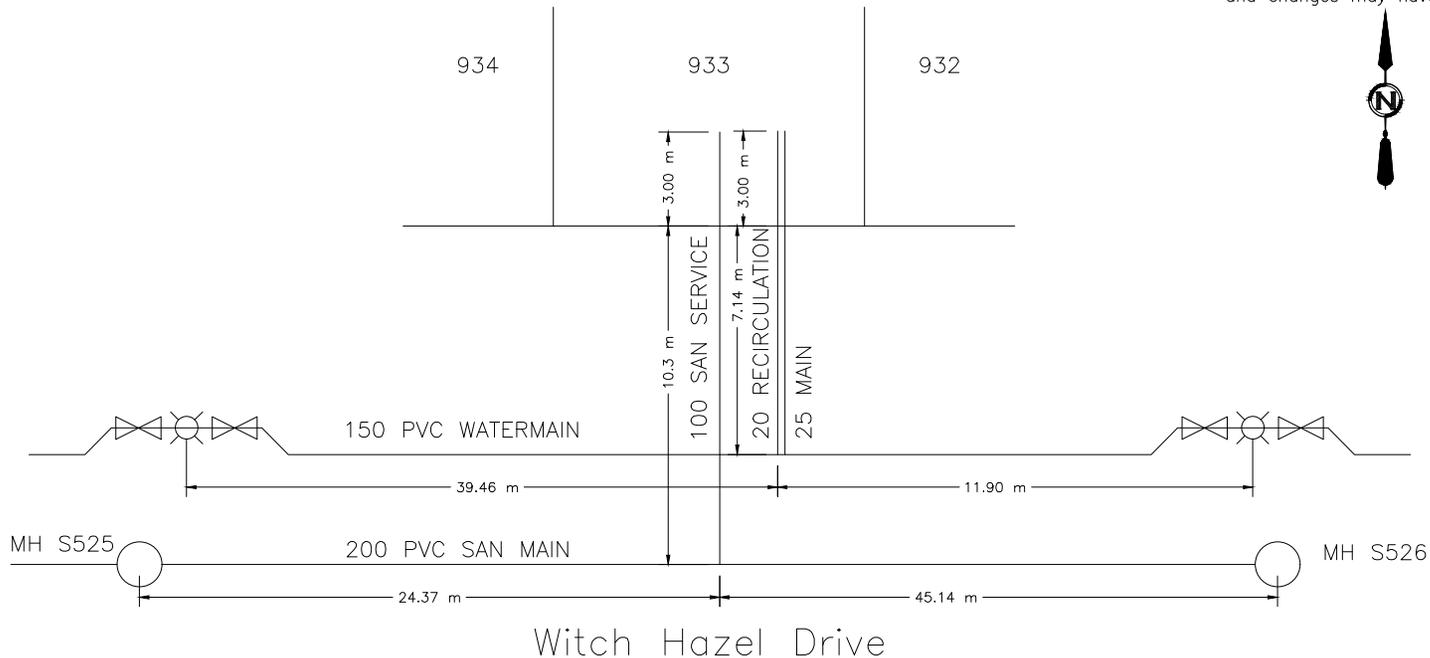



CITY OF WHITEHORSE SERVICE CONNECTION RECORD

FIELD BOOK


No.

ADDRESS 145 Witch Hazel Drive BLOCK LOT 934

DATES	WATER	SEWER
On at Main 2019	Depth at P/L: 2.27 m	2.31 m
On at Building	Depth at Main: 2.96 m	3.59 m
Frost Plug:	Pipe Size: 25 mm / 20 mm	100 mm
Memo:	Pipe Material: HDPE	Insul. <input checked="" type="checkbox"/> Yes / <input type="checkbox"/> No
	Length from Main to P/L: 7.31 m	PVC
	Squirt Test: <input checked="" type="checkbox"/> Pass / <input type="checkbox"/> Fail	Insul. Yes / <input checked="" type="checkbox"/> No
Booster Pump Required: <input type="checkbox"/> Yes / <input checked="" type="checkbox"/> No	Frost Protection: Aquaflo / <input checked="" type="checkbox"/> Recirc / Heat Trace / Bleeder	N/A
PRV Required: <input type="checkbox"/> Yes / <input checked="" type="checkbox"/> No	Greased @ CC: <input checked="" type="checkbox"/> Yes / <input type="checkbox"/> No	N/A
Water Meter Installed: <input type="checkbox"/> Yes / <input checked="" type="checkbox"/> No	Continuity Test: <input checked="" type="checkbox"/> N/A	Pass / <input type="checkbox"/> Fail

CLEARLY INDICATE LOCATION OF CC AND ROUTE OF PIPES ON DRAWING BELOW

1. Show main valves required to isolate this service. 2. All dimensions to be tied to property line 3. All dimensions to be metric 4. Depth @ property line is based on elevation after construction and changes may have occurred.

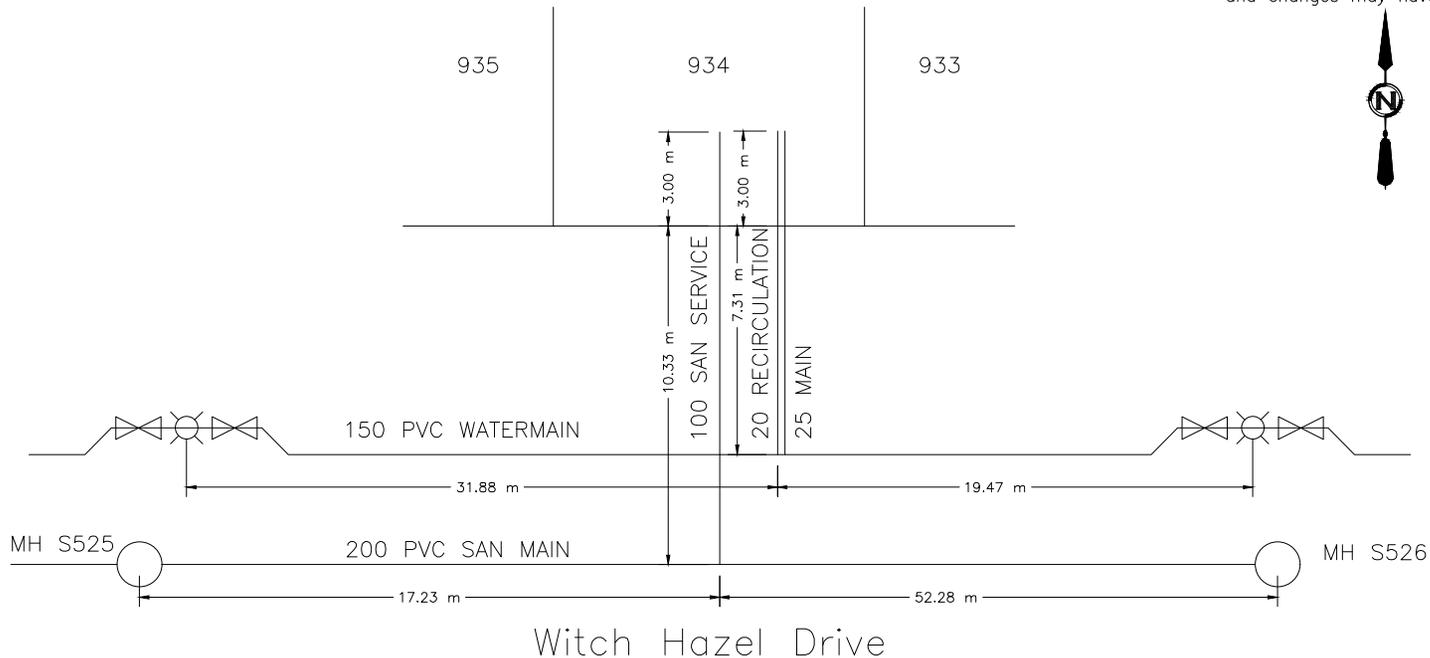



CITY OF WHITEHORSE SERVICE CONNECTION RECORD

FIELD BOOK


No.

ADDRESS 147 Witch Hazel Drive BLOCK LOT 935

DATES		WATER		SEWER		
On at Main	2019	Depth at P/L:	2.45 m		2.37 m	
On at Building		Depth at Main:	2.93 m		3.67 m	
Frost Plug:		Pipe Size:	25 mm / 20 mm		100 mm	
Memo:		Pipe Material:	HDPE	Insul. <input checked="" type="checkbox"/> Yes/ <input type="checkbox"/> No	PVC	Insul. Yes/ <input checked="" type="checkbox"/> No
		Length from Main to P/L:	7.15 m		10.41 m	
		Squirt Test:	<input checked="" type="checkbox"/> Pass/ <input type="checkbox"/> Fail			N/A
Booster Pump Required:	Yes/No	Frost Protection:	Aquaflow/ <input checked="" type="checkbox"/> Recirc/ <input type="checkbox"/> Heat Trace/Bleeder		N/A	
PRV Required:	Yes/No	Greased @ CC:	<input checked="" type="checkbox"/> Yes/ <input type="checkbox"/> No		N/A	
Water Meter Installed:	Yes/No	Continuity Test:	<input checked="" type="checkbox"/> N/A <input type="checkbox"/> Pass/ <input type="checkbox"/> Fail		N/A	

CLEARLY INDICATE LOCATION OF CC AND ROUTE OF PIPES ON DRAWING BELOW

- Show main valves required to isolate this service.
- All dimensions to be tied to property line
- All dimensions to be metric
- Depth @ property line is based on elevation after construction and changes may have occurred.

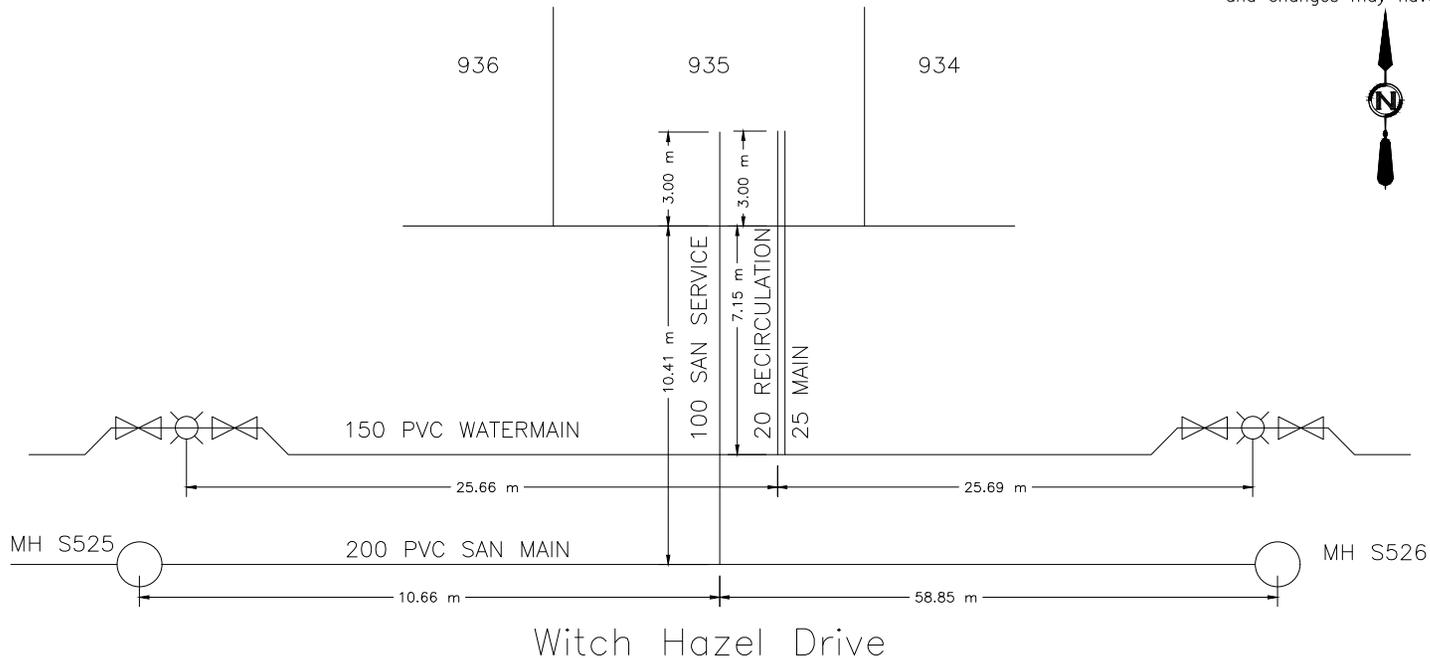



CITY OF WHITEHORSE SERVICE CONNECTION RECORD

FIELD BOOK


No.

ADDRESS 149 Witch Hazel Drive BLOCK LOT 936

	DATES	WATER	SEWER
On at Main	2019	Depth at P/L: 2.43 m	2.47 m
On at Building		Depth at Main: 2.94 m	3.78 m
Frost Plug:		Pipe Size: 25 mm / 20 mm	100 mm
Memo:		Pipe Material: HDPE	PVC
		Insul. <input checked="" type="checkbox"/> Yes / <input type="checkbox"/> No	Insul. <input type="checkbox"/> Yes / <input checked="" type="checkbox"/> No
		Length from Main to P/L: 7.27 m	10.38 m
		Squirt Test: <input checked="" type="checkbox"/> Pass / <input type="checkbox"/> Fail	N/A
Booster Pump Required:	<input type="checkbox"/> Yes / <input type="checkbox"/> No	Frost Protection: Aquaflo / <input checked="" type="checkbox"/> Recirc / Heat Trace / Bleeder	N/A
PRV Required:	<input type="checkbox"/> Yes / <input type="checkbox"/> No	Greased @ CC: <input checked="" type="checkbox"/> Yes / <input type="checkbox"/> No	N/A
Water Meter Installed:	<input type="checkbox"/> Yes / <input type="checkbox"/> No	Continuity Test: <input checked="" type="checkbox"/> N/A	N/A

CLEARLY INDICATE LOCATION OF CC AND ROUTE OF PIPES ON DRAWING BELOW

1. Show main valves required to isolate this service. 2. All dimensions to be tied to property line 3. All dimensions to be metric 4. Depth @ property line is based on elevation after construction and changes may have occurred.

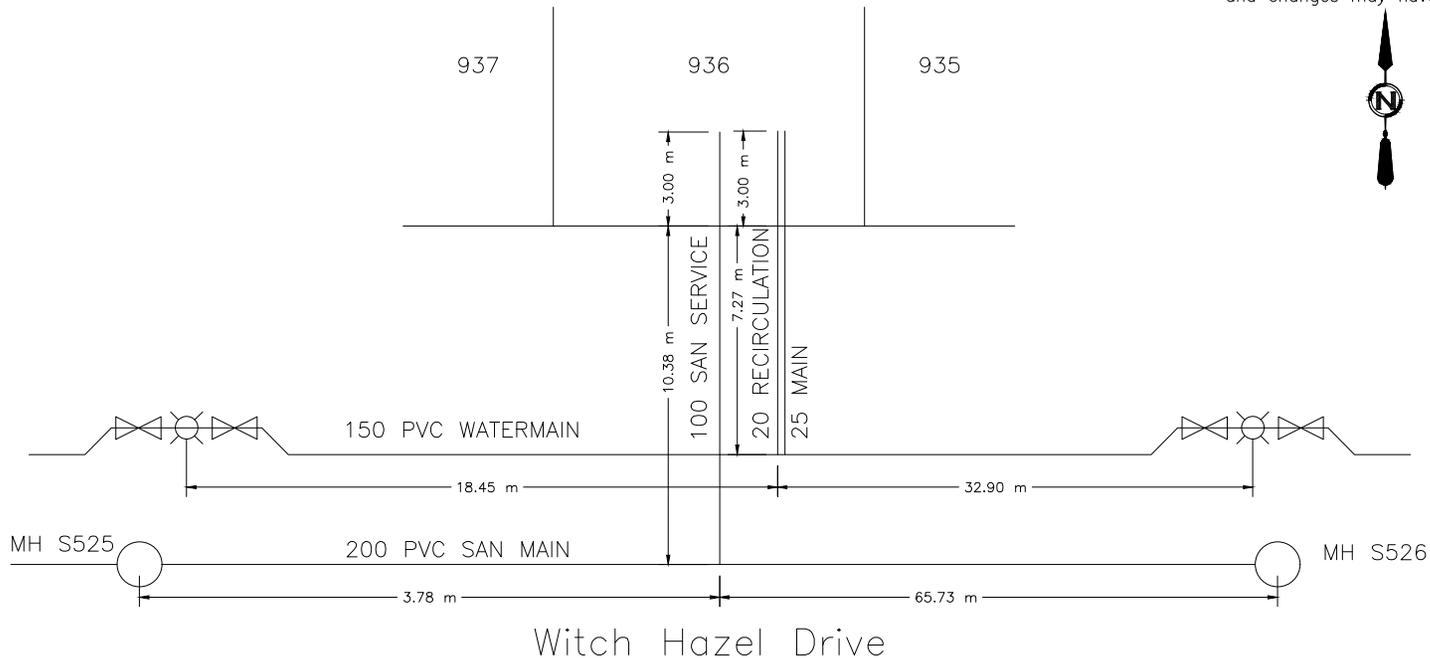



CITY OF WHITEHORSE SERVICE CONNECTION RECORD

FIELD BOOK


No.

ADDRESS 151 Witch Hazel Drive BLOCK LOT 937

DATES	WATER	SEWER
On at Main 2019	Depth at P/L: 2.3 m	2.31 m
On at Building	Depth at Main: 2.86 m	3.85 m
Frost Plug:	Pipe Size: 25 mm / 20 mm	100 mm
Memo:	Pipe Material: HDPE Insul. <u>(Yes)</u> /No	PVC Insul. Yes/ <u>(No)</u>
	Length from Main to P/L: 7.31 m	10.34 m
	Squirt Test: <u>(Pass)</u> /Fail	N/A
Booster Pump Required: Yes/No	Frost Protection: Aquaflo/ <u>(Recirc)</u> /Heat Trace/Bleeder	N/A
PRV Required: Yes/No	Greased @ CC: <u>(Yes)</u> /No	N/A
Water Meter Installed: Yes/No	Continuity Test: <u>(N/A)</u> Pass/Fail	N/A

CLEARLY INDICATE LOCATION OF CC AND ROUTE OF PIPES ON DRAWING BELOW

1. Show main valves required to isolate this service. 2. All dimensions to be tied to property line 3. All dimensions to be metric 4. Depth @ property line is based on elevation after construction and changes may have occurred.

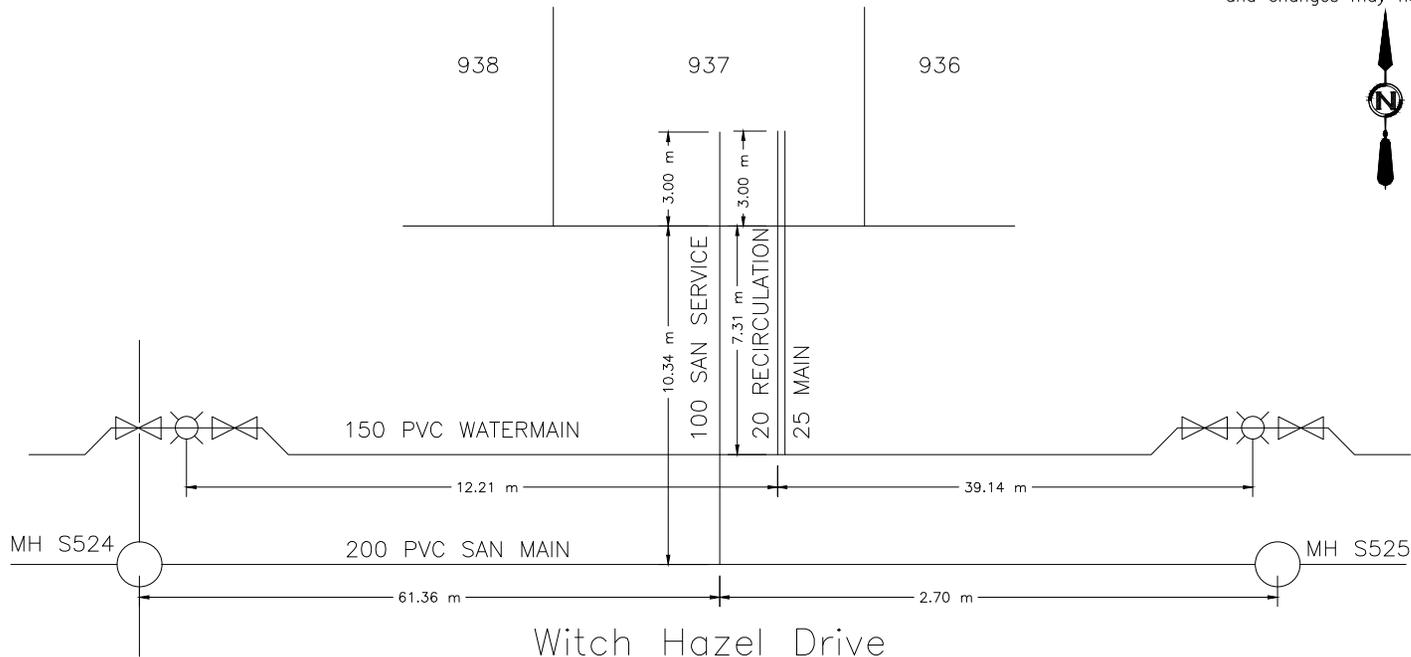



CITY OF WHITEHORSE SERVICE CONNECTION RECORD

FIELD BOOK


No.

ADDRESS 153 Witch Hazel Drive BLOCK LOT 938

DATES		WATER		SEWER	
On at Main	2019	Depth at P/L:	2.4 m	2.28 m	
On at Building		Depth at Main:	2.86 m	3.96 m	
Frost Plug:		Pipe Size:	25 mm / 20 mm	100 mm	
Memo:		Pipe Material:	HDPE	Insul. <u>(Yes/No)</u>	PVC
		Length from Main to P/L:	7.18 m	10.31 m	Insul. Yes/ <u>(No)</u>
		Squirt Test:	<u>(Pass)</u> /Fail		N/A
Booster Pump Required:	Yes/No	Frost Protection:	Aquaflow/ <u>(Recirc)</u> /Heat Trace/Bleeder		N/A
PRV Required:	Yes/No	Greased @ CC:	<u>(Yes)</u> /No		N/A
Water Meter Installed:	Yes/No	Continuity Test:	<u>(N/A)</u>	Pass/Fail	N/A

CLEARLY INDICATE LOCATION OF CC AND ROUTE OF PIPES ON DRAWING BELOW

1. Show main valves required to isolate this service. 2. All dimensions to be tied to property line 3. All dimensions to be metric 4. Depth @ property line is based on elevation after construction and changes may have occurred.

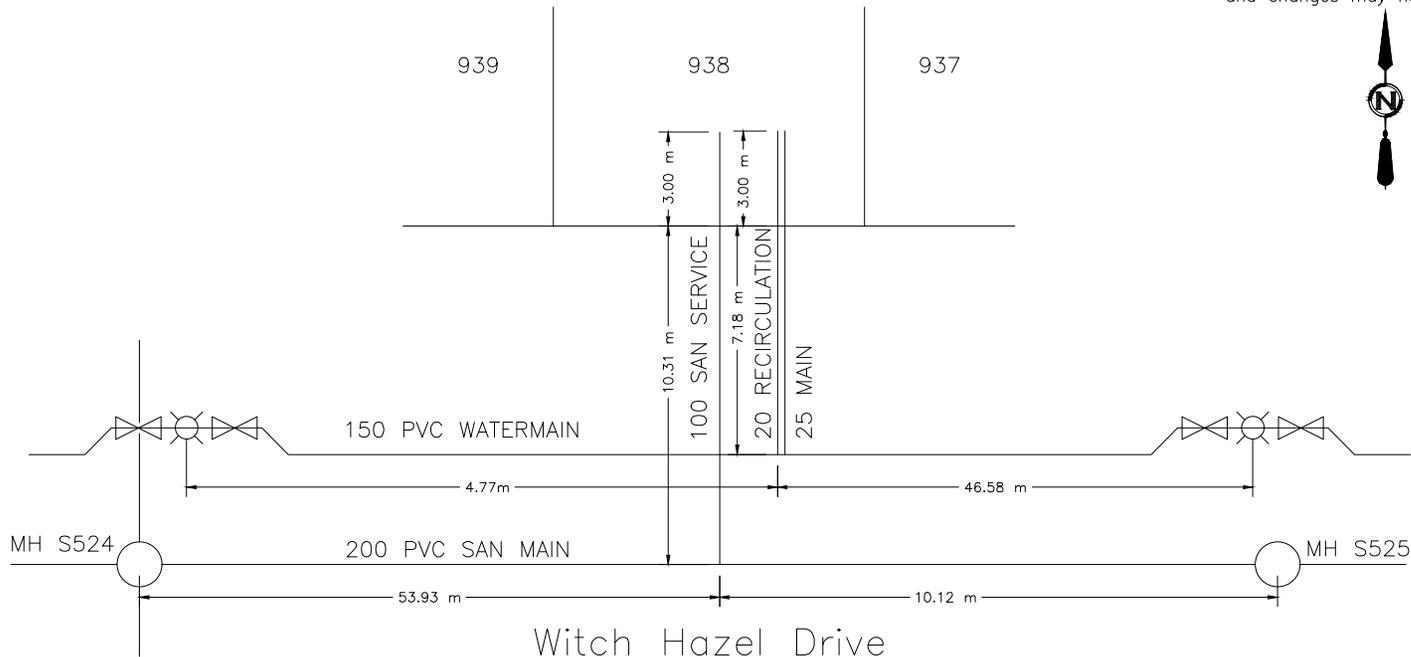



CITY OF WHITEHORSE SERVICE CONNECTION RECORD

FIELD BOOK


No.

ADDRESS 155 Witch Hazel Drive BLOCK LOT 939

DATES		WATER		SEWER	
On at Main	2019	Depth at P/L:	2.47 m	2.5	m
On at Building		Depth at Main:	2.92 m	4	m
Frost Plug:		Pipe Size:	25 mm / 20 mm	100	mm
Memo:		Pipe Material:	HDPE	Insul. <input checked="" type="checkbox"/> Yes/No	PVC
		Length from Main to P/L:	7.36 m	10.3	m
		Squirt Test:	<input checked="" type="checkbox"/> Pass/Fail		N/A
Booster Pump Required:	Yes/No	Frost Protection:	Aquaflow/ <input checked="" type="checkbox"/> Recirc/Heat Trace/Bleeder		N/A
PRV Required:	Yes/No	Greased @ CC:	<input checked="" type="checkbox"/> Yes/No		N/A
Water Meter Installed:	Yes/No	Continuity Test:	<input checked="" type="checkbox"/> N/A	Pass/Fail	N/A

CLEARLY INDICATE LOCATION OF CC AND ROUTE OF PIPES ON DRAWING BELOW

- Show main valves required to isolate this service.
- All dimensions to be tied to property line
- All dimensions to be metric
- Depth @ property line is based on elevation after construction and changes may have occurred.

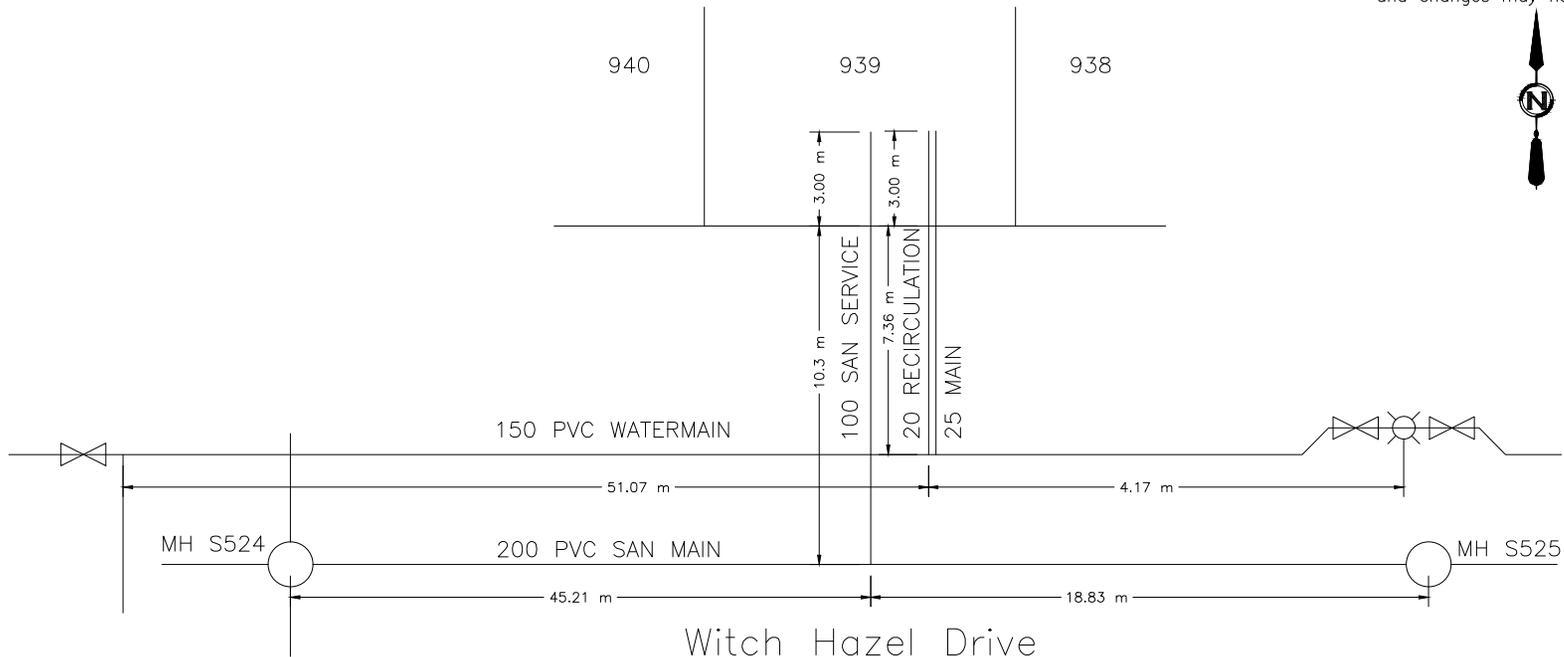



CITY OF WHITEHORSE SERVICE CONNECTION RECORD

FIELD BOOK


No.

ADDRESS 157 Witch Hazel Drive BLOCK LOT 940

DATES	WATER	SEWER
On at Main 2019	Depth at P/L: 2.43 m	2.32 m
On at Building	Depth at Main: 2.92 m	4.1 m
Frost Plug:	Pipe Size: 25 mm / 20 mm	100 mm
Memo:	Pipe Material: HDPE Insul. <u>(Yes)</u> /No	PVC Insul. Yes/ <u>(No)</u>
	Length from Main to P/L: 7.15 m	10.31 m
	Squirt Test: <u>(Pass)</u> /Fail	N/A
Booster Pump Required: Yes/No	Frost Protection: Aquaflo/ <u>(Recirc)</u> /Heat Trace/Bleeder	N/A
PRV Required: Yes/No	Greased @ CC: <u>(Yes)</u> /No	N/A
Water Meter Installed: Yes/No	Continuity Test: <u>(N/A)</u> Pass/Fail	N/A

CLEARLY INDICATE LOCATION OF CC AND ROUTE OF PIPES ON DRAWING BELOW

1. Show main valves required to isolate this service. 2. All dimensions to be tied to property line 3. All dimensions to be metric 4. Depth @ property line is based on elevation after construction and changes may have occurred.

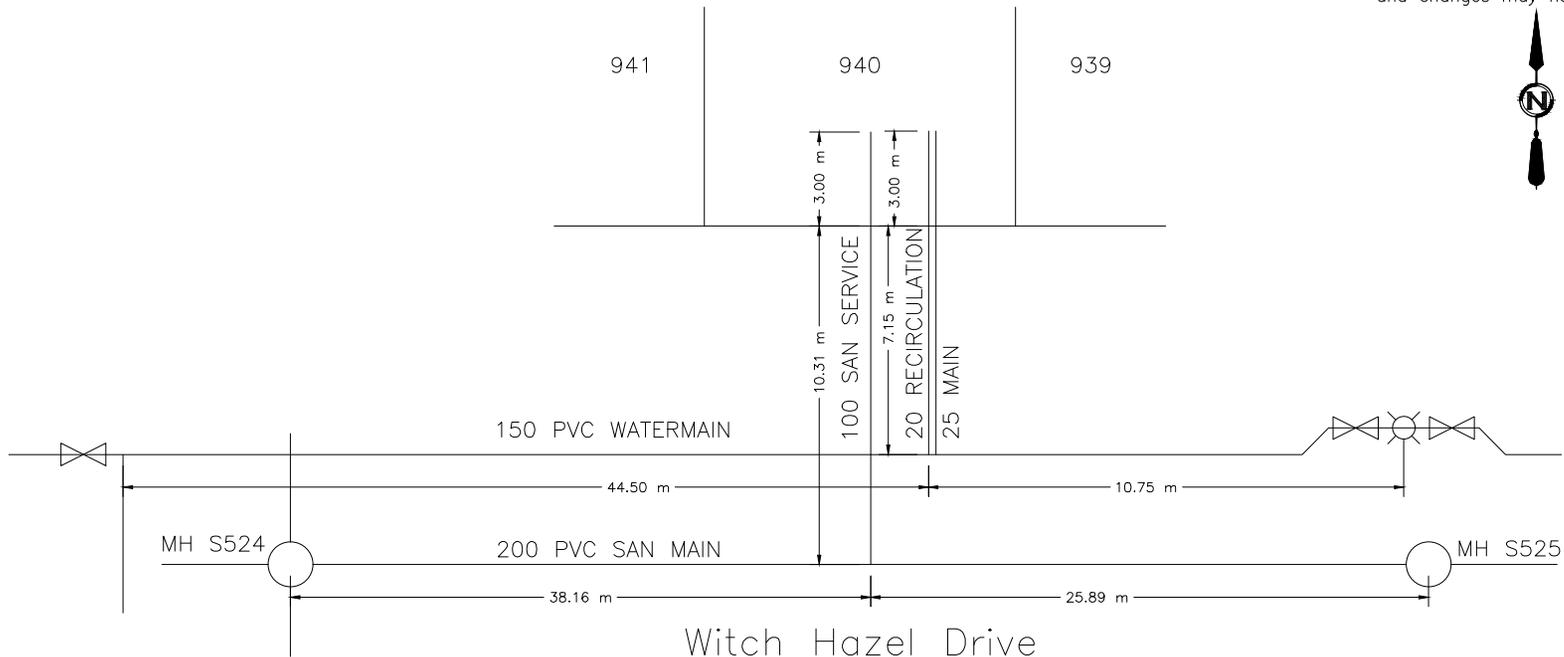



CITY OF WHITEHORSE SERVICE CONNECTION RECORD

FIELD BOOK


No.

ADDRESS 159 Witch Hazel Drive BLOCK LOT 941

DATES		WATER		SEWER	
On at Main	2019	Depth at P/L:	2.2 m	2.17 m	
On at Building		Depth at Main:	2.95 m	4.21 m	
Frost Plug:		Pipe Size:	25 mm / 20 mm	100 mm	
Memo:		Pipe Material:	HDPE	Insul. (Yes/No)	PVC
					Insul. (Yes/No)
		Length from Main to P/L:	7.17 m	10.32 m	
		Squirt Test:	(Pass)/Fail		N/A
Booster Pump Required:	Yes/No	Frost Protection:	Aquaflow/(Recirc)/Heat Trace/Bleeder		N/A
PRV Required:	Yes/No	Greased @ CC:	(Yes)/No		N/A
Water Meter Installed:	Yes/No	Continuity Test:	(N/A)	Pass/Fail	N/A

CLEARLY INDICATE LOCATION OF CC AND ROUTE OF PIPES ON DRAWING BELOW

1. Show main valves required to isolate this service.
2. All dimensions to be tied to property line
3. All dimensions to be metric
4. Depth @ property line is based on elevation after construction and changes may have occurred.

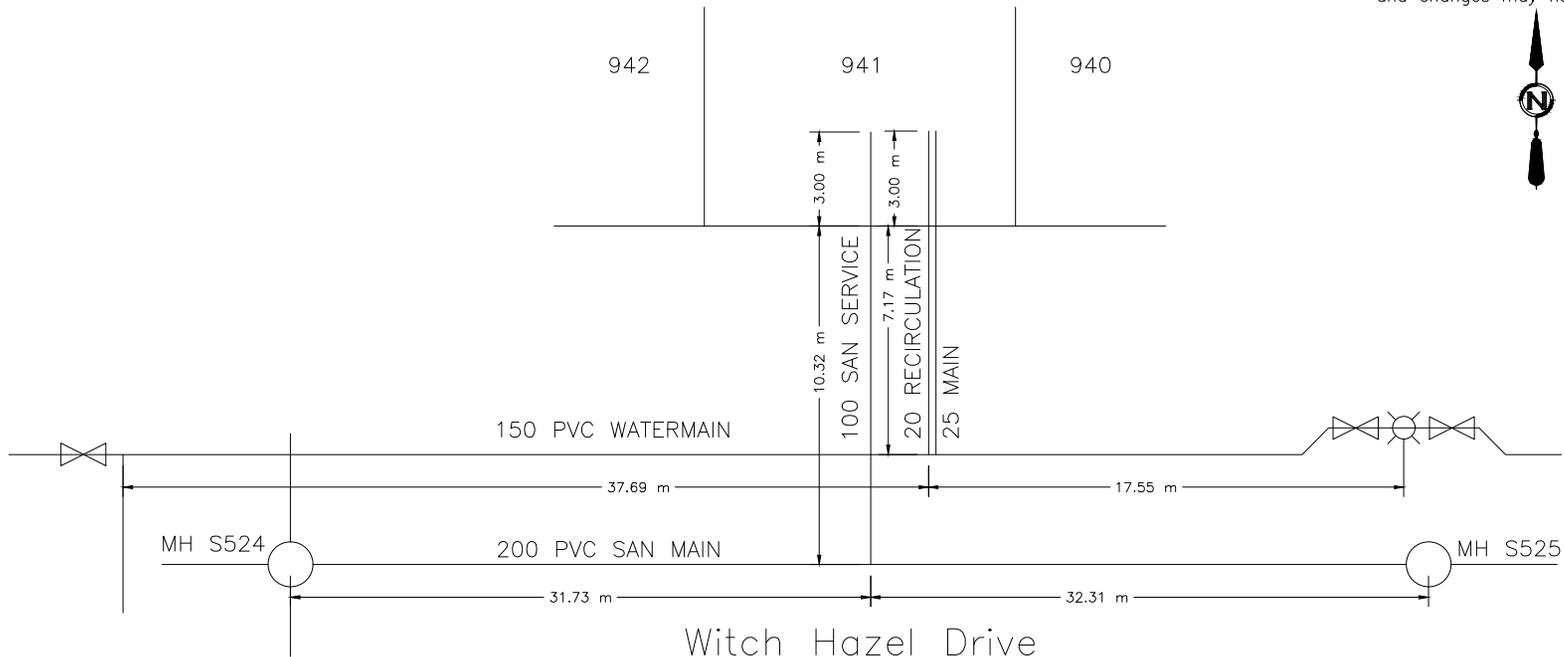



CITY OF WHITEHORSE SERVICE CONNECTION RECORD

FIELD BOOK

No.

ADDRESS 161 Witch Hazel Drive BLOCK LOT 942

DATES	WATER	SEWER
On at Main 2019	Depth at P/L: 2.53 m	2.45 m
On at Building	Depth at Main: 2.87 m	4.33 m
Frost Plug:	Pipe Size: 25 mm / 20 mm	100 mm
Memo:	Pipe Material: HDPE Insul. <input checked="" type="checkbox"/> Yes/No	PVC Insul. Yes/ <input checked="" type="checkbox"/> No
	Length from Main to P/L: 7.12 m	10.26 m
	Squirt Test: <input checked="" type="checkbox"/> Pass/Fail	N/A
Booster Pump Required: Yes/No	Frost Protection: Aquaflo/ <input checked="" type="checkbox"/> Recirc/Heat Trace/Bleeder	N/A
PRV Required: Yes/No	Greased @ CC: <input checked="" type="checkbox"/> Yes/No	N/A
Water Meter Installed: Yes/No	Continuity Test: <input checked="" type="checkbox"/> N/A Pass/Fail	N/A

CLEARLY INDICATE LOCATION OF CC AND ROUTE OF PIPES ON DRAWING BELOW

1. Show main valves required to isolate this service. 2. All dimensions to be tied to property line 3. All dimensions to be metric 4. Depth @ property line is based on elevation after construction and changes may have occurred.

