



CITY OF WHITEHORSE

SERVICE CONNECTION RECORD

FIELD BOOK

No.

ADDRESS 25 RELIANCE STREET BLOCK LOT 950

DATES


WATER

SEWER

On at Main 20200919	Depth at P/L: 2.67 m	2.65 m
On at Building	Depth at Main: 3.04 m	3.77 m
Frost Plug:	Pipe Size: 20 mm / 25 mm	100 mm
Memo:	Pipe Material: HDPE Insul. <u>Yes</u> /No	PVC Insul. Yes/ <u>No</u>
	Length from Main to P/L: 6.00 m	8.98 m
	Squirt Test: <u>Pass</u> /Fail	N/A
Booster Pump Required: Yes/No	Frost Protection: Aquaflo/ <u>Recirc</u> /Heat Trace/Bleeder	N/A
PRV Required: Yes/No	Greased @ CC: <u>Yes</u> /No	N/A
Water Meter Installed: Yes/No	Continuity Test: <u>N/A</u> Pass/Fail	N/A

CLEARLY INDICATE LOCATION OF CC AND ROUTE OF PIPES ON DRAWING BELOW

1. Show main valves required to isolate this service.
2. All dimensions to be tied to property line
3. All dimensions to be metric
4. Depth @ property line is based on elevation after construction and changes may have occurred.

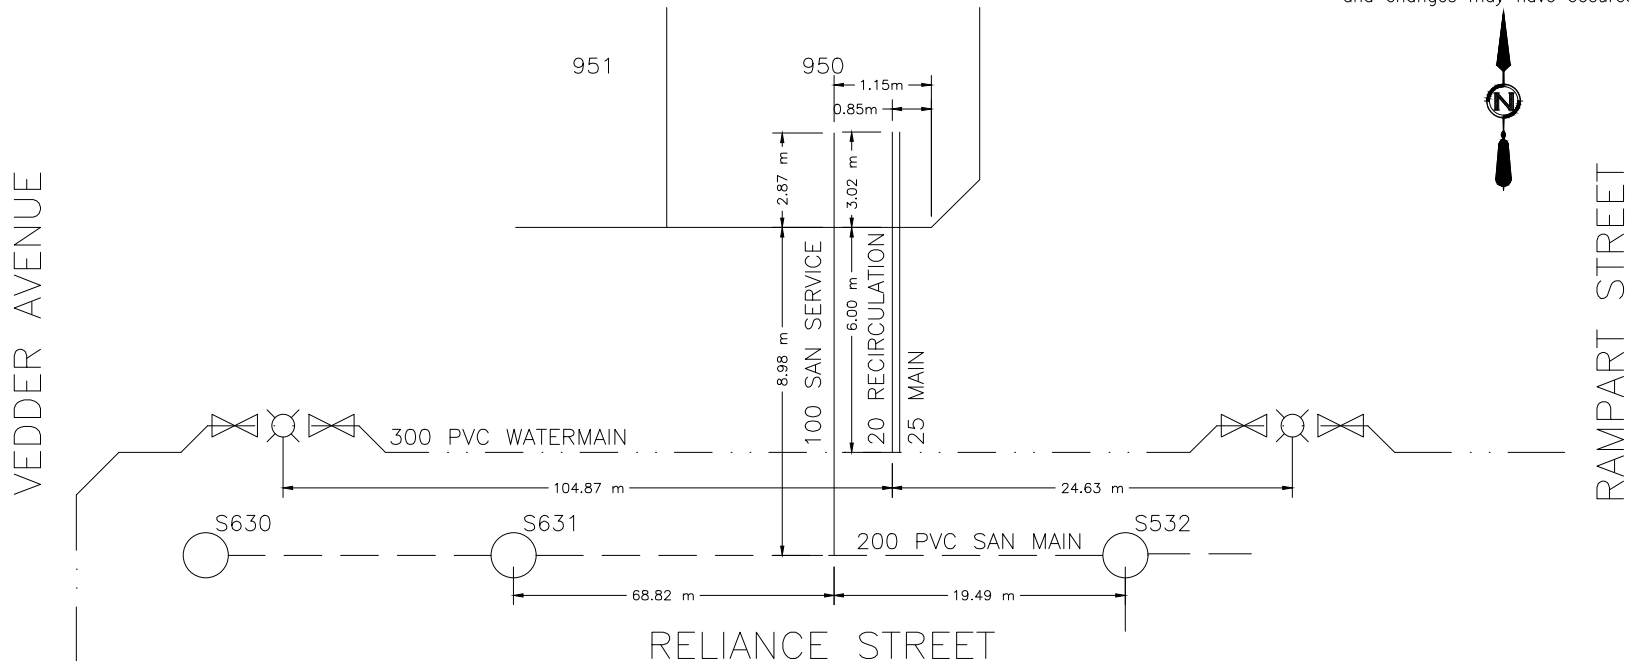



CITY OF WHITEHORSE

SERVICE CONNECTION RECORD

FIELD BOOK

No.

ADDRESS 27 RELIANCE STREET BLOCK LOT 951

DATES


WATER

SEWER

On at Main 20200919	Depth at P/L: 2.62 m	2.64 m
On at Building	Depth at Main: 2.98 m	3.62 m
Frost Plug:	Pipe Size: 20 mm / 25 mm	100 mm
Memo:	Pipe Material: HDPE Insul. <u>Yes</u> /No	PVC Insul. Yes/ <u>No</u>
	Length from Main to P/L: 6.00 m	9.01 m
	Squirt Test: <u>Pass</u> /Fail	N/A
Booster Pump Required: Yes/No	Frost Protection: Aquaflow/ <u>Recirc</u> /Heat Trace/Bleeder	N/A
PRV Required: Yes/No	Greased @ CC: <u>Yes</u> /No	N/A
Water Meter Installed: Yes/No	Continuity Test: <u>N/A</u> Pass/Fail	N/A

CLEARLY INDICATE LOCATION OF CC AND ROUTE OF PIPES ON DRAWING BELOW

1. Show main valves required to isolate this service. 2. All dimensions to be tied to property line 3. All dimensions to be metric 4. Depth @ property line is based on elevation after construction and changes may have occurred.

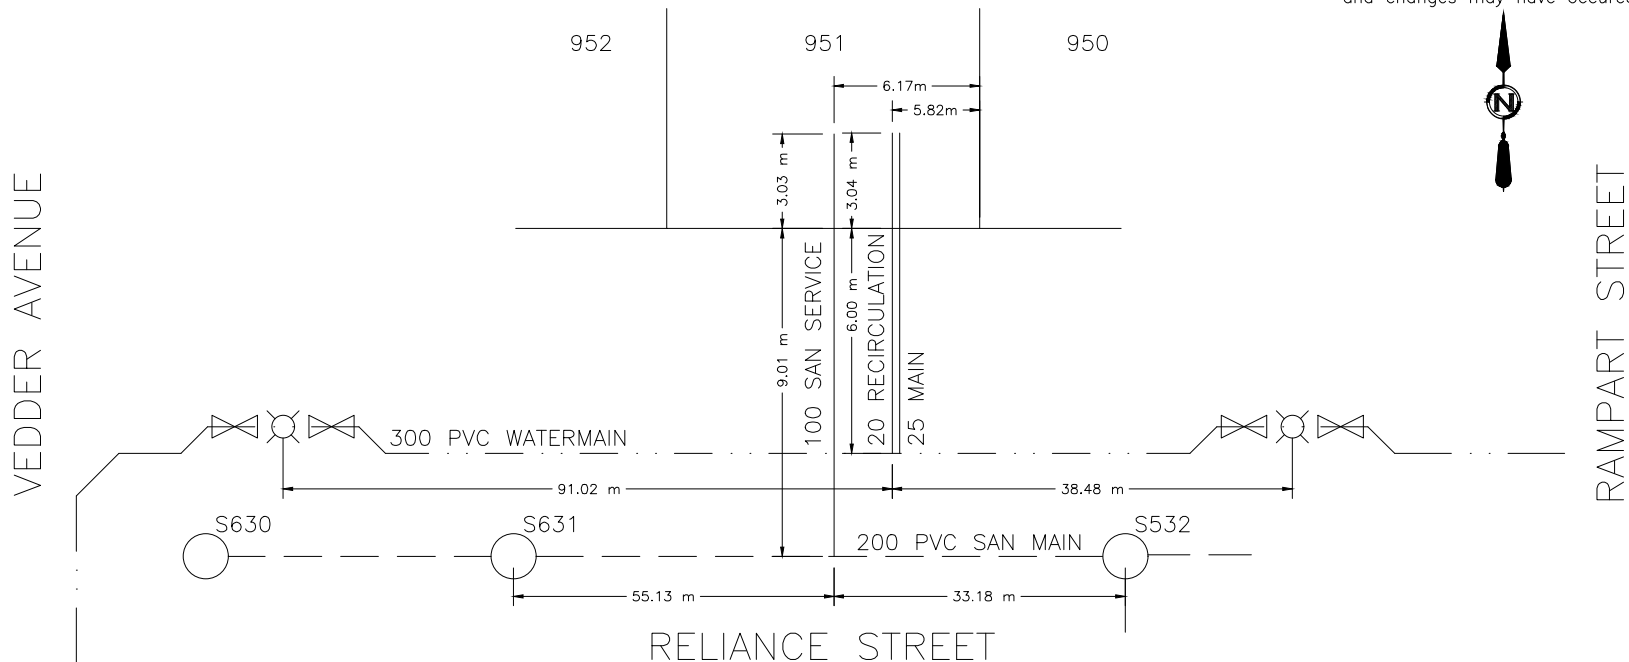



CITY OF WHITEHORSE

SERVICE CONNECTION RECORD

FIELD BOOK

No.

ADDRESS 29 RELIANCE STREET BLOCK LOT 952

DATES


WATER

SEWER

On at Main 20200919	Depth at P/L: 2.65 m	2.73 m
On at Building	Depth at Main: 2.96 m	3.49 m
Frost Plug:	Pipe Size: 20 mm / 25 mm	100 mm
Memo:	Pipe Material: HDPE Insul. <u>Yes</u> /No	PVC Insul. Yes/ <u>No</u>
	Length from Main to P/L: 6.00 m	8.98 m
	Squirt Test: <u>Pass</u> /Fail	N/A
Booster Pump Required: Yes/No	Frost Protection: Aquaflo/ <u>Recirc</u> /Heat Trace/Bleeder	N/A
PRV Required: Yes/No	Greased @ CC: <u>Yes</u> /No	N/A
Water Meter Installed: Yes/No	Continuity Test: <u>N/A</u> Pass/Fail	N/A

CLEARLY INDICATE LOCATION OF CC AND ROUTE OF PIPES ON DRAWING BELOW

1. Show main valves required to isolate this service.
2. All dimensions to be tied to property line
3. All dimensions to be metric
4. Depth @ property line is based on elevation after construction and changes may have occurred.

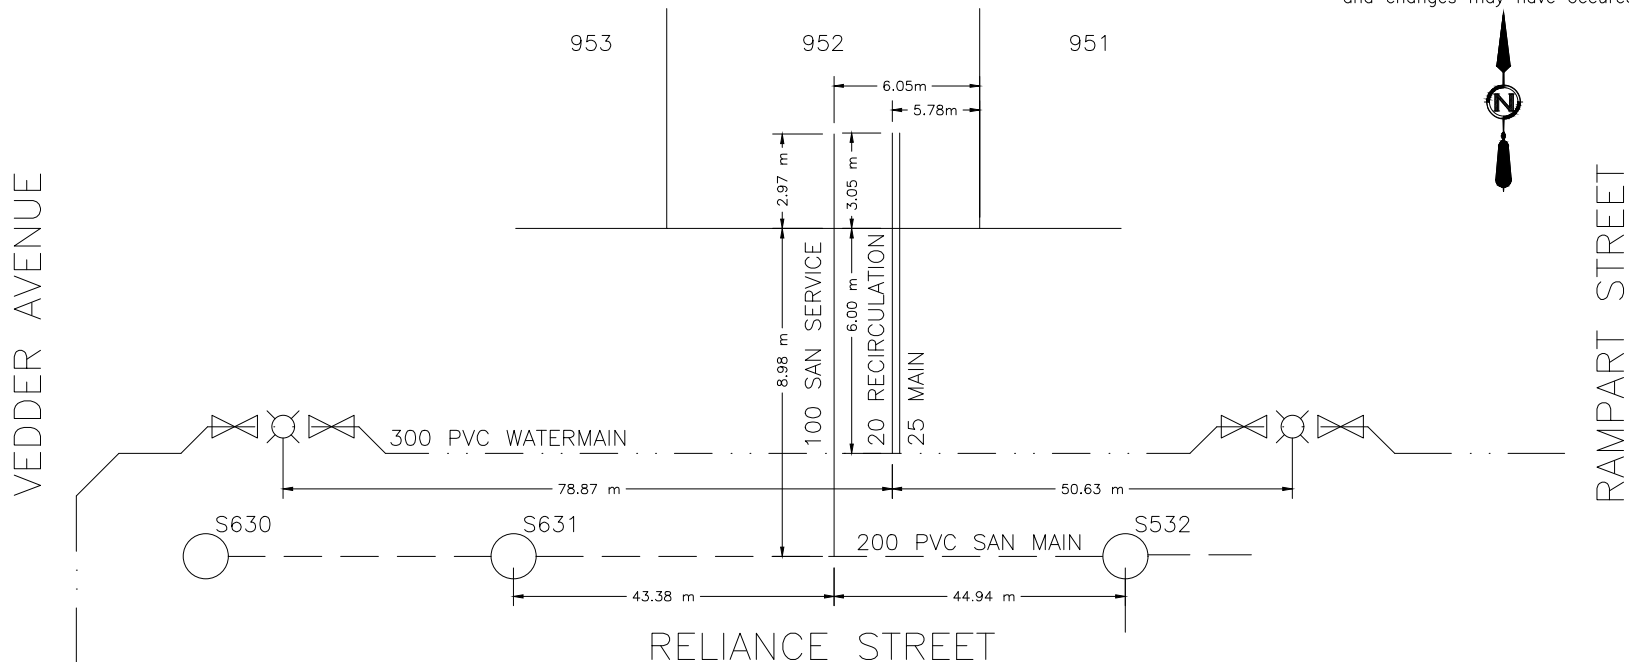



CITY OF WHITEHORSE

SERVICE CONNECTION RECORD

FIELD BOOK

No.

ADDRESS 31 RELIANCE STREET BLOCK LOT 953

DATES


WATER

SEWER

On at Main 20200919	Depth at P/L: 2.67 m	2.69 m
On at Building	Depth at Main: 3.04 m	3.34 m
Frost Plug:	Pipe Size: 20 mm / 25 mm	100 mm
Memo:	Pipe Material: HDPE Insul. <u>Yes</u> /No	PVC Insul. Yes/ <u>No</u>
	Length from Main to P/L: 6.00 m	9.00 m
	Squirt Test: <u>Pass</u> /Fail	N/A
Booster Pump Required: Yes/No	Frost Protection: Aquaflo/ <u>Recirc</u> /Heat Trace/Bleeder	N/A
PRV Required: Yes/No	Greased @ CC: <u>Yes</u> /No	N/A
Water Meter Installed: Yes/No	Continuity Test: <u>N/A</u> Pass/Fail	N/A

CLEARLY INDICATE LOCATION OF CC AND ROUTE OF PIPES ON DRAWING BELOW

1. Show main valves required to isolate this service. 2. All dimensions to be tied to property line 3. All dimensions to be metric 4. Depth @ property line is based on elevation after construction and changes may have occurred.

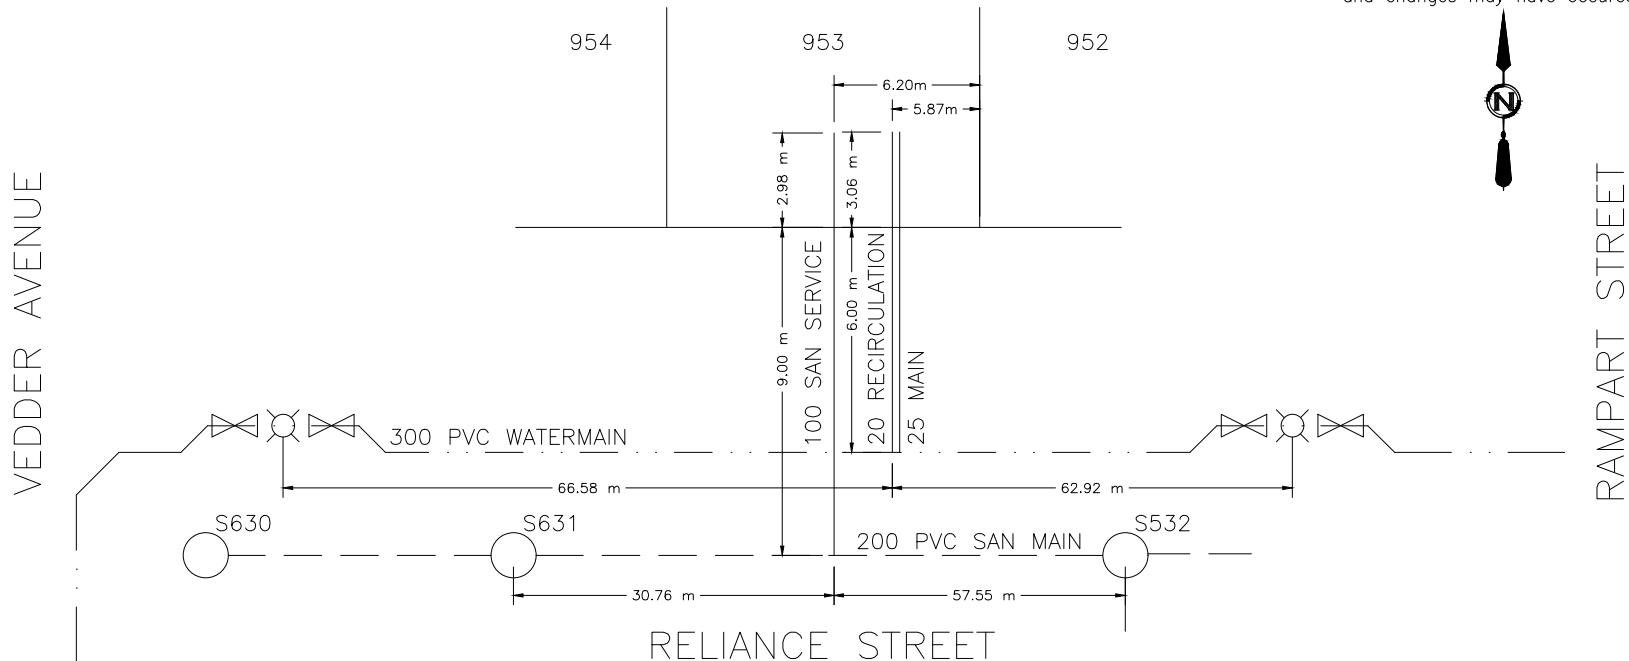



CITY OF WHITEHORSE

SERVICE CONNECTION RECORD

FIELD BOOK

No.

ADDRESS 33 RELIANCE STREET BLOCK LOT 954

DATES


WATER

SEWER

On at Main 20200919	Depth at P/L: 2.68 m	2.72 m
On at Building	Depth at Main: 3.02 m	3.20 m
Frost Plug:	Pipe Size: 20 mm / 25 mm	100 mm
Memo:	Pipe Material: HDPE	Insul. Yes/No
	Length from Main to P/L: 6.00 m	9.01 m
	Squirt Test:	Pass/Fail
Booster Pump Required:	Yes/No	Frost Protection: Aquaflo/Recirc/Heat Trace/Bleeder
PRV Required:	Yes/No	Greased @ CC:
Water Meter Installed:	Yes/No	Continuity Test:

CLEARLY INDICATE LOCATION OF CC AND ROUTE OF PIPES ON DRAWING BELOW

1. Show main valves required to isolate this service. 2. All dimensions to be tied to property line 3. All dimensions to be metric 4. Depth @ property line is based on elevation after construction and changes may have occurred.

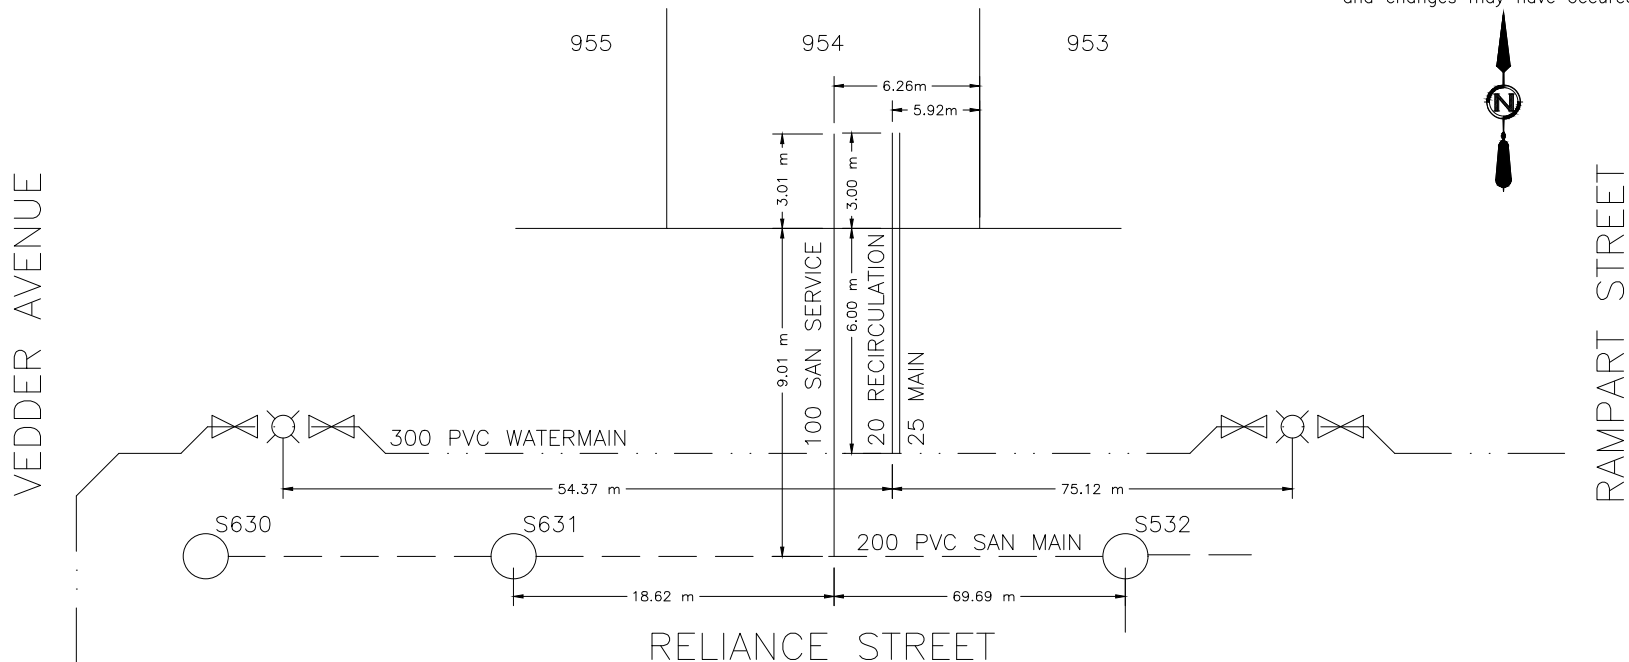



CITY OF WHITEHORSE

SERVICE CONNECTION RECORD

FIELD BOOK

No.

ADDRESS 35 RELIANCE STREET BLOCK LOT 955

DATES


WATER

SEWER

On at Main 20200919	Depth at P/L: 2.68 m	2.72 m
On at Building	Depth at Main: 3.07 m	3.06 m
Frost Plug:	Pipe Size: 20 mm / 25 mm	100 mm
Memo:	Pipe Material: HDPE Insul. <u>Yes</u> /No	PVC Insul. Yes/ <u>No</u>
	Length from Main to P/L: 6.00 m	9.01 m
	Squirt Test: <u>Pass</u> /Fail	N/A
Booster Pump Required: Yes/No	Frost Protection: Aquaflo/ <u>Recirc</u> /Heat Trace/Bleeder	N/A
PRV Required: Yes/No	Greased @ CC: <u>Yes</u> /No	N/A
Water Meter Installed: Yes/No	Continuity Test: <u>N/A</u> Pass/Fail	N/A

CLEARLY INDICATE LOCATION OF CC AND ROUTE OF PIPES ON DRAWING BELOW

1. Show main valves required to isolate this service. 2. All dimensions to be tied to property line 3. All dimensions to be metric 4. Depth @ property line is based on elevation after construction and changes may have occurred.

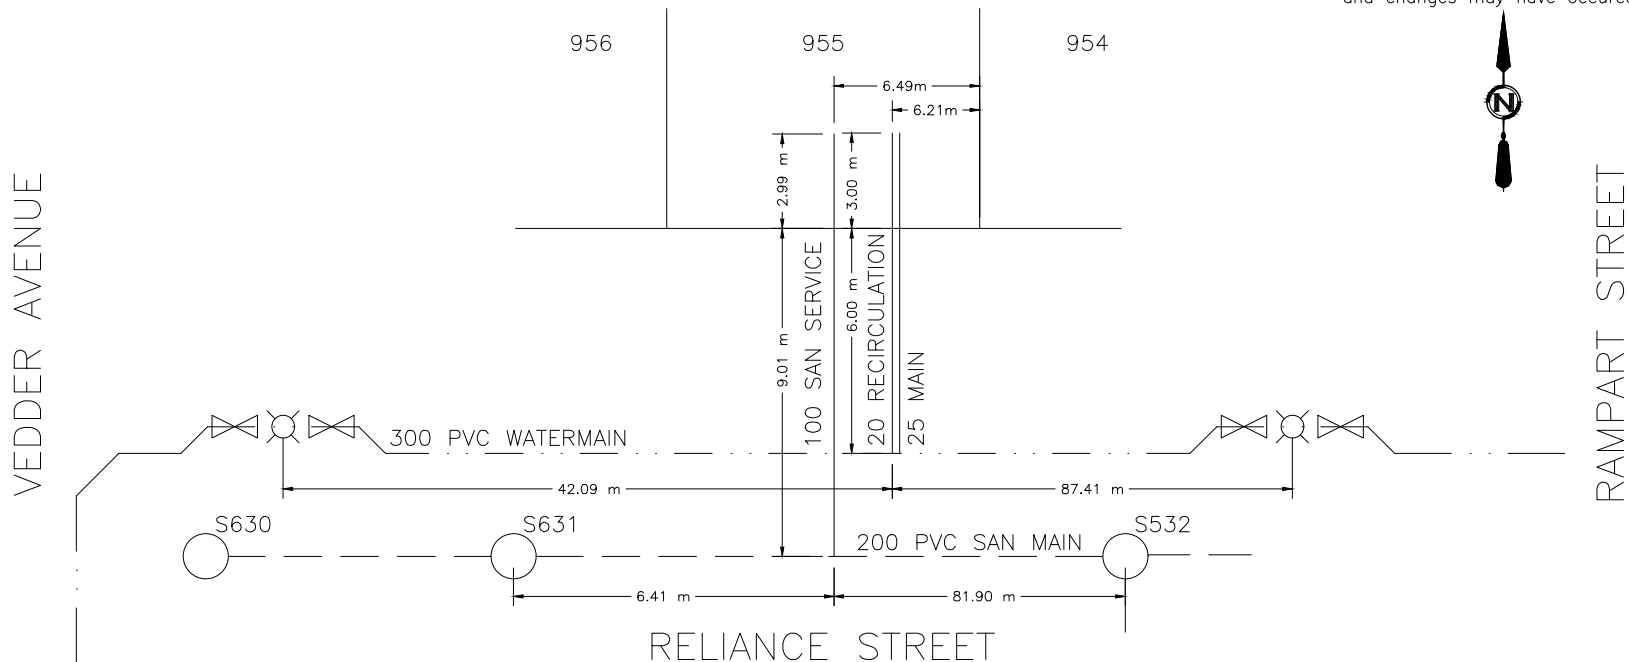



CITY OF WHITEHORSE

SERVICE CONNECTION RECORD

FIELD BOOK

No.

ADDRESS 37 RELIANCE STREET BLOCK LOT 956

DATES


WATER

SEWER

On at Main 20200919	Depth at P/L: 2.54 m	2.56 m
On at Building	Depth at Main: 3.10 m	2.85 m
Frost Plug:	Pipe Size: 20 mm / 25 mm	100 mm
Memo:	Pipe Material: HDPE Insul. <u>Yes</u> /No	PVC Insul. Yes/ <u>No</u>
	Length from Main to P/L: 6.03 m	9.00 m
	Squirt Test: <u>Pass</u> /Fail	N/A
Booster Pump Required: Yes/No	Frost Protection: Aquaflow/ <u>Recirc</u> /Heat Trace/Bleeder	N/A
PRV Required: Yes/No	Greased @ CC: <u>Yes</u> /No	N/A
Water Meter Installed: Yes/No	Continuity Test: <u>N/A</u> Pass/Fail	N/A

CLEARLY INDICATE LOCATION OF CC AND ROUTE OF PIPES ON DRAWING BELOW

1. Show main valves required to isolate this service. 2. All dimensions to be tied to property line 3. All dimensions to be metric 4. Depth @ property line is based on elevation after construction and changes may have occurred.

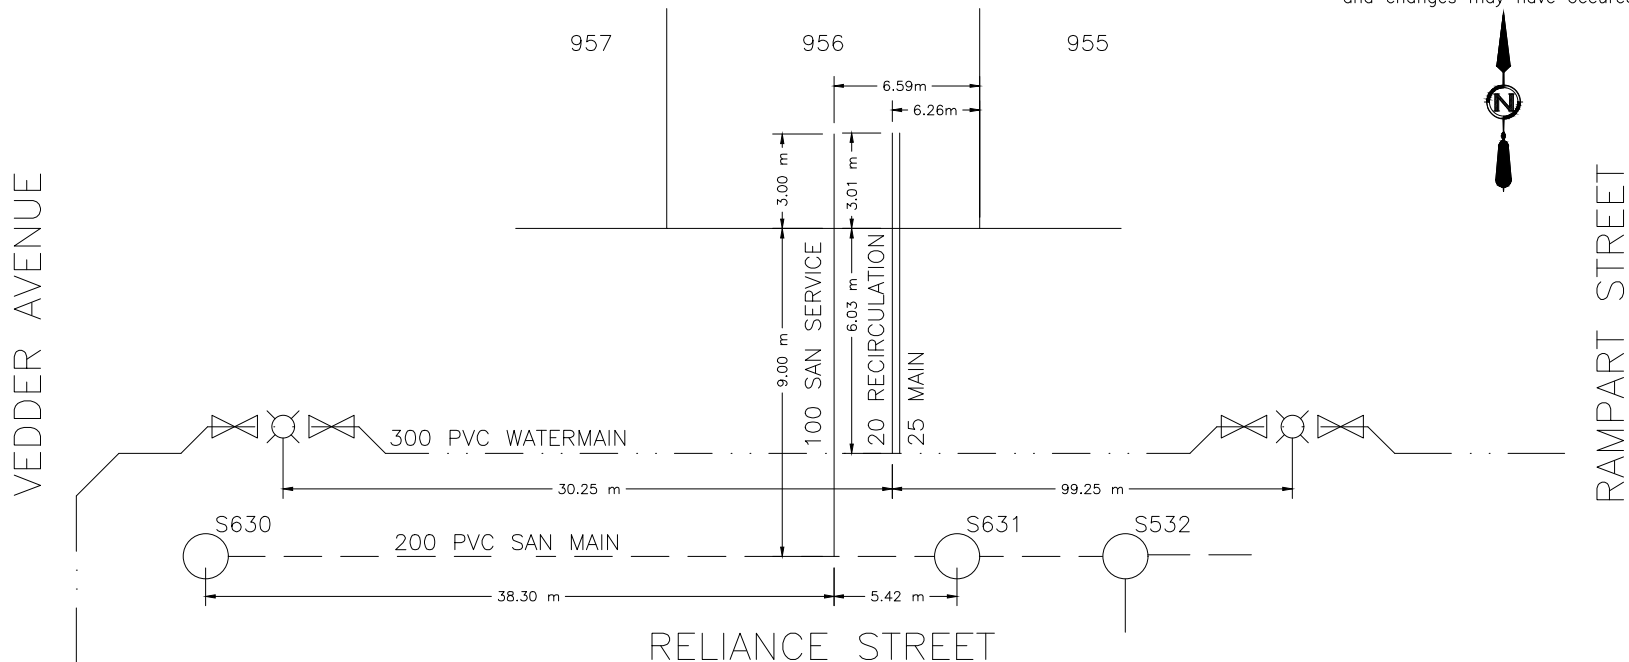



CITY OF WHITEHORSE

SERVICE CONNECTION RECORD

FIELD BOOK

No.

ADDRESS 39 RELIANCE STREET BLOCK LOT 957

DATES


WATER

SEWER

On at Main 20200923	Depth at P/L: 2.41 m	2.29 m
On at Building	Depth at Main: 3.15 m	2.73 m
Frost Plug:	Pipe Size: 20 mm / 25 mm	100 mm
Memo:	Pipe Material: HDPE Insul. <u>Yes</u> /No	PVC Insul. <u>Yes</u> /No
	Length from Main to P/L: 6.00 m	9.00 m
	Squirt Test: <u>Pass</u> /Fail	N/A
Booster Pump Required: Yes/No	Frost Protection: Aquaflow/ <u>Recirc</u> /Heat Trace/Bleeder	N/A
PRV Required: Yes/No	Greased @ CC: <u>Yes</u> /No	N/A
Water Meter Installed: Yes/No	Continuity Test: <u>N/A</u> Pass/Fail	N/A

CLEARLY INDICATE LOCATION OF CC AND ROUTE OF PIPES ON DRAWING BELOW

1. Show main valves required to isolate this service.
2. All dimensions to be tied to property line
3. All dimensions to be metric
4. Depth @ property line is based on elevation after construction and changes may have occurred.

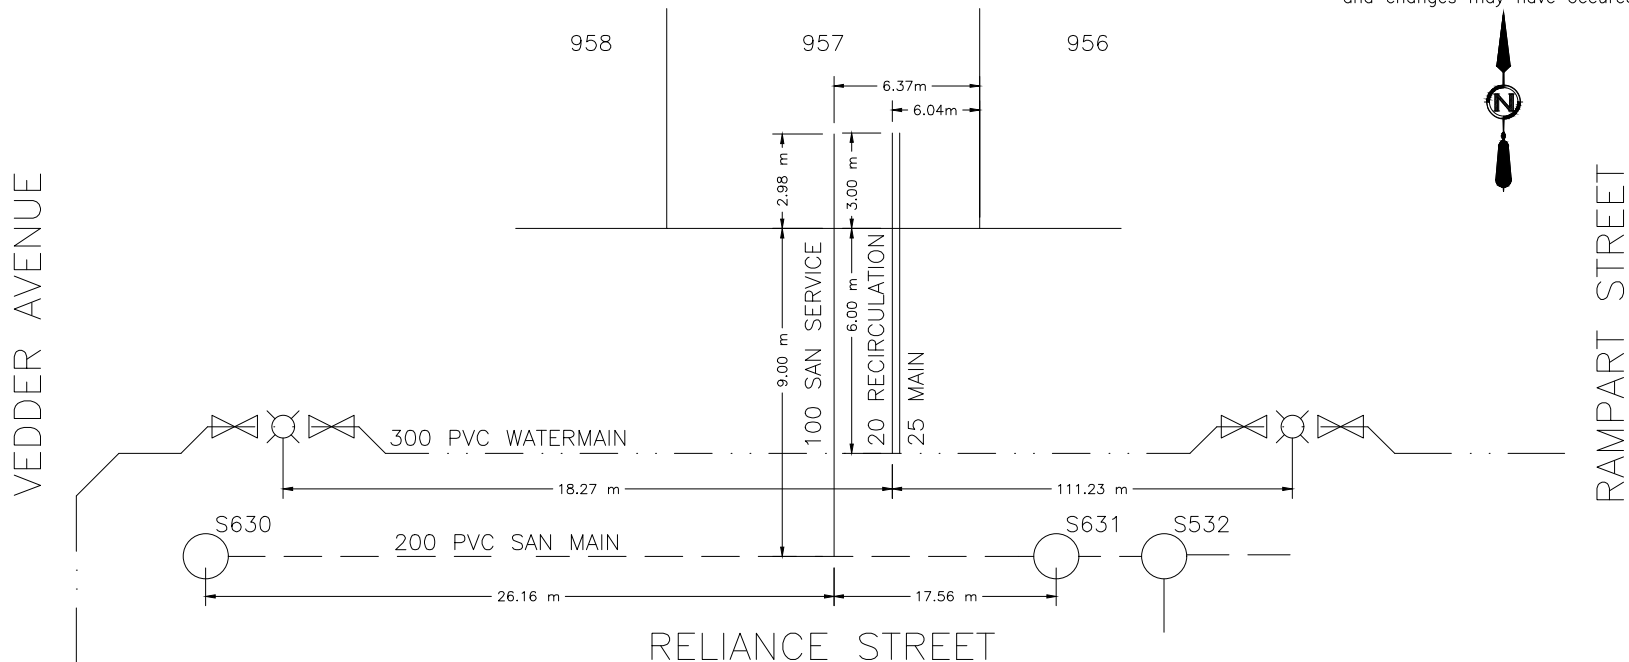



CITY OF WHITEHORSE

SERVICE CONNECTION RECORD

FIELD BOOK

No.

ADDRESS 41 RELIANCE STREET BLOCK LOT 958

DATES

WATER


SEWER

On at Main 20200923	Depth at P/L: 2.24 m	2.11 m
On at Building	Depth at Main: 3.14 m	2.52 m
Frost Plug:	Pipe Size: 20 mm / 25 mm	100 mm
Memo:	Pipe Material: HDPE Insul. <u>Yes</u> /No	PVC Insul. <u>Yes</u> /No
	Length from Main to P/L: 6.00 m	9.01 m
	Squirt Test: <u>Pass</u> /Fail	N/A
Booster Pump Required: Yes/No	Frost Protection: Aquaflo/ <u>Recirc</u> /Heat Trace/Bleeder	N/A
PRV Required: Yes/No	Greased @ CC: <u>Yes</u> /No	N/A
Water Meter Installed: Yes/No	Continuity Test: <u>N/A</u> Pass/Fail	N/A

CLEARLY INDICATE LOCATION OF CC AND ROUTE OF PIPES ON DRAWING BELOW

1. Show main valves required to isolate this service. 2. All dimensions to be tied to property line 3. All dimensions to be metric 4. Depth @ property line is based on elevation after construction and changes may have occurred.

VEDDER AVENUE

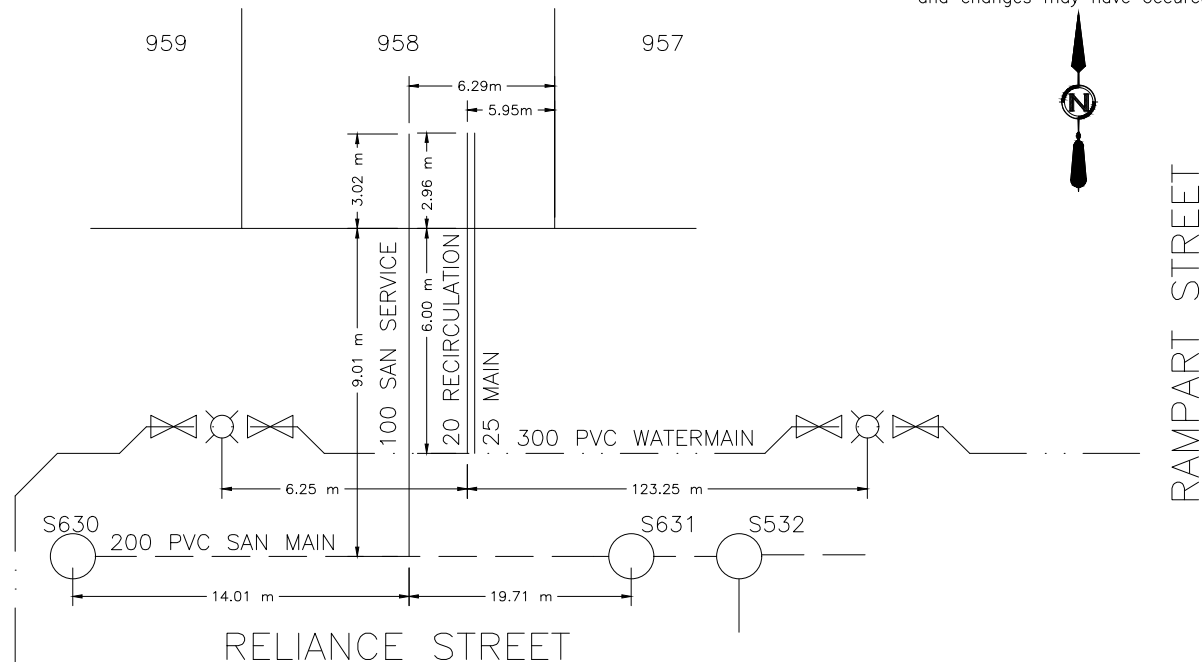



CITY OF WHITEHORSE

SERVICE CONNECTION RECORD

FIELD BOOK

No.

ADDRESS 43 RELIANCE STREET BLOCK LOT 959

DATES

WATER


SEWER

On at Main 20200923	Depth at P/L: 2.03 m	1.96 m
On at Building	Depth at Main: 3.04 m	2.39 m
Frost Plug:	Pipe Size: 20 mm / 25 mm	100 mm
Memo:	Pipe Material: HDPE Insul. (Yes/No)	PVC Insul. (Yes/No)
	Length from Main to P/L: 6.00 m	9.00 m
	Squirt Test: (Pass/Fail)	N/A
Booster Pump Required: Yes/No	Frost Protection: Aquaflo/Recirc/Heat Trace/Bleeder	N/A
PRV Required: Yes/No	Greased @ CC: (Yes/No)	N/A
Water Meter Installed: Yes/No	Continuity Test: (N/A) Pass/Fail	N/A

CLEARLY INDICATE LOCATION OF CC AND ROUTE OF PIPES ON DRAWING BELOW

1. Show main valves required to isolate this service. 2. All dimensions to be tied to property line 3. All dimensions to be metric 4. Depth @ property line is based on elevation after construction and changes may have occurred.

VEDDER AVENUE

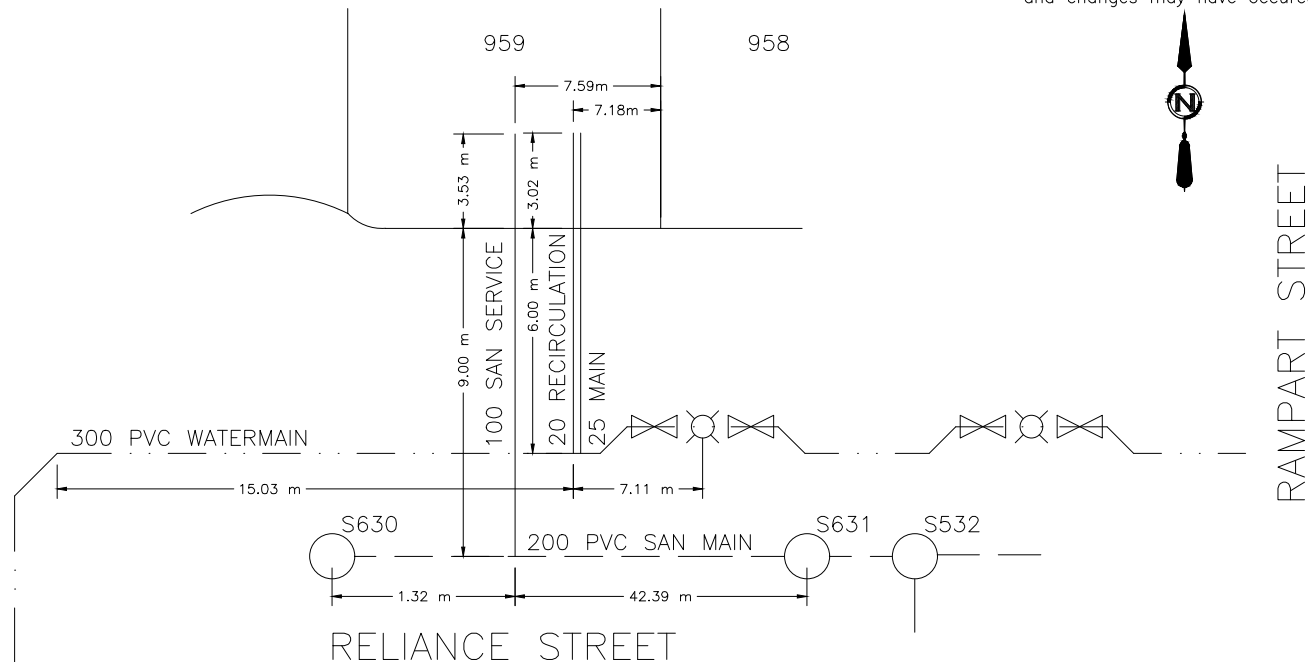

RAMPART STREET

RELIANCE STREET



CITY OF WHITEHORSE

SERVICE CONNECTION RECORD

FIELD BOOK

No.

ADDRESS 98 VEDDER AVENUE BLOCK LOT 960

DATES


WATER

SEWER

On at Main 20200917	Depth at P/L: 2.33 m	2.27 m
On at Building	Depth at Main: 2.61 m	2.71 m
Frost Plug:	Pipe Size: 20 mm / 25 mm	100 mm
Memo:	Pipe Material: HDPE	Insul. <u>Yes</u> /No
	Length from Main to P/L: 6.04 m	PVC
	Squirt Test: <u>Pass</u> /Fail	Insul. <u>Yes</u> /No
Booster Pump Required: Yes/No	Frost Protection: Aquaflow/ <u>Recirc</u> /Heat Trace/Bleeder	N/A
PRV Required: Yes/No	Greased @ CC: <u>Yes</u> /No	N/A
Water Meter Installed: Yes/No	Continuity Test: <u>N/A</u> Pass/Fail	N/A

CLEARLY INDICATE LOCATION OF CC AND ROUTE OF PIPES ON DRAWING BELOW

1. Show main valves required to isolate this service. 2. All dimensions to be tied to property line 3. All dimensions to be metric 4. Depth @ property line is based on elevation after construction and changes may have occurred.

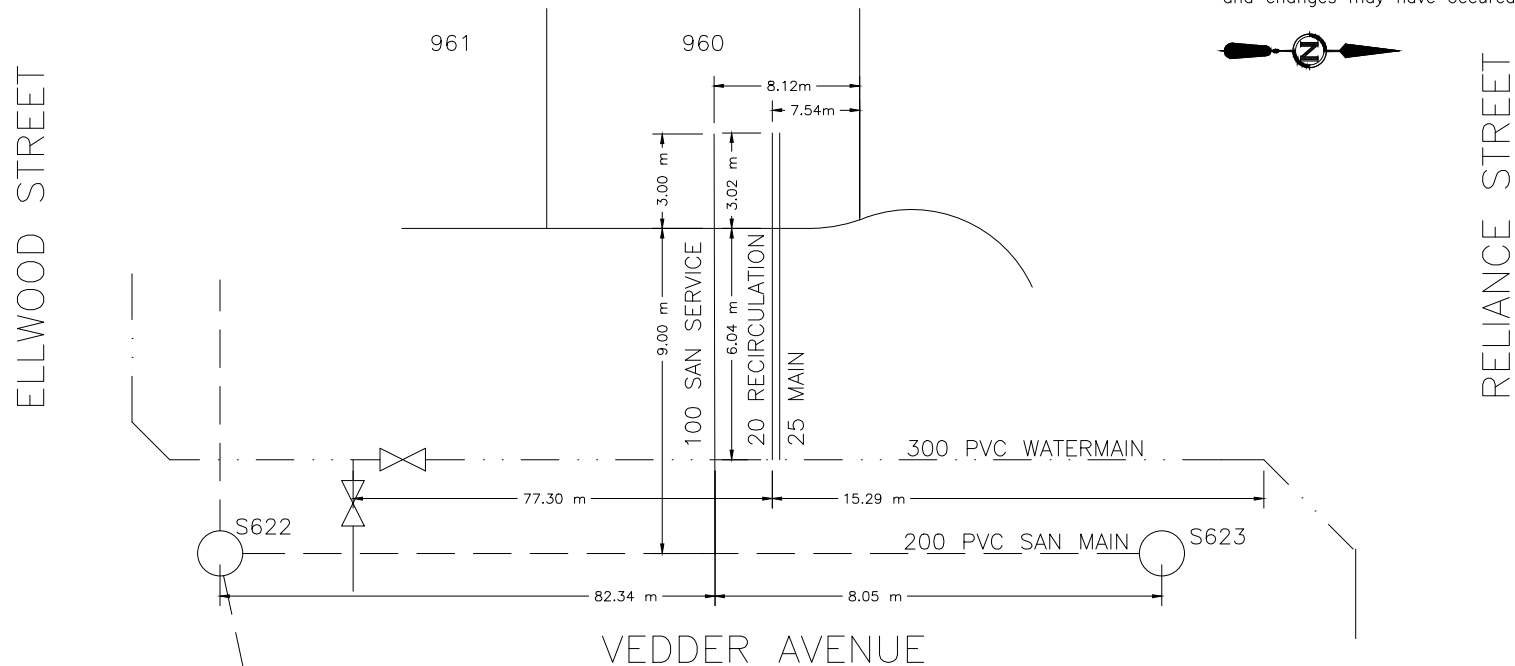



CITY OF WHITEHORSE

SERVICE CONNECTION RECORD

FIELD BOOK

No.

ADDRESS 96 VEDDER AVENUE BLOCK LOT 961

DATES


WATER

SEWER

On at Main 20200917	Depth at P/L: 2.33 m	2.28 m
On at Building	Depth at Main: 2.60 m	2.86 m
Frost Plug:	Pipe Size: 20 mm / 25 mm	100 mm
Memo:	Pipe Material: HDPE Insul. <u>Yes</u> /No	PVC Insul. <u>Yes</u> /No
	Length from Main to P/L: 6.03 m	9.00 m
	Squirt Test: <u>Pass</u> /Fail	N/A
Booster Pump Required: Yes/No	Frost Protection: Aquaflow/ <u>Recirc</u> /Heat Trace/Bleeder	N/A
PRV Required: Yes/No	Greased @ CC: <u>Yes</u> /No	N/A
Water Meter Installed: Yes/No	Continuity Test: <u>N/A</u> Pass/Fail	N/A

CLEARLY INDICATE LOCATION OF CC AND ROUTE OF PIPES ON DRAWING BELOW

1. Show main valves required to isolate this service. 2. All dimensions to be tied to property line 3. All dimensions to be metric 4. Depth @ property line is based on elevation after construction and changes may have occurred.

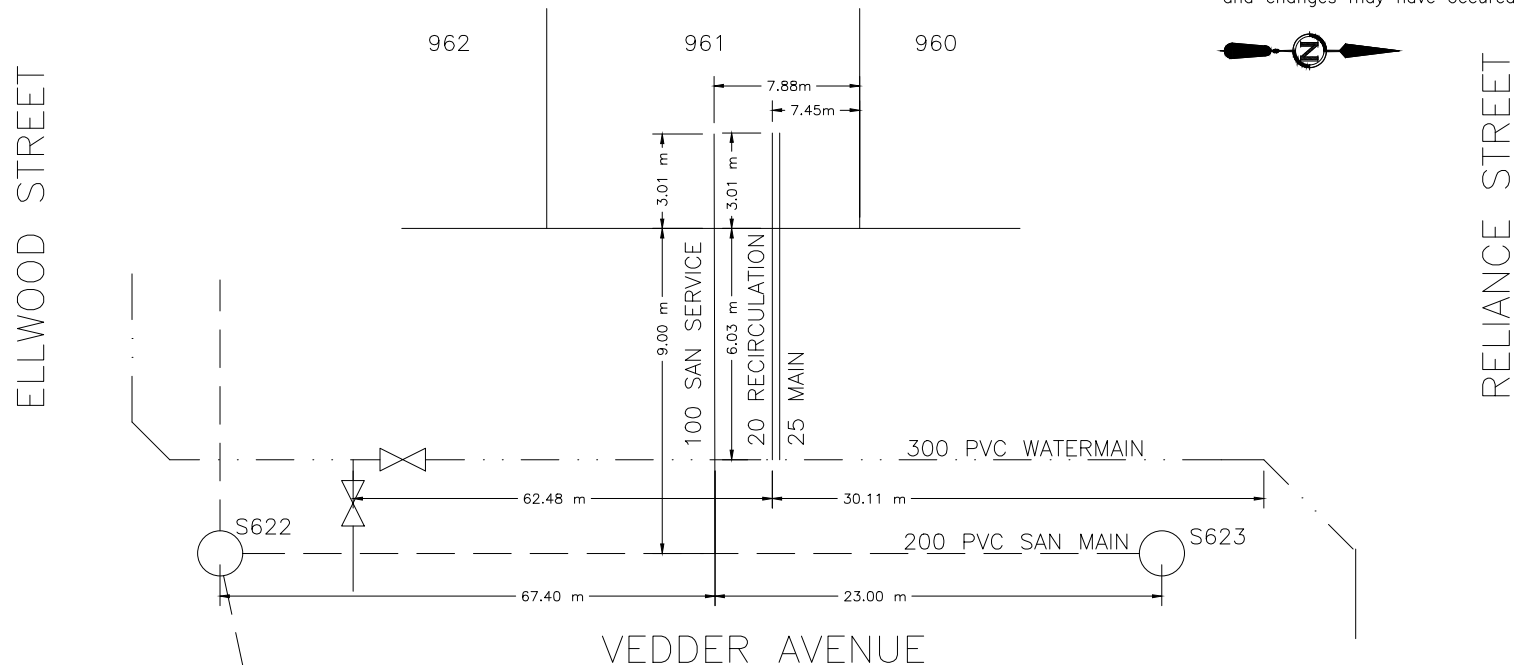



CITY OF WHITEHORSE

SERVICE CONNECTION RECORD

FIELD BOOK

No.

ADDRESS 94 VEDDER AVENUE BLOCK LOT 962

DATES


WATER

SEWER

On at Main 20200917	Depth at P/L: 2.34 m	2.09 m
On at Building	Depth at Main: 2.56 m	3.04 m
Frost Plug:	Pipe Size: 20 mm / 25 mm	100 mm
Memo:	Pipe Material: HDPE Insul. <u>(Yes)</u> /No	PVC Insul. <u>(Yes)</u> /No
	Length from Main to P/L: 6.03 m	9.02 m
	Squirt Test: <u>(Pass)</u> /Fail	N/A
Booster Pump Required: Yes/No	Frost Protection: Aquaflo/ <u>(Recirc)</u> /Heat Trace/Bleeder	N/A
PRV Required: Yes/No	Greased @ CC: <u>(Yes)</u> /No	N/A
Water Meter Installed: Yes/No	Continuity Test: <u>(N/A)</u> Pass/Fail	N/A

CLEARLY INDICATE LOCATION OF CC AND ROUTE OF PIPES ON DRAWING BELOW

1. Show main valves required to isolate this service.
2. All dimensions to be tied to property line
3. All dimensions to be metric
4. Depth @ property line is based on elevation after construction and changes may have occurred.

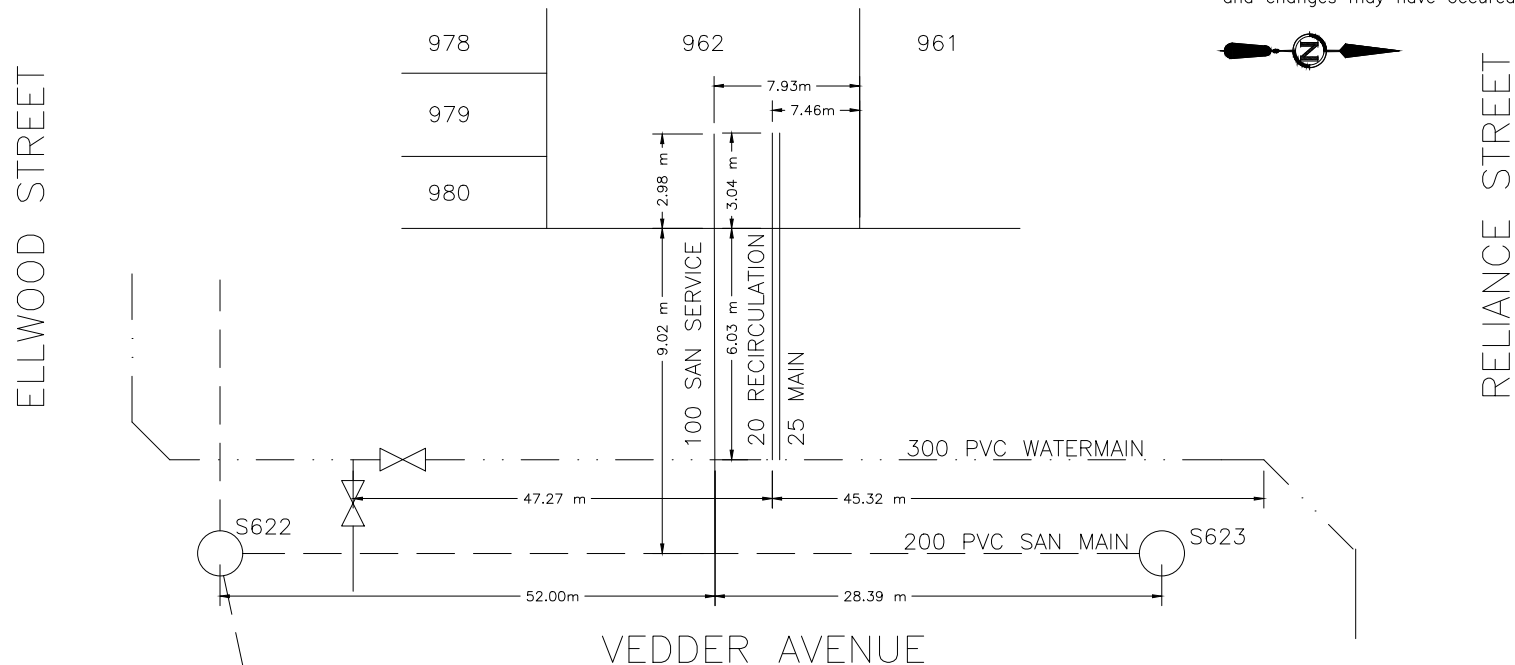



CITY OF WHITEHORSE

SERVICE CONNECTION RECORD

FIELD BOOK

No.

ADDRESS 40 RELIANCE STREET BLOCK LOT 963

DATES


WATER

SEWER

On at Main 20200924	Depth at P/L: 2.08 m	2.00 m
On at Building	Depth at Main: 3.08 m	2.42 m
Frost Plug:	Pipe Size: 20 mm / 25 mm	100 mm
Memo:	Pipe Material: HDPE Insul. <u>Yes</u> /No	PVC Insul. Yes/ <u>No</u>
	Length from Main to P/L: 12.00 m	9.00 m
	Squirt Test: <u>Pass</u> /Fail	N/A
Booster Pump Required: Yes/No	Frost Protection: Aquaflow/ <u>Recirc</u> /Heat Trace/Bleeder	N/A
PRV Required: Yes/No	Greased @ CC: <u>Yes</u> /No	N/A
Water Meter Installed: Yes/No	Continuity Test: <u>N/A</u> Pass/Fail	N/A

CLEARLY INDICATE LOCATION OF CC AND ROUTE OF PIPES ON DRAWING BELOW

1. Show main valves required to isolate this service.
2. All dimensions to be tied to property line
3. All dimensions to be metric
4. Depth @ property line is based on elevation after construction and changes may have occurred.

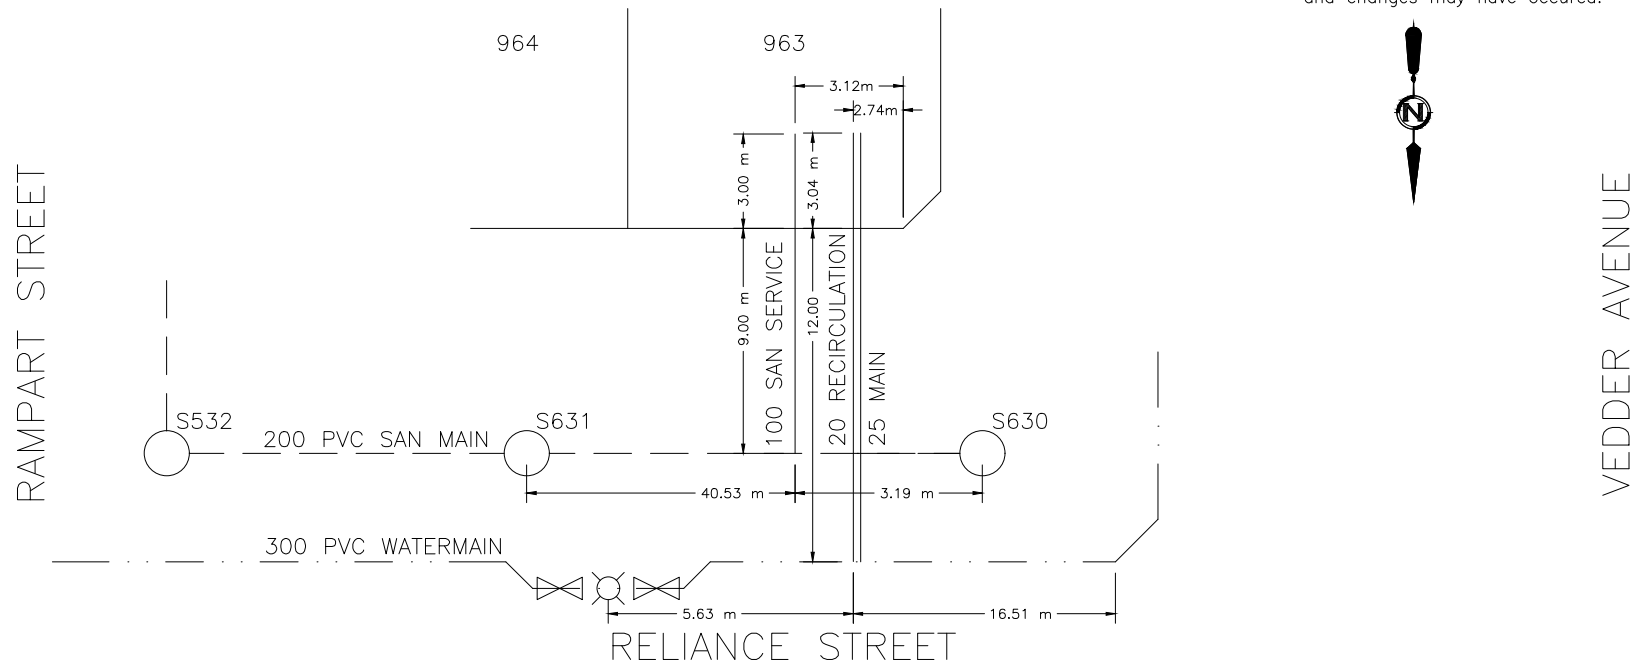



CITY OF WHITEHORSE

SERVICE CONNECTION RECORD

FIELD BOOK

No.

ADDRESS 38 RELIANCE STREET BLOCK LOT 964

DATES


WATER

SEWER

On at Main 20200919	Depth at P/L: 2.25 m	2.16 m
On at Building	Depth at Main: 3.16 m	2.63 m
Frost Plug:	Pipe Size: 20 mm / 25 mm	100 mm
Memo:	Pipe Material: HDPE	Insul. (Yes/No) PVC
	Length from Main to P/L: 12.01 m	9.00 m
	Squirt Test: (Pass/Fail)	N/A
Booster Pump Required: Yes/No	Frost Protection: Aquaflo/Recirc/Heat Trace/Bleeder	N/A
PRV Required: Yes/No	Greased @ CC: (Yes/No)	N/A
Water Meter Installed: Yes/No	Continuity Test: (N/A) Pass/Fail	N/A

CLEARLY INDICATE LOCATION OF CC AND ROUTE OF PIPES ON DRAWING BELOW

1. Show main valves required to isolate this service. 2. All dimensions to be tied to property line 3. All dimensions to be metric 4. Depth @ property line is based on elevation after construction and changes may have occurred.

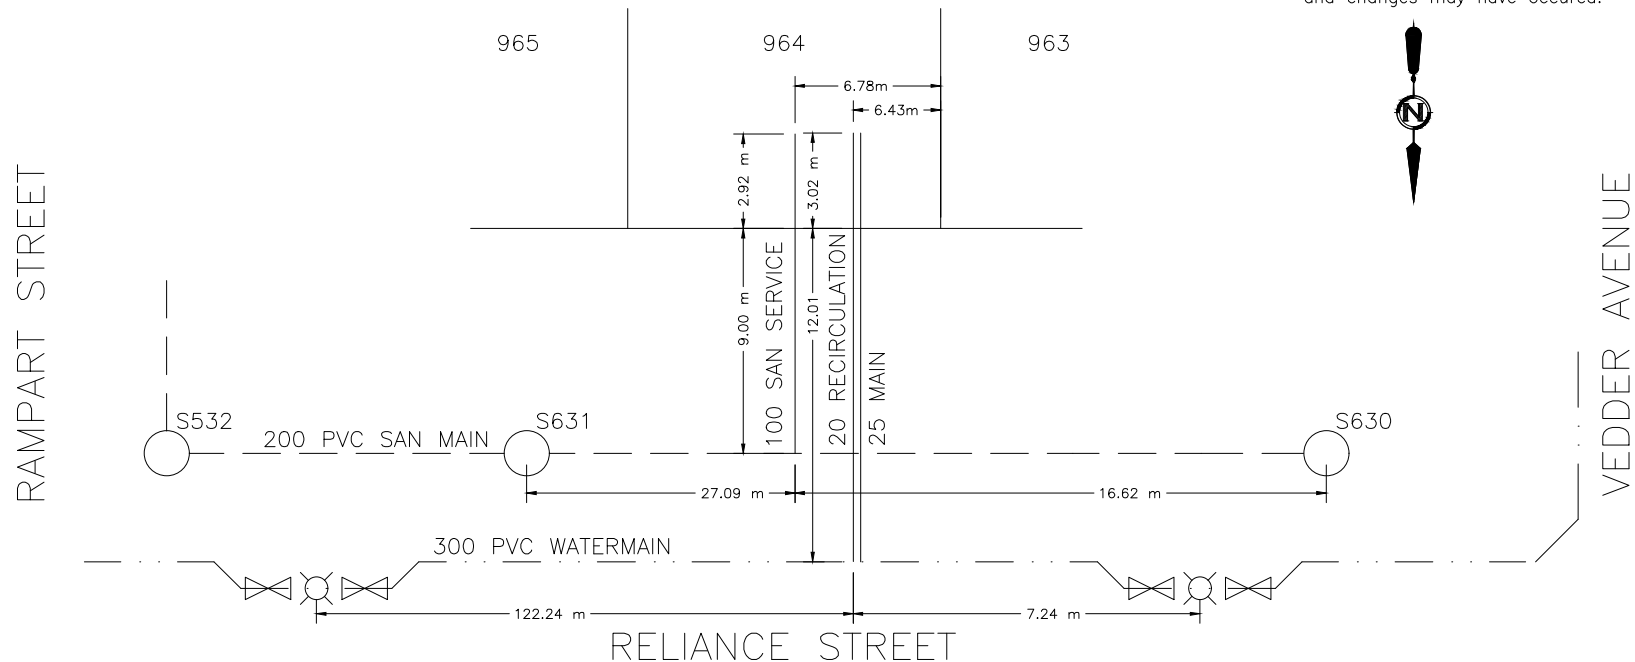



CITY OF WHITEHORSE

SERVICE CONNECTION RECORD

FIELD BOOK

No.

ADDRESS 36 RELIANCE STREET BLOCK LOT 965

DATES


WATER

SEWER

On at Main 20200919	Depth at P/L: 2.41 m	2.34 m
On at Building	Depth at Main: 3.15 m	2.77 m
Frost Plug:	Pipe Size: 20 mm / 25 mm	100 mm
Memo:	Pipe Material: HDPE Insul. <u>(Yes)</u> /No	PVC Insul. <u>(Yes)</u> /No
	Length from Main to P/L: 12.00 m	9.00 m
	Squirt Test: <u>(Pass)</u> /Fail	N/A
Booster Pump Required: Yes/No	Frost Protection: Aquaflow/ <u>(Recirc)</u> /Heat Trace/Bleeder	N/A
PRV Required: Yes/No	Greased @ CC: <u>(Yes)</u> /No	N/A
Water Meter Installed: Yes/No	Continuity Test: <u>(N/A)</u> Pass/Fail	N/A

CLEARLY INDICATE LOCATION OF CC AND ROUTE OF PIPES ON DRAWING BELOW

1. Show main valves required to isolate this service. 2. All dimensions to be tied to property line 3. All dimensions to be metric 4. Depth @ property line is based on elevation after construction and changes may have occurred.

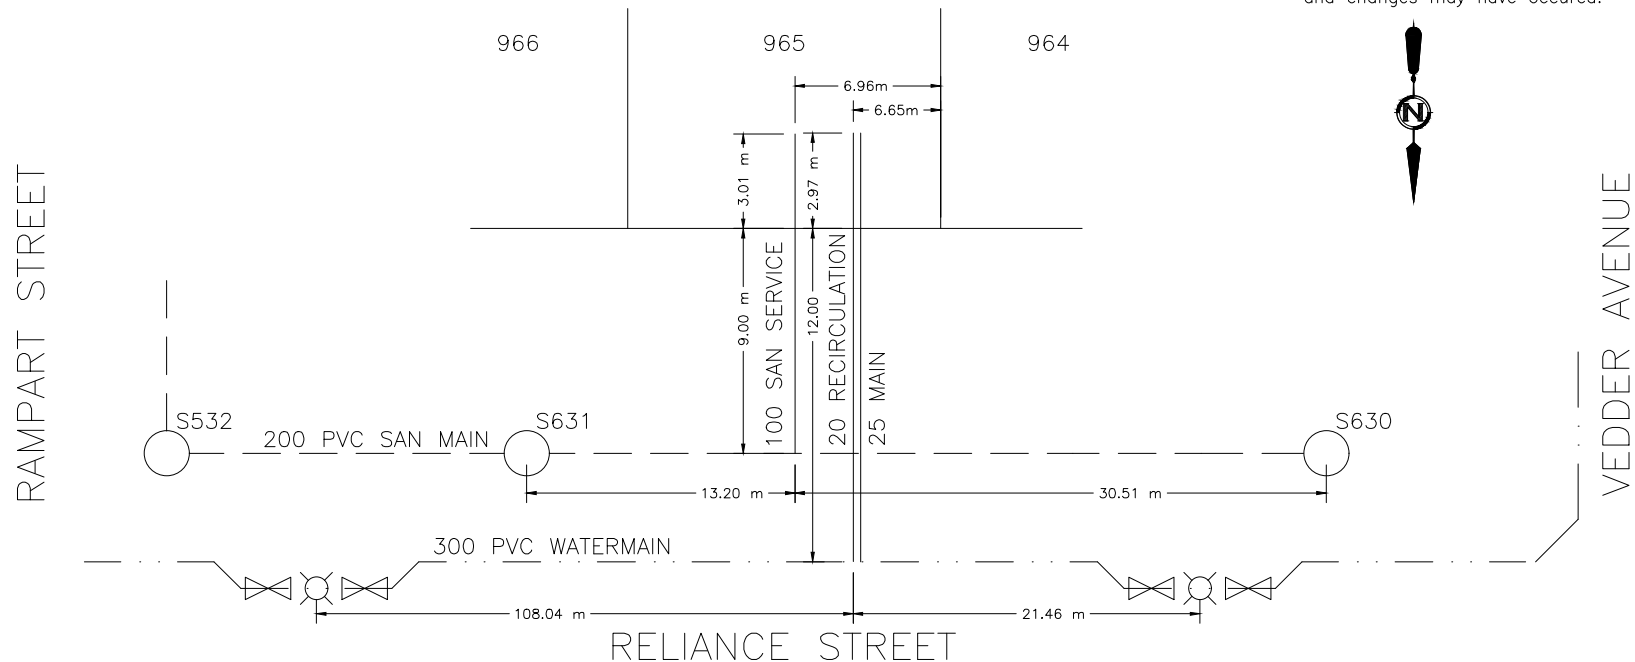



CITY OF WHITEHORSE

SERVICE CONNECTION RECORD

FIELD BOOK

No.

ADDRESS 34 RELIANCE STREET BLOCK LOT 966

DATES


WATER

SEWER

On at Main 20200919	Depth at P/L: 2.58 m	2.64 m
On at Building	Depth at Main: 3.09 m	2.96 m
Frost Plug:	Pipe Size: 20 mm / 25 mm	100 mm
Memo:	Pipe Material: HDPE Insul. <u>Yes</u> /No	PVC Insul. Yes/ <u>No</u>
	Length from Main to P/L: 11.99 m	9.03 m
	Squirt Test: <u>Pass</u> /Fail	N/A
Booster Pump Required: Yes/No	Frost Protection: Aquaflow/ <u>Recirc</u> /Heat Trace/Bleeder	N/A
PRV Required: Yes/No	Greased @ CC: <u>Yes</u> /No	N/A
Water Meter Installed: Yes/No	Continuity Test: <u>N/A</u> Pass/Fail	N/A

CLEARLY INDICATE LOCATION OF CC AND ROUTE OF PIPES ON DRAWING BELOW

1. Show main valves required to isolate this service. 2. All dimensions to be tied to property line 3. All dimensions to be metric 4. Depth @ property line is based on elevation after construction and changes may have occurred.

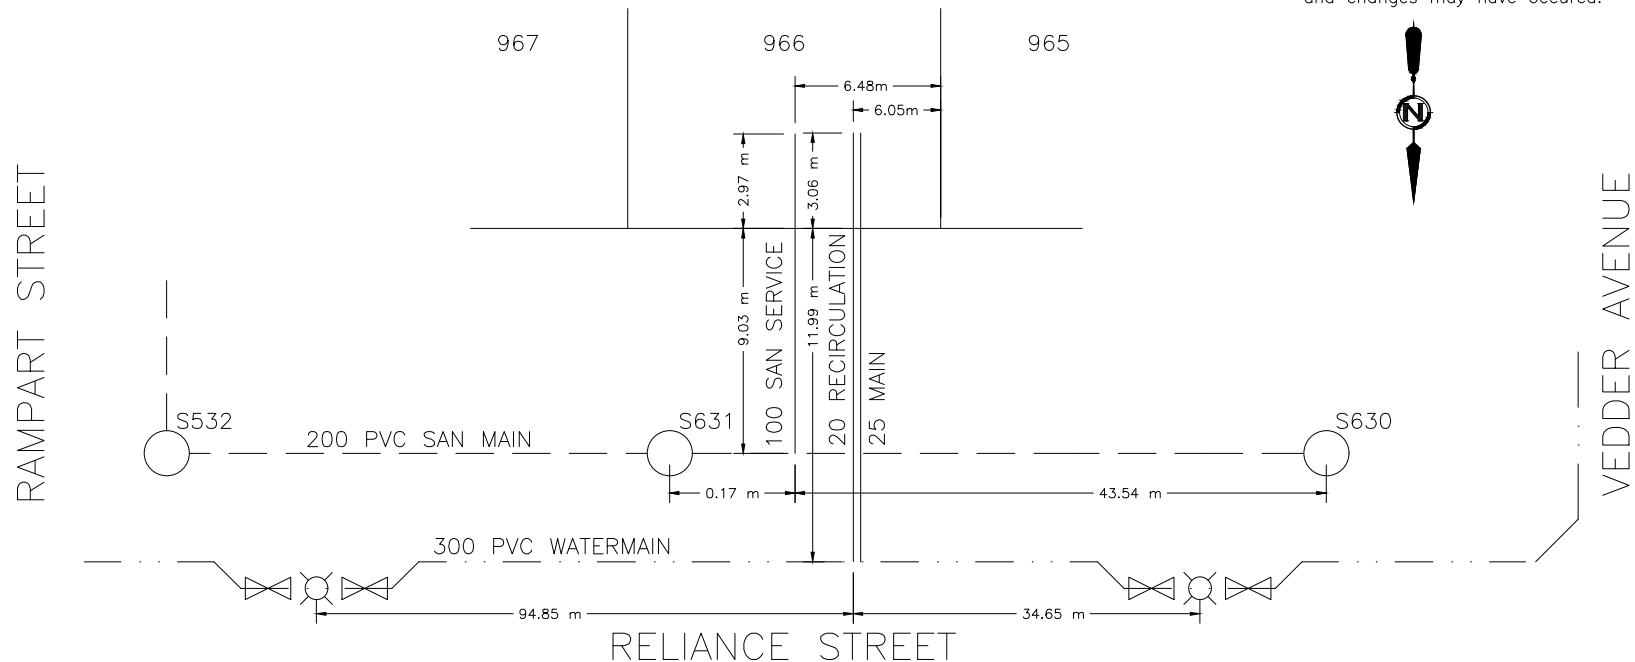



CITY OF WHITEHORSE

SERVICE CONNECTION RECORD

FIELD BOOK

No.

ADDRESS 32 RELIANCE STREET BLOCK LOT 967

DATES


WATER

SEWER

On at Main 20200919	Depth at P/L: 2.69 m	2.75 m
On at Building	Depth at Main: 3.08 m	3.14 m
Frost Plug:	Pipe Size: 20 mm / 25 mm	100 mm
Memo:	Pipe Material: HDPE Insul. <u>Yes</u> /No	PVC Insul. Yes/ <u>No</u>
	Length from Main to P/L: 12.00 m	8.98 m
	Squirt Test: <u>Pass</u> /Fail	N/A
Booster Pump Required: Yes/No	Frost Protection: Aquaflow/ <u>Recirc</u> /Heat Trace/Bleeder	N/A
PRV Required: Yes/No	Greased @ CC: <u>Yes</u> /No	N/A
Water Meter Installed: Yes/No	Continuity Test: <u>N/A</u> Pass/Fail	N/A

CLEARLY INDICATE LOCATION OF CC AND ROUTE OF PIPES ON DRAWING BELOW

1. Show main valves required to isolate this service. 2. All dimensions to be tied to property line 3. All dimensions to be metric 4. Depth @ property line is based on elevation after construction and changes may have occurred.

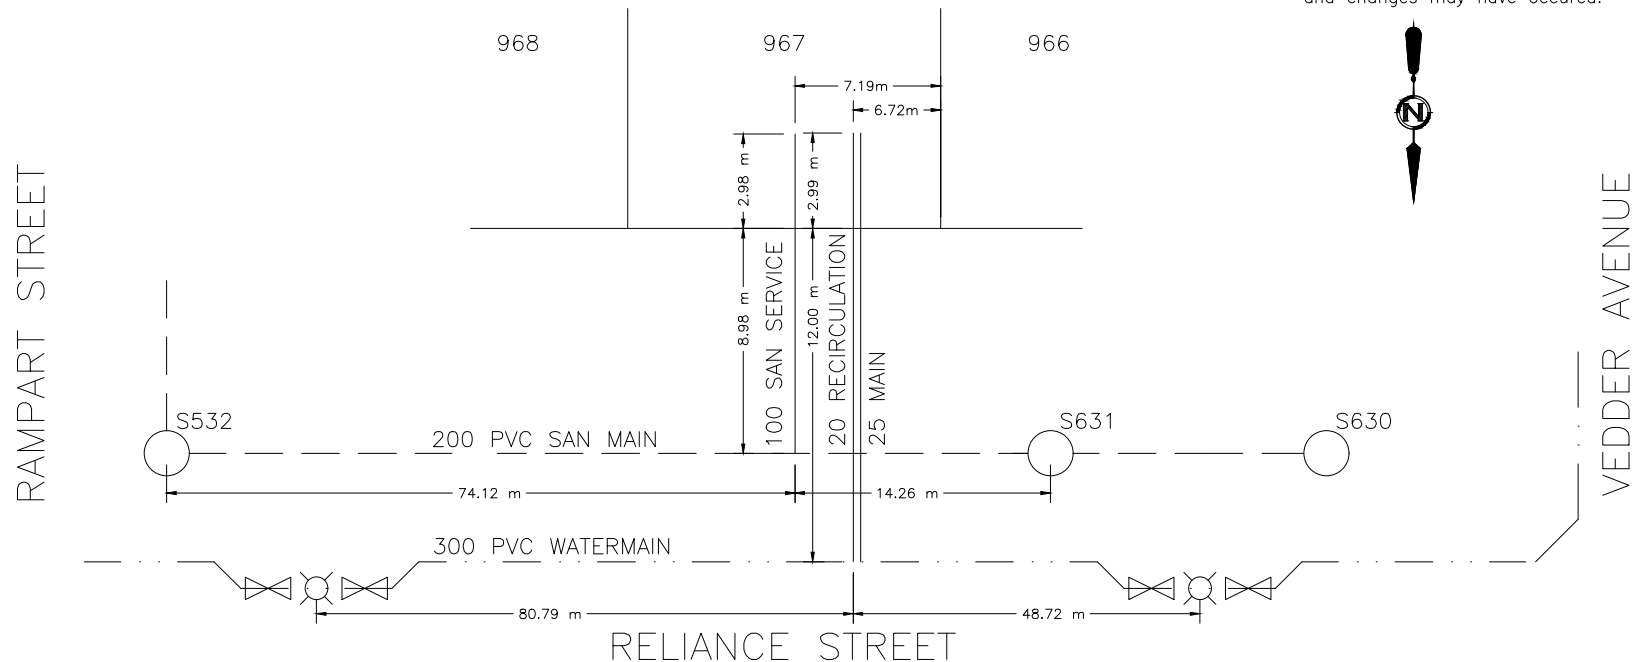



CITY OF WHITEHORSE

SERVICE CONNECTION RECORD

FIELD BOOK

No.

ADDRESS 30 RELIANCE STREET BLOCK LOT 968

DATES


WATER

SEWER

On at Main 20200919	Depth at P/L: 2.40 m	2.50 m
On at Building	Depth at Main: 3.01 m	3.31 m
Frost Plug:	Pipe Size: 20 mm / 25 mm	100 mm
Memo:	Pipe Material: HDPE Insul. <u>Yes</u> /No	PVC Insul. Yes/ <u>No</u>
	Length from Main to P/L: 12.00 m	9.01 m
	Squirt Test: <u>Pass</u> /Fail	N/A
Booster Pump Required: Yes/No	Frost Protection: Aquaflow/ <u>Recirc</u> /Heat Trace/Bleeder	N/A
PRV Required: Yes/No	Greased @ CC: <u>Yes</u> /No	N/A
Water Meter Installed: Yes/No	Continuity Test: <u>N/A</u> Pass/Fail	N/A

CLEARLY INDICATE LOCATION OF CC AND ROUTE OF PIPES ON DRAWING BELOW

1. Show main valves required to isolate this service. 2. All dimensions to be tied to property line 3. All dimensions to be metric 4. Depth @ property line is based on elevation after construction and changes may have occurred.

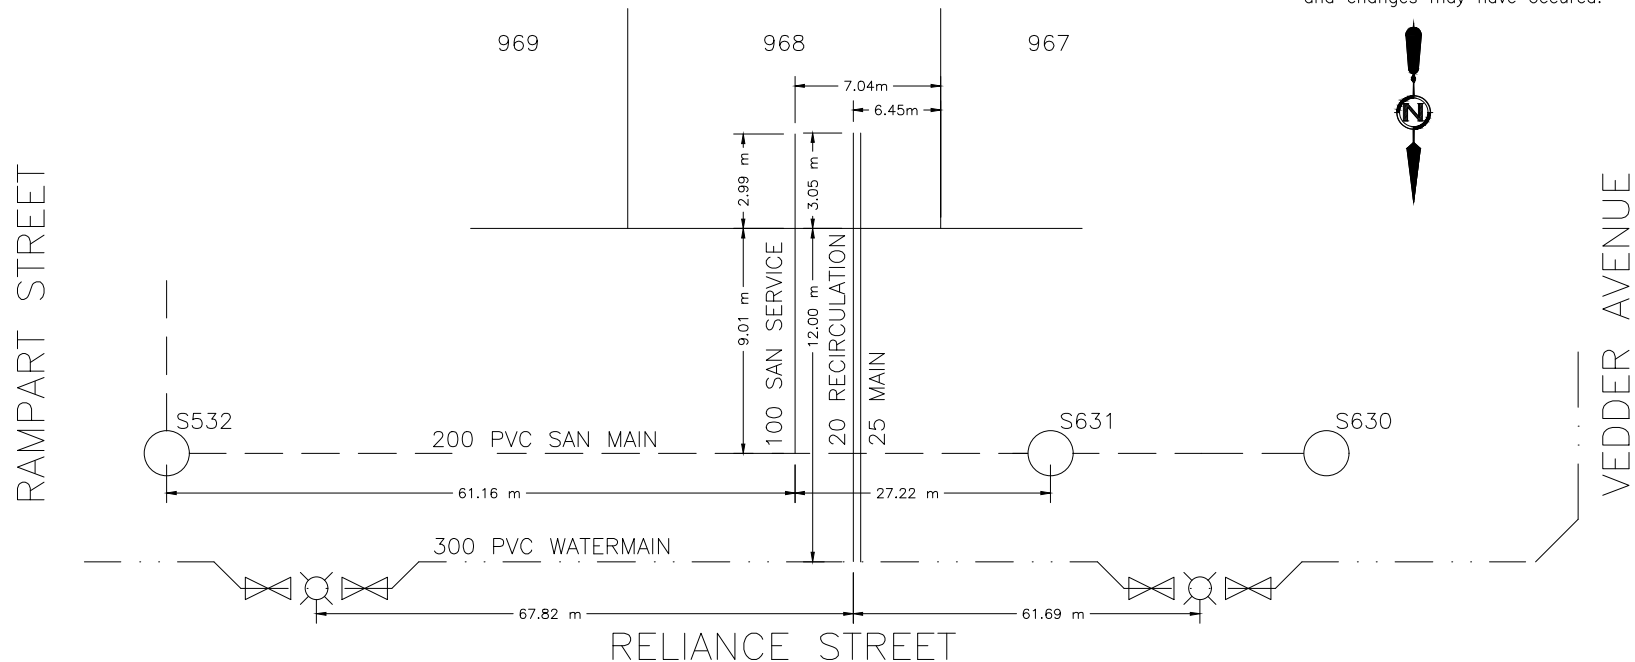



CITY OF WHITEHORSE

SERVICE CONNECTION RECORD

FIELD BOOK

No.

ADDRESS 28 RELIANCE STREET BLOCK LOT 969

DATES


WATER

SEWER

On at Main 20200919	Depth at P/L: 2.65 m	2.61 m
On at Building	Depth at Main: 3.00 m	3.46 m
Frost Plug:	Pipe Size: 20 mm / 25 mm	100 mm
Memo:	Pipe Material: HDPE Insul. <u>Yes</u> /No	PVC Insul. Yes/ <u>No</u>
	Length from Main to P/L: 12.00 m	9.01 m
	Squirt Test: <u>Pass</u> /Fail	N/A
Booster Pump Required: Yes/No	Frost Protection: Aquaflow/ <u>Recirc</u> /Heat Trace/Bleeder	N/A
PRV Required: Yes/No	Greased @ CC: <u>Yes</u> /No	N/A
Water Meter Installed: Yes/No	Continuity Test: <u>N/A</u> Pass/Fail	N/A

CLEARLY INDICATE LOCATION OF CC AND ROUTE OF PIPES ON DRAWING BELOW

1. Show main valves required to isolate this service. 2. All dimensions to be tied to property line 3. All dimensions to be metric 4. Depth @ property line is based on elevation after construction and changes may have occurred.

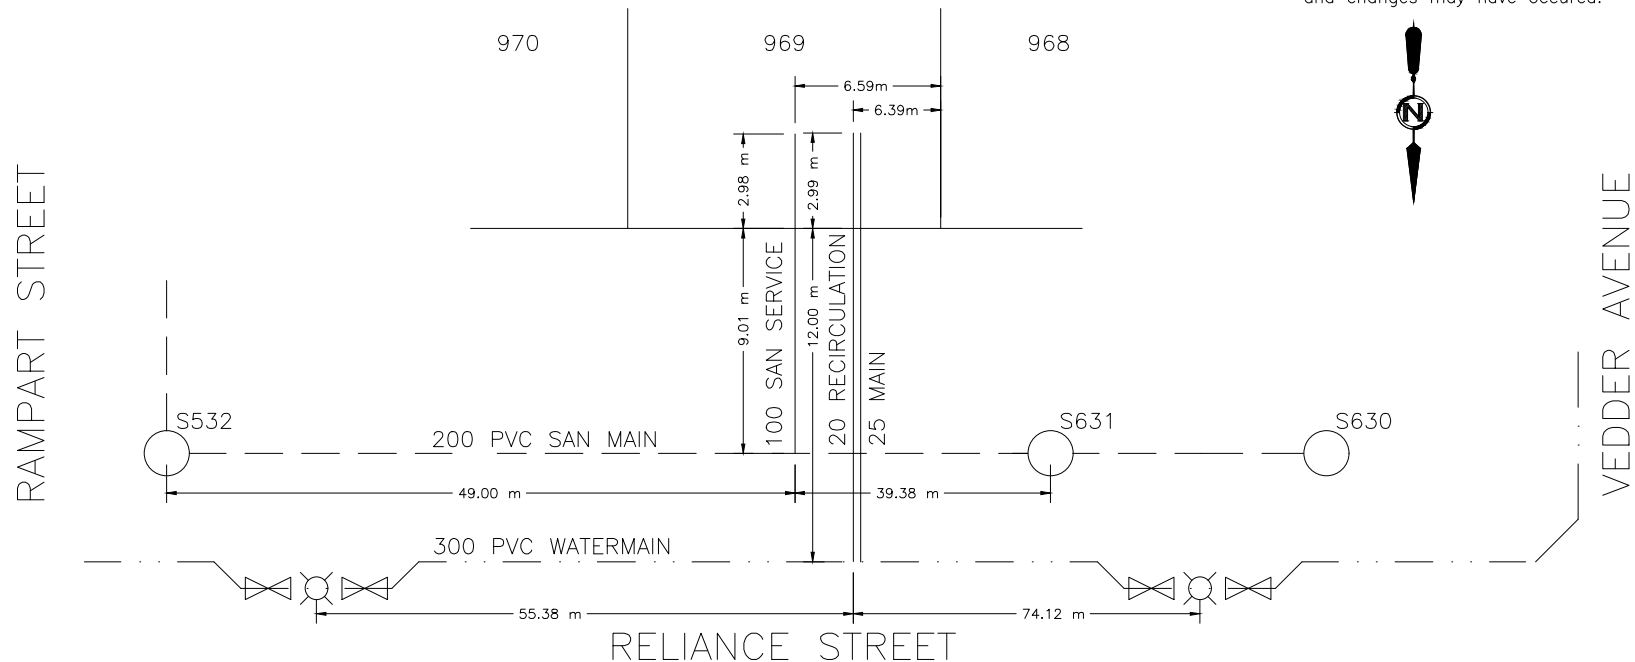



CITY OF WHITEHORSE

SERVICE CONNECTION RECORD

FIELD BOOK

No.

ADDRESS 26 RELIANCE STREET BLOCK LOT 970

DATES


WATER

SEWER

On at Main 20200919	Depth at P/L: 2.49 m	2.54 m
On at Building	Depth at Main: 2.98 m	3.61 m
Frost Plug:	Pipe Size: 20 mm / 25 mm	100 mm
Memo:	Pipe Material: HDPE	Insul. <u>Yes</u> /No
	Length from Main to P/L: 12.00 m	PVC
	Squirt Test:	Insul. Yes/ <u>No</u>
Booster Pump Required:	Yes/No	Frost Protection: Aquaflow/ <u>Recirc</u> /Heat Trace/Bleeder
PRV Required:	Yes/No	Greased @ CC:
Water Meter Installed:	Yes/No	Continuity Test: <u>N/A</u> Pass/Fail

CLEARLY INDICATE LOCATION OF CC AND ROUTE OF PIPES ON DRAWING BELOW

1. Show main valves required to isolate this service. 2. All dimensions to be tied to property line 3. All dimensions to be metric 4. Depth @ property line is based on elevation after construction and changes may have occurred.

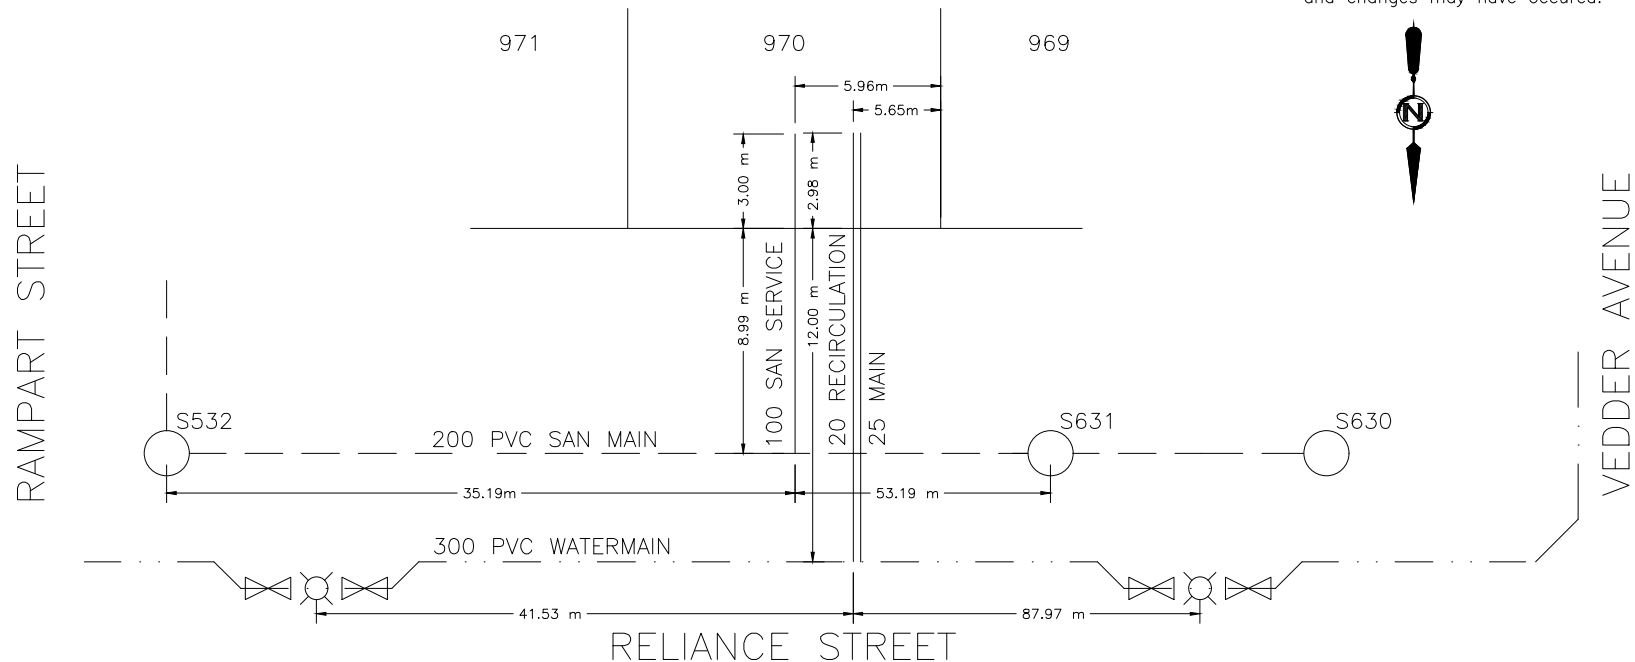



CITY OF WHITEHORSE

SERVICE CONNECTION RECORD

FIELD BOOK

No.

ADDRESS 24 RELIANCE STREET BLOCK LOT 971

DATES


WATER

SEWER

On at Main 20200919	Depth at P/L: 2.58 m	2.61 m
On at Building	Depth at Main: 3.04 m	3.75 m
Frost Plug:	Pipe Size: 20 mm / 25 mm	100 mm
Memo:	Pipe Material: HDPE	Insul. Yes/No
	Length from Main to P/L: 12.00 m	9.04 m
	Squirt Test:	Pass/Fail
Booster Pump Required: Yes/No	Frost Protection: Aquaflow/Recirc/Heat Trace/Bleeder	N/A
PRV Required: Yes/No	Greased @ CC: Yes/No	N/A
Water Meter Installed: Yes/No	Continuity Test: N/A	Pass/Fail

CLEARLY INDICATE LOCATION OF CC AND ROUTE OF PIPES ON DRAWING BELOW

1. Show main valves required to isolate this service. 2. All dimensions to be tied to property line 3. All dimensions to be metric 4. Depth @ property line is based on elevation after construction and changes may have occurred.

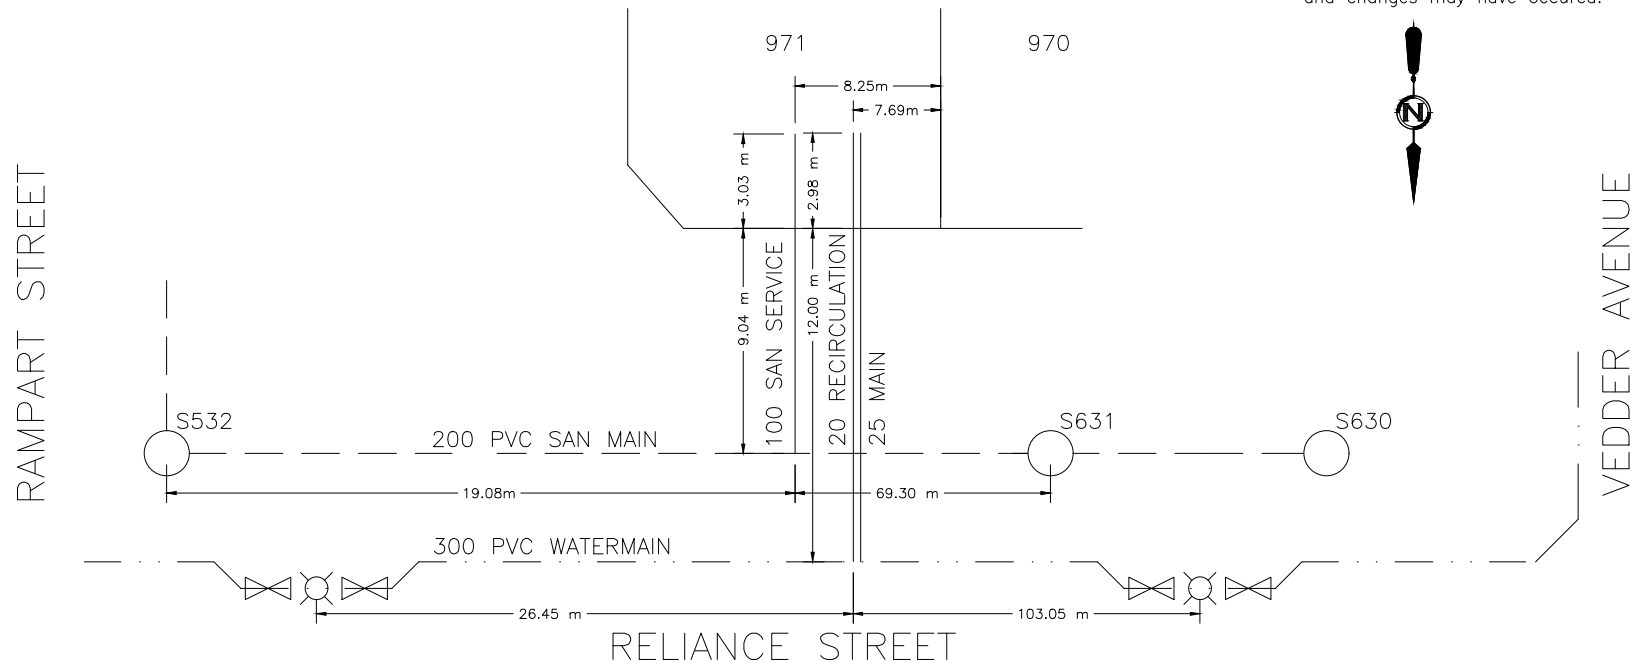



CITY OF WHITEHORSE

SERVICE CONNECTION RECORD

FIELD BOOK

No.

ADDRESS 35 CHANCE LANE BLOCK LOT 981

DATES


WATER

SEWER

On at Main 20200831	Depth at P/L: 2.38 m	2.39 m
On at Building	Depth at Main: 2.75 m	2.82 m
Frost Plug:	Pipe Size: 20 mm / 25 mm	100 mm
Memo:	Pipe Material: HDPE Insul. <u>(Yes)</u> /No	PVC Insul. <u>(Yes)</u> /No
	Length from Main to P/L: 4.00 m	8.94 m
	Squirt Test: <u>(Pass)</u> /Fail	N/A
Booster Pump Required: Yes/No	Frost Protection: Aquaflow/ <u>(Recirc)</u> /Heat Trace/Bleeder	N/A
PRV Required: Yes/No	Greased @ CC: <u>(Yes)</u> /No	N/A
Water Meter Installed: Yes/No	Continuity Test: <u>(N/A)</u> Pass/Fail	N/A

CLEARLY INDICATE LOCATION OF CC AND ROUTE OF PIPES ON DRAWING BELOW

1. Show main valves required to isolate this service. 2. All dimensions to be tied to property line 3. All dimensions to be metric 4. Depth @ property line is based on elevation after construction and changes may have occurred.

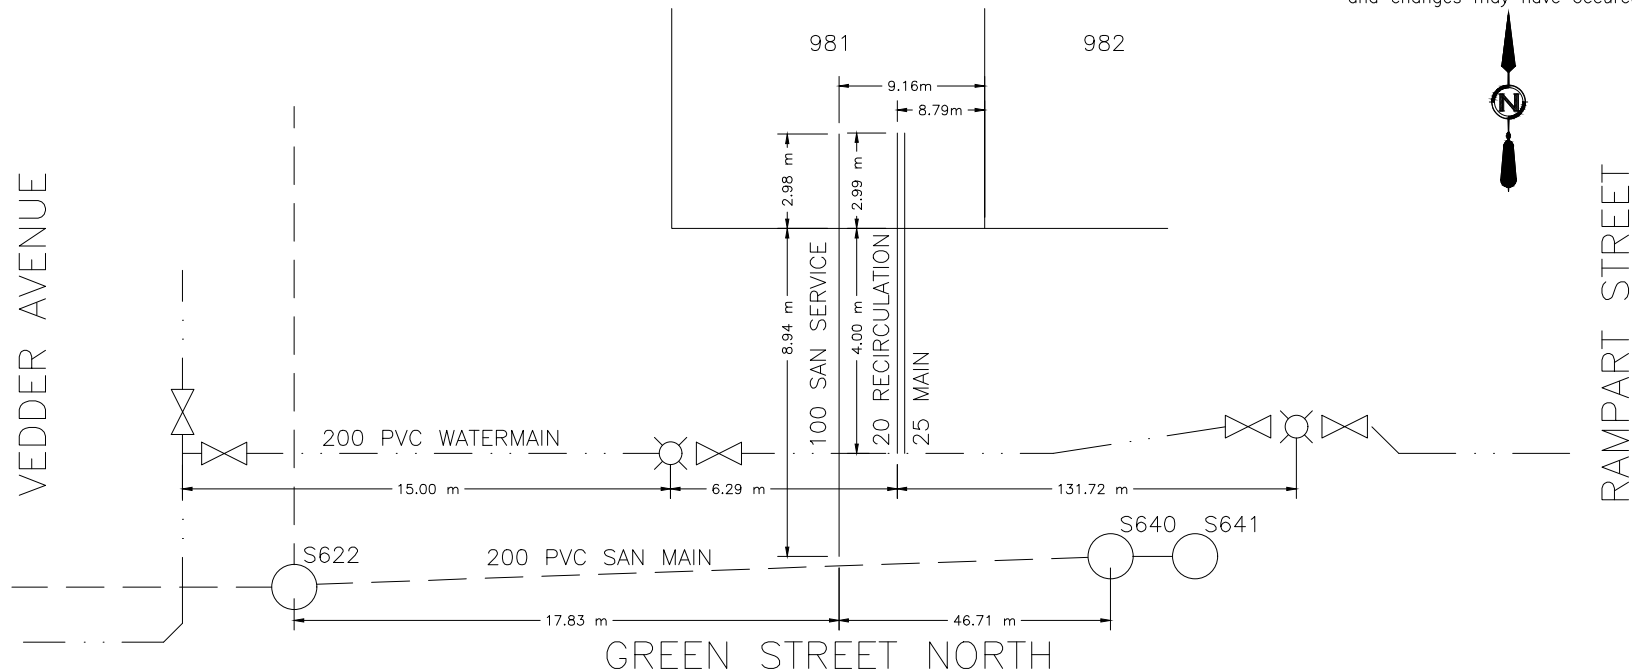



CITY OF WHITEHORSE

SERVICE CONNECTION RECORD

FIELD BOOK

No.

ADDRESS 33 CHANCE LANE BLOCK LOT 982

DATES


WATER

SEWER

On at Main 20200831	Depth at P/L: 2.63 m	2.74 m
On at Building	Depth at Main: 2.83 m	2.85 m
Frost Plug:	Pipe Size: 20 mm / 25 mm	100 mm
Memo:	Pipe Material: HDPE Insul. <u>Yes</u> /No	PVC Insul. Yes/ <u>No</u>
	Length from Main to P/L: 4.00 m	8.42 m
	Squirt Test: <u>Pass</u> /Fail	N/A
Booster Pump Required: Yes/No	Frost Protection: Aquaflow/ <u>Recirc</u> /Heat Trace/Bleeder	N/A
PRV Required: Yes/No	Greased @ CC: <u>Yes</u> /No	N/A
Water Meter Installed: Yes/No	Continuity Test: <u>N/A</u> Pass/Fail	N/A

CLEARLY INDICATE LOCATION OF CC AND ROUTE OF PIPES ON DRAWING BELOW

1. Show main valves required to isolate this service. 2. All dimensions to be tied to property line 3. All dimensions to be metric 4. Depth @ property line is based on elevation after construction and changes may have occurred.

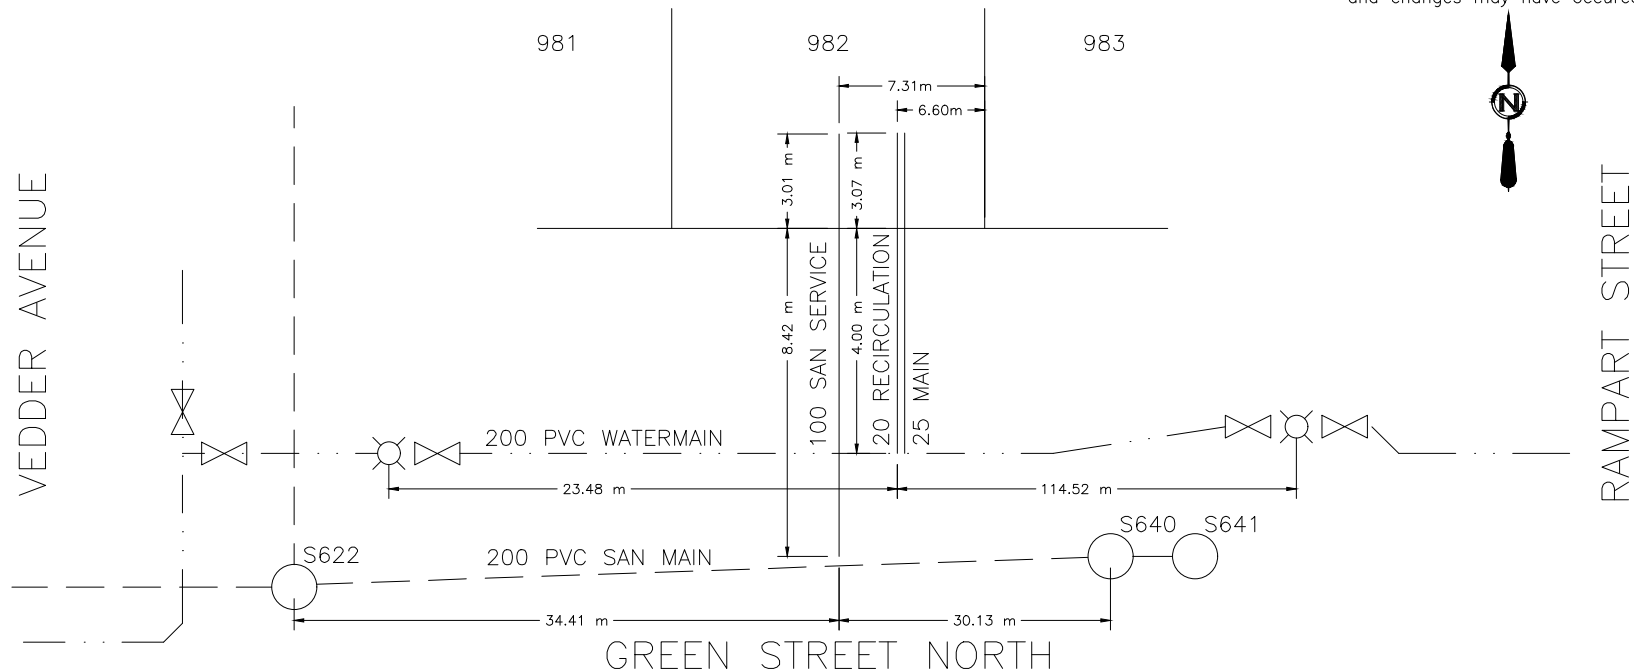



CITY OF WHITEHORSE

SERVICE CONNECTION RECORD

FIELD BOOK

No.

ADDRESS 31 CHANCE LANE BLOCK LOT 983

DATES


WATER

SEWER

On at Main 20200901	Depth at P/L: 2.68 m	2.69 m
On at Building	Depth at Main: 2.87 m	2.87 m
Frost Plug:	Pipe Size: 20 mm / 25 mm	100 mm
Memo:	Pipe Material: HDPE Insul. <u>Yes</u> /No	PVC Insul. Yes/ <u>No</u>
	Length from Main to P/L: 4.01 m	7.97 m
	Squirt Test: <u>Pass</u> /Fail	N/A
Booster Pump Required: Yes/No	Frost Protection: Aquaflow/ <u>Recirc</u> /Heat Trace/Bleeder	N/A
PRV Required: Yes/No	Greased @ CC: <u>Yes</u> /No	N/A
Water Meter Installed: Yes/No	Continuity Test: <u>N/A</u> Pass/Fail	N/A

CLEARLY INDICATE LOCATION OF CC AND ROUTE OF PIPES ON DRAWING BELOW

1. Show main valves required to isolate this service. 2. All dimensions to be tied to property line 3. All dimensions to be metric 4. Depth @ property line is based on elevation after construction and changes may have occurred.

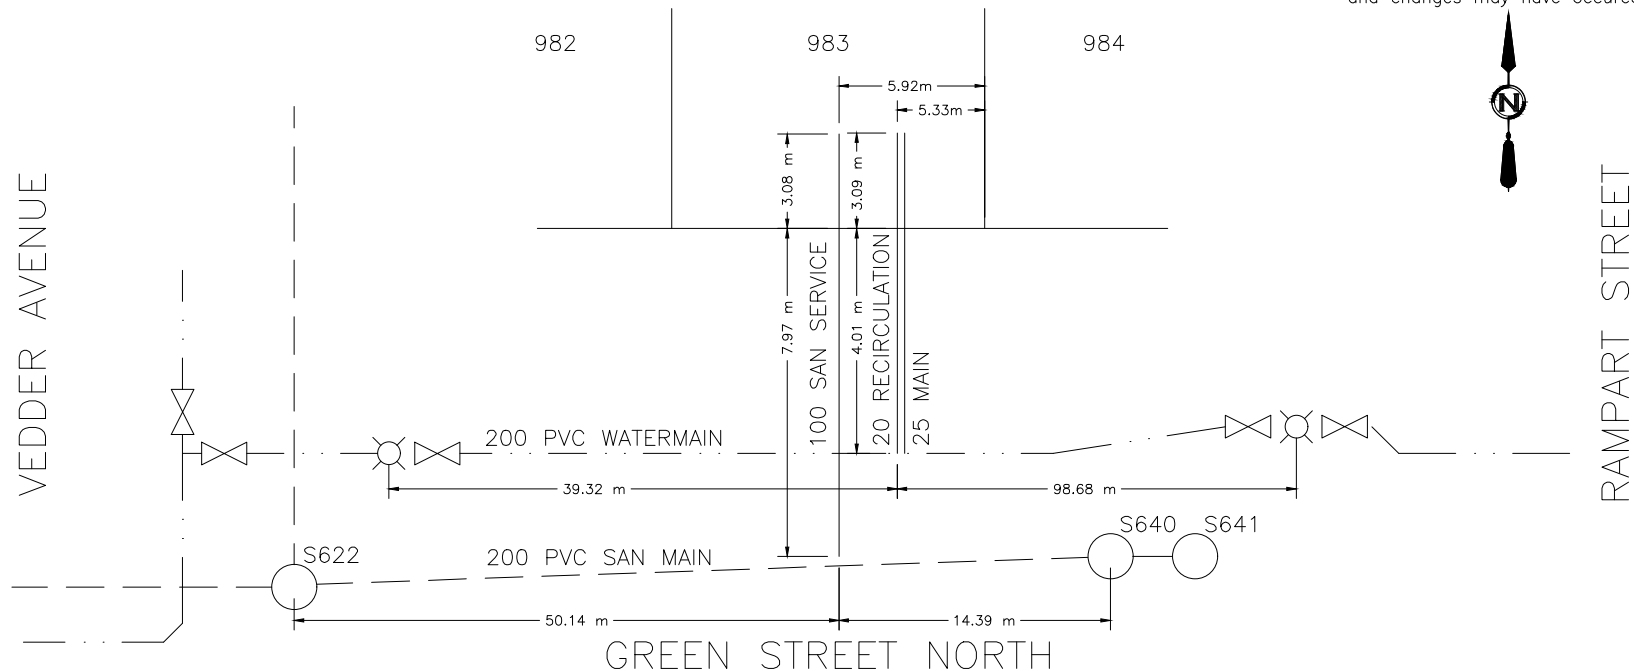



CITY OF WHITEHORSE

SERVICE CONNECTION RECORD

FIELD BOOK

No.

ADDRESS 29 CHANCE LANE BLOCK LOT 984

DATES


WATER

SEWER

On at Main 20200901	Depth at P/L: 2.52 m	2.57 m
On at Building	Depth at Main: 2.93 m	2.56 m
Frost Plug:	Pipe Size: 20 mm / 25 mm	100 mm
Memo:	Pipe Material: HDPE Insul. <u>Yes</u> /No	PVC Insul. Yes/ <u>No</u>
	Length from Main to P/L: 4.00 m	6.63 m
	Squirt Test: <u>Pass</u> /Fail	N/A
Booster Pump Required: Yes/No	Frost Protection: Aquaflo/ <u>Recirc</u> /Heat Trace/Bleeder	N/A
PRV Required: Yes/No	Greased @ CC: <u>Yes</u> /No	N/A
Water Meter Installed: Yes/No	Continuity Test: <u>N/A</u> Pass/Fail	N/A

CLEARLY INDICATE LOCATION OF CC AND ROUTE OF PIPES ON DRAWING BELOW

1. Show main valves required to isolate this service. 2. All dimensions to be tied to property line 3. All dimensions to be metric 4. Depth @ property line is based on elevation after construction and changes may have occurred.

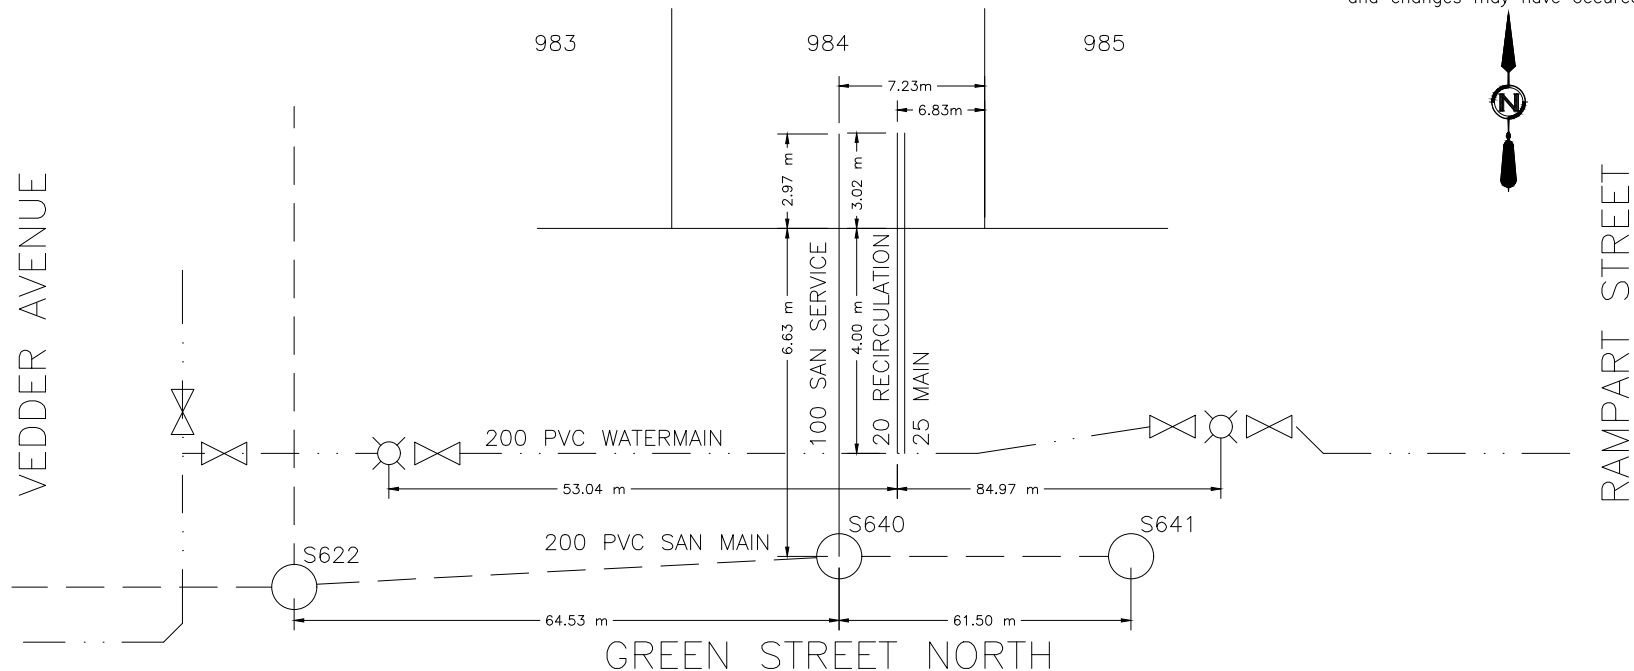



CITY OF WHITEHORSE

SERVICE CONNECTION RECORD

FIELD BOOK

No.

ADDRESS 27 CHANCE LANE BLOCK LOT 985

DATES


WATER

SEWER

On at Main 20200902	Depth at P/L: 2.74 m	2.77 m
On at Building	Depth at Main: 3.00 m	2.83 m
Frost Plug:	Pipe Size: 20 mm / 25 mm	100 mm
Memo:	Pipe Material: HDPE Insul. <u>Yes</u> /No	PVC Insul. Yes/ <u>No</u>
	Length from Main to P/L: 4.02 m	7.50 m
	Squirt Test: <u>Pass</u> /Fail	N/A
Booster Pump Required: Yes/No	Frost Protection: Aquaflo/ <u>Recirc</u> /Heat Trace/Bleeder	N/A
PRV Required: Yes/No	Greased @ CC: <u>Yes</u> /No	N/A
Water Meter Installed: Yes/No	Continuity Test: <u>N/A</u> Pass/Fail	N/A

CLEARLY INDICATE LOCATION OF CC AND ROUTE OF PIPES ON DRAWING BELOW

1. Show main valves required to isolate this service.
2. All dimensions to be tied to property line
3. All dimensions to be metric
4. Depth @ property line is based on elevation after construction and changes may have occurred.

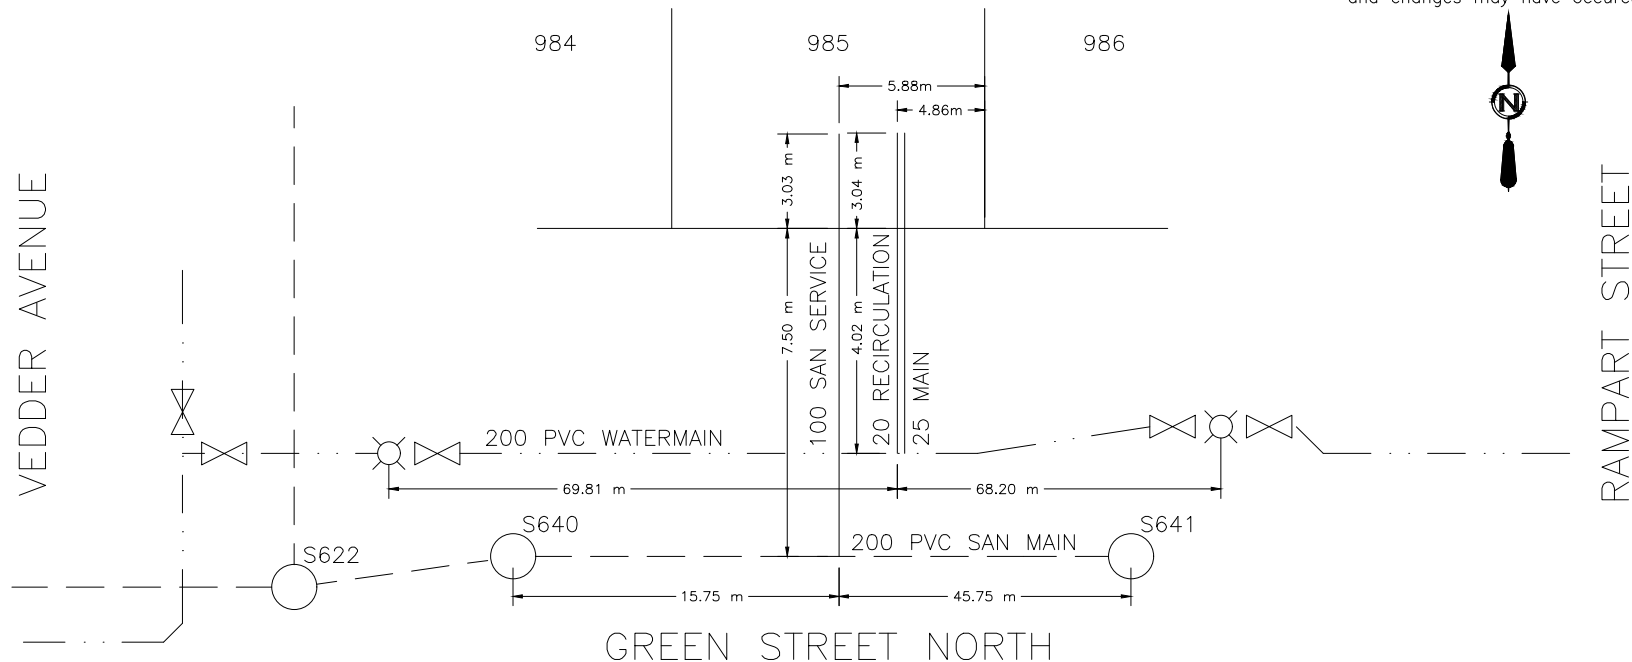



CITY OF WHITEHORSE

SERVICE CONNECTION RECORD

FIELD BOOK

No.

ADDRESS 25 CHANCE LANE BLOCK LOT 986

DATES


WATER

SEWER

On at Main 20200902	Depth at P/L: 2.63 m	2.69 m
On at Building	Depth at Main: 3.02 m	2.80 m
Frost Plug:	Pipe Size: 20 mm / 25 mm	100 mm
Memo:	Pipe Material: HDPE Insul. <u>Yes</u> /No	PVC Insul. Yes/ <u>No</u>
	Length from Main to P/L: 4.01 m	7.48 m
	Squirt Test: <u>Pass</u> /Fail	N/A
Booster Pump Required: Yes/No	Frost Protection: Aquaflo/ <u>Recirc</u> /Heat Trace/Bleeder	N/A
PRV Required: Yes/No	Greased @ CC: <u>Yes</u> /No	N/A
Water Meter Installed: Yes/No	Continuity Test: <u>N/A</u> Pass/Fail	N/A

CLEARLY INDICATE LOCATION OF CC AND ROUTE OF PIPES ON DRAWING BELOW

1. Show main valves required to isolate this service. 2. All dimensions to be tied to property line 3. All dimensions to be metric 4. Depth @ property line is based on elevation after construction and changes may have occurred.

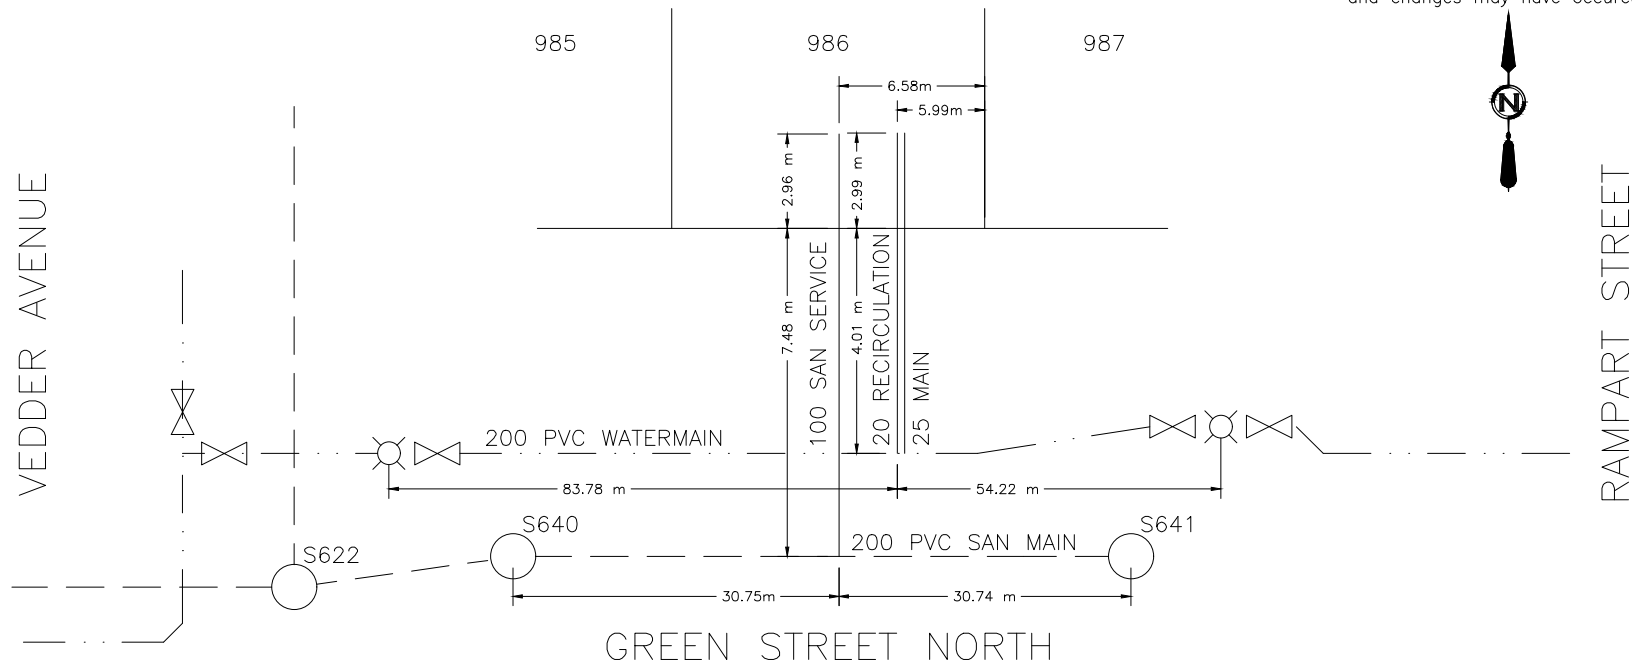



CITY OF WHITEHORSE

SERVICE CONNECTION RECORD

FIELD BOOK

No.

ADDRESS 23 CHANCE LANE BLOCK LOT 987

DATES


WATER

SEWER

On at Main 20200903	Depth at P/L: 2.57 m	2.65 m
On at Building	Depth at Main: 3.06 m	2.81 m
Frost Plug:	Pipe Size: 20 mm / 25 mm	100 mm
Memo:	Pipe Material: HDPE Insul. <u>Yes</u> /No	PVC Insul. Yes/ <u>No</u>
	Length from Main to P/L: 3.81 m	7.49 m
	Squirt Test: <u>Pass</u> /Fail	N/A
Booster Pump Required: Yes/No	Frost Protection: Aquaflow/ <u>Recirc</u> /Heat Trace/Bleeder	N/A
PRV Required: Yes/No	Greased @ CC: <u>Yes</u> /No	N/A
Water Meter Installed: Yes/No	Continuity Test: <u>N/A</u> Pass/Fail	N/A

CLEARLY INDICATE LOCATION OF CC AND ROUTE OF PIPES ON DRAWING BELOW

1. Show main valves required to isolate this service.
2. All dimensions to be tied to property line
3. All dimensions to be metric
4. Depth @ property line is based on elevation after construction and changes may have occurred.

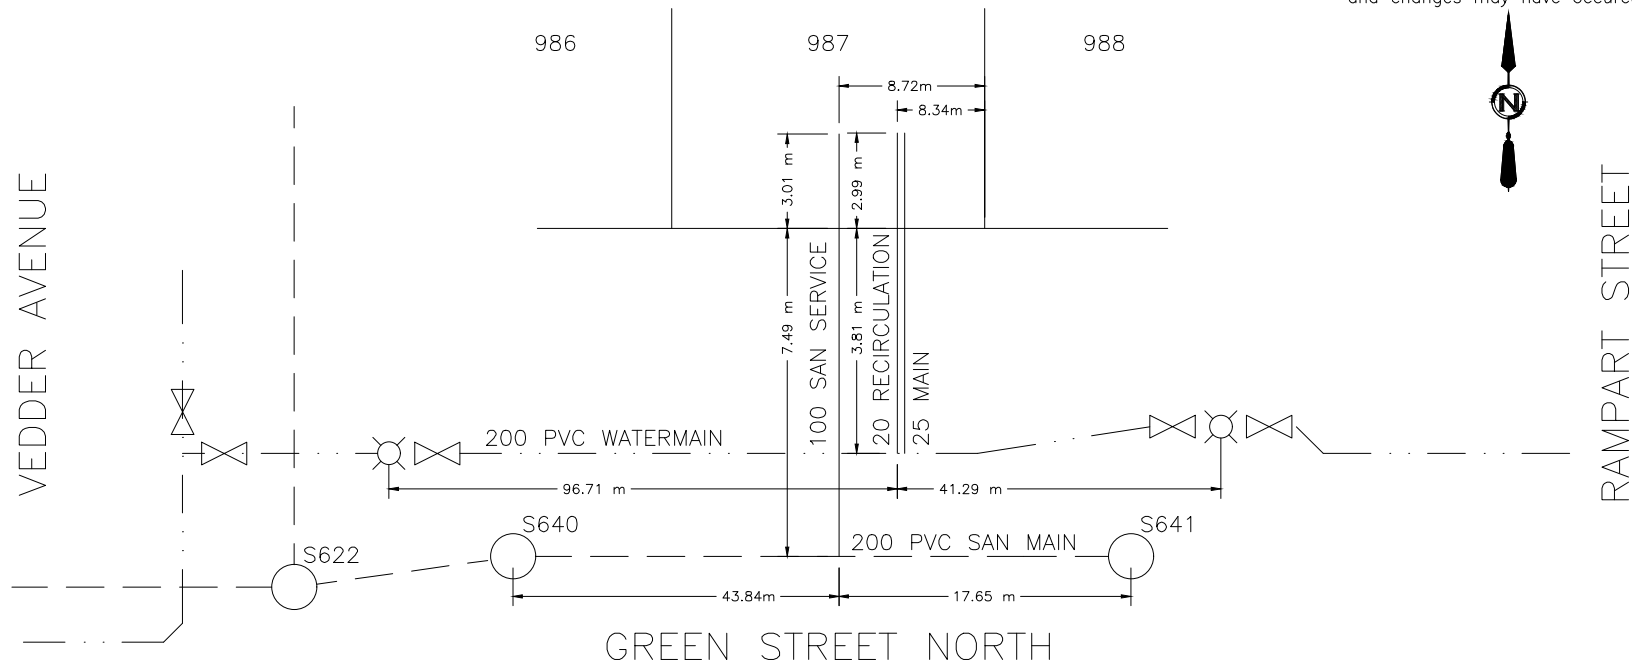



CITY OF WHITEHORSE

SERVICE CONNECTION RECORD

FIELD BOOK

No.

ADDRESS 21 CHANCE LANE BLOCK LOT 988

DATES


WATER

SEWER

On at Main 20200903	Depth at P/L: 2.50 m	2.59 m
On at Building	Depth at Main: 3.05 m	2.80 m
Frost Plug:	Pipe Size: 20 mm / 25 mm	100 mm
Memo:	Pipe Material: HDPE Insul. <u>Yes</u> /No	PVC Insul. Yes/ <u>No</u>
	Length from Main to P/L: 3.27 m	7.51 m
	Squirt Test: <u>Pass</u> /Fail	N/A
Booster Pump Required: Yes/No	Frost Protection: Aquaflo/ <u>Recirc</u> /Heat Trace/Bleeder	N/A
PRV Required: Yes/No	Greased @ CC: <u>Yes</u> /No	N/A
Water Meter Installed: Yes/No	Continuity Test: <u>N/A</u> Pass/Fail	N/A

CLEARLY INDICATE LOCATION OF CC AND ROUTE OF PIPES ON DRAWING BELOW

1. Show main valves required to isolate this service.
2. All dimensions to be tied to property line
3. All dimensions to be metric
4. Depth @ property line is based on elevation after construction and changes may have occurred.

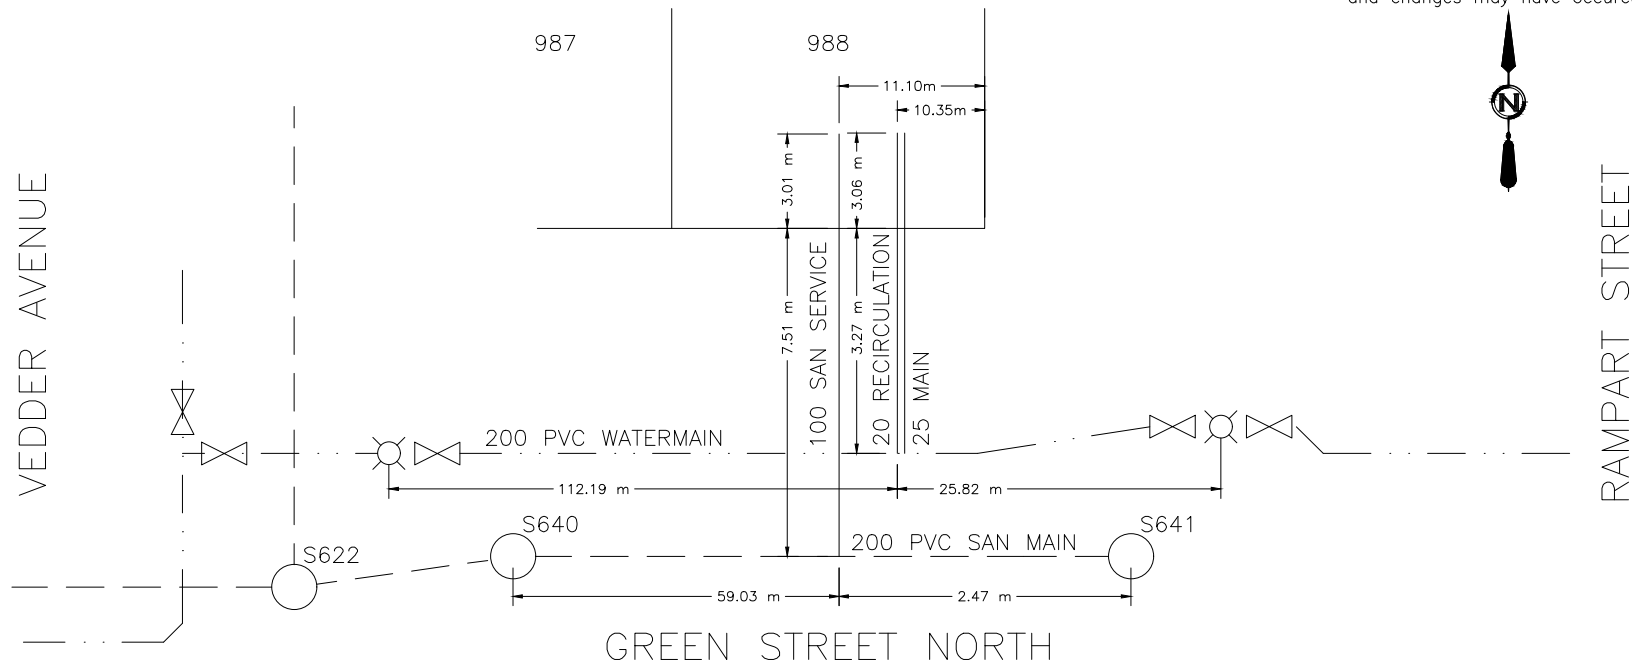



CITY OF WHITEHORSE

SERVICE CONNECTION RECORD

FIELD BOOK

No.

ADDRESS 36 SCOTIA LANE BLOCK LOT 1008

DATES


WATER

SEWER

On at Main 20200831	Depth at P/L: 2.51 m	2.56 m
On at Building	Depth at Main: 2.74 m	2.82 m
Frost Plug:	Pipe Size: 20 mm / 25 mm	100 mm
Memo:	Pipe Material: HDPE	Insul. <u>Yes</u> /No
	Length from Main to P/L: 10.02 m	5.09 m
	Squirt Test:	<u>Pass</u> /Fail
Booster Pump Required:	Yes/No	Frost Protection: Aquaflow/ <u>Recirc</u> /Heat Trace/Bleeder
PRV Required:	Yes/No	Greased @ CC:
Water Meter Installed:	Yes/No	Continuity Test: <u>N/A</u> Pass/Fail

CLEARLY INDICATE LOCATION OF CC AND ROUTE OF PIPES ON DRAWING BELOW

1. Show main valves required to isolate this service.
2. All dimensions to be tied to property line
3. All dimensions to be metric
4. Depth @ property line is based on elevation after construction and changes may have occurred.

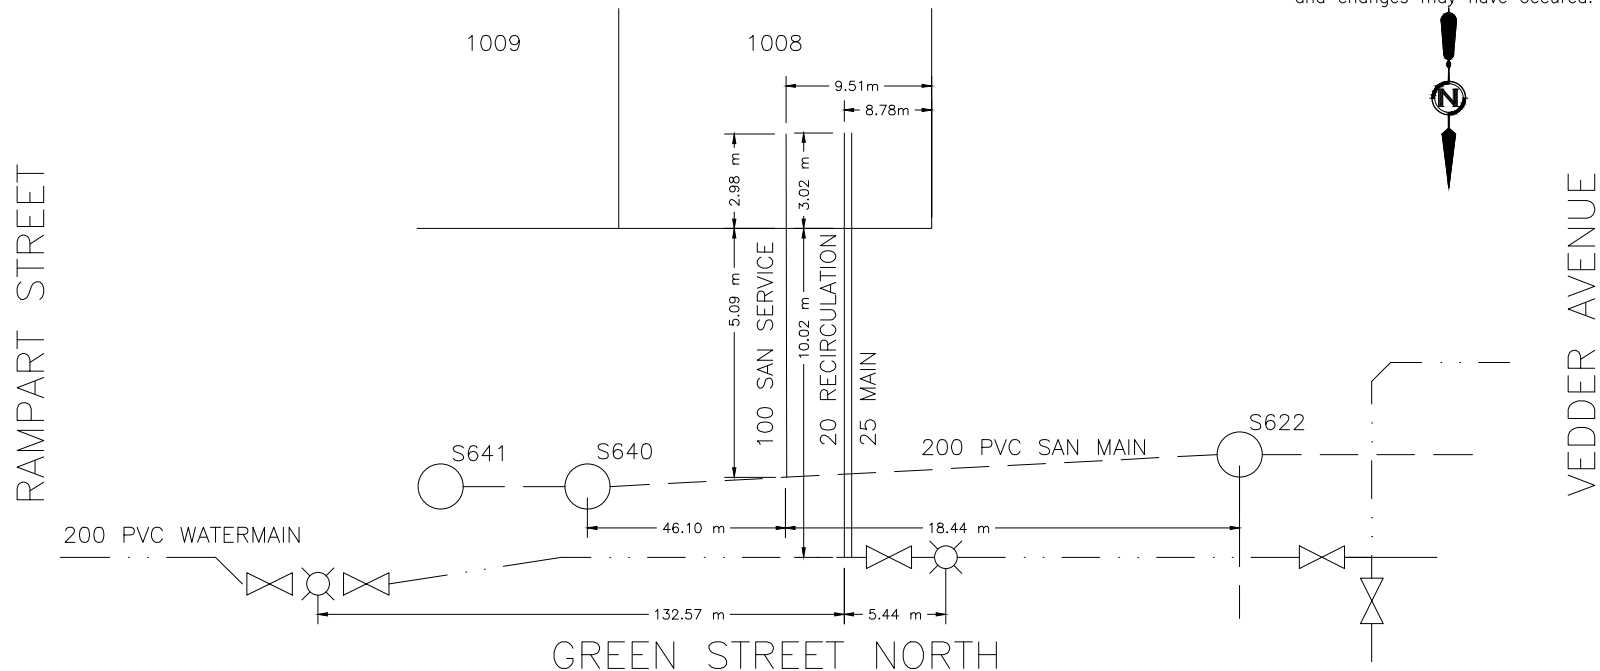



CITY OF WHITEHORSE

SERVICE CONNECTION RECORD

FIELD BOOK

No.

ADDRESS 34 SCOTIA LANE BLOCK LOT 1009

DATES


WATER

SEWER

On at Main 20200831	Depth at P/L: 2.55 m	2.79 m
On at Building	Depth at Main: 2.82 m	2.85 m
Frost Plug:	Pipe Size: 20 mm / 25 mm	100 mm
Memo:	Pipe Material: HDPE Insul. <u>Yes</u> /No	PVC Insul. Yes/ <u>No</u>
	Length from Main to P/L: 10.00 m	5.62 m
	Squirt Test: <u>Pass</u> /Fail	N/A
Booster Pump Required: Yes/No	Frost Protection: Aquaflo/ <u>Recirc</u> /Heat Trace/Bleeder	N/A
PRV Required: Yes/No	Greased @ CC: <u>Yes</u> /No	N/A
Water Meter Installed: Yes/No	Continuity Test: <u>N/A</u> Pass/Fail	N/A

CLEARLY INDICATE LOCATION OF CC AND ROUTE OF PIPES ON DRAWING BELOW

1. Show main valves required to isolate this service.
2. All dimensions to be tied to property line
3. All dimensions to be metric
4. Depth @ property line is based on elevation after construction and changes may have occurred.

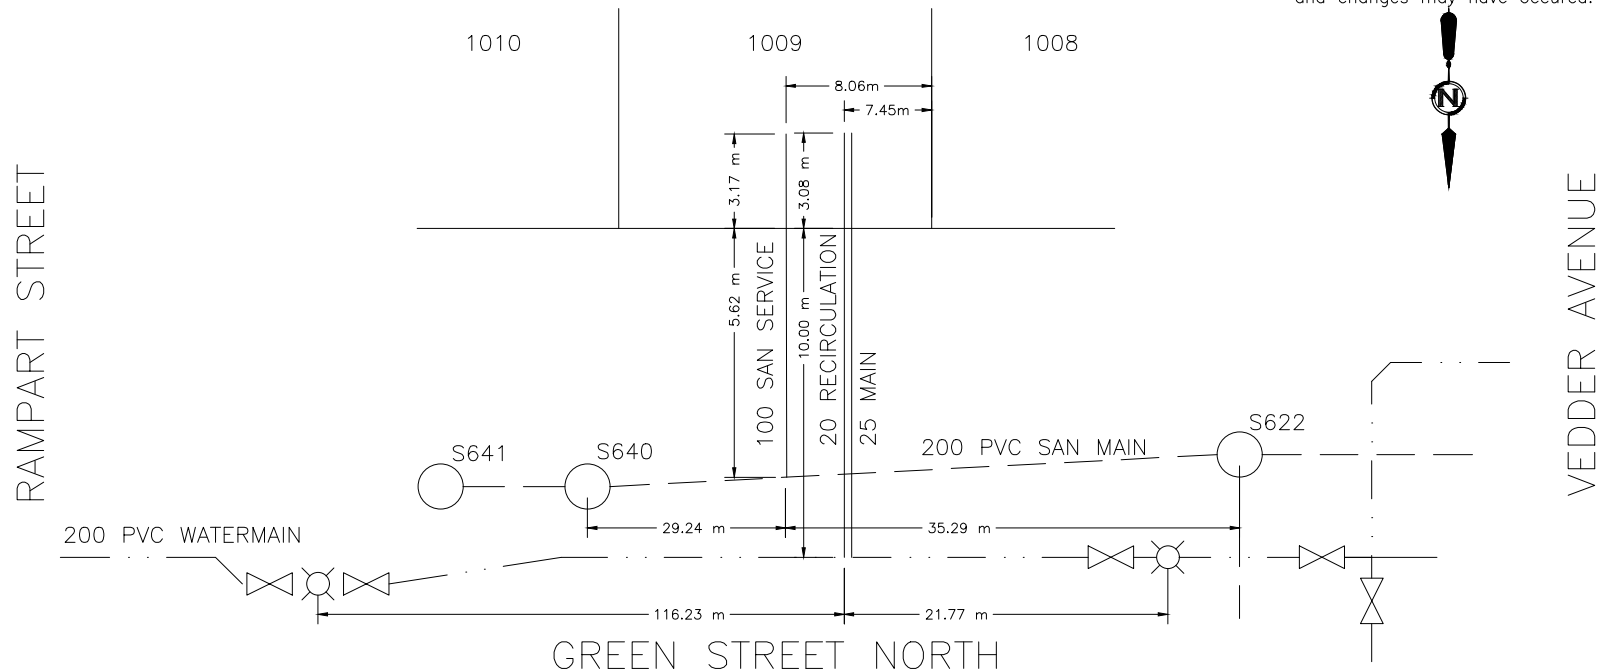



CITY OF WHITEHORSE

SERVICE CONNECTION RECORD

FIELD BOOK

No.

ADDRESS 32 SCOTIA LANE BLOCK LOT 1010

DATES


WATER

SEWER

On at Main 20200901	Depth at P/L: 2.55 m	2.61 m
On at Building	Depth at Main: 2.89 m	2.86 m
Frost Plug:	Pipe Size: 20 mm / 25 mm	100 mm
Memo:	Pipe Material: HDPE Insul. <u>Yes</u> /No	PVC Insul. Yes/ <u>No</u>
	Length from Main to P/L: 10.00 m	6.07 m
	Squirt Test: <u>Pass</u> /Fail	N/A
Booster Pump Required: Yes/No	Frost Protection: Aquaflo/ <u>Recirc</u> /Heat Trace/Bleeder	N/A
PRV Required: Yes/No	Greased @ CC: <u>Yes</u> /No	N/A
Water Meter Installed: Yes/No	Continuity Test: <u>N/A</u> Pass/Fail	N/A

CLEARLY INDICATE LOCATION OF CC AND ROUTE OF PIPES ON DRAWING BELOW

1. Show main valves required to isolate this service.
2. All dimensions to be tied to property line
3. All dimensions to be metric
4. Depth @ property line is based on elevation after construction and changes may have occurred.

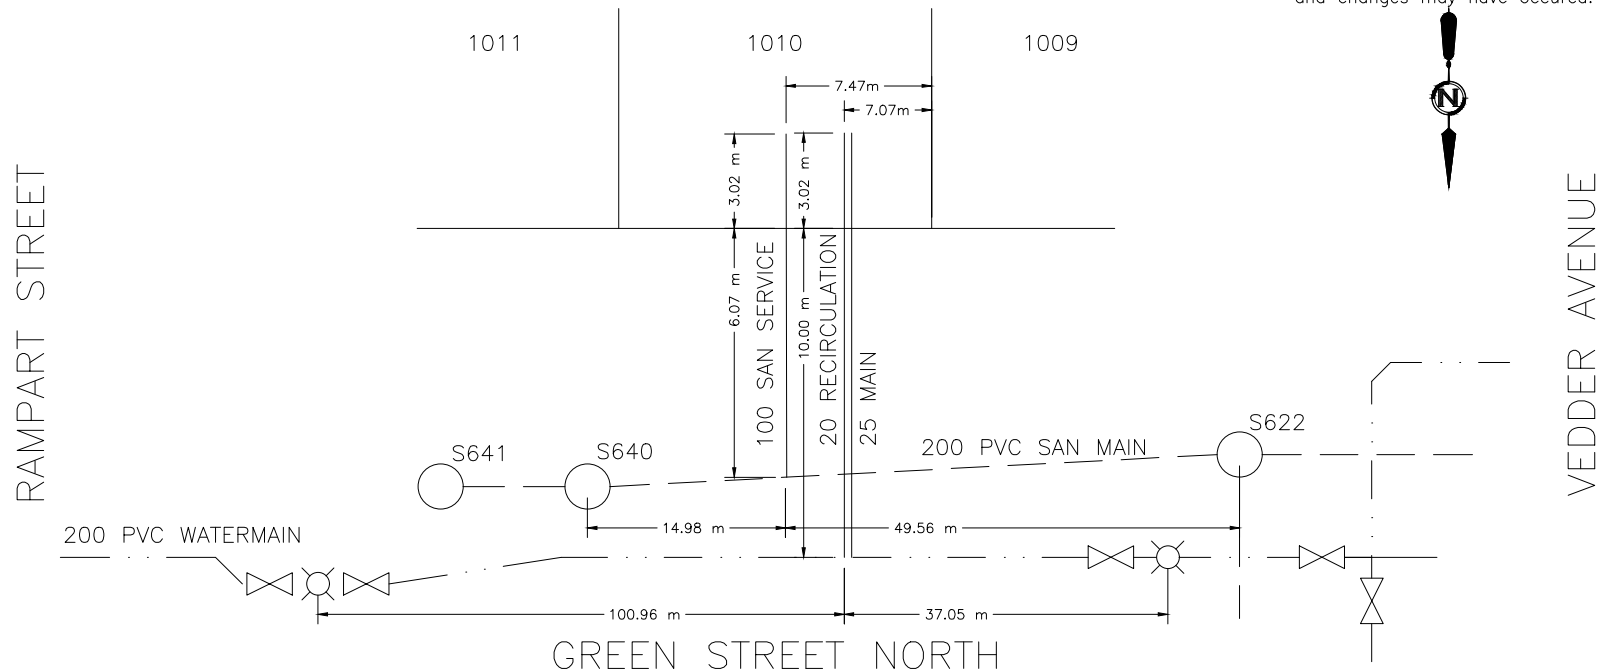



CITY OF WHITEHORSE

SERVICE CONNECTION RECORD

FIELD BOOK

No.

ADDRESS 30 SCOTIA LANE BLOCK LOT 1011

DATES


WATER

SEWER

On at Main 20200901	Depth at P/L: 2.53 m	2.57 m
On at Building	Depth at Main: 2.92 m	2.60 m
Frost Plug:	Pipe Size: 20 mm / 25 mm	100 mm
Memo:	Pipe Material: HDPE Insul. <u>Yes</u> /No	PVC Insul. Yes/ <u>No</u>
	Length from Main to P/L: 10.14 m	5.74 m
	Squirt Test: <u>Pass</u> /Fail	N/A
Booster Pump Required: Yes/No	Frost Protection: Aquaflo/ <u>Recirc</u> /Heat Trace/Bleeder	N/A
PRV Required: Yes/No	Greased @ CC: <u>Yes</u> /No	N/A
Water Meter Installed: Yes/No	Continuity Test: <u>N/A</u> Pass/Fail	N/A

CLEARLY INDICATE LOCATION OF CC AND ROUTE OF PIPES ON DRAWING BELOW

1. Show main valves required to isolate this service. 2. All dimensions to be tied to property line 3. All dimensions to be metric 4. Depth @ property line is based on elevation after construction and changes may have occurred.

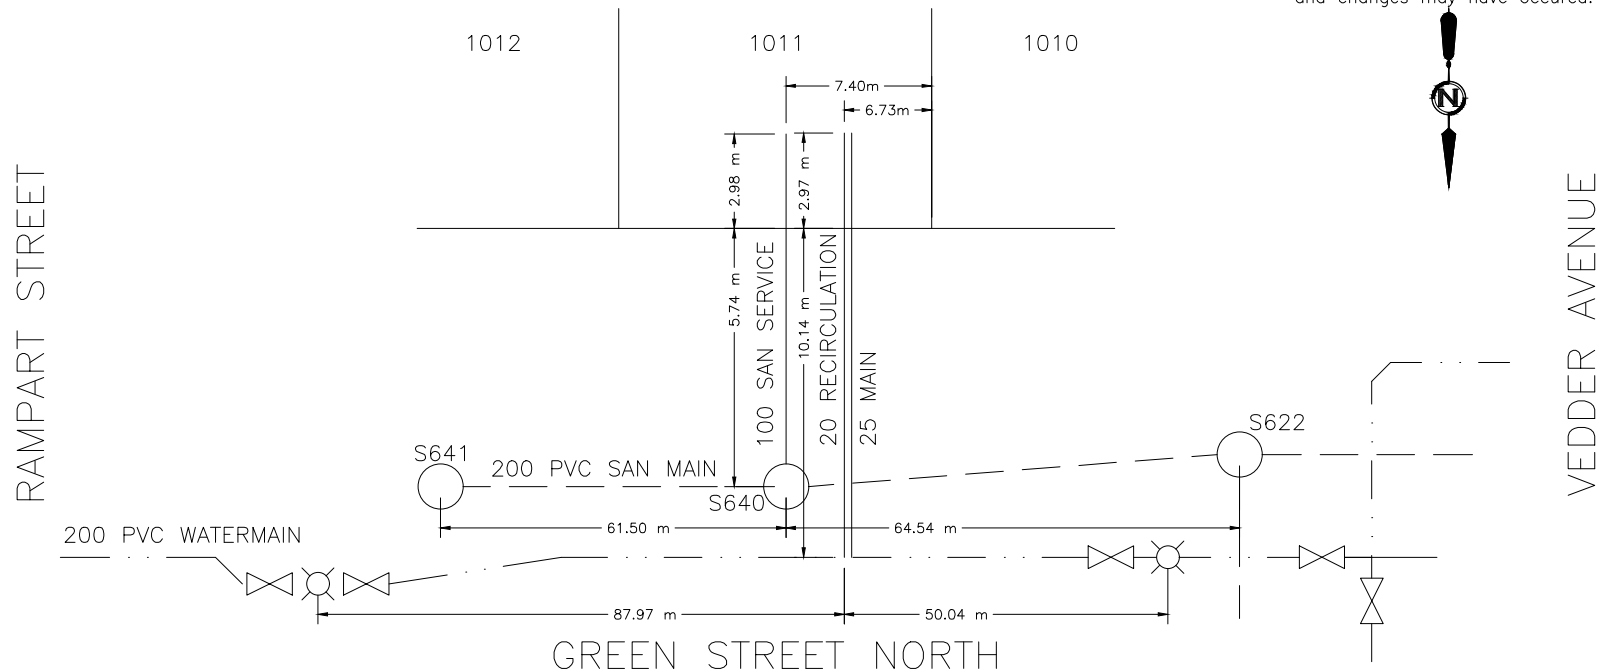



CITY OF WHITEHORSE

SERVICE CONNECTION RECORD

FIELD BOOK

No.

ADDRESS 28 SCOTIA LANE BLOCK LOT 1012

DATES


WATER

SEWER

On at Main 20200902	Depth at P/L: 2.64 m	2.64 m
On at Building	Depth at Main: 2.97 m	2.83 m
Frost Plug:	Pipe Size: 20 mm / 25 mm	100 mm
Memo:	Pipe Material: HDPE Insul. <u>Yes</u> /No	PVC Insul. Yes/ <u>No</u>
	Length from Main to P/L: 10.00 m	6.54 m
	Squirt Test: <u>Pass</u> /Fail	N/A
Booster Pump Required: Yes/No	Frost Protection: Aquaflo/ <u>Recirc</u> /Heat Trace/Bleeder	N/A
PRV Required: Yes/No	Greased @ CC: <u>Yes</u> /No	N/A
Water Meter Installed: Yes/No	Continuity Test: <u>N/A</u> Pass/Fail	N/A

CLEARLY INDICATE LOCATION OF CC AND ROUTE OF PIPES ON DRAWING BELOW

1. Show main valves required to isolate this service.
2. All dimensions to be tied to property line
3. All dimensions to be metric
4. Depth @ property line is based on elevation after construction and changes may have occurred.

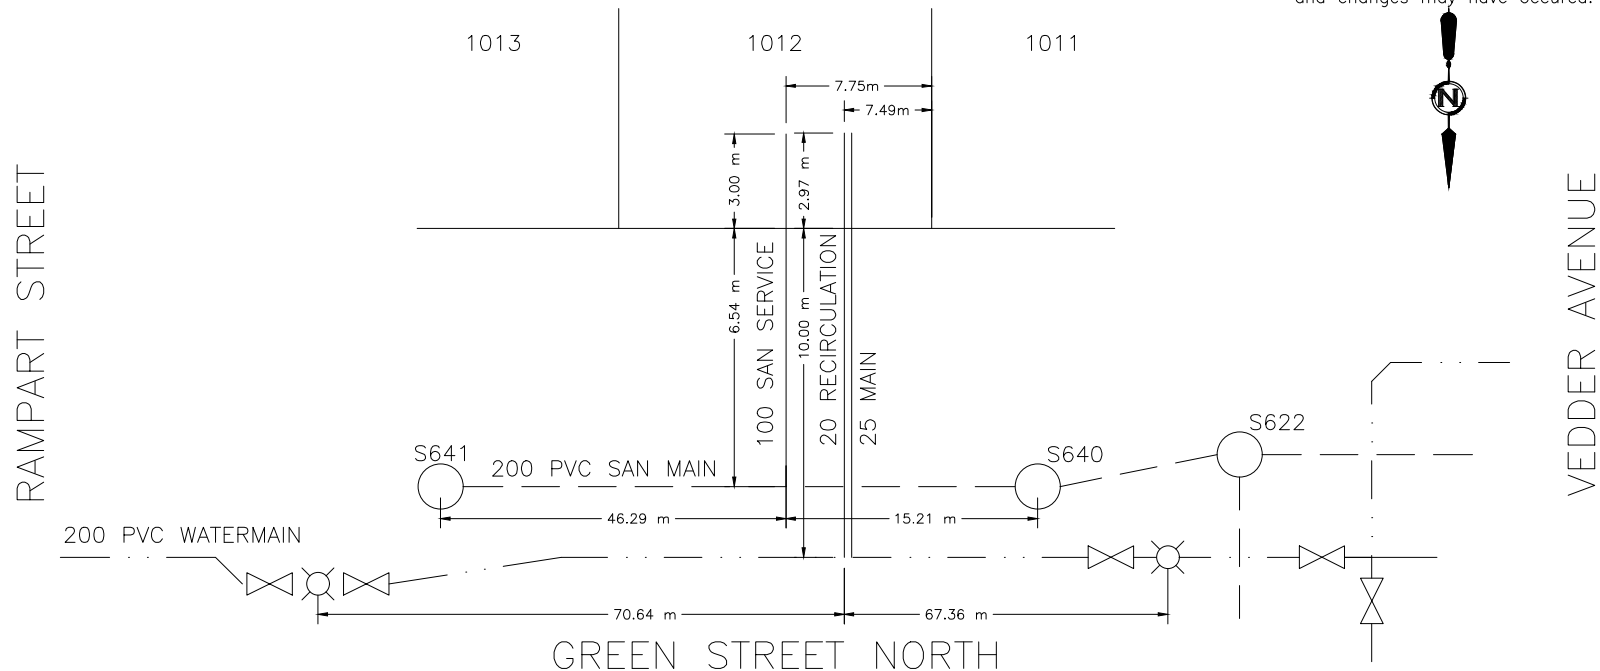



CITY OF WHITEHORSE

SERVICE CONNECTION RECORD

FIELD BOOK

No.

ADDRESS 26 SCOTIA LANE BLOCK LOT 1013

DATES


WATER

SEWER

On at Main 20200902	Depth at P/L: 2.61 m	2.66 m
On at Building	Depth at Main: 3.04 m	2.83 m
Frost Plug:	Pipe Size: 20 mm / 25 mm	100 mm
Memo:	Pipe Material: HDPE Insul. <u>Yes</u> /No	PVC Insul. Yes/ <u>No</u>
	Length from Main to P/L: 10.00 m	6.52 m
	Squirt Test: <u>Pass</u> /Fail	N/A
Booster Pump Required: Yes/No	Frost Protection: Aquaflo/ <u>Recirc</u> /Heat Trace/Bleeder	N/A
PRV Required: Yes/No	Greased @ CC: <u>Yes</u> /No	N/A
Water Meter Installed: Yes/No	Continuity Test: <u>N/A</u> Pass/Fail	N/A

CLEARLY INDICATE LOCATION OF CC AND ROUTE OF PIPES ON DRAWING BELOW

1. Show main valves required to isolate this service.
2. All dimensions to be tied to property line
3. All dimensions to be metric
4. Depth @ property line is based on elevation after construction and changes may have occurred.

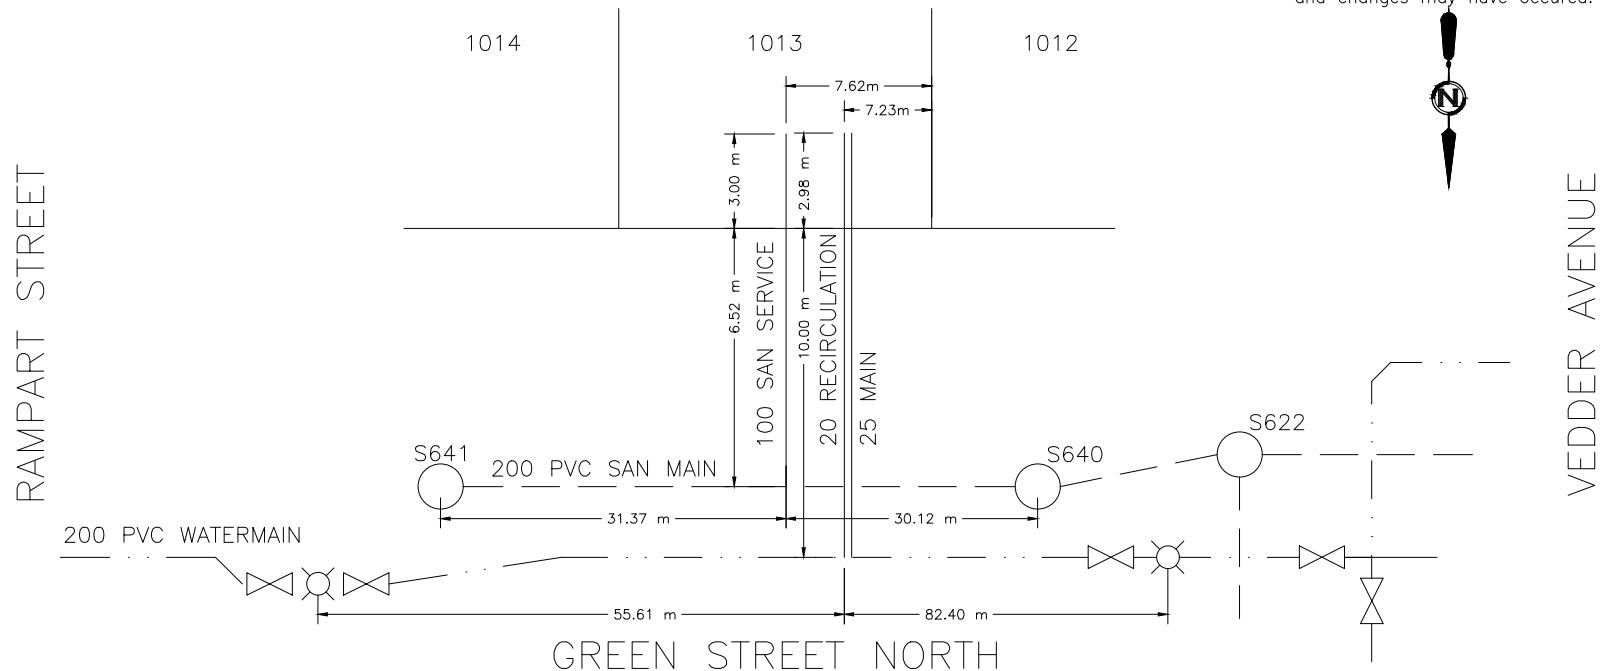



CITY OF WHITEHORSE

SERVICE CONNECTION RECORD

FIELD BOOK

No.

ADDRESS 24 SCOTIA LANE BLOCK LOT 1014

DATES


WATER

SEWER

On at Main 20200903	Depth at P/L: 2.49 m	2.56 m
On at Building	Depth at Main: 3.06 m	2.83 m
Frost Plug:	Pipe Size: 20 mm / 25 mm	100 mm
Memo:	Pipe Material: HDPE Insul. <u>Yes</u> /No	PVC Insul. Yes/ <u>No</u>
	Length from Main to P/L: 10.23 m	6.51 m
	Squirt Test: <u>Pass</u> /Fail	N/A
Booster Pump Required: Yes/No	Frost Protection: Aquaflo/ <u>Recirc</u> /Heat Trace/Bleeder	N/A
PRV Required: Yes/No	Greased @ CC: <u>Yes</u> /No	N/A
Water Meter Installed: Yes/No	Continuity Test: <u>N/A</u> Pass/Fail	N/A

CLEARLY INDICATE LOCATION OF CC AND ROUTE OF PIPES ON DRAWING BELOW

1. Show main valves required to isolate this service. 2. All dimensions to be tied to property line 3. All dimensions to be metric 4. Depth @ property line is based on elevation after construction and changes may have occurred.

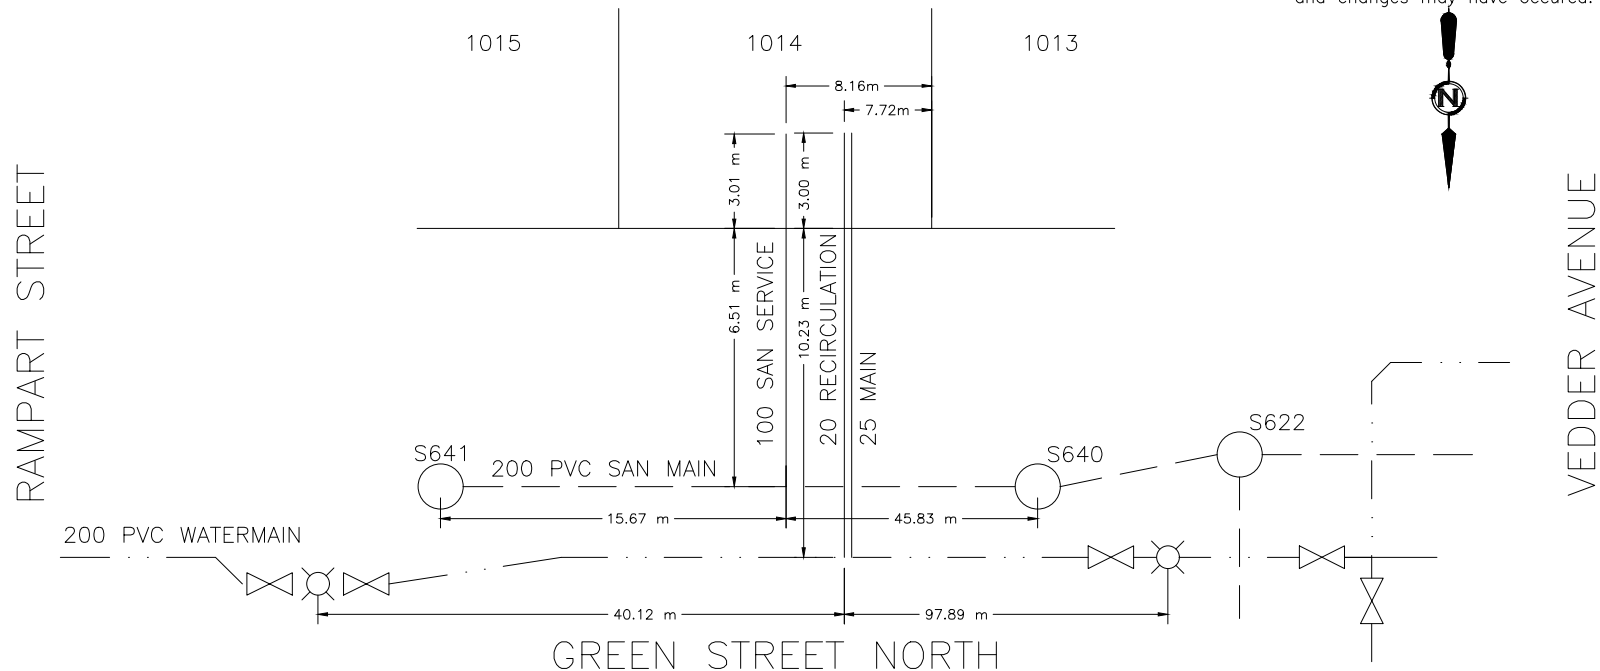



CITY OF WHITEHORSE

SERVICE CONNECTION RECORD

FIELD BOOK

No.

ADDRESS 22 SCOTIA LANE BLOCK LOT 1015

DATES


WATER

SEWER

On at Main 20200903	Depth at P/L: 2.55 m	2.52 m
On at Building	Depth at Main: 3.05 m	2.80 m
Frost Plug:	Pipe Size: 20 mm / 25 mm	100 mm
Memo:	Pipe Material: HDPE Insul. <u>Yes</u> /No	PVC Insul. Yes/ <u>No</u>
	Length from Main to P/L: 10.73 m	6.50 m
	Squirt Test: <u>Pass</u> /Fail	N/A
Booster Pump Required: Yes/No	Frost Protection: Aquaflo/ <u>Recirc</u> /Heat Trace/Bleeder	N/A
PRV Required: Yes/No	Greased @ CC: <u>Yes</u> /No	N/A
Water Meter Installed: Yes/No	Continuity Test: <u>N/A</u> Pass/Fail	N/A

CLEARLY INDICATE LOCATION OF CC AND ROUTE OF PIPES ON DRAWING BELOW

1. Show main valves required to isolate this service. 2. All dimensions to be tied to property line 3. All dimensions to be metric 4. Depth @ property line is based on elevation after construction and changes may have occurred.

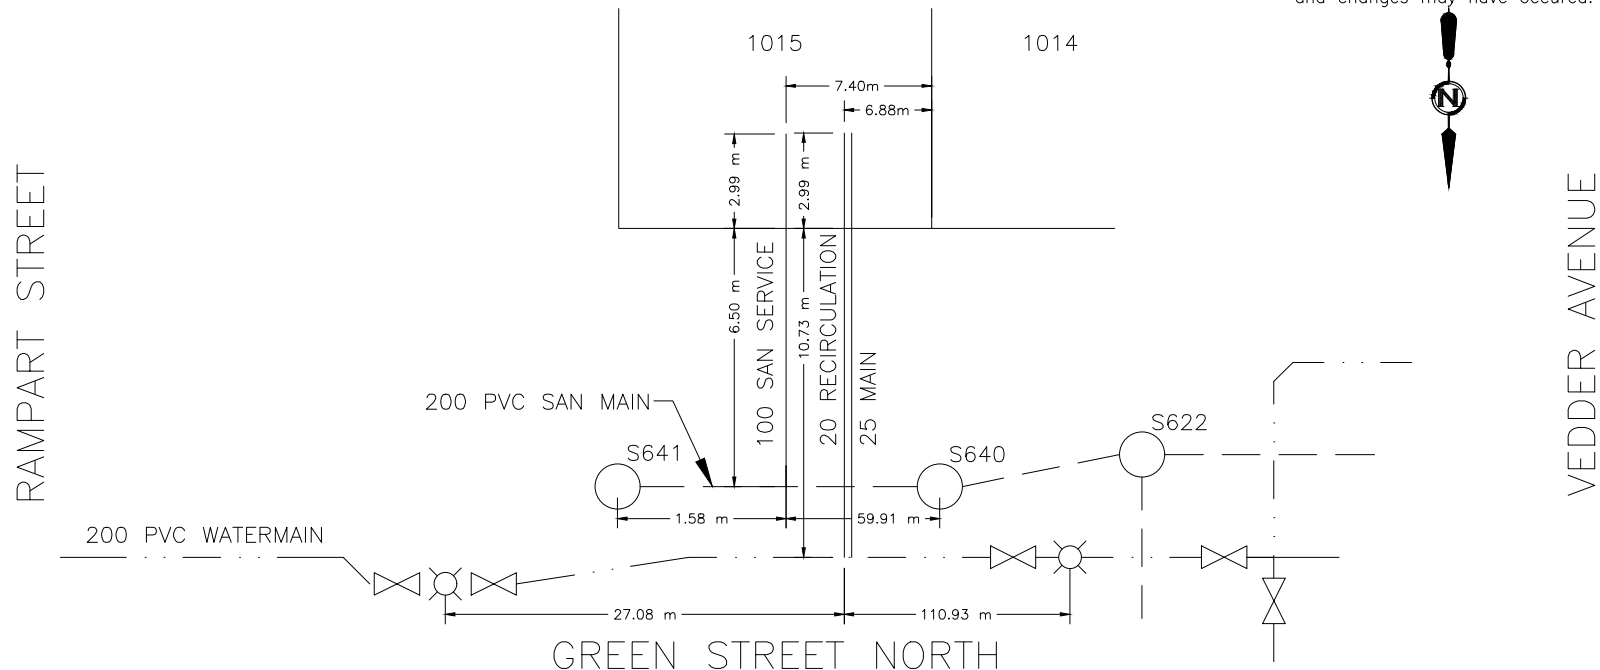



CITY OF WHITEHORSE

SERVICE CONNECTION RECORD

FIELD BOOK

No.

ADDRESS 171 WITCH HAZEL DRIVE BLOCK LOT 1016

DATES


WATER

SEWER

On at Main 20200914	Depth at P/L: 2.47 m	2.48 m
On at Building	Depth at Main: 2.84 m	2.84 m
Frost Plug:	Pipe Size: 20 mm / 25 mm	100 mm
Memo:	Pipe Material: HDPE Insul. <u>Yes</u> /No	PVC Insul. Yes/ <u>No</u>
	Length from Main to P/L: 7.37 m	10.22 m
	Squirt Test: <u>Pass</u> /Fail	N/A
Booster Pump Required: Yes/No	Frost Protection: Aquaflo/ <u>Recirc</u> /Heat Trace/Bleeder	N/A
PRV Required: Yes/No	Greased @ CC: <u>Yes</u> /No	N/A
Water Meter Installed: Yes/No	Continuity Test: <u>N/A</u> Pass/Fail	N/A

CLEARLY INDICATE LOCATION OF CC AND ROUTE OF PIPES ON DRAWING BELOW

1. Show main valves required to isolate this service. 2. All dimensions to be tied to property line 3. All dimensions to be metric 4. Depth @ property line is based on elevation after construction and changes may have occurred.

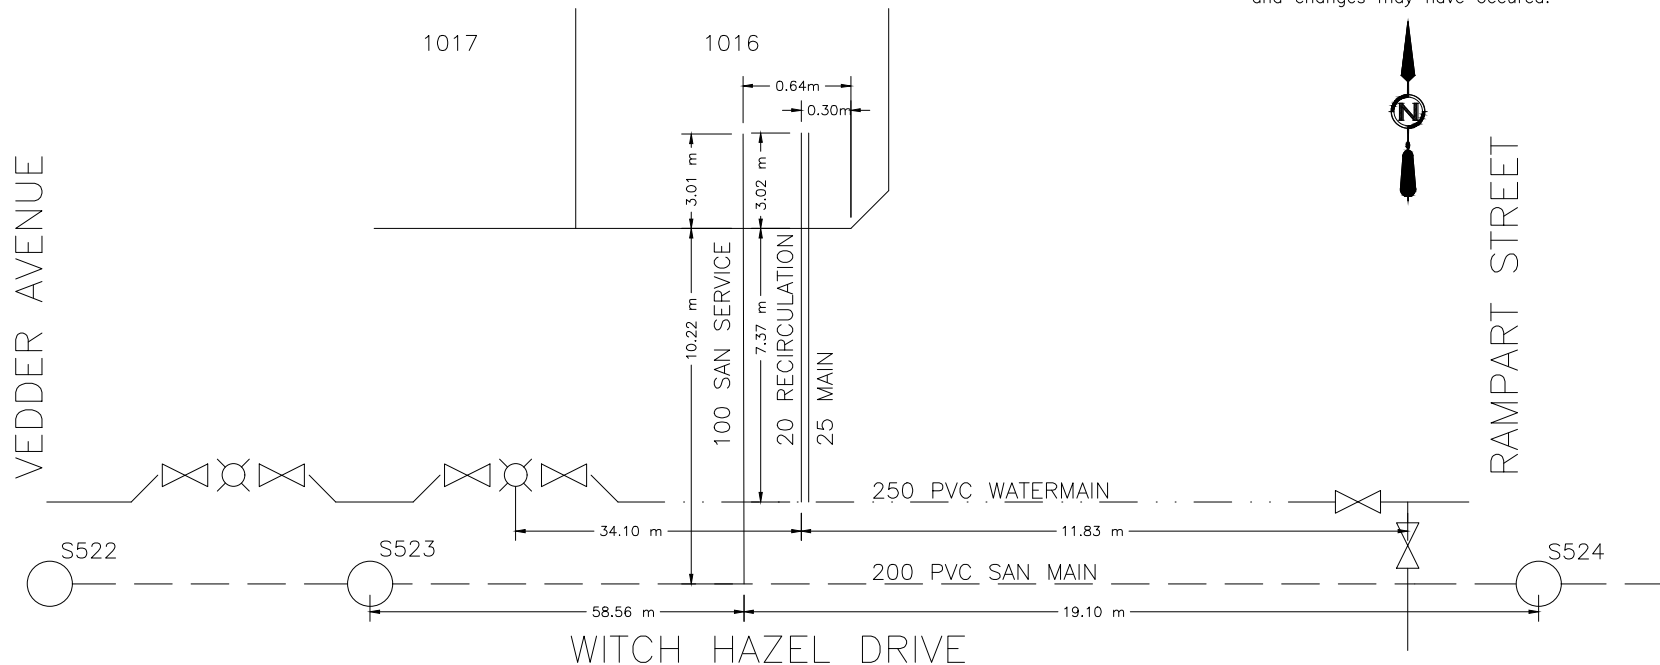



CITY OF WHITEHORSE

SERVICE CONNECTION RECORD

FIELD BOOK

No.

ADDRESS 173 WITCH HAZEL DRIVE BLOCK LOT 1017

DATES


WATER

SEWER

On at Main 20200912	Depth at P/L: 2.43 m	2.49 m
On at Building	Depth at Main: 2.87 m	3.03 m
Frost Plug:	Pipe Size: 20 mm / 25 mm	100 mm
Memo:	Pipe Material: HDPE Insul. <u>Yes</u> /No	PVC Insul. Yes/ <u>No</u>
	Length from Main to P/L: 7.35 m	10.35 m
	Squirt Test: <u>Pass</u> /Fail	N/A
Booster Pump Required: Yes/No	Frost Protection: Aquaflow/ <u>Recirc</u> /Heat Trace/Bleeder	N/A
PRV Required: Yes/No	Greased @ CC: <u>Yes</u> /No	N/A
Water Meter Installed: Yes/No	Continuity Test: <u>N/A</u> Pass/Fail	N/A

CLEARLY INDICATE LOCATION OF CC AND ROUTE OF PIPES ON DRAWING BELOW

1. Show main valves required to isolate this service. 2. All dimensions to be tied to property line 3. All dimensions to be metric 4. Depth @ property line is based on elevation after construction and changes may have occurred.

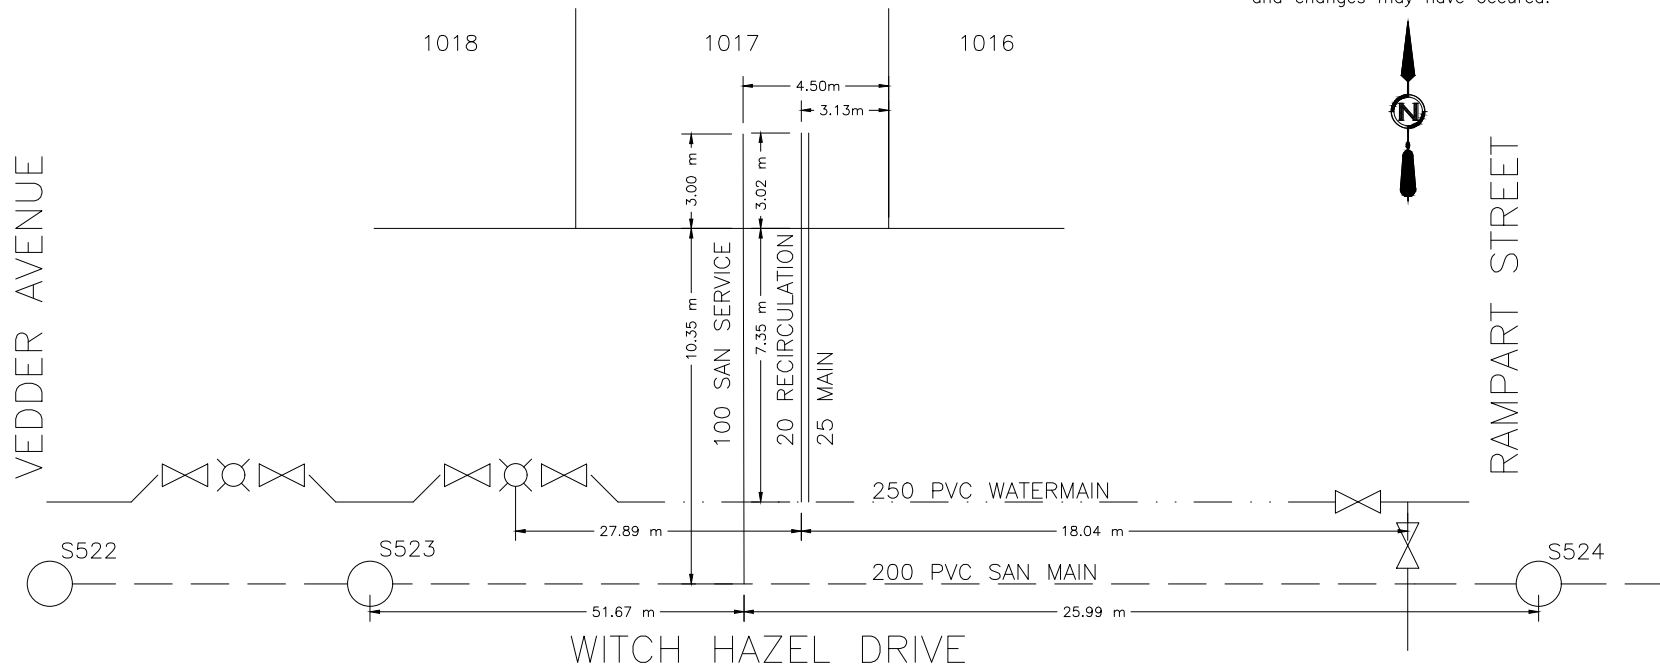



CITY OF WHITEHORSE

SERVICE CONNECTION RECORD

FIELD BOOK

No.

ADDRESS 175 WITCH HAZEL DRIVE BLOCK LOT 1018

DATES


WATER

SEWER

On at Main 20200915	Depth at P/L: 2.46 m	2.50 m
On at Building	Depth at Main: 2.84 m	3.13 m
Frost Plug:	Pipe Size: 20 mm / 25 mm	100 mm
Memo:	Pipe Material: HDPE Insul. <u>Yes</u> /No	PVC Insul. Yes/ <u>No</u>
	Length from Main to P/L: 7.35 m	10.35 m
	Squirt Test: <u>Pass</u> /Fail	N/A
Booster Pump Required: Yes/No	Frost Protection: Aquaflo/ <u>Recirc</u> /Heat Trace/Bleeder	N/A
PRV Required: Yes/No	Greased @ CC: <u>Yes</u> /No	N/A
Water Meter Installed: Yes/No	Continuity Test: <u>N/A</u> Pass/Fail	N/A

CLEARLY INDICATE LOCATION OF CC AND ROUTE OF PIPES ON DRAWING BELOW

1. Show main valves required to isolate this service. 2. All dimensions to be tied to property line 3. All dimensions to be metric 4. Depth @ property line is based on elevation after construction and changes may have occurred.

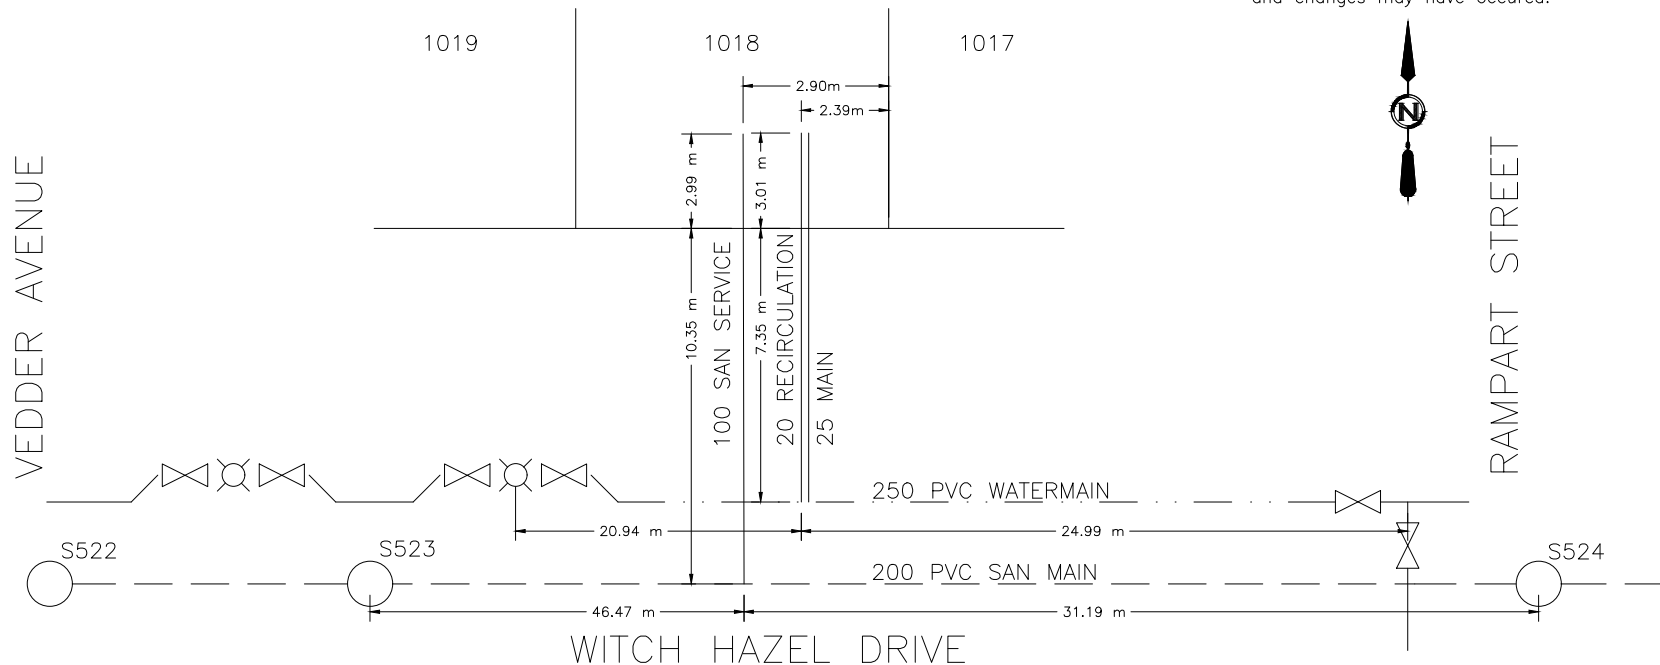



CITY OF WHITEHORSE

SERVICE CONNECTION RECORD

FIELD BOOK

No.

ADDRESS 177 WITCH HAZEL DRIVE BLOCK LOT 1019

DATES


WATER

SEWER

On at Main 20200914	Depth at P/L: 2.44 m	2.53 m
On at Building	Depth at Main: 2.89 m	3.31 m
Frost Plug:	Pipe Size: 20 mm / 25 mm	100 mm
Memo:	Pipe Material: HDPE Insul. <u>Yes</u> /No	PVC Insul. Yes/ <u>No</u>
	Length from Main to P/L: 7.35 m	10.35 m
	Squirt Test: <u>Pass</u> /Fail	N/A
Booster Pump Required: Yes/No	Frost Protection: Aquaflow/ <u>Recirc</u> /Heat Trace/Bleeder	N/A
PRV Required: Yes/No	Greased @ CC: <u>Yes</u> /No	N/A
Water Meter Installed: Yes/No	Continuity Test: <u>N/A</u> Pass/Fail	N/A

CLEARLY INDICATE LOCATION OF CC AND ROUTE OF PIPES ON DRAWING BELOW

1. Show main valves required to isolate this service. 2. All dimensions to be tied to property line 3. All dimensions to be metric 4. Depth @ property line is based on elevation after construction and changes may have occurred.

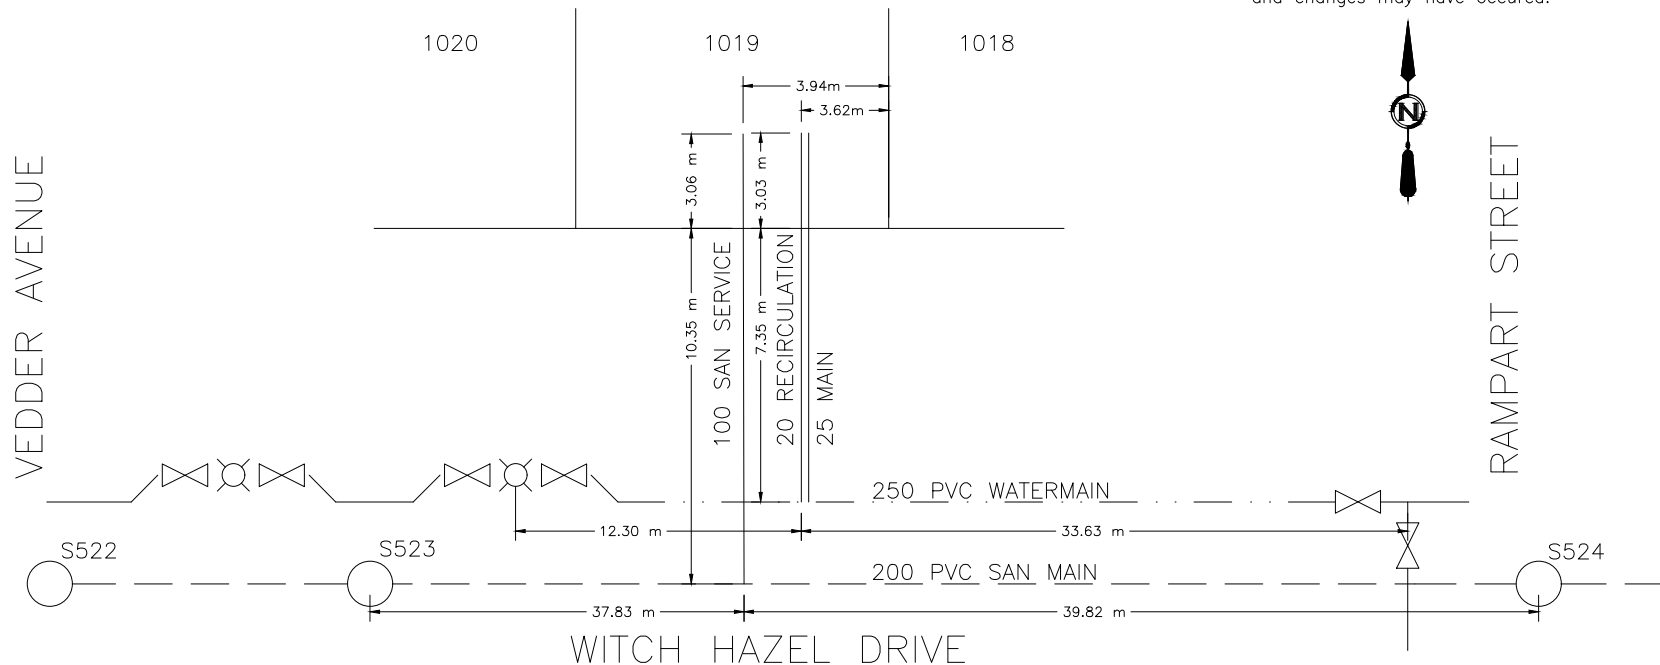



CITY OF WHITEHORSE

SERVICE CONNECTION RECORD

FIELD BOOK

No.

ADDRESS 179 WITCH HAZEL DRIVE BLOCK LOT 1020

DATES


WATER

SEWER

On at Main 20200910	Depth at P/L: 2.47 m	2.49 m
On at Building	Depth at Main: 2.93 m	3.46 m
Frost Plug:	Pipe Size: 20 mm / 25 mm	100 mm
Memo:	Pipe Material: HDPE Insul. <u>Yes</u> /No	PVC Insul. Yes/ <u>No</u>
	Length from Main to P/L: 7.36 m	10.35 m
	Squirt Test: <u>Pass</u> /Fail	N/A
Booster Pump Required: Yes/No	Frost Protection: Aquaflow/ <u>Recirc</u> /Heat Trace/Bleeder	N/A
PRV Required: Yes/No	Greased @ CC: <u>Yes</u> /No	N/A
Water Meter Installed: Yes/No	Continuity Test: <u>N/A</u> Pass/Fail	N/A

CLEARLY INDICATE LOCATION OF CC AND ROUTE OF PIPES ON DRAWING BELOW

1. Show main valves required to isolate this service. 2. All dimensions to be tied to property line 3. All dimensions to be metric 4. Depth @ property line is based on elevation after construction and changes may have occurred.

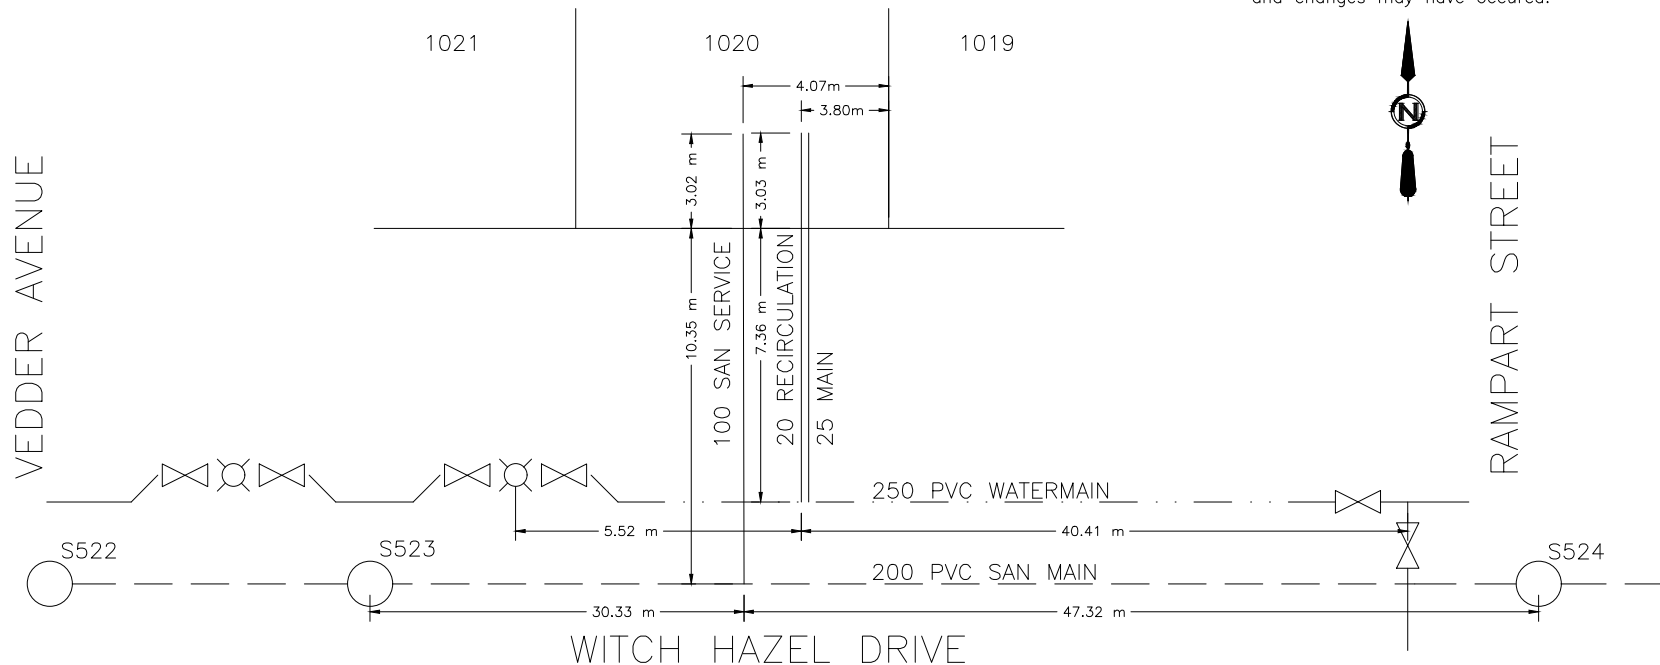



CITY OF WHITEHORSE

SERVICE CONNECTION RECORD

FIELD BOOK

No.

ADDRESS 181 WITCH HAZEL DRIVE BLOCK LOT 1021

DATES


WATER

SEWER

On at Main 20200914	Depth at P/L: 2.45 m	2.45 m
On at Building	Depth at Main: 2.87 m	3.69 m
Frost Plug:	Pipe Size: 20 mm / 25 mm	100 mm
Memo:	Pipe Material: HDPE Insul. <u>Yes</u> /No	PVC Insul. Yes/ <u>No</u>
	Length from Main to P/L: 6.03 m	10.35 m
	Squirt Test: <u>Pass</u> /Fail	N/A
Booster Pump Required: Yes/No	Frost Protection: Aquaflow/ <u>Recirc</u> /Heat Trace/Bleeder	N/A
PRV Required: Yes/No	Greased @ CC: <u>Yes</u> /No	N/A
Water Meter Installed: Yes/No	Continuity Test: <u>N/A</u> Pass/Fail	N/A

CLEARLY INDICATE LOCATION OF CC AND ROUTE OF PIPES ON DRAWING BELOW

1. Show main valves required to isolate this service. 2. All dimensions to be tied to property line 3. All dimensions to be metric 4. Depth @ property line is based on elevation after construction and changes may have occurred.

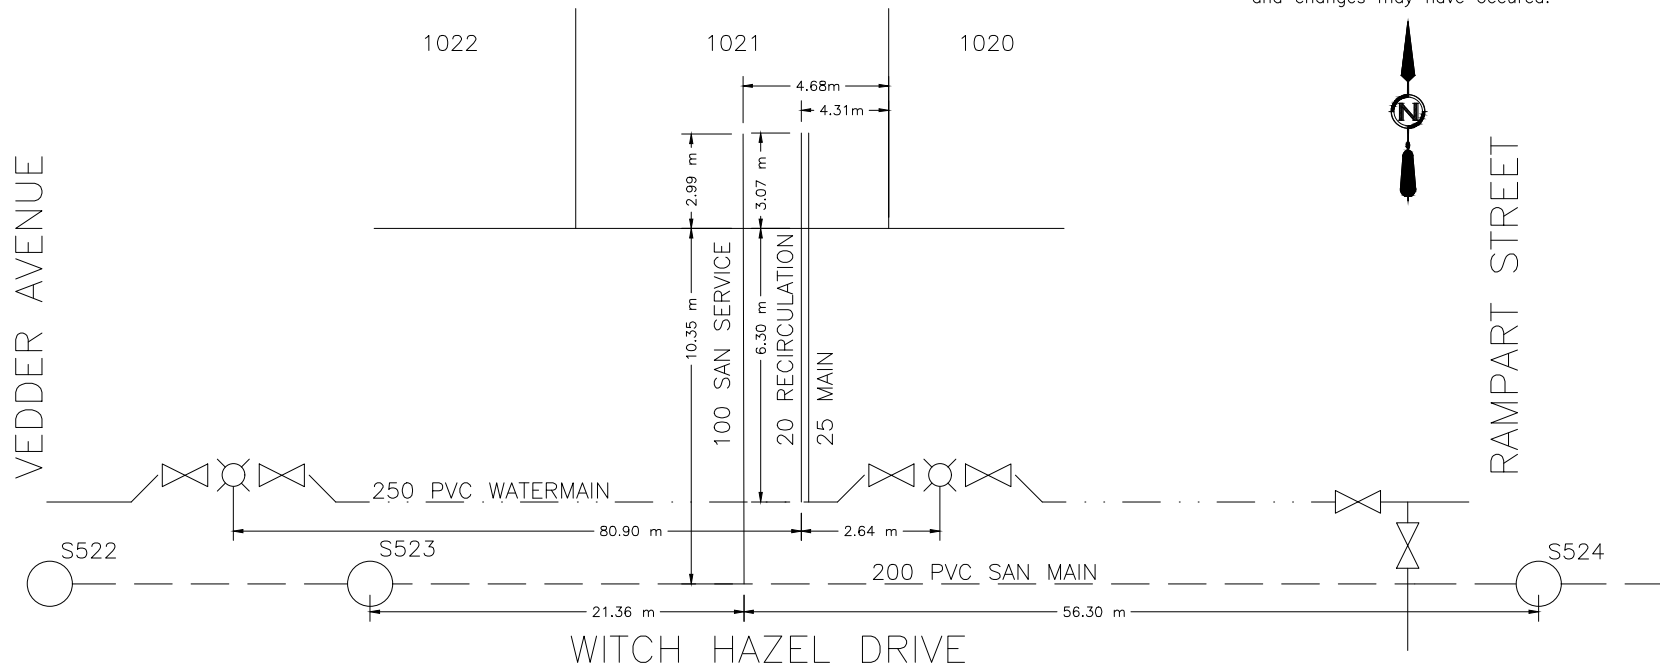



CITY OF WHITEHORSE

SERVICE CONNECTION RECORD

FIELD BOOK

No.

ADDRESS 183 WITCH HAZEL DRIVE BLOCK LOT 1022

DATES


WATER

SEWER

On at Main 20200911	Depth at P/L: 2.52 m	2.55 m
On at Building	Depth at Main: 2.91 m	3.82 m
Frost Plug:	Pipe Size: 20 mm / 25 mm	100 mm
Memo:	Pipe Material: HDPE Insul. <u>Yes</u> /No	PVC Insul. Yes/ <u>No</u>
	Length from Main to P/L: 7.34 m	10.35 m
	Squirt Test: <u>Pass</u> /Fail	N/A
Booster Pump Required: Yes/No	Frost Protection: Aquaflow/ <u>Recirc</u> /Heat Trace/Bleeder	N/A
PRV Required: Yes/No	Greased @ CC: <u>Yes</u> /No	N/A
Water Meter Installed: Yes/No	Continuity Test: <u>N/A</u> Pass/Fail	N/A

CLEARLY INDICATE LOCATION OF CC AND ROUTE OF PIPES ON DRAWING BELOW

1. Show main valves required to isolate this service. 2. All dimensions to be tied to property line 3. All dimensions to be metric 4. Depth @ property line is based on elevation after construction and changes may have occurred.

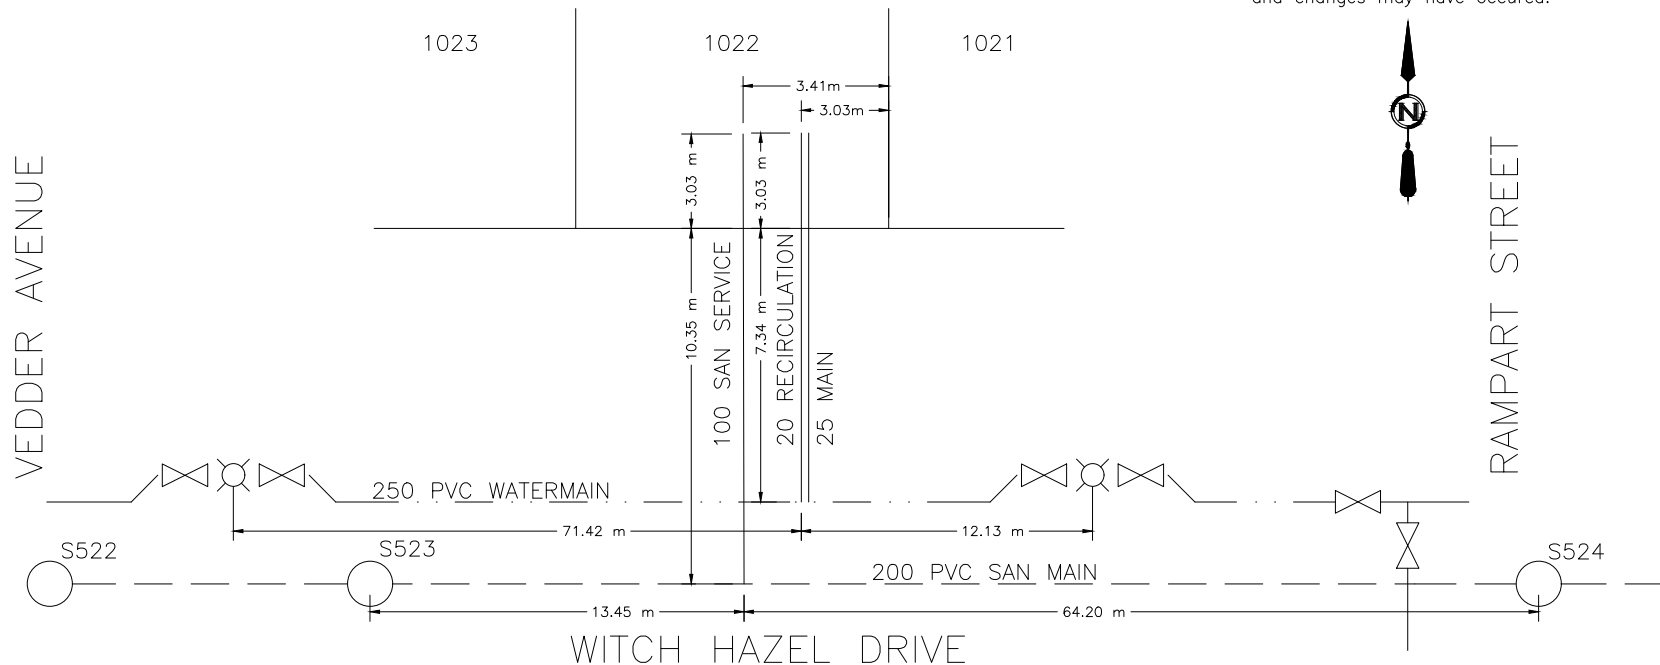



CITY OF WHITEHORSE

SERVICE CONNECTION RECORD

FIELD BOOK

No.

ADDRESS 185 WITCH HAZEL DRIVE BLOCK LOT 1023

DATES


WATER

SEWER

On at Main 20200911	Depth at P/L: 2.53 m	2.58 m
On at Building	Depth at Main: 2.95 m	4.03 m
Frost Plug:	Pipe Size: 20 mm / 25 mm	100 mm
Memo:	Pipe Material: HDPE Insul. <u>Yes</u> /No	PVC Insul. Yes/ <u>No</u>
	Length from Main to P/L: 7.34 m	10.35 m
	Squirt Test: <u>Pass</u> /Fail	N/A
Booster Pump Required: Yes/No	Frost Protection: Aquaflo/ <u>Recirc</u> /Heat Trace/Bleeder	N/A
PRV Required: Yes/No	Greased @ CC: <u>Yes</u> /No	N/A
Water Meter Installed: Yes/No	Continuity Test: <u>N/A</u> Pass/Fail	N/A

CLEARLY INDICATE LOCATION OF CC AND ROUTE OF PIPES ON DRAWING BELOW

1. Show main valves required to isolate this service. 2. All dimensions to be tied to property line 3. All dimensions to be metric 4. Depth @ property line is based on elevation after construction and changes may have occurred.

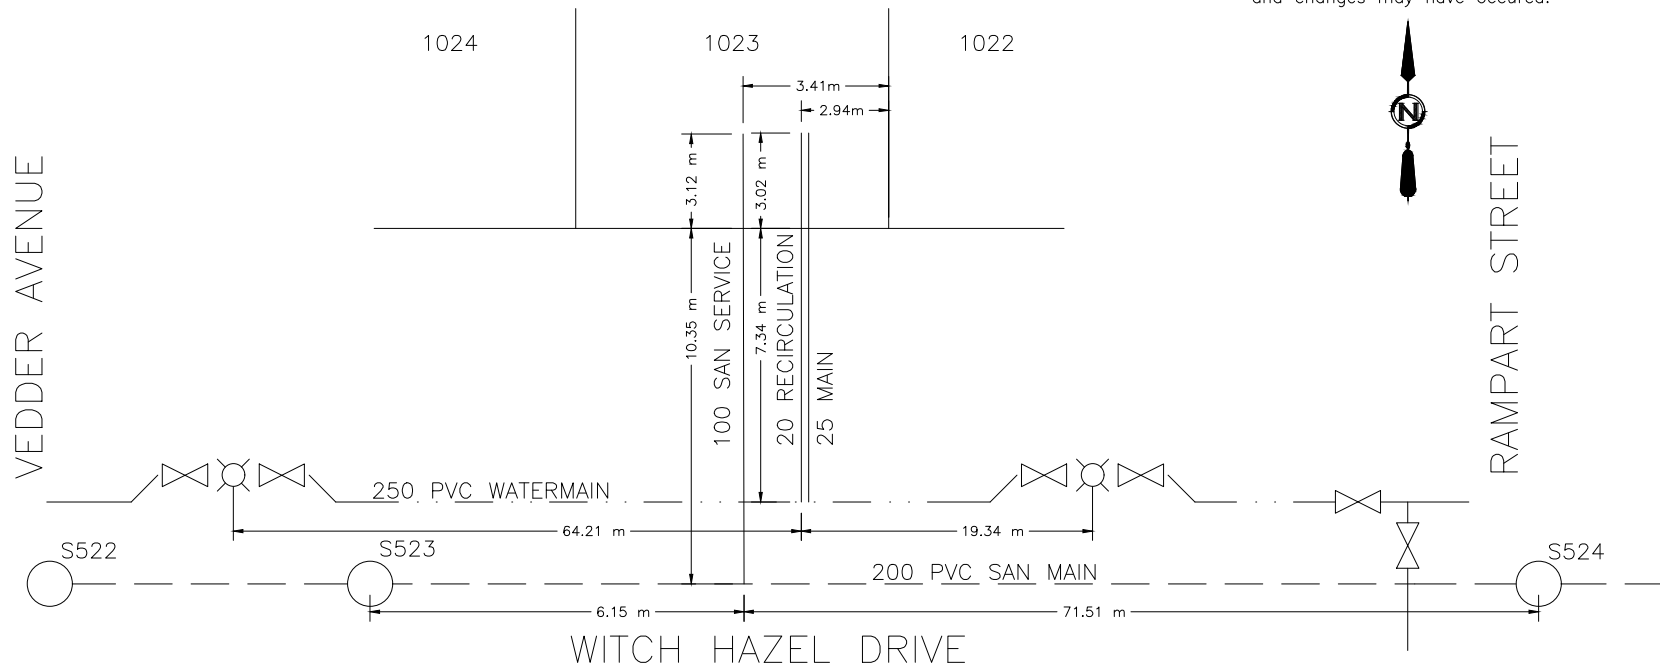



CITY OF WHITEHORSE

SERVICE CONNECTION RECORD

FIELD BOOK

No.

ADDRESS 187 WITCH HAZEL DRIVE BLOCK LOT 1024

DATES


WATER

SEWER

On at Main 20200904	Depth at P/L: 2.51 m	2.57 m
On at Building	Depth at Main: 2.96 m	3.84 m
Frost Plug:	Pipe Size: 20 mm / 25 mm	100 mm
Memo:	Pipe Material: HDPE Insul. <u>Yes</u> /No	PVC Insul. Yes/ <u>No</u>
	Length from Main to P/L: 7.33 m	10.36 m
	Squirt Test: <u>Pass</u> /Fail	N/A
Booster Pump Required: Yes/No	Frost Protection: Aquaflow/ <u>Recirc</u> /Heat Trace/Bleeder	N/A
PRV Required: Yes/No	Greased @ CC: <u>Yes</u> /No	N/A
Water Meter Installed: Yes/No	Continuity Test: <u>N/A</u> Pass/Fail	N/A

CLEARLY INDICATE LOCATION OF CC AND ROUTE OF PIPES ON DRAWING BELOW

1. Show main valves required to isolate this service. 2. All dimensions to be tied to property line 3. All dimensions to be metric 4. Depth @ property line is based on elevation after construction and changes may have occurred.

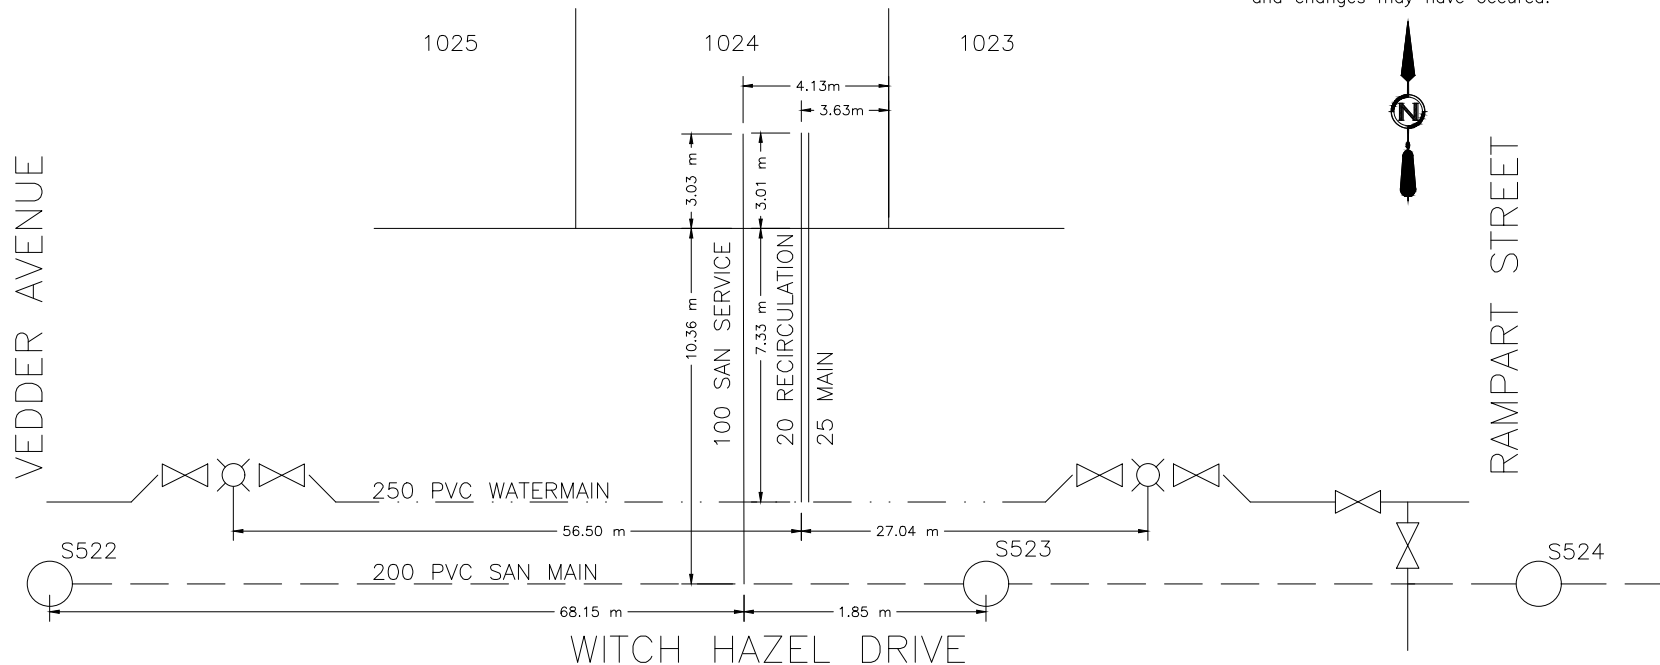



CITY OF WHITEHORSE

SERVICE CONNECTION RECORD

FIELD BOOK

No.

ADDRESS 189 WITCH HAZEL DRIVE BLOCK LOT 1025

DATES


WATER

SEWER

On at Main 20200818	Depth at P/L: 2.58 m	2.58 m
On at Building	Depth at Main: 2.97 m	3.89 m
Frost Plug:	Pipe Size: 20 mm / 25 mm	100 mm
Memo:	Pipe Material: HDPE Insul. <u>Yes</u> /No	PVC Insul. Yes/ <u>No</u>
	Length from Main to P/L: 7.34 m	10.35 m
	Squirt Test: <u>Pass</u> /Fail	N/A
Booster Pump Required: Yes/No	Frost Protection: Aquaflo/ <u>Recirc</u> /Heat Trace/Bleeder	N/A
PRV Required: Yes/No	Greased @ CC: <u>Yes</u> /No	N/A
Water Meter Installed: Yes/No	Continuity Test: <u>N/A</u> Pass/Fail	N/A

CLEARLY INDICATE LOCATION OF CC AND ROUTE OF PIPES ON DRAWING BELOW

1. Show main valves required to isolate this service. 2. All dimensions to be tied to property line 3. All dimensions to be metric 4. Depth @ property line is based on elevation after construction and changes may have occurred.

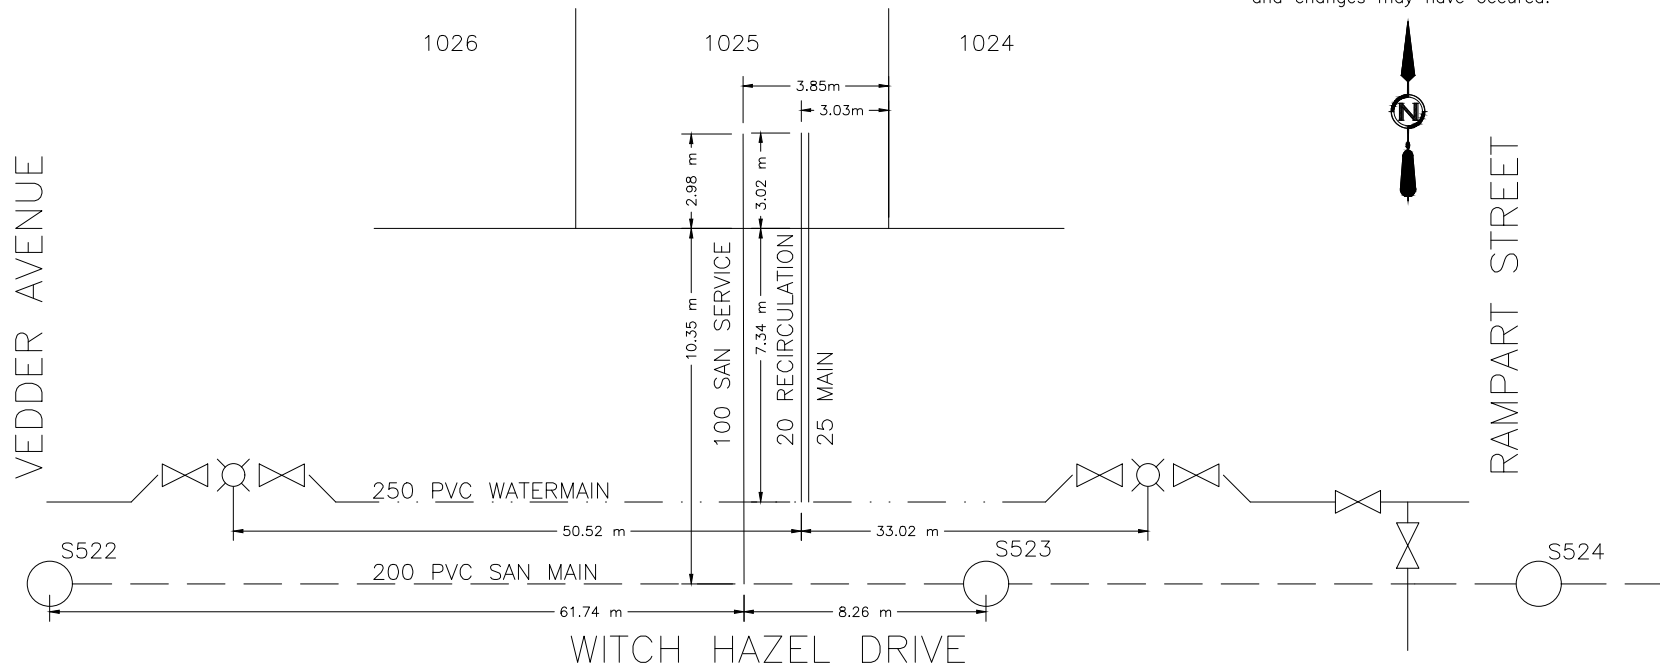



CITY OF WHITEHORSE

SERVICE CONNECTION RECORD

FIELD BOOK

No.

ADDRESS 191 WITCH HAZEL DRIVE BLOCK LOT 1026

DATES


WATER

SEWER

On at Main 20200813	Depth at P/L: 2.47 m	2.53 m
On at Building	Depth at Main: 3.01 m	4.00 m
Frost Plug:	Pipe Size: 20 mm / 25 mm	100 mm
Memo:	Pipe Material: HDPE Insul. <u>Yes</u> /No	PVC Insul. Yes/ <u>No</u>
	Length from Main to P/L: 7.32 m	10.35 m
	Squirt Test: <u>Pass</u> /Fail	N/A
Booster Pump Required: Yes/No	Frost Protection: Aquaflow/ <u>Recirc</u> /Heat Trace/Bleeder	N/A
PRV Required: Yes/No	Greased @ CC: <u>Yes</u> /No	N/A
Water Meter Installed: Yes/No	Continuity Test: <u>N/A</u> Pass/Fail	N/A

CLEARLY INDICATE LOCATION OF CC AND ROUTE OF PIPES ON DRAWING BELOW

1. Show main valves required to isolate this service. 2. All dimensions to be tied to property line 3. All dimensions to be metric 4. Depth @ property line is based on elevation after construction and changes may have occurred.

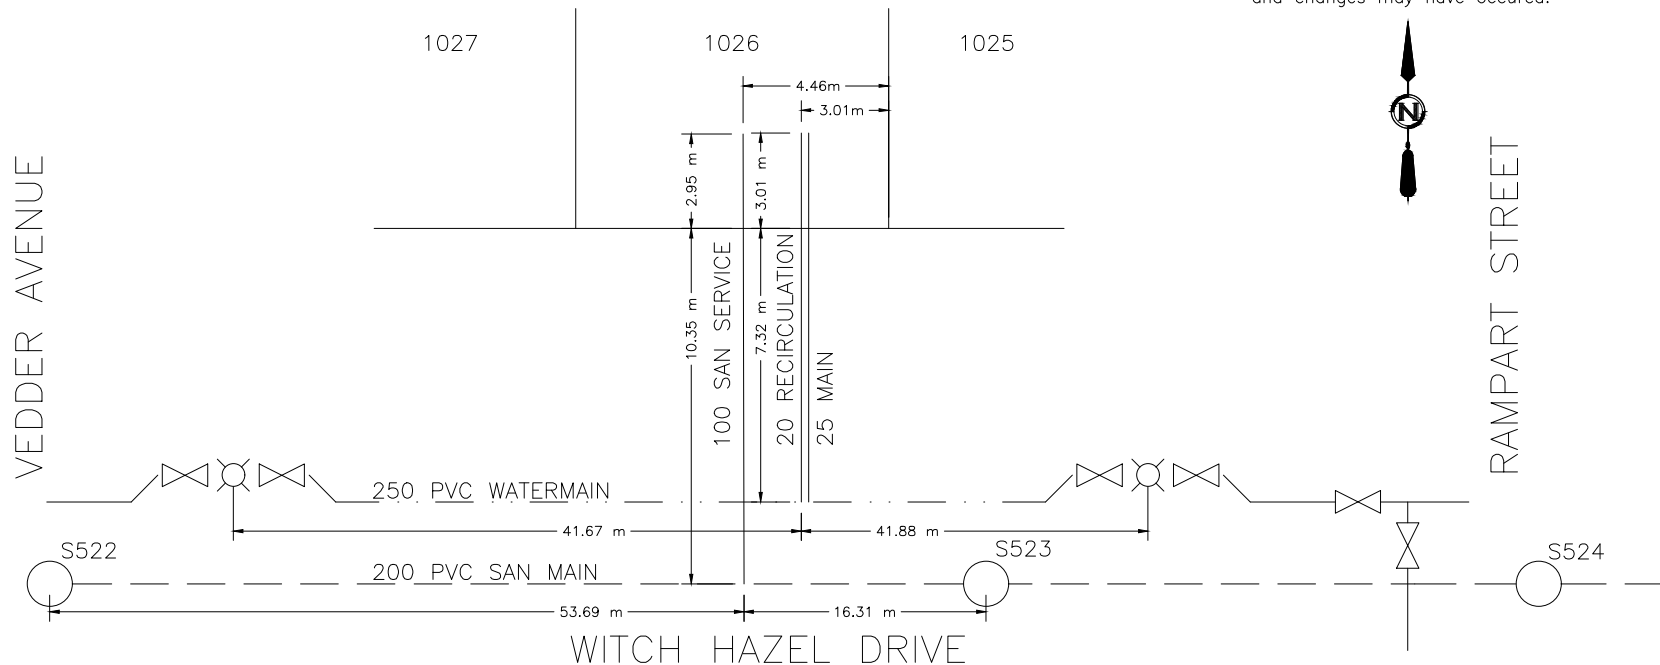



CITY OF WHITEHORSE

SERVICE CONNECTION RECORD

FIELD BOOK

No.

ADDRESS 193 WITCH HAZEL DRIVE BLOCK LOT 1027

DATES


WATER

SEWER

On at Main 20200814	Depth at P/L: 2.51 m	2.51 m
On at Building	Depth at Main: 3.00 m	4.10 m
Frost Plug:	Pipe Size: 20 mm / 25 mm	100 mm
Memo:	Pipe Material: HDPE Insul. <u>Yes</u> /No	PVC Insul. Yes/ <u>No</u>
	Length from Main to P/L: 7.31 m	10.36 m
	Squirt Test: <u>Pass</u> /Fail	N/A
Booster Pump Required: Yes/No	Frost Protection: Aquaflow/ <u>Recirc</u> /Heat Trace/Bleeder	N/A
PRV Required: Yes/No	Greased @ CC: <u>Yes</u> /No	N/A
Water Meter Installed: Yes/No	Continuity Test: <u>N/A</u> Pass/Fail	N/A

CLEARLY INDICATE LOCATION OF CC AND ROUTE OF PIPES ON DRAWING BELOW

1. Show main valves required to isolate this service. 2. All dimensions to be tied to property line 3. All dimensions to be metric 4. Depth @ property line is based on elevation after construction and changes may have occurred.

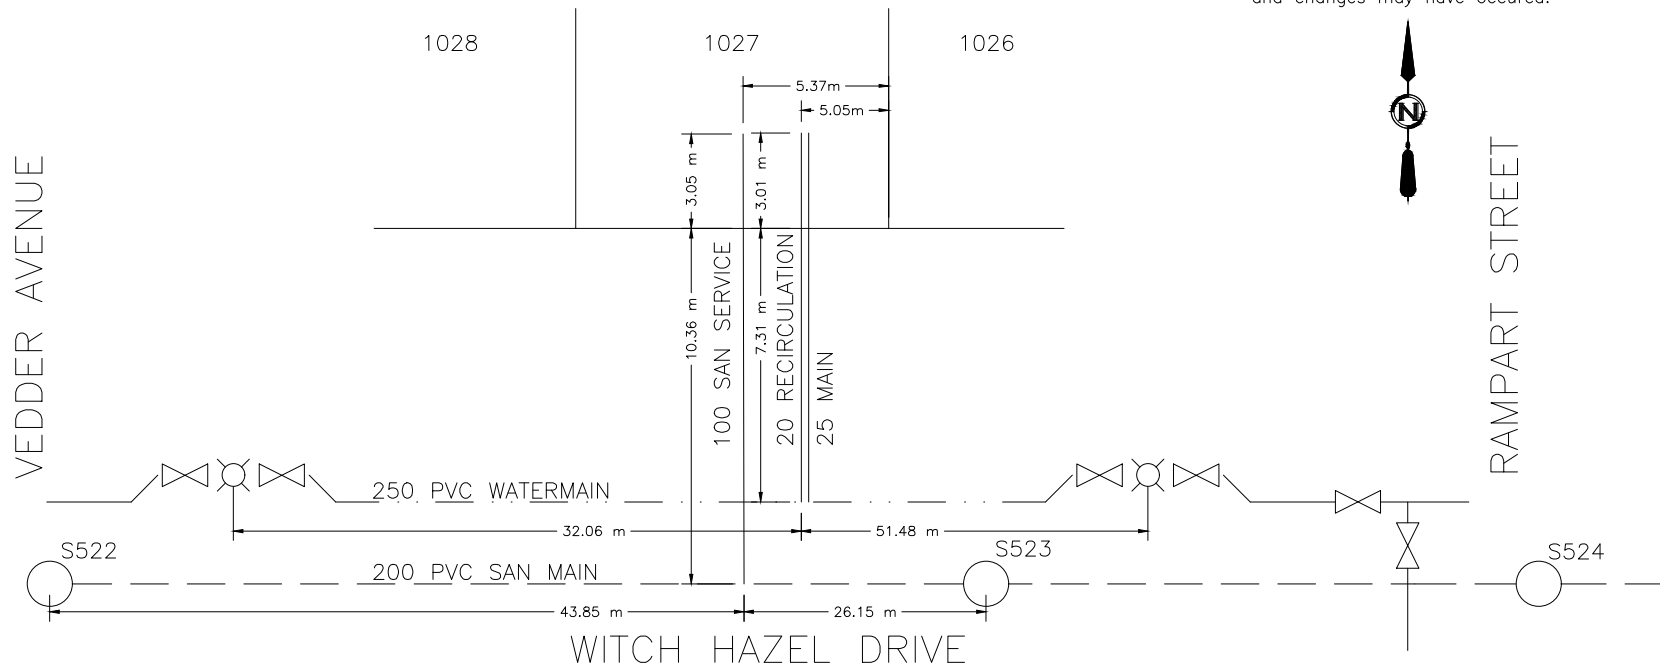



CITY OF WHITEHORSE

SERVICE CONNECTION RECORD

FIELD BOOK

No.

ADDRESS 195 WITCH HAZEL DRIVE BLOCK LOT 1028

DATES


WATER

SEWER

On at Main 20200821	Depth at P/L: 2.53 m	2.52 m
On at Building	Depth at Main: 3.06 m	4.15 m
Frost Plug:	Pipe Size: 20 mm / 25 mm	100 mm
Memo:	Pipe Material: HDPE Insul. <u>Yes</u> /No	PVC Insul. Yes/ <u>No</u>
	Length from Main to P/L: 7.31 m	10.35 m
	Squirt Test: <u>Pass</u> /Fail	N/A
Booster Pump Required: Yes/No	Frost Protection: Aquaflow/ <u>Recirc</u> /Heat Trace/Bleeder	N/A
PRV Required: Yes/No	Greased @ CC: <u>Yes</u> /No	N/A
Water Meter Installed: Yes/No	Continuity Test: <u>N/A</u> Pass/Fail	N/A

CLEARLY INDICATE LOCATION OF CC AND ROUTE OF PIPES ON DRAWING BELOW

1. Show main valves required to isolate this service. 2. All dimensions to be tied to property line 3. All dimensions to be metric 4. Depth @ property line is based on elevation after construction and changes may have occurred.

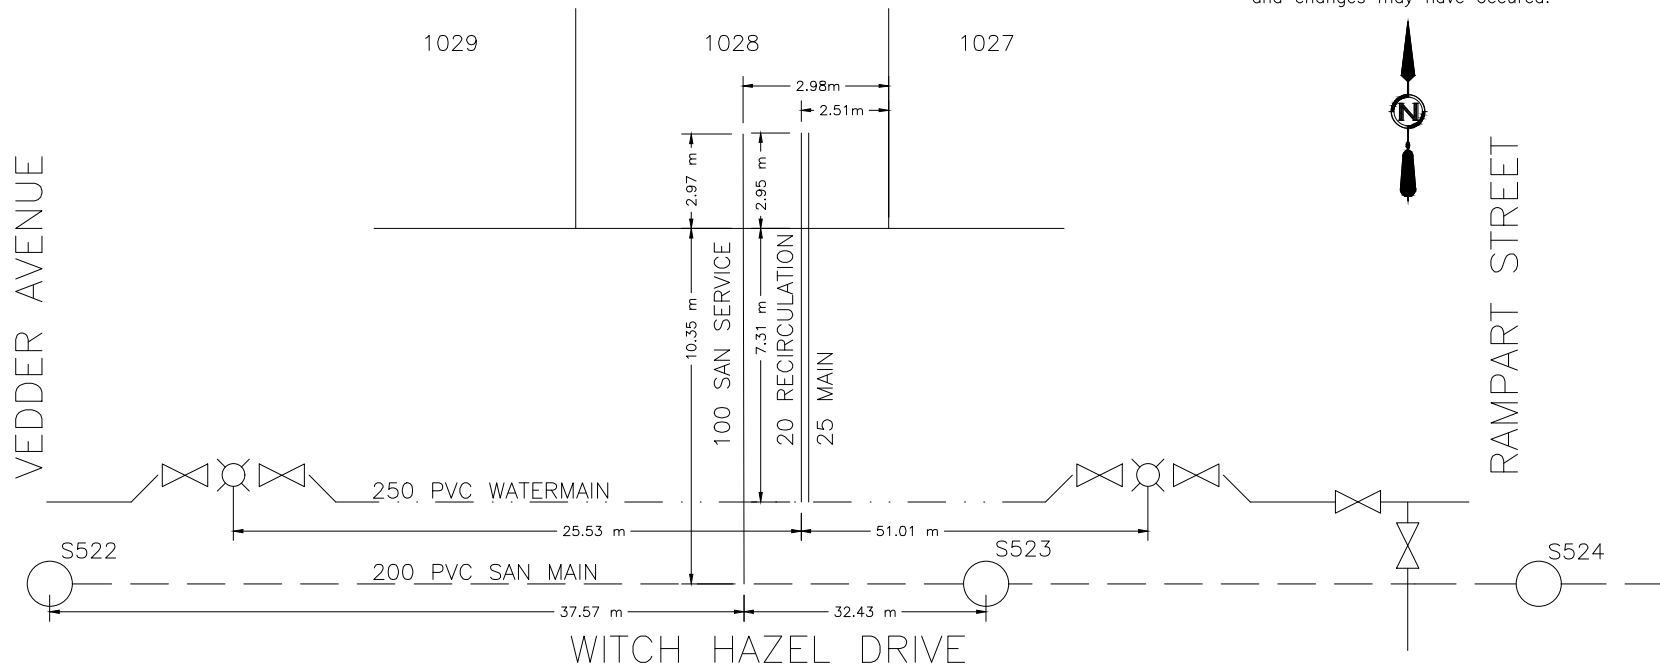



CITY OF WHITEHORSE

SERVICE CONNECTION RECORD

FIELD BOOK

No.

ADDRESS 197 WITCH HAZEL DRIVE BLOCK LOT 1029

DATES


WATER

SEWER

On at Main 20200825	Depth at P/L: 2.57 m	2.61 m
On at Building	Depth at Main: 3.06 m	2.24 m
Frost Plug:	Pipe Size: 20 mm / 25 mm	100 mm
Memo:	Pipe Material: HDPE Insul. <u>Yes</u> /No	PVC Insul. Yes/ <u>No</u>
	Length from Main to P/L: 7.31 m	10.35 m
	Squirt Test: <u>Pass</u> /Fail	N/A
Booster Pump Required: Yes/No	Frost Protection: Aquaflow/ <u>Recirc</u> /Heat Trace/Bleeder	N/A
PRV Required: Yes/No	Greased @ CC: <u>Yes</u> /No	N/A
Water Meter Installed: Yes/No	Continuity Test: <u>N/A</u> Pass/Fail	N/A

CLEARLY INDICATE LOCATION OF CC AND ROUTE OF PIPES ON DRAWING BELOW

1. Show main valves required to isolate this service. 2. All dimensions to be tied to property line 3. All dimensions to be metric 4. Depth @ property line is based on elevation after construction and changes may have occurred.

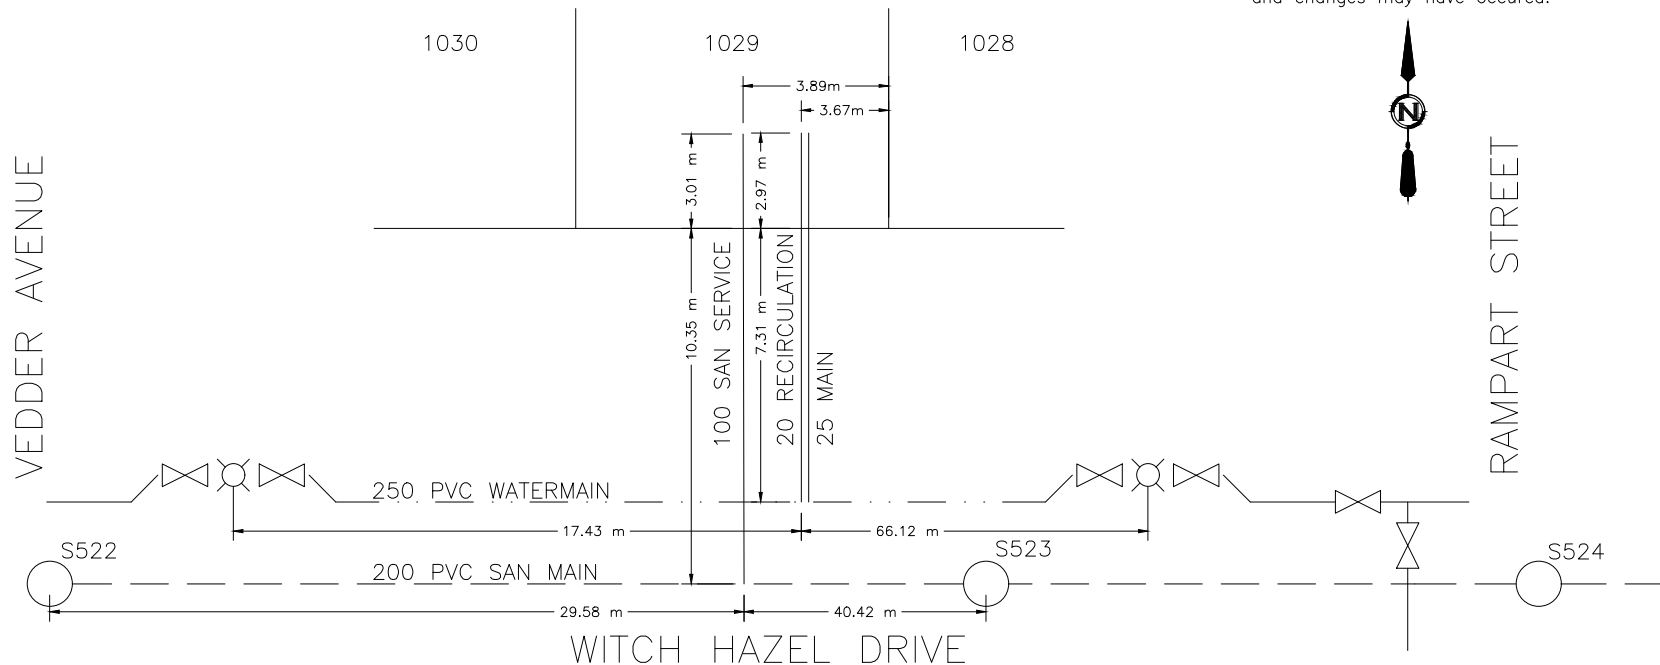



CITY OF WHITEHORSE

SERVICE CONNECTION RECORD

FIELD BOOK

No.

ADDRESS 199 WITCH HAZEL DRIVE BLOCK LOT 1030

DATES


WATER

SEWER

On at Main 20200814	Depth at P/L: 2.70 m	2.68 m
On at Building	Depth at Main: 3.07 m	4.34 m
Frost Plug:	Pipe Size: 20 mm / 25 mm	100 mm
Memo:	Pipe Material: HDPE Insul. <u>Yes</u> /No	PVC Insul. Yes/ <u>No</u>
	Length from Main to P/L: 7.30 m	10.36 m
	Squirt Test: <u>Pass</u> /Fail	N/A
Booster Pump Required: Yes/No	Frost Protection: Aquaflo/ <u>Recirc</u> /Heat Trace/Bleeder	N/A
PRV Required: Yes/No	Greased @ CC: <u>Yes</u> /No	N/A
Water Meter Installed: Yes/No	Continuity Test: <u>N/A</u> Pass/Fail	N/A

CLEARLY INDICATE LOCATION OF CC AND ROUTE OF PIPES ON DRAWING BELOW

1. Show main valves required to isolate this service. 2. All dimensions to be tied to property line 3. All dimensions to be metric 4. Depth @ property line is based on elevation after construction and changes may have occurred.

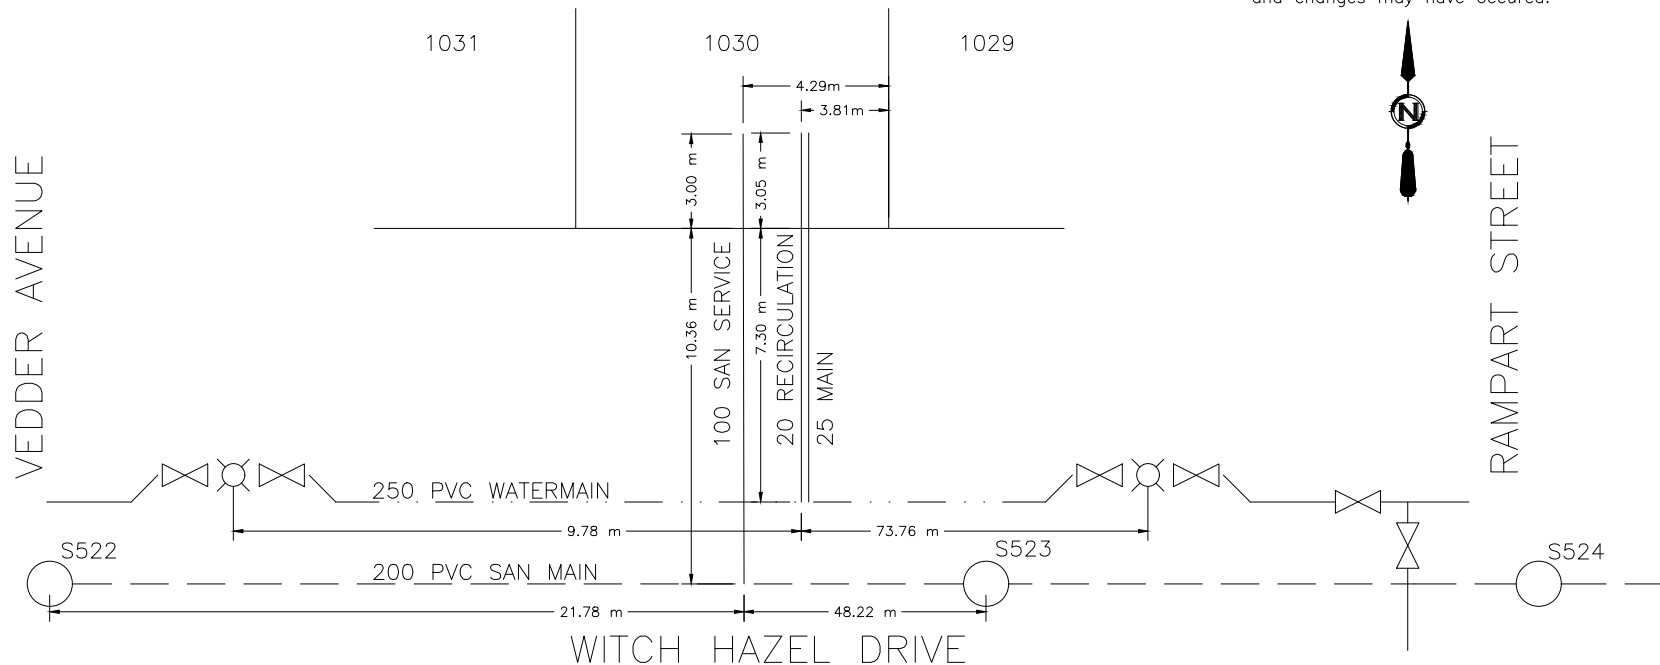



CITY OF WHITEHORSE

SERVICE CONNECTION RECORD

FIELD BOOK

No.

ADDRESS 201 WITCH HAZEL DRIVE BLOCK LOT 1031

DATES


WATER

SEWER

On at Main 20200804	Depth at P/L: 2.66 m	2.71 m
On at Building	Depth at Main: 3.11 m	4.38 m
Frost Plug:	Pipe Size: 20 mm / 25 mm	100 mm
Memo:	Pipe Material: HDPE Insul. <u>Yes</u> /No	PVC Insul. Yes/ <u>No</u>
	Length from Main to P/L: 7.30 m	10.36 m
	Squirt Test: <u>Pass</u> /Fail	N/A
Booster Pump Required: Yes/No	Frost Protection: Aquaflow/ <u>Recirc</u> /Heat Trace/Bleeder	N/A
PRV Required: Yes/No	Greased @ CC: <u>Yes</u> /No	N/A
Water Meter Installed: Yes/No	Continuity Test: <u>N/A</u> Pass/Fail	N/A

CLEARLY INDICATE LOCATION OF CC AND ROUTE OF PIPES ON DRAWING BELOW

1. Show main valves required to isolate this service. 2. All dimensions to be tied to property line 3. All dimensions to be metric 4. Depth @ property line is based on elevation after construction and changes may have occurred.

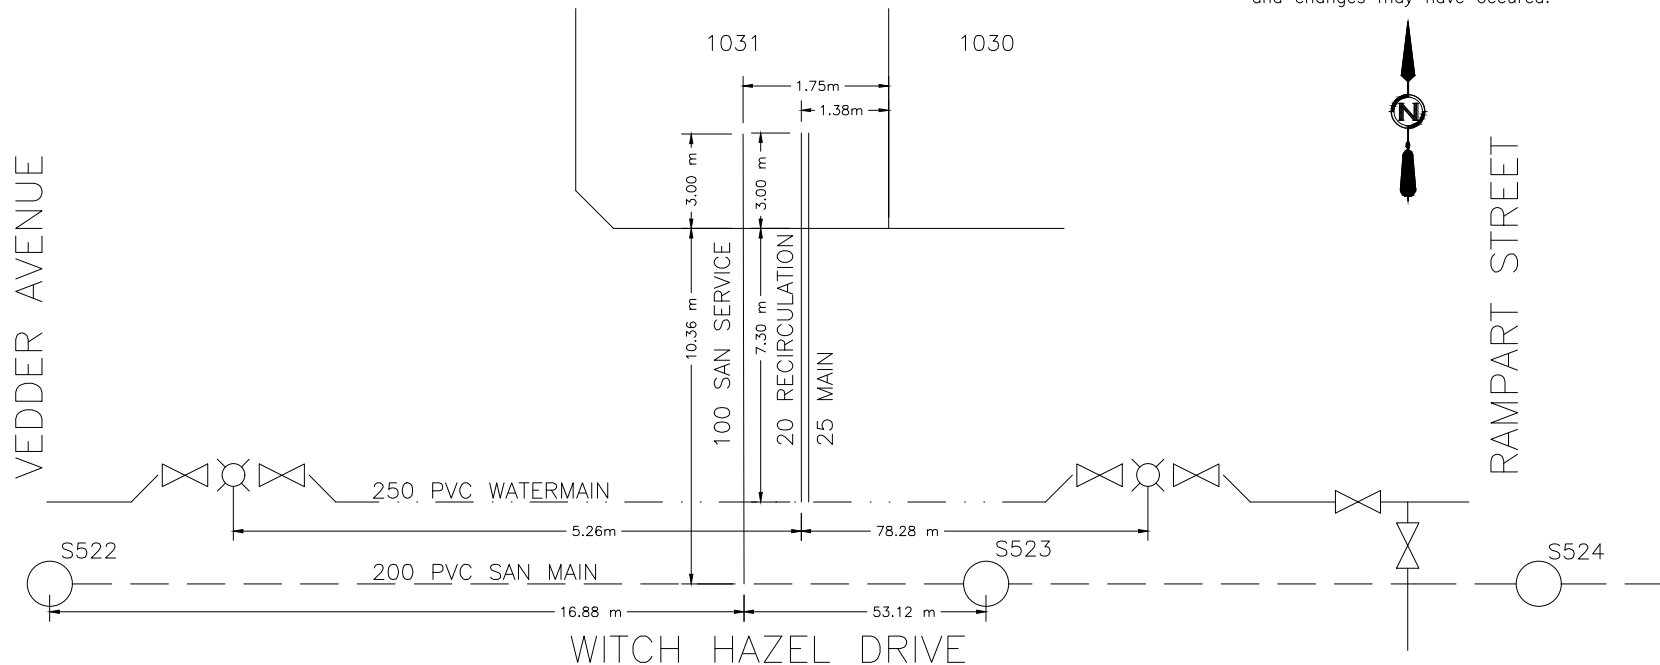



CITY OF WHITEHORSE

SERVICE CONNECTION RECORD

FIELD BOOK

No.

ADDRESS 200 WITCH HAZEL DRIVE BLOCK LOT 1080

DATES


WATER

SEWER

On at Main 20200804	Depth at P/L: 2.88 m	3.04 m
On at Building	Depth at Main: 3.11 m	4.37 m
Frost Plug:	Pipe Size: 20 mm / 25 mm	100 mm
Memo:	Pipe Material: HDPE	Insul. Yes/No
	Length from Main to P/L: 15.24 m	11.65 m
	Squirt Test:	Pass/Fail
Booster Pump Required: Yes/No	Frost Protection: Aquaflo/Recirc/Heat Trace/Bleeder	N/A
PRV Required: Yes/No	Greased @ CC: Yes/No	N/A
Water Meter Installed: Yes/No	Continuity Test: N/A	Pass/Fail

CLEARLY INDICATE LOCATION OF CC AND ROUTE OF PIPES ON DRAWING BELOW

1. Show main valves required to isolate this service.
2. All dimensions to be tied to property line
3. All dimensions to be metric
4. Depth @ property line is based on elevation after construction and changes may have occurred.

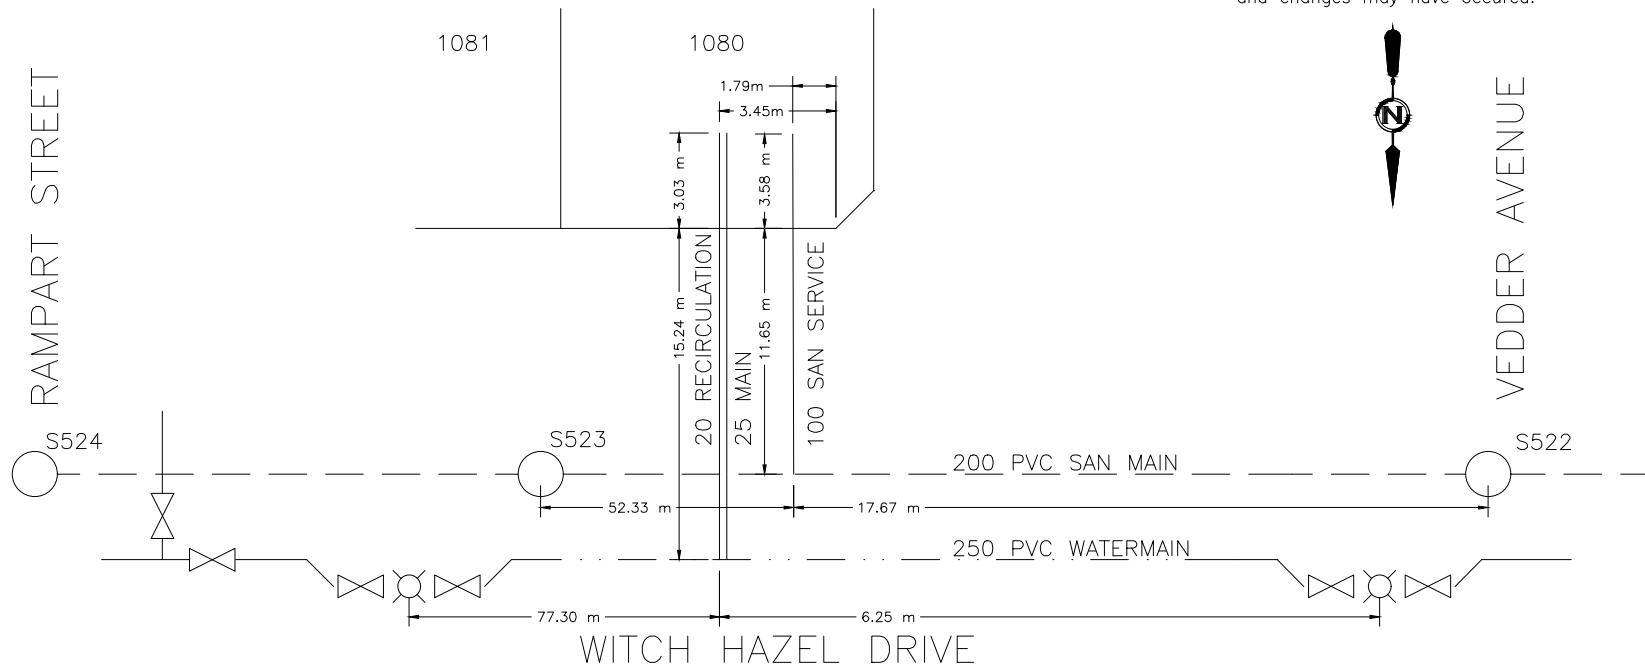



CITY OF WHITEHORSE

SERVICE CONNECTION RECORD

FIELD BOOK

No.

ADDRESS 198 WITCH HAZEL DRIVE BLOCK LOT 1081

DATES


WATER

SEWER

On at Main 20200819	Depth at P/L: 2.59 m	2.65 m
On at Building	Depth at Main: 3.07 m	4.31 m
Frost Plug:	Pipe Size: 20 mm / 25 mm	100 mm
Memo:	Pipe Material: HDPE	Insul. <u>Yes</u> /No
	Length from Main to P/L: 15.20 m	PVC
		Insul. Yes/ <u>No</u>
	Squirt Test: <u>Pass</u> /Fail	N/A
Booster Pump Required: Yes/No	Frost Protection: Aquaflow/ <u>Recirc</u> /Heat Trace/Bleeder	N/A
PRV Required: Yes/No	Greased @ CC: <u>Yes</u> /No	N/A
Water Meter Installed: Yes/No	Continuity Test: <u>N/A</u> Pass/Fail	N/A

CLEARLY INDICATE LOCATION OF CC AND ROUTE OF PIPES ON DRAWING BELOW

1. Show main valves required to isolate this service. 2. All dimensions to be tied to property line 3. All dimensions to be metric 4. Depth @ property line is based on elevation after construction and changes may have occurred.

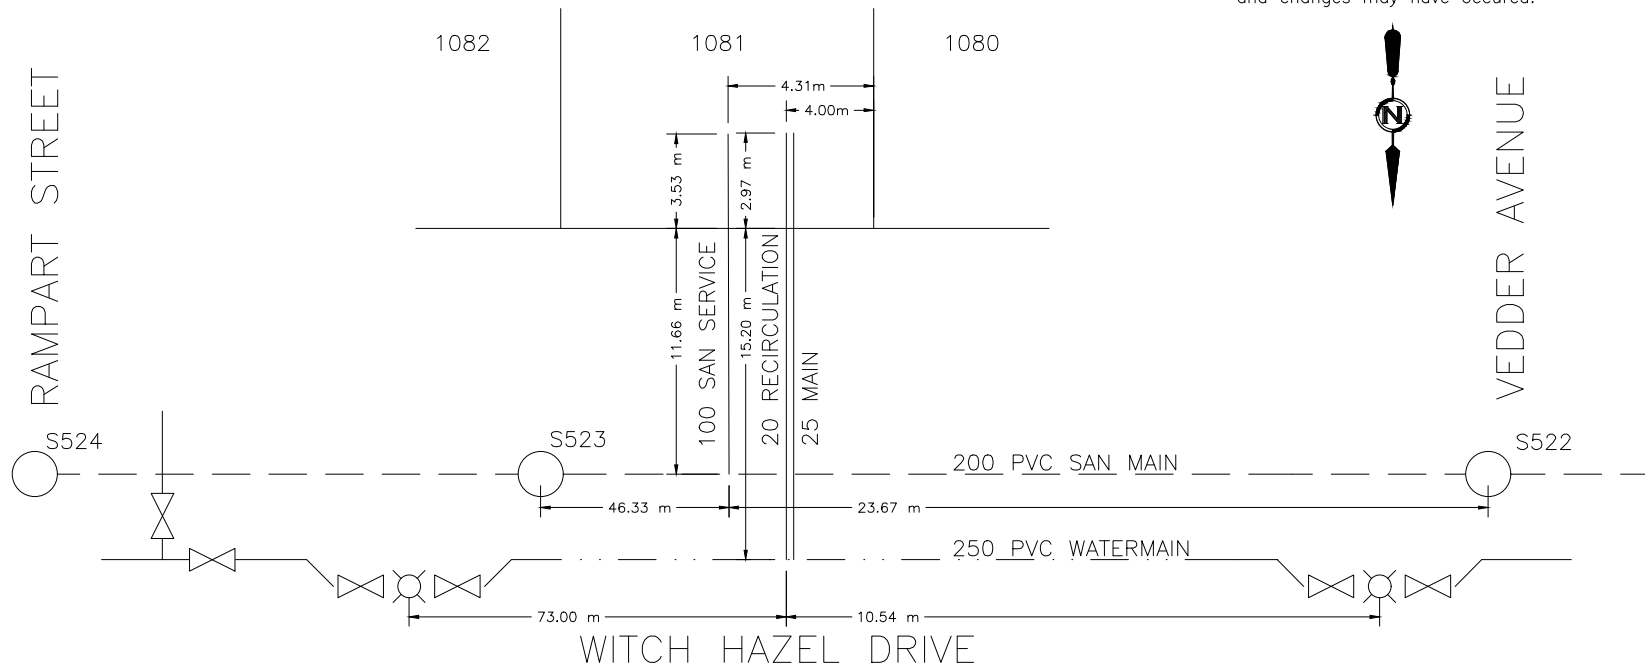



CITY OF WHITEHORSE

SERVICE CONNECTION RECORD

FIELD BOOK

No.

ADDRESS 196 WITCH HAZEL DRIVE BLOCK LOT 1082

DATES


WATER

SEWER

On at Main 20200821	Depth at P/L: 2.51 m	2.56 m
On at Building	Depth at Main: 3.09 m	4.22 m
Frost Plug:	Pipe Size: 20 mm / 25 mm	100 mm
Memo:	Pipe Material: HDPE	Insul. <u>Yes</u> /No
	Length from Main to P/L: 15.21 m	PVC
		Insul. Yes/ <u>No</u>
	Squirt Test: <u>Pass</u> /Fail	N/A
Booster Pump Required: Yes/No	Frost Protection: Aquaflow/ <u>Recirc</u> /Heat Trace/Bleeder	N/A
PRV Required: Yes/No	Greased @ CC: <u>Yes</u> /No	N/A
Water Meter Installed: Yes/No	Continuity Test: <u>N/A</u> Pass/Fail	N/A

CLEARLY INDICATE LOCATION OF CC AND ROUTE OF PIPES ON DRAWING BELOW

1. Show main valves required to isolate this service.
2. All dimensions to be tied to property line
3. All dimensions to be metric
4. Depth @ property line is based on elevation after construction and changes may have occurred.

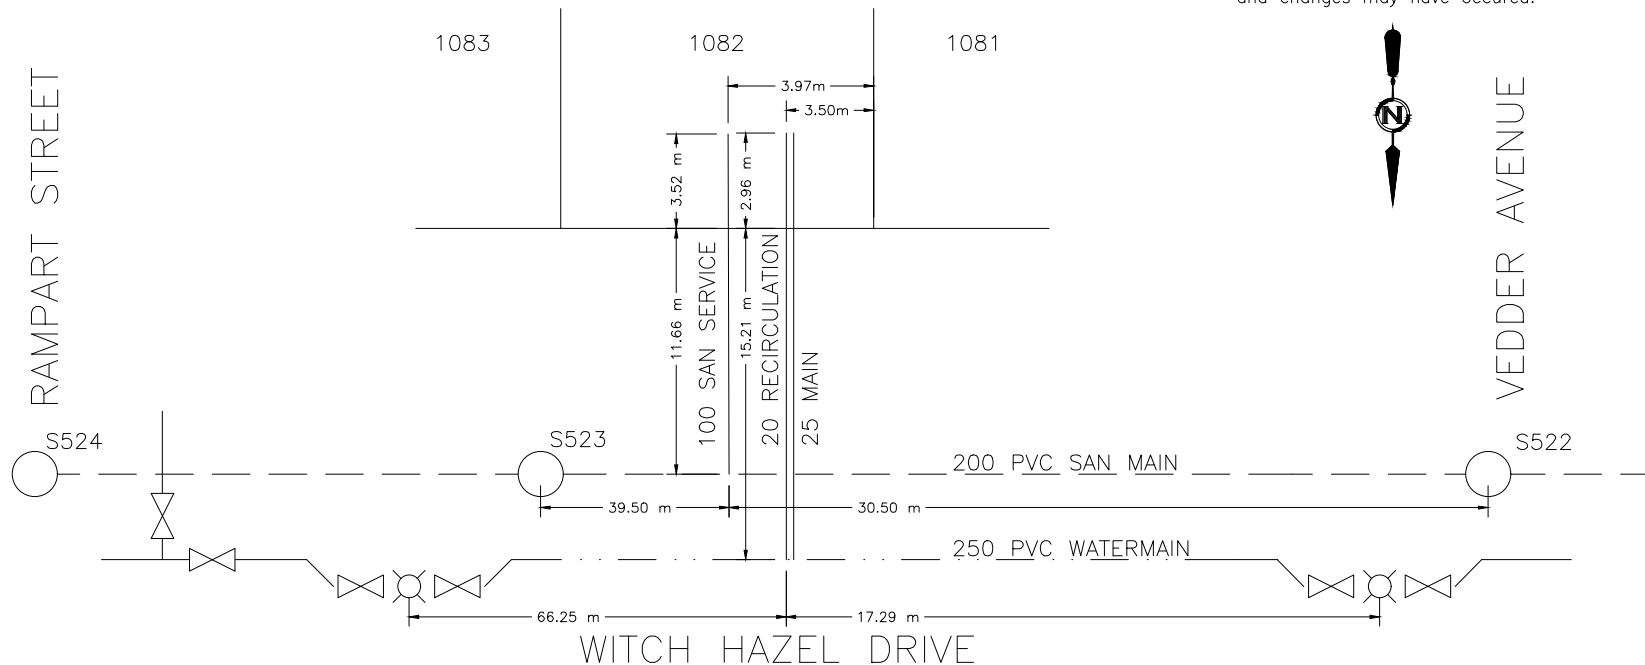



CITY OF WHITEHORSE

SERVICE CONNECTION RECORD

FIELD BOOK

No.

ADDRESS 194 WITCH HAZEL DRIVE BLOCK LOT 1083

DATES


WATER

SEWER

On at Main 20200825	Depth at P/L: 2.56 m	2.58 m
On at Building	Depth at Main: 3.07 m	4.17 m
Frost Plug:	Pipe Size: 20 mm / 25 mm	100 mm
Memo:	Pipe Material: HDPE	Insul. <u>Yes</u> /No
	Length from Main to P/L: 15.21 m	PVC
		Insul. Yes/ <u>No</u>
	Squirt Test: <u>Pass</u> /Fail	N/A
Booster Pump Required: Yes/No	Frost Protection: Aquaflow/ <u>Recirc</u> /Heat Trace/Bleeder	N/A
PRV Required: Yes/No	Greased @ CC: <u>Yes</u> /No	N/A
Water Meter Installed: Yes/No	Continuity Test: <u>N/A</u> Pass/Fail	N/A

CLEARLY INDICATE LOCATION OF CC AND ROUTE OF PIPES ON DRAWING BELOW

1. Show main valves required to isolate this service. 2. All dimensions to be tied to property line 3. All dimensions to be metric 4. Depth @ property line is based on elevation after construction and changes may have occurred.

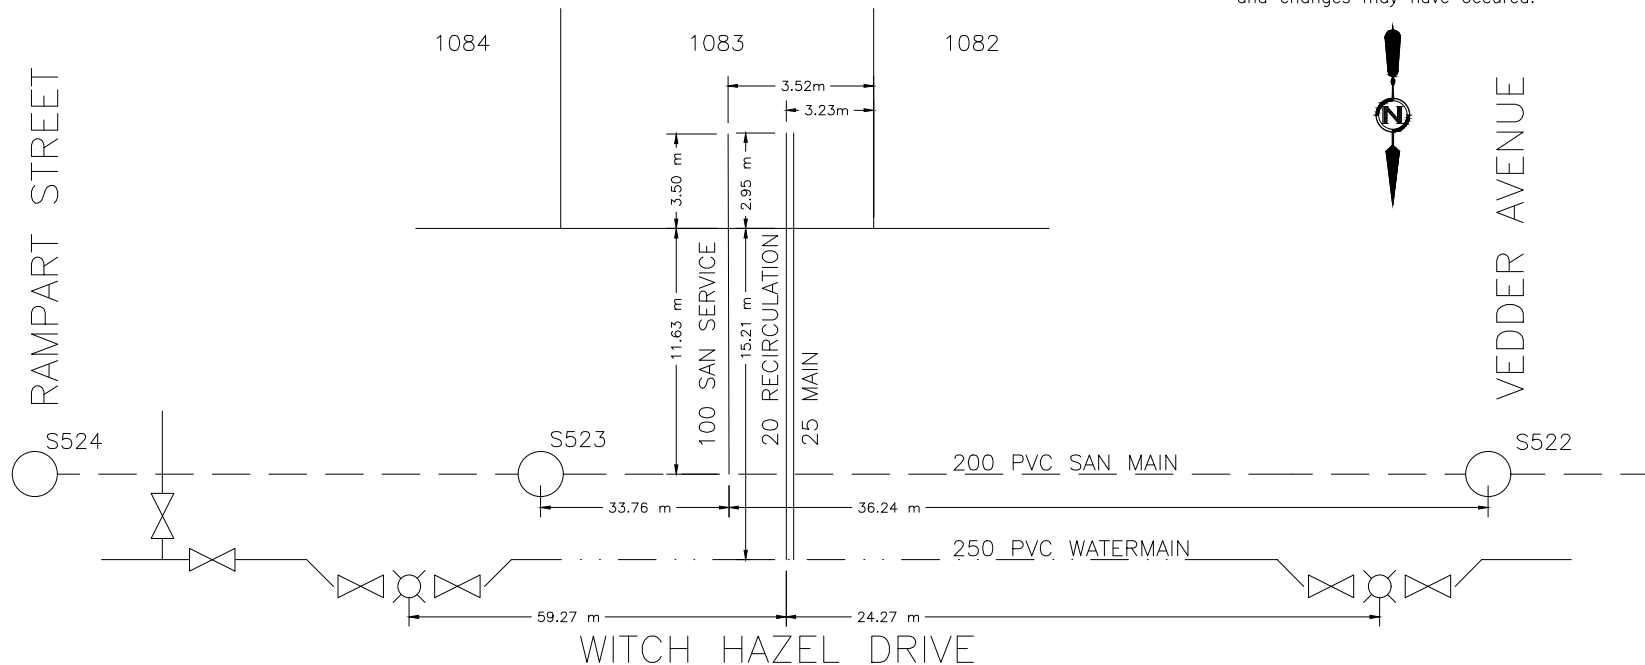



CITY OF WHITEHORSE

SERVICE CONNECTION RECORD

FIELD BOOK

No.

ADDRESS 192 WITCH HAZEL DRIVE BLOCK LOT 1084

DATES


WATER

SEWER

On at Main 20200818	Depth at P/L: 2.58 m	2.59 m
On at Building	Depth at Main: 3.00 m	4.10 m
Frost Plug:	Pipe Size: 20 mm / 25 mm	100 mm
Memo:	Pipe Material: HDPE	Insul. <u>Yes</u> /No
	Length from Main to P/L: 15.20 m	PVC
		Insul. Yes/ <u>No</u>
	Squirt Test:	<u>Pass</u> /Fail
Booster Pump Required:	Frost Protection: Aquaflow/ <u>Recirc</u> /Heat Trace/Bleeder	N/A
PRV Required:	Greased @ CC:	<u>Yes</u> /No
Water Meter Installed:	Continuity Test: <u>N/A</u>	Pass/Fail
		N/A

CLEARLY INDICATE LOCATION OF CC AND ROUTE OF PIPES ON DRAWING BELOW

1. Show main valves required to isolate this service.
2. All dimensions to be tied to property line
3. All dimensions to be metric
4. Depth @ property line is based on elevation after construction and changes may have occurred.

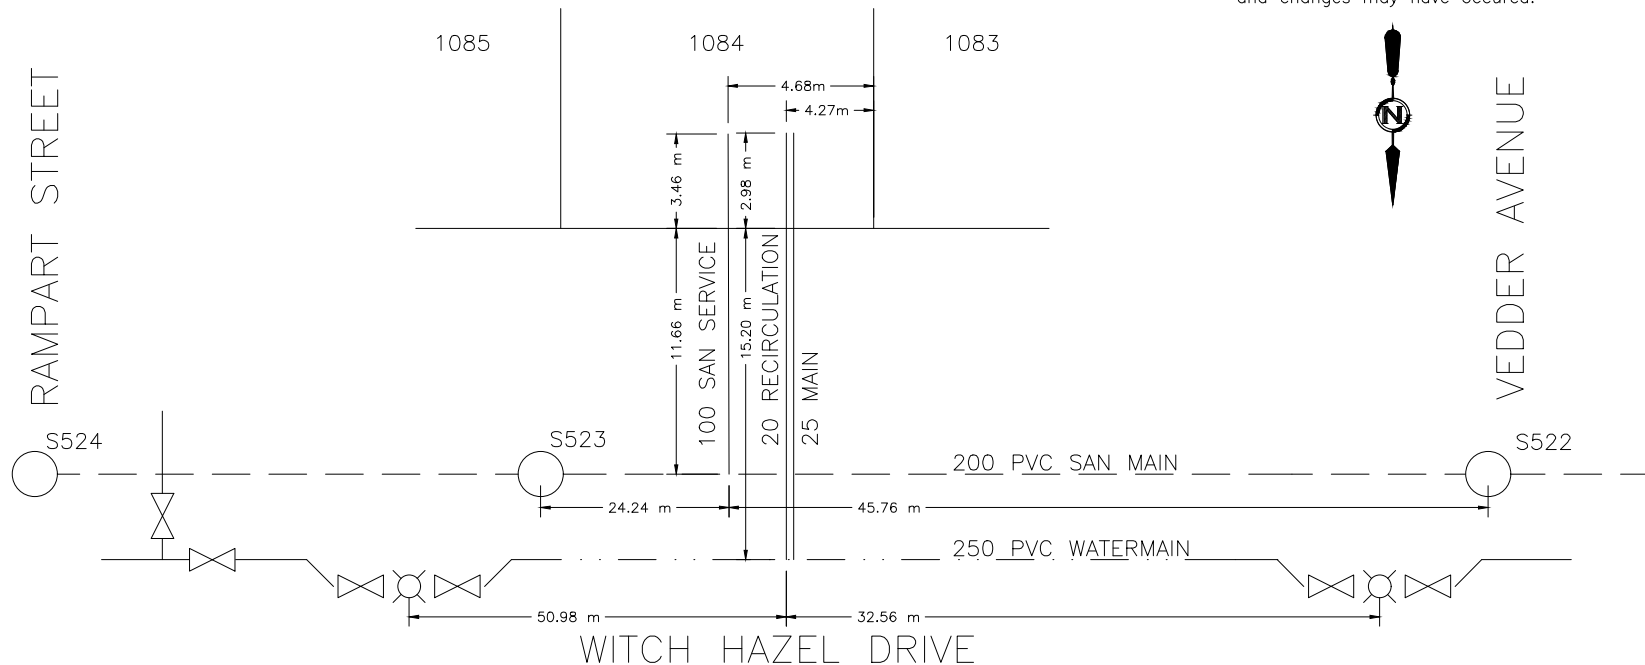



CITY OF WHITEHORSE

SERVICE CONNECTION RECORD

FIELD BOOK

No.

ADDRESS 190 WITCH HAZEL DRIVE BLOCK LOT 1085

DATES


WATER

SEWER

On at Main 20200821	Depth at P/L: 2.48 m	2.52 m
On at Building	Depth at Main: 3.01 m	3.98 m
Frost Plug:	Pipe Size: 20 mm / 25 mm	100 mm
Memo:	Pipe Material: HDPE	Insul. <u>Yes</u> /No
	Length from Main to P/L: 15.18 m	PVC
		Insul. Yes/ <u>No</u>
	Squirt Test:	<u>Pass</u> /Fail
Booster Pump Required:	Frost Protection: Aquaflow/ <u>Recirc</u> /Heat Trace/Bleeder	N/A
PRV Required:	Greased @ CC:	<u>Yes</u> /No
Water Meter Installed:	Continuity Test: <u>N/A</u>	Pass/Fail

CLEARLY INDICATE LOCATION OF CC AND ROUTE OF PIPES ON DRAWING BELOW

1. Show main valves required to isolate this service. 2. All dimensions to be tied to property line 3. All dimensions to be metric 4. Depth @ property line is based on elevation after construction and changes may have occurred.

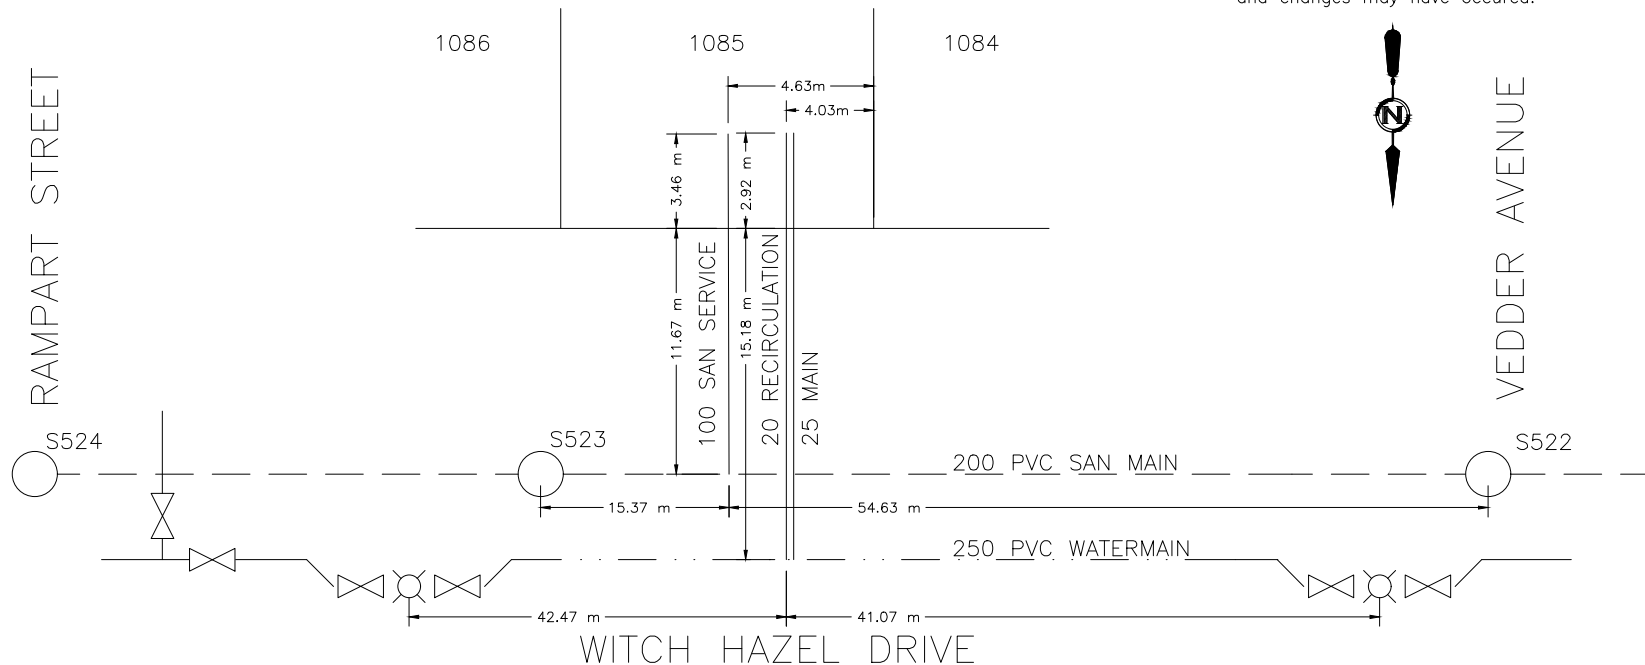



CITY OF WHITEHORSE

SERVICE CONNECTION RECORD

FIELD BOOK

No.

ADDRESS 188 WITCH HAZEL DRIVE BLOCK LOT 1086

DATES


WATER

SEWER

On at Main 20200818	Depth at P/L: 2.49 m	2.54 m
On at Building	Depth at Main: 2.99 m	3.90 m
Frost Plug:	Pipe Size: 20 mm / 25 mm	100 mm
Memo:	Pipe Material: HDPE Insul. <u>Yes</u> /No	PVC Insul. Yes/ <u>No</u>
	Length from Main to P/L: 15.18 m	11.66 m
	Squirt Test: <u>Pass</u> /Fail	N/A
Booster Pump Required: Yes/No	Frost Protection: Aquaflo/ <u>Recirc</u> /Heat Trace/Bleeder	N/A
PRV Required: Yes/No	Greased @ CC: <u>Yes</u> /No	N/A
Water Meter Installed: Yes/No	Continuity Test: <u>N/A</u> Pass/Fail	N/A

CLEARLY INDICATE LOCATION OF CC AND ROUTE OF PIPES ON DRAWING BELOW

1. Show main valves required to isolate this service. 2. All dimensions to be tied to property line 3. All dimensions to be metric 4. Depth @ property line is based on elevation after construction and changes may have occurred.

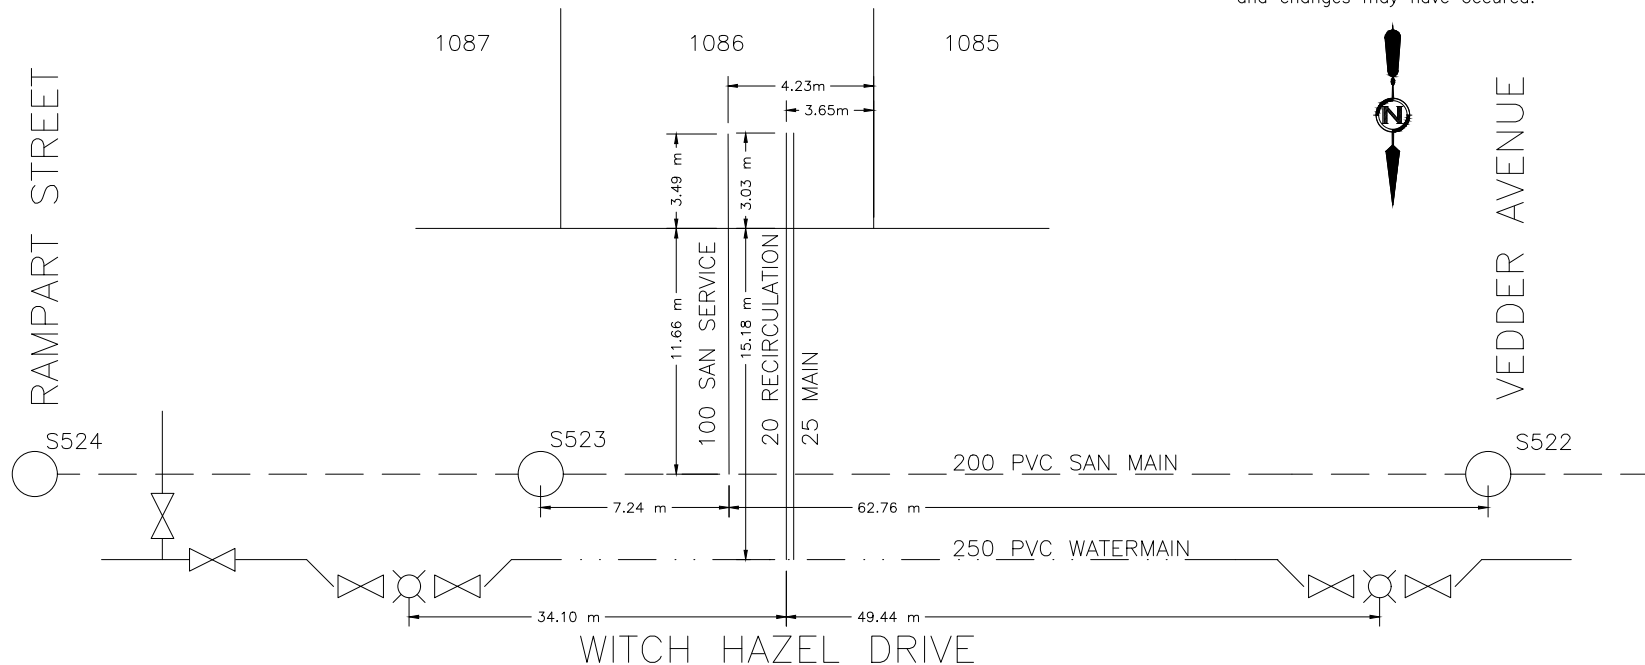



CITY OF WHITEHORSE

SERVICE CONNECTION RECORD

FIELD BOOK

No.

ADDRESS 186 WITCH HAZEL DRIVE BLOCK LOT 1087

DATES


WATER

SEWER

On at Main 20200905	Depth at P/L: 2.59 m	2.62 m
On at Building	Depth at Main: 2.98 m	3.85 m
Frost Plug:	Pipe Size: 20 mm / 25 mm	100 mm
Memo:	Pipe Material: HDPE Insul. <u>Yes</u> /No	PVC Insul. Yes/ <u>No</u>
	Length from Main to P/L: 15.18 m	11.67 m
	Squirt Test: <u>Pass</u> /Fail	N/A
Booster Pump Required: Yes/No	Frost Protection: Aquaflo/ <u>Recirc</u> /Heat Trace/Bleeder	N/A
PRV Required: Yes/No	Greased @ CC: <u>Yes</u> /No	N/A
Water Meter Installed: Yes/No	Continuity Test: <u>N/A</u> Pass/Fail	N/A

CLEARLY INDICATE LOCATION OF CC AND ROUTE OF PIPES ON DRAWING BELOW

1. Show main valves required to isolate this service. 2. All dimensions to be tied to property line 3. All dimensions to be metric 4. Depth @ property line is based on elevation after construction and changes may have occurred.

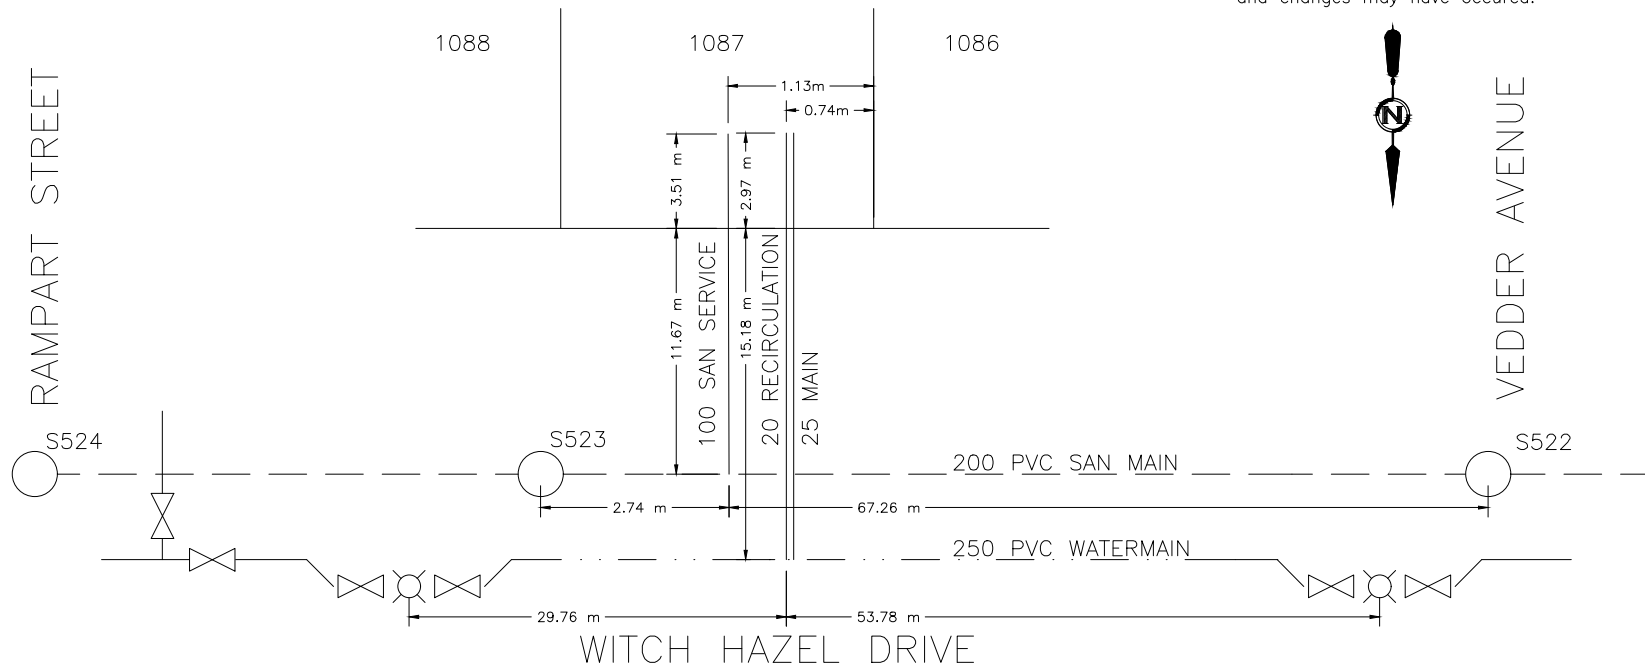



CITY OF WHITEHORSE

SERVICE CONNECTION RECORD

FIELD BOOK

No.

ADDRESS 184 WITCH HAZEL DRIVE BLOCK LOT 1088

DATES


WATER

SEWER

On at Main 20200911	Depth at P/L: 2.90 m	2.93 m
On at Building	Depth at Main: 2.94 m	4.01 m
Frost Plug:	Pipe Size: 20 mm / 25 mm	100 mm
Memo:	Pipe Material: HDPE Insul. <u>Yes</u> /No	PVC Insul. Yes/ <u>No</u>
	Length from Main to P/L: 15.19 m	11.67 m
	Squirt Test: <u>Pass</u> /Fail	N/A
Booster Pump Required: Yes/No	Frost Protection: Aquaflo/ <u>Recirc</u> /Heat Trace/Bleeder	N/A
PRV Required: Yes/No	Greased @ CC: <u>Yes</u> /No	N/A
Water Meter Installed: Yes/No	Continuity Test: <u>N/A</u> Pass/Fail	N/A

CLEARLY INDICATE LOCATION OF CC AND ROUTE OF PIPES ON DRAWING BELOW

1. Show main valves required to isolate this service. 2. All dimensions to be tied to property line 3. All dimensions to be metric 4. Depth @ property line is based on elevation after construction and changes may have occurred.

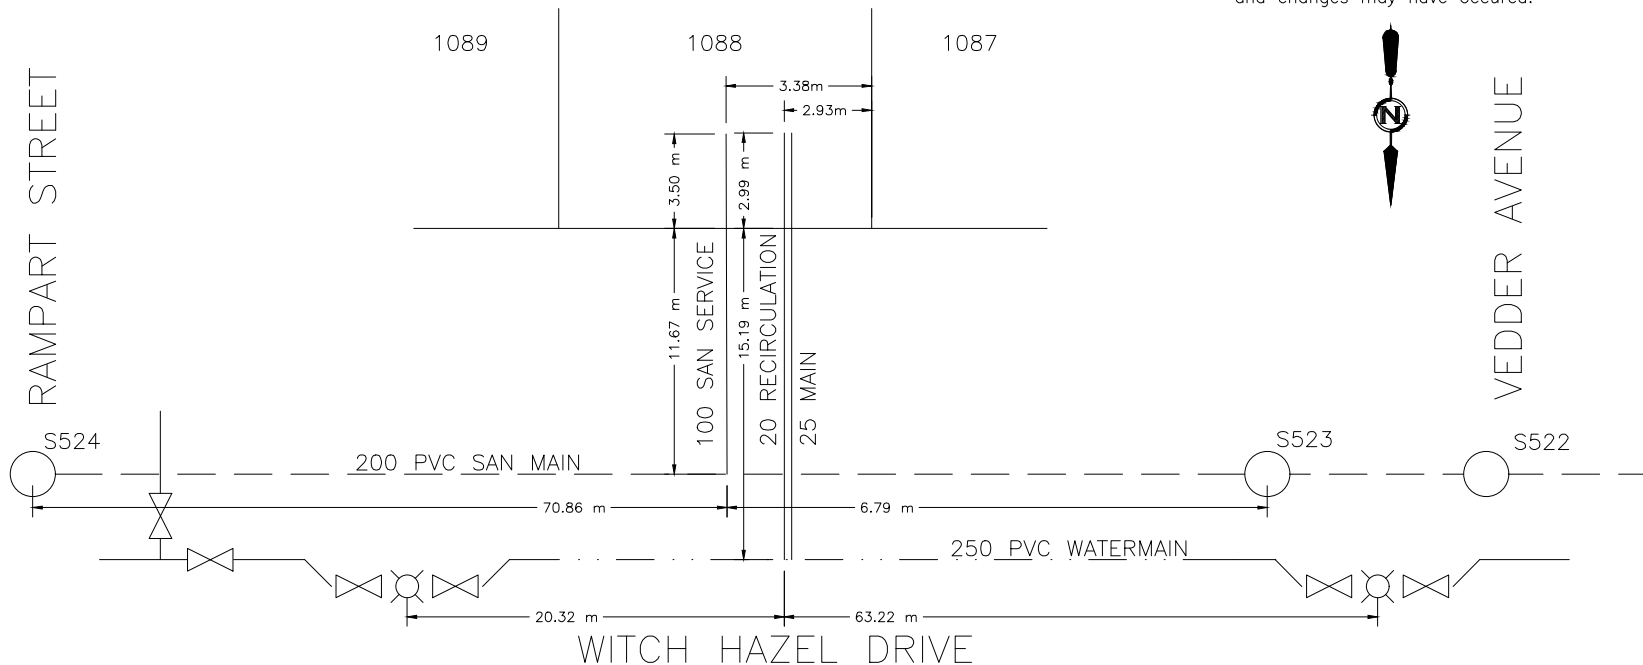



CITY OF WHITEHORSE

SERVICE CONNECTION RECORD

FIELD BOOK

No.

ADDRESS 182 WITCH HAZEL DRIVE BLOCK LOT 1089

DATES


WATER

SEWER

On at Main 20200911	Depth at P/L: 2.73 m	2.76 m
On at Building	Depth at Main: 2.93 m	3.81 m
Frost Plug:	Pipe Size: 20 mm / 25 mm	100 mm
Memo:	Pipe Material: HDPE Insul. <u>Yes</u> /No	PVC Insul. Yes/ <u>No</u>
	Length from Main to P/L: 15.15 m	11.68 m
	Squirt Test: <u>Pass</u> /Fail	N/A
Booster Pump Required: Yes/No	Frost Protection: Aquaflow/ <u>Recirc</u> /Heat Trace/Bleeder	N/A
PRV Required: Yes/No	Greased @ CC: <u>Yes</u> /No	N/A
Water Meter Installed: Yes/No	Continuity Test: <u>N/A</u> Pass/Fail	N/A

CLEARLY INDICATE LOCATION OF CC AND ROUTE OF PIPES ON DRAWING BELOW

1. Show main valves required to isolate this service. 2. All dimensions to be tied to property line 3. All dimensions to be metric 4. Depth @ property line is based on elevation after construction and changes may have occurred.

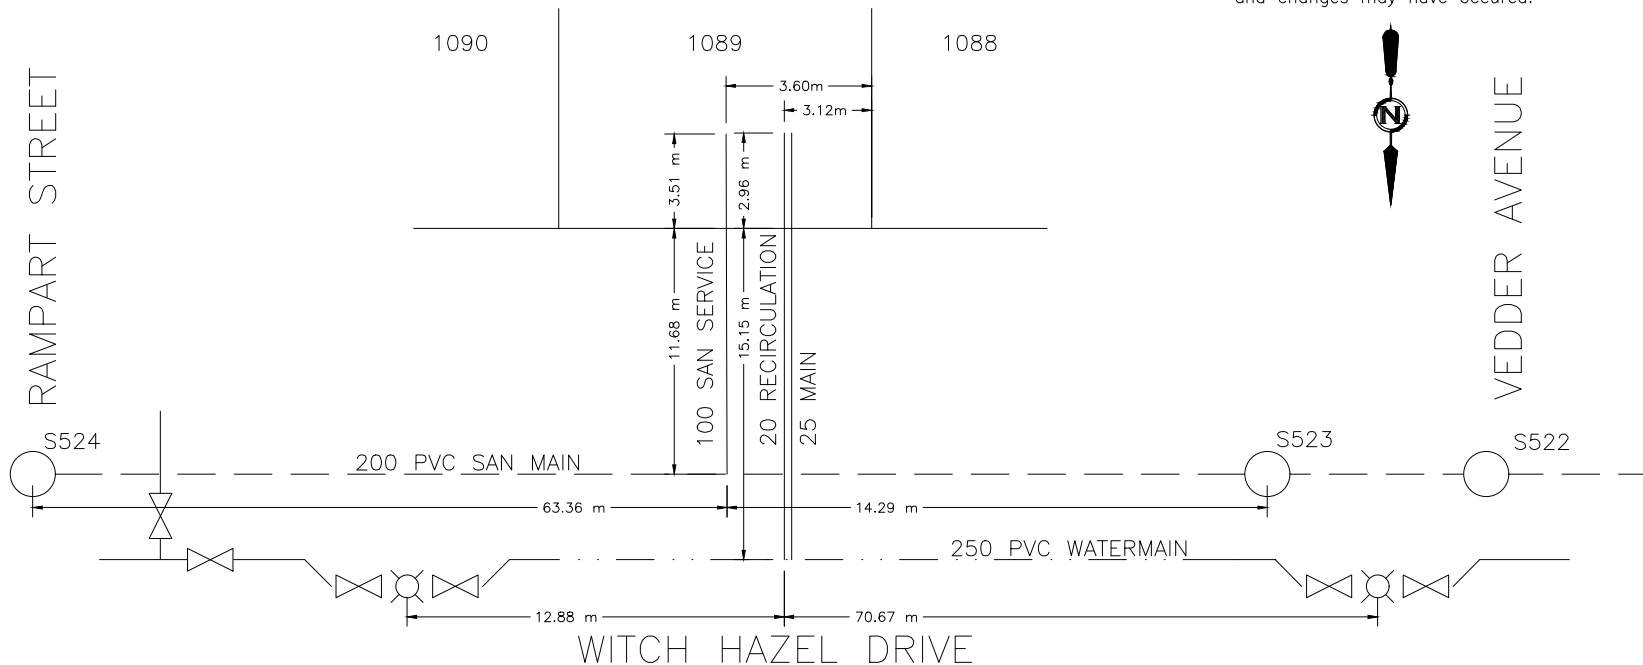



CITY OF WHITEHORSE

SERVICE CONNECTION RECORD

FIELD BOOK

No.

ADDRESS 180 WITCH HAZEL DRIVE BLOCK LOT 1090

DATES


WATER

SEWER

On at Main 20200914	Depth at P/L: 2.38 m	2.47 m
On at Building	Depth at Main: 2.87 m	3.65 m
Frost Plug:	Pipe Size: 20 mm / 25 mm	100 mm
Memo:	Pipe Material: HDPE Insul. <u>Yes</u> /No	PVC Insul. Yes/ <u>No</u>
	Length from Main to P/L: 15.18 m	11.65 m
	Squirt Test: <u>Pass</u> /Fail	N/A
Booster Pump Required: Yes/No	Frost Protection: Aquaflo/ <u>Recirc</u> /Heat Trace/Bleeder	N/A
PRV Required: Yes/No	Greased @ CC: <u>Yes</u> /No	N/A
Water Meter Installed: Yes/No	Continuity Test: <u>N/A</u> Pass/Fail	N/A

CLEARLY INDICATE LOCATION OF CC AND ROUTE OF PIPES ON DRAWING BELOW

1. Show main valves required to isolate this service. 2. All dimensions to be tied to property line 3. All dimensions to be metric 4. Depth @ property line is based on elevation after construction and changes may have occurred.

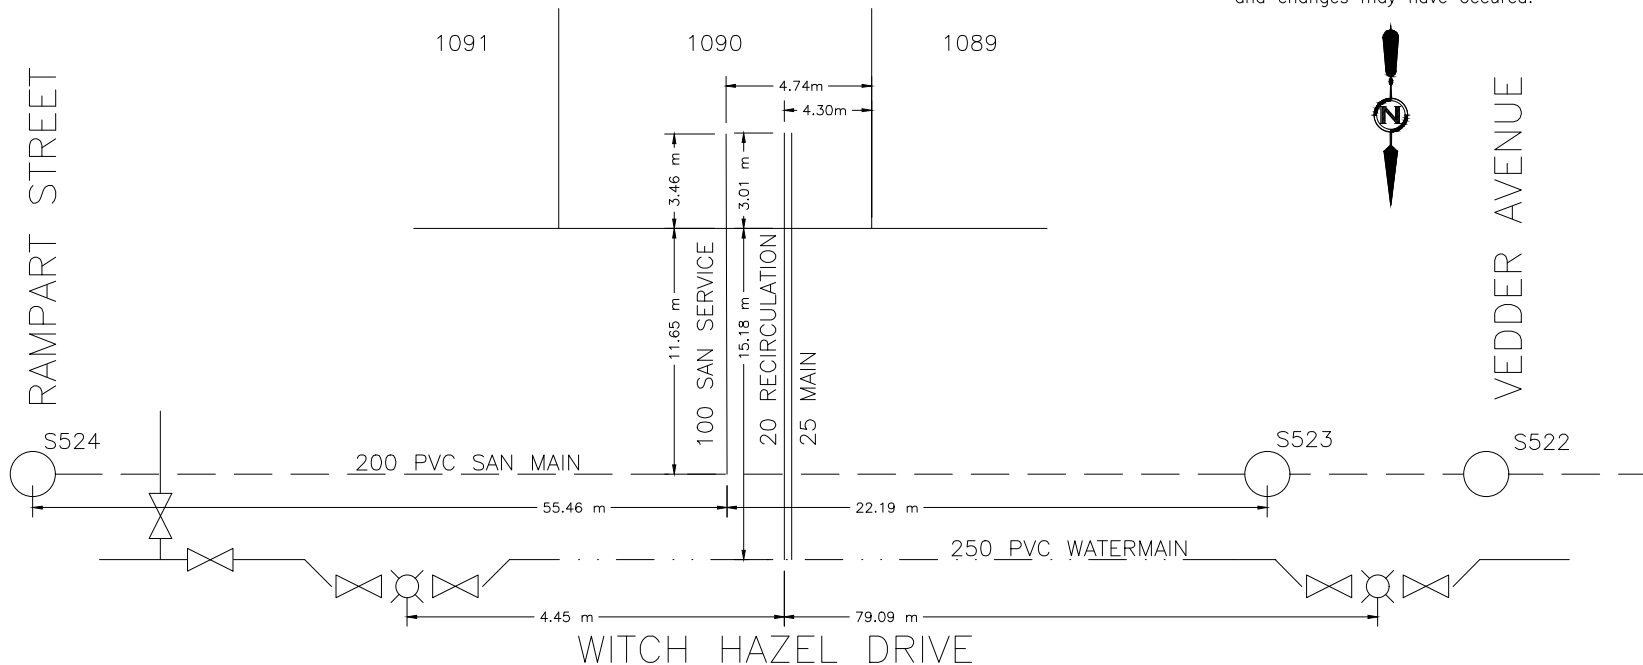



CITY OF WHITEHORSE

SERVICE CONNECTION RECORD

FIELD BOOK

No.

ADDRESS 178 WITCH HAZEL DRIVE BLOCK LOT 1091

DATES


WATER

SEWER

On at Main 20200910	Depth at P/L: 2.82 m	2.85 m
On at Building	Depth at Main: 2.95 m	3.45 m
Frost Plug:	Pipe Size: 20 mm / 25 mm	100 mm
Memo:	Pipe Material: HDPE	Insul. <u>Yes</u> /No
	Length from Main to P/L: 16.38 m	PVC
		Insul. Yes/ <u>No</u>
	Squirt Test: <u>Pass</u> /Fail	N/A
Booster Pump Required: Yes/No	Frost Protection: Aquaflow/ <u>Recirc</u> /Heat Trace/Bleeder	N/A
PRV Required: Yes/No	Greased @ CC: <u>Yes</u> /No	N/A
Water Meter Installed: Yes/No	Continuity Test: <u>N/A</u> Pass/Fail	N/A

CLEARLY INDICATE LOCATION OF CC AND ROUTE OF PIPES ON DRAWING BELOW

1. Show main valves required to isolate this service. 2. All dimensions to be tied to property line 3. All dimensions to be metric 4. Depth @ property line is based on elevation after construction and changes may have occurred.

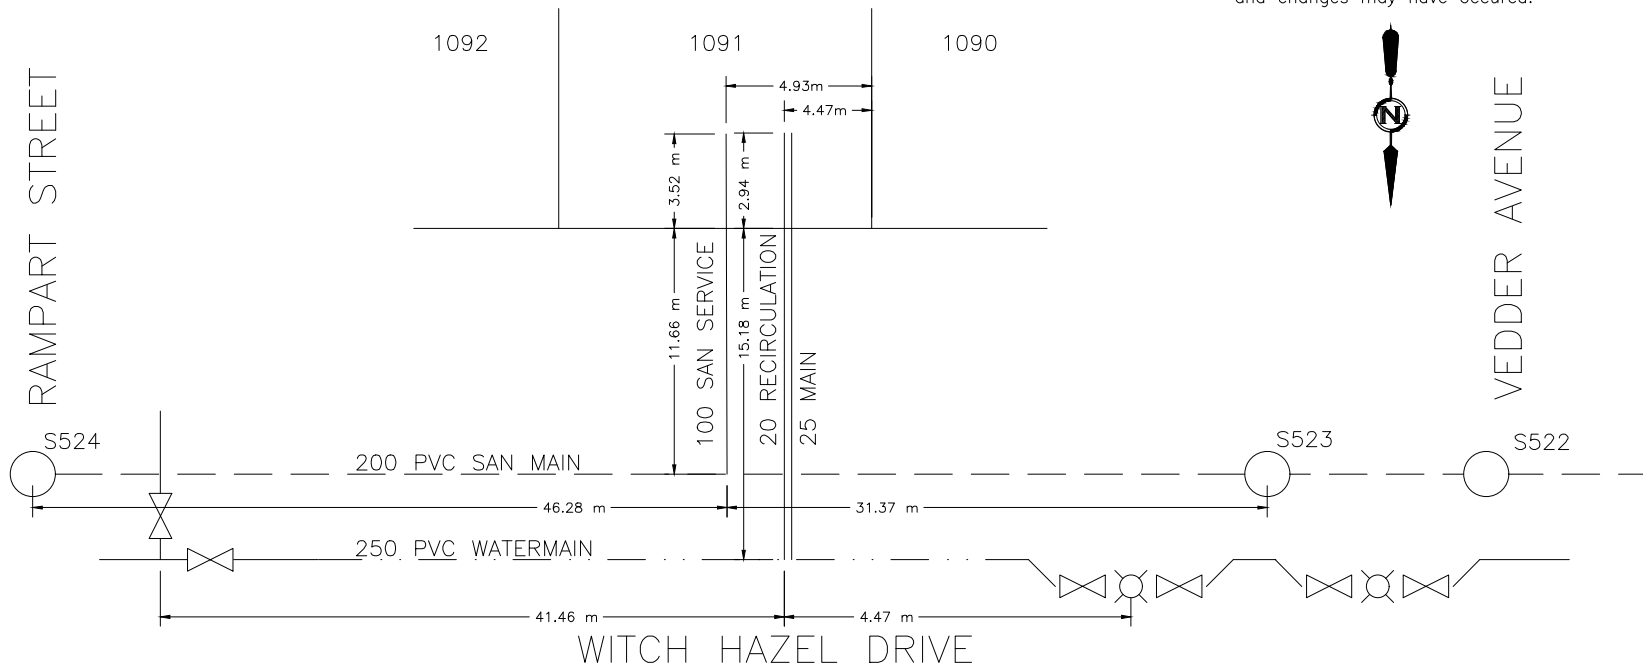



CITY OF WHITEHORSE

SERVICE CONNECTION RECORD

FIELD BOOK

No.

ADDRESS 176 WITCH HAZEL DRIVE BLOCK LOT 1092

DATES


WATER

SEWER

On at Main 20200914	Depth at P/L: 2.44 m	2.49 m
On at Building	Depth at Main: 2.90 m	3.30 m
Frost Plug:	Pipe Size: 20 mm / 25 mm	100 mm
Memo:	Pipe Material: HDPE Insul. <u>Yes</u> /No	PVC Insul. Yes/ <u>No</u>
	Length from Main to P/L: 15.18 m	11.65 m
	Squirt Test: <u>Pass</u> /Fail	N/A
Booster Pump Required: Yes/No	Frost Protection: Aquaflo/ <u>Recirc</u> /Heat Trace/Bleeder	N/A
PRV Required: Yes/No	Greased @ CC: <u>Yes</u> /No	N/A
Water Meter Installed: Yes/No	Continuity Test: <u>N/A</u> Pass/Fail	N/A

CLEARLY INDICATE LOCATION OF CC AND ROUTE OF PIPES ON DRAWING BELOW

1. Show main valves required to isolate this service. 2. All dimensions to be tied to property line 3. All dimensions to be metric 4. Depth @ property line is based on elevation after construction and changes may have occurred.

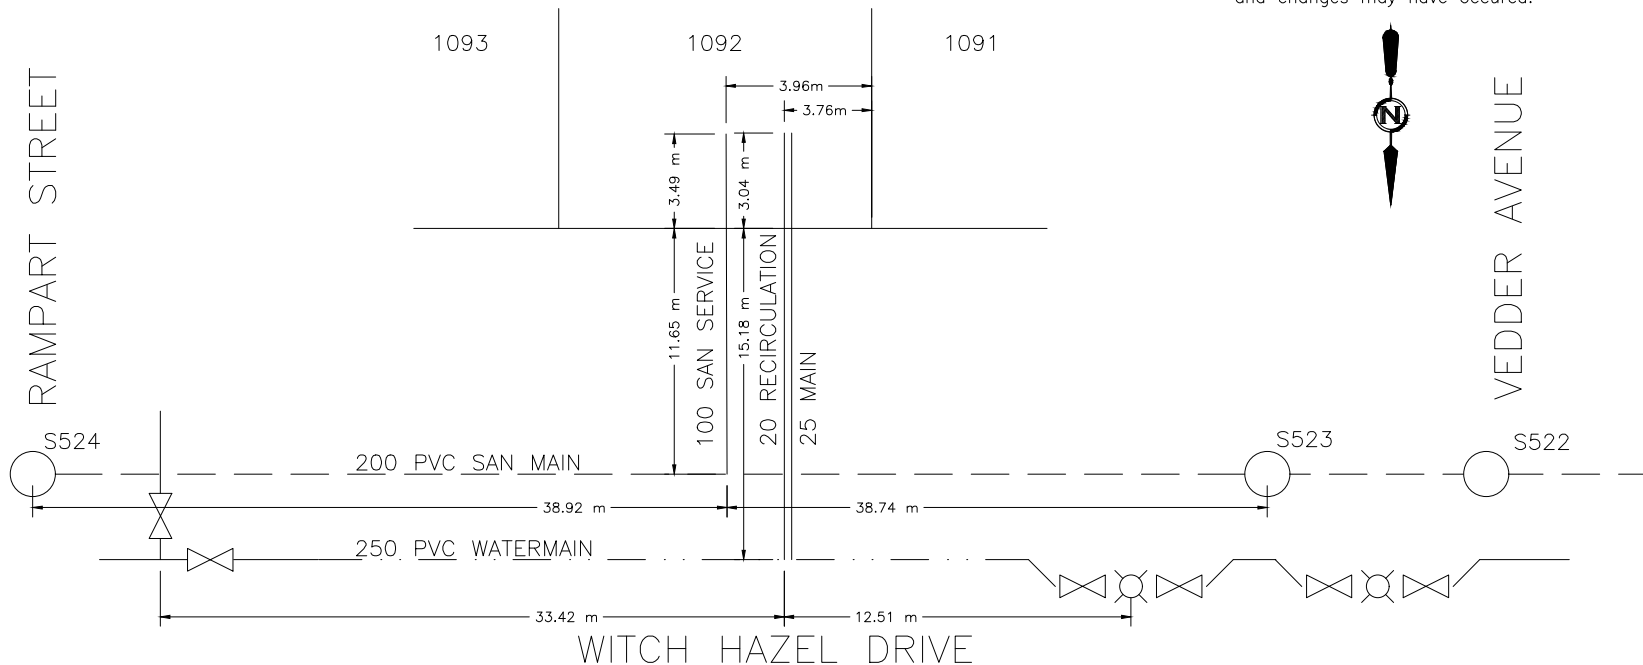



CITY OF WHITEHORSE

SERVICE CONNECTION RECORD

FIELD BOOK

No.

ADDRESS 174 WITCH HAZEL DRIVE BLOCK LOT 1093

DATES


WATER

SEWER

On at Main 20200915	Depth at P/L: 2.45 m	2.49 m
On at Building	Depth at Main: 2.89 m	3.16 m
Frost Plug:	Pipe Size: 20 mm / 25 mm	100 mm
Memo:	Pipe Material: HDPE Insul. <u>Yes</u> /No	PVC Insul. Yes/ <u>No</u>
	Length from Main to P/L: 15.16 m	11.65 m
	Squirt Test: <u>Pass</u> /Fail	N/A
Booster Pump Required: Yes/No	Frost Protection: Aquaflo/ <u>Recirc</u> /Heat Trace/Bleeder	N/A
PRV Required: Yes/No	Greased @ CC: <u>Yes</u> /No	N/A
Water Meter Installed: Yes/No	Continuity Test: <u>N/A</u> Pass/Fail	N/A

CLEARLY INDICATE LOCATION OF CC AND ROUTE OF PIPES ON DRAWING BELOW

1. Show main valves required to isolate this service.
2. All dimensions to be tied to property line
3. All dimensions to be metric
4. Depth @ property line is based on elevation after construction and changes may have occurred.

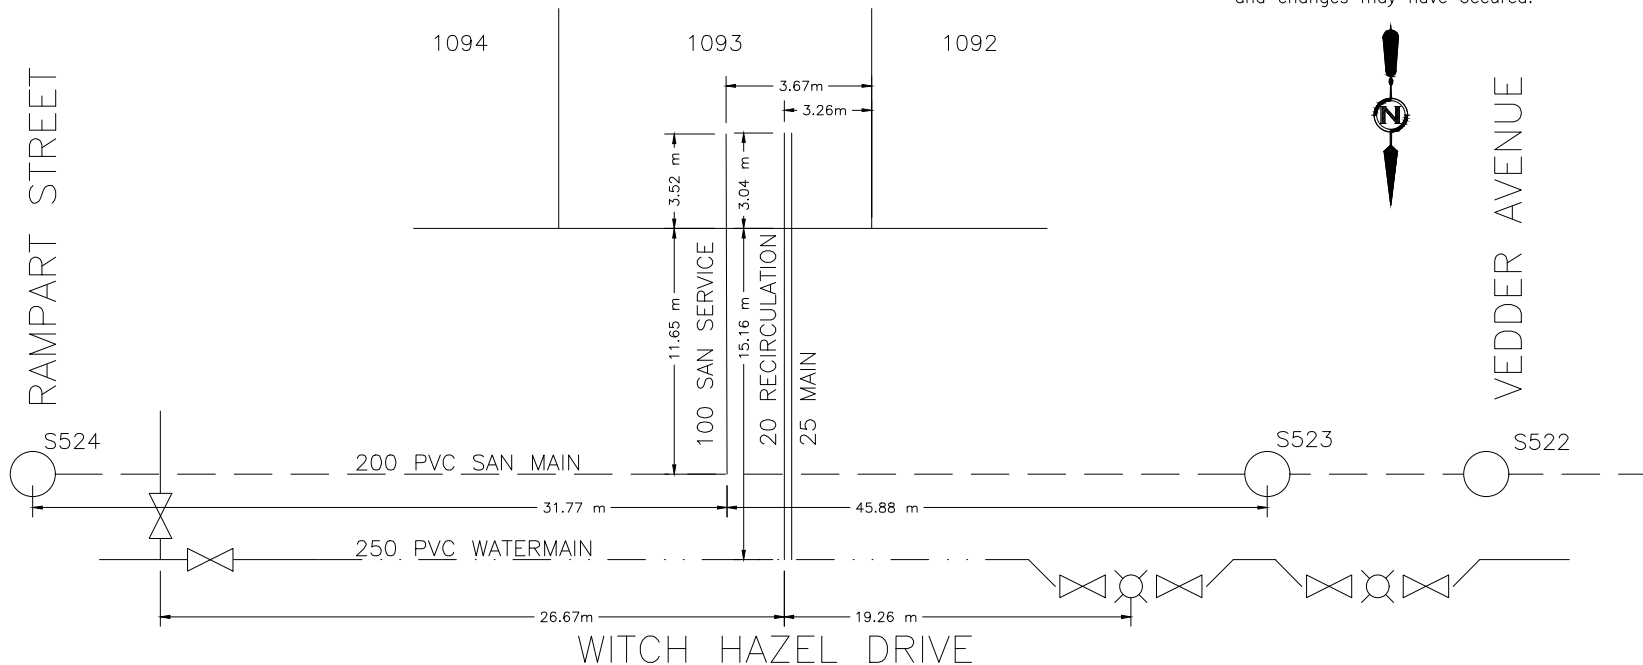



CITY OF WHITEHORSE

SERVICE CONNECTION RECORD

FIELD BOOK

No.

ADDRESS 172 WITCH HAZEL DRIVE BLOCK LOT 1094

DATES


WATER

SEWER

On at Main 20200912	Depth at P/L: 2.42 m	2.48 m
On at Building	Depth at Main: 2.90 m	3.01 m
Frost Plug:	Pipe Size: 20 mm / 25 mm	100 mm
Memo:	Pipe Material: HDPE Insul. <u>Yes</u> /No	PVC Insul. Yes/ <u>No</u>
	Length from Main to P/L: 15.16 m	11.66 m
	Squirt Test: <u>Pass</u> /Fail	N/A
Booster Pump Required: Yes/No	Frost Protection: Aquaflo/ <u>Recirc</u> /Heat Trace/Bleeder	N/A
PRV Required: Yes/No	Greased @ CC: <u>Yes</u> /No	N/A
Water Meter Installed: Yes/No	Continuity Test: <u>N/A</u> Pass/Fail	N/A

CLEARLY INDICATE LOCATION OF CC AND ROUTE OF PIPES ON DRAWING BELOW

1. Show main valves required to isolate this service. 2. All dimensions to be tied to property line 3. All dimensions to be metric 4. Depth @ property line is based on elevation after construction and changes may have occurred.

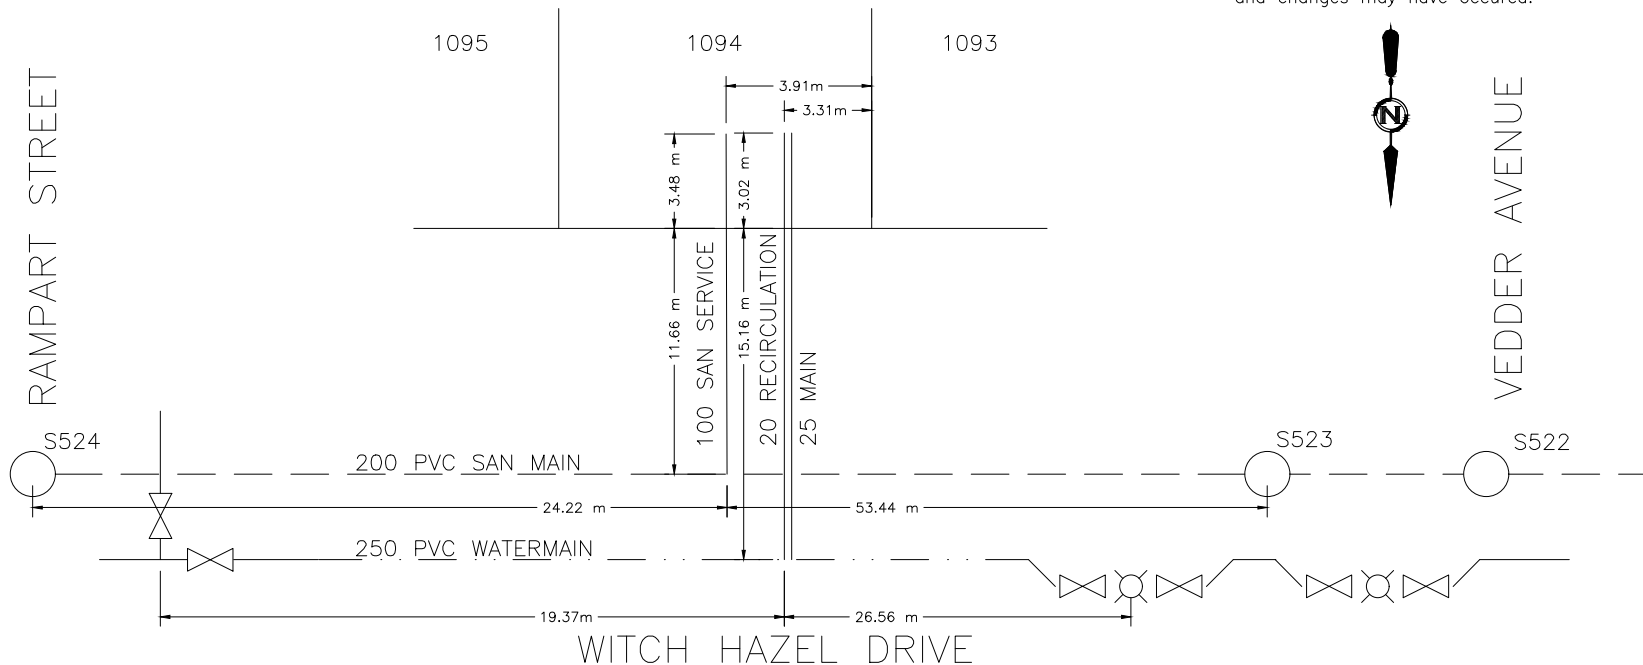



CITY OF WHITEHORSE

SERVICE CONNECTION RECORD

FIELD BOOK

No.

ADDRESS 170 WITCH HAZEL DRIVE BLOCK LOT 1095

DATES

WATER

SEWER

On at Main 20200915	Depth at P/L: 2.40 m	2.42 m
On at Building	Depth at Main: 2.87 m	2.87 m
Frost Plug:	Pipe Size: 20 mm / 25 mm	100 mm
Memo:	Pipe Material: HDPE Insul. <u>Yes</u> /No	PVC Insul. Yes/ <u>No</u>
	Length from Main to P/L: 15.17 m	11.67 m
	Squirt Test: <u>Pass</u> /Fail	N/A
Booster Pump Required: Yes/No	Frost Protection: Aquaflo/ <u>Recirc</u> /Heat Trace/Bleeder	N/A
PRV Required: Yes/No	Greased @ CC: <u>Yes</u> /No	N/A
Water Meter Installed: Yes/No	Continuity Test: <u>N/A</u> Pass/Fail	N/A

CLEARLY INDICATE LOCATION OF CC AND ROUTE OF PIPES ON DRAWING BELOW

1. Show main valves required to isolate this service. 2. All dimensions to be tied to property line 3. All dimensions to be metric 4. Depth @ property line is based on elevation after construction and changes may have occurred.

