



CITY OF WHITEHORSE SERVICE CONNECTION RECORD

FIELD BOOK

No.

ADDRESS 167 RAMPART AVENUE BLOCK LOT 1260

DATES


WATER

SEWER

On at Main 20220831	Depth at P/L: 2.56 m	2.59 m
On at Building	Depth at Main: 3.25 m	2.94 m
Frost Plug:	Pipe Size: 20 mm / 25 mm	100 mm
Memo:	Pipe Material: HDPE Insul. <u>Yes</u> /No	PVC Insul. Yes/ <u>No</u>
	Length from Main to P/L: 12.03 m	6.15 m
	Squirt Test: <u>Pass</u> /Fail	N/A
Booster Pump Required: Yes/No	Frost Protection: Aquaflow/ <u>Recirc</u> /Heat Trace/Bleeder	N/A
PRV Required: Yes/No	Greased @ CC: <u>Yes</u> /No	N/A
Water Meter Installed: Yes/No	Continuity Test: <u>N/A</u> Pass/Fail	N/A

CLEARLY INDICATE LOCATION OF CC AND ROUTE OF PIPES ON DRAWING BELOW

1. Show main valves required to isolate this service. 2. All dimensions to be tied to property line 3. All dimensions to be metric 4. Depth @ property line is based on elevation after construction and changes may have occurred.

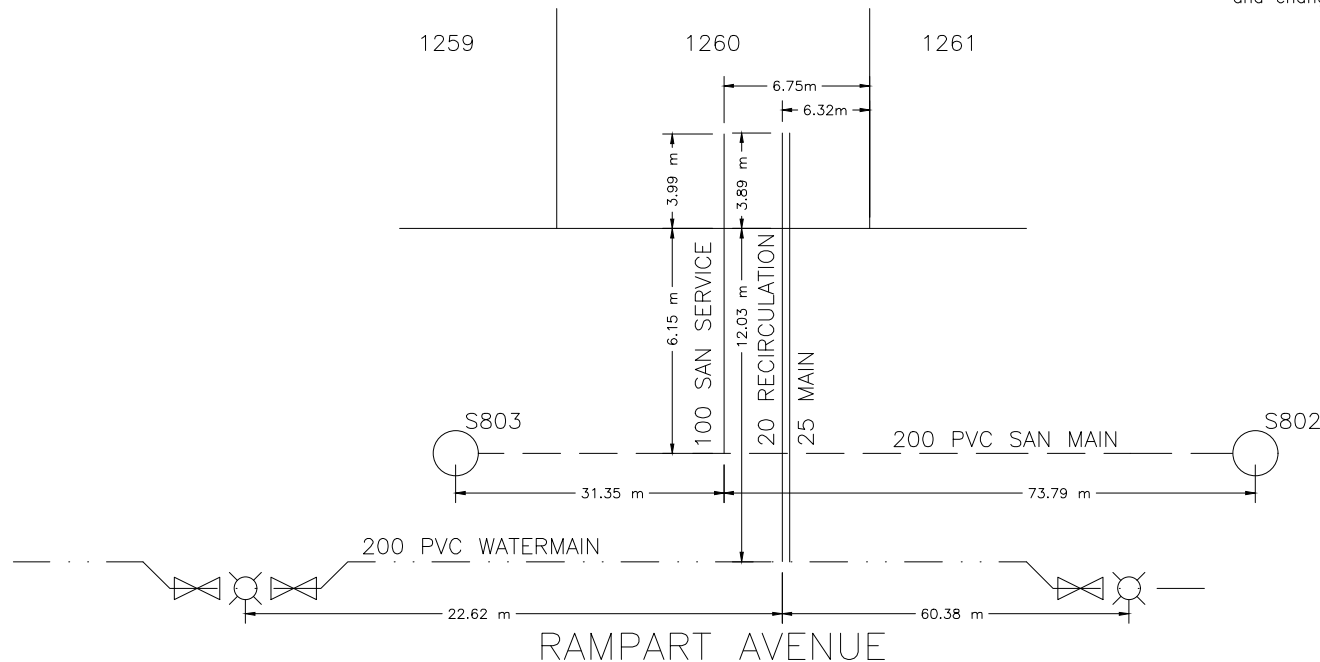



CITY OF WHITEHORSE SERVICE CONNECTION RECORD

FIELD BOOK

No.

ADDRESS 165 RAMPART AVENUE BLOCK LOT 1261

DATES


WATER

SEWER

On at Main 20220831	Depth at P/L: 2.47 m	2.51 m
On at Building	Depth at Main: 3.24 m	2.94 m
Frost Plug:	Pipe Size: 20 mm / 25 mm	100 mm
Memo:	Pipe Material: HDPE Insul. <u>Yes</u> /No	PVC Insul. Yes/ <u>No</u>
	Length from Main to P/L: 12.03 m	6.25 m
	Squirt Test: <u>Pass</u> /Fail	N/A
Booster Pump Required: Yes/No	Frost Protection: Aquaflow/ <u>Recirc</u> /Heat Trace/Bleeder	N/A
PRV Required: Yes/No	Greased @ CC: <u>Yes</u> /No	N/A
Water Meter Installed: Yes/No	Continuity Test: <u>N/A</u> Pass/Fail	N/A

CLEARLY INDICATE LOCATION OF CC AND ROUTE OF PIPES ON DRAWING BELOW

1. Show main valves required to isolate this service. 2. All dimensions to be tied to property line 3. All dimensions to be metric 4. Depth @ property line is based on elevation after construction and changes may have occurred.

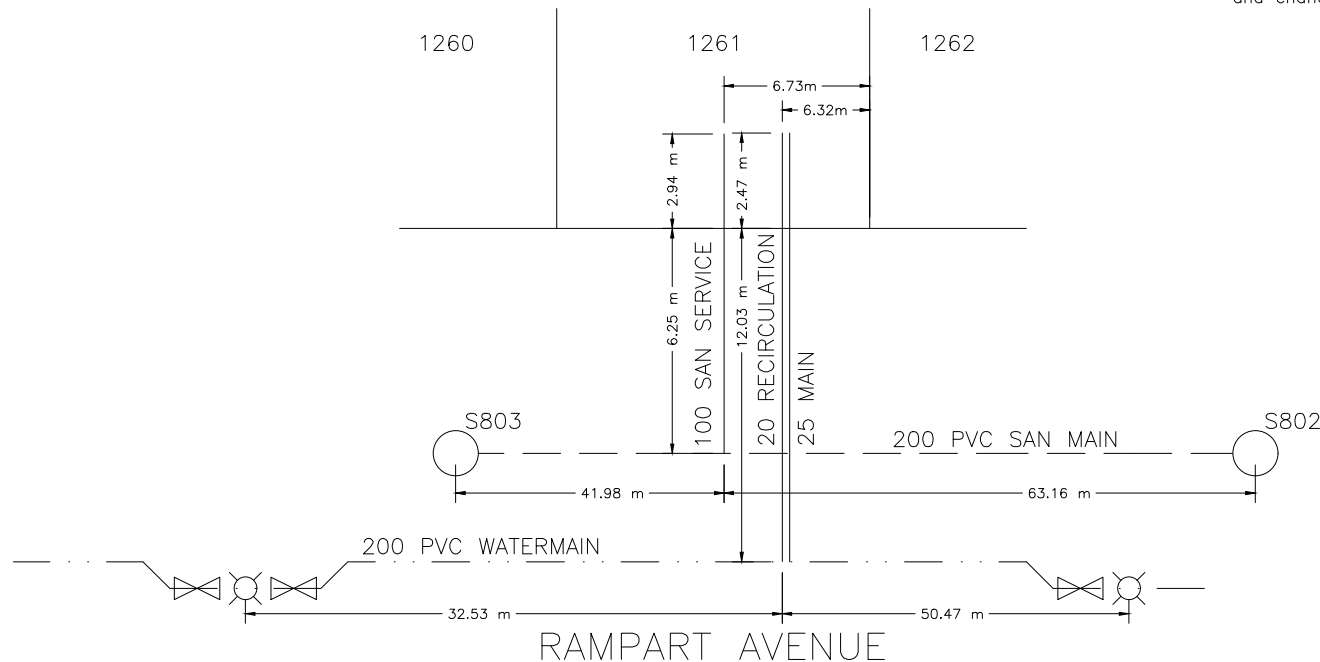



CITY OF WHITEHORSE SERVICE CONNECTION RECORD

FIELD BOOK

No.

ADDRESS 163 RAMPART AVENUE BLOCK LOT 1262

DATES


WATER

SEWER

On at Main 20220831	Depth at P/L: 2.52 m	2.55 m
On at Building	Depth at Main: 3.20 m	2.93 m
Frost Plug:	Pipe Size: 20 mm / 25 mm	100 mm
Memo:	Pipe Material: HDPE Insul. <u>Yes</u> /No	PVC Insul. Yes/ <u>No</u>
	Length from Main to P/L: 12.12 m	6.20 m
	Squirt Test: <u>Pass</u> /Fail	N/A
Booster Pump Required: Yes/No	Frost Protection: Aquaflow/ <u>Recirc</u> /Heat Trace/Bleeder	N/A
PRV Required: Yes/No	Greased @ CC: <u>Yes</u> /No	N/A
Water Meter Installed: Yes/No	Continuity Test: <u>N/A</u> Pass/Fail	N/A

CLEARLY INDICATE LOCATION OF CC AND ROUTE OF PIPES ON DRAWING BELOW

1. Show main valves required to isolate this service. 2. All dimensions to be tied to property line 3. All dimensions to be metric 4. Depth @ property line is based on elevation after construction and changes may have occurred.

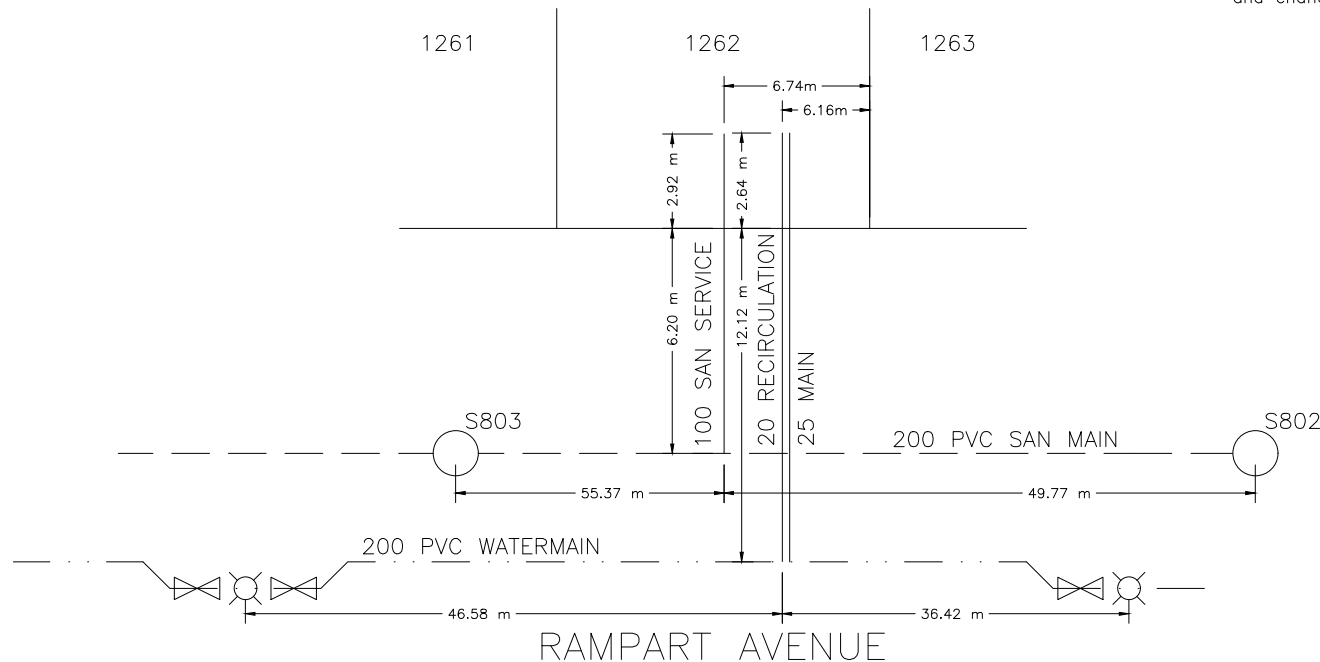



CITY OF WHITEHORSE SERVICE CONNECTION RECORD

FIELD BOOK

No.

ADDRESS 161 RAMPART AVENUE BLOCK LOT 1263

DATES


WATER

SEWER

On at Main 20220831	Depth at P/L: 2.58 m	2.63 m
On at Building	Depth at Main: 3.12 m	2.91 m
Frost Plug:	Pipe Size: 20 mm / 25 mm	100 mm
Memo:	Pipe Material: HDPE Insul. <u>Yes</u> /No	PVC Insul. Yes/ <u>No</u>
	Length from Main to P/L: 12.06 m	6.16 m
	Squirt Test: <u>Pass</u> /Fail	N/A
Booster Pump Required: Yes/No	Frost Protection: Aquaflow/ <u>Recirc</u> /Heat Trace/Bleeder	N/A
PRV Required: Yes/No	Greased @ CC: <u>Yes</u> /No	N/A
Water Meter Installed: Yes/No	Continuity Test: <u>N/A</u> Pass/Fail	N/A

CLEARLY INDICATE LOCATION OF CC AND ROUTE OF PIPES ON DRAWING BELOW

1. Show main valves required to isolate this service. 2. All dimensions to be tied to property line 3. All dimensions to be metric 4. Depth @ property line is based on elevation after construction and changes may have occurred.

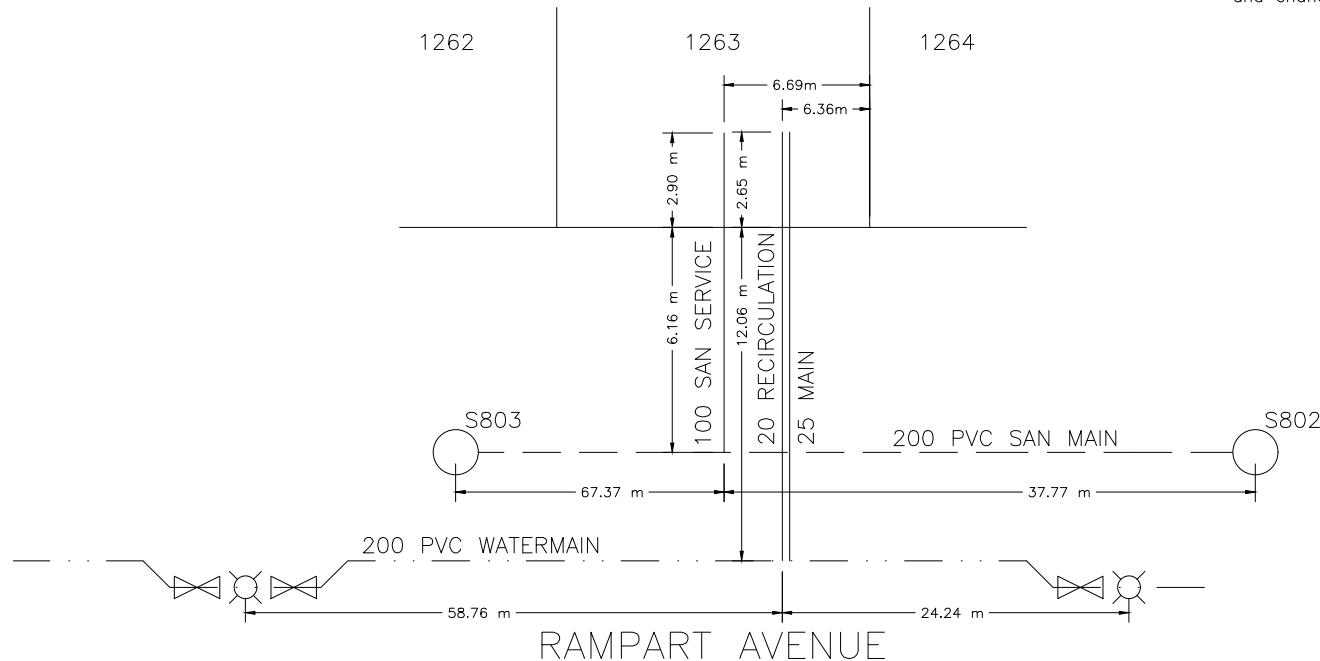



CITY OF WHITEHORSE SERVICE CONNECTION RECORD

FIELD BOOK

No.

ADDRESS 159 RAMPART AVENUE BLOCK LOT 1264

DATES


WATER

SEWER

On at Main 20220831	Depth at P/L: 2.61 m	2.61 m
On at Building	Depth at Main: 3.11 m	2.89 m
Frost Plug:	Pipe Size: 20 mm / 25 mm	100 mm
Memo:	Pipe Material: HDPE Insul. <u>Yes</u> /No	PVC Insul. Yes/ <u>No</u>
	Length from Main to P/L: 12.09 m	6.18 m
	Squirt Test: <u>Pass</u> /Fail	N/A
Booster Pump Required: Yes/No	Frost Protection: Aquaflow/ <u>Recirc</u> /Heat Trace/Bleeder	N/A
PRV Required: Yes/No	Greased @ CC: <u>Yes</u> /No	N/A
Water Meter Installed: Yes/No	Continuity Test: <u>N/A</u> Pass/Fail	N/A

CLEARLY INDICATE LOCATION OF CC AND ROUTE OF PIPES ON DRAWING BELOW

1. Show main valves required to isolate this service. 2. All dimensions to be tied to property line 3. All dimensions to be metric 4. Depth @ property line is based on elevation after construction and changes may have occurred.

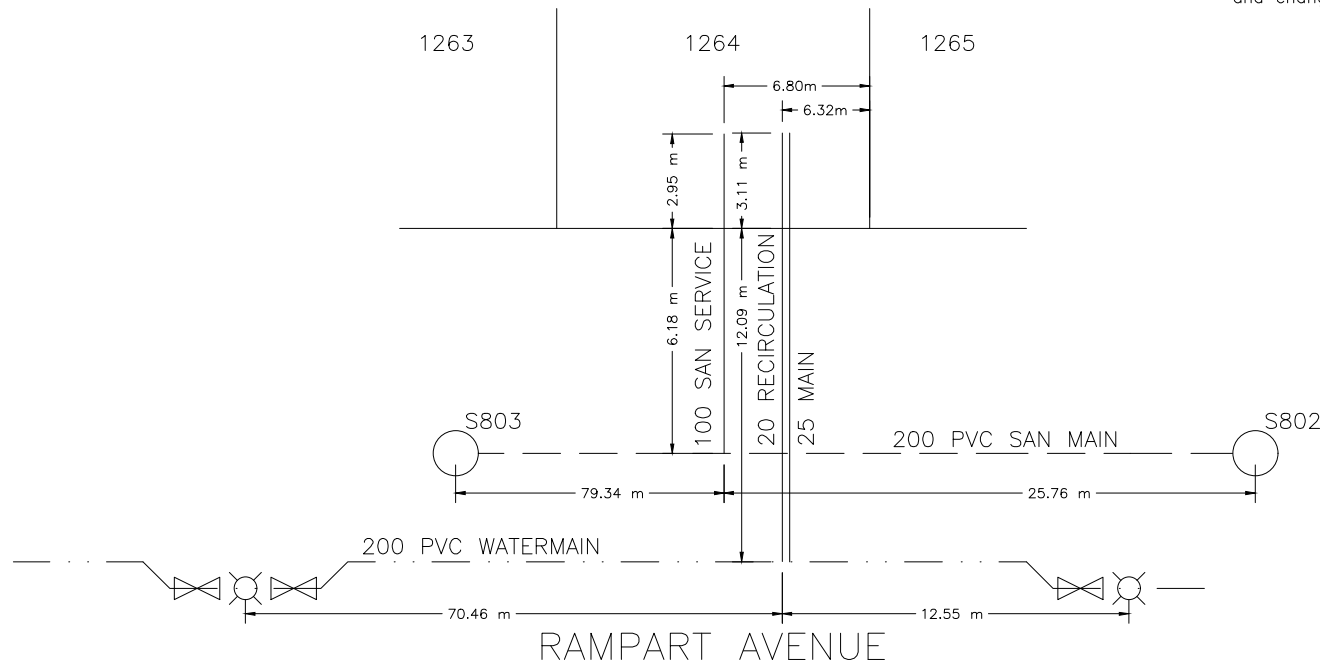



CITY OF WHITEHORSE

SERVICE CONNECTION RECORD

FIELD BOOK

No.

ADDRESS 157 RAMPART AVENUE BLOCK LOT 1266

DATES


WATER

SEWER

On at Main 20220901	Depth at P/L: 2.53 m	2.59 m
On at Building	Depth at Main: 3.03 m	2.86 m
Frost Plug:	Pipe Size: 20 mm / 25 mm	100 mm
Memo:	Pipe Material: HDPE Insul. <u>Yes</u> /No	PVC Insul. Yes/ <u>No</u>
	Length from Main to P/L: 13.94 m	6.30 m
	Squirt Test: <u>Pass</u> /Fail	N/A
Booster Pump Required: Yes/No	Frost Protection: Aquaflow/ <u>Recirc</u> /Heat Trace/Bleeder	N/A
PRV Required: Yes/No	Greased @ CC: <u>Yes</u> /No	N/A
Water Meter Installed: Yes/No	Continuity Test: <u>N/A</u> Pass/Fail	N/A

CLEARLY INDICATE LOCATION OF CC AND ROUTE OF PIPES ON DRAWING BELOW

1. Show main valves required to isolate this service. 2. All dimensions to be tied to property line 3. All dimensions to be metric 4. Depth @ property line is based on elevation after construction and changes may have occurred.

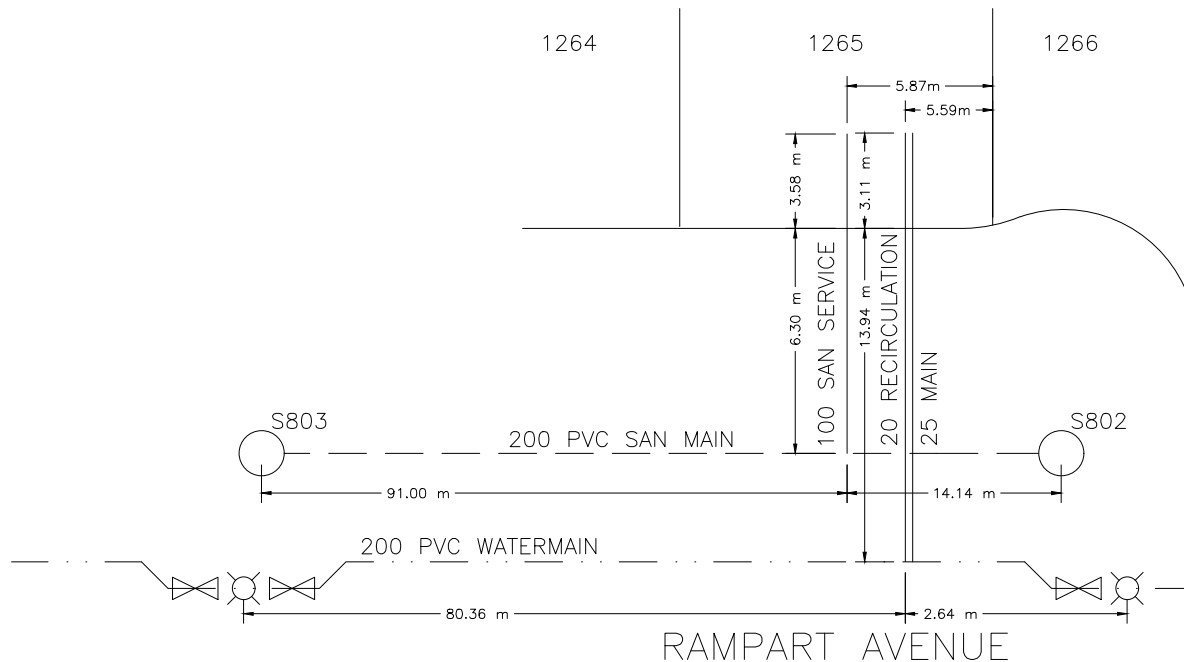



CITY OF WHITEHORSE SERVICE CONNECTION RECORD

FIELD BOOK

No.

ADDRESS 155 RAMPART AVENUE BLOCK LOT 1266

DATES


WATER

SEWER

On at Main 20220901	Depth at P/L: 2.52 m	2.54 m
On at Building	Depth at Main: 3.07 m	2.86 m
Frost Plug:	Pipe Size: 20 mm / 25 mm	100 mm
Memo:	Pipe Material: HDPE Insul. <u>Yes</u> /No	PVC Insul. Yes/ <u>No</u>
	Length from Main to P/L: 19.15 m	9.32 m
	Squirt Test: <u>Pass</u> /Fail	N/A
Booster Pump Required: Yes/No	Frost Protection: Aquaflow/ <u>Recirc</u> /Heat Trace/Bleeder	N/A
PRV Required: Yes/No	Greased @ CC: <u>Yes</u> /No	N/A
Water Meter Installed: Yes/No	Continuity Test: <u>N/A</u> Pass/Fail	N/A

CLEARLY INDICATE LOCATION OF CC AND ROUTE OF PIPES ON DRAWING BELOW

1. Show main valves required to isolate this service. 2. All dimensions to be tied to property line 3. All dimensions to be metric 4. Depth @ property line is based on elevation after construction and changes may have occurred.

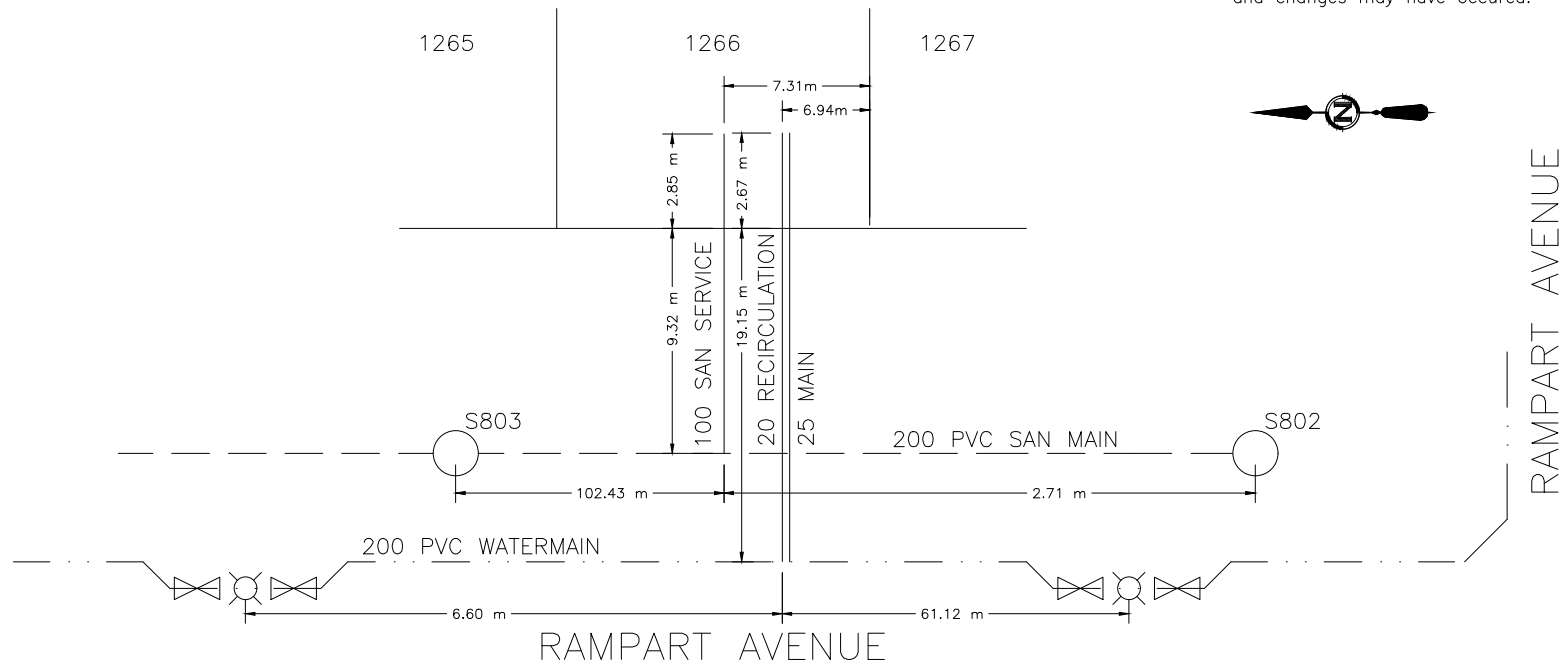



CITY OF WHITEHORSE SERVICE CONNECTION RECORD

FIELD BOOK

No.

ADDRESS 153 RAMPART AVENUE BLOCK LOT 1267

DATES


WATER

SEWER

On at Main 20220901	Depth at P/L: 2.44 m	2.48 m
On at Building	Depth at Main: 3.07 m	2.93 m
Frost Plug:	Pipe Size: 20 mm / 25 mm	100 mm
Memo:	Pipe Material: HDPE Insul. <u>Yes</u> /No	PVC Insul. Yes/ <u>No</u>
	Length from Main to P/L: 21.39 m	12.04 m
	Squirt Test: <u>Pass</u> /Fail	N/A
Booster Pump Required: Yes/No	Frost Protection: Aquaflo/ <u>Recirc</u> /Heat Trace/Bleeder	N/A
PRV Required: Yes/No	Greased @ CC: <u>Yes</u> /No	N/A
Water Meter Installed: Yes/No	Continuity Test: <u>N/A</u> Pass/Fail	N/A

CLEARLY INDICATE LOCATION OF CC AND ROUTE OF PIPES ON DRAWING BELOW

1. Show main valves required to isolate this service. 2. All dimensions to be tied to property line 3. All dimensions to be metric 4. Depth @ property line is based on elevation after construction and changes may have occurred.

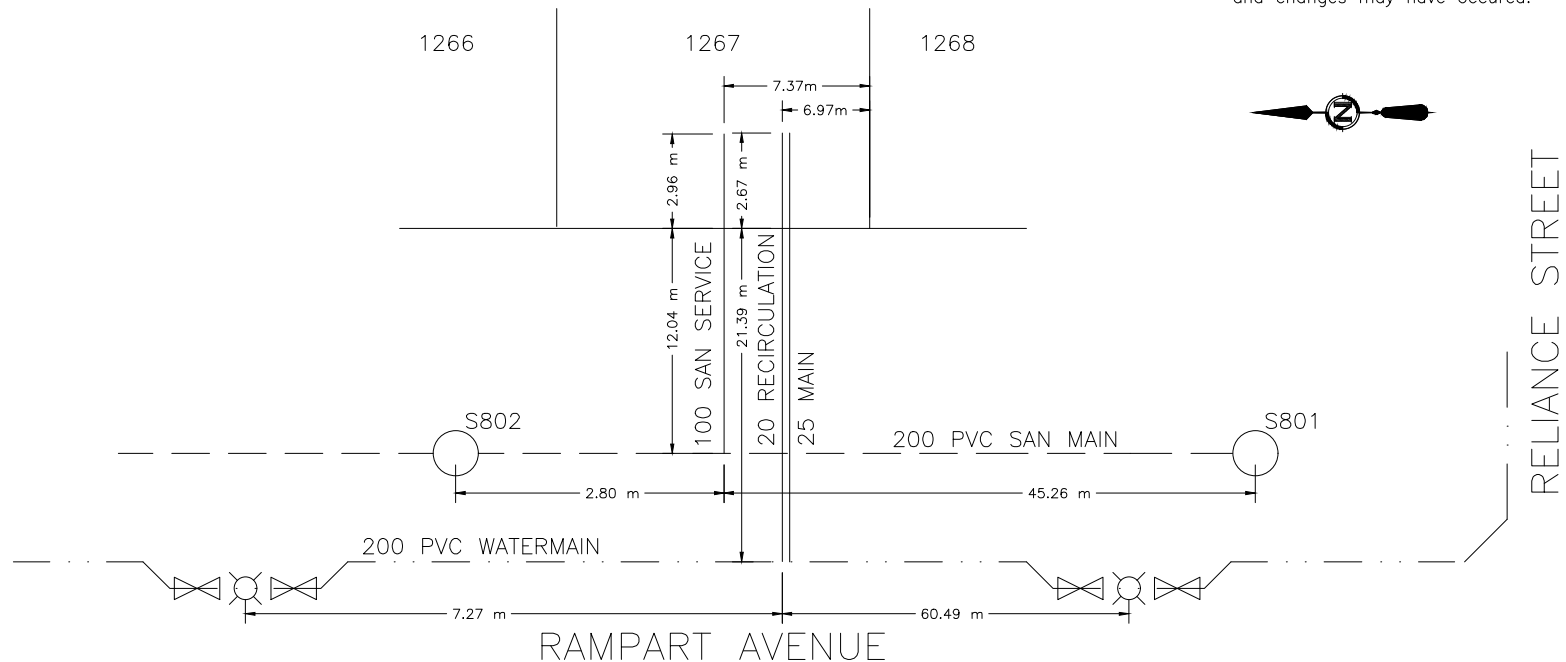



CITY OF WHITEHORSE SERVICE CONNECTION RECORD

FIELD BOOK

No.

ADDRESS 147 RAMPART AVENUE BLOCK LOT 1270

DATES


WATER

SEWER

On at Main 20220831	Depth at P/L: 2.45 m	2.50 m
On at Building	Depth at Main: 2.99 m	2.79 m
Frost Plug:	Pipe Size: 20 mm / 25 mm	100 mm
Memo:	Pipe Material: HDPE Insul. <u>Yes</u> /No	PVC Insul. Yes/ <u>No</u>
	Length from Main to P/L: 12.32 m	6.40 m
	Squirt Test: <u>Pass</u> /Fail	N/A
Booster Pump Required: Yes/No	Frost Protection: Aquaflo/ <u>Recirc</u> /Heat Trace/Bleeder	N/A
PRV Required: Yes/No	Greased @ CC: <u>Yes</u> /No	N/A
Water Meter Installed: Yes/No	Continuity Test: <u>N/A</u> Pass/Fail	N/A

CLEARLY INDICATE LOCATION OF CC AND ROUTE OF PIPES ON DRAWING BELOW

1. Show main valves required to isolate this service. 2. All dimensions to be tied to property line 3. All dimensions to be metric 4. Depth @ property line is based on elevation after construction and changes may have occurred.

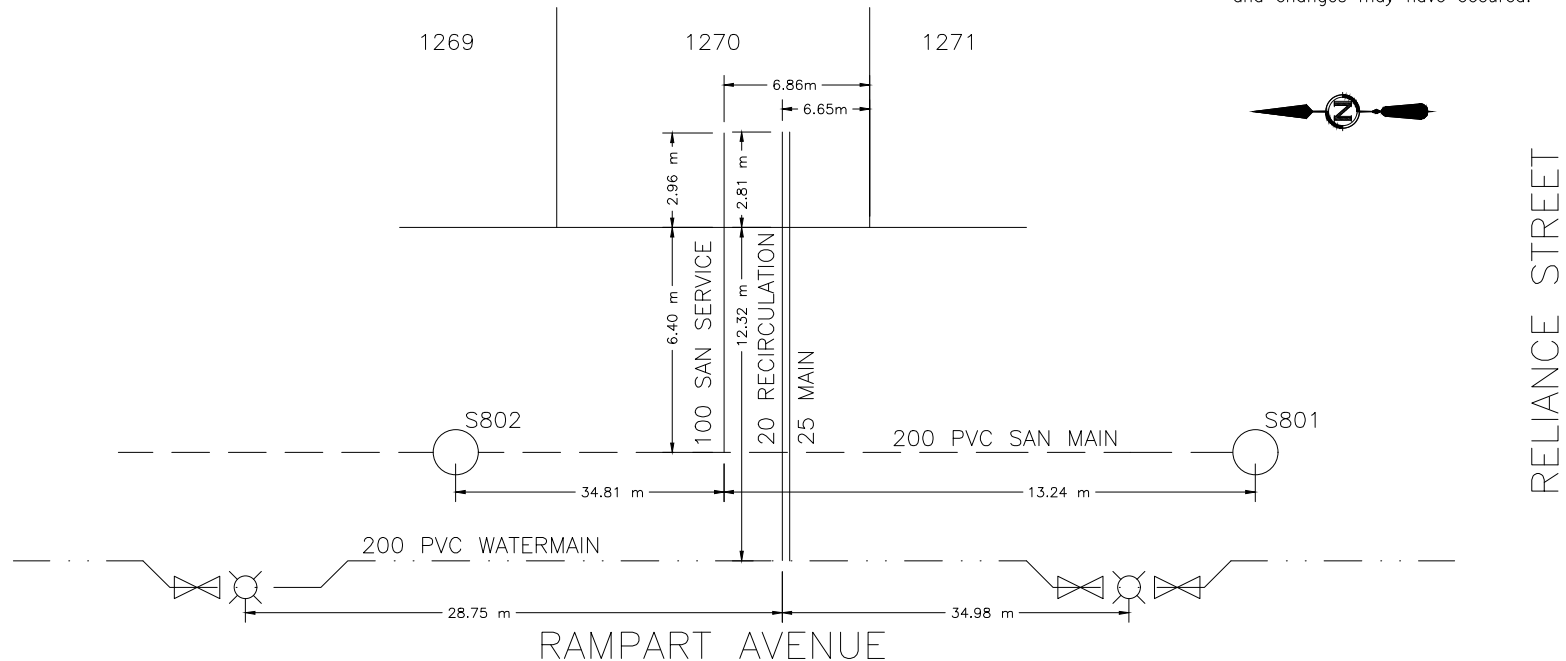



CITY OF WHITEHORSE SERVICE CONNECTION RECORD

FIELD BOOK

No.

ADDRESS 145 RAMPART AVENUE BLOCK LOT 1271

DATES


WATER

SEWER

On at Main 20220831	Depth at P/L: 2.43 m	2.54 m
On at Building	Depth at Main: 2.95 m	2.77 m
Frost Plug:	Pipe Size: 20 mm / 25 mm	100 mm
Memo:	Pipe Material: HDPE Insul. <u>Yes</u> /No	PVC Insul. Yes/ <u>No</u>
	Length from Main to P/L: 11.89 m	6.01 m
	Squirt Test: <u>Pass</u> /Fail	N/A
Booster Pump Required: Yes/No	Frost Protection: Aquaflow/ <u>Recirc</u> /Heat Trace/Bleeder	N/A
PRV Required: Yes/No	Greased @ CC: <u>Yes</u> /No	N/A
Water Meter Installed: Yes/No	Continuity Test: <u>N/A</u> Pass/Fail	N/A

CLEARLY INDICATE LOCATION OF CC AND ROUTE OF PIPES ON DRAWING BELOW

1. Show main valves required to isolate this service. 2. All dimensions to be tied to property line 3. All dimensions to be metric 4. Depth @ property line is based on elevation after construction and changes may have occurred.

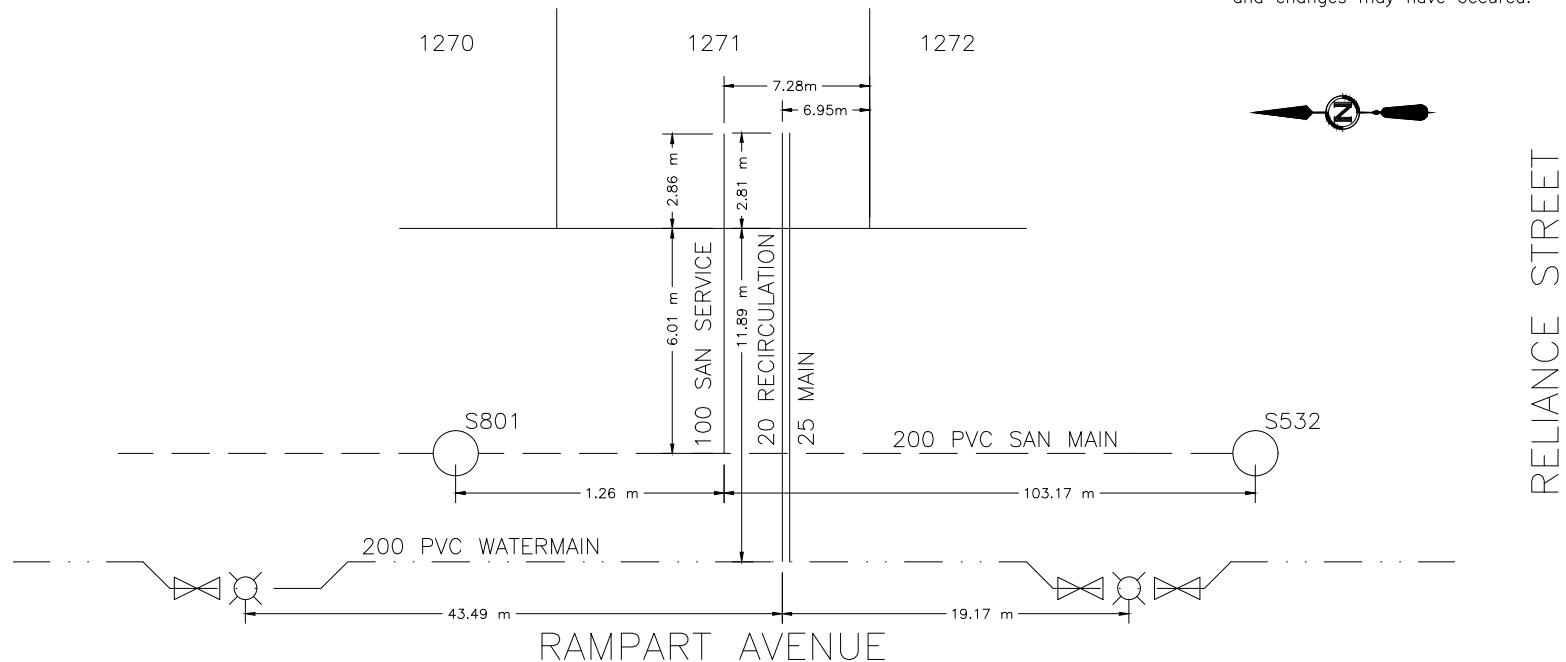



CITY OF WHITEHORSE SERVICE CONNECTION RECORD

FIELD BOOK

No.

ADDRESS 143 RAMPART AVENUE BLOCK LOT 1272

DATES


WATER

SEWER

On at Main 20220831	Depth at P/L: 2.39 m	2.49 m
On at Building	Depth at Main: 2.89 m	2.71 m
Frost Plug:	Pipe Size: 20 mm / 25 mm	100 mm
Memo:	Pipe Material: HDPE Insul. <u>(Yes)</u> /No	PVC Insul. Yes/ <u>(No)</u>
	Length from Main to P/L: 11.90 m	6.06 m
	Squirt Test: <u>(Pass)</u> /Fail	N/A
Booster Pump Required: Yes/No	Frost Protection: Aquaflow/ <u>(Recirc)</u> /Heat Trace/Bleeder	N/A
PRV Required: Yes/No	Greased @ CC: <u>(Yes)</u> /No	N/A
Water Meter Installed: Yes/No	Continuity Test: <u>(N/A)</u> Pass/Fail	N/A

CLEARLY INDICATE LOCATION OF CC AND ROUTE OF PIPES ON DRAWING BELOW

1. Show main valves required to isolate this service. 2. All dimensions to be tied to property line 3. All dimensions to be metric 4. Depth @ property line is based on elevation after construction and changes may have occurred.

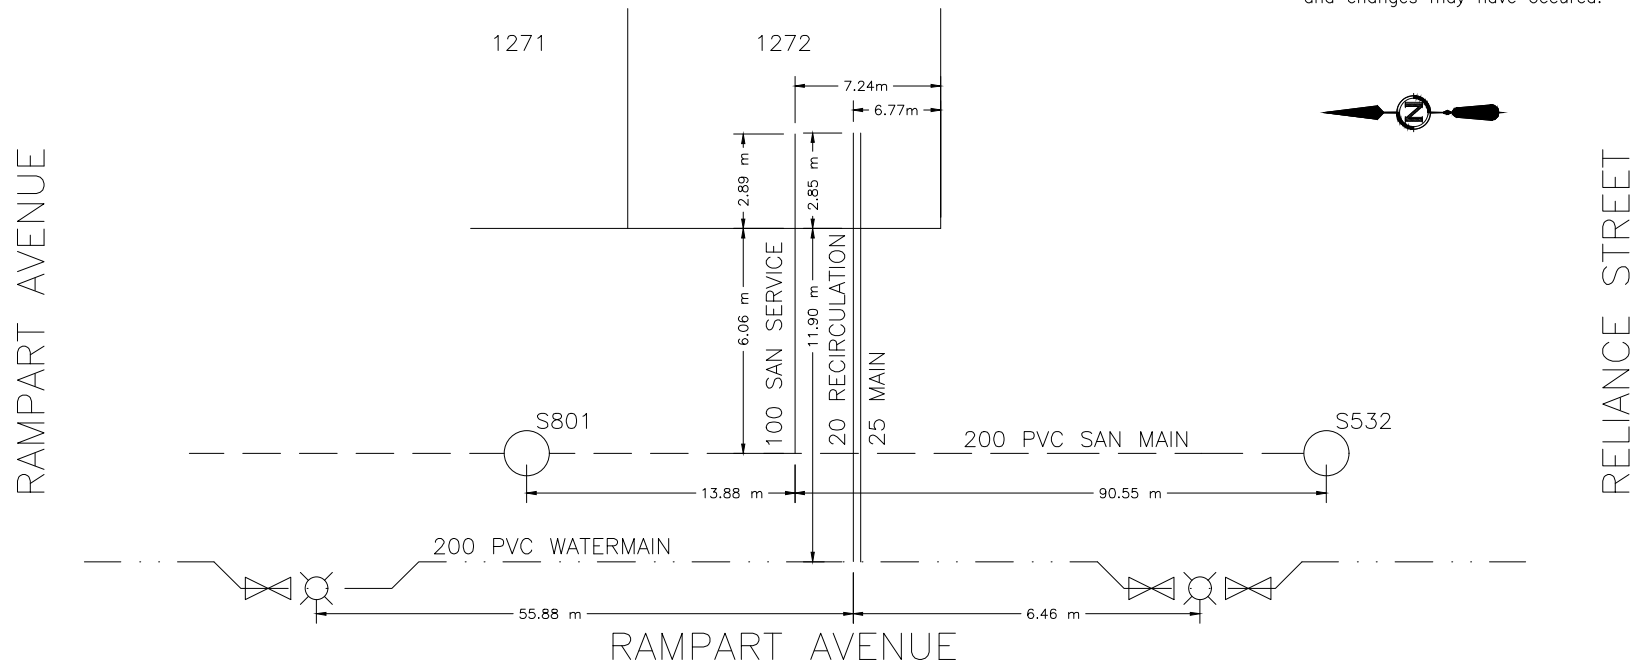



CITY OF WHITEHORSE

SERVICE CONNECTION RECORD

FIELD BOOK

No.

ADDRESS 154 RAMPART AVENUE BLOCK LOT 1273

DATES

WATER

SEWER

On at Main 20220831	Depth at P/L: 3.27 m	2.77 m
On at Building	Depth at Main: 3.17 m	2.68 m
Frost Plug:	Pipe Size: 150 mm / 150 mm	150 mm
Memo:	Pipe Material: PVC	Insul. <u>Yes</u> /No
	Length from Main to P/L: 6.00 m	12.00 m
	Squirt Test: <u>Pass</u> /Fail	N/A
Booster Pump Required: Yes/No	Frost Protection: Aquaflow/ <u>Recirc</u> /Heat Trace/Bleeder	N/A
PRV Required: Yes/No	Greased @ CC: N/A Yes/No	N/A
Water Meter Installed: Yes/No	Continuity Test: <u>N/A</u> Pass/Fail	N/A

CLEARLY INDICATE LOCATION OF CC AND ROUTE OF PIPES ON DRAWING BELOW

1. Show main valves required to isolate this service.
2. All dimensions to be tied to property line
3. All dimensions to be metric
4. Depth @ property line is based on elevation after construction and changes may have occurred.

