




CITY OF WHITEHORSE
DESIGN APPROVALS

PREVIOUSLY SIGNED	JAN. 17, 2020
MANAGER OF OPERATIONS	DATE
PREVIOUSLY SIGNED	JAN. 16, 2020
MANAGER OF ENGINEERING SERVICES	DATE
PREVIOUSLY SIGNED	JAN. 17, 2020
MANAGER OF WATER & WASTE SERVICES	DATE



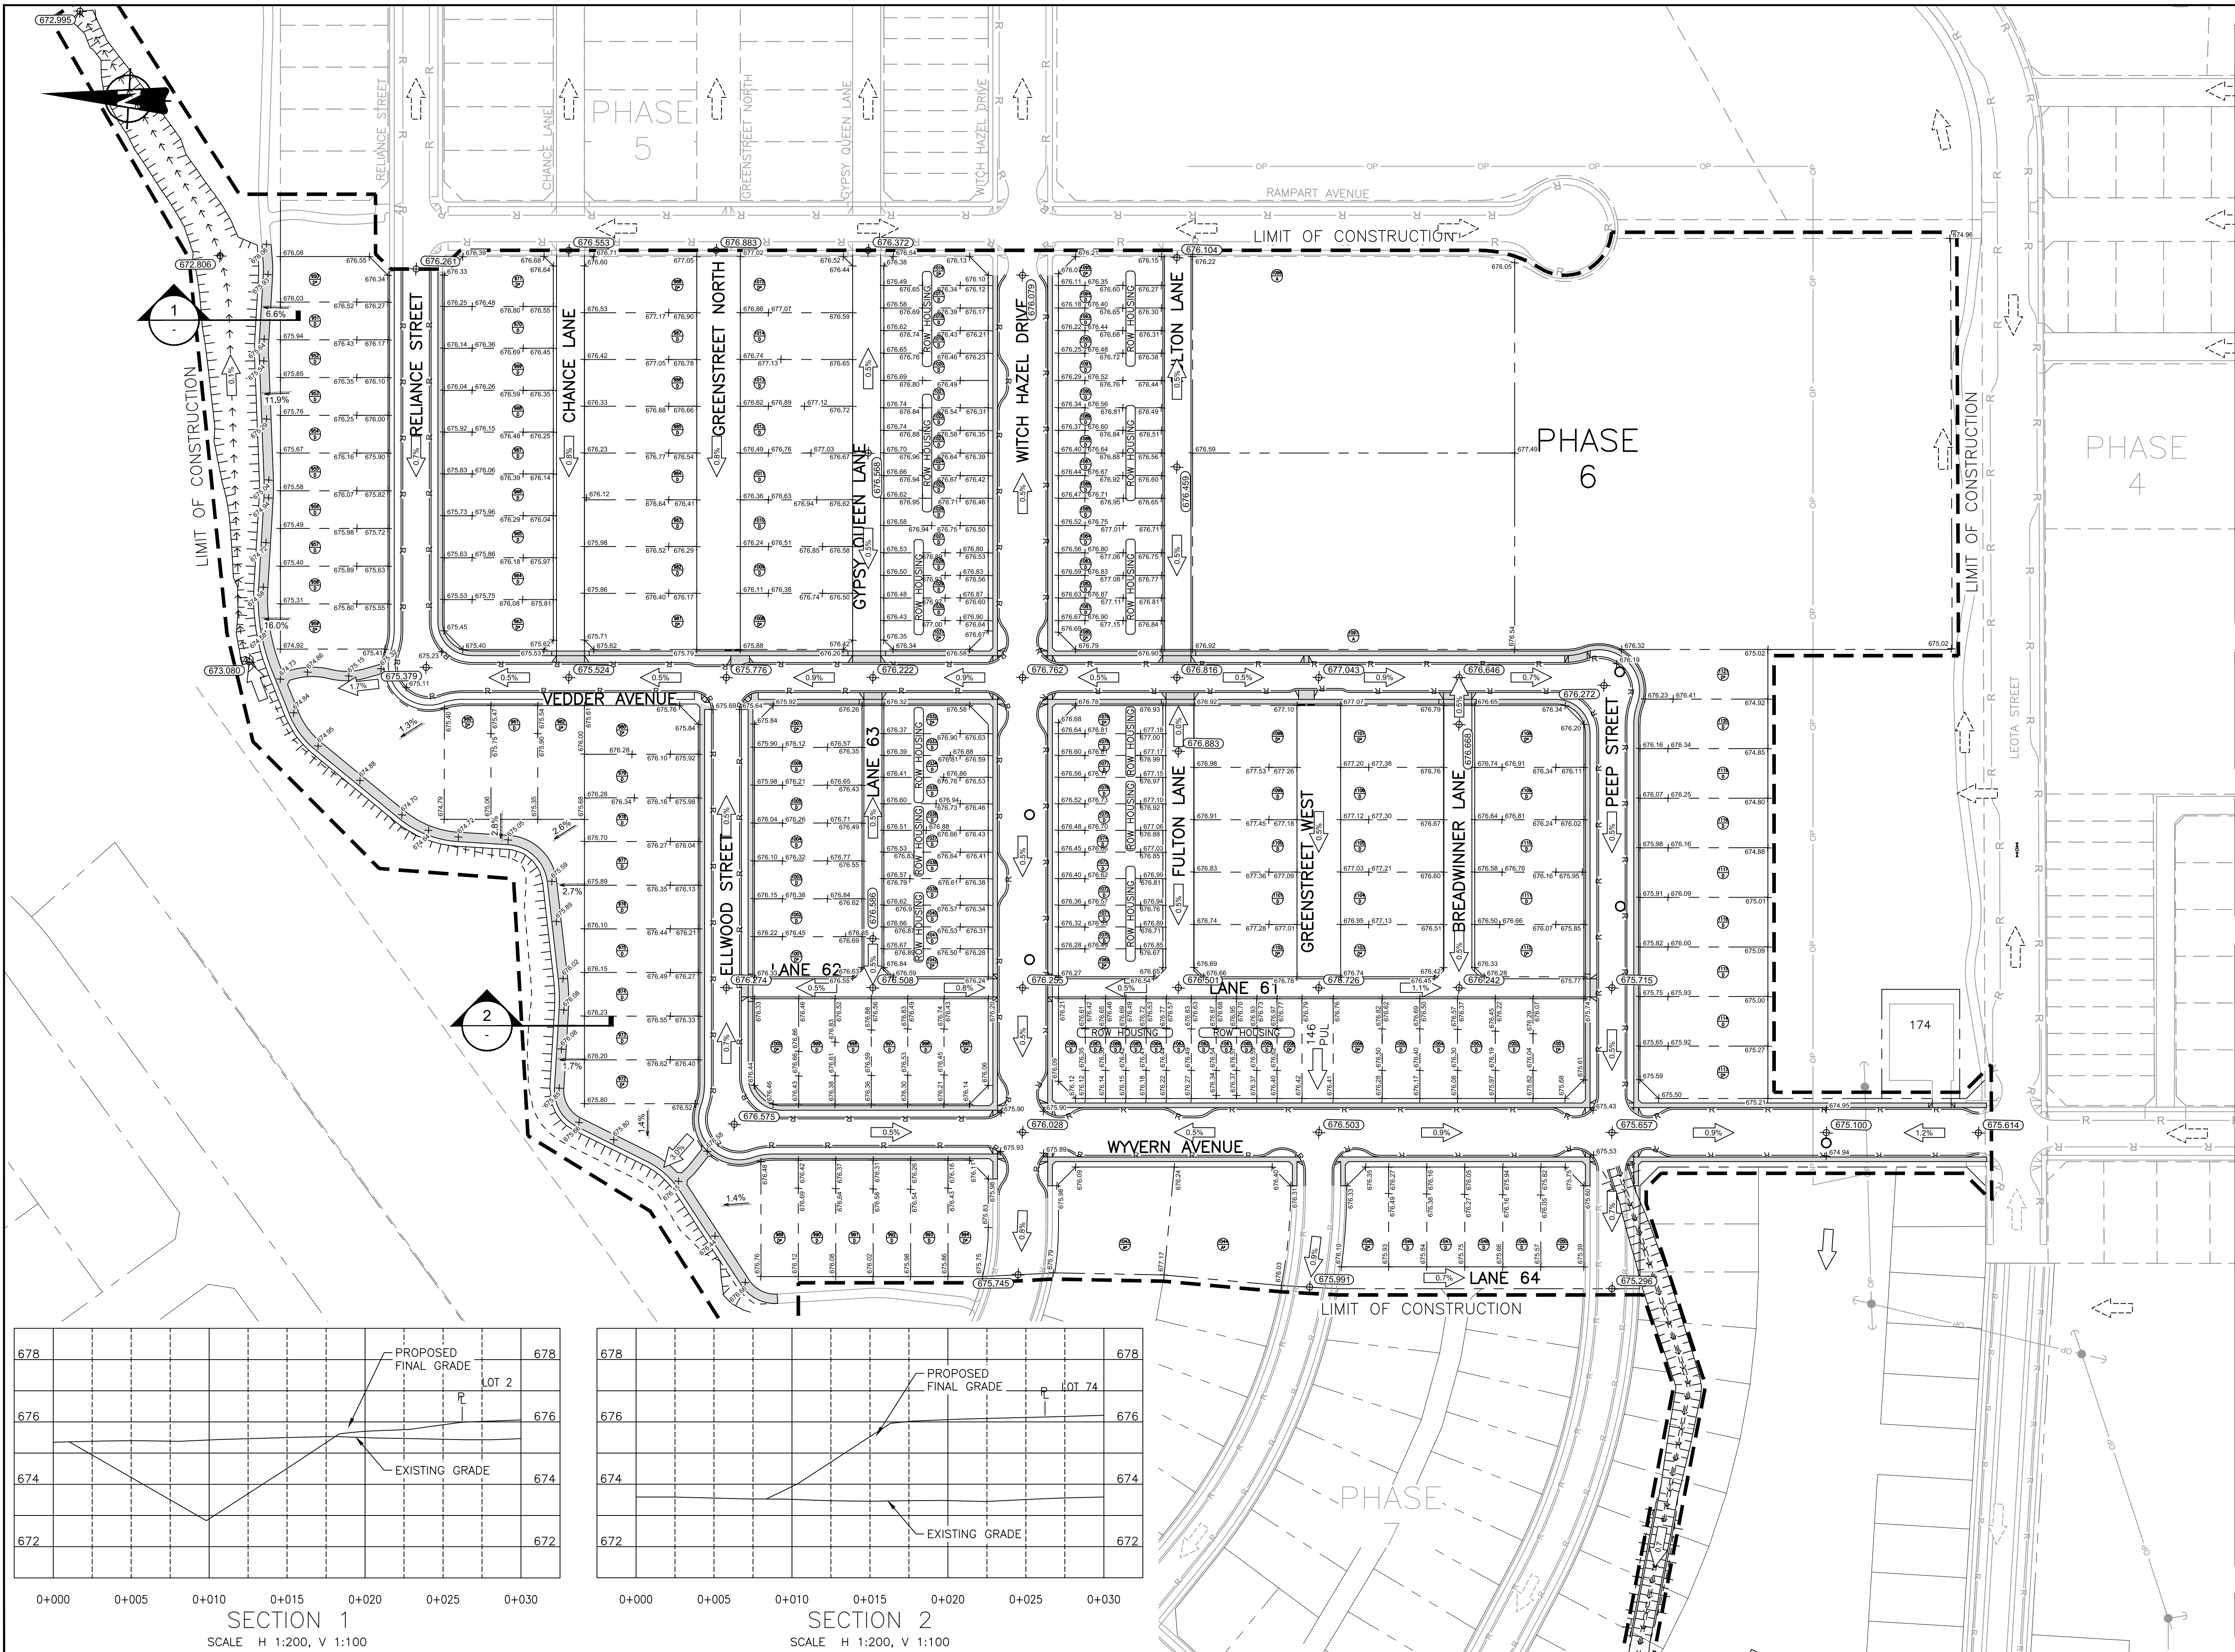

Associated Engineering

Suite 301-4109 4th Ave.
Whitehorse, Yukon
Canada Y1A 1H6
Phone: 867-456-2711
Fax: 604-291-6163

REVISIONS :			
NO.	DATE	ENG.	SUBJECT
0	JAN.06.2020	S.B.	ISSUED FOR TENDER
1	JAN.15.2020	S.B.	RE-ISSUED FOR TENDER
2	FEB.24.2020	S.B.	ISSUED FOR CONSTRUCTION
3	JUL.21.2023	S.B.	RECORD DRAWINGS
4	JUL.28.2023	S.B.	RECORD DRAWINGS - REVISED LOT NUMBERS

PROJECT :
WHISTLE BEND SUBDIVISION
PHASE 6

DRAWING TITLE :
SURFACE WORKS
FUTURE LOT GRADES

SCALE : 1:1000
DATE : 2019/12/23
DESIGN : J.S.
DRAWN : J.S.
CHECKED : M.A.
APPROVED : S.B.

DRAWING NUMBER : 2183-06-C-4105	SHEET : 1
------------------------------------	--------------