



CITY OF WHITEHORSE SERVICE CONNECTION RECORD

FIELD BOOK


No.

ADDRESS 98 Vedder Avenue BLOCK LOT 960

DATES		WATER		SEWER	
On at Main 2020-SEPT-17		Depth at P/L: 2.23 m		2.27 m	
On at Building		Depth at Main: 2.61 m		2.71 m	
Frost Plug:		Pipe Size: 25 mm / 20 mm		100 mm	
Memo:		Pipe Material: HDPE Insul. <u>(Yes)</u> /No		PVC Insul. <u>(Yes)</u> /No	
		Length from Main to P/L: 6.04 m		8.93 m	
		Squirt Test: <u>(Pass)</u> /Fail		N/A	
Booster Pump Required:	Yes/No	Frost Protection: Aquaflow/ <u>(Recirc)</u> /Heat Trace/Bleeder		N/A	
PRV Required:	Yes/No	Greased @ CC: <u>(Yes)</u> /No		N/A	
Water Meter Installed:	Yes/No	Continuity Test: <u>(N/A)</u> Pass/Fail		N/A	

CLEARLY INDICATE LOCATION OF CC AND ROUTE OF PIPES ON DRAWING BELOW

1. Show main valves required to isolate this service. 2. All dimensions to be tied to property line 3. All dimensions to be metric 4. Depth @ property line is based on elevation after construction and changes may have occurred.

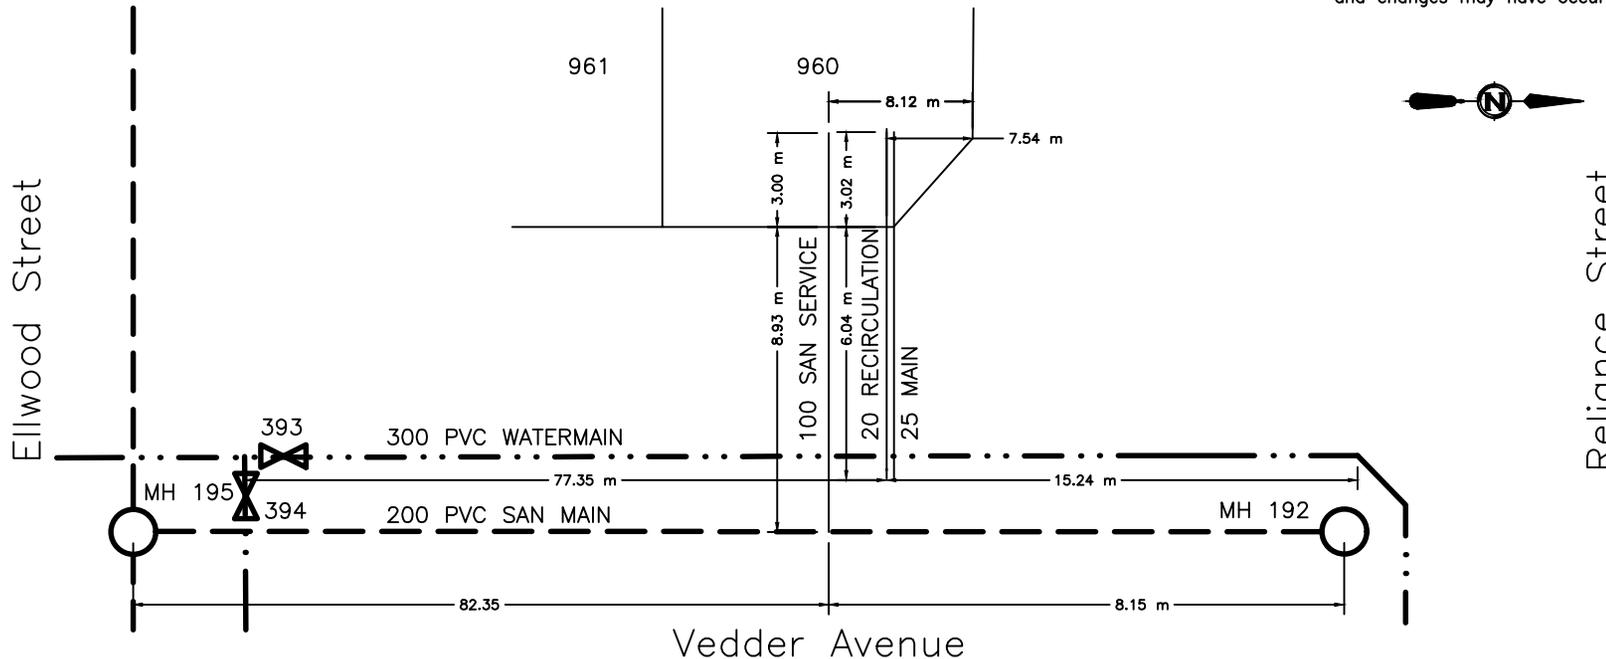



CITY OF WHITEHORSE SERVICE CONNECTION RECORD

FIELD BOOK


No.

ADDRESS 96 Vedder Avenue BLOCK LOT 961

DATES		WATER		SEWER		
On at Main 2020-SEPT-17		Depth at P/L: 2.33 m		2.28 m		
On at Building		Depth at Main: 2.60 m		2.86 m		
Frost Plug:		Pipe Size: 25 mm / 20 mm		100 mm		
Memo:	Pipe Material: HDPE		Insul. <u>(Yes)</u> /No		PVC	
	Length from Main to P/L: 6.03 m				8.96 m	
	Squirt Test:		<u>(Pass)</u> /Fail		N/A	
Booster Pump Required:	Yes/No	Frost Protection: Aquaflo/ <u>(Recirc)</u> /Heat Trace/Bleeder		N/A		
PRV Required:	Yes/No	Greased @ CC:		<u>(Yes)</u> /No		
Water Meter Installed:	Yes/No	Continuity Test: <u>(N/A)</u>		Pass/Fail		
				N/A		

CLEARLY INDICATE LOCATION OF CC AND ROUTE OF PIPES ON DRAWING BELOW

1. Show main valves required to isolate this service. 2. All dimensions to be tied to property line 3. All dimensions to be metric 4. Depth @ property line is based on elevation after construction and changes may have occurred.

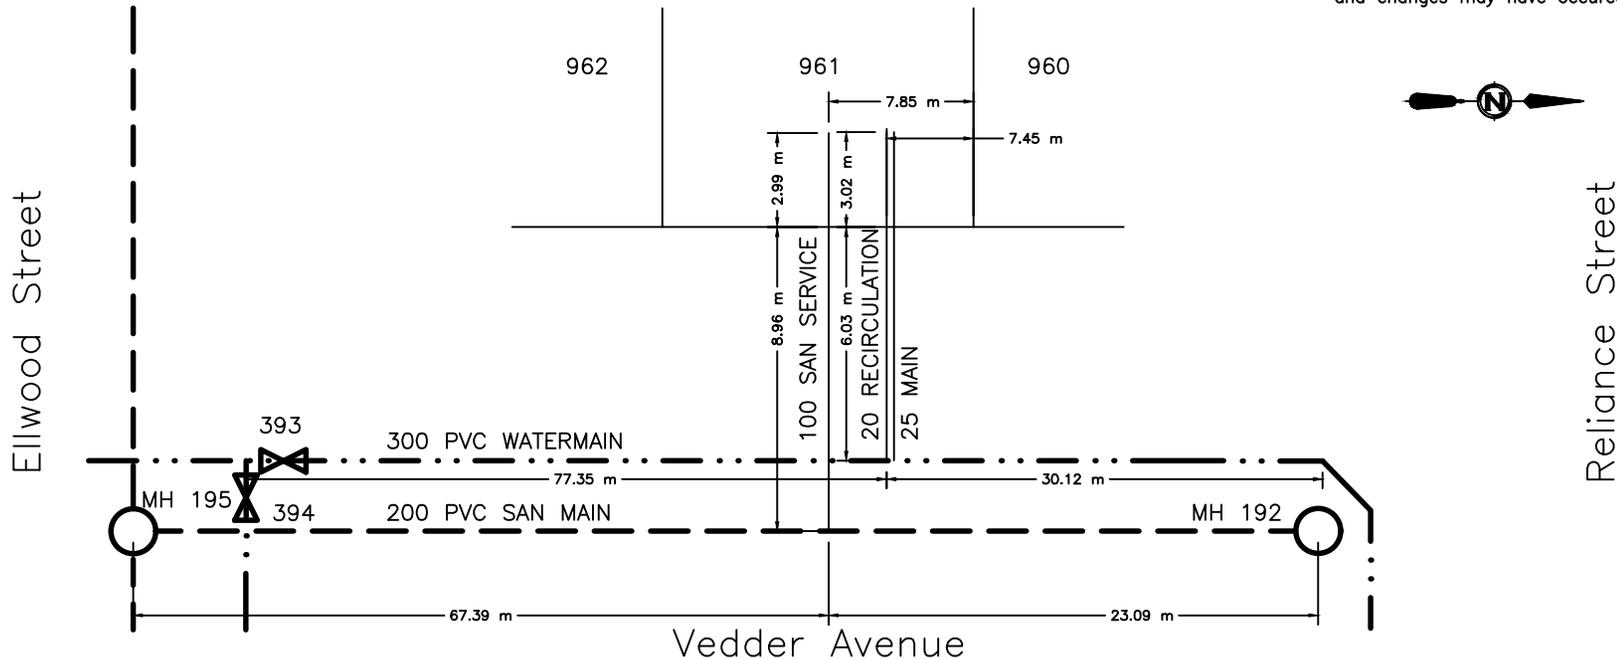



CITY OF WHITEHORSE SERVICE CONNECTION RECORD

FIELD BOOK


No.

ADDRESS 94 Vedder Avenue BLOCK LOT 962

DATES		WATER		SEWER	
On at Main 2020-SEPT-17		Depth at P/L: 2.34 m		2.09 m	
On at Building		Depth at Main: 2.56 m		3.04 m	
Frost Plug:		Pipe Size: 20 mm / 25 mm		100 mm	
Memo:		Pipe Material: HDPE Insul. <u>(Yes)</u> /No		PVC Insul. <u>(Yes)</u> /No	
		Length from Main to P/L: 6.03 m		8.94 m	
		Squirt Test: <u>(Pass)</u> /Fail		N/A	
Booster Pump Required:	Yes/No	Frost Protection: Aquaflow/ <u>(Recirc)</u> /Heat Trace/Bleeder		N/A	
PRV Required:	Yes/No	Greased @ CC: <u>(Yes)</u> /No		N/A	
Water Meter Installed:	Yes/No	Continuity Test: <u>(N/A)</u> Pass/Fail		N/A	

CLEARLY INDICATE LOCATION OF CC AND ROUTE OF PIPES ON DRAWING BELOW

1. Show main valves required to isolate this service. 2. All dimensions to be tied to property line 3. All dimensions to be metric 4. Depth @ property line is based on elevation after construction and changes may have occurred.

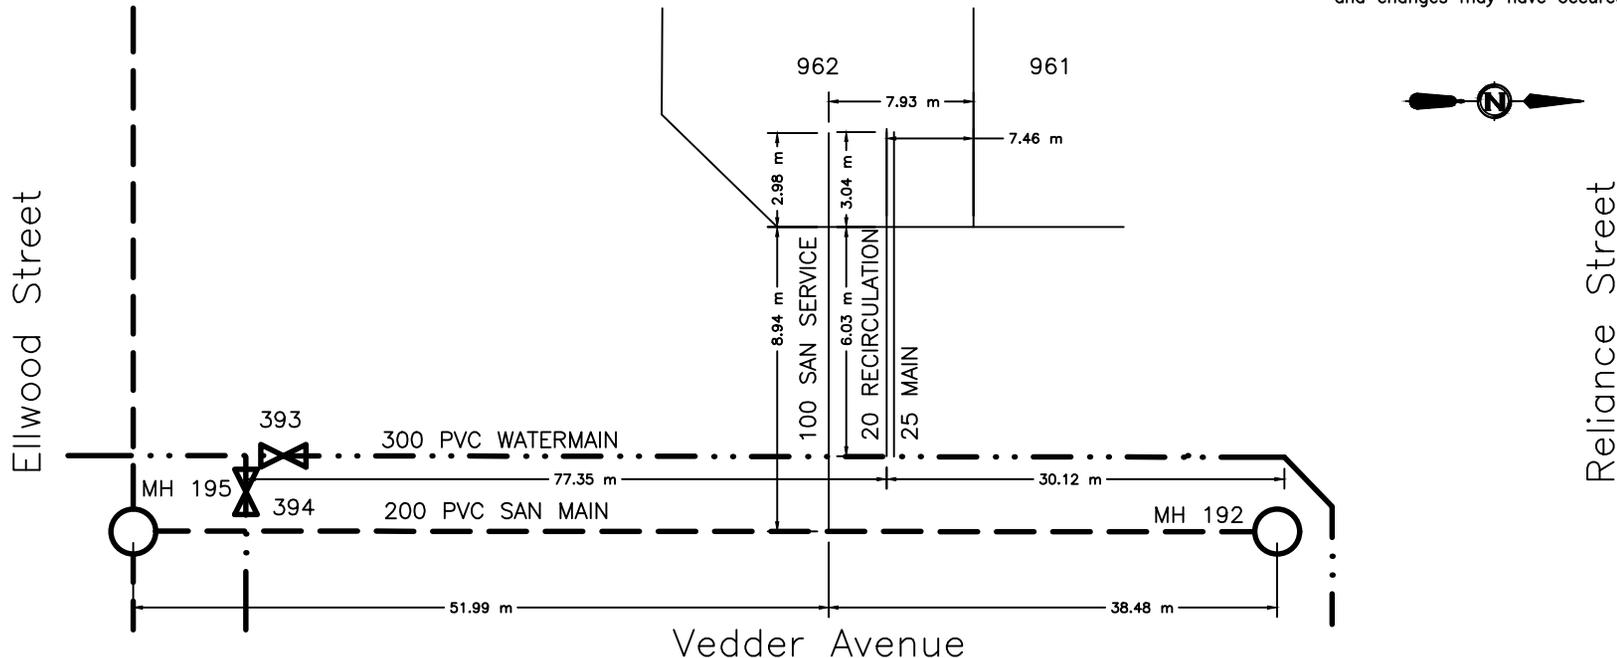



CITY OF WHITEHORSE SERVICE CONNECTION RECORD

FIELD BOOK


No.

ADDRESS 57 Ellwood Street BLOCK LOT 972

DATES	WATER	SEWER
On at Main 2020-AUG-28	Depth at P/L: 2.89 m	2.93 m
On at Building	Depth at Main: 3.34 m	4.90 m
Frost Plug:	Pipe Size: 20 mm / 25 mm	100 mm
Memo:	Pipe Material: HDPE Insul. <input checked="" type="checkbox"/> Yes / <input type="checkbox"/> No	PVC Insul. <input checked="" type="checkbox"/> Yes / <input type="checkbox"/> No
	Length from Main to P/L: 12.28 m	9.04 m
	Squirt Test: <input checked="" type="checkbox"/> Pass / <input type="checkbox"/> Fail	N/A
Booster Pump Required: <input type="checkbox"/> Yes / <input checked="" type="checkbox"/> No	Frost Protection: Aquaflo / <input checked="" type="checkbox"/> Recirc / Heat Trace / Bleeder	N/A
PRV Required: <input type="checkbox"/> Yes / <input checked="" type="checkbox"/> No	Greased @ CC: <input checked="" type="checkbox"/> Yes / <input type="checkbox"/> No	N/A
Water Meter Installed: <input type="checkbox"/> Yes / <input checked="" type="checkbox"/> No	Continuity Test: <input checked="" type="checkbox"/> N/A / <input type="checkbox"/> Pass / <input type="checkbox"/> Fail	N/A

CLEARLY INDICATE LOCATION OF CC AND ROUTE OF PIPES ON DRAWING BELOW

1. Show main valves required to isolate this service. 2. All dimensions to be tied to property line 3. All dimensions to be metric 4. Depth @ property line is based on elevation after construction and changes may have occurred.

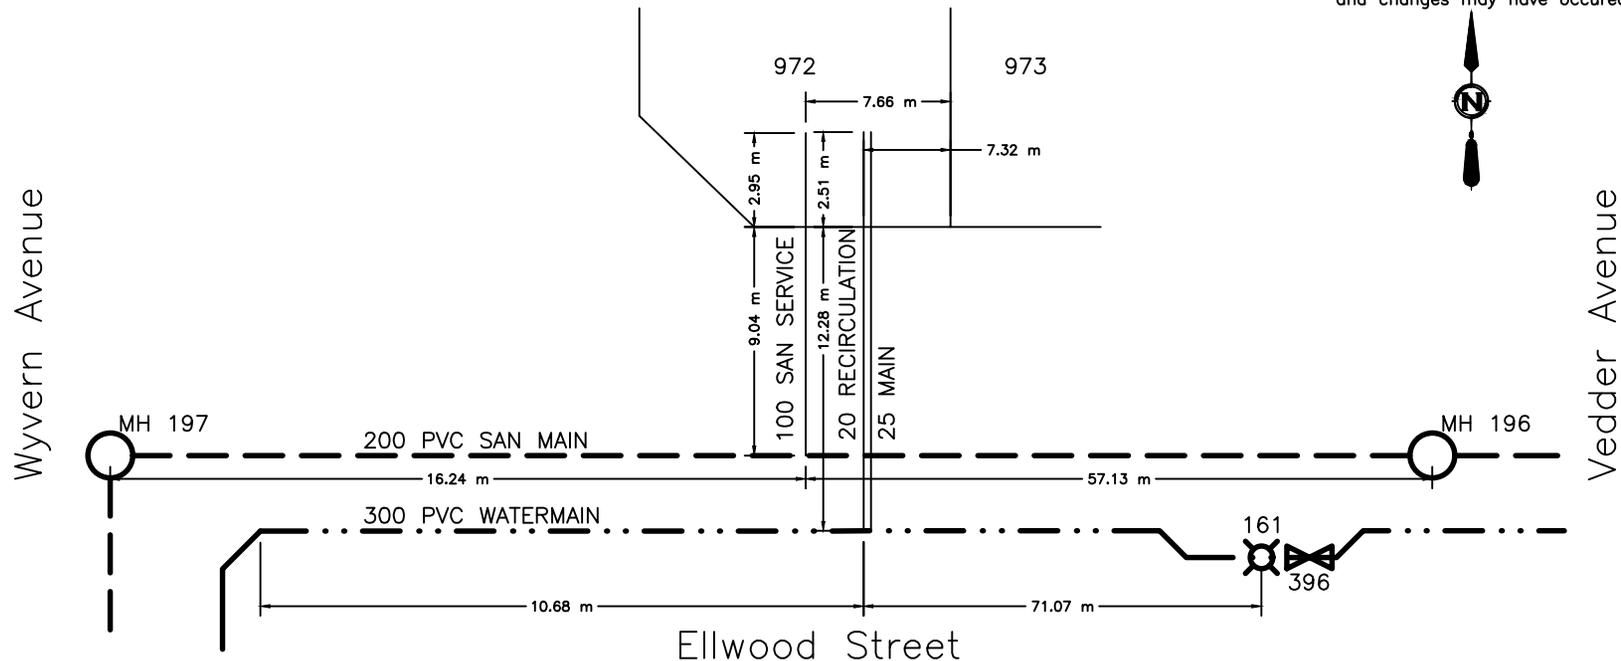



CITY OF WHITEHORSE SERVICE CONNECTION RECORD

FIELD BOOK


No.

ADDRESS 55 Ellwood Street BLOCK LOT 973

DATES		WATER		SEWER	
On at Main 2020-AUG-28		Depth at P/L: 3.00 m		3.08 m	
On at Building		Depth at Main: 3.25 m		4.71 m	
Frost Plug:		Pipe Size: 25 mm / 20 mm		100 mm	
Memo:		Pipe Material: HDPE		Insul. <input checked="" type="checkbox"/> Yes / <input type="checkbox"/> No	
		Length from Main to P/L: 12.20 m		PVC	
		Squirt Test: <input checked="" type="checkbox"/> Pass / <input type="checkbox"/> Fail		Insul. <input checked="" type="checkbox"/> Yes / <input type="checkbox"/> No	
Booster Pump Required: Yes/No		Frost Protection: Aquaflo / <input checked="" type="checkbox"/> Recirc / Heat Trace / Bleeder		N/A	
PRV Required: Yes/No		Greased @ CC: <input checked="" type="checkbox"/> Yes / <input type="checkbox"/> No		N/A	
Water Meter Installed: Yes/No		Continuity Test: <input checked="" type="checkbox"/> N/A		Pass/Fail	

CLEARLY INDICATE LOCATION OF CC AND ROUTE OF PIPES ON DRAWING BELOW

1. Show main valves required to isolate this service. 2. All dimensions to be tied to property line 3. All dimensions to be metric 4. Depth @ property line is based on elevation after construction and changes may have occurred.

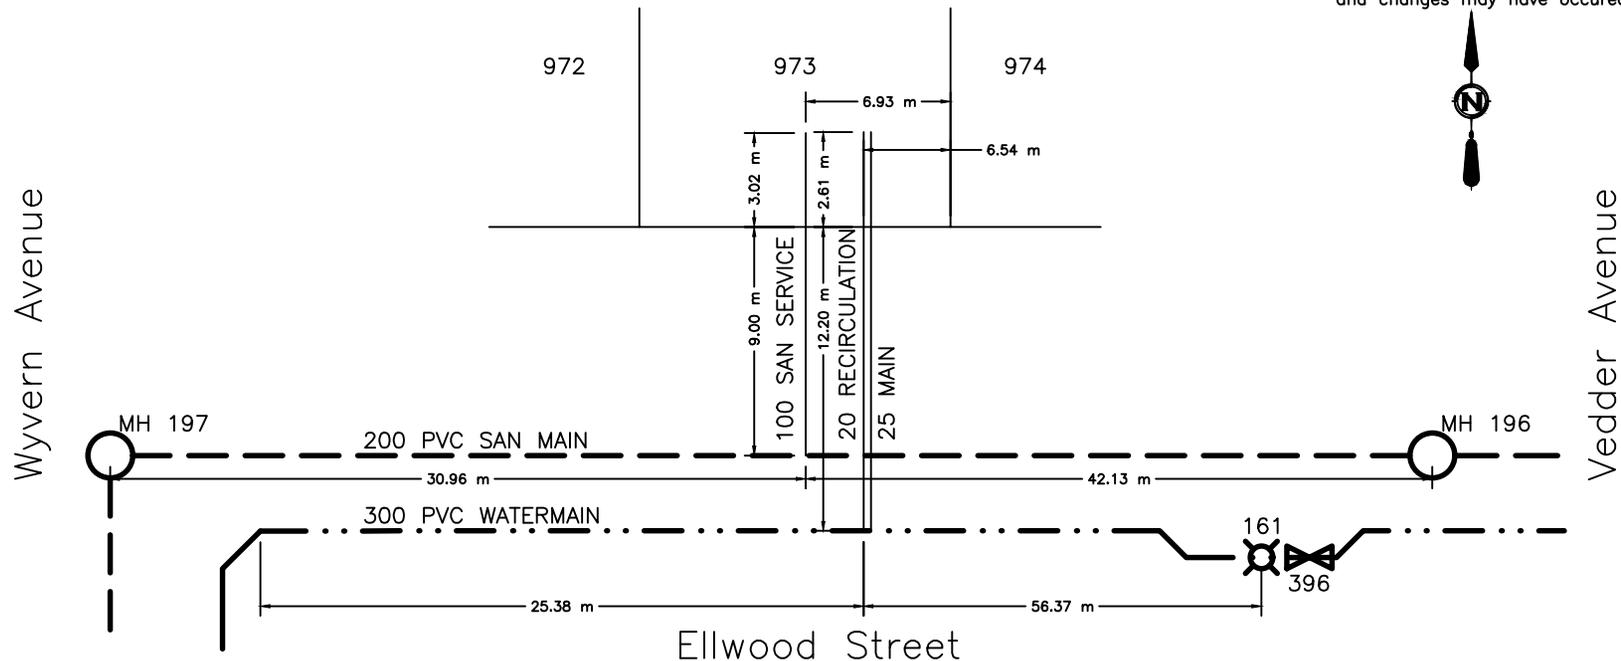



CITY OF WHITEHORSE SERVICE CONNECTION RECORD

FIELD BOOK


No.

ADDRESS 53 Ellwood Street BLOCK LOT 974

DATES		WATER		SEWER	
On at Main	2020-AUG-28	Depth at P/L:	3.00 m	3.06	m
On at Building		Depth at Main:	3.23 m	4.62	m
Frost Plug:		Pipe Size:	25 mm / 20 mm	100	mm
Memo:		Pipe Material:	HDPE	Insul.	(Yes/No)
		Length from Main to P/L:	12.29 m	8.09	m
		Squirt Test:	(Pass/Fail)		N/A
Booster Pump Required:	Yes/No	Frost Protection:	Aquaflow/(Recirc)/Heat Trace/Bleeder		N/A
PRV Required:	Yes/No	Greased @ CC:	(Yes/No)		N/A
Water Meter Installed:	Yes/No	Continuity Test:	(N/A) Pass/Fail		N/A

CLEARLY INDICATE LOCATION OF CC AND ROUTE OF PIPES ON DRAWING BELOW

1. Show main valves required to isolate this service. 2. All dimensions to be tied to property line 3. All dimensions to be metric 4. Depth @ property line is based on elevation after construction and changes may have occurred.

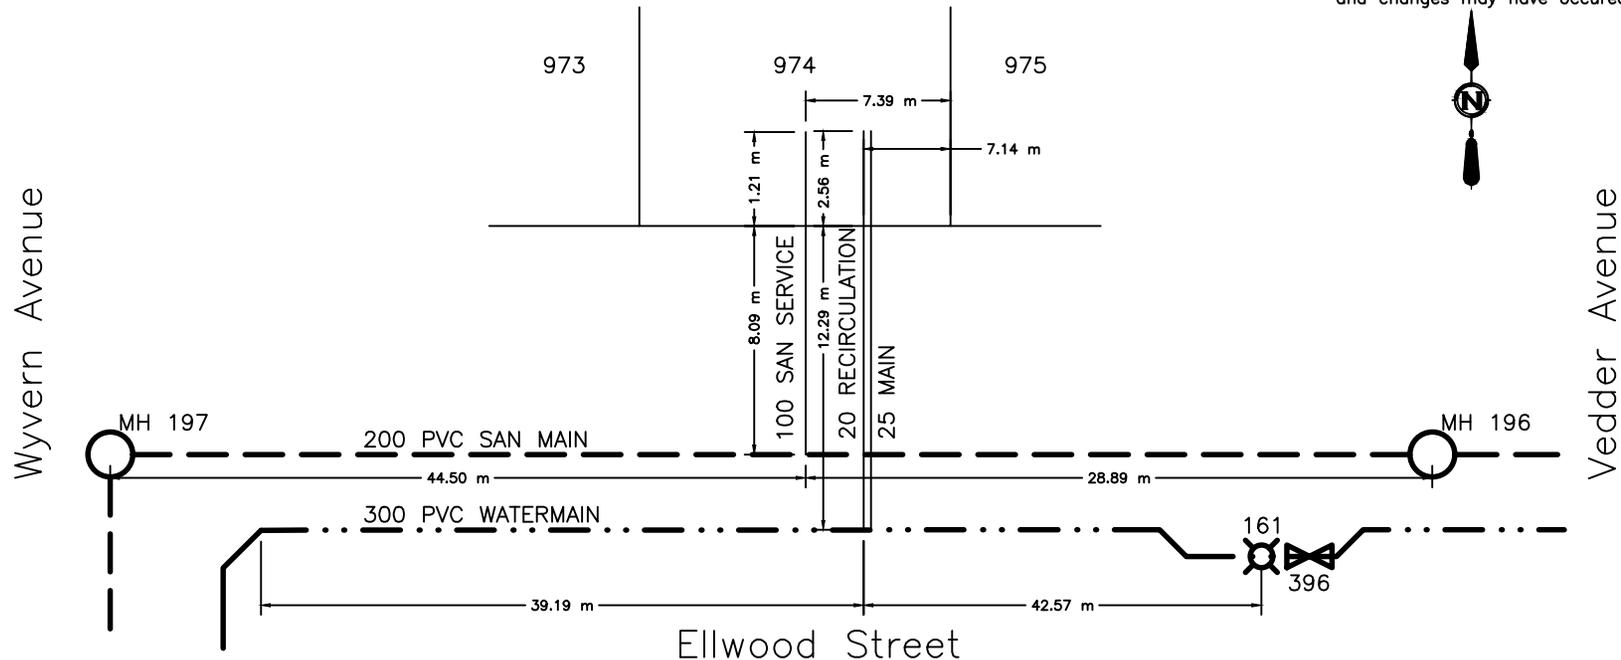



CITY OF WHITEHORSE SERVICE CONNECTION RECORD

FIELD BOOK


No.

ADDRESS 51 Ellwood Street BLOCK LOT 975

DATES		WATER		SEWER		
On at Main	2020-AUG-27	Depth at P/L:	3.01 m		2.97 m	
On at Building		Depth at Main:	3.24 m		4.49 m	
Frost Plug:		Pipe Size:	25 mm / 20 mm		100 mm	
Memo:		Pipe Material:	HDPE	Insul. <input checked="" type="checkbox"/> Yes / <input type="checkbox"/> No	PVC	Insul. <input type="checkbox"/> Yes / <input checked="" type="checkbox"/> No
		Length from Main to P/L:	11.96 m		9.34 m	
		Squirt Test:		<input checked="" type="checkbox"/> Pass / <input type="checkbox"/> Fail		N/A
Booster Pump Required:	<input type="checkbox"/> Yes / <input type="checkbox"/> No	Frost Protection:	Aquaflow / <input checked="" type="checkbox"/> Recirc / Heat Trace / Bleeder		N/A	
PRV Required:	<input type="checkbox"/> Yes / <input type="checkbox"/> No	Greased @ CC:	<input checked="" type="checkbox"/> Yes / <input type="checkbox"/> No		N/A	
Water Meter Installed:	<input type="checkbox"/> Yes / <input type="checkbox"/> No	Continuity Test:	<input checked="" type="checkbox"/> N/A	<input type="checkbox"/> Pass / <input type="checkbox"/> Fail		N/A

CLEARLY INDICATE LOCATION OF CC AND ROUTE OF PIPES ON DRAWING BELOW

1. Show main valves required to isolate this service. 2. All dimensions to be tied to property line 3. All dimensions to be metric 4. Depth @ property line is based on elevation after construction and changes may have occurred.

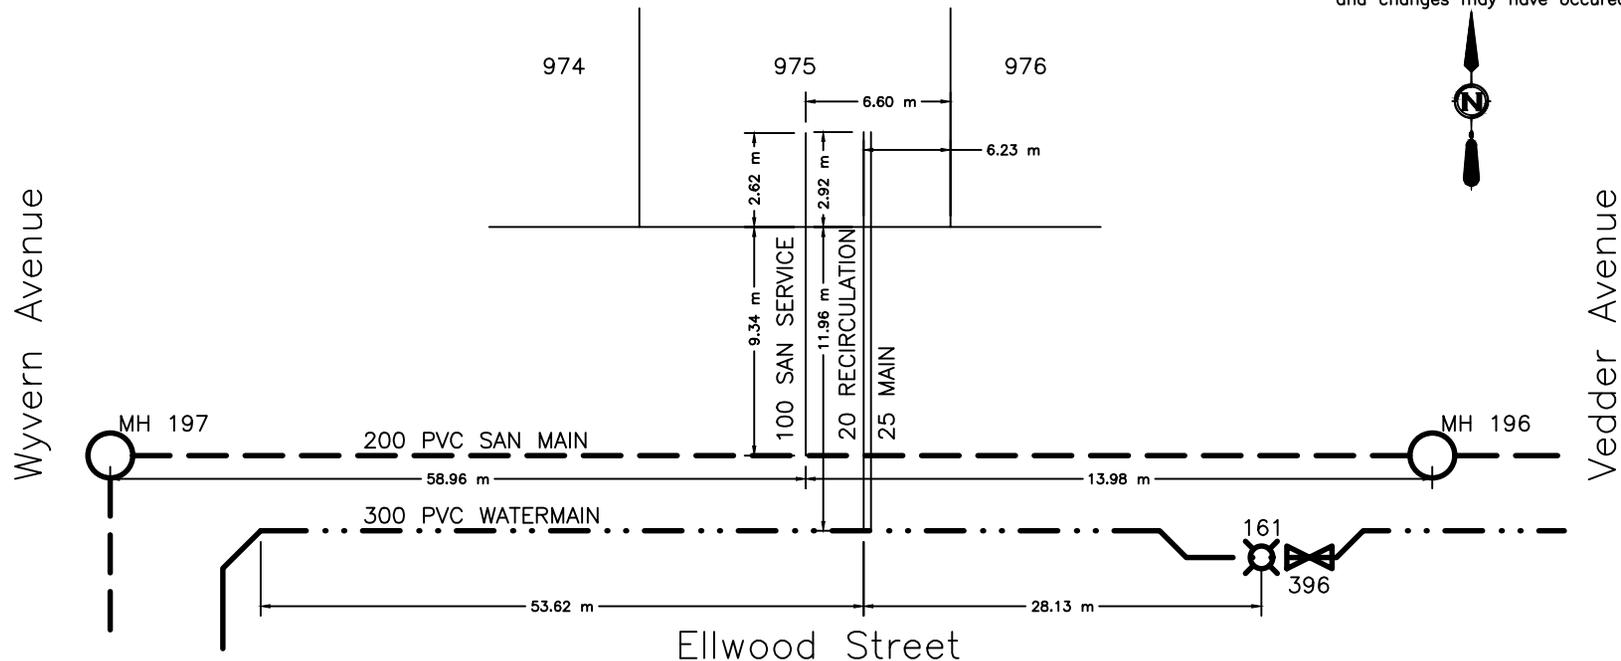



CITY OF WHITEHORSE SERVICE CONNECTION RECORD

FIELD BOOK


No.

ADDRESS 49 Ellwood Street BLOCK LOT 976

DATES		WATER		SEWER	
On at Main	2020-AUG-27	Depth at P/L:	2.92 m		2.91 m
On at Building		Depth at Main:	3.24 m		4.32 m
Frost Plug:		Pipe Size:	25 mm / 20 mm		100 mm
Memo:		Pipe Material:	HDPE	Insul. <input checked="" type="checkbox"/> Yes/No	PVC
		Length from Main to P/L:	11.92 m		9.28 m
		Squirt Test:	<input checked="" type="checkbox"/> Pass/Fail		N/A
Booster Pump Required:	Yes/No	Frost Protection:	Aquaflow/ <input checked="" type="checkbox"/> Recirc/Heat Trace/Bleeder		N/A
PRV Required:	Yes/No	Greased @ CC:	<input checked="" type="checkbox"/> Yes/No		N/A
Water Meter Installed:	Yes/No	Continuity Test:	<input checked="" type="checkbox"/> N/A	Pass/Fail	N/A

CLEARLY INDICATE LOCATION OF CC AND ROUTE OF PIPES ON DRAWING BELOW

1. Show main valves required to isolate this service. 2. All dimensions to be tied to property line 3. All dimensions to be metric 4. Depth @ property line is based on elevation after construction and changes may have occurred.

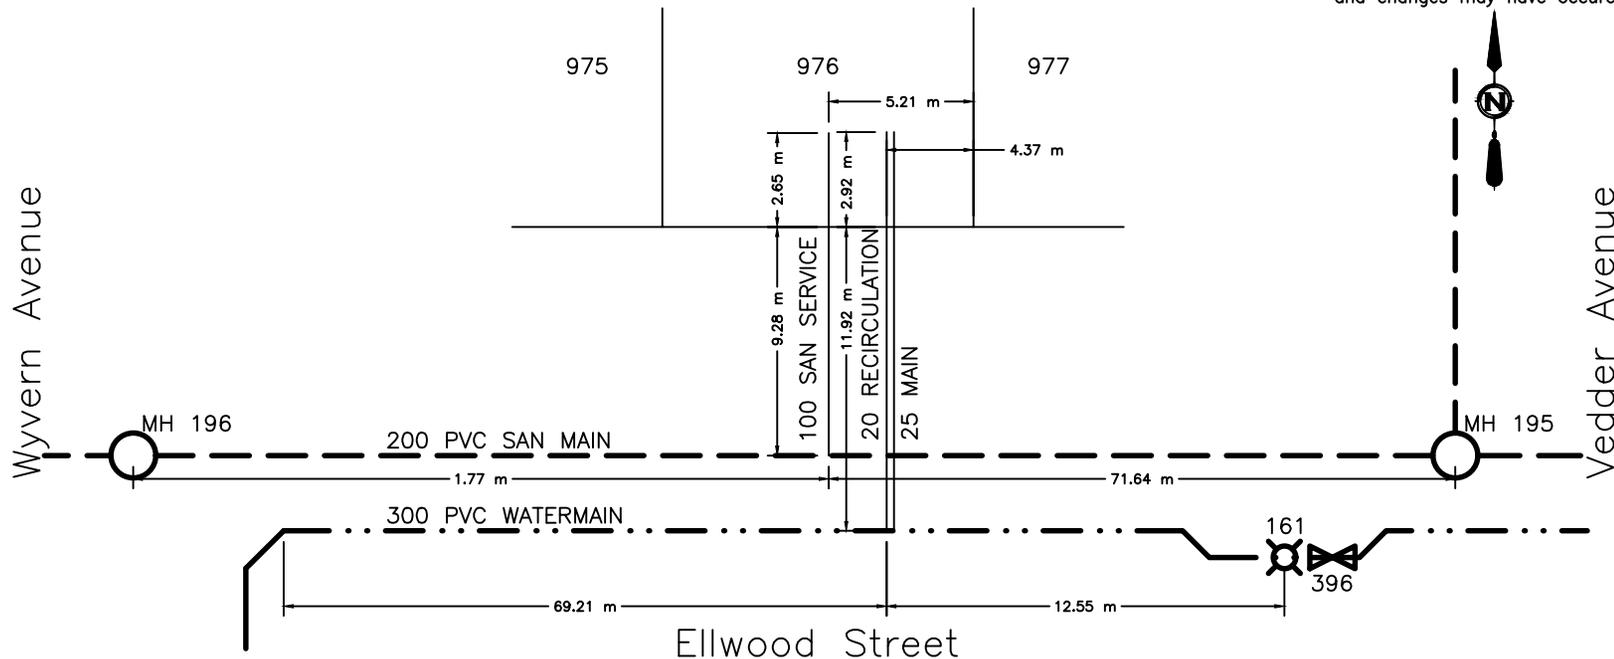



CITY OF WHITEHORSE SERVICE CONNECTION RECORD

FIELD BOOK


No.

ADDRESS 47 Ellwood Street BLOCK LOT 977

DATES		WATER		SEWER		
On at Main	2020-AUG-29	Depth at P/L:	2.91 m		2.95 m	
On at Building		Depth at Main:	3.23 m		4.23 m	
Frost Plug:		Pipe Size:	25 mm / 20 mm		100 mm	
Memo:		Pipe Material:	HDPE	Insul. <input checked="" type="checkbox"/> Yes/ <input type="checkbox"/> No	PVC	Insul. <input type="checkbox"/> Yes/ <input checked="" type="checkbox"/> No
		Length from Main to P/L:	13.40 m		9.03 m	
		Squirt Test:	<input checked="" type="checkbox"/> Pass/ <input type="checkbox"/> Fail			N/A
Booster Pump Required:	Yes/No	Frost Protection:	Aquaflow/ <input checked="" type="checkbox"/> Recirc/ <input type="checkbox"/> Heat Trace/Bleeder		N/A	
PRV Required:	Yes/No	Greased @ CC:	<input checked="" type="checkbox"/> Yes/ <input type="checkbox"/> No		N/A	
Water Meter Installed:	Yes/No	Continuity Test:	<input type="checkbox"/> N/A <input checked="" type="checkbox"/> Pass/ <input type="checkbox"/> Fail		N/A	

CLEARLY INDICATE LOCATION OF CC AND ROUTE OF PIPES ON DRAWING BELOW

1. Show main valves required to isolate this service. 2. All dimensions to be tied to property line 3. All dimensions to be metric 4. Depth @ property line is based on elevation after construction and changes may have occurred.

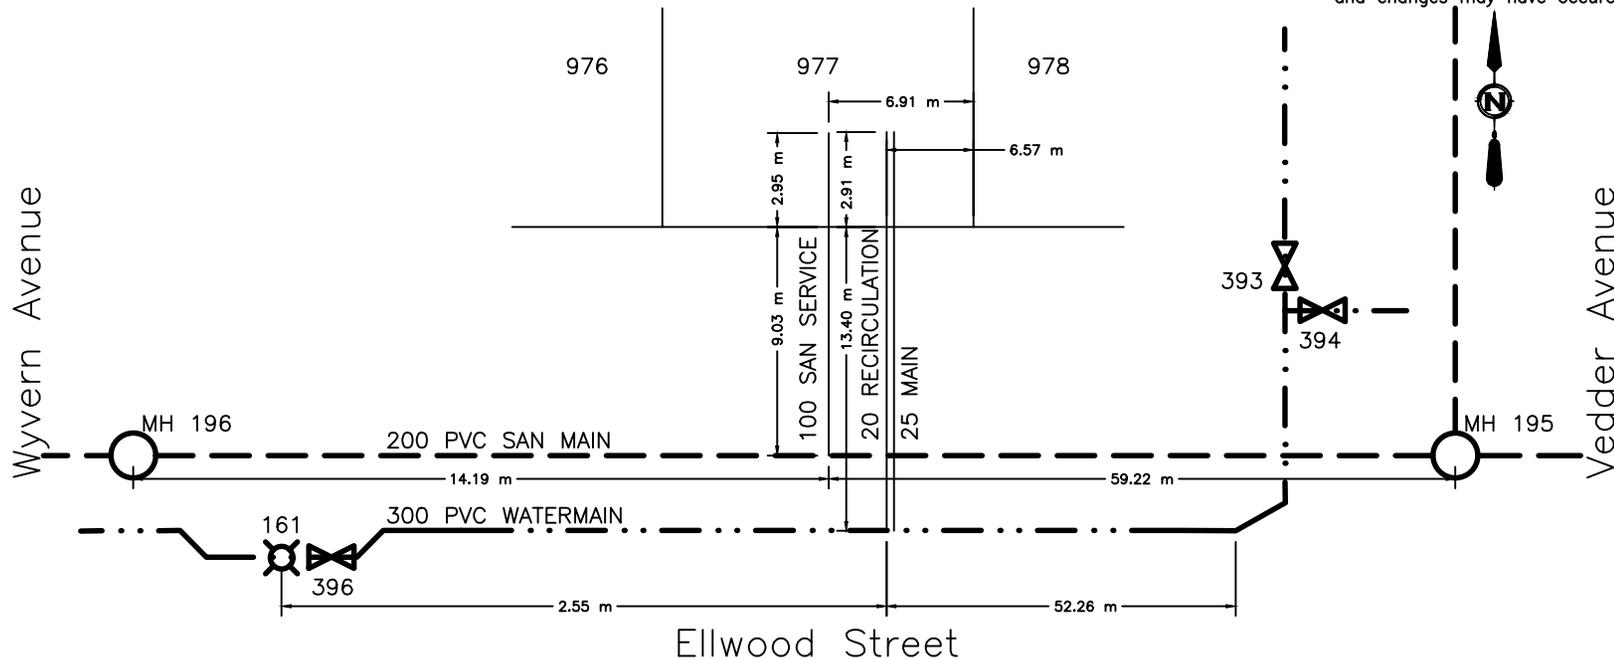



CITY OF WHITEHORSE SERVICE CONNECTION RECORD

FIELD BOOK


No.

ADDRESS 45 Ellwood Street BLOCK LOT 978

DATES		WATER		SEWER		
On at Main	2020-AUG-28	Depth at P/L:	2.64 m		2.68 m	
On at Building		Depth at Main:	3.05 m		4.09 m	
Frost Plug:		Pipe Size:	25 mm / 20 mm		100 mm	
Memo:		Pipe Material:	HDPE	Insul. <input checked="" type="checkbox"/> Yes/ <input type="checkbox"/> No	PVC	Insul. <input type="checkbox"/> Yes/ <input checked="" type="checkbox"/> No
		Length from Main to P/L:	11.99 m		9.00 m	
		Squirt Test:	<input checked="" type="checkbox"/> Pass/ <input type="checkbox"/> Fail			N/A
Booster Pump Required:	<input type="checkbox"/> Yes/ <input type="checkbox"/> No	Frost Protection:	Aquaflow/ <input checked="" type="checkbox"/> Recirc/ <input type="checkbox"/> Heat Trace/ <input type="checkbox"/> Bleeder			N/A
PRV Required:	<input type="checkbox"/> Yes/ <input type="checkbox"/> No	Greased @ CC:	<input checked="" type="checkbox"/> Yes/ <input type="checkbox"/> No			N/A
Water Meter Installed:	<input type="checkbox"/> Yes/ <input type="checkbox"/> No	Continuity Test:	<input checked="" type="checkbox"/> N/A	<input type="checkbox"/> Pass/ <input type="checkbox"/> Fail		N/A

CLEARLY INDICATE LOCATION OF CC AND ROUTE OF PIPES ON DRAWING BELOW

1. Show main valves required to isolate this service. 2. All dimensions to be tied to property line 3. All dimensions to be metric 4. Depth @ property line is based on elevation after construction and changes may have occurred.

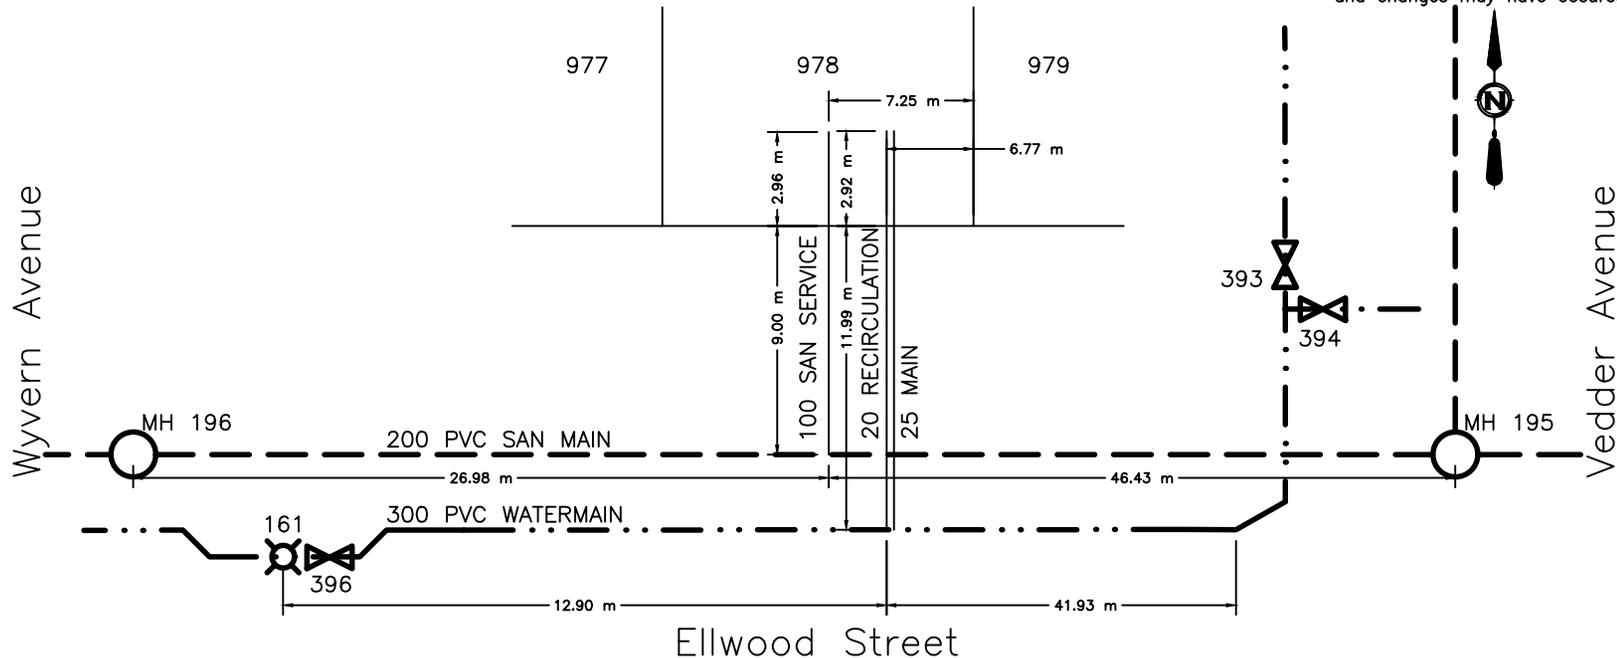



CITY OF WHITEHORSE SERVICE CONNECTION RECORD

FIELD BOOK


No.

ADDRESS 43 Ellwood Street BLOCK LOT 979

DATES		WATER		SEWER	
On at Main	2020-AUG-28	Depth at P/L:	2.60 m		2.64 m
On at Building		Depth at Main:	2.89 m		3.98 m
Frost Plug:		Pipe Size:	25 mm / 20 mm		100 mm
Memo:		Pipe Material:	HDPE	Insul. <input checked="" type="checkbox"/> Yes/ <input type="checkbox"/> No	PVC
		Length from Main to P/L:	11.95 m		8.96 m
		Squirt Test:	<input checked="" type="checkbox"/> Pass/ <input type="checkbox"/> Fail		N/A
Booster Pump Required:	Yes/No	Frost Protection:	Aquaflow/ <input checked="" type="checkbox"/> Recirc/ <input type="checkbox"/> Heat Trace/Bleeder		N/A
PRV Required:	Yes/No	Greased @ CC:	<input checked="" type="checkbox"/> Yes/ <input type="checkbox"/> No		N/A
Water Meter Installed:	Yes/No	Continuity Test:	<input type="checkbox"/> N/A <input checked="" type="checkbox"/> Pass/ <input type="checkbox"/> Fail		N/A

CLEARLY INDICATE LOCATION OF CC AND ROUTE OF PIPES ON DRAWING BELOW

1. Show main valves required to isolate this service. 2. All dimensions to be tied to property line 3. All dimensions to be metric 4. Depth @ property line is based on elevation after construction and changes may have occurred.

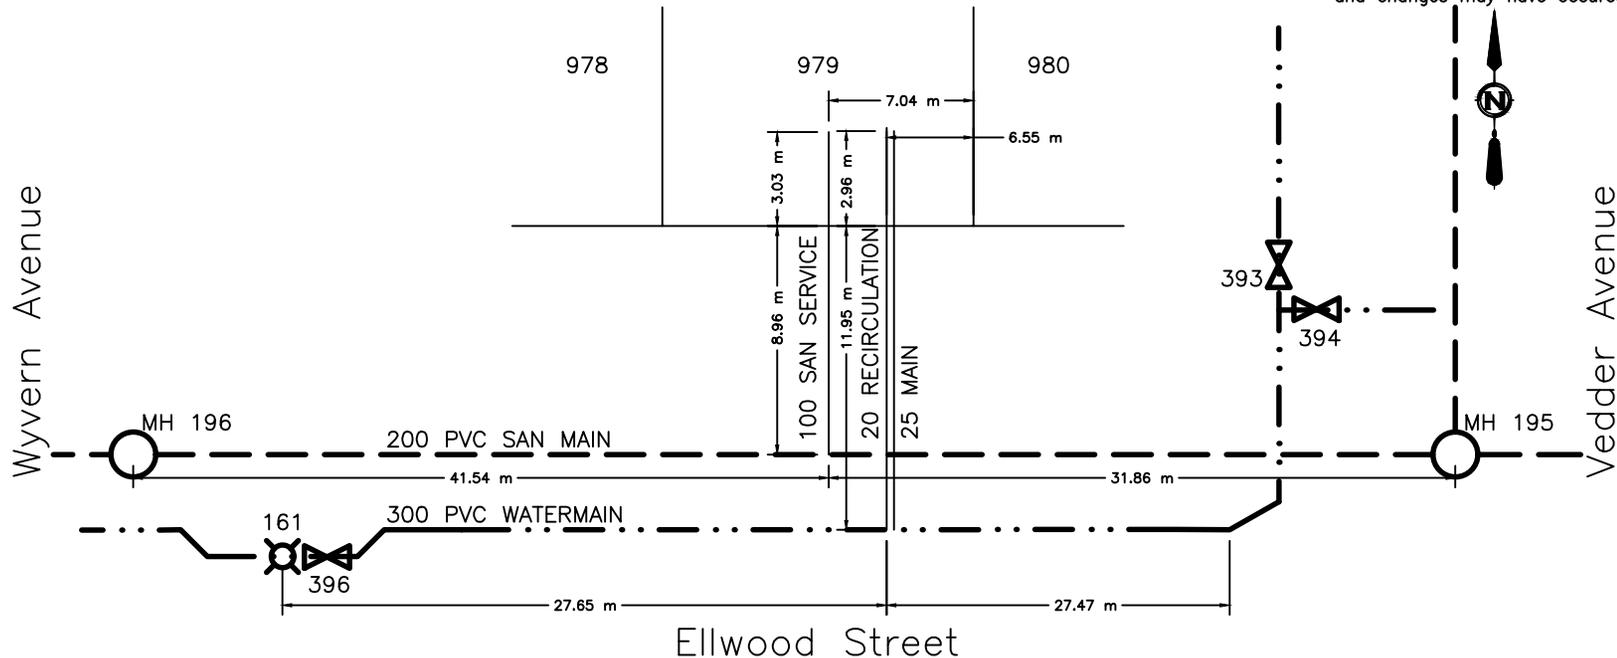



CITY OF WHITEHORSE SERVICE CONNECTION RECORD

FIELD BOOK


No.

ADDRESS 41 Ellwood Street BLOCK LOT 980

DATES		WATER		SEWER		
On at Main	2020-SEPT-01	Depth at P/L:	2.50 m		2.58 m	
On at Building		Depth at Main:	2.78 m		3.85 m	
Frost Plug:		Pipe Size:	25 mm / 20 mm		100 mm	
Memo:		Pipe Material:	HDPE	Insul. <input checked="" type="checkbox"/> Yes / <input type="checkbox"/> No	PVC	Insul. <input type="checkbox"/> Yes / <input checked="" type="checkbox"/> No
		Length from Main to P/L:	11.90 m		9.00 m	
		Squirt Test:	<input checked="" type="checkbox"/> Pass / <input type="checkbox"/> Fail			N/A
Booster Pump Required:	Yes/No	Frost Protection:	Aquaflow / <input checked="" type="checkbox"/> Recirc / Heat Trace / Bleeder		N/A	
PRV Required:	Yes/No	Greased @ CC:	<input checked="" type="checkbox"/> Yes / <input type="checkbox"/> No		N/A	
Water Meter Installed:	Yes/No	Continuity Test:	<input type="checkbox"/> N/A / <input type="checkbox"/> Pass / <input type="checkbox"/> Fail		N/A	

CLEARLY INDICATE LOCATION OF CC AND ROUTE OF PIPES ON DRAWING BELOW

1. Show main valves required to isolate this service. 2. All dimensions to be tied to property line 3. All dimensions to be metric 4. Depth @ property line is based on elevation after construction and changes may have occurred.

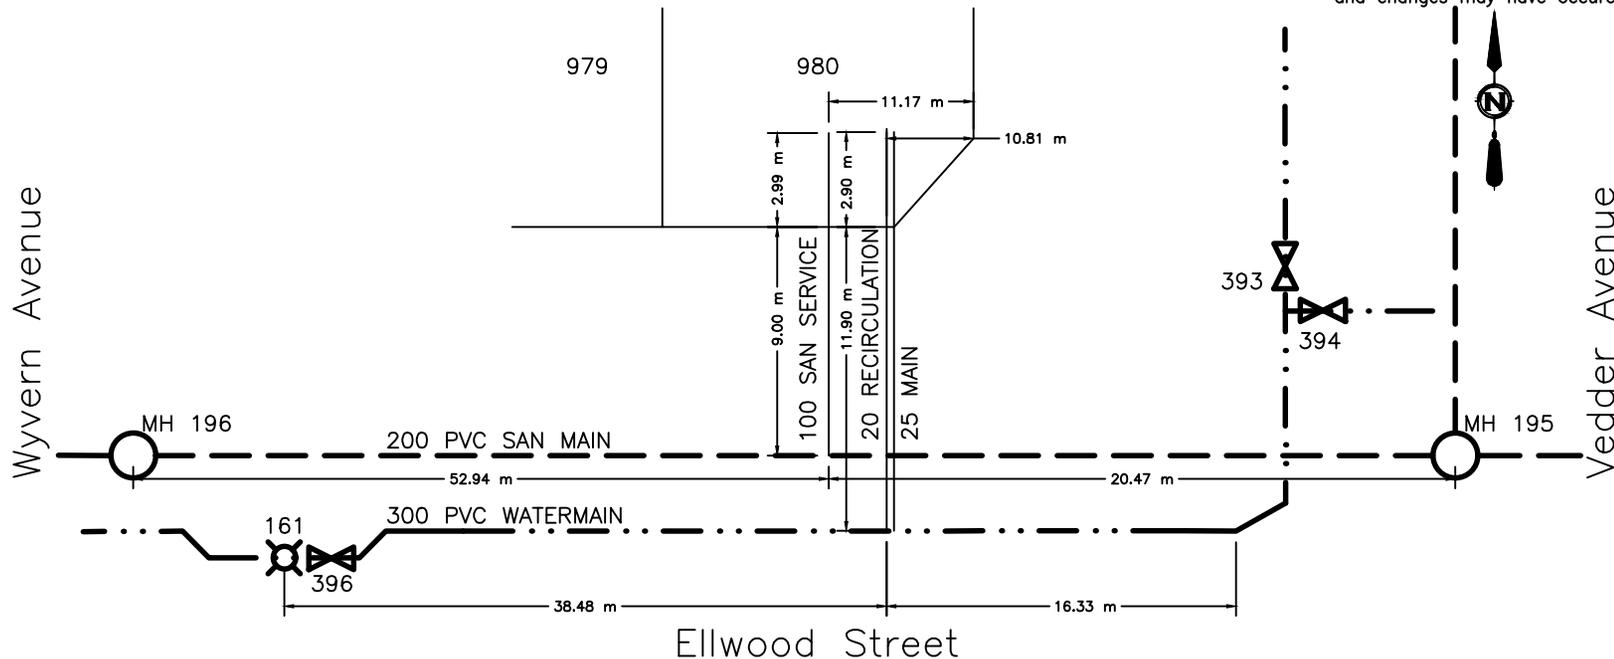



CITY OF WHITEHORSE SERVICE CONNECTION RECORD

FIELD BOOK


No.

ADDRESS 78 Wyvern Avenue BLOCK LOT 989

DATES	WATER	SEWER
On at Main 2020-AUG-28	Depth at P/L: 2.84 m	2.87 m
On at Building	Depth at Main: 3.24 m	5.30 m
Frost Plug:	Pipe Size: 25 mm / 20 mm	100 mm
Memo:	Pipe Material: HDPE	PVC
	Insul. <input checked="" type="checkbox"/> Yes / <input type="checkbox"/> No	Insul. <input checked="" type="checkbox"/> Yes / <input type="checkbox"/> No
	Length from Main to P/L: 11.04 m	6.27 m
	Squirt Test: <input checked="" type="checkbox"/> Pass / <input type="checkbox"/> Fail	N/A
Booster Pump Required: <input type="checkbox"/> Yes / <input checked="" type="checkbox"/> No	Frost Protection: Aquaflo / <input checked="" type="checkbox"/> Recirc / Heat Trace / Bleeder	N/A
PRV Required: <input type="checkbox"/> Yes / <input checked="" type="checkbox"/> No	Greased @ CC: <input checked="" type="checkbox"/> Yes / <input type="checkbox"/> No	N/A
Water Meter Installed: <input type="checkbox"/> Yes / <input checked="" type="checkbox"/> No	Continuity Test: <input checked="" type="checkbox"/> N/A / <input type="checkbox"/> Pass / <input type="checkbox"/> Fail	N/A

CLEARLY INDICATE LOCATION OF CC AND ROUTE OF PIPES ON DRAWING BELOW

1. Show main valves required to isolate this service. 2. All dimensions to be tied to property line 3. All dimensions to be metric 4. Depth @ property line is based on elevation after construction and changes may have occurred.

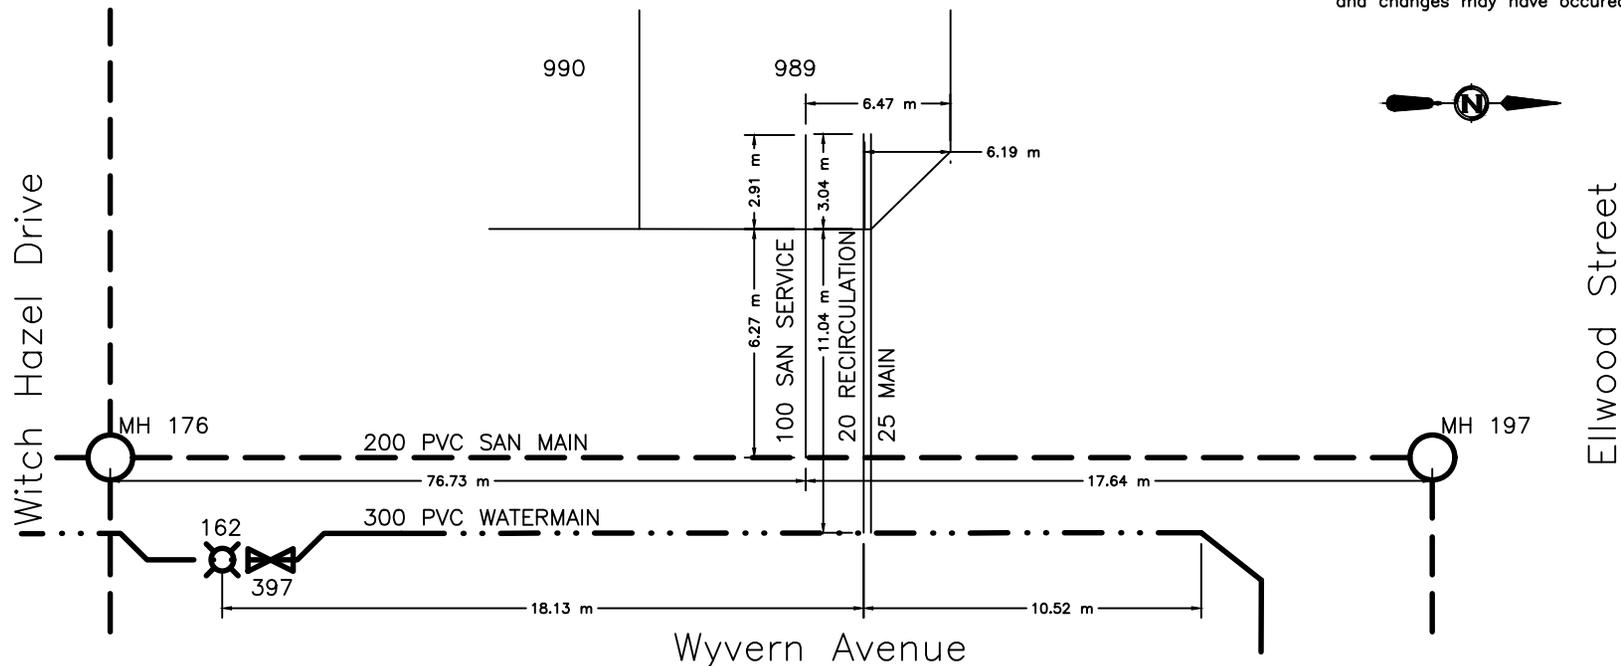



CITY OF WHITEHORSE SERVICE CONNECTION RECORD

FIELD BOOK


No.

ADDRESS 76 Wyvern Avenue BLOCK LOT 990

DATES	WATER	SEWER
On at Main 2020-AUG-24	Depth at P/L: 2.62 m	2.65 m
On at Building	Depth at Main: 3.09 m	5.40 m
Frost Plug:	Pipe Size: 25 mm / 20 mm	100 mm
Memo:	Pipe Material: HDPE	PVC
	Insul. <input checked="" type="checkbox"/> Yes / <input type="checkbox"/> No	Insul. <input checked="" type="checkbox"/> Yes / <input type="checkbox"/> No
	Length from Main to P/L: 10.89 m	8.25 m
	Squirt Test: <input checked="" type="checkbox"/> Pass / <input type="checkbox"/> Fail	N/A
Booster Pump Required: <input type="checkbox"/> Yes / <input checked="" type="checkbox"/> No	Frost Protection: Aquaflo / <input checked="" type="checkbox"/> Recirc / Heat Trace / Bleeder	N/A
PRV Required: <input type="checkbox"/> Yes / <input checked="" type="checkbox"/> No	Greased @ CC: <input checked="" type="checkbox"/> Yes / <input type="checkbox"/> No	N/A
Water Meter Installed: <input type="checkbox"/> Yes / <input checked="" type="checkbox"/> No	Continuity Test: <input checked="" type="checkbox"/> N/A	N/A

CLEARLY INDICATE LOCATION OF CC AND ROUTE OF PIPES ON DRAWING BELOW

1. Show main valves required to isolate this service. 2. All dimensions to be tied to property line 3. All dimensions to be metric 4. Depth @ property line is based on elevation after construction and changes may have occurred.

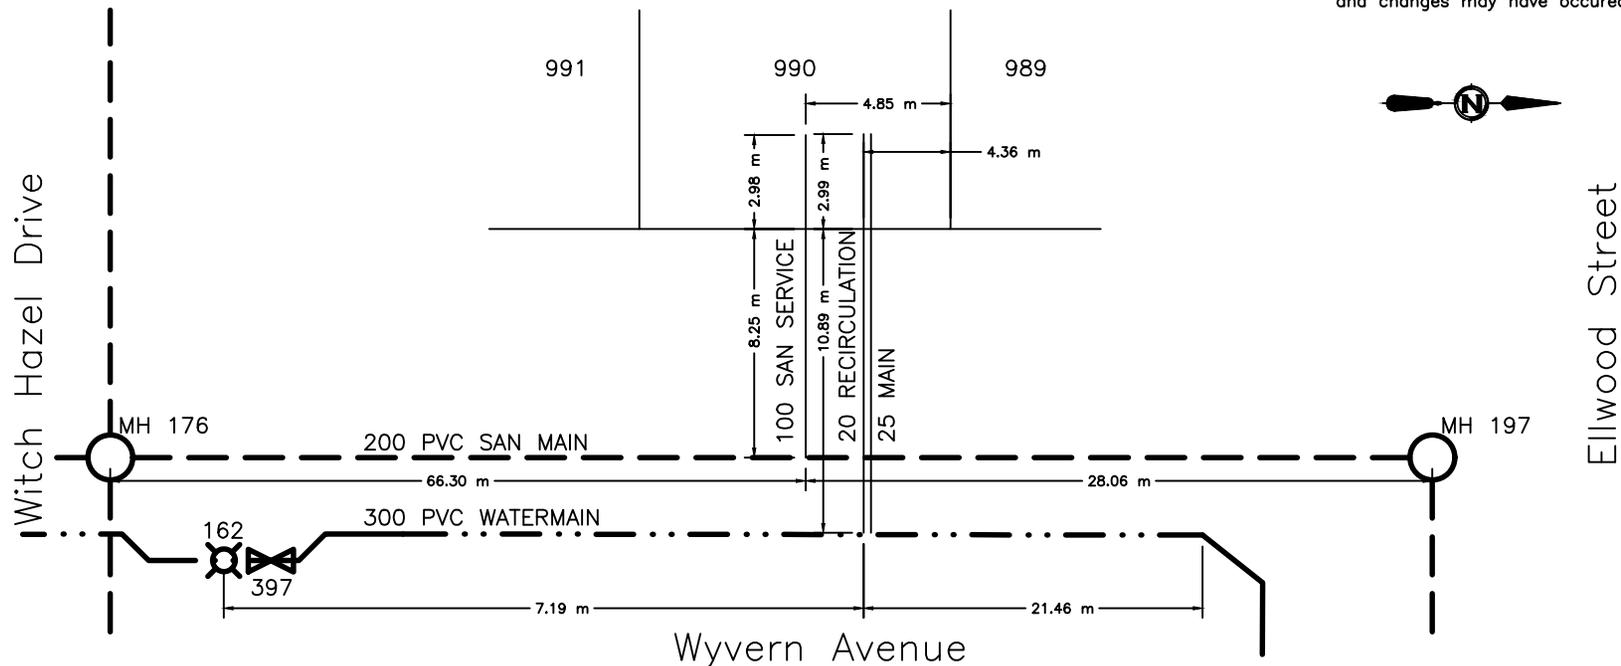



CITY OF WHITEHORSE SERVICE CONNECTION RECORD

FIELD BOOK


No.

ADDRESS 74 Wyvern Avenue BLOCK LOT 991

DATES		WATER		SEWER
On at Main	2020-AUG-28	Depth at P/L:	2.66 m	2.71 m
On at Building		Depth at Main:	3.03 m	5.54 m
Frost Plug:		Pipe Size:	25 mm / 20 mm	100 mm
Memo:		Pipe Material:	HDPE	PVC
		Insul.:	<input checked="" type="checkbox"/> Yes / <input type="checkbox"/> No	Insul. <input checked="" type="checkbox"/> Yes / <input type="checkbox"/> No
		Length from Main to P/L:	11.06 m	8.28 m
		Squirt Test:	<input checked="" type="checkbox"/> Pass / <input type="checkbox"/> Fail	N/A
Booster Pump Required:	<input type="checkbox"/> Yes / <input type="checkbox"/> No	Frost Protection:	Aquaflow / <input checked="" type="checkbox"/> Recirc / Heat Trace / Bleeder	N/A
PRV Required:	<input type="checkbox"/> Yes / <input type="checkbox"/> No	Greased @ CC:	<input checked="" type="checkbox"/> Yes / <input type="checkbox"/> No	N/A
Water Meter Installed:	<input type="checkbox"/> Yes / <input type="checkbox"/> No	Continuity Test:	<input checked="" type="checkbox"/> N/A / <input type="checkbox"/> Pass / <input type="checkbox"/> Fail	N/A

CLEARLY INDICATE LOCATION OF CC AND ROUTE OF PIPES ON DRAWING BELOW

1. Show main valves required to isolate this service. 2. All dimensions to be tied to property line 3. All dimensions to be metric 4. Depth @ property line is based on elevation after construction and changes may have occurred.

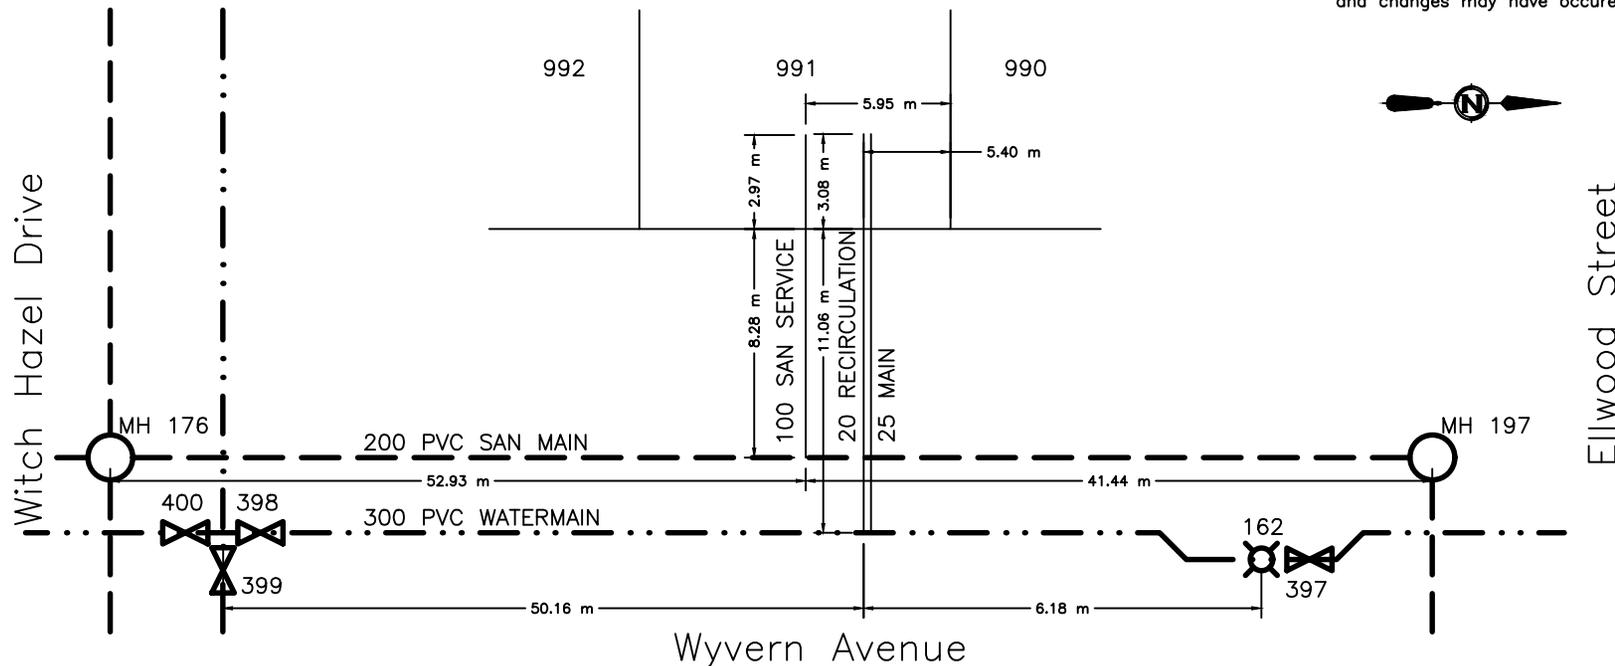



CITY OF WHITEHORSE SERVICE CONNECTION RECORD

FIELD BOOK


No.

ADDRESS 72 Wyvern Avenue BLOCK LOT 992

DATES		WATER		SEWER	
On at Main	YYYYMMDD	Depth at P/L:	2.53 m	2.60	m
On at Building	YYYYMMDD	Depth at Main:	3.05 m	5.69	m
Frost Plug:	YYYYMMDD	Pipe Size:	20 mm / 25 mm	100	mm
Memo:		Pipe Material:	HDPE	Insul.	<input checked="" type="radio"/> Yes / <input type="radio"/> No
		Length from Main to P/L:	11.06 m	8.24	m
		Squirt Test:	<input checked="" type="radio"/> Pass / <input type="radio"/> Fail		N/A
Booster Pump Required:	Yes/No	Frost Protection:	Aquaflow / <input checked="" type="radio"/> Recirc / Heat Trace / Bleeder		N/A
PRV Required:	Yes/No	Greased @ CC:	<input checked="" type="radio"/> Yes / <input type="radio"/> No		N/A
Water Meter Installed:	Yes/No	Continuity Test:	<input type="radio"/> N/A / <input type="radio"/> Pass / <input type="radio"/> Fail		N/A

CLEARLY INDICATE LOCATION OF CC AND ROUTE OF PIPES ON DRAWING BELOW

1. Show main valves required to isolate this service. 2. All dimensions to be tied to property line 3. All dimensions to be metric 4. Depth @ property line is based on elevation after construction and changes may have occurred.

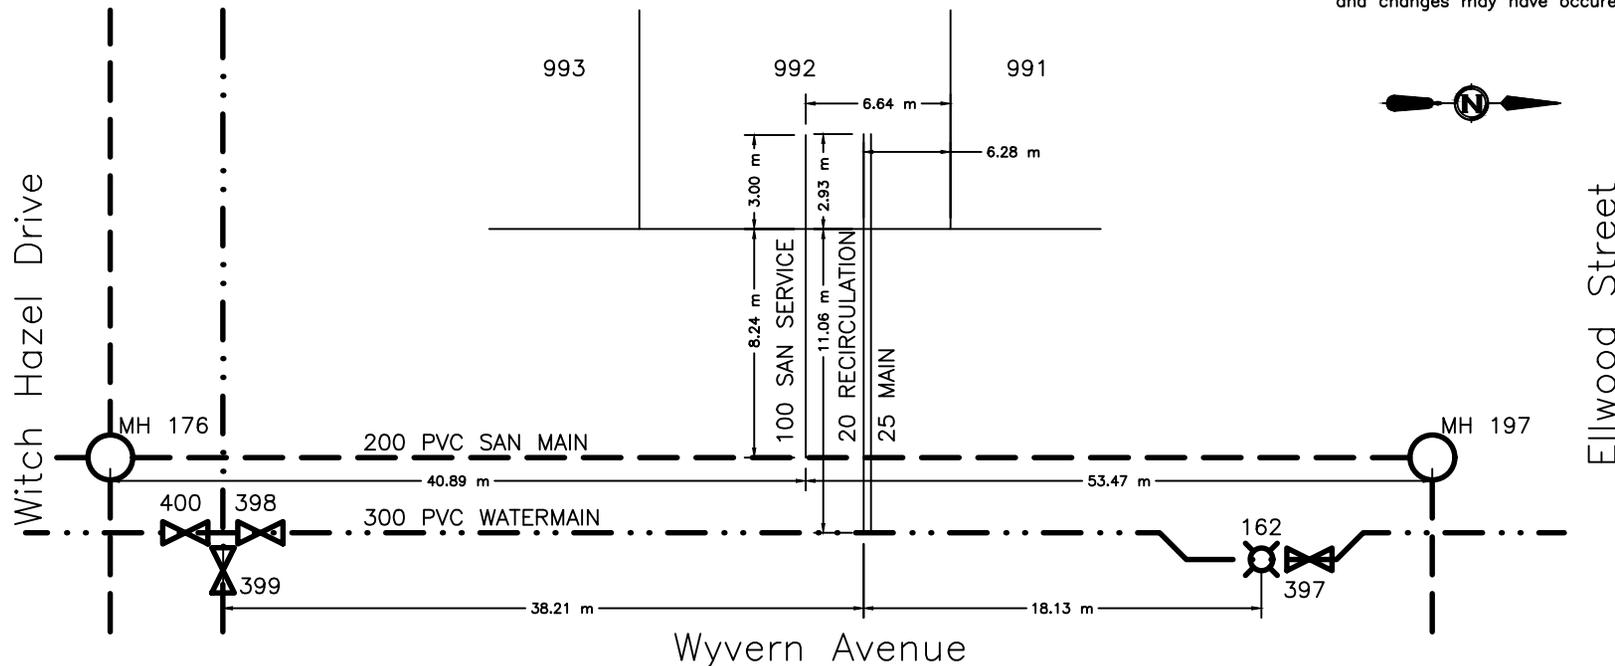



CITY OF WHITEHORSE SERVICE CONNECTION RECORD

FIELD BOOK


No.

ADDRESS 70 Wyvern Avenue BLOCK LOT 993

DATES		WATER		SEWER
On at Main	2020-AUG-28	Depth at P/L:	2.54 m	2.62 m
On at Building		Depth at Main:	3.01 m	5.84 m
Frost Plug:		Pipe Size:	25 mm / 20 mm	100 mm
Memo:		Pipe Material:	HDPE	PVC
		Insul.:	<input checked="" type="checkbox"/> Yes / <input type="checkbox"/> No	Insul. <input checked="" type="checkbox"/> Yes / <input type="checkbox"/> No
		Length from Main to P/L:	11.06 m	8.23 m
		Squirt Test:	<input checked="" type="checkbox"/> Pass / <input type="checkbox"/> Fail	N/A
Booster Pump Required:	<input type="checkbox"/> Yes / <input type="checkbox"/> No	Frost Protection:	Aquaflow / <input checked="" type="checkbox"/> Recirc / Heat Trace / Bleeder	N/A
PRV Required:	<input type="checkbox"/> Yes / <input type="checkbox"/> No	Greased @ CC:	<input checked="" type="checkbox"/> Yes / <input type="checkbox"/> No	N/A
Water Meter Installed:	<input type="checkbox"/> Yes / <input type="checkbox"/> No	Continuity Test:	<input checked="" type="checkbox"/> N/A / <input type="checkbox"/> Pass / <input type="checkbox"/> Fail	N/A

CLEARLY INDICATE LOCATION OF CC AND ROUTE OF PIPES ON DRAWING BELOW

1. Show main valves required to isolate this service. 2. All dimensions to be tied to property line 3. All dimensions to be metric 4. Depth @ property line is based on elevation after construction and changes may have occurred.

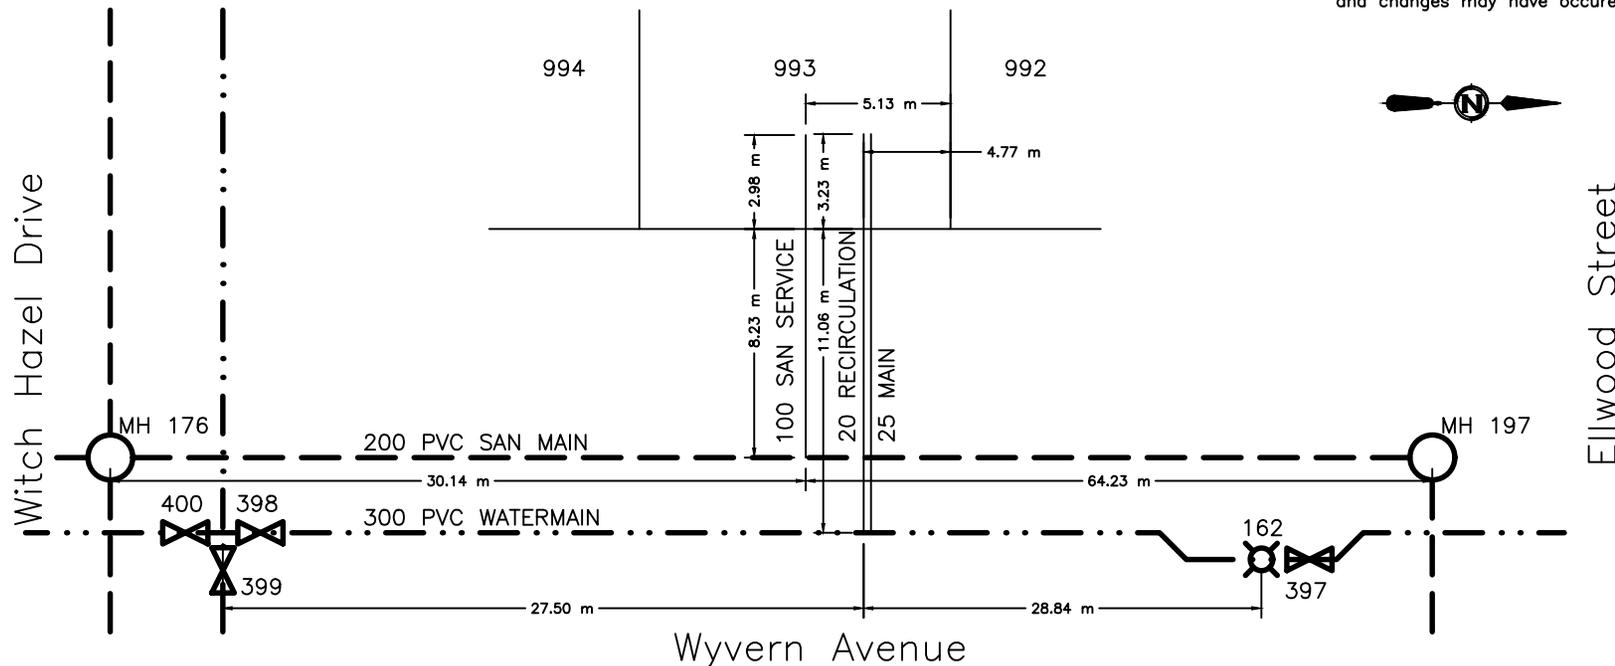



CITY OF WHITEHORSE SERVICE CONNECTION RECORD

FIELD BOOK


No.

ADDRESS 68 Wyvern Avenue BLOCK LOT 994

DATES		WATER		SEWER
On at Main	2020-AUG-21	Depth at P/L:	2.74 m	2.80 m
On at Building		Depth at Main:	3.03 m	5.94 m
Frost Plug:		Pipe Size:	25 mm / 20 mm	100 mm
Memo:		Pipe Material:	HDPE	PVC
		Insul.:	(Yes/No)	Insul. (Yes/No)
		Length from Main to P/L:	11.06 m	8.21 m
		Squirt Test:	(Pass/Fail)	N/A
Booster Pump Required:	Yes/No	Frost Protection:	Aquaflow/(Recirc)/Heat Trace/Bleeder	N/A
PRV Required:	Yes/No	Greased @ CC:	(Yes/No)	N/A
Water Meter Installed:	Yes/No	Continuity Test:	(N/A) Pass/Fail	N/A

CLEARLY INDICATE LOCATION OF CC AND ROUTE OF PIPES ON DRAWING BELOW

1. Show main valves required to isolate this service. 2. All dimensions to be tied to property line 3. All dimensions to be metric 4. Depth @ property line is based on elevation after construction and changes may have occurred.

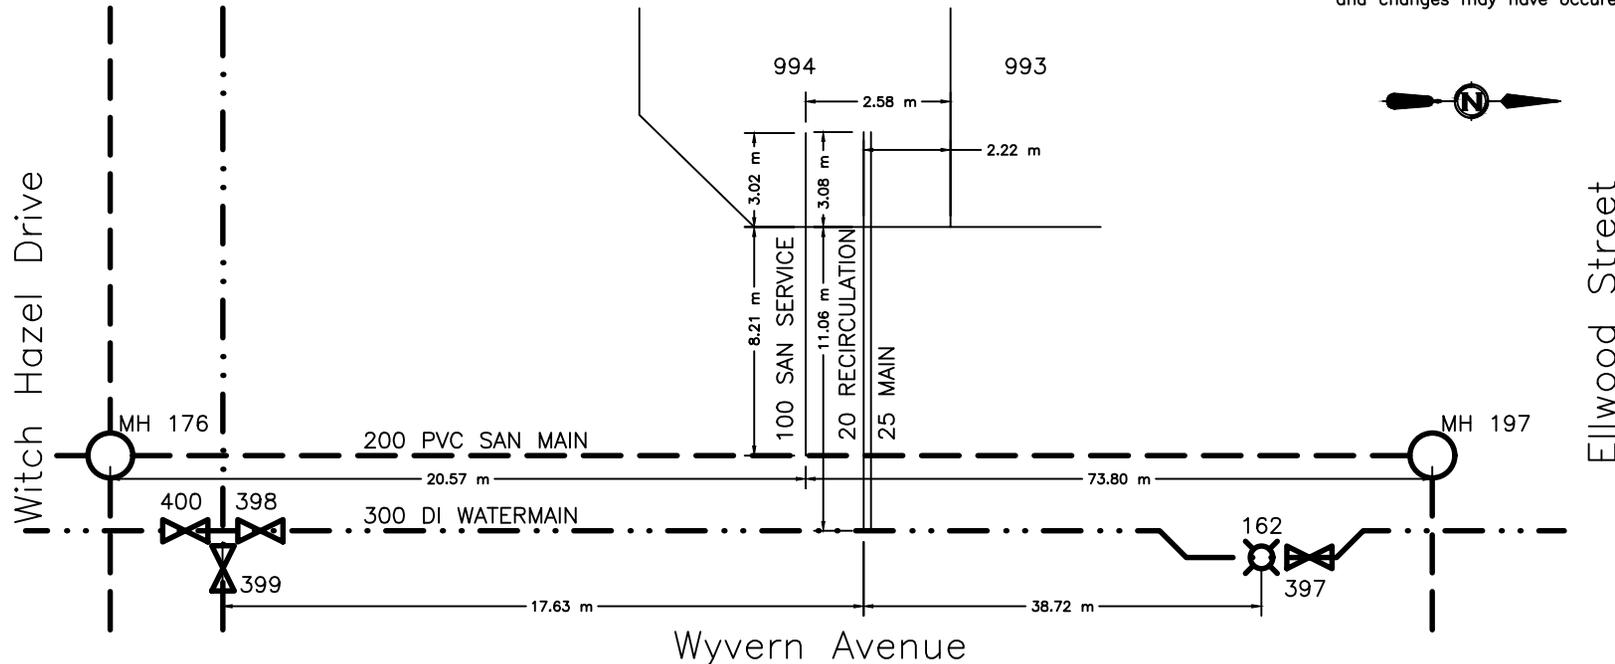



CITY OF WHITEHORSE SERVICE CONNECTION RECORD

FIELD BOOK


No.

ADDRESS 67 Wyvern Avenue BLOCK LOT 995

DATES		WATER		SEWER	
On at Main 2020-AUG-21		Depth at P/L: 2.64 m		2.70 m	
On at Building		Depth at Main: 3.03 m		5.96 m	
Frost Plug:		Pipe Size: 25 mm / 20 mm		100 mm	
Memo:		Pipe Material: HDPE Insul. <input checked="" type="checkbox"/> Yes / <input type="checkbox"/> No		PVC Insul. <input checked="" type="checkbox"/> Yes / <input type="checkbox"/> No	
		Length from Main to P/L: 6.66 m		9.78 m	
		Squirt Test: <input checked="" type="checkbox"/> Pass / <input type="checkbox"/> Fail		N/A	
Booster Pump Required:	<input type="checkbox"/> Yes / <input type="checkbox"/> No	Frost Protection: <input checked="" type="checkbox"/> Aquaflow / <input checked="" type="checkbox"/> Recirc / <input type="checkbox"/> Heat Trace / <input type="checkbox"/> Bleeder		N/A	
PRV Required:	<input type="checkbox"/> Yes / <input type="checkbox"/> No	Greased @ CC: <input checked="" type="checkbox"/> Yes / <input type="checkbox"/> No		N/A	
Water Meter Installed:	<input type="checkbox"/> Yes / <input type="checkbox"/> No	Continuity Test: <input checked="" type="checkbox"/> N/A <input type="checkbox"/> Pass / <input type="checkbox"/> Fail		N/A	

CLEARLY INDICATE LOCATION OF CC AND ROUTE OF PIPES ON DRAWING BELOW

1. Show main valves required to isolate this service. 2. All dimensions to be tied to property line 3. All dimensions to be metric 4. Depth @ property line is based on elevation after construction and changes may have occurred.

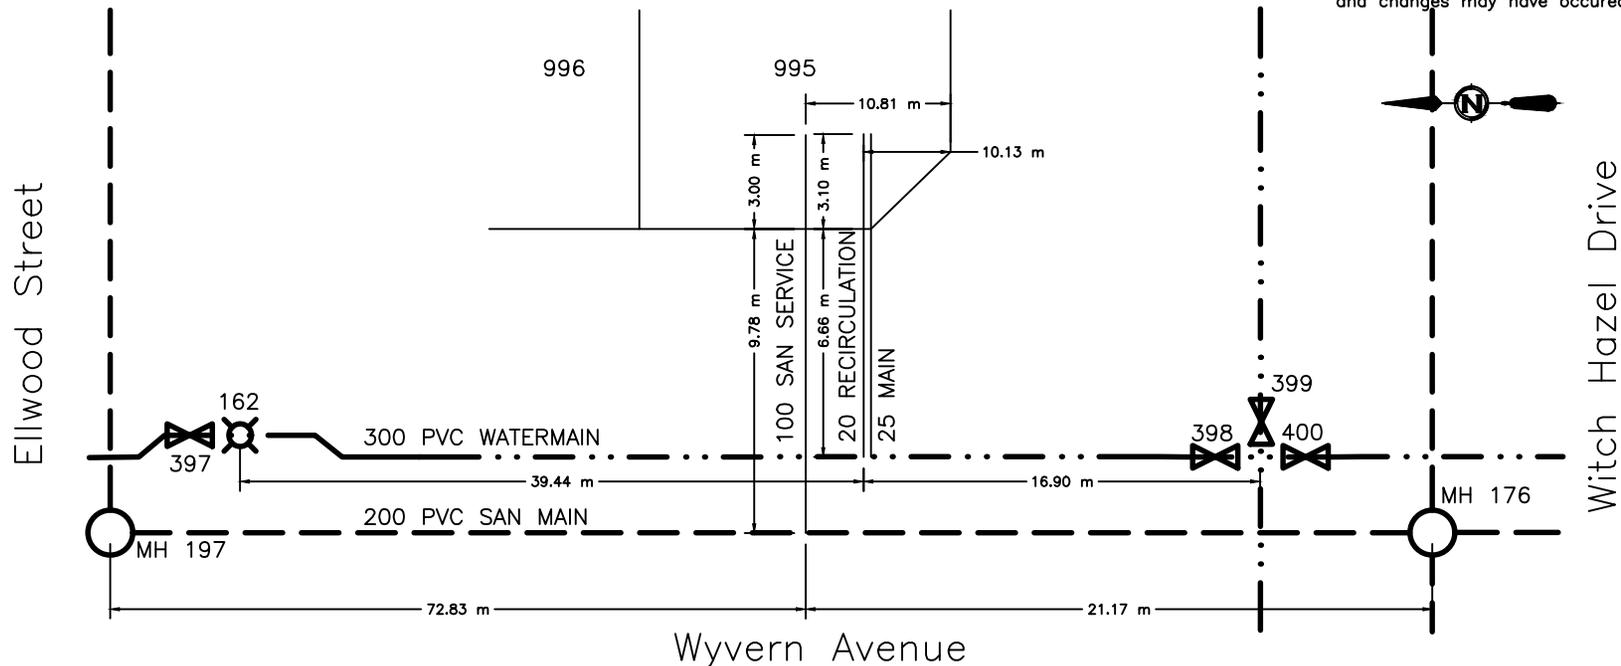



CITY OF WHITEHORSE SERVICE CONNECTION RECORD

FIELD BOOK


No.

ADDRESS 69 Wyvern Avenue BLOCK LOT 996

DATES	WATER	SEWER
On at Main 2020-AUG-28	Depth at P/L: 2.71 m	2.71 m
On at Building	Depth at Main: 3.01 m	5.84 m
Frost Plug:	Pipe Size: 25 mm / 20 mm	100 mm
Memo:	Pipe Material: HDPE Insul. <input checked="" type="checkbox"/> Yes / <input type="checkbox"/> No	PVC Insul. <input checked="" type="checkbox"/> Yes / <input type="checkbox"/> No
	Length from Main to P/L: 6.61 m	9.79 m
	Squirt Test: <input checked="" type="checkbox"/> Pass / <input type="checkbox"/> Fail	N/A
Booster Pump Required: <input type="checkbox"/> Yes / <input checked="" type="checkbox"/> No	Frost Protection: Aquaflo / <input checked="" type="checkbox"/> Recirc / Heat Trace / Bleeder	N/A
PRV Required: <input type="checkbox"/> Yes / <input checked="" type="checkbox"/> No	Greased @ CC: <input checked="" type="checkbox"/> Yes / <input type="checkbox"/> No	N/A
Water Meter Installed: <input type="checkbox"/> Yes / <input checked="" type="checkbox"/> No	Continuity Test: <input checked="" type="checkbox"/> N/A / <input type="checkbox"/> Pass / <input type="checkbox"/> Fail	N/A

CLEARLY INDICATE LOCATION OF CC AND ROUTE OF PIPES ON DRAWING BELOW

1. Show main valves required to isolate this service. 2. All dimensions to be tied to property line 3. All dimensions to be metric 4. Depth @ property line is based on elevation after construction and changes may have occurred.

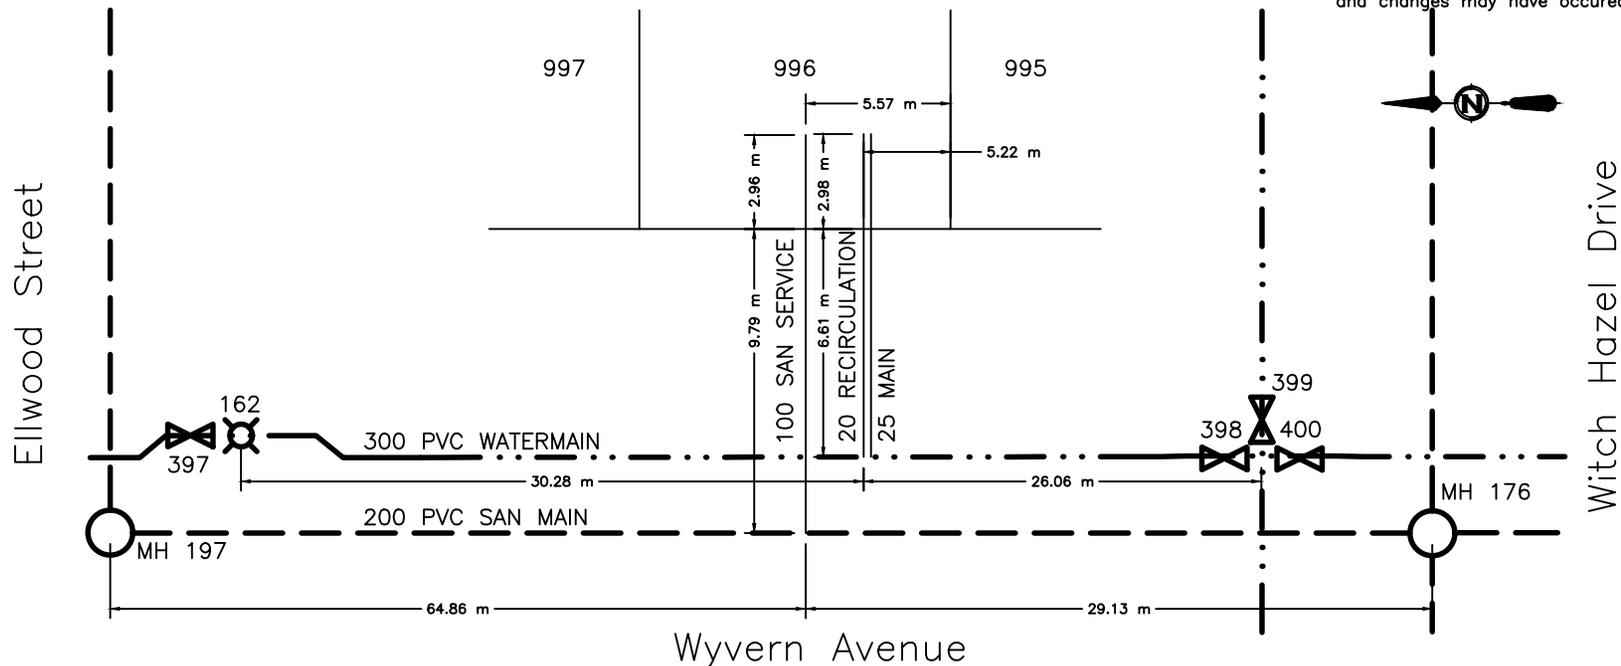



CITY OF WHITEHORSE SERVICE CONNECTION RECORD

FIELD BOOK


No.

ADDRESS 71 Wyvern Avenue BLOCK LOT 997

DATES		WATER		SEWER	
On at Main 2020-AUG-22		Depth at P/L: 2.58 m		2.67 m	
On at Building		Depth at Main: 3.03 m		5.65 m	
Frost Plug:		Pipe Size: 25 mm / 20 mm		100 mm	
Memo:		Pipe Material: HDPE Insul. <u>(Yes)</u> /No		PVC Insul. Yes/ <u>(No)</u>	
		Length from Main to P/L: 6.63 m		9.73 m	
		Squirt Test: <u>(Pass)</u> /Fail		N/A	
Booster Pump Required:	Yes/No	Frost Protection: Aquaflo/ <u>(Recirc)</u> /Heat Trace/Bleeder		N/A	
PRV Required:	Yes/No	Greased @ CC: <u>(Yes)</u> /No		N/A	
Water Meter Installed:	Yes/No	Continuity Test: <u>(N/A)</u> Pass/Fail		N/A	

CLEARLY INDICATE LOCATION OF CC AND ROUTE OF PIPES ON DRAWING BELOW

1. Show main valves required to isolate this service. 2. All dimensions to be tied to property line 3. All dimensions to be metric 4. Depth @ property line is based on elevation after construction and changes may have occurred.

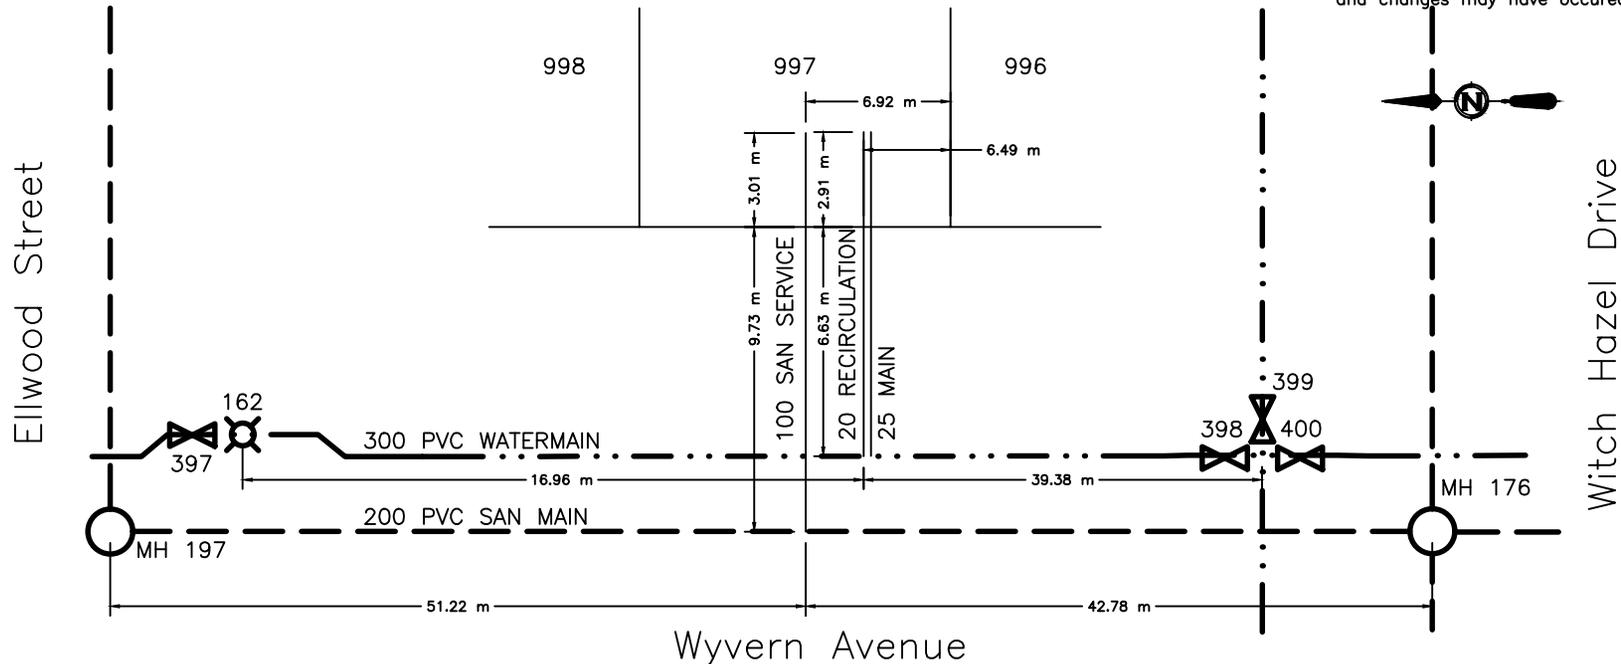



CITY OF WHITEHORSE SERVICE CONNECTION RECORD

FIELD BOOK


No.

ADDRESS 73 Wyvern Avenue BLOCK LOT 998

DATES		WATER		SEWER
On at Main	2020-AUG-28	Depth at P/L:	2.59 m	2.64 m
On at Building		Depth at Main:	3.04 m	5.52 m
Frost Plug:		Pipe Size:	25 mm / 20 mm	100 mm
Memo:		Pipe Material:	HDPE Insul. <input checked="" type="checkbox"/> Yes / <input type="checkbox"/> No	PVC Insul. <input checked="" type="checkbox"/> Yes / <input type="checkbox"/> No
		Length from Main to P/L:	6.62 m	9.75 m
		Squirt Test:	<input checked="" type="checkbox"/> Pass / <input type="checkbox"/> Fail	N/A
Booster Pump Required:	<input type="checkbox"/> Yes / <input type="checkbox"/> No	Frost Protection:	Aquaflow / <input checked="" type="checkbox"/> Recirc / Heat Trace / Bleeder	N/A
PRV Required:	<input type="checkbox"/> Yes / <input type="checkbox"/> No	Greased @ CC:	<input checked="" type="checkbox"/> Yes / <input type="checkbox"/> No	N/A
Water Meter Installed:	<input type="checkbox"/> Yes / <input type="checkbox"/> No	Continuity Test:	<input checked="" type="checkbox"/> N/A / <input type="checkbox"/> Pass / <input type="checkbox"/> Fail	N/A

CLEARLY INDICATE LOCATION OF CC AND ROUTE OF PIPES ON DRAWING BELOW

1. Show main valves required to isolate this service. 2. All dimensions to be tied to property line 3. All dimensions to be metric 4. Depth @ property line is based on elevation after construction and changes may have occurred.

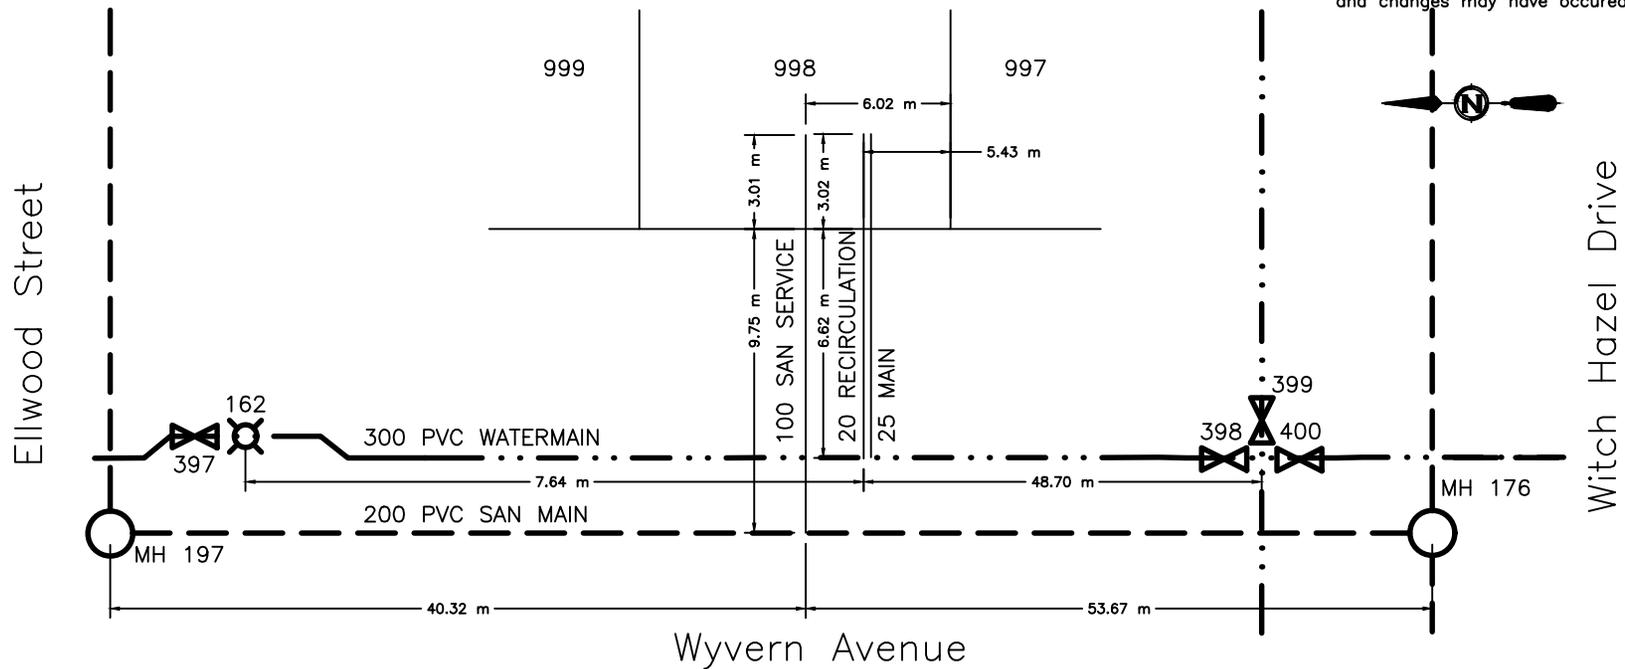



CITY OF WHITEHORSE SERVICE CONNECTION RECORD

FIELD BOOK


No.

ADDRESS 75 Wyvern Avenue BLOCK LOT 999

DATES		WATER		SEWER	
On at Main 2020-AUG-24		Depth at P/L: 2.71 m		2.78 m	
On at Building		Depth at Main: 3.09 m		5.39 m	
Frost Plug:		Pipe Size: 25 mm / 20 mm		100 mm	
Memo:		Pipe Material: HDPE		Insul. <input checked="" type="checkbox"/> Yes / <input type="checkbox"/> No	
		Length from Main to P/L: 6.66 m		PVC	
		Squirt Test: <input checked="" type="checkbox"/> Pass / <input type="checkbox"/> Fail		Insul. <input checked="" type="checkbox"/> Yes / <input type="checkbox"/> No	
Booster Pump Required: Yes/No		Frost Protection: Aquaflo / <input checked="" type="checkbox"/> Recirc / Heat Trace / Bleeder		N/A	
PRV Required: Yes/No		Greased @ CC: <input checked="" type="checkbox"/> Yes / <input type="checkbox"/> No		N/A	
Water Meter Installed: Yes/No		Continuity Test: <input checked="" type="checkbox"/> N/A		Pass/Fail	

CLEARLY INDICATE LOCATION OF CC AND ROUTE OF PIPES ON DRAWING BELOW

1. Show main valves required to isolate this service. 2. All dimensions to be tied to property line 3. All dimensions to be metric 4. Depth @ property line is based on elevation after construction and changes may have occurred.

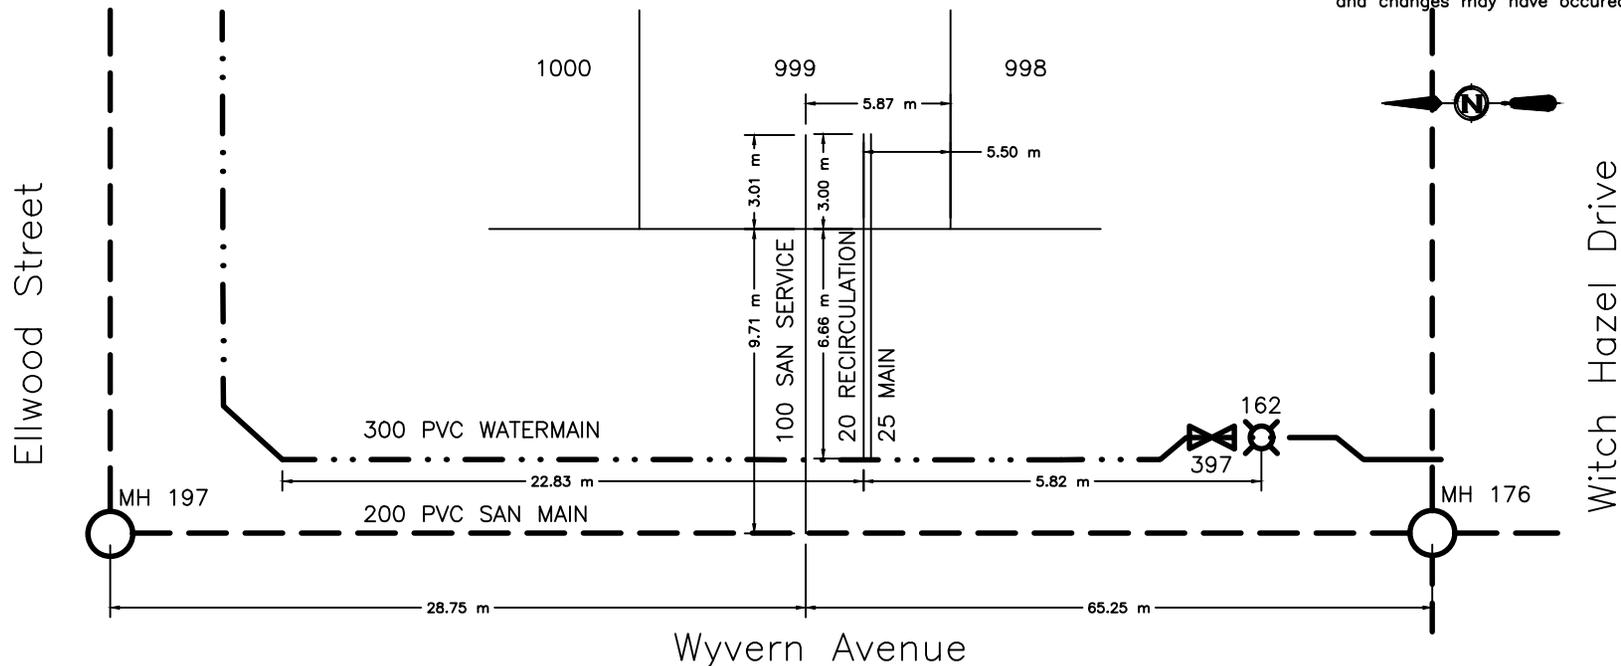



CITY OF WHITEHORSE SERVICE CONNECTION RECORD

FIELD BOOK


No.

ADDRESS 77 Wyvern Avenue BLOCK LOT 1000

DATES		WATER		SEWER	
On at Main 2020-AUG-28		Depth at P/L: 2.78 m		2.84 m	
On at Building		Depth at Main: 3.20 m		5.33 m	
Frost Plug:		Pipe Size: 25 mm / 20 mm		100 mm	
Memo:		Pipe Material: HDPE Insul. <u>(Yes)</u> /No		PVC Insul. Yes/ <u>(No)</u>	
		Length from Main to P/L: 6.65 m		9.72 m	
		Squirt Test: <u>(Pass)</u> /Fail		N/A	
Booster Pump Required:	Yes/No	Frost Protection: Aquaflo/ <u>(Recirc)</u> /Heat Trace/Bleeder		N/A	
PRV Required:	Yes/No	Greased @ CC: <u>(Yes)</u> /No		N/A	
Water Meter Installed:	Yes/No	Continuity Test: <u>(N/A)</u> Pass/Fail		N/A	

CLEARLY INDICATE LOCATION OF CC AND ROUTE OF PIPES ON DRAWING BELOW

1. Show main valves required to isolate this service. 2. All dimensions to be tied to property line 3. All dimensions to be metric 4. Depth @ property line is based on elevation after construction and changes may have occurred.

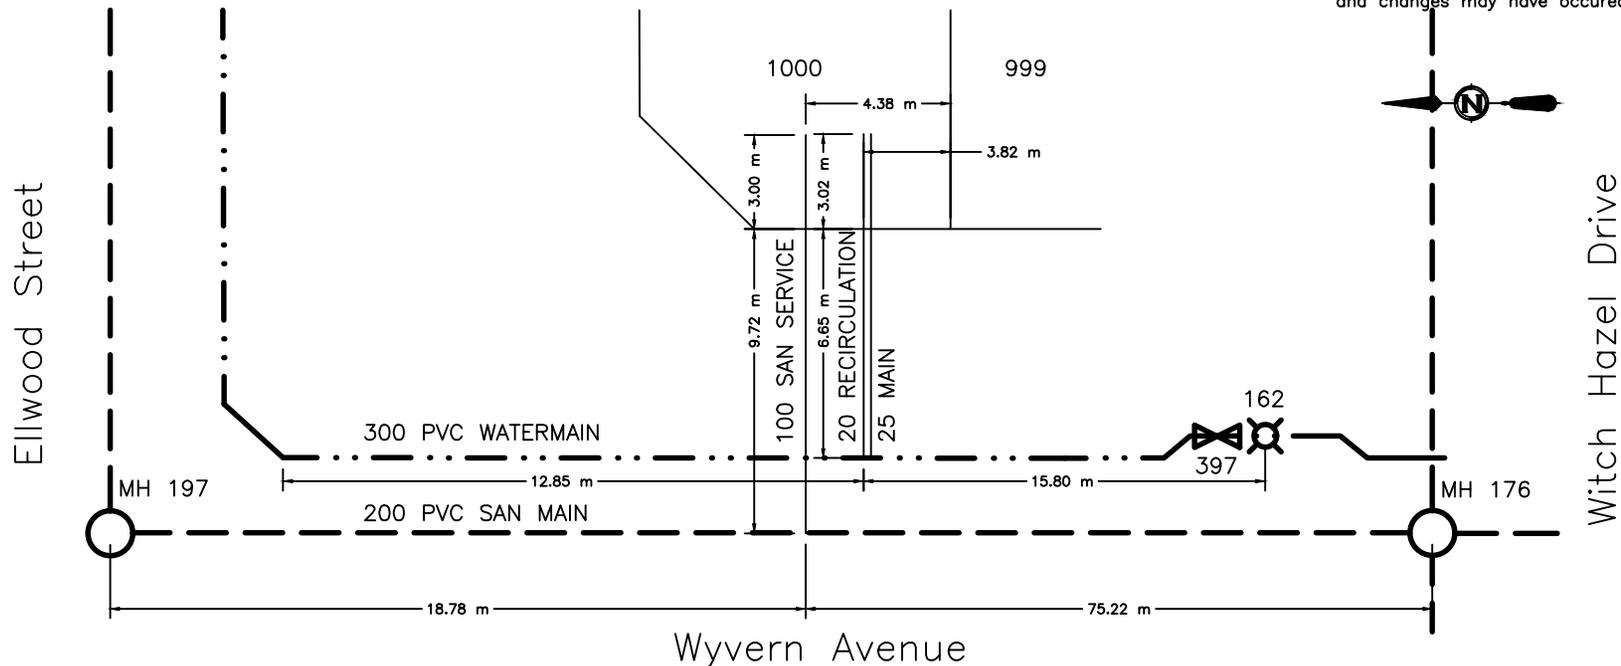



CITY OF WHITEHORSE SERVICE CONNECTION RECORD

FIELD BOOK


No.

ADDRESS 54 Ellwood Street BLOCK LOT 1001

DATES		WATER		SEWER	
On at Main 2020-AUG-26		Depth at P/L: 2.90 m		2.92 m	
On at Building		Depth at Main: 3.24 m		4.48 m	
Frost Plug:		Pipe Size: 25 mm / 20 mm		100 mm	
Memo:		Pipe Material: HDPE Insul. <input checked="" type="checkbox"/> Yes/No		PVC Insul. <input checked="" type="checkbox"/> Yes/No	
		Length from Main to P/L: 5.95 m		9.43 m	
		Squirt Test: <input checked="" type="checkbox"/> Pass/Fail		N/A	
Booster Pump Required:	Yes/No	Frost Protection: Aquaflo/ <input checked="" type="checkbox"/> Recirc/Heat Trace/Bleeder		N/A	
PRV Required:	Yes/No	Greased @ CC: <input checked="" type="checkbox"/> Yes/No		N/A	
Water Meter Installed:	Yes/No	Continuity Test: <input checked="" type="checkbox"/> N/A		Pass/Fail	

CLEARLY INDICATE LOCATION OF CC AND ROUTE OF PIPES ON DRAWING BELOW

1. Show main valves required to isolate this service. 2. All dimensions to be tied to property line 3. All dimensions to be metric 4. Depth @ property line is based on elevation after construction and changes may have occurred.

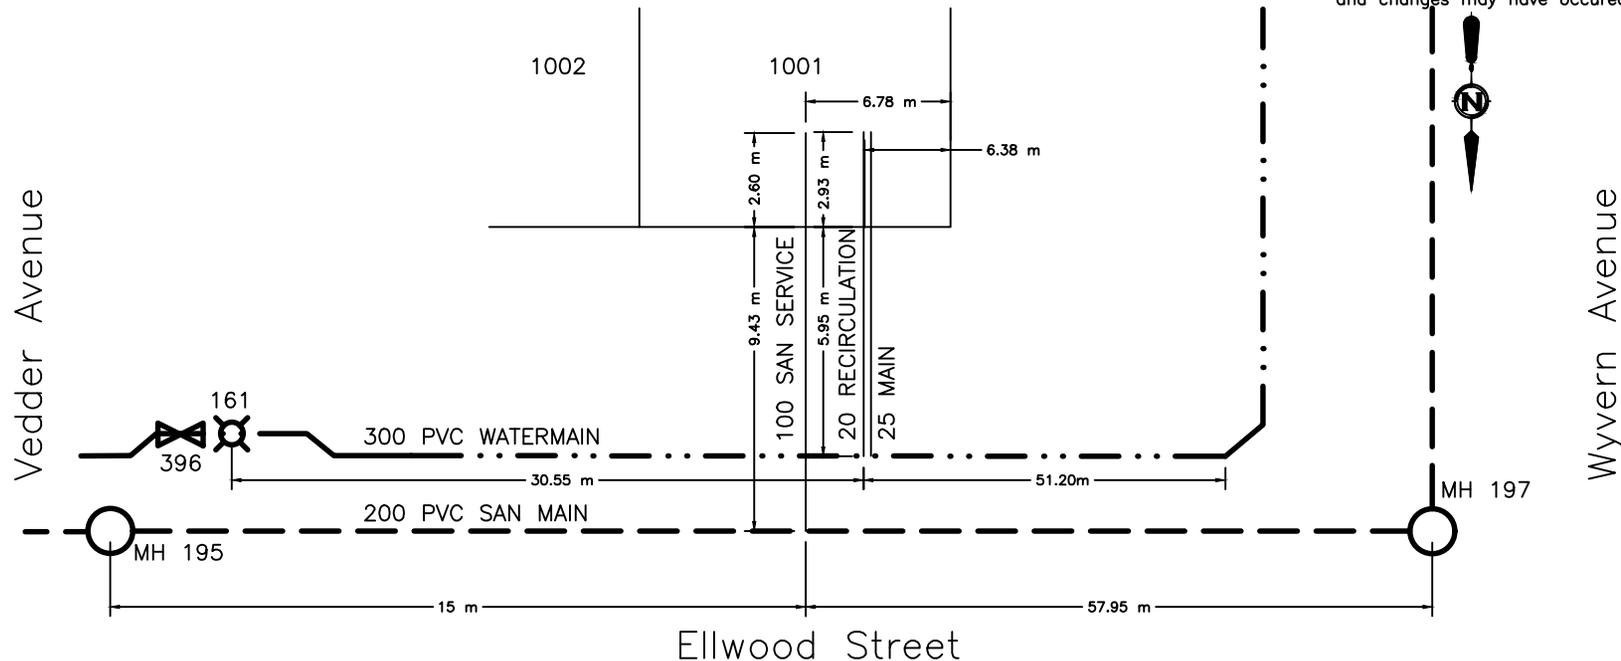



CITY OF WHITEHORSE SERVICE CONNECTION RECORD

FIELD BOOK


No.

ADDRESS 52 Ellwood Street BLOCK LOT 1002

DATES		WATER		SEWER	
On at Main 2020-AUG-27		Depth at P/L: 2.90 m		2.95 m	
On at Building		Depth at Main: 3.22 m		4.40 m	
Frost Plug:		Pipe Size: 25 mm / 20 mm		100 mm	
Memo:		Pipe Material: HDPE Insul. <input checked="" type="checkbox"/> Yes / <input type="checkbox"/> No		PVC Insul. <input checked="" type="checkbox"/> Yes / <input type="checkbox"/> No	
		Length from Main to P/L: 5.62 m		10.23 m	
		Squirt Test: <input checked="" type="checkbox"/> Pass / <input type="checkbox"/> Fail		N/A	
Booster Pump Required:	<input type="checkbox"/> Yes / <input type="checkbox"/> No	Frost Protection: <input checked="" type="checkbox"/> Aquaflow / <input checked="" type="checkbox"/> Recirc / <input type="checkbox"/> Heat Trace / <input type="checkbox"/> Bleeder		N/A	
PRV Required:	<input type="checkbox"/> Yes / <input type="checkbox"/> No	Greased @ CC: <input checked="" type="checkbox"/> Yes / <input type="checkbox"/> No		N/A	
Water Meter Installed:	<input type="checkbox"/> Yes / <input type="checkbox"/> No	Continuity Test: <input checked="" type="checkbox"/> N/A <input type="checkbox"/> Pass / <input type="checkbox"/> Fail		N/A	

CLEARLY INDICATE LOCATION OF CC AND ROUTE OF PIPES ON DRAWING BELOW

1. Show main valves required to isolate this service. 2. All dimensions to be tied to property line 3. All dimensions to be metric 4. Depth @ property line is based on elevation after construction and changes may have occurred.

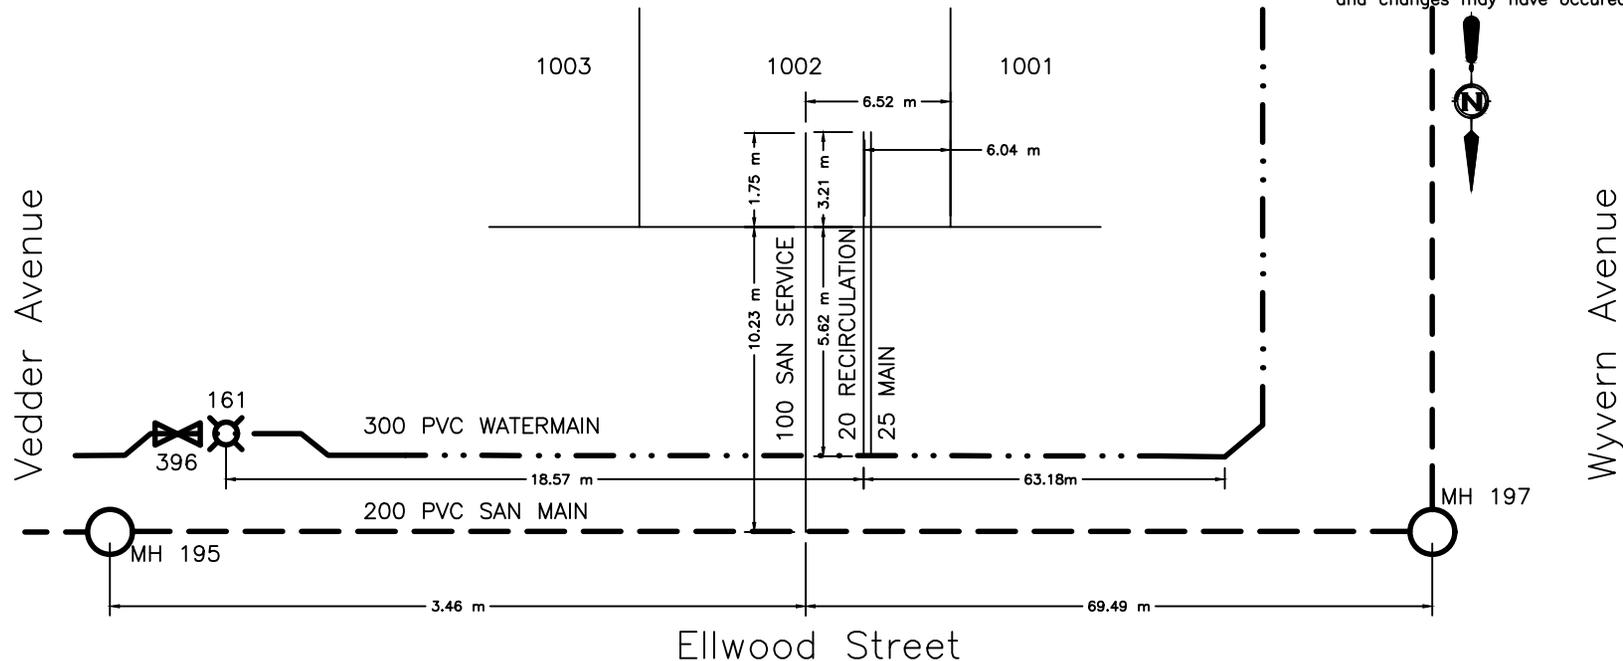



CITY OF WHITEHORSE SERVICE CONNECTION RECORD

FIELD BOOK


No.

ADDRESS 50 Ellwood Street BLOCK LOT 1003

DATES		WATER		SEWER	
On at Main	2020-AUG-28	Depth at P/L:	2.91 m	2.93 m	
On at Building		Depth at Main:	3.19 m	4.25 m	
Frost Plug:		Pipe Size:	25 mm / 20 mm	100 mm	
Memo:		Pipe Material:	HDPE	Insul. <input checked="" type="checkbox"/> Yes / <input type="checkbox"/> No	PVC
		Length from Main to P/L:	6.02 m	8.99 m	Insul. <input checked="" type="checkbox"/> Yes / <input type="checkbox"/> No
		Squirt Test:	<input checked="" type="checkbox"/> Pass / <input type="checkbox"/> Fail		N/A
Booster Pump Required:	<input type="checkbox"/> Yes / <input type="checkbox"/> No	Frost Protection:	Aquaflow / <input checked="" type="checkbox"/> Recirc / Heat Trace / Bleeder		N/A
PRV Required:	<input type="checkbox"/> Yes / <input type="checkbox"/> No	Greased @ CC:	<input checked="" type="checkbox"/> Yes / <input type="checkbox"/> No		N/A
Water Meter Installed:	<input type="checkbox"/> Yes / <input type="checkbox"/> No	Continuity Test:	<input checked="" type="checkbox"/> N/A / <input type="checkbox"/> Pass / <input type="checkbox"/> Fail		N/A

CLEARLY INDICATE LOCATION OF CC AND ROUTE OF PIPES ON DRAWING BELOW

1. Show main valves required to isolate this service. 2. All dimensions to be tied to property line 3. All dimensions to be metric 4. Depth @ property line is based on elevation after construction and changes may have occurred.

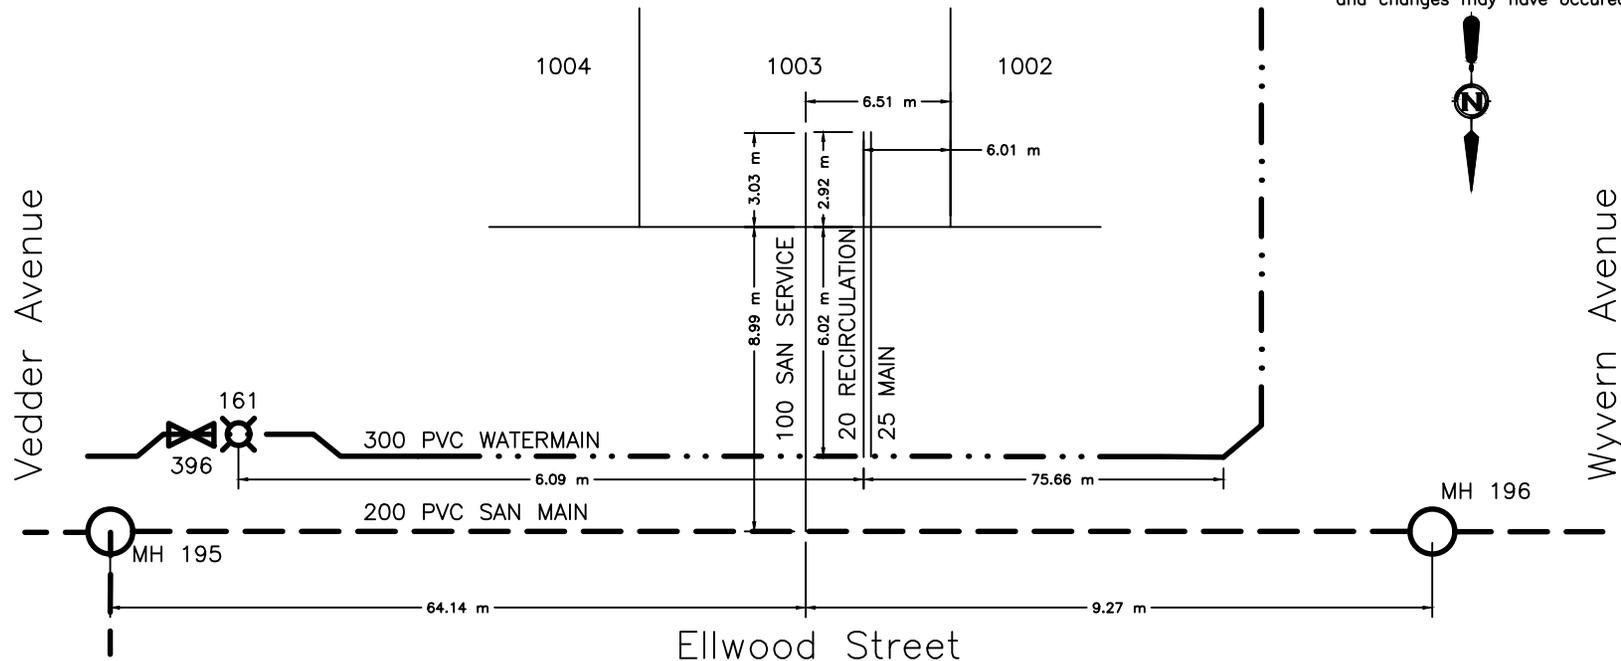



CITY OF WHITEHORSE SERVICE CONNECTION RECORD

FIELD BOOK


No.

ADDRESS 48 Ellwood Street BLOCK LOT 1004

DATES	WATER	SEWER
On at Main 2020-AUG-28	Depth at P/L: 2.79 m	2.83 m
On at Building	Depth at Main: 3.14 m	4.16 m
Frost Plug:	Pipe Size: 25 mm / 20 mm	100 mm
Memo:	Pipe Material: HDPE Insul. <input checked="" type="checkbox"/> Yes / <input type="checkbox"/> No	PVC Insul. <input checked="" type="checkbox"/> Yes / <input type="checkbox"/> No
	Length from Main to P/L: 5.96 m	9.09 m
	Squirt Test: <input checked="" type="checkbox"/> Pass / <input type="checkbox"/> Fail	N/A
Booster Pump Required: <input type="checkbox"/> Yes / <input checked="" type="checkbox"/> No	Frost Protection: Aquaflo / <input checked="" type="checkbox"/> Recirc / Heat Trace / Bleeder	N/A
PRV Required: <input type="checkbox"/> Yes / <input checked="" type="checkbox"/> No	Greased @ CC: <input checked="" type="checkbox"/> Yes / <input type="checkbox"/> No	N/A
Water Meter Installed: <input type="checkbox"/> Yes / <input checked="" type="checkbox"/> No	Continuity Test: <input checked="" type="checkbox"/> N/A / <input type="checkbox"/> Pass / <input type="checkbox"/> Fail	N/A

CLEARLY INDICATE LOCATION OF CC AND ROUTE OF PIPES ON DRAWING BELOW

1. Show main valves required to isolate this service. 2. All dimensions to be tied to property line 3. All dimensions to be metric 4. Depth @ property line is based on elevation after construction and changes may have occurred.

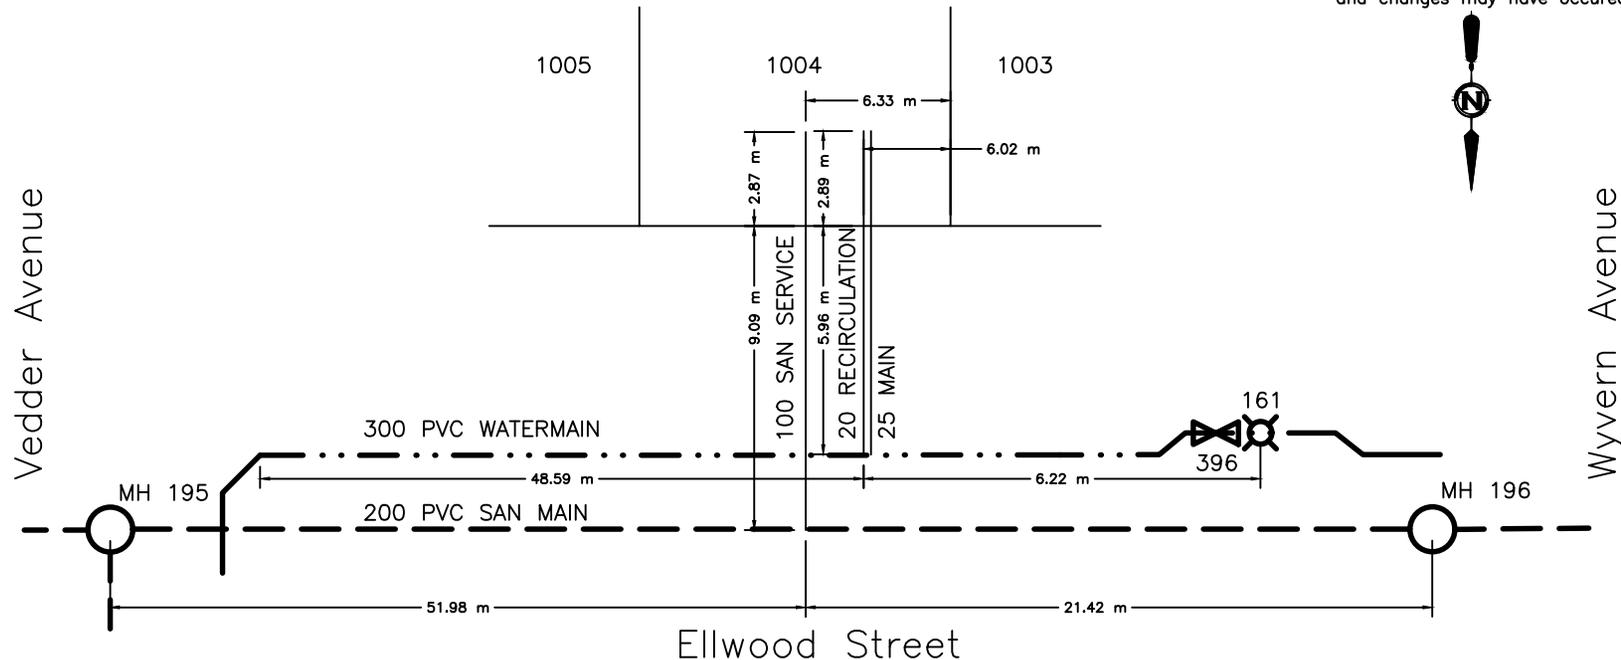



CITY OF WHITEHORSE SERVICE CONNECTION RECORD

FIELD BOOK


No.

ADDRESS 46 Ellwood Street BLOCK LOT 1005

DATES		WATER		SEWER
On at Main 2020-AUG-29		Depth at P/L: 2.68 m	2.70 m	
On at Building		Depth at Main: 2.98 m	4.03 m	
Frost Plug:		Pipe Size: 25 mm / 20 mm	100 mm	
Memo:		Pipe Material: HDPE	Insul. <input checked="" type="checkbox"/> Yes / <input type="checkbox"/> No	PVC
		Length from Main to P/L: 5.94 m	8.84 m	Insul. Yes / <input checked="" type="checkbox"/> No
		Squirt Test:	<input checked="" type="checkbox"/> Pass / <input type="checkbox"/> Fail	N/A
Booster Pump Required:	<input type="checkbox"/> Yes / <input type="checkbox"/> No	Frost Protection: Aquaflo / <input checked="" type="checkbox"/> Recirc / Heat Trace / Bleeder		N/A
PRV Required:	<input type="checkbox"/> Yes / <input type="checkbox"/> No	Greased @ CC:	<input checked="" type="checkbox"/> Yes / <input type="checkbox"/> No	N/A
Water Meter Installed:	<input type="checkbox"/> Yes / <input type="checkbox"/> No	Continuity Test: <input checked="" type="checkbox"/> N/A	Pass / <input type="checkbox"/> Fail	N/A

CLEARLY INDICATE LOCATION OF CC AND ROUTE OF PIPES ON DRAWING BELOW

1. Show main valves required to isolate this service. 2. All dimensions to be tied to property line 3. All dimensions to be metric 4. Depth @ property line is based on elevation after construction and changes may have occurred.

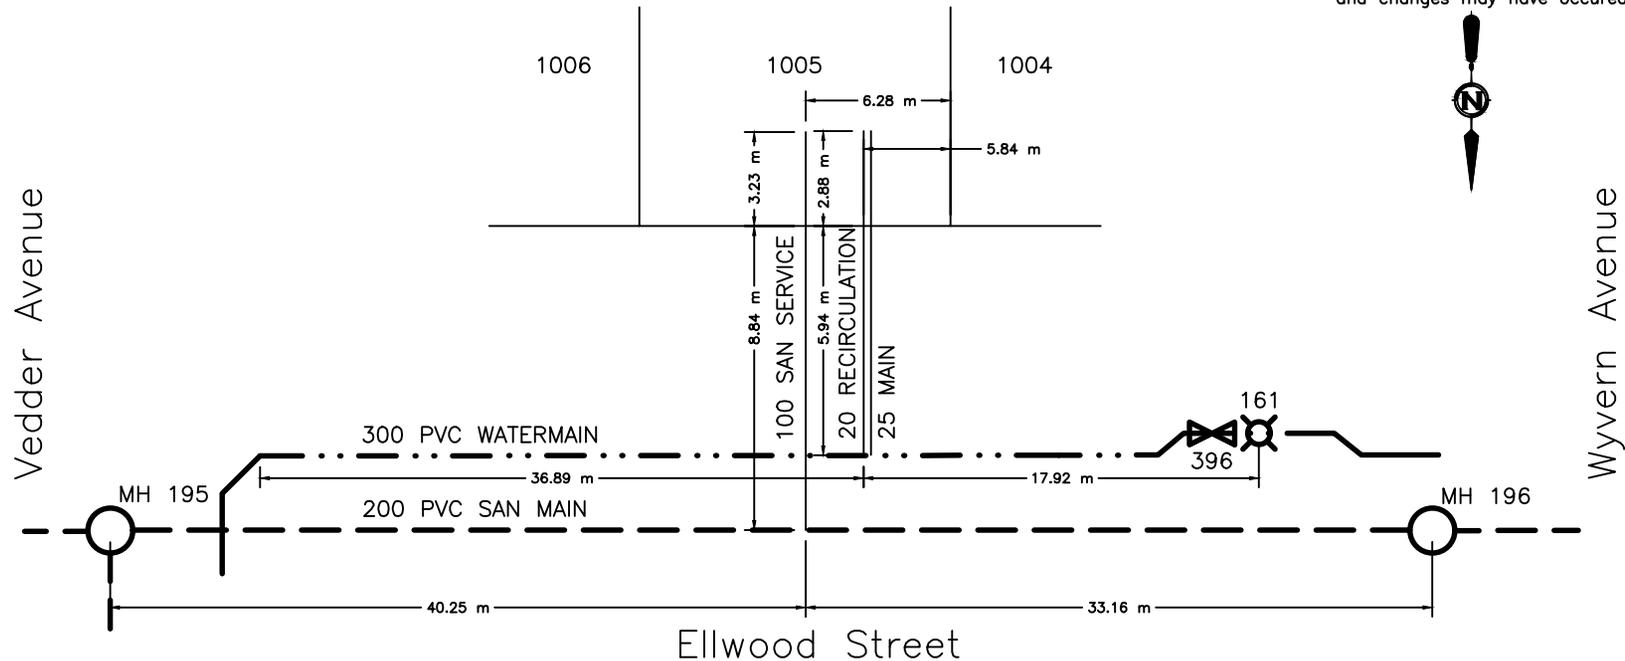



CITY OF WHITEHORSE SERVICE CONNECTION RECORD

FIELD BOOK


No.

ADDRESS 44 Ellwood Street BLOCK _____ LOT 1006

DATES		WATER		SEWER
On at Main	2020-AUG-29	Depth at P/L:	2.46 m	2.49 m
On at Building		Depth at Main:	2.81 m	3.94 m
Frost Plug:		Pipe Size:	25 mm / 20 mm	100 mm
Memo:		Pipe Material:	HDPE Insul. <input checked="" type="checkbox"/> Yes/ <input type="checkbox"/> No	PVC Insul. Yes/ <input checked="" type="checkbox"/> No
		Length from Main to P/L:	5.94 m	9.06 m
		Squirt Test:	<input checked="" type="checkbox"/> Pass/ <input type="checkbox"/> Fail	N/A
Booster Pump Required:	Yes/No	Frost Protection:	Aquaflow/ <input checked="" type="checkbox"/> Recirc/Heat Trace/Bleeder	N/A
PRV Required:	Yes/No	Greased @ CC:	<input checked="" type="checkbox"/> Yes/ <input type="checkbox"/> No	N/A
Water Meter Installed:	Yes/No	Continuity Test:	<input checked="" type="checkbox"/> N/A Pass/Fail	N/A

CLEARLY INDICATE LOCATION OF CC AND ROUTE OF PIPES ON DRAWING BELOW

1. Show main valves required to isolate this service. 2. All dimensions to be tied to property line 3. All dimensions to be metric 4. Depth @ property line is based on elevation after construction and changes may have occurred.

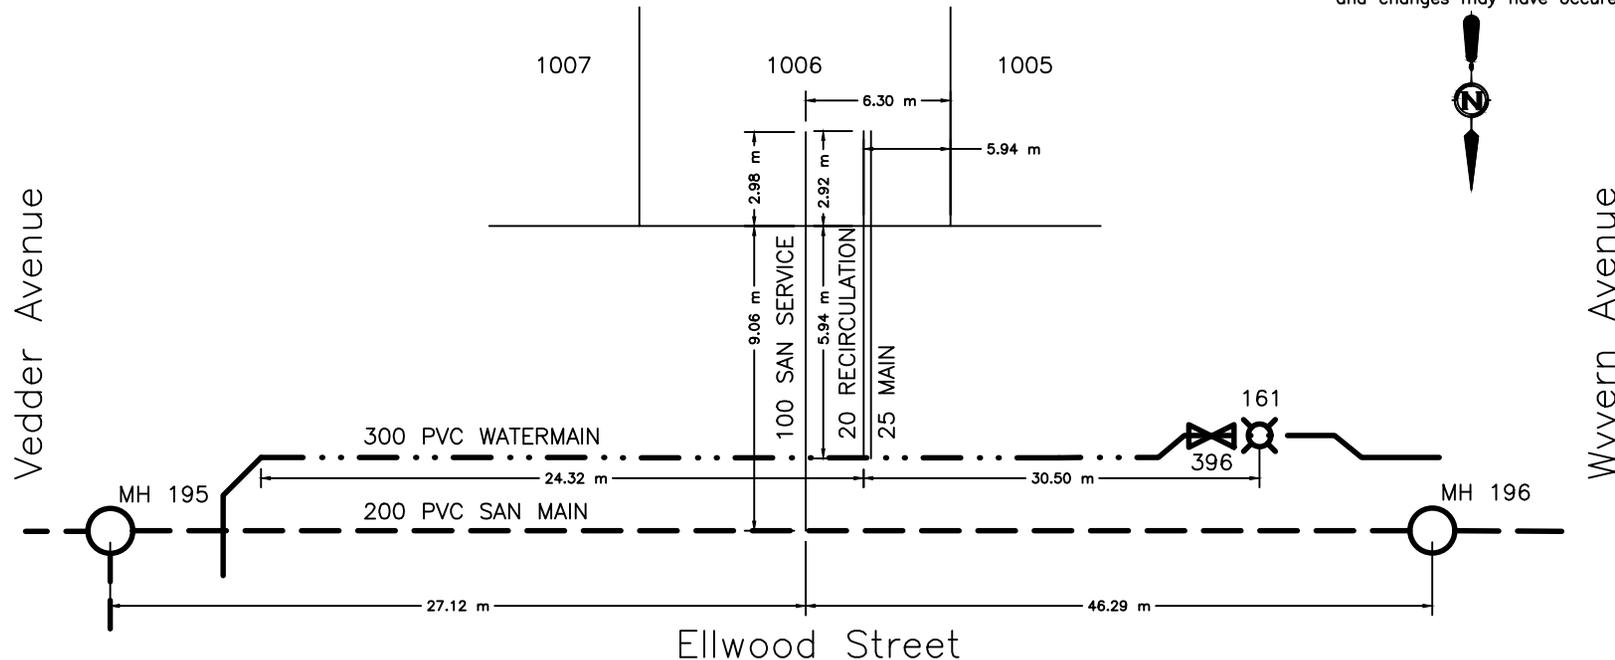



CITY OF WHITEHORSE SERVICE CONNECTION RECORD

FIELD BOOK


No.

ADDRESS 42 Ellwood Street BLOCK LOT 1007

DATES	WATER	SEWER
On at Main 2020-SEPT-01	Depth at P/L: 2.43 m	2.46 m
On at Building	Depth at Main: 2.74 m	3.82 m
Frost Plug:	Pipe Size: 25 mm / 20 mm	100 mm
Memo:	Pipe Material: HDPE Insul. <input checked="" type="checkbox"/> Yes / <input type="checkbox"/> No	PVC Insul. <input checked="" type="checkbox"/> Yes / <input type="checkbox"/> No
	Length from Main to P/L: 5.96 m	9.41 m
	Squirt Test: <input checked="" type="checkbox"/> Pass / <input type="checkbox"/> Fail	N/A
Booster Pump Required: <input type="checkbox"/> Yes / <input checked="" type="checkbox"/> No	Frost Protection: Aquaflo / <input checked="" type="checkbox"/> Recirc / Heat Trace / Bleeder	N/A
PRV Required: <input type="checkbox"/> Yes / <input checked="" type="checkbox"/> No	Greased @ CC: <input checked="" type="checkbox"/> Yes / <input type="checkbox"/> No	N/A
Water Meter Installed: <input type="checkbox"/> Yes / <input checked="" type="checkbox"/> No	Continuity Test: <input type="checkbox"/> N/A / <input checked="" type="checkbox"/> Pass / <input type="checkbox"/> Fail	N/A

CLEARLY INDICATE LOCATION OF CC AND ROUTE OF PIPES ON DRAWING BELOW

1. Show main valves required to isolate this service. 2. All dimensions to be tied to property line 3. All dimensions to be metric 4. Depth @ property line is based on elevation after construction and changes may have occurred.

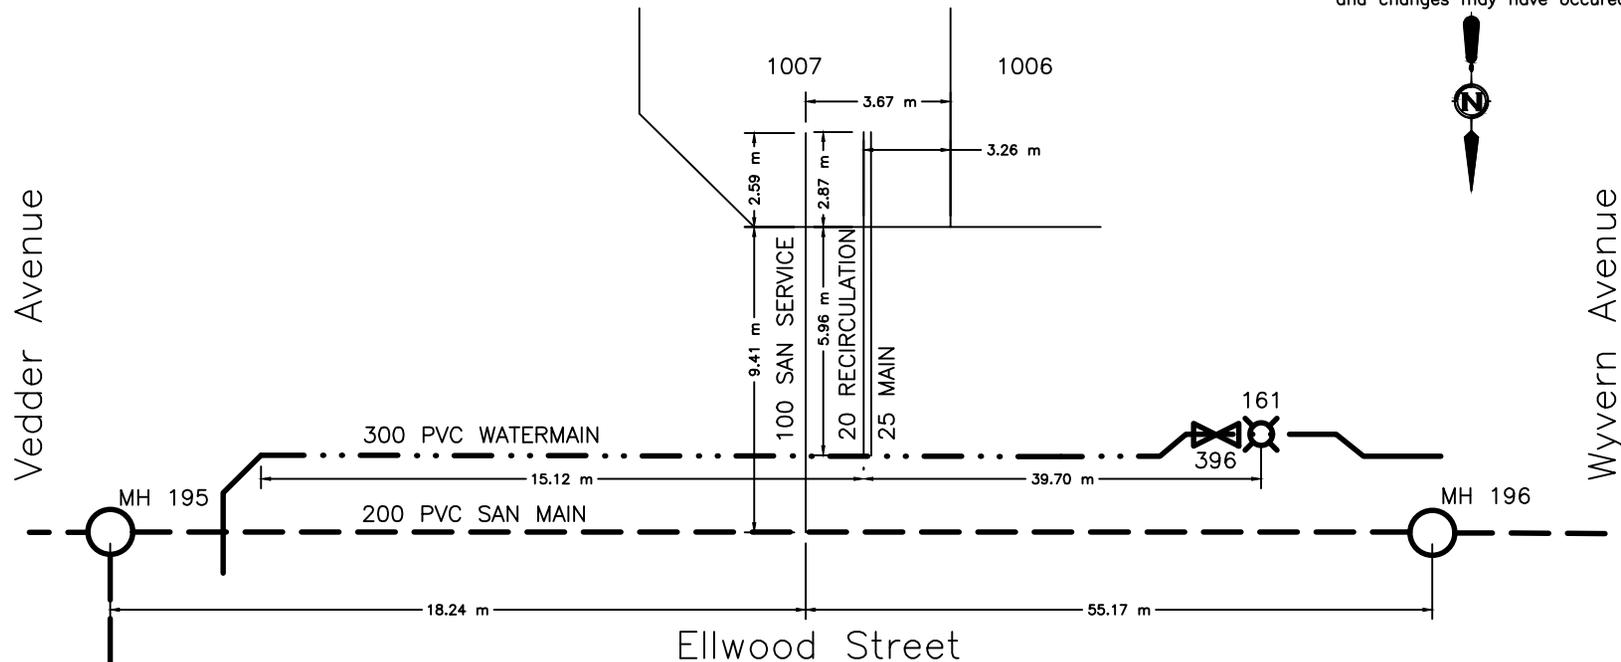



CITY OF WHITEHORSE SERVICE CONNECTION RECORD

FIELD BOOK


No.

ADDRESS 207 Witch Hazel Drive BLOCK LOT 1032

DATES		WATER		SEWER
On at Main 2020-JUL-25		Depth at P/L: 2.65 m	2.53 m	
On at Building		Depth at Main: 3.06 m	3.18 m	
Frost Plug:		Pipe Size: 25 mm / 20 mm	100 mm	
Memo:		Pipe Material: HDPE	Insul. <input checked="" type="checkbox"/> Yes / <input type="checkbox"/> No	PVC
		Length from Main to P/L: 7.16 m		10.39 m
		Squirt Test:	<input checked="" type="checkbox"/> Pass / <input type="checkbox"/> Fail	N/A
Booster Pump Required:	<input type="checkbox"/> Yes / <input type="checkbox"/> No	Frost Protection: Aquaflo / <input checked="" type="checkbox"/> Recirc / Heat Trace / Bleeder		N/A
PRV Required:	<input type="checkbox"/> Yes / <input type="checkbox"/> No	Greased @ CC: <input checked="" type="checkbox"/> Yes / <input type="checkbox"/> No		N/A
Water Meter Installed:	<input type="checkbox"/> Yes / <input type="checkbox"/> No	Continuity Test: <input type="checkbox"/> N/A / <input type="checkbox"/> Pass / <input type="checkbox"/> Fail		N/A

CLEARLY INDICATE LOCATION OF CC AND ROUTE OF PIPES ON DRAWING BELOW

1. Show main valves required to isolate this service. 2. All dimensions to be tied to property line 3. All dimensions to be metric 4. Depth @ property line is based on elevation after construction and changes may have occurred.

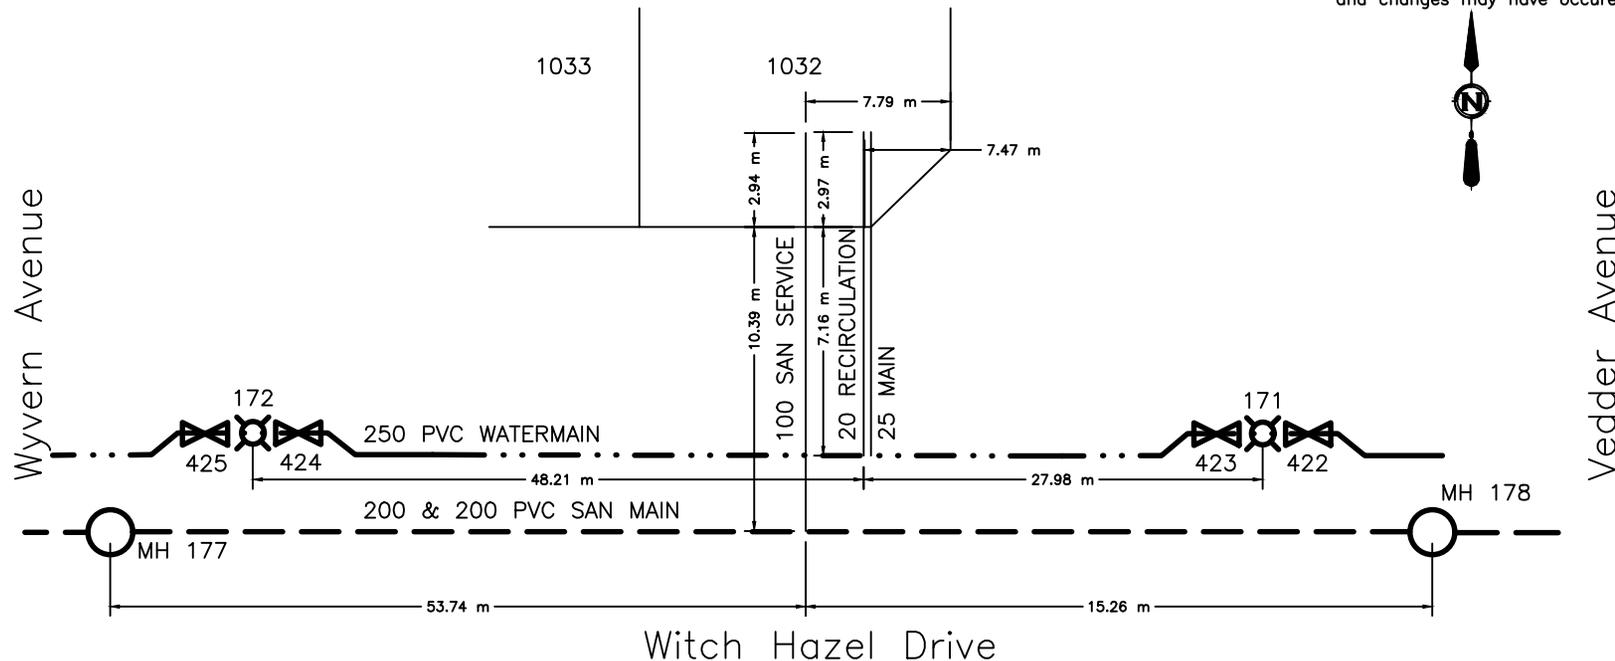



CITY OF WHITEHORSE SERVICE CONNECTION RECORD

FIELD BOOK


No.

ADDRESS 209 Witch Hazel Drive BLOCK LOT 1033

DATES		WATER		SEWER
On at Main	2020-JUL-29	Depth at P/L:	2.61 m	2.67 m
On at Building		Depth at Main:	3.09 m	3.18 m
Frost Plug:		Pipe Size:	25 mm / 20 mm	100 mm
Memo:		Pipe Material:	HDPE Insul. <input checked="" type="checkbox"/> Yes / <input type="checkbox"/> No	PVC Insul. <input checked="" type="checkbox"/> Yes / <input type="checkbox"/> No
		Length from Main to P/L:	7.16 m	10.31 m
		Squirt Test:	<input checked="" type="checkbox"/> Pass / <input type="checkbox"/> Fail	N/A
Booster Pump Required:	<input type="checkbox"/> Yes / <input checked="" type="checkbox"/> No	Frost Protection:	Aquaflow / <input checked="" type="checkbox"/> Recirc / Heat Trace / Bleeder	N/A
PRV Required:	<input type="checkbox"/> Yes / <input checked="" type="checkbox"/> No	Greased @ CC:	<input checked="" type="checkbox"/> Yes / <input type="checkbox"/> No	N/A
Water Meter Installed:	<input type="checkbox"/> Yes / <input checked="" type="checkbox"/> No	Continuity Test:	<input checked="" type="checkbox"/> N/A / <input type="checkbox"/> Pass / <input type="checkbox"/> Fail	N/A

CLEARLY INDICATE LOCATION OF CC AND ROUTE OF PIPES ON DRAWING BELOW

1. Show main valves required to isolate this service. 2. All dimensions to be tied to property line 3. All dimensions to be metric 4. Depth @ property line is based on elevation after construction and changes may have occurred.

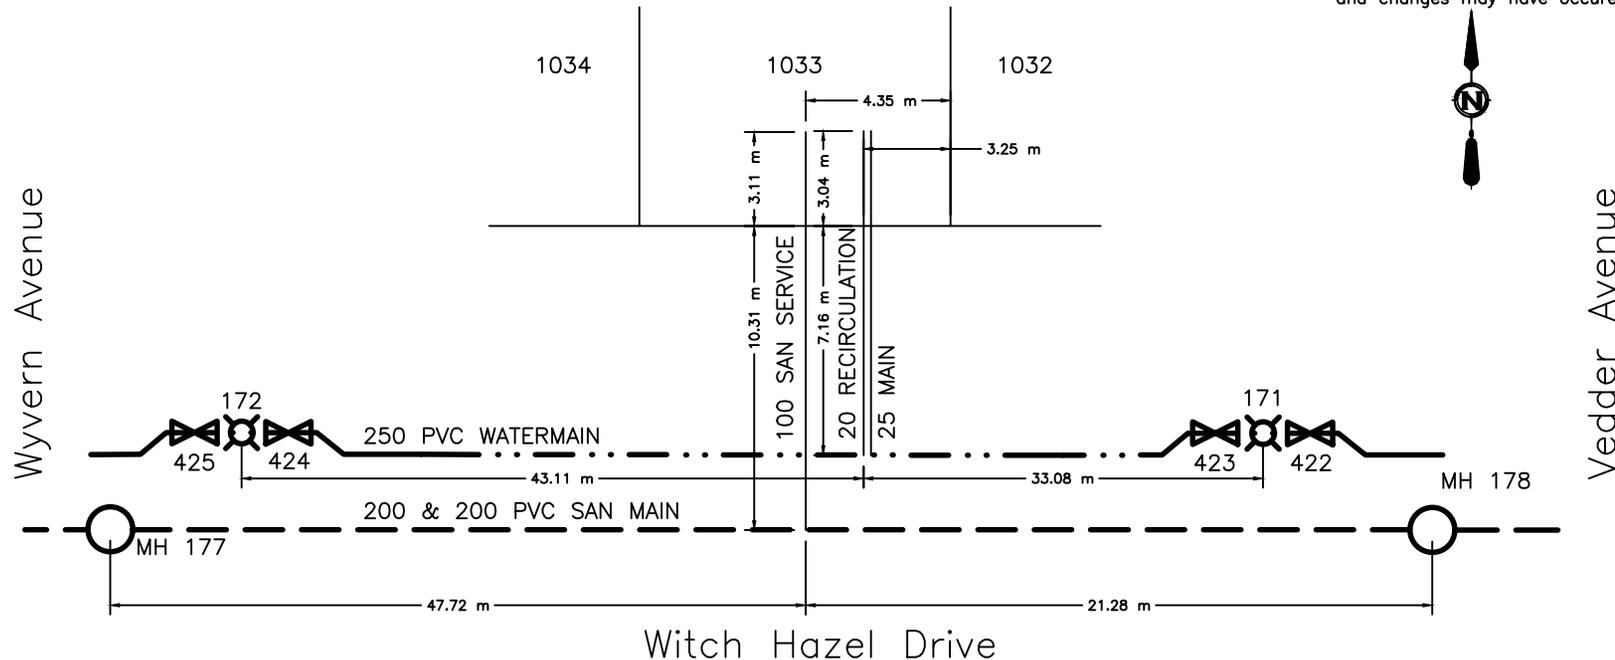



CITY OF WHITEHORSE SERVICE CONNECTION RECORD

FIELD BOOK


No.

ADDRESS 211 Witch Hazel Drive BLOCK LOT 1034

DATES	WATER	SEWER
On at Main 2020-JUL-31	Depth at P/L: 2.58 m	2.62 m
On at Building	Depth at Main: 3.05 m	3.20 m
Frost Plug:	Pipe Size: 25 mm / 20 mm	100 mm
Memo:	Pipe Material: HDPE Insul. <input checked="" type="checkbox"/> Yes / <input type="checkbox"/> No	PVC Insul. <input checked="" type="checkbox"/> Yes / <input type="checkbox"/> No
	Length from Main to P/L: 7.18 m	10.31 m
	Squirt Test: <input checked="" type="checkbox"/> Pass / <input type="checkbox"/> Fail	N/A
Booster Pump Required: <input type="checkbox"/> Yes / <input checked="" type="checkbox"/> No	Frost Protection: Aquaflo / <input checked="" type="checkbox"/> Recirc / Heat Trace / Bleeder	N/A
PRV Required: <input type="checkbox"/> Yes / <input checked="" type="checkbox"/> No	Greased @ CC: <input checked="" type="checkbox"/> Yes / <input type="checkbox"/> No	N/A
Water Meter Installed: <input type="checkbox"/> Yes / <input checked="" type="checkbox"/> No	Continuity Test: <input checked="" type="checkbox"/> N/A / <input type="checkbox"/> Pass / <input type="checkbox"/> Fail	N/A

CLEARLY INDICATE LOCATION OF CC AND ROUTE OF PIPES ON DRAWING BELOW

1. Show main valves required to isolate this service. 2. All dimensions to be tied to property line 3. All dimensions to be metric 4. Depth @ property line is based on elevation after construction and changes may have occurred.

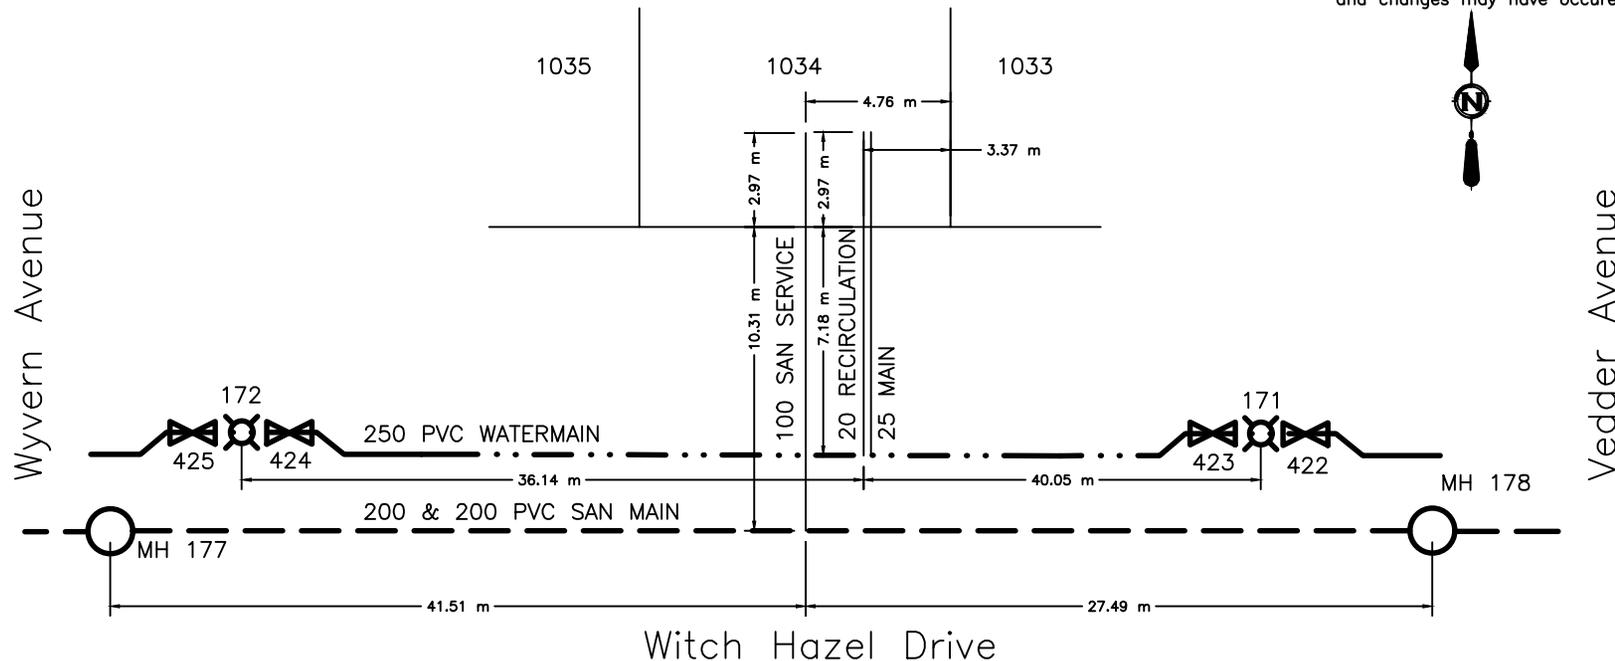



CITY OF WHITEHORSE SERVICE CONNECTION RECORD

FIELD BOOK


No.

ADDRESS 213 Witch Hazel Drive BLOCK LOT 1035

DATES		WATER		SEWER
On at Main	2020-JUL-25	Depth at P/L:	2.62 m	2.73 m
On at Building		Depth at Main:	3.05 m	3.21 m
Frost Plug:		Pipe Size:	25 mm / 20 mm	100 mm
Memo:		Pipe Material:	HDPE Insul. <input checked="" type="checkbox"/> Yes/ <input type="checkbox"/> No	PVC Insul. <input checked="" type="checkbox"/> Yes/ <input type="checkbox"/> No
		Length from Main to P/L:	7.14 m	10.31 m
		Squirt Test:	<input checked="" type="checkbox"/> Pass/ <input type="checkbox"/> Fail	N/A
Booster Pump Required:	<input type="checkbox"/> Yes/ <input type="checkbox"/> No	Frost Protection:	Aquaflow/ <input checked="" type="checkbox"/> Recirc/Heat Trace/Bleeder	N/A
PRV Required:	<input type="checkbox"/> Yes/ <input type="checkbox"/> No	Greased @ CC:	<input checked="" type="checkbox"/> Yes/ <input type="checkbox"/> No	N/A
Water Meter Installed:	<input type="checkbox"/> Yes/ <input type="checkbox"/> No	Continuity Test:	<input checked="" type="checkbox"/> N/A <input type="checkbox"/> Pass/ <input type="checkbox"/> Fail	N/A

CLEARLY INDICATE LOCATION OF CC AND ROUTE OF PIPES ON DRAWING BELOW

1. Show main valves required to isolate this service. 2. All dimensions to be tied to property line 3. All dimensions to be metric 4. Depth @ property line is based on elevation after construction and changes may have occurred.

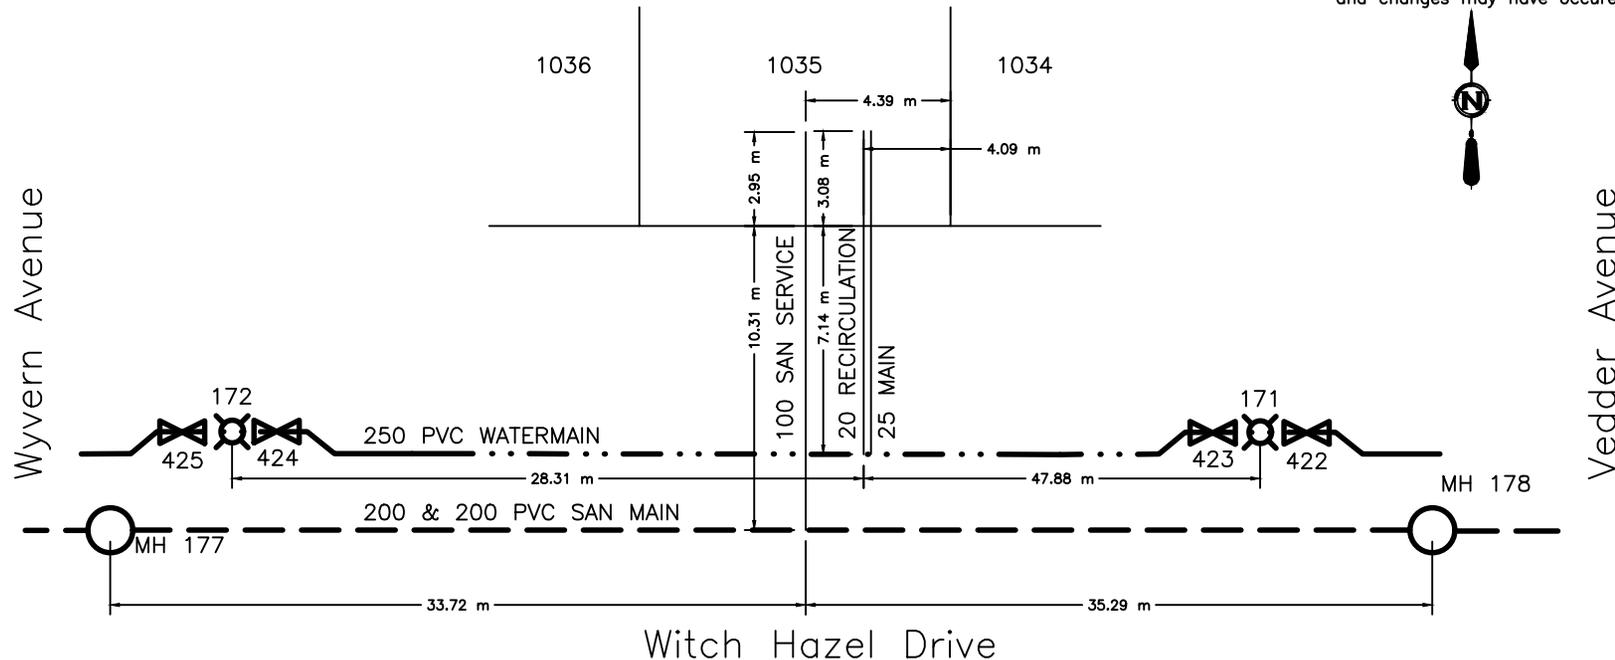



CITY OF WHITEHORSE SERVICE CONNECTION RECORD

FIELD BOOK


No.

ADDRESS 215 Witch Hazel Drive BLOCK LOT 1036

DATES	WATER	SEWER
On at Main 2020-JUL-30	Depth at P/L: 2.66 m	2.69 m
On at Building	Depth at Main: 3.04 m	3.22 m
Frost Plug:	Pipe Size: 25 mm / 20 mm	100 mm
Memo:	Pipe Material: HDPE Insul. <input checked="" type="checkbox"/> Yes / <input type="checkbox"/> No	PVC Insul. <input checked="" type="checkbox"/> Yes / <input type="checkbox"/> No
	Length from Main to P/L: 10.32 m	7.15 m
	Squirt Test: <input checked="" type="checkbox"/> Pass / <input type="checkbox"/> Fail	N/A
Booster Pump Required: <input type="checkbox"/> Yes / <input checked="" type="checkbox"/> No	Frost Protection: Aquaflo / <input checked="" type="checkbox"/> Recirc / Heat Trace / Bleeder	N/A
PRV Required: <input type="checkbox"/> Yes / <input checked="" type="checkbox"/> No	Greased @ CC: <input checked="" type="checkbox"/> Yes / <input type="checkbox"/> No	N/A
Water Meter Installed: <input type="checkbox"/> Yes / <input checked="" type="checkbox"/> No	Continuity Test: <input checked="" type="checkbox"/> N/A / <input type="checkbox"/> Pass / <input type="checkbox"/> Fail	N/A

CLEARLY INDICATE LOCATION OF CC AND ROUTE OF PIPES ON DRAWING BELOW

1. Show main valves required to isolate this service. 2. All dimensions to be tied to property line 3. All dimensions to be metric 4. Depth @ property line is based on elevation after construction and changes may have occurred.

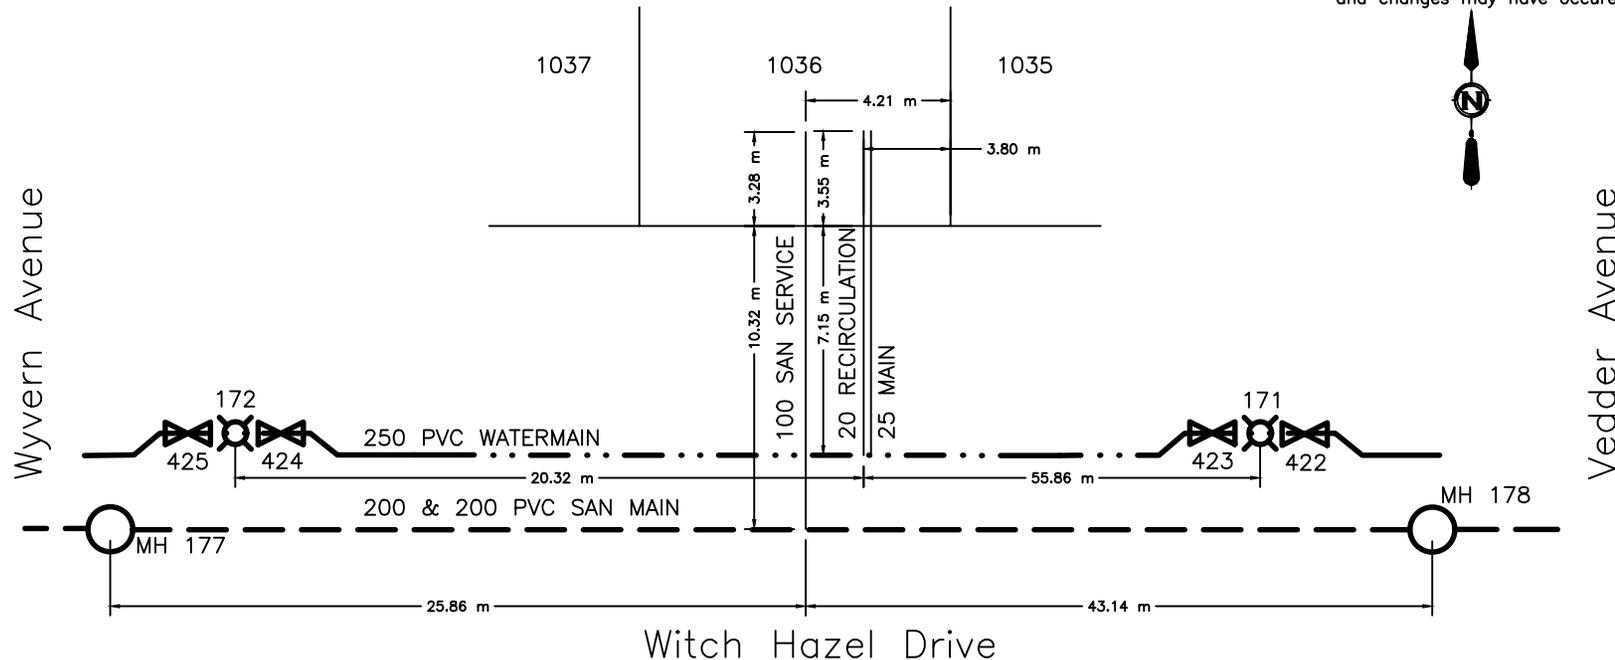



CITY OF WHITEHORSE SERVICE CONNECTION RECORD

FIELD BOOK


No.

ADDRESS 217 Witch Hazel Drive BLOCK LOT 1037

DATES		WATER		SEWER
On at Main 2020-JUL-31		Depth at P/L: 2.62 m	2.67 m	
On at Building		Depth at Main: 3.11 m	3.22 m	
Frost Plug:		Pipe Size: 25 mm / 20 mm	100 mm	
Memo:		Pipe Material: HDPE	Insul. <input checked="" type="checkbox"/> Yes / <input type="checkbox"/> No	PVC
		Length from Main to P/L: 7.16 m		10.32 m
		Squirt Test: <input checked="" type="checkbox"/> Pass / <input type="checkbox"/> Fail		N/A
Booster Pump Required:	<input type="checkbox"/> Yes / <input type="checkbox"/> No	Frost Protection: Aquaflo / <input checked="" type="checkbox"/> Recirc / Heat Trace / Bleeder	N/A	
PRV Required:	<input type="checkbox"/> Yes / <input type="checkbox"/> No	Greased @ CC: <input checked="" type="checkbox"/> Yes / <input type="checkbox"/> No	N/A	
Water Meter Installed:	<input type="checkbox"/> Yes / <input type="checkbox"/> No	Continuity Test: <input type="checkbox"/> N/A	Pass / Fail	N/A

CLEARLY INDICATE LOCATION OF CC AND ROUTE OF PIPES ON DRAWING BELOW

1. Show main valves required to isolate this service. 2. All dimensions to be tied to property line 3. All dimensions to be metric 4. Depth @ property line is based on elevation after construction and changes may have occurred.

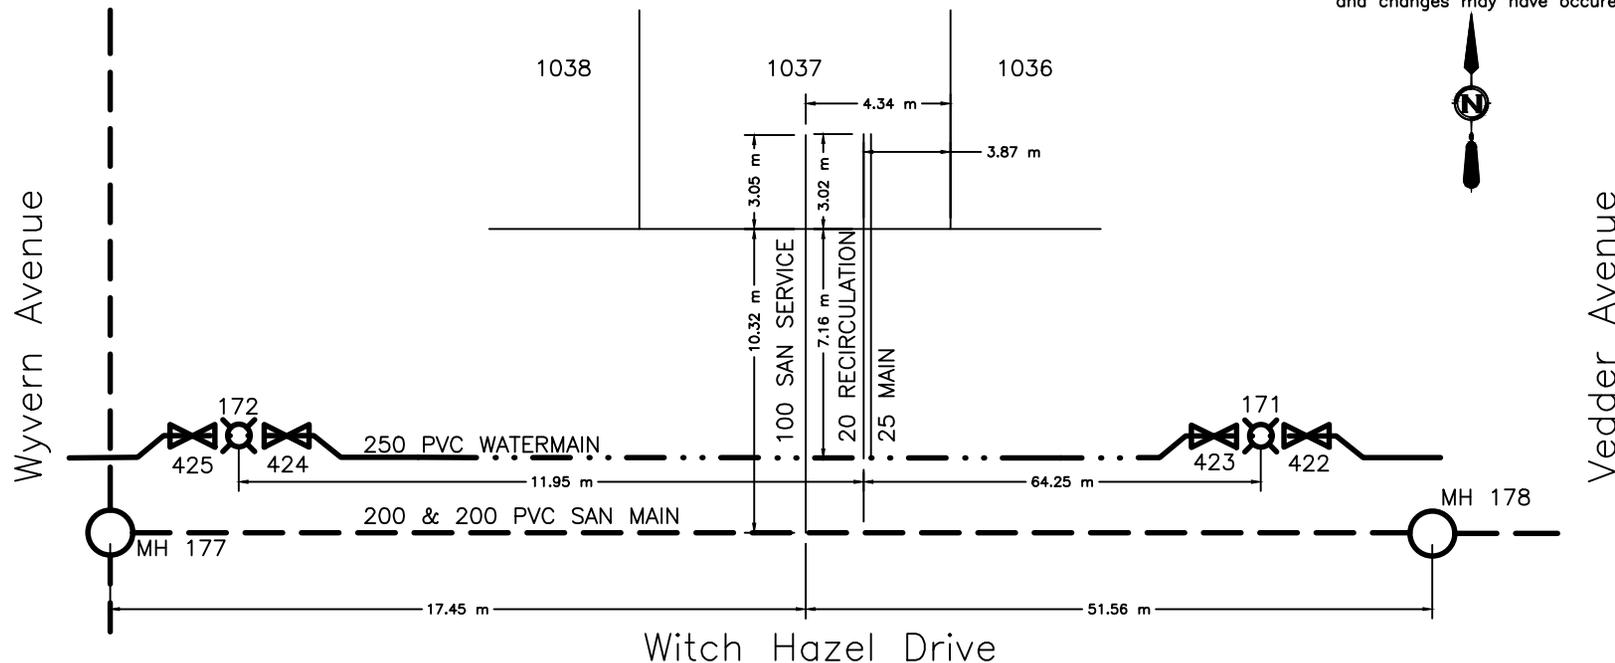



CITY OF WHITEHORSE SERVICE CONNECTION RECORD

FIELD BOOK


No.

ADDRESS 219 Witch Hazel Drive BLOCK LOT 1038

DATES		WATER		SEWER
On at Main	2020-JUL-27	Depth at P/L:	2.68 m	2.72 m
On at Building		Depth at Main:	3.05 m	3.24 m
Frost Plug:		Pipe Size:	25 mm / 20 mm	100 mm
Memo:		Pipe Material:	HDPE	PVC
		Insul.:	(Yes)/No	Insul. Yes/(No)
		Length from Main to P/L:	7.20 m	10.21 m
		Squirt Test:	(Pass)/Fail	N/A
Booster Pump Required:	Yes/No	Frost Protection:	Aquaflow/(Recirc)/Heat Trace/Bleeder	N/A
PRV Required:	Yes/No	Greased @ CC:	(Yes)/No	N/A
Water Meter Installed:	Yes/No	Continuity Test:	(N/A) Pass/Fail	N/A

CLEARLY INDICATE LOCATION OF CC AND ROUTE OF PIPES ON DRAWING BELOW

1. Show main valves required to isolate this service. 2. All dimensions to be tied to property line 3. All dimensions to be metric 4. Depth @ property line is based on elevation after construction and changes may have occurred.

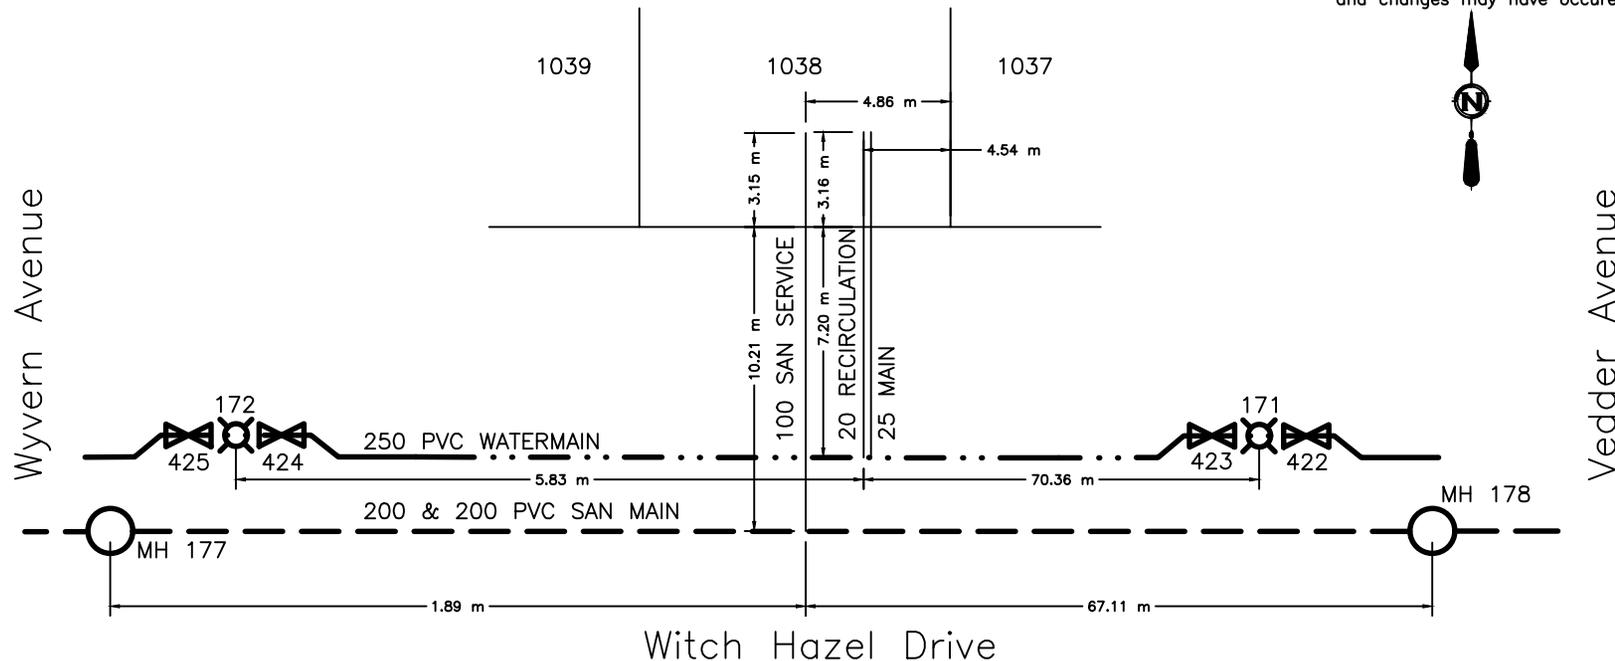



CITY OF WHITEHORSE SERVICE CONNECTION RECORD

FIELD BOOK


No.

ADDRESS 221 Witch Hazel Drive BLOCK LOT 1039

DATES		WATER		SEWER
On at Main 2020-JUL-30		Depth at P/L: 2.68 m	2.72 m	
On at Building		Depth at Main: 3.05 m	3.24 m	
Frost Plug:		Pipe Size: 25 mm / 20 mm	100 mm	
Memo:		Pipe Material: HDPE	Insul. <input checked="" type="checkbox"/> Yes / <input type="checkbox"/> No	PVC
		Length from Main to P/L: 7.20 m		10.21 m
		Squirt Test: <input checked="" type="checkbox"/> Pass / <input type="checkbox"/> Fail		N/A
Booster Pump Required:	<input type="checkbox"/> Yes / <input type="checkbox"/> No	Frost Protection: Aquaflo / <input checked="" type="checkbox"/> Recirc / Heat Trace / Bleeder	N/A	
PRV Required:	<input type="checkbox"/> Yes / <input type="checkbox"/> No	Greased @ CC: <input checked="" type="checkbox"/> Yes / <input type="checkbox"/> No	N/A	
Water Meter Installed:	<input type="checkbox"/> Yes / <input type="checkbox"/> No	Continuity Test: <input type="checkbox"/> N/A	Pass / Fail	N/A

CLEARLY INDICATE LOCATION OF CC AND ROUTE OF PIPES ON DRAWING BELOW

1. Show main valves required to isolate this service. 2. All dimensions to be tied to property line 3. All dimensions to be metric 4. Depth @ property line is based on elevation after construction and changes may have occurred.

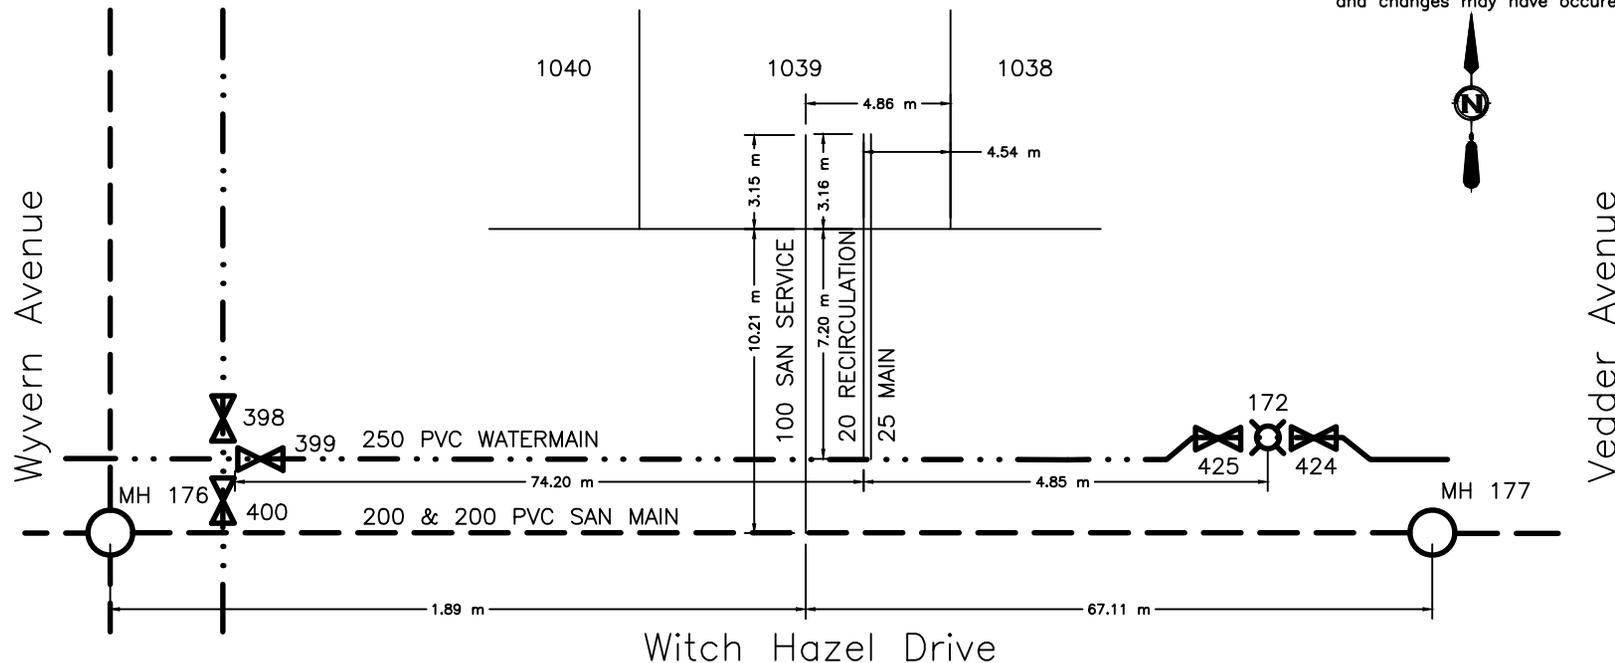



CITY OF WHITEHORSE SERVICE CONNECTION RECORD

FIELD BOOK


No.

ADDRESS 223 Witch Hazel Drive BLOCK LOT 1040

DATES		WATER		SEWER
On at Main	2020-AUG-03	Depth at P/L:	2.35 m	2.32 m
On at Building		Depth at Main:	3.07 m	2.81 m
Frost Plug:		Pipe Size:	25 mm / 20 mm	100 mm
Memo:		Pipe Material:	HDPE Insul. <input checked="" type="checkbox"/> /No	PVC Insul. <input checked="" type="checkbox"/> /No
		Length from Main to P/L:	7.12 m	10.32 m
		Squirt Test:	<input checked="" type="checkbox"/> Pass/Fail	N/A
Booster Pump Required:	Yes/No	Frost Protection:	Aquaflow/ <input checked="" type="checkbox"/> Recirc/Heat Trace/Bleeder	N/A
PRV Required:	Yes/No	Greased @ CC:	<input checked="" type="checkbox"/> Yes/No	N/A
Water Meter Installed:	Yes/No	Continuity Test:	<input checked="" type="checkbox"/> N/A Pass/Fail	N/A

CLEARLY INDICATE LOCATION OF CC AND ROUTE OF PIPES ON DRAWING BELOW

1. Show main valves required to isolate this service. 2. All dimensions to be tied to property line 3. All dimensions to be metric 4. Depth @ property line is based on elevation after construction and changes may have occurred.

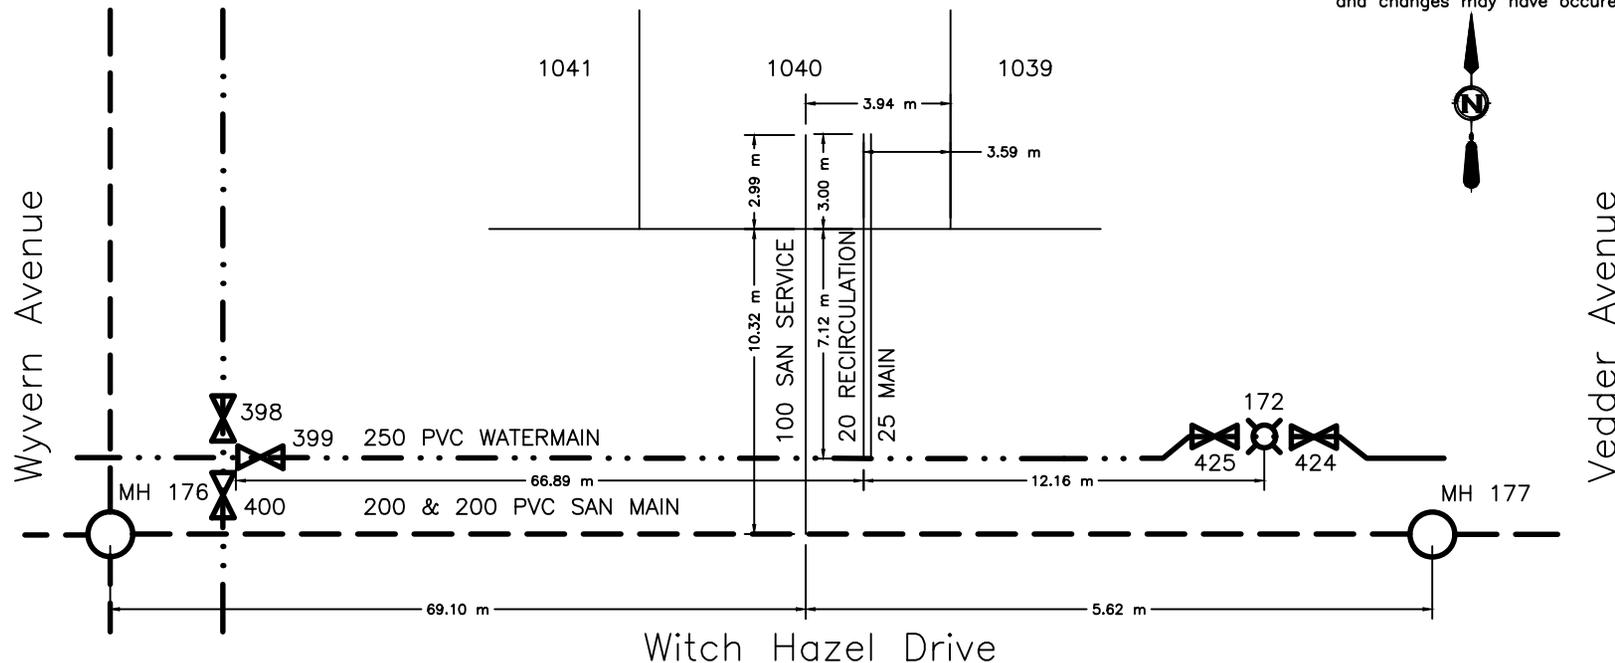



CITY OF WHITEHORSE SERVICE CONNECTION RECORD

FIELD BOOK


No.

ADDRESS 225 Witch Hazel Drive BLOCK LOT 1041

DATES		WATER		SEWER
On at Main 2020-JUL-28		Depth at P/L: 2.42 m	2.48 m	
On at Building		Depth at Main: 2.65 m	2.81 m	
Frost Plug:		Pipe Size: 25 mm / 20 mm	100 mm	
Memo:		Pipe Material: HDPE	Insul. <input checked="" type="checkbox"/> Yes / <input type="checkbox"/> No	PVC
		Length from Main to P/L: 6.51 m		10.33 m
		Squirt Test: <input checked="" type="checkbox"/> Pass / <input type="checkbox"/> Fail		N/A
Booster Pump Required:	<input type="checkbox"/> Yes / <input type="checkbox"/> No	Frost Protection: <input checked="" type="checkbox"/> Aquaflow / <input checked="" type="checkbox"/> Recirc / <input type="checkbox"/> Heat Trace / <input type="checkbox"/> Bleeder	N/A	
PRV Required:	<input type="checkbox"/> Yes / <input type="checkbox"/> No	Greased @ CC: <input checked="" type="checkbox"/> Yes / <input type="checkbox"/> No	N/A	
Water Meter Installed:	<input type="checkbox"/> Yes / <input type="checkbox"/> No	Continuity Test: <input checked="" type="checkbox"/> N/A	Pass / Fail	N/A

CLEARLY INDICATE LOCATION OF CC AND ROUTE OF PIPES ON DRAWING BELOW

1. Show main valves required to isolate this service. 2. All dimensions to be tied to property line 3. All dimensions to be metric 4. Depth @ property line is based on elevation after construction and changes may have occurred.

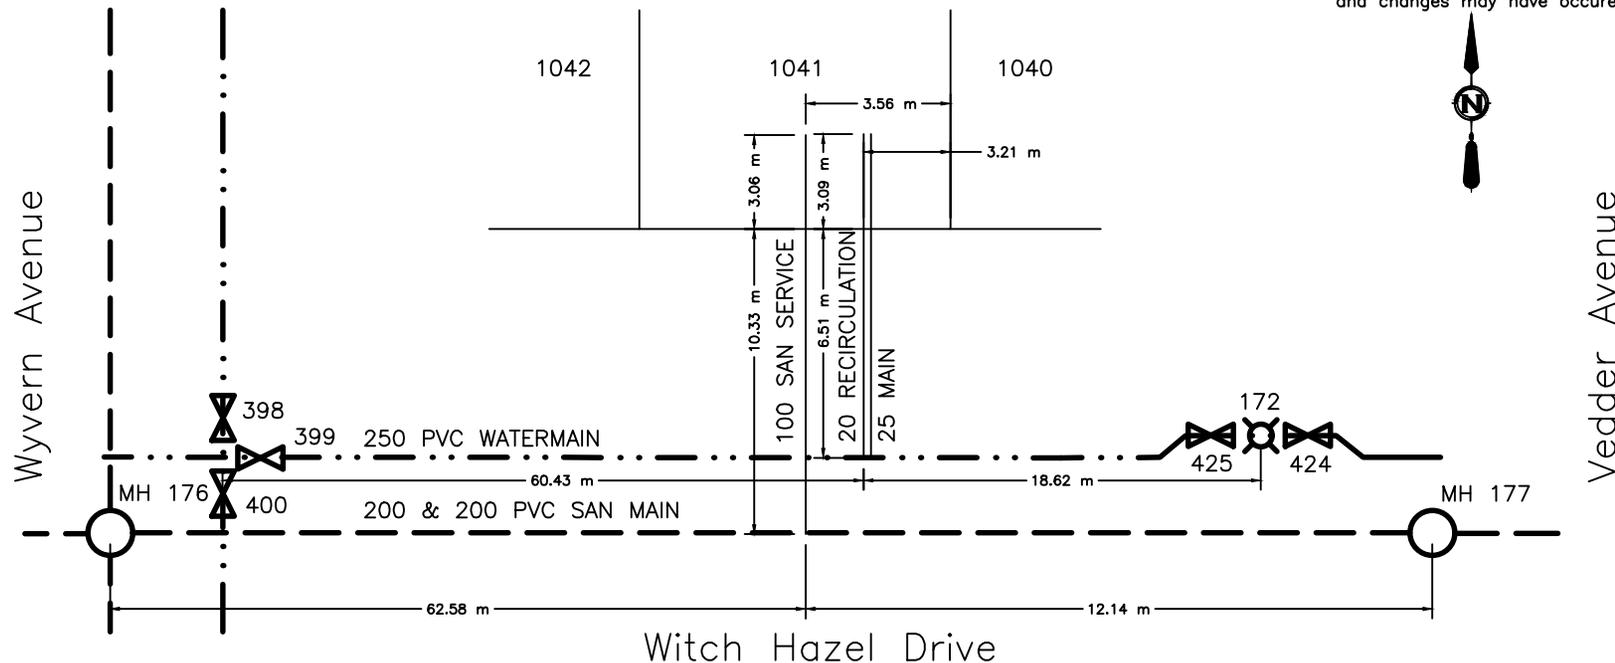



CITY OF WHITEHORSE SERVICE CONNECTION RECORD

FIELD BOOK


No.

ADDRESS 227 Witch Hazel Drive BLOCK LOT 1042

DATES		WATER		SEWER
On at Main 2020-AUG-01		Depth at P/L: 2.27 m	2.38 m	
On at Building		Depth at Main: 3.06 m	2.82 m	
Frost Plug:		Pipe Size: 25 mm / 20 mm	100 mm	
Memo:		Pipe Material: HDPE	Insul. <input checked="" type="checkbox"/> Yes / <input type="checkbox"/> No	PVC
		Length from Main to P/L: 7.11 m		10.33 m
		Squirt Test: <input checked="" type="checkbox"/> Pass / <input type="checkbox"/> Fail		N/A
Booster Pump Required:	<input type="checkbox"/> Yes / <input type="checkbox"/> No	Frost Protection: Aquaflo / <input checked="" type="checkbox"/> Recirc / Heat Trace / Bleeder		N/A
PRV Required:	<input type="checkbox"/> Yes / <input type="checkbox"/> No	Greased @ CC: <input checked="" type="checkbox"/> Yes / <input type="checkbox"/> No		N/A
Water Meter Installed:	<input type="checkbox"/> Yes / <input type="checkbox"/> No	Continuity Test: <input type="checkbox"/> N/A / <input type="checkbox"/> Pass / <input type="checkbox"/> Fail		N/A

CLEARLY INDICATE LOCATION OF CC AND ROUTE OF PIPES ON DRAWING BELOW

1. Show main valves required to isolate this service. 2. All dimensions to be tied to property line 3. All dimensions to be metric 4. Depth @ property line is based on elevation after construction and changes may have occurred.

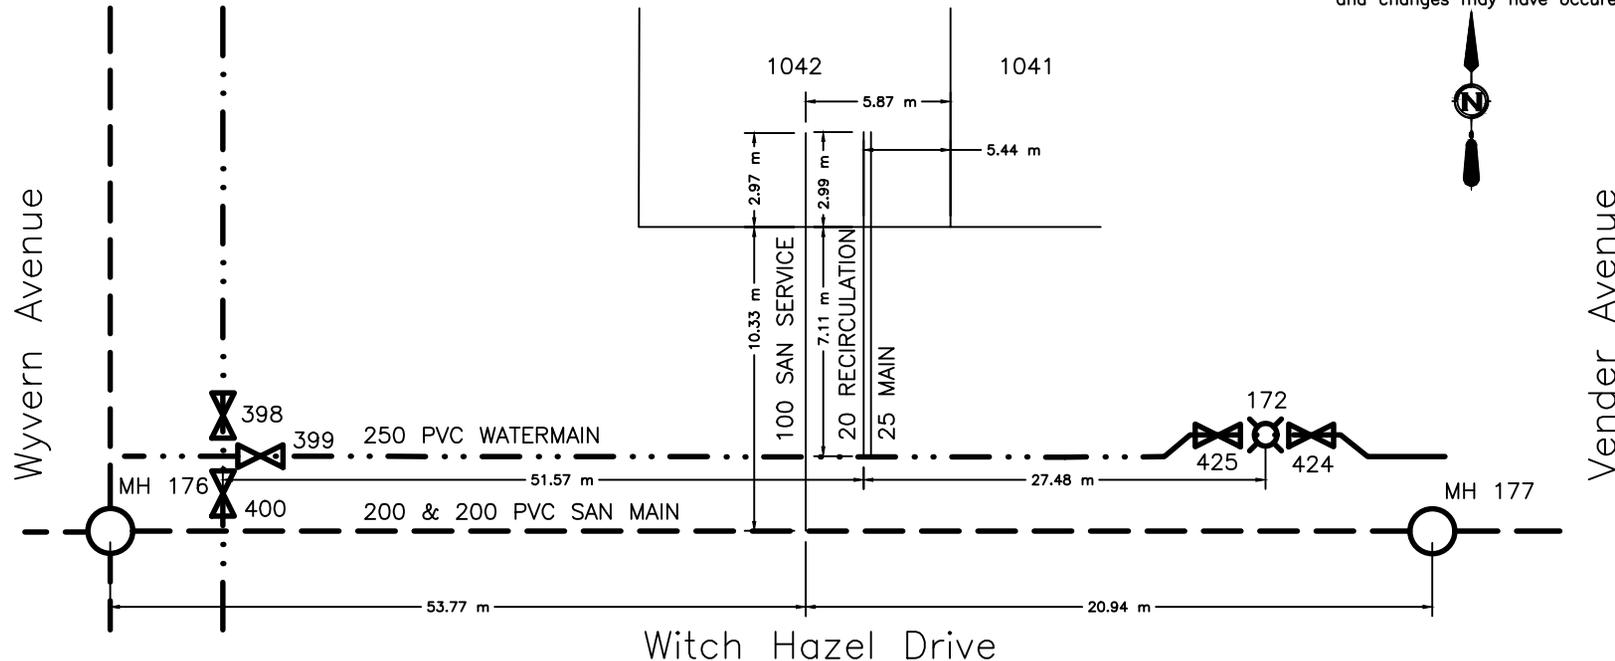



CITY OF WHITEHORSE SERVICE CONNECTION RECORD

FIELD BOOK


No.

ADDRESS 58 Wyvern Avenue BLOCK LOT 1043

DATES	WATER	SEWER
On at Main 2020-AUG-13	Depth at P/L: 2.96 m	2.90 m
On at Building	Depth at Main: 3.14 m	3.44 m
Frost Plug:	Pipe Size: 50 mm / 20 mm	150 mm
Memo:	Pipe Material: HDPE Insul. <input checked="" type="checkbox"/> Yes / <input type="checkbox"/> No	PVC Insul. <input checked="" type="checkbox"/> Yes / <input type="checkbox"/> No
	Length from Main to P/L: 13.47 m	10.39 m
	Squirt Test: <input checked="" type="checkbox"/> Pass / <input type="checkbox"/> Fail	N/A
Booster Pump Required: <input type="checkbox"/> Yes / <input checked="" type="checkbox"/> No	Frost Protection: Aquaflo / <input checked="" type="checkbox"/> Recirc / Heat Trace / Bleeder	N/A
PRV Required: <input type="checkbox"/> Yes / <input checked="" type="checkbox"/> No	Greased @ CC: <input checked="" type="checkbox"/> Yes / <input type="checkbox"/> No	N/A
Water Meter Installed: <input type="checkbox"/> Yes / <input checked="" type="checkbox"/> No	Continuity Test: <input checked="" type="checkbox"/> N/A / <input type="checkbox"/> Pass / <input type="checkbox"/> Fail	N/A

CLEARLY INDICATE LOCATION OF CC AND ROUTE OF PIPES ON DRAWING BELOW

1. Show main valves required to isolate this service. 2. All dimensions to be tied to property line 3. All dimensions to be metric 4. Depth @ property line is based on elevation after construction and changes may have occurred.

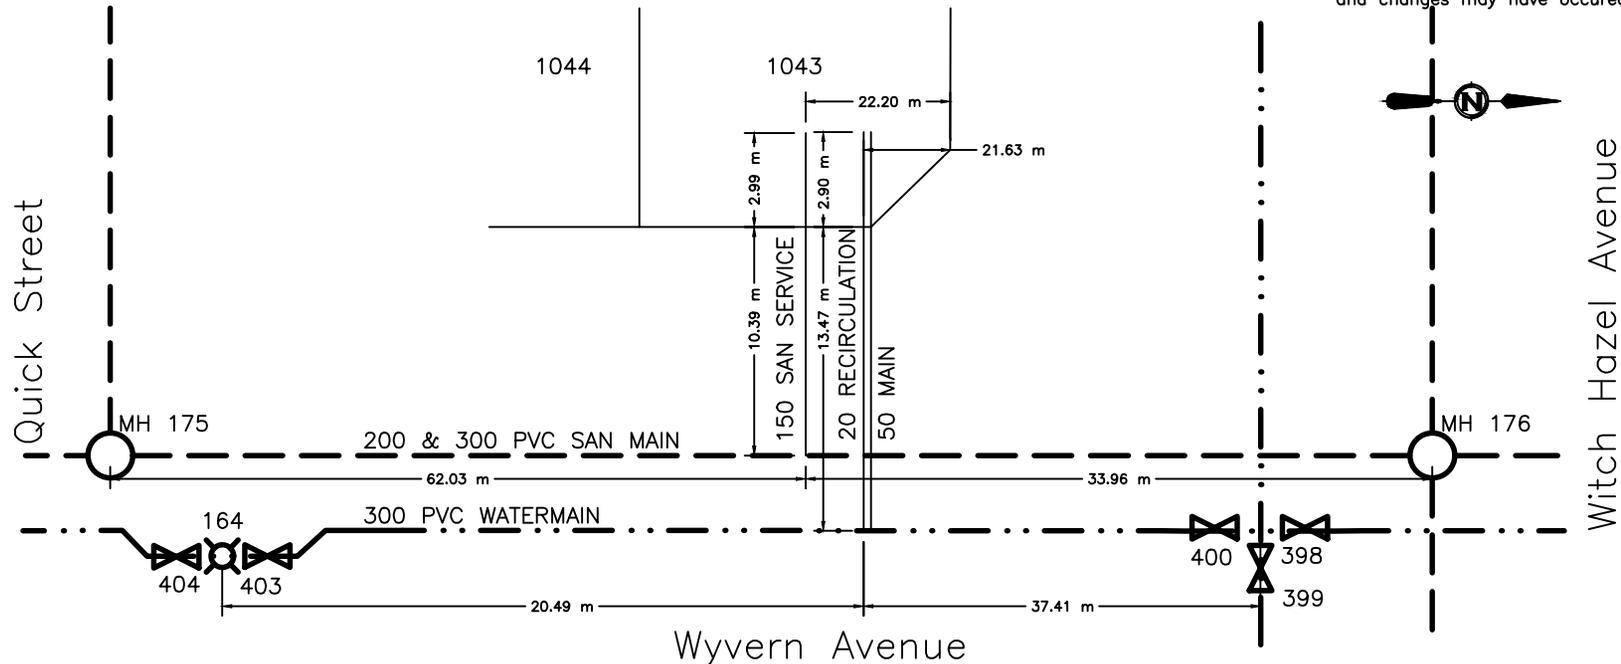



CITY OF WHITEHORSE SERVICE CONNECTION RECORD

FIELD BOOK


No.

ADDRESS 48 Wyvern Avenue BLOCK LOT 1044

DATES		WATER		SEWER
On at Main 2020-AUG-13		Depth at P/L: 2.43 m	2.41 m	
On at Building		Depth at Main: 3.05 m	3.73 m	
Frost Plug:		Pipe Size: 50 mm / 20 mm	150 mm	
Memo:		Pipe Material: HDPE	Insul. <input checked="" type="checkbox"/> Yes / <input type="checkbox"/> No	PVC
		Length from Main to P/L: 15.01 m		10.36 m
		Squirt Test: <input checked="" type="checkbox"/> Pass / <input type="checkbox"/> Fail		N/A
Booster Pump Required:	<input type="checkbox"/> Yes / <input type="checkbox"/> No	Frost Protection: Aquaflo / <input checked="" type="checkbox"/> Recirc / Heat Trace / Bleeder	N/A	
PRV Required:	<input type="checkbox"/> Yes / <input type="checkbox"/> No	Greased @ CC: <input checked="" type="checkbox"/> Yes / <input type="checkbox"/> No	N/A	
Water Meter Installed:	<input type="checkbox"/> Yes / <input type="checkbox"/> No	Continuity Test: <input type="checkbox"/> N/A / <input type="checkbox"/> Pass / <input type="checkbox"/> Fail	N/A	

CLEARLY INDICATE LOCATION OF CC AND ROUTE OF PIPES ON DRAWING BELOW

1. Show main valves required to isolate this service. 2. All dimensions to be tied to property line 3. All dimensions to be metric 4. Depth @ property line is based on elevation after construction and changes may have occurred.

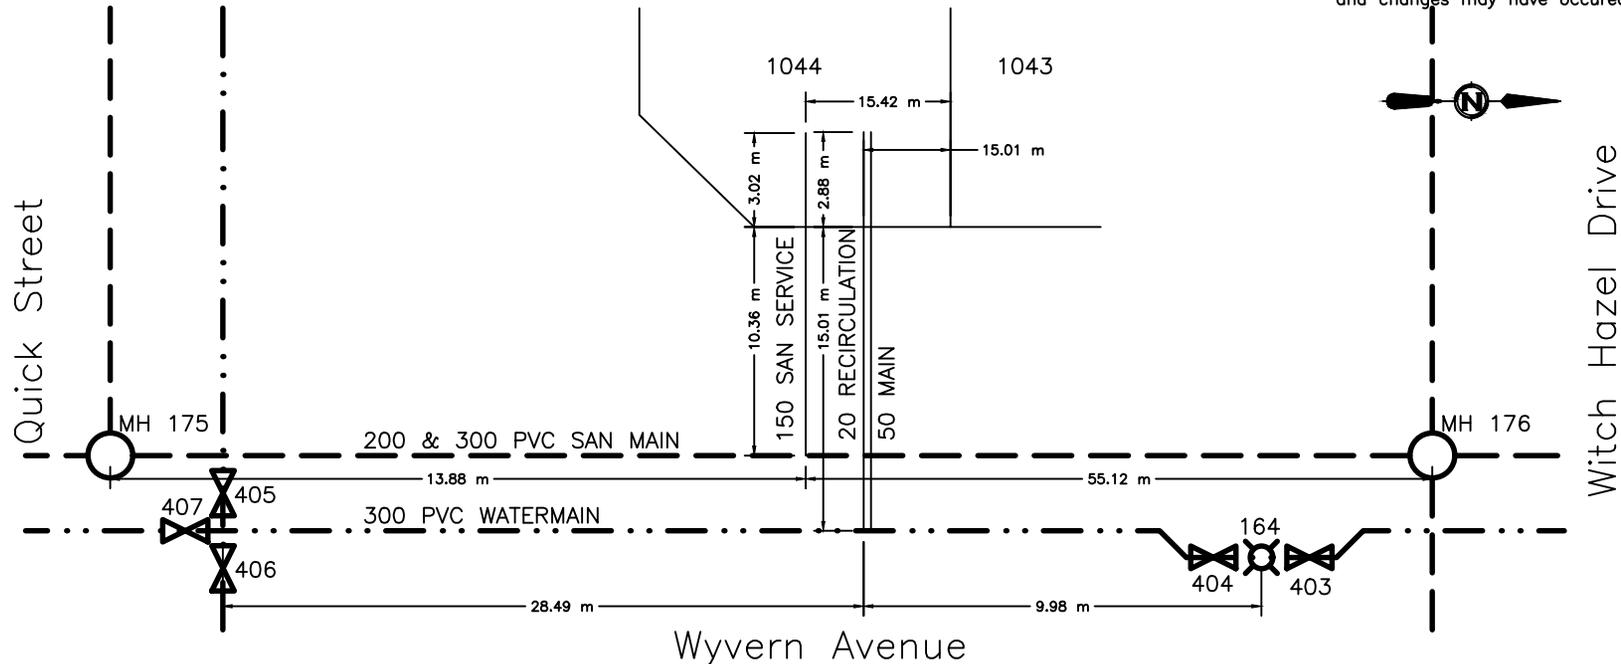



CITY OF WHITEHORSE SERVICE CONNECTION RECORD

FIELD BOOK


No.

ADDRESS 38 Wyvern Avenue BLOCK LOT 1045

DATES		WATER		SEWER		
On at Main	2020-AUG-10	Depth at P/L:	2.63 m		2.69 m	
On at Building		Depth at Main:	3.46 m		3.26 m	
Frost Plug:		Pipe Size:	25 mm / 20 mm		100 mm	
Memo:		Pipe Material:	HDPE	Insul. <input checked="" type="checkbox"/> Yes / <input type="checkbox"/> No	PVC	Insul. <input checked="" type="checkbox"/> Yes / <input type="checkbox"/> No
		Length from Main to P/L:	2.87 m		10.30 m	
		Squirt Test:	<input checked="" type="checkbox"/> Pass / <input type="checkbox"/> Fail		N/A	
Booster Pump Required:	<input type="checkbox"/> Yes / <input type="checkbox"/> No	Frost Protection:	Aquaflow / <input checked="" type="checkbox"/> Recirc / Heat Trace / Bleeder		N/A	
PRV Required:	<input type="checkbox"/> Yes / <input type="checkbox"/> No	Greased @ CC:	<input checked="" type="checkbox"/> Yes / <input type="checkbox"/> No		N/A	
Water Meter Installed:	<input type="checkbox"/> Yes / <input type="checkbox"/> No	Continuity Test:	<input checked="" type="checkbox"/> N/A / <input type="checkbox"/> Pass / <input type="checkbox"/> Fail		N/A	

CLEARLY INDICATE LOCATION OF CC AND ROUTE OF PIPES ON DRAWING BELOW

1. Show main valves required to isolate this service. 2. All dimensions to be tied to property line 3. All dimensions to be metric 4. Depth @ property line is based on elevation after construction and changes may have occurred.

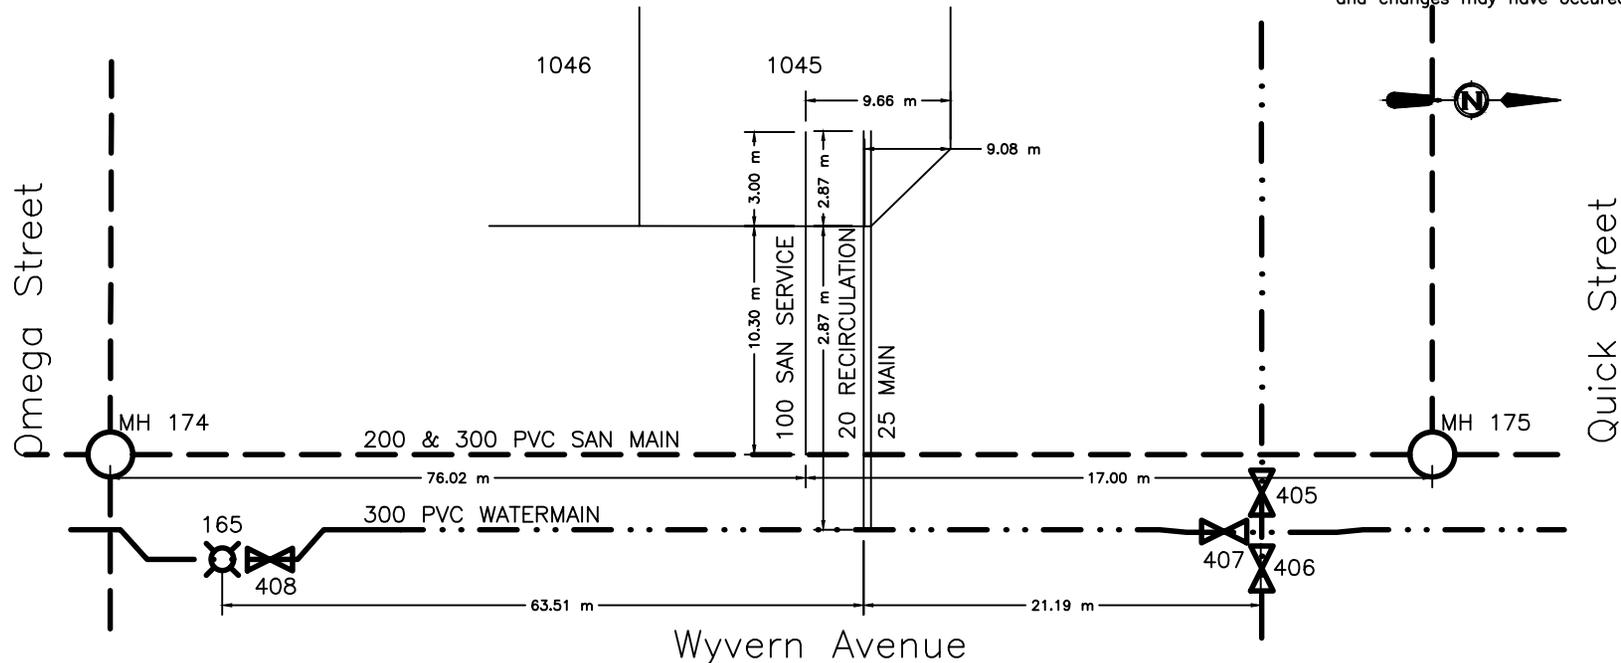



CITY OF WHITEHORSE SERVICE CONNECTION RECORD

FIELD BOOK


No.

ADDRESS 36 Wyvern Avenue BLOCK LOT 1046

DATES	WATER	SEWER
On at Main 2020-AUG-13	Depth at P/L: 2.81 m	2.83 m
On at Building	Depth at Main: 3.38 m	3.29 m
Frost Plug:	Pipe Size: 25 mm / 20 mm	100 mm
Memo:	Pipe Material: HDPE Insul. <input checked="" type="checkbox"/> Yes / <input type="checkbox"/> No	PVC Insul. <input checked="" type="checkbox"/> Yes / <input type="checkbox"/> No
	Length from Main to P/L: 13.32 m	10.25 m
	Squirt Test: <input checked="" type="checkbox"/> Pass / <input type="checkbox"/> Fail	N/A
Booster Pump Required: <input type="checkbox"/> Yes / <input checked="" type="checkbox"/> No	Frost Protection: Aquaflo / <input checked="" type="checkbox"/> Recirc / Heat Trace / Bleeder	N/A
PRV Required: <input type="checkbox"/> Yes / <input checked="" type="checkbox"/> No	Greased @ CC: <input checked="" type="checkbox"/> Yes / <input type="checkbox"/> No	N/A
Water Meter Installed: <input type="checkbox"/> Yes / <input checked="" type="checkbox"/> No	Continuity Test: <input checked="" type="checkbox"/> N/A / <input type="checkbox"/> Pass / <input type="checkbox"/> Fail	N/A

CLEARLY INDICATE LOCATION OF CC AND ROUTE OF PIPES ON DRAWING BELOW

1. Show main valves required to isolate this service. 2. All dimensions to be tied to property line 3. All dimensions to be metric 4. Depth @ property line is based on elevation after construction and changes may have occurred.

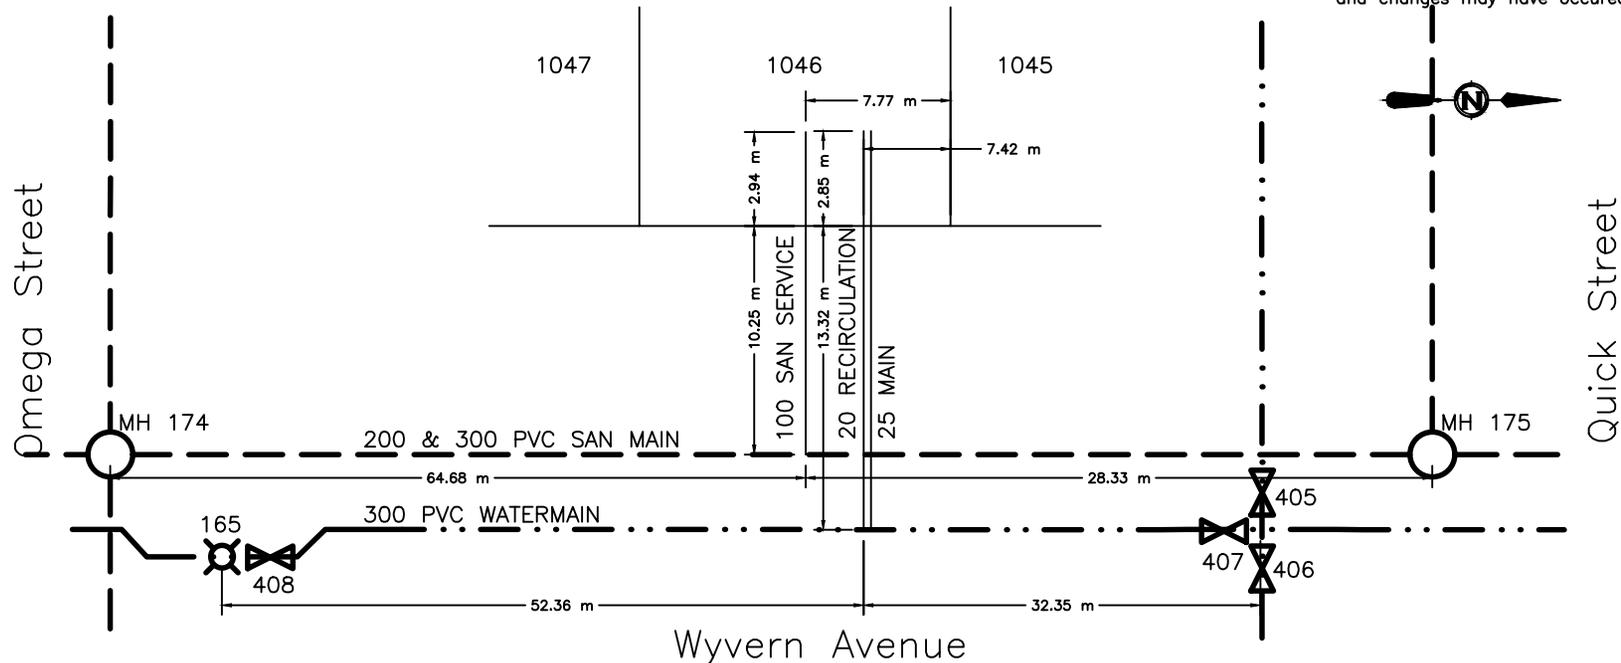



CITY OF WHITEHORSE SERVICE CONNECTION RECORD

FIELD BOOK


No.

ADDRESS 34 Wyvern Avenue BLOCK LOT 1047

DATES	WATER	SEWER
On at Main 2020-AUG-06	Depth at P/L: 3.00 m	3.03 m
On at Building	Depth at Main: 3.26 m	3.38 m
Frost Plug:	Pipe Size: 25 mm / 20 mm	100 mm
Memo:	Pipe Material: HDPE Insul. <input checked="" type="checkbox"/> Yes / <input type="checkbox"/> No	PVC Insul. <input checked="" type="checkbox"/> Yes / <input type="checkbox"/> No
	Length from Main to P/L: 13.33 m	10.29 m
	Squirt Test: <input checked="" type="checkbox"/> Pass / <input type="checkbox"/> Fail	N/A
Booster Pump Required: <input type="checkbox"/> Yes / <input checked="" type="checkbox"/> No	Frost Protection: Aquaflo / <input checked="" type="checkbox"/> Recirc / Heat Trace / Bleeder	N/A
PRV Required: <input type="checkbox"/> Yes / <input checked="" type="checkbox"/> No	Greased @ CC: <input checked="" type="checkbox"/> Yes / <input type="checkbox"/> No	N/A
Water Meter Installed: <input type="checkbox"/> Yes / <input checked="" type="checkbox"/> No	Continuity Test: <input checked="" type="checkbox"/> N/A / <input type="checkbox"/> Pass / <input type="checkbox"/> Fail	N/A

CLEARLY INDICATE LOCATION OF CC AND ROUTE OF PIPES ON DRAWING BELOW

1. Show main valves required to isolate this service. 2. All dimensions to be tied to property line 3. All dimensions to be metric 4. Depth @ property line is based on elevation after construction and changes may have occurred.

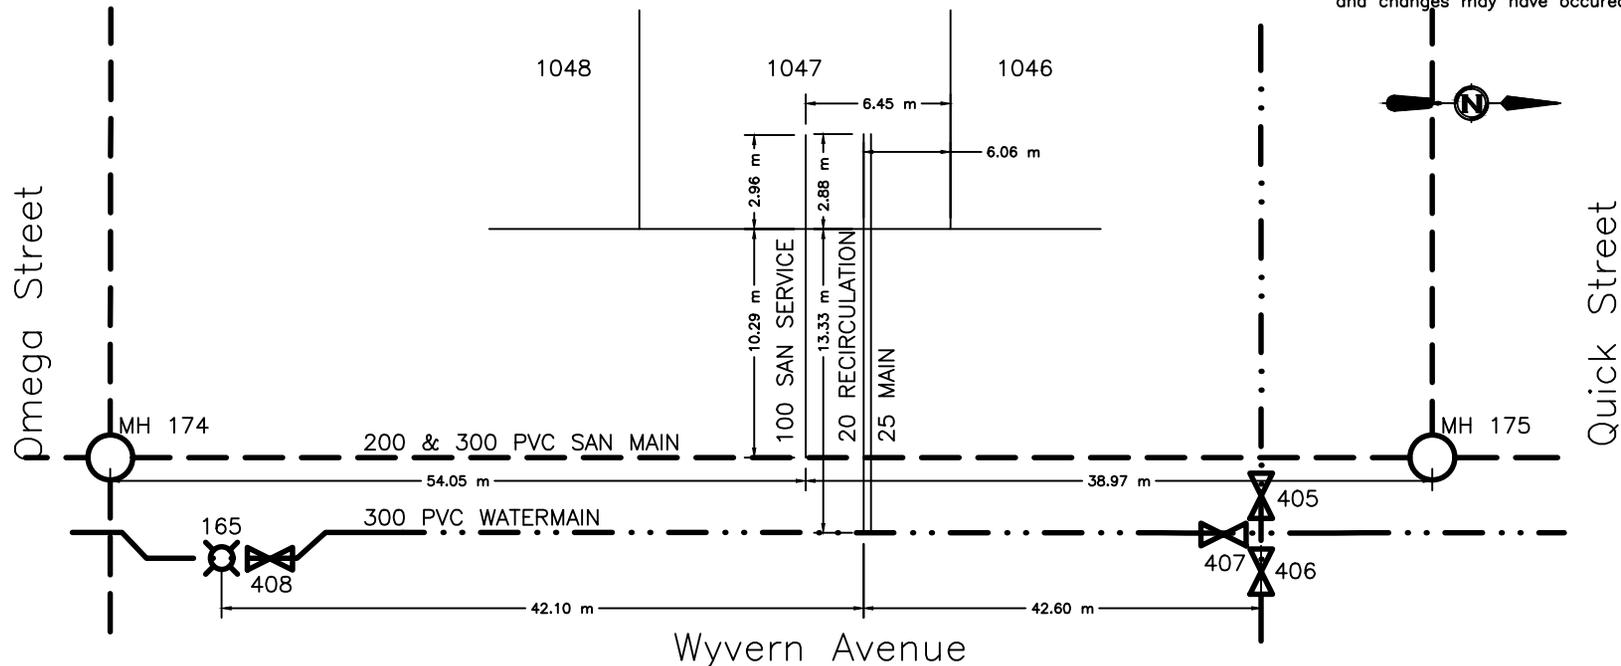



CITY OF WHITEHORSE SERVICE CONNECTION RECORD

FIELD BOOK


No.

ADDRESS 32 Wyvern Avenue BLOCK LOT 1048

DATES	WATER	SEWER
On at Main 2020-AUG-10	Depth at P/L: 2.77 m	2.81 m
On at Building	Depth at Main: 3.34 m	3.35 m
Frost Plug:	Pipe Size: 25 mm / 20 mm	100 mm
Memo:	Pipe Material: HDPE Insul. <input checked="" type="checkbox"/> Yes / <input type="checkbox"/> No	PVC Insul. <input checked="" type="checkbox"/> Yes / <input type="checkbox"/> No
	Length from Main to P/L: 13.33 m	10.24 m
	Squirt Test: <input checked="" type="checkbox"/> Pass / <input type="checkbox"/> Fail	N/A
Booster Pump Required: <input type="checkbox"/> Yes / <input checked="" type="checkbox"/> No	Frost Protection: Aquaflo / <input checked="" type="checkbox"/> Recirc / Heat Trace / Bleeder	N/A
PRV Required: <input type="checkbox"/> Yes / <input checked="" type="checkbox"/> No	Greased @ CC: <input checked="" type="checkbox"/> Yes / <input type="checkbox"/> No	N/A
Water Meter Installed: <input type="checkbox"/> Yes / <input checked="" type="checkbox"/> No	Continuity Test: <input checked="" type="checkbox"/> N/A / <input type="checkbox"/> Pass / <input type="checkbox"/> Fail	N/A

CLEARLY INDICATE LOCATION OF CC AND ROUTE OF PIPES ON DRAWING BELOW

1. Show main valves required to isolate this service. 2. All dimensions to be tied to property line 3. All dimensions to be metric 4. Depth @ property line is based on elevation after construction and changes may have occurred.

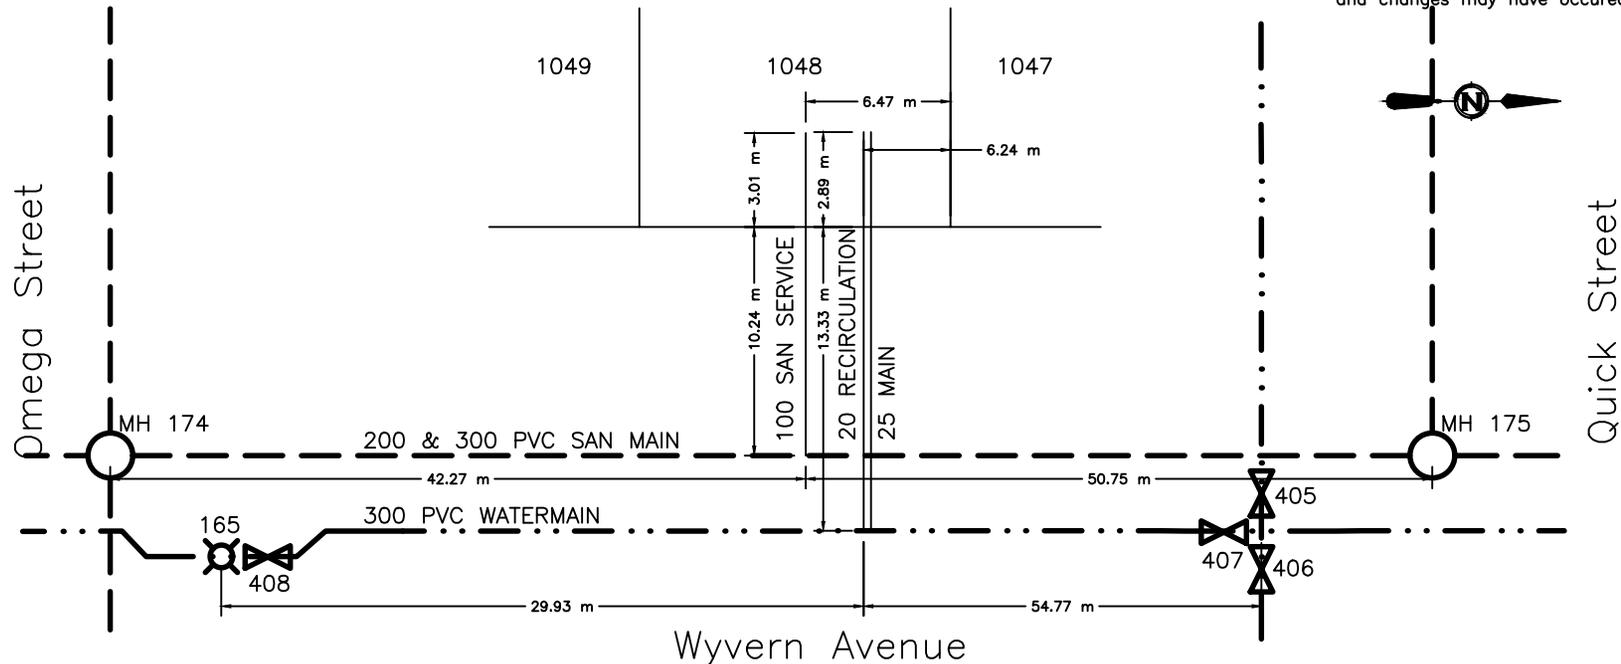



CITY OF WHITEHORSE SERVICE CONNECTION RECORD

FIELD BOOK


No.

ADDRESS 30 Wyvern Avenue BLOCK LOT 1049

DATES	WATER	SEWER
On at Main 2020-AUG-06	Depth at P/L: 3.00 m	2.95 m
On at Building	Depth at Main: 3.42 m	3.28 m
Frost Plug:	Pipe Size: 25 mm / 20 mm	100 mm
Memo:	Pipe Material: HDPE	Insul. <input checked="" type="checkbox"/> Yes / <input type="checkbox"/> No
	Length from Main to P/L: 13.31 m	PVC
	Squirt Test:	Insul. <input checked="" type="checkbox"/> Yes / <input type="checkbox"/> No
Booster Pump Required: <input type="checkbox"/> Yes / <input checked="" type="checkbox"/> No	Frost Protection: Aquaflo / <input checked="" type="checkbox"/> Recirc / Heat Trace / Bleeder	N/A
PRV Required: <input type="checkbox"/> Yes / <input checked="" type="checkbox"/> No	Greased @ CC: <input checked="" type="checkbox"/> Yes / <input type="checkbox"/> No	N/A
Water Meter Installed: <input type="checkbox"/> Yes / <input checked="" type="checkbox"/> No	Continuity Test: <input checked="" type="checkbox"/> N/A	N/A

CLEARLY INDICATE LOCATION OF CC AND ROUTE OF PIPES ON DRAWING BELOW

1. Show main valves required to isolate this service. 2. All dimensions to be tied to property line 3. All dimensions to be metric 4. Depth @ property line is based on elevation after construction and changes may have occurred.

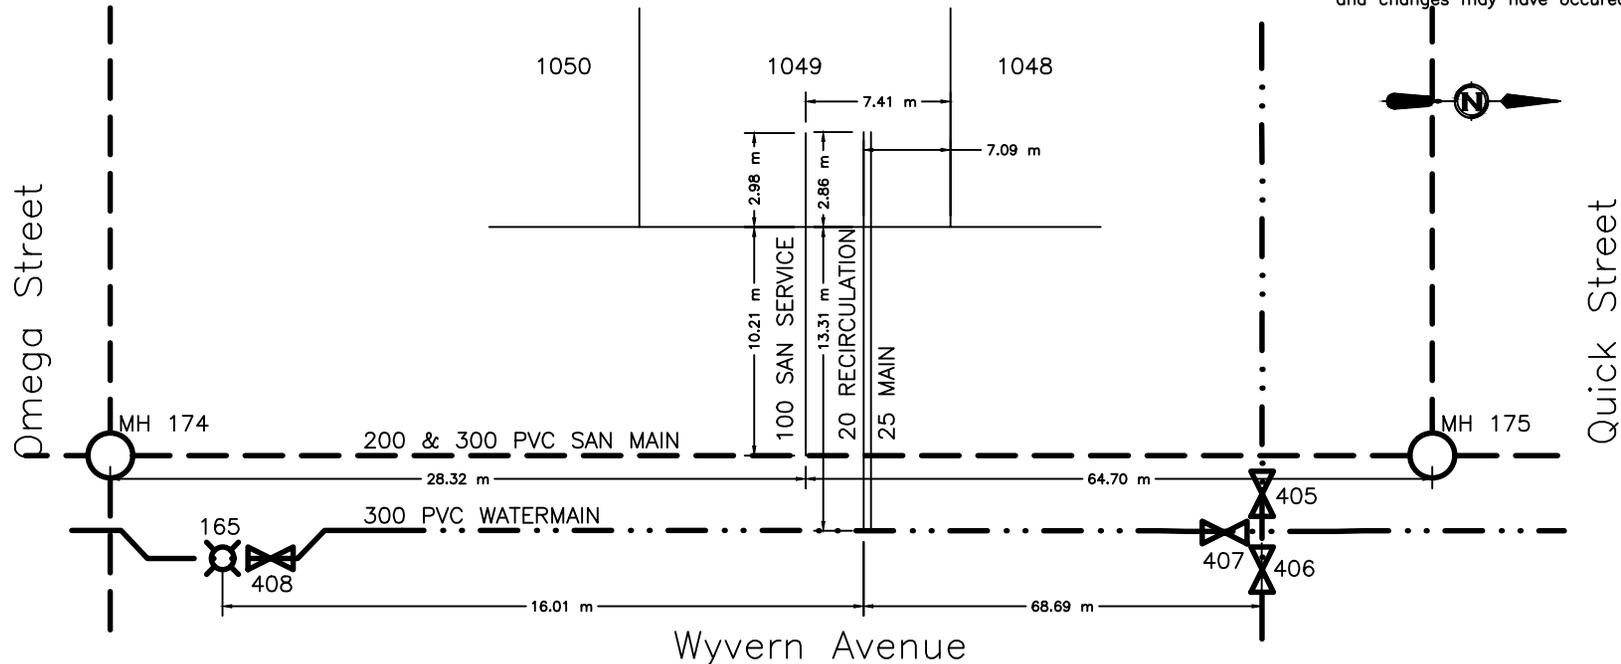



CITY OF WHITEHORSE SERVICE CONNECTION RECORD

FIELD BOOK


No.

ADDRESS 28 Wyvern Avenue BLOCK LOT 1050

DATES		WATER		SEWER	
On at Main 2020-AUG-12		Depth at P/L: 3.00 m		2.95 m	
On at Building		Depth at Main: 3.42 m		3.28 m	
Frost Plug:		Pipe Size: 25 mm / 20 mm		100 mm	
Memo:		Pipe Material: HDPE		PVC	
		Insul. <input checked="" type="checkbox"/> Yes / <input type="checkbox"/> No		Insul. <input checked="" type="checkbox"/> Yes / <input type="checkbox"/> No	
		Length from Main to P/L: 14.28 m		10.21 m	
		Squirt Test: <input checked="" type="checkbox"/> Pass / <input type="checkbox"/> Fail		N/A	
Booster Pump Required: <input type="checkbox"/> Yes / <input type="checkbox"/> No		Frost Protection: Aquaflo / <input checked="" type="checkbox"/> Recirc / Heat Trace / Bleeder		N/A	
PRV Required: <input type="checkbox"/> Yes / <input type="checkbox"/> No		Greased @ CC: <input checked="" type="checkbox"/> Yes / <input type="checkbox"/> No		N/A	
Water Meter Installed: <input type="checkbox"/> Yes / <input type="checkbox"/> No		Continuity Test: <input checked="" type="checkbox"/> N/A		Pass / Fail	
				N/A	

CLEARLY INDICATE LOCATION OF CC AND ROUTE OF PIPES ON DRAWING BELOW

1. Show main valves required to isolate this service. 2. All dimensions to be tied to property line 3. All dimensions to be metric 4. Depth @ property line is based on elevation after construction and changes may have occurred.

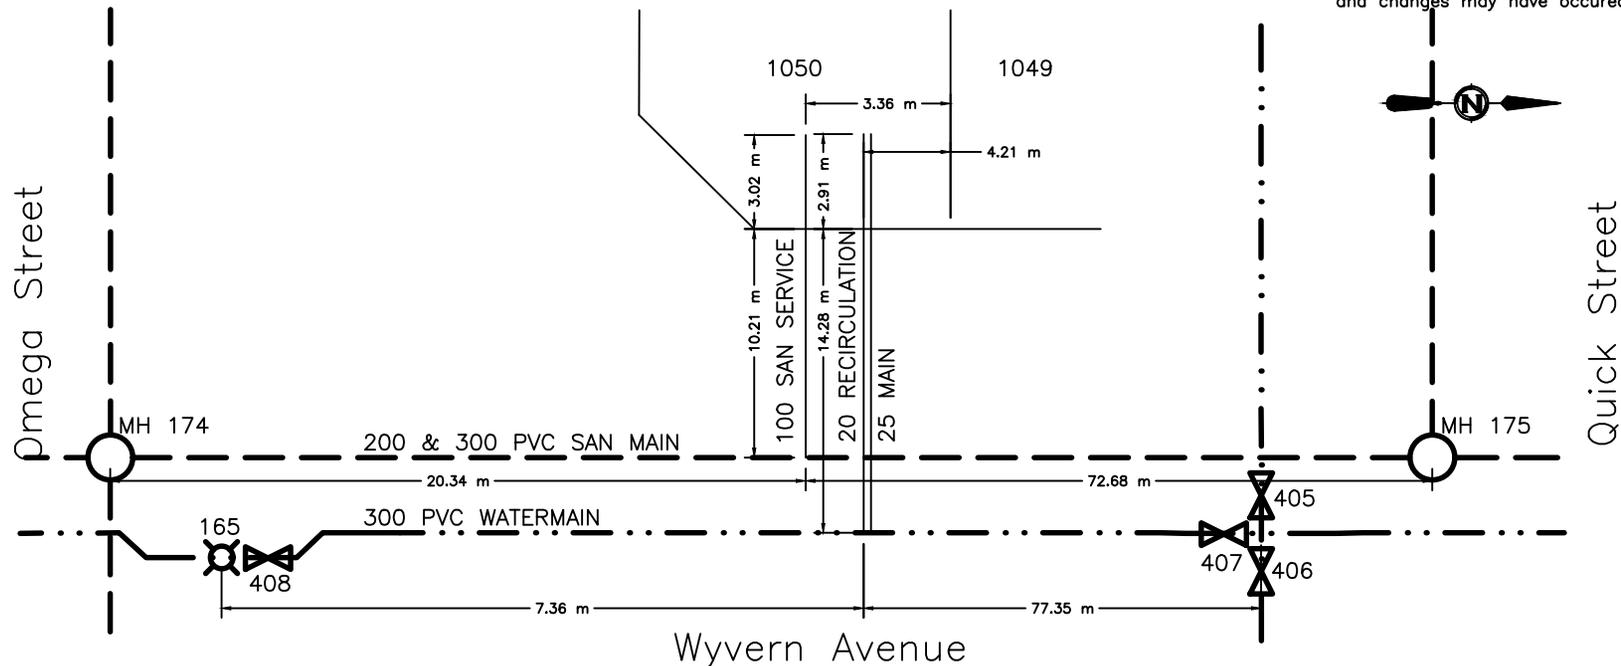



CITY OF WHITEHORSE SERVICE CONNECTION RECORD

FIELD BOOK


No.

ADDRESS 27 Wyvern Avenue BLOCK LOT 1051

DATES		WATER		SEWER	
On at Main 2020-AUG-10		Depth at P/L: 2.63 m		2.69 m	
On at Building		Depth at Main: 3.46 m		3.26 m	
Frost Plug:		Pipe Size: 25 mm / 20 mm		100 mm	
Memo:		Pipe Material: HDPE Insul. <u>(Yes)</u> /No		PVC Insul. Yes/ <u>(No)</u>	
		Length from Main to P/L: 7.11 m		11.69 m	
		Squirt Test: <u>(Pass)</u> /Fail		N/A	
Booster Pump Required:	Yes/No	Frost Protection: Aquaflo/ <u>(Recirc)</u> /Heat Trace/Bleeder		N/A	
PRV Required:	Yes/No	Greased @ CC: <u>(Yes)</u> /No		N/A	
Water Meter Installed:	Yes/No	Continuity Test: <u>(N/A)</u> Pass/Fail		N/A	

CLEARLY INDICATE LOCATION OF CC AND ROUTE OF PIPES ON DRAWING BELOW

1. Show main valves required to isolate this service. 2. All dimensions to be tied to property line 3. All dimensions to be metric 4. Depth @ property line is based on elevation after construction and changes may have occurred.

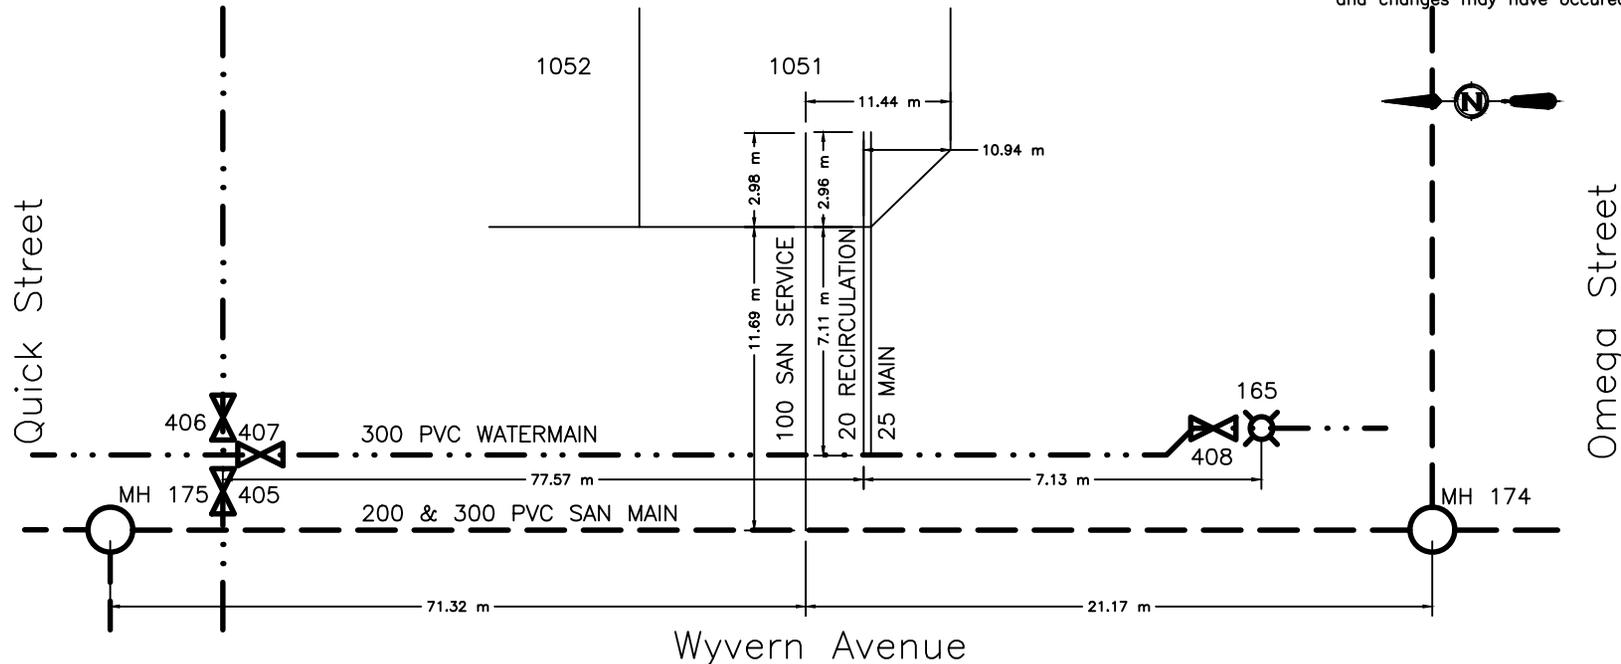



CITY OF WHITEHORSE SERVICE CONNECTION RECORD

FIELD BOOK


No.

ADDRESS 29 Wyvern Avenue BLOCK LOT 1052

DATES		WATER		SEWER
On at Main 2020-AUG-06		Depth at P/L: 2.81 m	2.83 m	
On at Building		Depth at Main: 3.38 m	3.29 m	
Frost Plug:		Pipe Size: 25 mm / 20 mm	100 mm	
Memo:		Pipe Material: HDPE	Insul. <input checked="" type="checkbox"/> Yes / <input type="checkbox"/> No	PVC
		Length from Main to P/L: 8.44 m		10.33 m
		Squirt Test: <input checked="" type="checkbox"/> Pass / <input type="checkbox"/> Fail		N/A
Booster Pump Required:	<input type="checkbox"/> Yes / <input type="checkbox"/> No	Frost Protection: <input checked="" type="checkbox"/> Aquaflow / <input checked="" type="checkbox"/> Recirc / <input type="checkbox"/> Heat Trace / <input type="checkbox"/> Bleeder		N/A
PRV Required:	<input type="checkbox"/> Yes / <input type="checkbox"/> No	Greased @ CC: <input checked="" type="checkbox"/> Yes / <input type="checkbox"/> No		N/A
Water Meter Installed:	<input type="checkbox"/> Yes / <input type="checkbox"/> No	Continuity Test: <input checked="" type="checkbox"/> N/A <input type="checkbox"/> Pass / <input type="checkbox"/> Fail		N/A

CLEARLY INDICATE LOCATION OF CC AND ROUTE OF PIPES ON DRAWING BELOW

1. Show main valves required to isolate this service. 2. All dimensions to be tied to property line 3. All dimensions to be metric 4. Depth @ property line is based on elevation after construction and changes may have occurred.

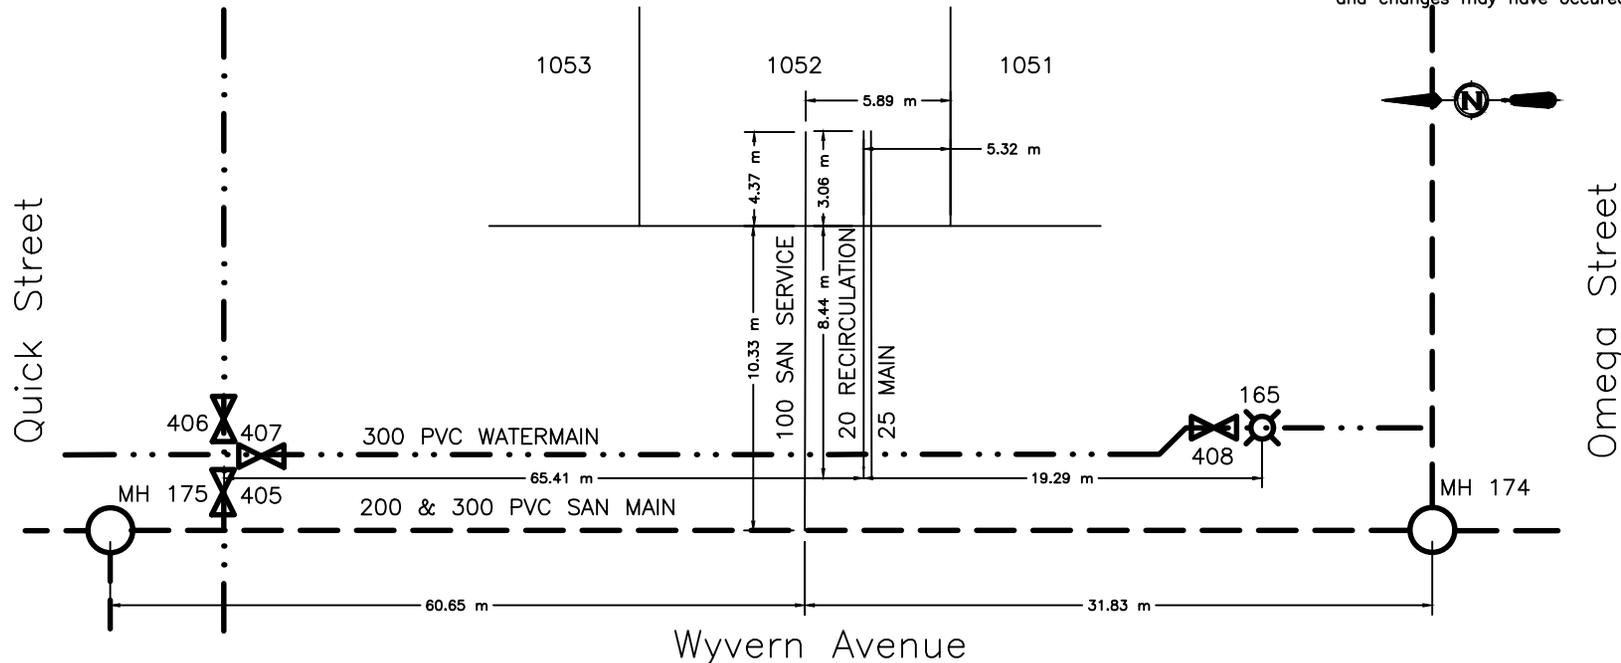



CITY OF WHITEHORSE SERVICE CONNECTION RECORD

FIELD BOOK


No.

ADDRESS 31 Wyvern Avenue BLOCK LOT 1053

DATES		WATER		SEWER	
On at Main 2020-AUG-13		Depth at P/L: 2.64 m		2.70 m	
On at Building		Depth at Main: 3.30 m		3.36 m	
Frost Plug:		Pipe Size: 25 mm / 20 mm		100 mm	
Memo:		Pipe Material: HDPE Insul. <u>(Yes)</u> /No		PVC Insul. Yes/ <u>(No)</u>	
		Length from Main to P/L: 8.47 m		11.68 m	
		Squirt Test: <u>(Pass)</u> /Fail		N/A	
Booster Pump Required:	Yes/No	Frost Protection: Aquaflo/ <u>(Recirc)</u> /Heat Trace/Bleeder		N/A	
PRV Required:	Yes/No	Greased @ CC: <u>(Yes)</u> /No		N/A	
Water Meter Installed:	Yes/No	Continuity Test: <u>(N/A)</u> Pass/Fail		N/A	

CLEARLY INDICATE LOCATION OF CC AND ROUTE OF PIPES ON DRAWING BELOW

1. Show main valves required to isolate this service. 2. All dimensions to be tied to property line 3. All dimensions to be metric 4. Depth @ property line is based on elevation after construction and changes may have occurred.

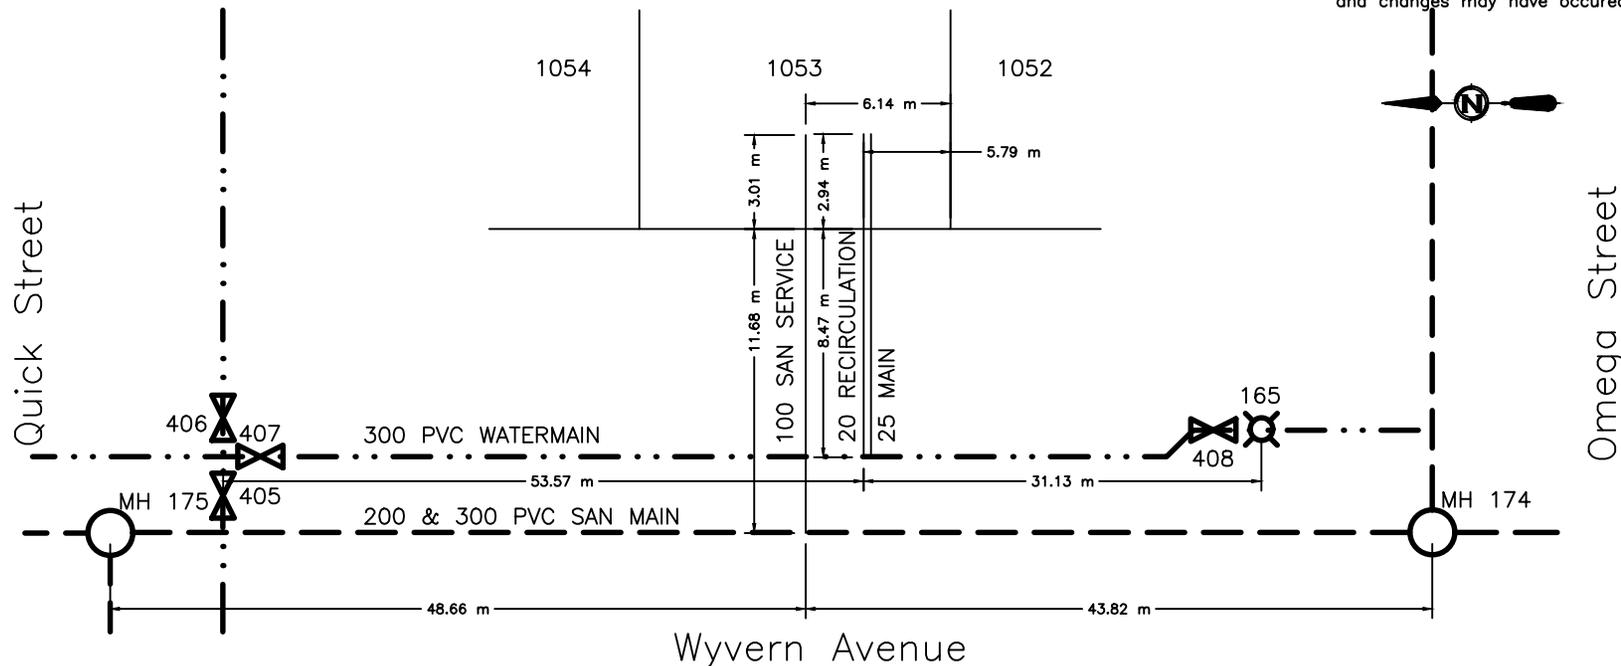



CITY OF WHITEHORSE SERVICE CONNECTION RECORD

FIELD BOOK


No.

ADDRESS 33 Wyvern Avenue BLOCK LOT 1054

DATES		WATER		SEWER
On at Main	2020-AUG-06	Depth at P/L:	2.77 m	2.82 m
On at Building		Depth at Main:	3.22 m	3.37 m
Frost Plug:		Pipe Size:	25 mm / 20 mm	100 mm
Memo:		Pipe Material:	HDPE	PVC
		Insul.:	(Yes/No)	Insul. (Yes/No)
		Length from Main to P/L:	8.44 m	11.58 m
		Squirt Test:	(Pass/Fail)	N/A
Booster Pump Required:	Yes/No	Frost Protection:	Aquaflow/Recirc/Heat Trace/Bleeder	N/A
PRV Required:	Yes/No	Greased @ CC:	(Yes/No)	N/A
Water Meter Installed:	Yes/No	Continuity Test:	(N/A) Pass/Fail	N/A

CLEARLY INDICATE LOCATION OF CC AND ROUTE OF PIPES ON DRAWING BELOW

1. Show main valves required to isolate this service. 2. All dimensions to be tied to property line 3. All dimensions to be metric 4. Depth @ property line is based on elevation after construction and changes may have occurred.

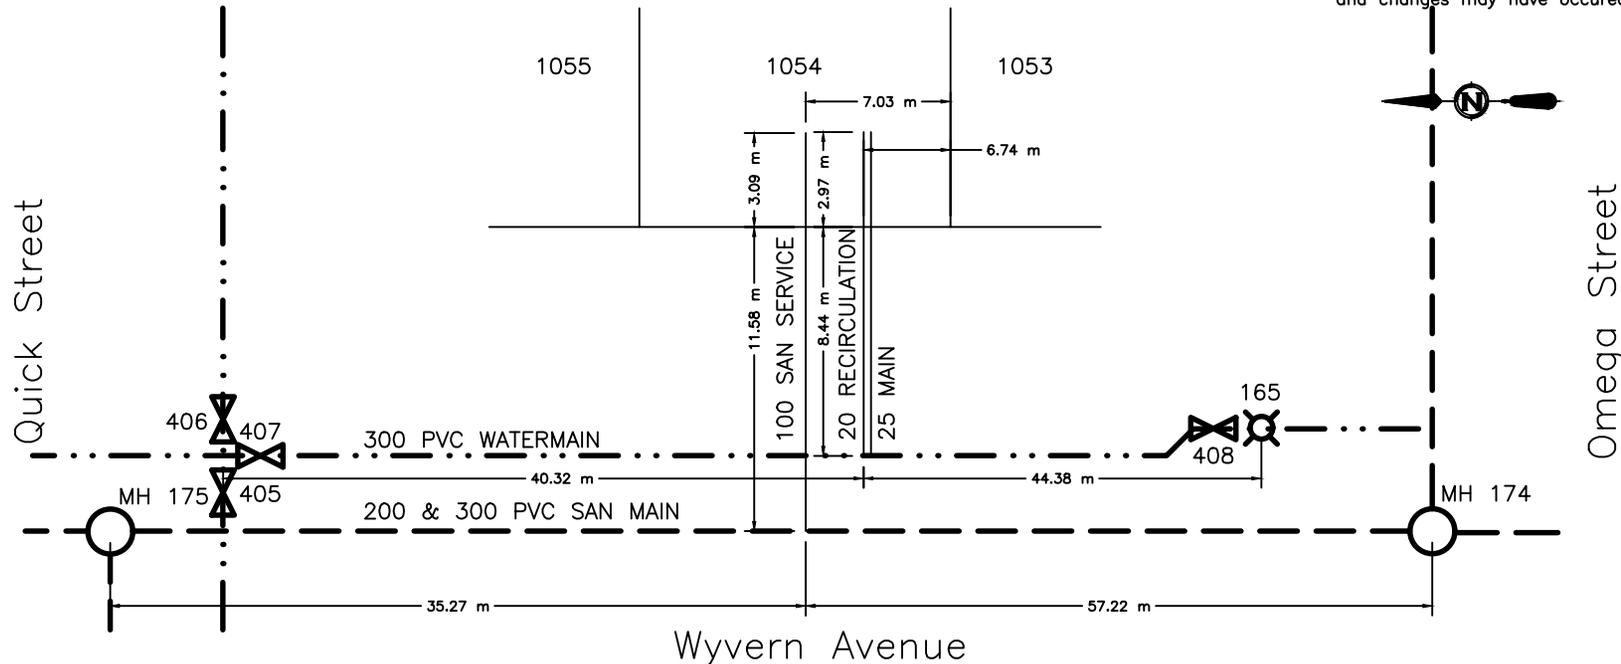



CITY OF WHITEHORSE SERVICE CONNECTION RECORD

FIELD BOOK


No.

ADDRESS 35 Wyvern Avenue BLOCK LOT 1055

DATES		WATER		SEWER	
On at Main 2020-AUG-08		Depth at P/L: 2.52 m		2.60 m	
On at Building		Depth at Main: 3.16 m		3.42 m	
Frost Plug:		Pipe Size: 25 mm / 20 mm		100 mm	
Memo:		Pipe Material: HDPE Insul. <input checked="" type="checkbox"/> Yes / <input type="checkbox"/> No		PVC Insul. Yes / <input checked="" type="checkbox"/> No	
		Length from Main to P/L: 8.42 m		11.64 m	
		Squirt Test: <input checked="" type="checkbox"/> Pass / <input type="checkbox"/> Fail		N/A	
Booster Pump Required:	<input type="checkbox"/> Yes / <input type="checkbox"/> No	Frost Protection: Aquaflo / <input checked="" type="checkbox"/> Recirc / Heat Trace / Bleeder		N/A	
PRV Required:	<input type="checkbox"/> Yes / <input type="checkbox"/> No	Greased @ CC: <input checked="" type="checkbox"/> Yes / <input type="checkbox"/> No		N/A	
Water Meter Installed:	<input type="checkbox"/> Yes / <input type="checkbox"/> No	Continuity Test: <input checked="" type="checkbox"/> N/A <input type="checkbox"/> Pass / <input type="checkbox"/> Fail		N/A	

CLEARLY INDICATE LOCATION OF CC AND ROUTE OF PIPES ON DRAWING BELOW

1. Show main valves required to isolate this service. 2. All dimensions to be tied to property line 3. All dimensions to be metric 4. Depth @ property line is based on elevation after construction and changes may have occurred.

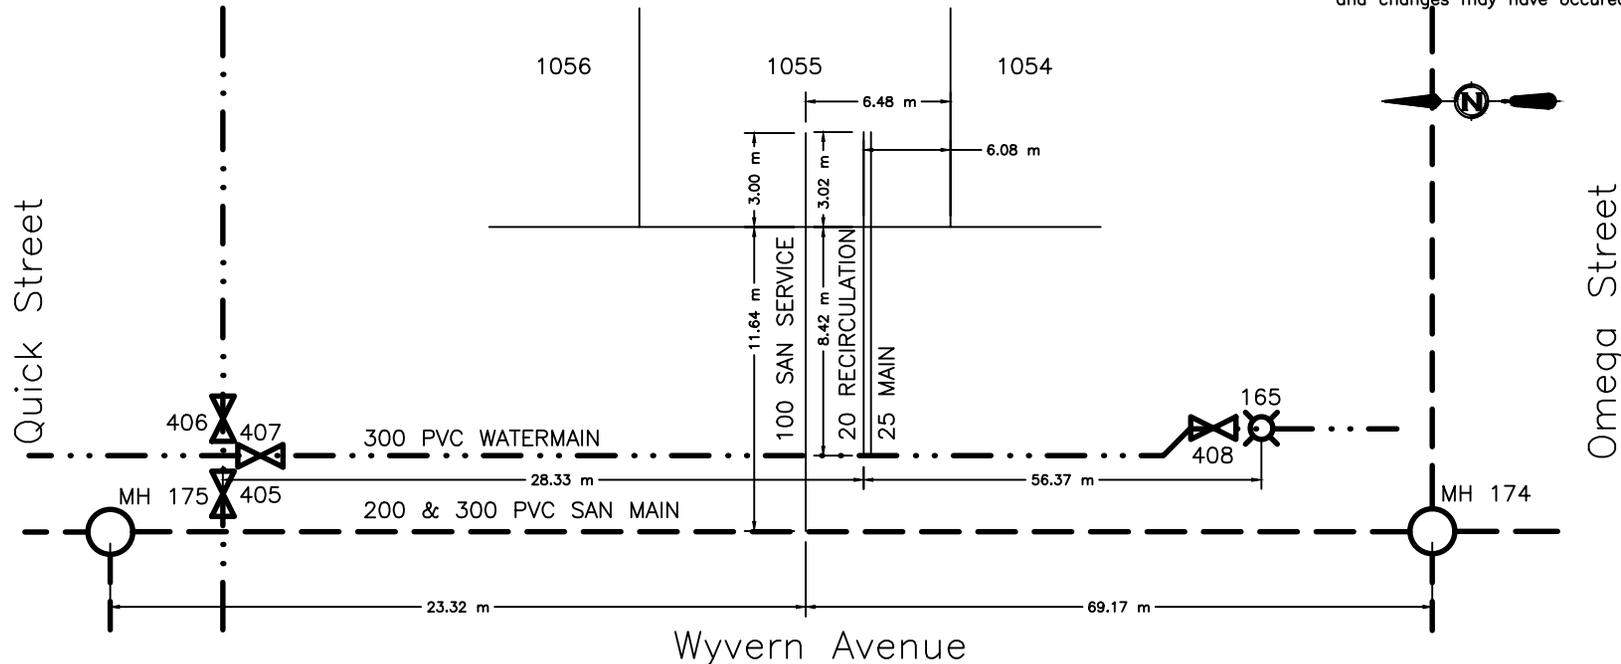



CITY OF WHITEHORSE SERVICE CONNECTION RECORD

FIELD BOOK


No.

ADDRESS 37 Wyvern Avenue BLOCK LOT 1056

DATES	WATER	SEWER
On at Main 2020-AUG-05	Depth at P/L: 2.59 m	2.63 m
On at Building	Depth at Main: 3.10 m	3.46 m
Frost Plug:	Pipe Size: 25 mm / 20 mm	100 mm
Memo:	Pipe Material: HDPE Insul. <u>(Yes)</u> /No	PVC Insul. Yes/ <u>(No)</u>
	Length from Main to P/L: 8.44 m	11.61 m
	Squirt Test: <u>(Pass)</u> /Fail	N/A
Booster Pump Required: Yes/No	Frost Protection: Aquaflo/ <u>(Recirc)</u> /Heat Trace/Bleeder	N/A
PRV Required: Yes/No	Greased @ CC: <u>(Yes)</u> /No	N/A
Water Meter Installed: Yes/No	Continuity Test: <u>(N/A)</u> Pass/Fail	N/A

CLEARLY INDICATE LOCATION OF CC AND ROUTE OF PIPES ON DRAWING BELOW

1. Show main valves required to isolate this service. 2. All dimensions to be tied to property line 3. All dimensions to be metric 4. Depth @ property line is based on elevation after construction and changes may have occurred.

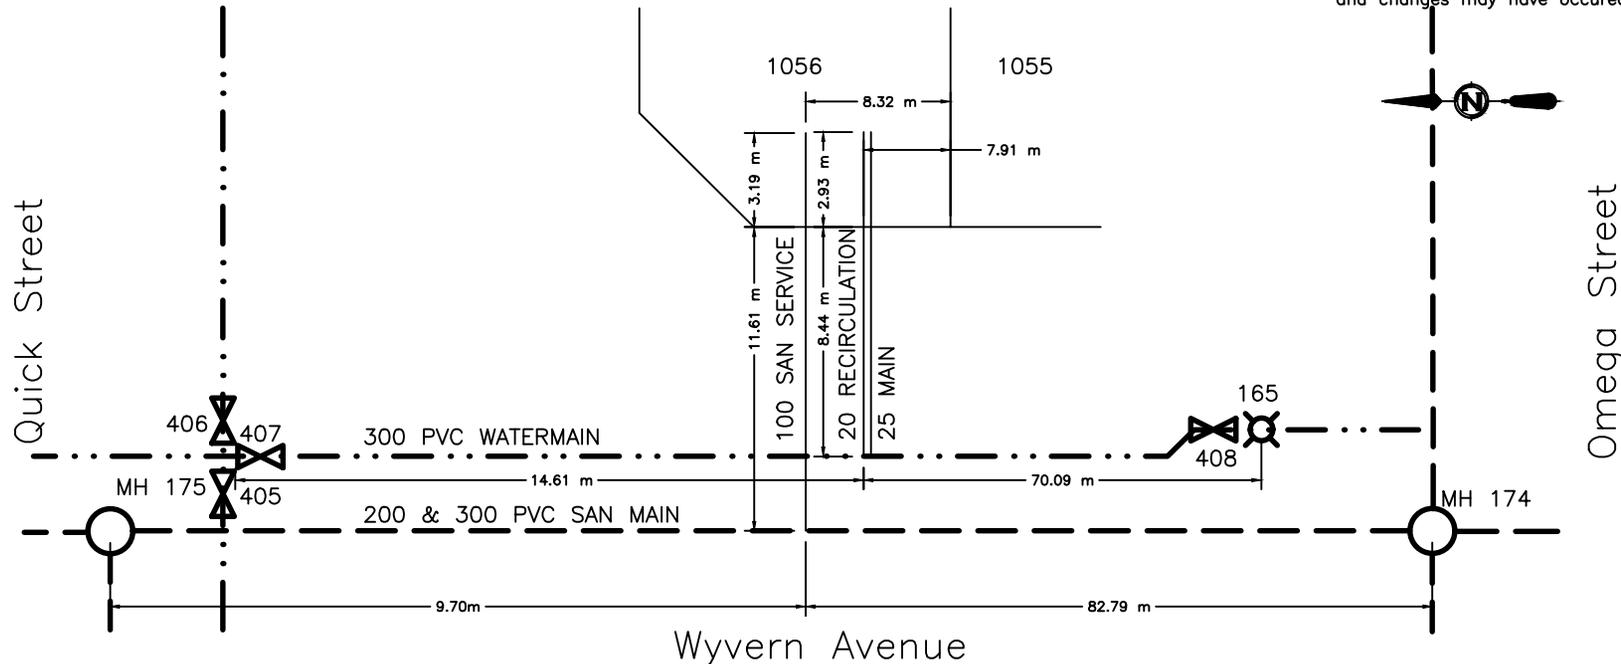



CITY OF WHITEHORSE SERVICE CONNECTION RECORD

FIELD BOOK


No.

ADDRESS 41 Wyvern Avenue BLOCK LOT 1058

DATES	WATER	SEWER
On at Main 2020-AUG-05	Depth at P/L: 2.93 m	3.02 m
On at Building	Depth at Main: 3.06 m	3.97 m
Frost Plug:	Pipe Size: 25 mm / 20 mm	100 mm
Memo:	Pipe Material: HDPE Insul. <input checked="" type="checkbox"/> Yes / <input type="checkbox"/> No	PVC Insul. <input checked="" type="checkbox"/> Yes / <input type="checkbox"/> No
	Length from Main to P/L: 8.42 m	11.67 m
	Squirt Test: <input checked="" type="checkbox"/> Pass / <input type="checkbox"/> Fail	N/A
Booster Pump Required: <input type="checkbox"/> Yes / <input checked="" type="checkbox"/> No	Frost Protection: Aquaflo / <input checked="" type="checkbox"/> Recirc / Heat Trace / Bleeder	N/A
PRV Required: <input type="checkbox"/> Yes / <input checked="" type="checkbox"/> No	Greased @ CC: <input checked="" type="checkbox"/> Yes / <input type="checkbox"/> No	N/A
Water Meter Installed: <input type="checkbox"/> Yes / <input checked="" type="checkbox"/> No	Continuity Test: <input checked="" type="checkbox"/> N/A / <input type="checkbox"/> Pass / <input type="checkbox"/> Fail	N/A

CLEARLY INDICATE LOCATION OF CC AND ROUTE OF PIPES ON DRAWING BELOW

1. Show main valves required to isolate this service. 2. All dimensions to be tied to property line 3. All dimensions to be metric 4. Depth @ property line is based on elevation after construction and changes may have occurred.

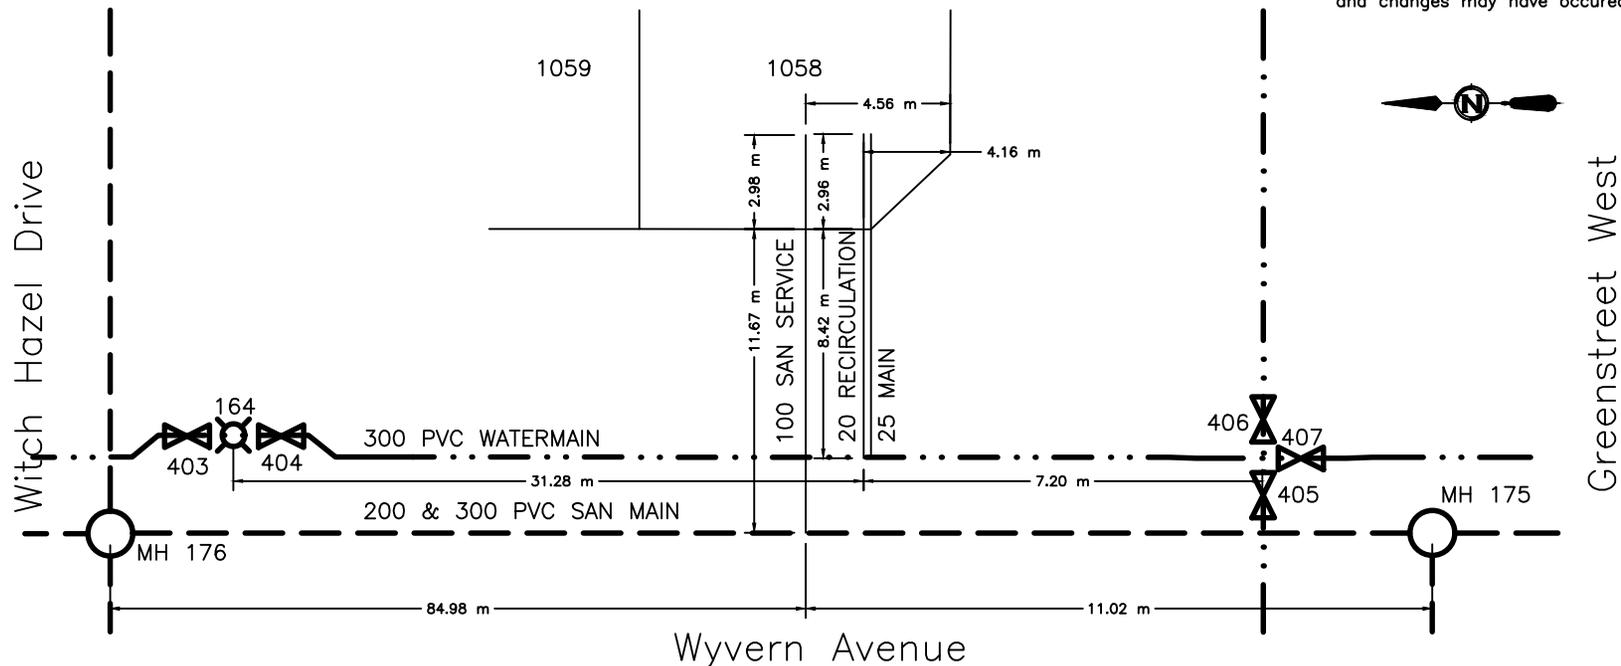



CITY OF WHITEHORSE SERVICE CONNECTION RECORD

FIELD BOOK


No.

ADDRESS 43 Wyvern Avenue BLOCK LOT 1059

DATES	WATER	SEWER
On at Main 2020-JUL-30	Depth at P/L: 3.05 m	3.23 m
On at Building	Depth at Main: 3.07 m	3.93 m
Frost Plug:	Pipe Size: 20 mm / 25 mm	100 mm
Memo:	Pipe Material: HDPE Insul. <u>(Yes)</u> /No	PVC Insul. Yes/ <u>(No)</u>
	Length from Main to P/L: 8.44 m	11.58 m
	Squirt Test: <u>(Pass)</u> /Fail	N/A
Booster Pump Required: Yes/No	Frost Protection: Aquaflo/ <u>(Recirc)</u> /Heat Trace/Bleeder	N/A
PRV Required: Yes/No	Greased @ CC: <u>(Yes)</u> /No	N/A
Water Meter Installed: Yes/No	Continuity Test: <u>(N/A)</u> Pass/Fail	N/A

CLEARLY INDICATE LOCATION OF CC AND ROUTE OF PIPES ON DRAWING BELOW

1. Show main valves required to isolate this service. 2. All dimensions to be tied to property line 3. All dimensions to be metric 4. Depth @ property line is based on elevation after construction and changes may have occurred.

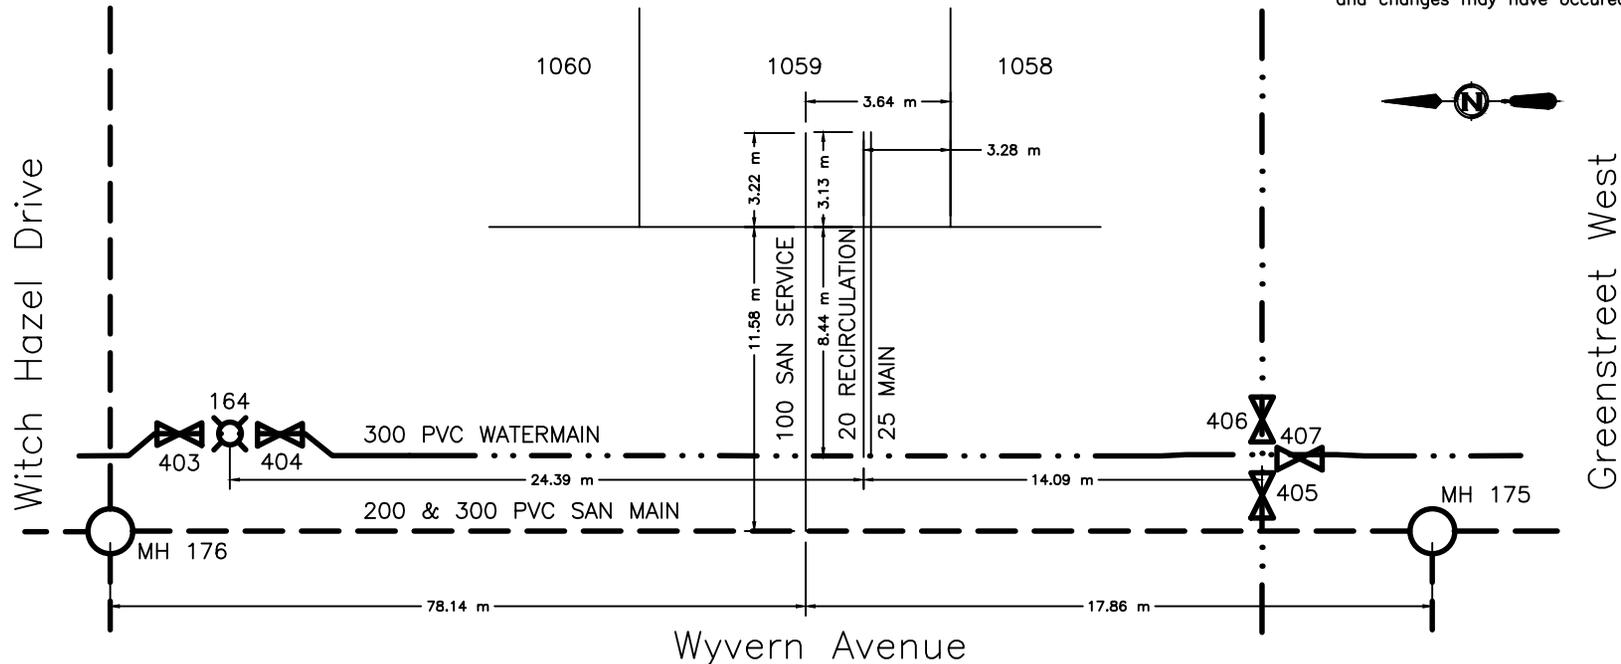



CITY OF WHITEHORSE SERVICE CONNECTION RECORD

FIELD BOOK


No.

ADDRESS 45 Wyvern Avenue BLOCK LOT 1060

DATES		WATER		SEWER		
On at Main	2020-AUG-14	Depth at P/L:	2.56 m		2.58 m	
On at Building		Depth at Main:	3.03 m		3.86 m	
Frost Plug:		Pipe Size:	25 mm / 20 mm		100 mm	
Memo:		Pipe Material:	HDPE	Insul. <input checked="" type="checkbox"/> Yes/ <input type="checkbox"/> No	PVC	Insul. <input checked="" type="checkbox"/> Yes/ <input type="checkbox"/> No
		Length from Main to P/L:	8.42 m		11.59 m	
		Squirt Test:	<input checked="" type="checkbox"/> Pass/ <input type="checkbox"/> Fail			N/A
Booster Pump Required:	<input type="checkbox"/> Yes/ <input type="checkbox"/> No	Frost Protection:	Aquaflow/ <input checked="" type="checkbox"/> Recirc/Heat Trace/Bleeder		N/A	
PRV Required:	<input type="checkbox"/> Yes/ <input type="checkbox"/> No	Greased @ CC:	<input checked="" type="checkbox"/> Yes/ <input type="checkbox"/> No		N/A	
Water Meter Installed:	<input type="checkbox"/> Yes/ <input type="checkbox"/> No	Continuity Test:	<input checked="" type="checkbox"/> N/A	<input type="checkbox"/> Pass/ <input type="checkbox"/> Fail	N/A	

CLEARLY INDICATE LOCATION OF CC AND ROUTE OF PIPES ON DRAWING BELOW

1. Show main valves required to isolate this service. 2. All dimensions to be tied to property line 3. All dimensions to be metric 4. Depth @ property line is based on elevation after construction and changes may have occurred.

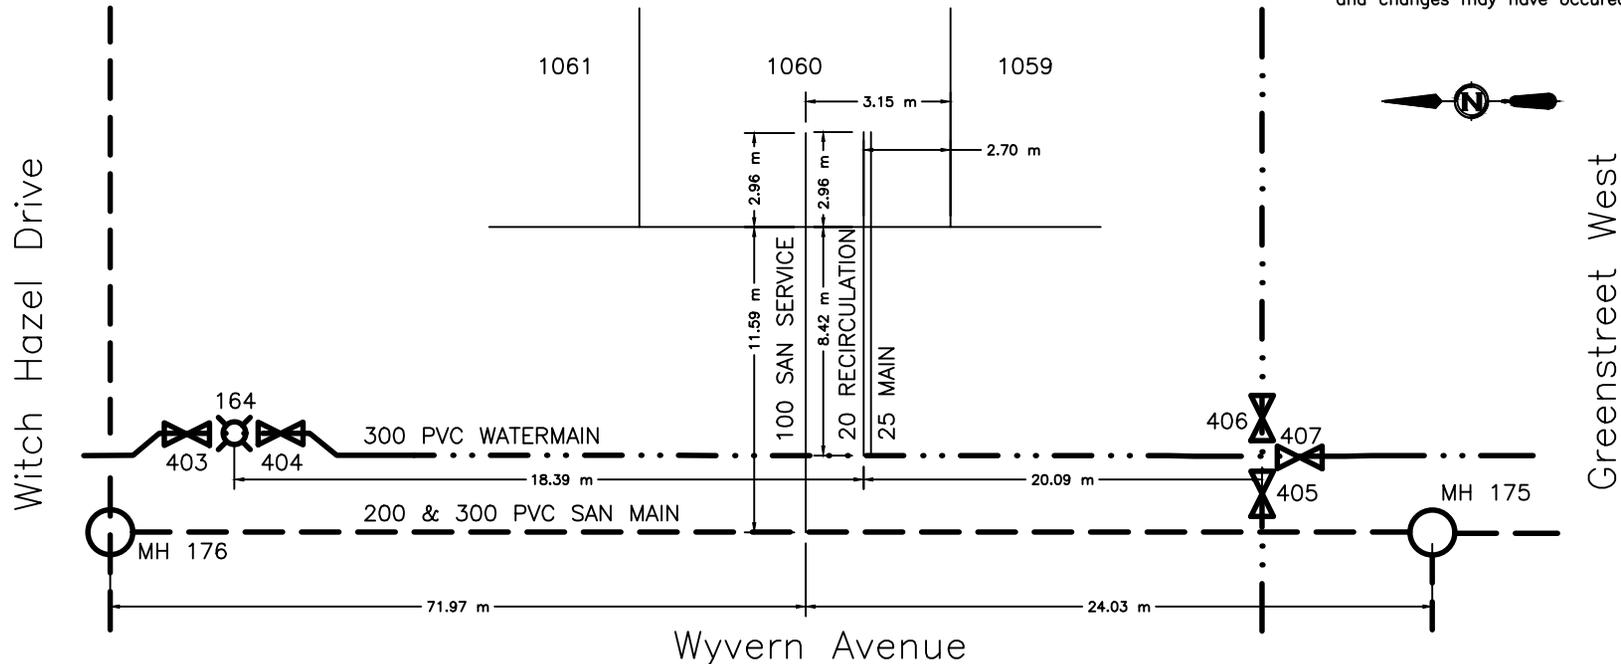



CITY OF WHITEHORSE SERVICE CONNECTION RECORD

FIELD BOOK


No.

ADDRESS 47 Wyvern Avenue BLOCK LOT 1061

DATES		WATER		SEWER
On at Main	2020-AUG-08	Depth at P/L:	2.52 m	2.56 m
On at Building		Depth at Main:	3.03 m	3.78 m
Frost Plug:		Pipe Size:	25 mm / 20 mm	100 mm
Memo:		Pipe Material:	HDPE	PVC
		Insul.:	<input checked="" type="checkbox"/> Yes / <input type="checkbox"/> No	Insul. <input checked="" type="checkbox"/> Yes / <input type="checkbox"/> No
		Length from Main to P/L:	8.46 m	11.63 m
		Squirt Test:	<input checked="" type="checkbox"/> Pass / <input type="checkbox"/> Fail	N/A
Booster Pump Required:	<input type="checkbox"/> Yes / <input type="checkbox"/> No	Frost Protection:	Aquaflow / <input checked="" type="checkbox"/> Recirc / Heat Trace / Bleeder	N/A
PRV Required:	<input type="checkbox"/> Yes / <input type="checkbox"/> No	Greased @ CC:	<input checked="" type="checkbox"/> Yes / <input type="checkbox"/> No	N/A
Water Meter Installed:	<input type="checkbox"/> Yes / <input type="checkbox"/> No	Continuity Test:	<input checked="" type="checkbox"/> N/A / <input type="checkbox"/> Pass / <input type="checkbox"/> Fail	N/A

CLEARLY INDICATE LOCATION OF CC AND ROUTE OF PIPES ON DRAWING BELOW

1. Show main valves required to isolate this service. 2. All dimensions to be tied to property line 3. All dimensions to be metric 4. Depth @ property line is based on elevation after construction and changes may have occurred.

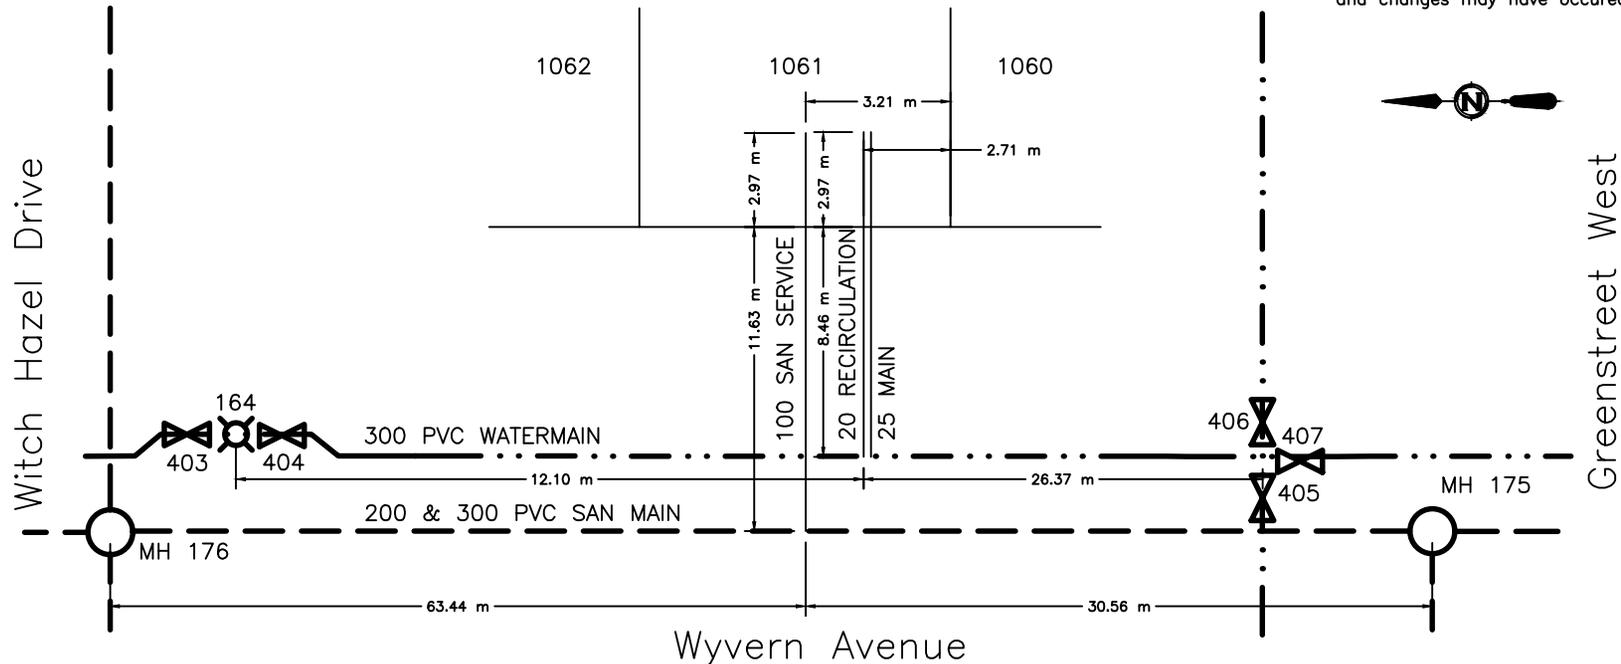



CITY OF WHITEHORSE SERVICE CONNECTION RECORD

FIELD BOOK


No.

ADDRESS 49 Wyvern Avenue BLOCK LOT 1062

DATES		WATER		SEWER
On at Main	2020-JUL-30	Depth at P/L:	3.12 m	3.15 m
On at Building		Depth at Main:	2.94 m	3.70 m
Frost Plug:		Pipe Size:	25 mm / 20 mm	100 mm
Memo:		Pipe Material:	HDPE Insul. <input checked="" type="checkbox"/> Yes/ <input type="checkbox"/> No	PVC Insul. <input checked="" type="checkbox"/> Yes/ <input type="checkbox"/> No
		Length from Main to P/L:	6.53 m	11.61 m
		Squirt Test:	<input checked="" type="checkbox"/> Pass/ <input type="checkbox"/> Fail	N/A
Booster Pump Required:	<input type="checkbox"/> Yes/ <input type="checkbox"/> No	Frost Protection:	Aquaflow/ <input checked="" type="checkbox"/> Recirc/ <input type="checkbox"/> Heat Trace/ <input type="checkbox"/> Bleeder	N/A
PRV Required:	<input type="checkbox"/> Yes/ <input type="checkbox"/> No	Greased @ CC:	<input checked="" type="checkbox"/> Yes/ <input type="checkbox"/> No	N/A
Water Meter Installed:	<input type="checkbox"/> Yes/ <input type="checkbox"/> No	Continuity Test:	<input checked="" type="checkbox"/> N/A <input type="checkbox"/> Pass/ <input type="checkbox"/> Fail	N/A

CLEARLY INDICATE LOCATION OF CC AND ROUTE OF PIPES ON DRAWING BELOW

1. Show main valves required to isolate this service. 2. All dimensions to be tied to property line 3. All dimensions to be metric 4. Depth @ property line is based on elevation after construction and changes may have occurred.

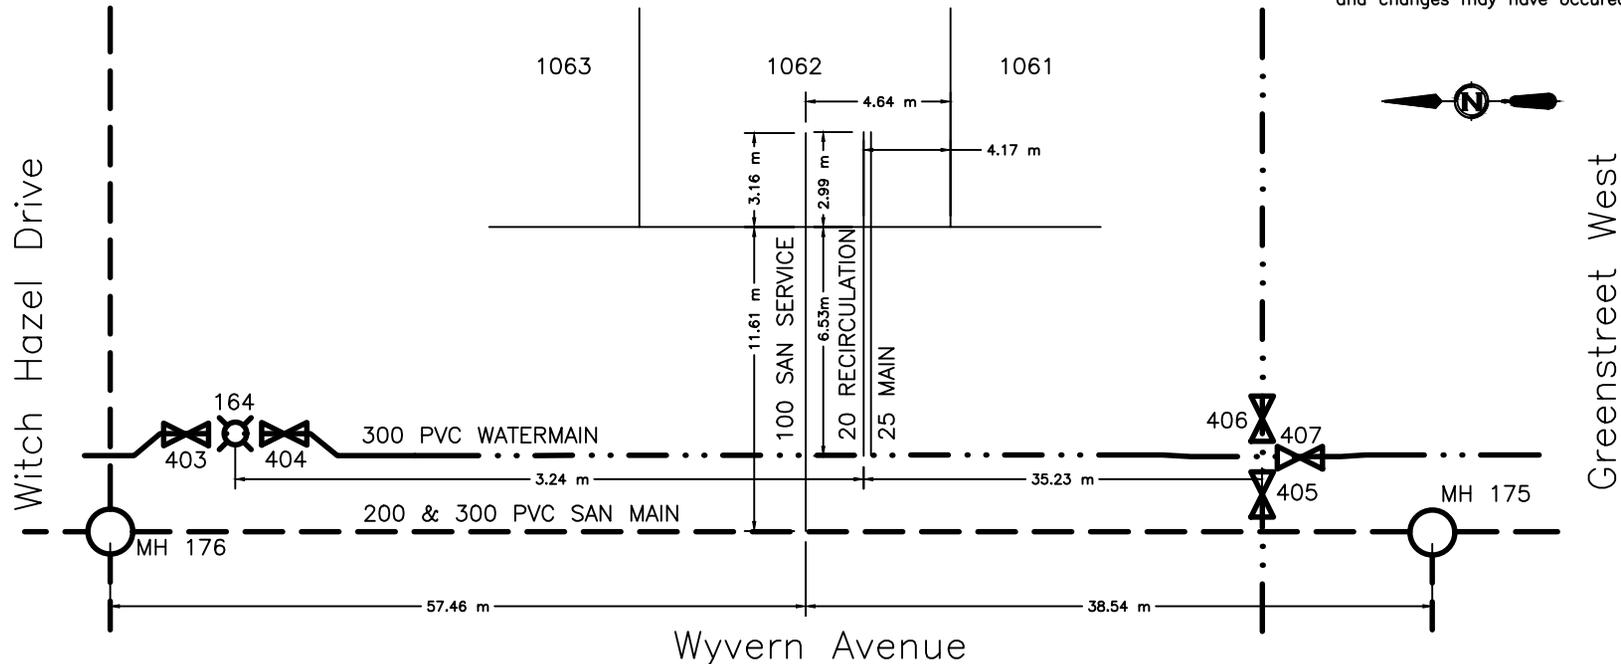



CITY OF WHITEHORSE SERVICE CONNECTION RECORD

FIELD BOOK


No.

ADDRESS 51 Wyvern Avenue BLOCK LOT 1063

DATES		WATER		SEWER	
On at Main 2020-AUG-05		Depth at P/L: 2.48 m		2.50 m	
On at Building		Depth at Main: 2.90 m		3.60 m	
Frost Plug:		Pipe Size: 25 mm / 20 mm		100 mm	
Memo:		Pipe Material: HDPE Insul. <input checked="" type="checkbox"/> Yes / <input type="checkbox"/> No		PVC Insul. <input checked="" type="checkbox"/> Yes / <input type="checkbox"/> No	
		Length from Main to P/L: 6.68 m		11.69 m	
		Squirt Test: <input checked="" type="checkbox"/> Pass / <input type="checkbox"/> Fail		N/A	
Booster Pump Required:	<input type="checkbox"/> Yes / <input type="checkbox"/> No	Frost Protection: <input checked="" type="checkbox"/> Aquaflow / <input checked="" type="checkbox"/> Recirc / <input type="checkbox"/> Heat Trace / <input type="checkbox"/> Bleeder		N/A	
PRV Required:	<input type="checkbox"/> Yes / <input type="checkbox"/> No	Greased @ CC: <input checked="" type="checkbox"/> Yes / <input type="checkbox"/> No		N/A	
Water Meter Installed:	<input type="checkbox"/> Yes / <input type="checkbox"/> No	Continuity Test: <input checked="" type="checkbox"/> N/A <input type="checkbox"/> Pass / <input type="checkbox"/> Fail		N/A	

CLEARLY INDICATE LOCATION OF CC AND ROUTE OF PIPES ON DRAWING BELOW

1. Show main valves required to isolate this service. 2. All dimensions to be tied to property line 3. All dimensions to be metric 4. Depth @ property line is based on elevation after construction and changes may have occurred.

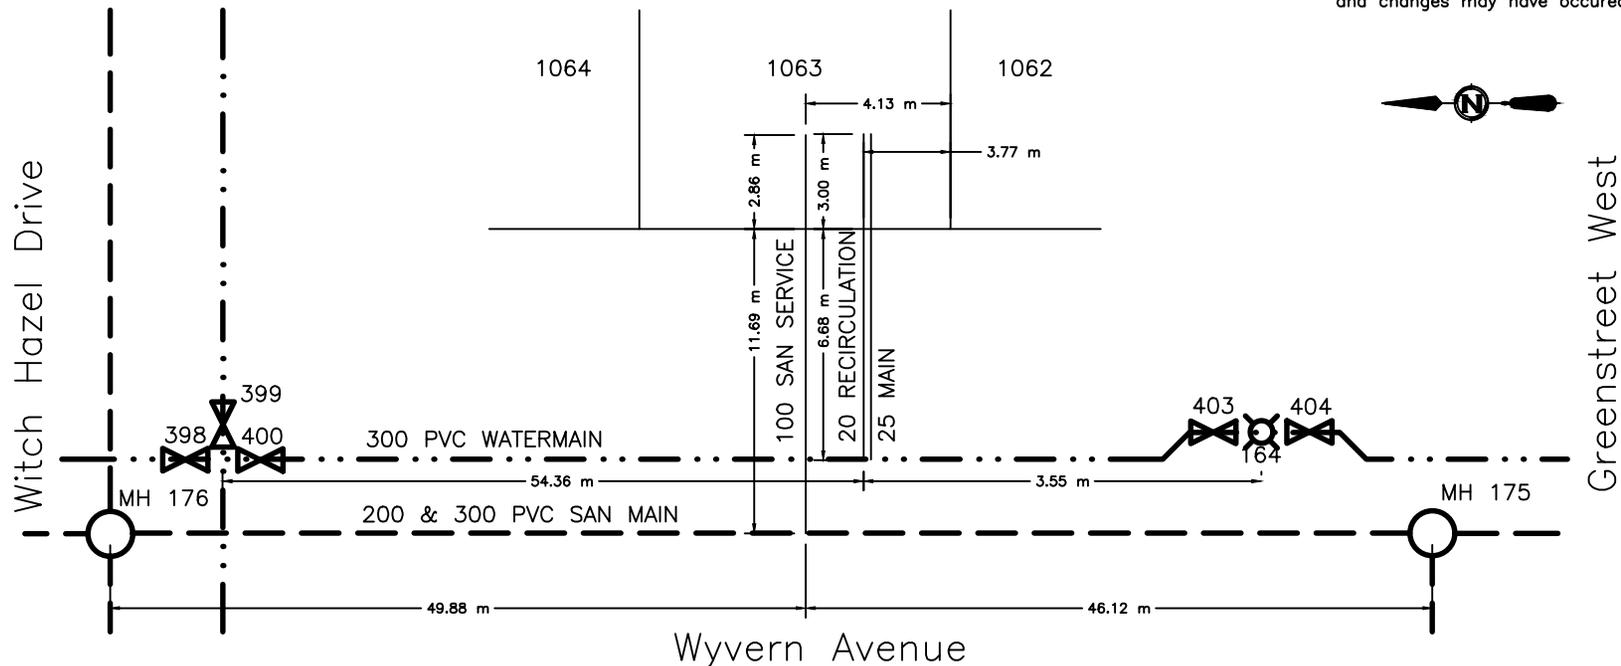



CITY OF WHITEHORSE SERVICE CONNECTION RECORD

FIELD BOOK


No.

ADDRESS 53 Wyvern Avenue BLOCK LOT 1064

DATES		WATER		SEWER
On at Main 2020-JUL-31		Depth at P/L: 2.97 m		3.09 m
On at Building		Depth at Main: 3.09 m		3.53 m
Frost Plug:		Pipe Size: 25 mm / 20 mm		100 mm
Memo:		Pipe Material: HDPE		PVC
		Insul. <input checked="" type="checkbox"/> Yes / <input type="checkbox"/> No		Insul. <input checked="" type="checkbox"/> Yes / <input type="checkbox"/> No
		Length from Main to P/L: 8.23 m		11.56 m
		Squirt Test: <input checked="" type="checkbox"/> Pass / <input type="checkbox"/> Fail		N/A
Booster Pump Required:	<input type="checkbox"/> Yes / <input type="checkbox"/> No	Frost Protection: <input checked="" type="checkbox"/> Aquaflow / <input checked="" type="checkbox"/> Recirc / <input type="checkbox"/> Heat Trace / <input type="checkbox"/> Bleeder		N/A
PRV Required:	<input type="checkbox"/> Yes / <input type="checkbox"/> No	Greased @ CC: <input checked="" type="checkbox"/> Yes / <input type="checkbox"/> No		N/A
Water Meter Installed:	<input type="checkbox"/> Yes / <input type="checkbox"/> No	Continuity Test: <input checked="" type="checkbox"/> N/A / <input type="checkbox"/> Pass / <input type="checkbox"/> Fail		N/A

CLEARLY INDICATE LOCATION OF CC AND ROUTE OF PIPES ON DRAWING BELOW

1. Show main valves required to isolate this service. 2. All dimensions to be tied to property line 3. All dimensions to be metric 4. Depth @ property line is based on elevation after construction and changes may have occurred.

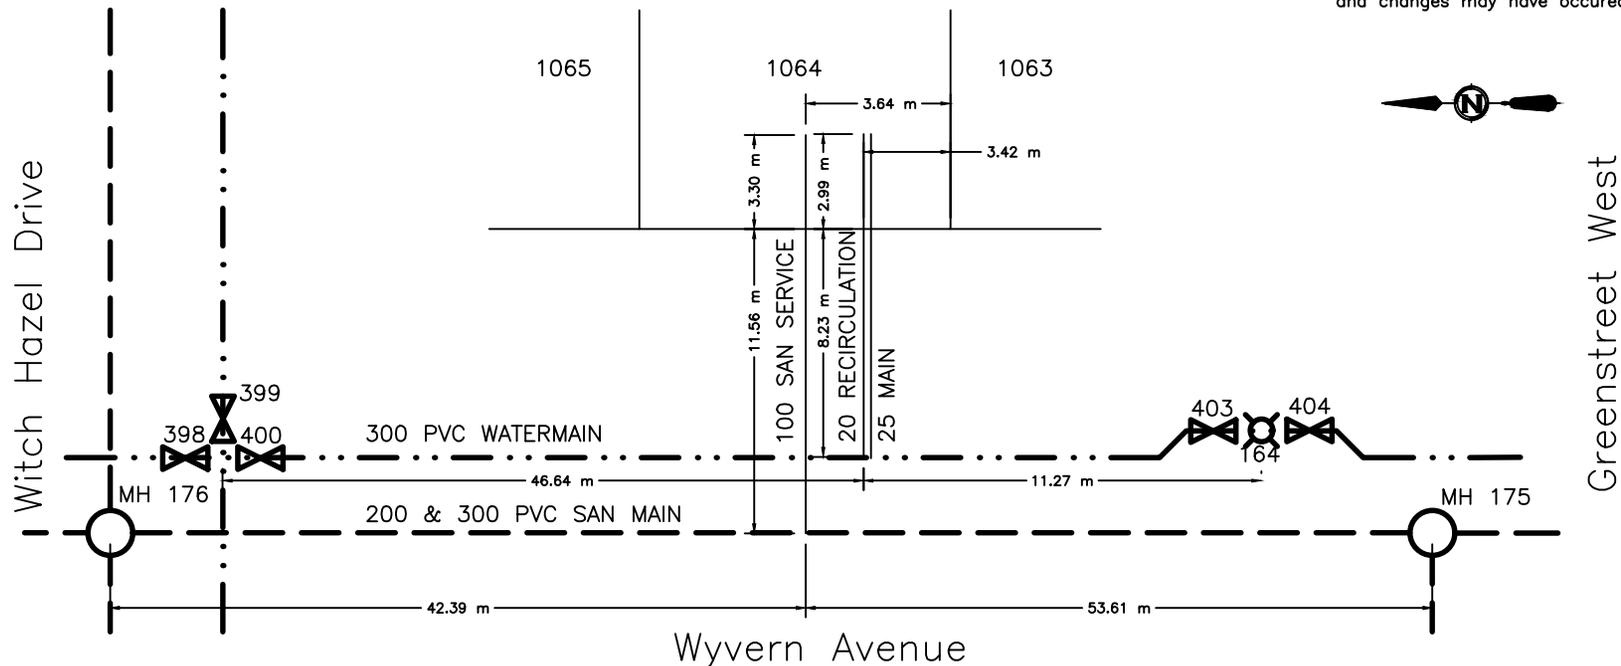



CITY OF WHITEHORSE SERVICE CONNECTION RECORD

FIELD BOOK


No.

ADDRESS 55 Wyvern Avenue BLOCK LOT 1065

DATES		WATER		SEWER
On at Main 2020-JUL-29		Depth at P/L: 2.47 m	2.50 m	
On at Building		Depth at Main: 3.08 m	3.45 m	
Frost Plug:		Pipe Size: 25 mm / 20 mm	100 mm	
Memo:		Pipe Material: HDPE	Insul. <input checked="" type="checkbox"/> Yes / <input type="checkbox"/> No	PVC
		Length from Main to P/L: 8.30 m		11.51 m
		Squirt Test:	<input checked="" type="checkbox"/> Pass / <input type="checkbox"/> Fail	N/A
Booster Pump Required:	<input type="checkbox"/> Yes / <input type="checkbox"/> No	Frost Protection: Aquaflo / <input checked="" type="checkbox"/> Recirc / Heat Trace / Bleeder		N/A
PRV Required:	<input type="checkbox"/> Yes / <input type="checkbox"/> No	Greased @ CC: <input checked="" type="checkbox"/> Yes / <input type="checkbox"/> No		N/A
Water Meter Installed:	<input type="checkbox"/> Yes / <input type="checkbox"/> No	Continuity Test: <input type="checkbox"/> N/A / <input type="checkbox"/> Pass / <input type="checkbox"/> Fail		N/A

CLEARLY INDICATE LOCATION OF CC AND ROUTE OF PIPES ON DRAWING BELOW

1. Show main valves required to isolate this service. 2. All dimensions to be tied to property line 3. All dimensions to be metric 4. Depth @ property line is based on elevation after construction and changes may have occurred.

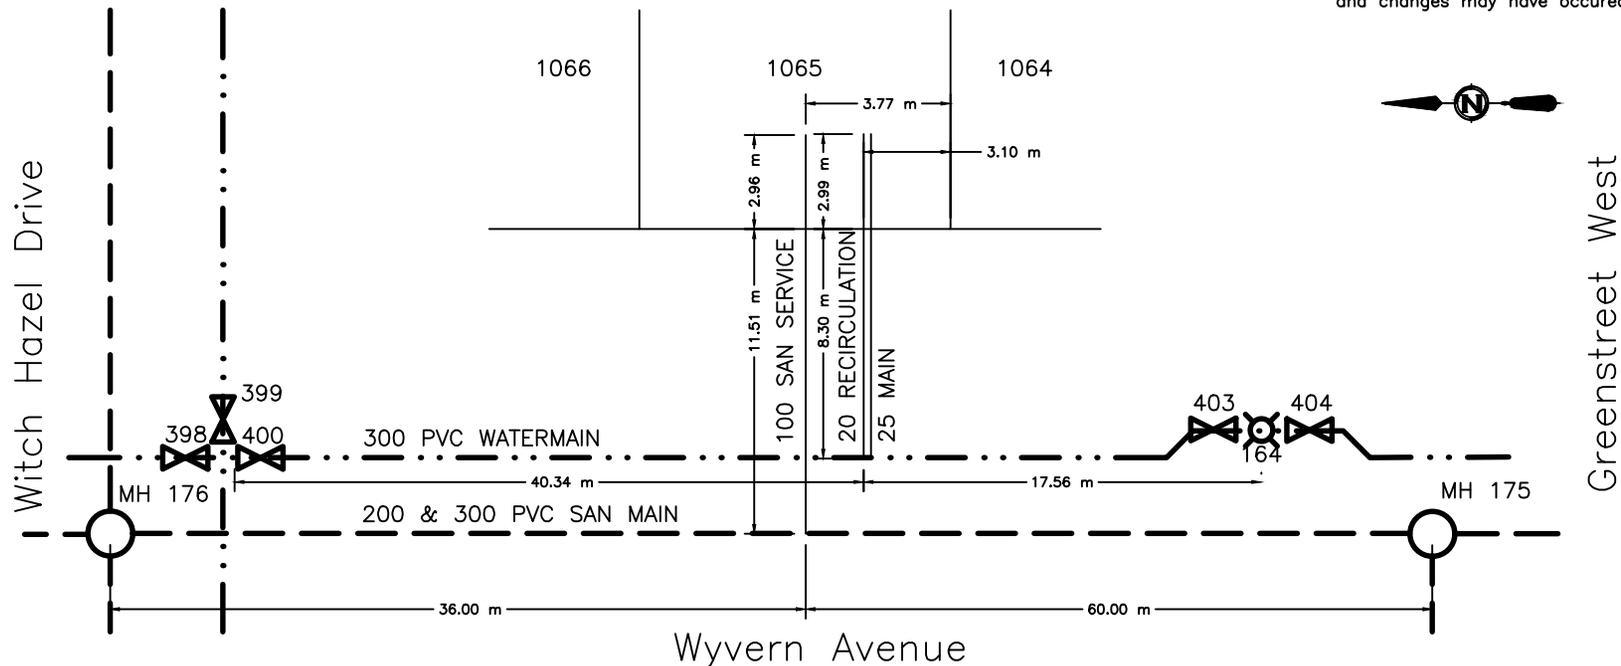



CITY OF WHITEHORSE SERVICE CONNECTION RECORD

FIELD BOOK


No.

ADDRESS 57 Wyvern Avenue BLOCK LOT 1066

DATES	WATER	SEWER
On at Main 2020-AUG-14	Depth at P/L: 2.61 m	2.61 m
On at Building	Depth at Main: 3.10 m	3.39 m
Frost Plug:	Pipe Size: 25 mm / 20 mm	100 mm
Memo:	Pipe Material: HDPE Insul. <input checked="" type="checkbox"/> Yes / <input type="checkbox"/> No	PVC Insul. <input checked="" type="checkbox"/> Yes / <input type="checkbox"/> No
	Length from Main to P/L: 8.31 m	11.52 m
	Squirt Test: <input checked="" type="checkbox"/> Pass / <input type="checkbox"/> Fail	N/A
Booster Pump Required: <input type="checkbox"/> Yes / <input checked="" type="checkbox"/> No	Frost Protection: Aquaflo / <input checked="" type="checkbox"/> Recirc / Heat Trace / Bleeder	N/A
PRV Required: <input type="checkbox"/> Yes / <input checked="" type="checkbox"/> No	Greased @ CC: <input checked="" type="checkbox"/> Yes / <input type="checkbox"/> No	N/A
Water Meter Installed: <input type="checkbox"/> Yes / <input checked="" type="checkbox"/> No	Continuity Test: <input checked="" type="checkbox"/> N/A / <input type="checkbox"/> Pass / <input type="checkbox"/> Fail	N/A

CLEARLY INDICATE LOCATION OF CC AND ROUTE OF PIPES ON DRAWING BELOW

1. Show main valves required to isolate this service. 2. All dimensions to be tied to property line 3. All dimensions to be metric 4. Depth @ property line is based on elevation after construction and changes may have occurred.

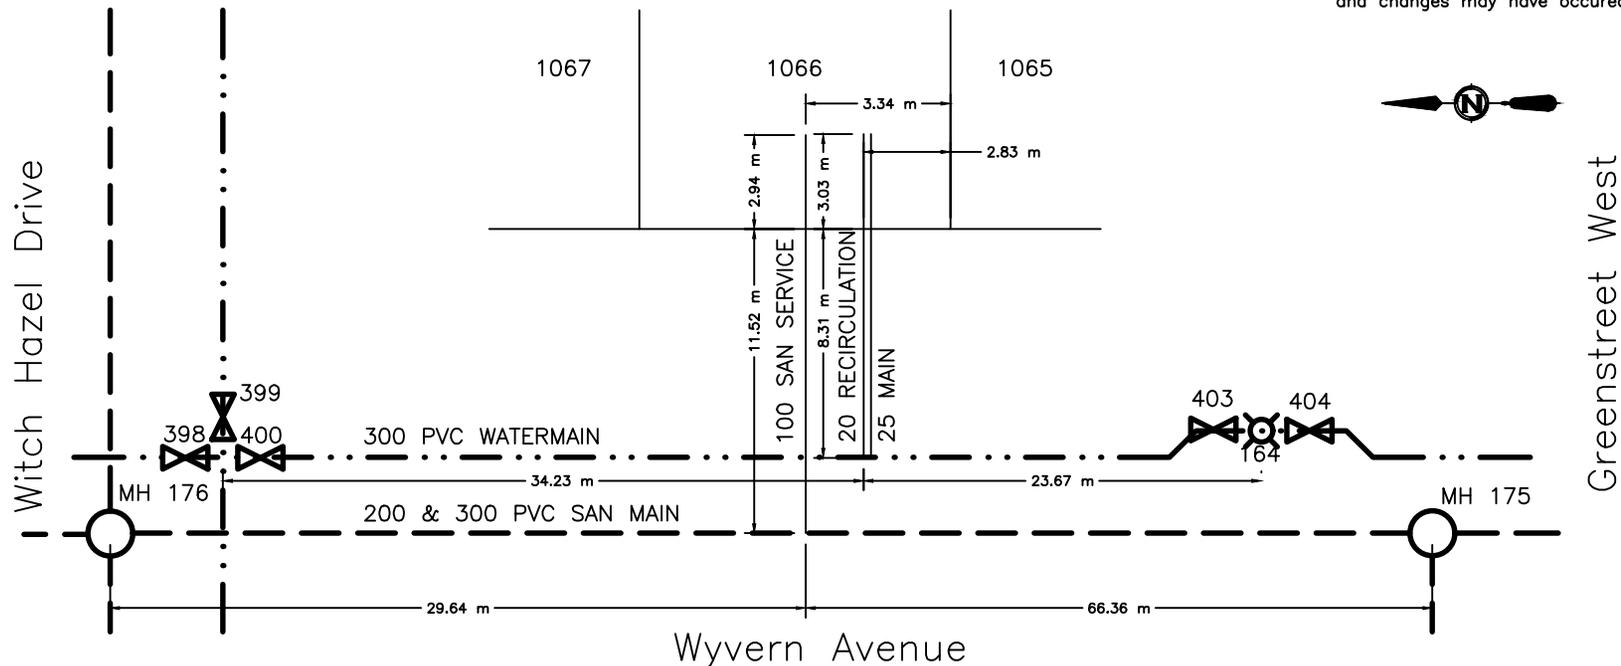



CITY OF WHITEHORSE SERVICE CONNECTION RECORD

FIELD BOOK


No.

ADDRESS 59 Wyvern Avenue BLOCK LOT 1067

DATES	WATER	SEWER
On at Main 2020-JUL-31	Depth at P/L: 2.58 m	2.62 m
On at Building	Depth at Main: 3.12 m	3.33 m
Frost Plug:	Pipe Size: 25 mm / 20 mm	100 mm
Memo:	Pipe Material: HDPE Insul. <input checked="" type="checkbox"/> Yes / <input type="checkbox"/> No	PVC Insul. Yes / <input checked="" type="checkbox"/> No
	Length from Main to P/L: 8.35 m	11.55 m
	Squirt Test: <input checked="" type="checkbox"/> Pass / <input type="checkbox"/> Fail	N/A
Booster Pump Required: Yes / <input type="checkbox"/> No	Frost Protection: Aquaflo / <input checked="" type="checkbox"/> Recirc / Heat Trace / Bleeder	N/A
PRV Required: Yes / <input type="checkbox"/> No	Greased @ CC: <input checked="" type="checkbox"/> Yes / <input type="checkbox"/> No	N/A
Water Meter Installed: Yes / <input type="checkbox"/> No	Continuity Test: <input checked="" type="checkbox"/> N/A / <input type="checkbox"/> Pass / <input type="checkbox"/> Fail	N/A

CLEARLY INDICATE LOCATION OF CC AND ROUTE OF PIPES ON DRAWING BELOW

1. Show main valves required to isolate this service. 2. All dimensions to be tied to property line 3. All dimensions to be metric 4. Depth @ property line is based on elevation after construction and changes may have occurred.

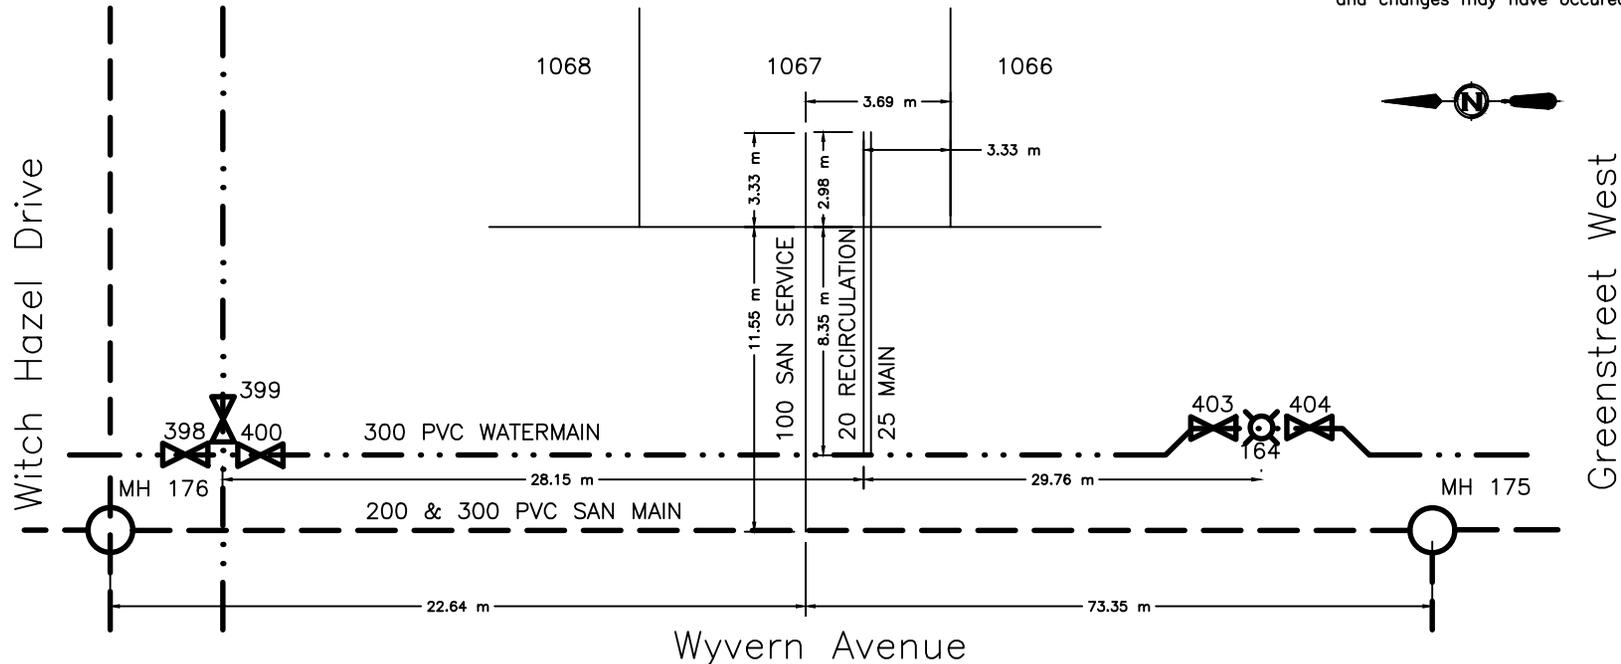



CITY OF WHITEHORSE SERVICE CONNECTION RECORD

FIELD BOOK


No.

ADDRESS 61 Wyvern Avenue BLOCK LOT 1068

DATES		WATER		SEWER	
On at Main 2020-JUL-28		Depth at P/L: 2.72 m		2.70 m	
On at Building		Depth at Main: 3.13 m		3.29 m	
Frost Plug:		Pipe Size: 20 mm / 25 mm		100 mm	
Memo:		Pipe Material: HDPE Insul. <input checked="" type="checkbox"/> Yes / <input type="checkbox"/> No		PVC Insul. <input checked="" type="checkbox"/> Yes / <input type="checkbox"/> No	
		Length from Main to P/L: 8.35 m		11.51 m	
		Squirt Test: <input checked="" type="checkbox"/> Pass / <input type="checkbox"/> Fail		N/A	
Booster Pump Required: <input type="checkbox"/> Yes / <input type="checkbox"/> No		Frost Protection: <input checked="" type="checkbox"/> Aquaflow / <input checked="" type="checkbox"/> Recirc / <input type="checkbox"/> Heat Trace / <input type="checkbox"/> Bleeder		N/A	
PRV Required: <input type="checkbox"/> Yes / <input type="checkbox"/> No		Greased @ CC: <input checked="" type="checkbox"/> Yes / <input type="checkbox"/> No		N/A	
Water Meter Installed: <input type="checkbox"/> Yes / <input type="checkbox"/> No		Continuity Test: <input checked="" type="checkbox"/> N/A <input type="checkbox"/> Pass / <input type="checkbox"/> Fail		N/A	

CLEARLY INDICATE LOCATION OF CC AND ROUTE OF PIPES ON DRAWING BELOW

1. Show main valves required to isolate this service. 2. All dimensions to be tied to property line 3. All dimensions to be metric 4. Depth @ property line is based on elevation after construction and changes may have occurred.

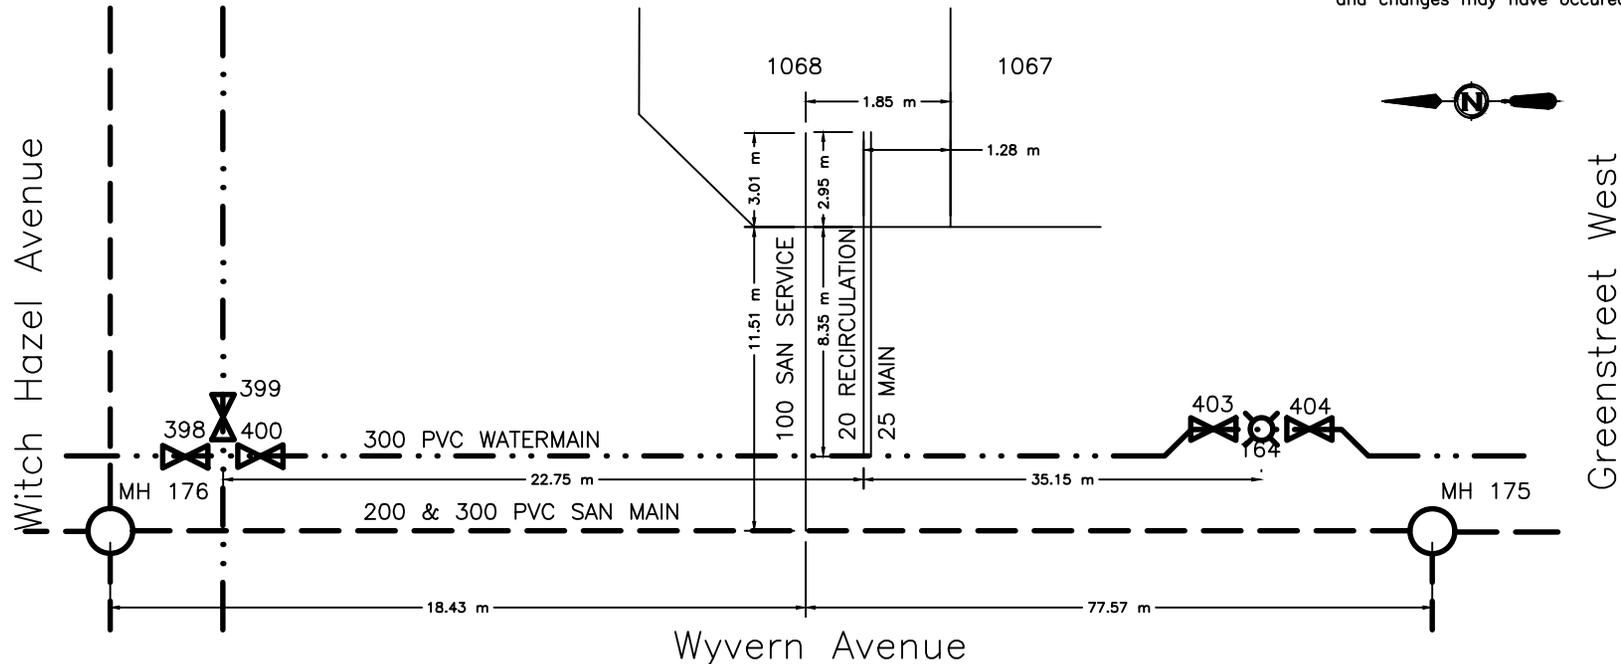



CITY OF WHITEHORSE SERVICE CONNECTION RECORD

FIELD BOOK


No.

ADDRESS 226 Witch Hazel Drive BLOCK LOT 1069

DATES		WATER		SEWER		
On at Main	2020-AUG-01	Depth at P/L:	2.40 m		2.45 m	
On at Building		Depth at Main:	3.06 m		2.82 m	
Frost Plug:		Pipe Size:	25 mm / 20 mm		100 mm	
Memo:		Pipe Material:	HDPE	Insul. <input checked="" type="checkbox"/> Yes / <input type="checkbox"/> No	PVC	Insul. <input checked="" type="checkbox"/> Yes / <input type="checkbox"/> No
		Length from Main to P/L:	15.12 m		12.12 m	
		Squirt Test:	<input checked="" type="checkbox"/> Pass / <input type="checkbox"/> Fail		N/A	
Booster Pump Required:	<input type="checkbox"/> Yes / <input type="checkbox"/> No	Frost Protection:	Aquaflow / <input checked="" type="checkbox"/> Recirc / Heat Trace / Bleeder		N/A	
PRV Required:	<input type="checkbox"/> Yes / <input type="checkbox"/> No	Greased @ CC:	<input checked="" type="checkbox"/> Yes / <input type="checkbox"/> No		N/A	
Water Meter Installed:	<input type="checkbox"/> Yes / <input type="checkbox"/> No	Continuity Test:	<input checked="" type="checkbox"/> N/A / <input type="checkbox"/> Pass / <input type="checkbox"/> Fail		N/A	

CLEARLY INDICATE LOCATION OF CC AND ROUTE OF PIPES ON DRAWING BELOW

1. Show main valves required to isolate this service. 2. All dimensions to be tied to property line 3. All dimensions to be metric 4. Depth @ property line is based on elevation after construction and changes may have occurred.

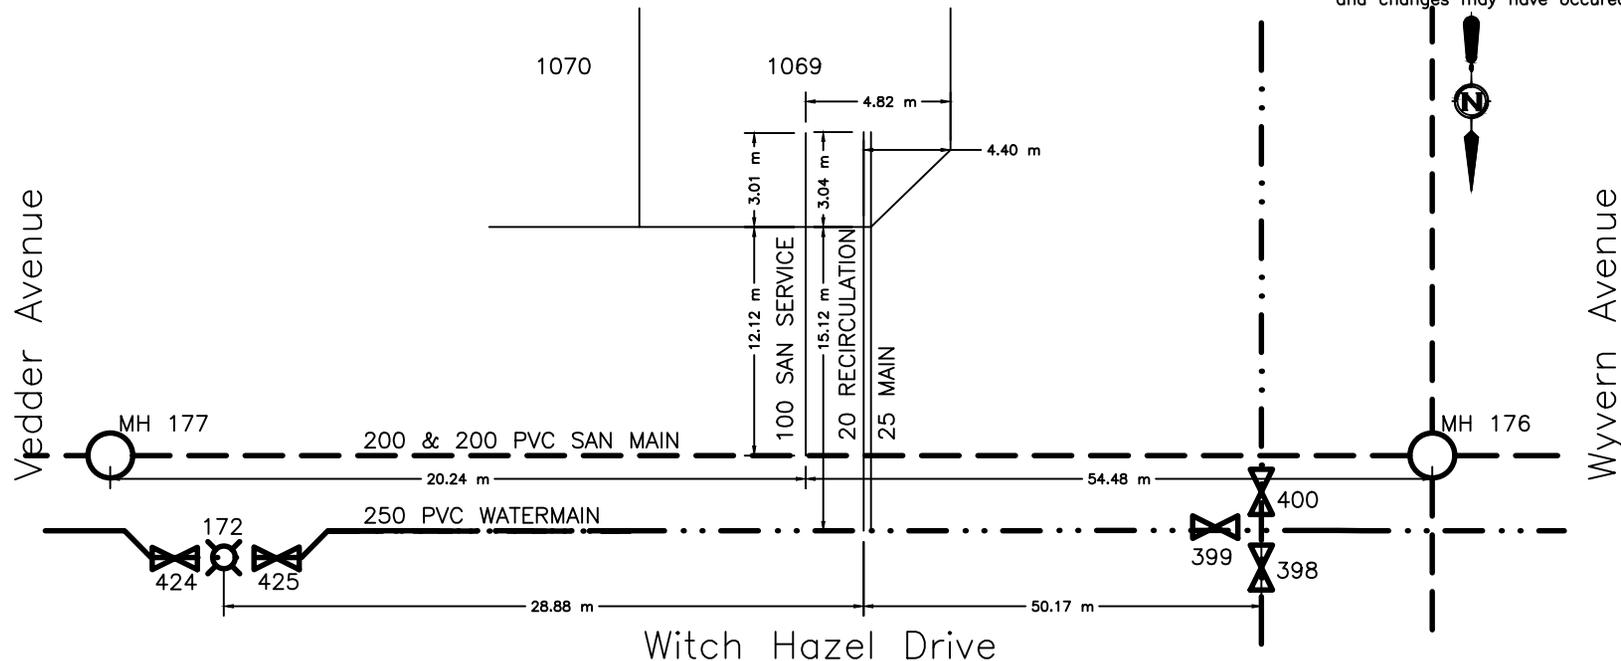



CITY OF WHITEHORSE SERVICE CONNECTION RECORD

FIELD BOOK


No.

ADDRESS 224 Witch Hazel Drive BLOCK LOT 1070

DATES		WATER		SEWER
On at Main 2020-JUL-28		Depth at P/L: 2.32 m		2.25 m
On at Building		Depth at Main: 2.84 m		2.80 m
Frost Plug:		Pipe Size: 25 mm / 20 mm		100 mm
Memo:		Pipe Material: HDPE Insul. <input checked="" type="checkbox"/> Yes/No		PVC Insul. <input checked="" type="checkbox"/> Yes/No
		Length from Main to P/L: 14.62 m		12.07 m
		Squirt Test: <input checked="" type="checkbox"/> Pass/Fail		N/A
Booster Pump Required:	Yes/No	Frost Protection: Aquaflo/ <input checked="" type="checkbox"/> Recirc/Heat Trace/Bleeder		N/A
PRV Required:	Yes/No	Greased @ CC: <input checked="" type="checkbox"/> Yes/No		N/A
Water Meter Installed:	Yes/No	Continuity Test: <input checked="" type="checkbox"/> N/A Pass/Fail		N/A

CLEARLY INDICATE LOCATION OF CC AND ROUTE OF PIPES ON DRAWING BELOW

1. Show main valves required to isolate this service. 2. All dimensions to be tied to property line 3. All dimensions to be metric 4. Depth @ property line is based on elevation after construction and changes may have occurred.

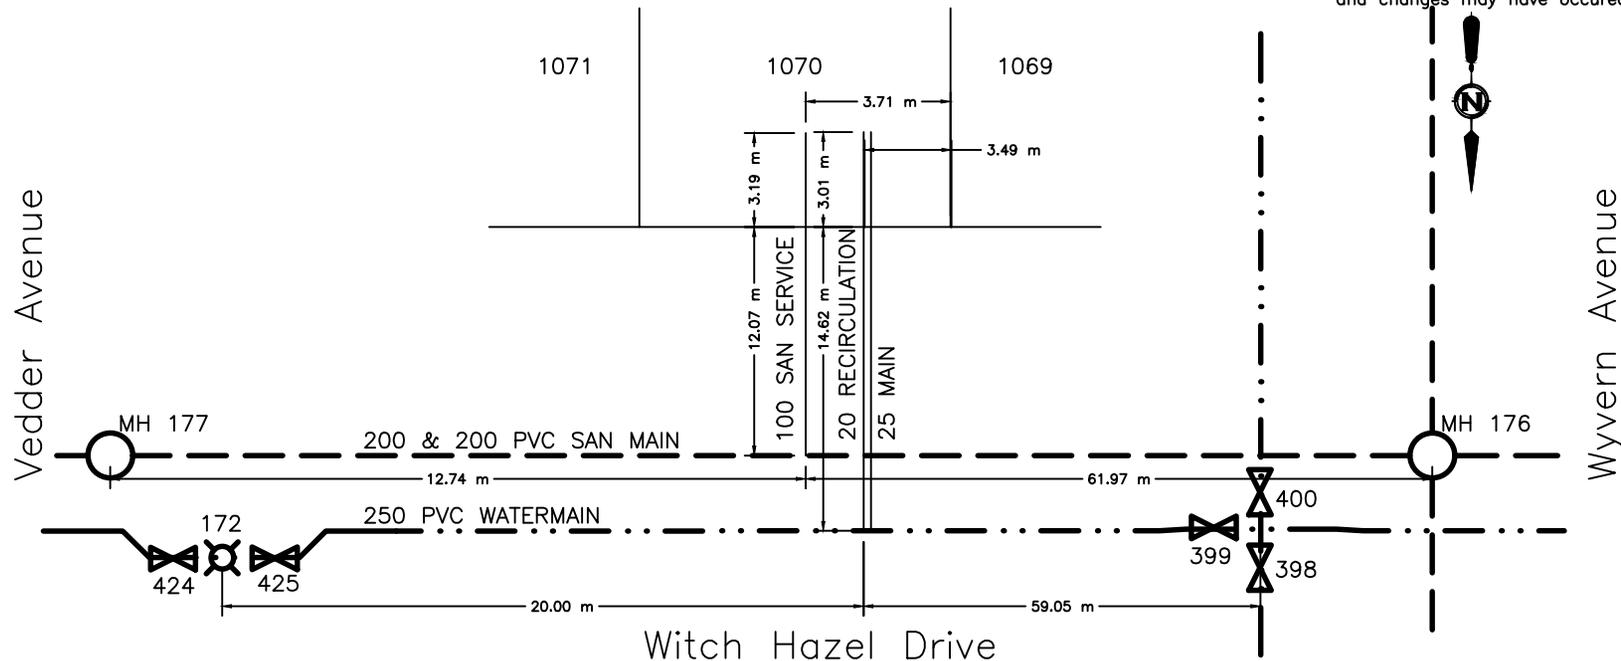



CITY OF WHITEHORSE SERVICE CONNECTION RECORD

FIELD BOOK


No.

ADDRESS 222 Witch Hazel Drive BLOCK LOT 1071

DATES		WATER		SEWER
On at Main	2020-AUG-03	Depth at P/L:	2.33 m	2.35 m
On at Building		Depth at Main:	3.08 m	2.81 m
Frost Plug:		Pipe Size:	25 mm / 20 mm	100 mm
Memo:		Pipe Material:	HDPE	PVC
		Insul.:	(Yes/No)	Insul. (Yes/No)
		Length from Main to P/L:	15.09 m	12.09 m
		Squirt Test:	(Pass/Fail)	N/A
Booster Pump Required:	Yes/No	Frost Protection:	Aquaflow/Recirc/Heat Trace/Bleeder	N/A
PRV Required:	Yes/No	Greased @ CC:	(Yes/No)	N/A
Water Meter Installed:	Yes/No	Continuity Test:	(N/A) Pass/Fail	N/A

CLEARLY INDICATE LOCATION OF CC AND ROUTE OF PIPES ON DRAWING BELOW

1. Show main valves required to isolate this service. 2. All dimensions to be tied to property line 3. All dimensions to be metric 4. Depth @ property line is based on elevation after construction and changes may have occurred.

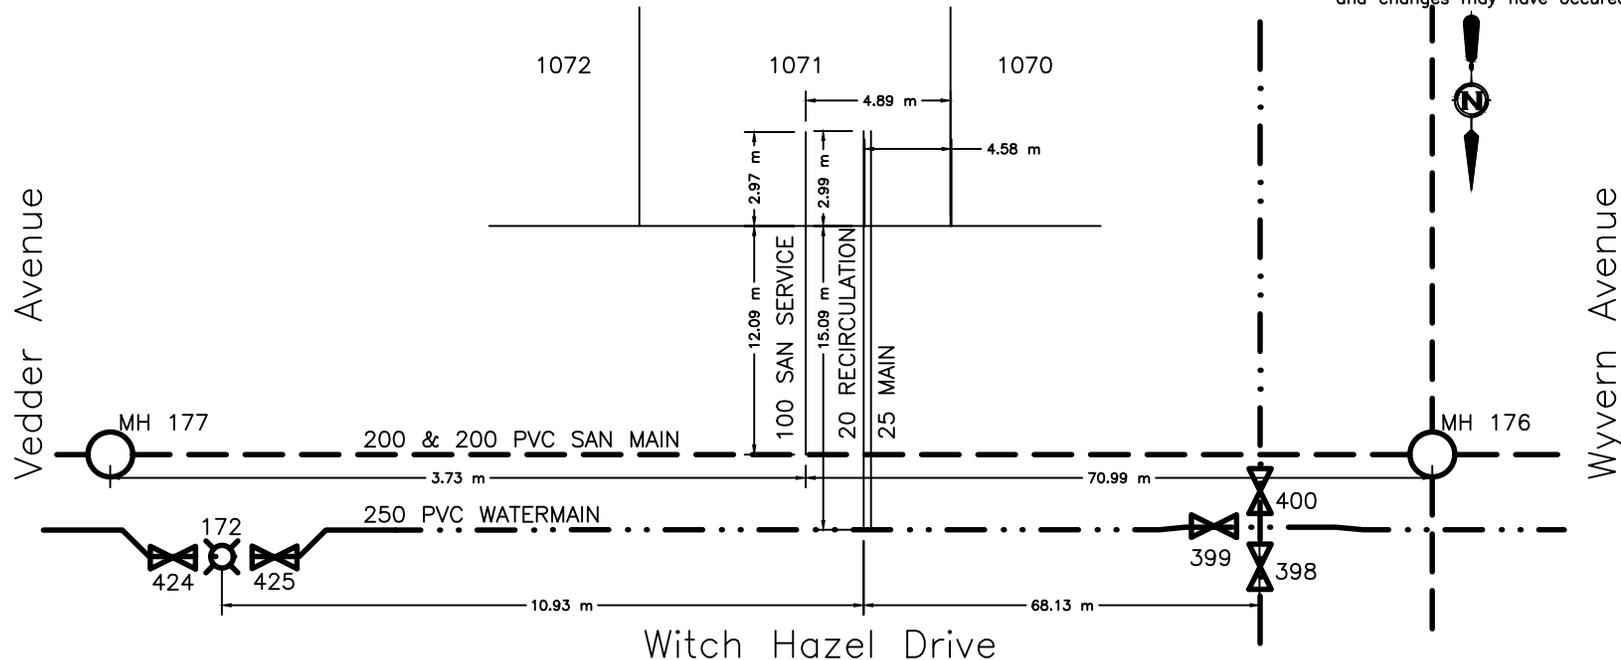



CITY OF WHITEHORSE SERVICE CONNECTION RECORD

FIELD BOOK


No.

ADDRESS 220 Witch Hazel Drive BLOCK LOT 1072

DATES		WATER		SEWER
On at Main 2020-JUL-30		Depth at P/L: 2.74 m	2.79 m	
On at Building		Depth at Main: 3.08 m	3.24 m	
Frost Plug:		Pipe Size: 25 mm / 20 mm	100 mm	
Memo:		Pipe Material: HDPE	Insul. <input checked="" type="checkbox"/> Yes / <input type="checkbox"/> No	PVC
		Length from Main to P/L: 15.17 m		12.18 m
		Squirt Test: <input checked="" type="checkbox"/> Pass / <input type="checkbox"/> Fail		N/A
Booster Pump Required:	<input type="checkbox"/> Yes / <input type="checkbox"/> No	Frost Protection: <input checked="" type="checkbox"/> Aquaflow / <input checked="" type="checkbox"/> Recirc / <input type="checkbox"/> Heat Trace / <input type="checkbox"/> Bleeder		N/A
PRV Required:	<input type="checkbox"/> Yes / <input type="checkbox"/> No	Greased @ CC: <input checked="" type="checkbox"/> Yes / <input type="checkbox"/> No		N/A
Water Meter Installed:	<input type="checkbox"/> Yes / <input type="checkbox"/> No	Continuity Test: <input checked="" type="checkbox"/> N/A / <input type="checkbox"/> Pass / <input type="checkbox"/> Fail		N/A

CLEARLY INDICATE LOCATION OF CC AND ROUTE OF PIPES ON DRAWING BELOW

1. Show main valves required to isolate this service. 2. All dimensions to be tied to property line 3. All dimensions to be metric 4. Depth @ property line is based on elevation after construction and changes may have occurred.

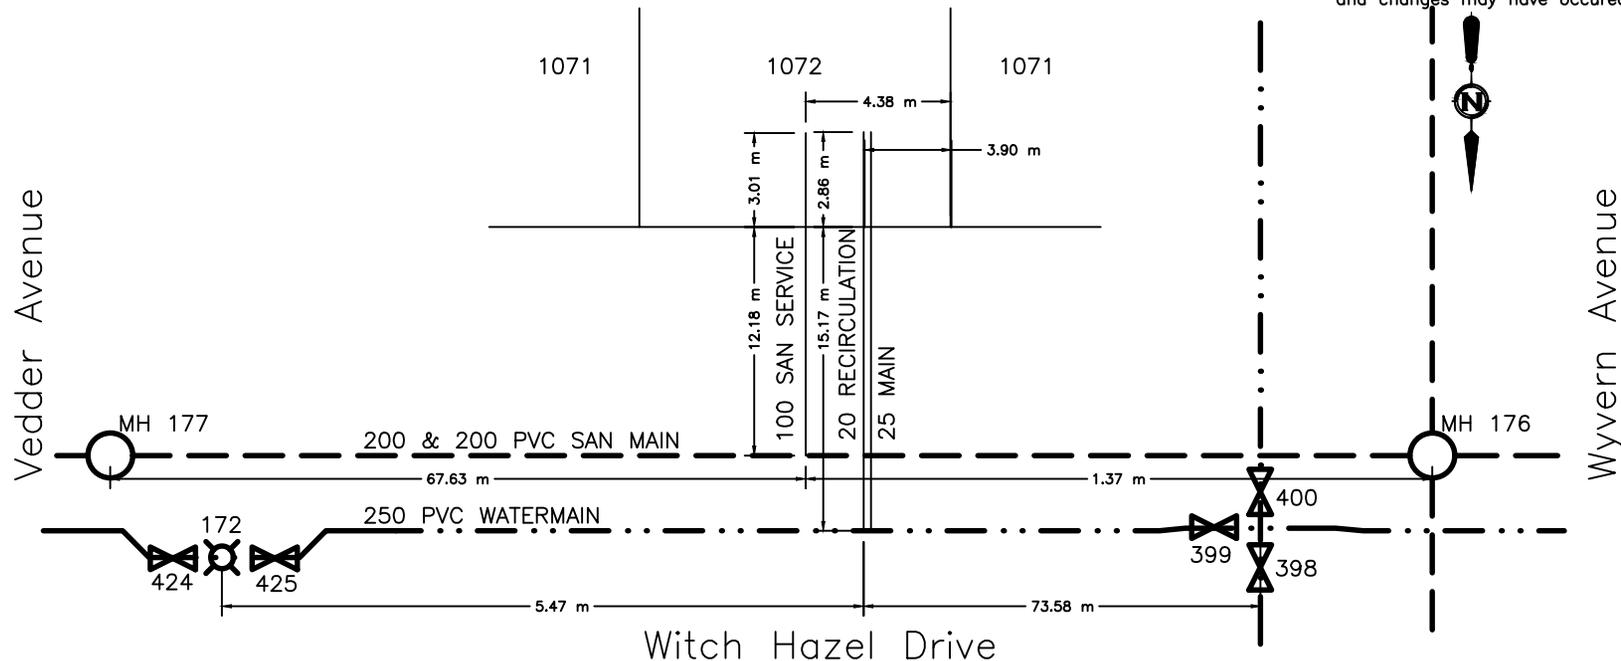



CITY OF WHITEHORSE SERVICE CONNECTION RECORD

FIELD BOOK


No.

ADDRESS 218 Witch Hazel Drive BLOCK LOT 1073

DATES		WATER		SEWER
On at Main 2020-JUL-27		Depth at P/L: 2.76 m		2.90 m
On at Building		Depth at Main: 3.05 m		3.23 m
Frost Plug:		Pipe Size: 25 mm / 20 mm		100 mm
Memo:		Pipe Material: HDPE Insul. <input checked="" type="checkbox"/> Yes / <input type="checkbox"/> No		PVC Insul. <input checked="" type="checkbox"/> Yes / <input type="checkbox"/> No
		Length from Main to P/L: 15.05 m		12.16 m
		Squirt Test: <input checked="" type="checkbox"/> Pass / <input type="checkbox"/> Fail		N/A
Booster Pump Required:	<input type="checkbox"/> Yes / <input type="checkbox"/> No	Frost Protection: Aquaflo / <input checked="" type="checkbox"/> Recirc / Heat Trace / Bleeder		N/A
PRV Required:	<input type="checkbox"/> Yes / <input type="checkbox"/> No	Greased @ CC: <input checked="" type="checkbox"/> Yes / <input type="checkbox"/> No		N/A
Water Meter Installed:	<input type="checkbox"/> Yes / <input type="checkbox"/> No	Continuity Test: <input checked="" type="checkbox"/> N/A <input type="checkbox"/> Pass / <input type="checkbox"/> Fail		N/A

CLEARLY INDICATE LOCATION OF CC AND ROUTE OF PIPES ON DRAWING BELOW

1. Show main valves required to isolate this service. 2. All dimensions to be tied to property line 3. All dimensions to be metric 4. Depth @ property line is based on elevation after construction and changes may have occurred.

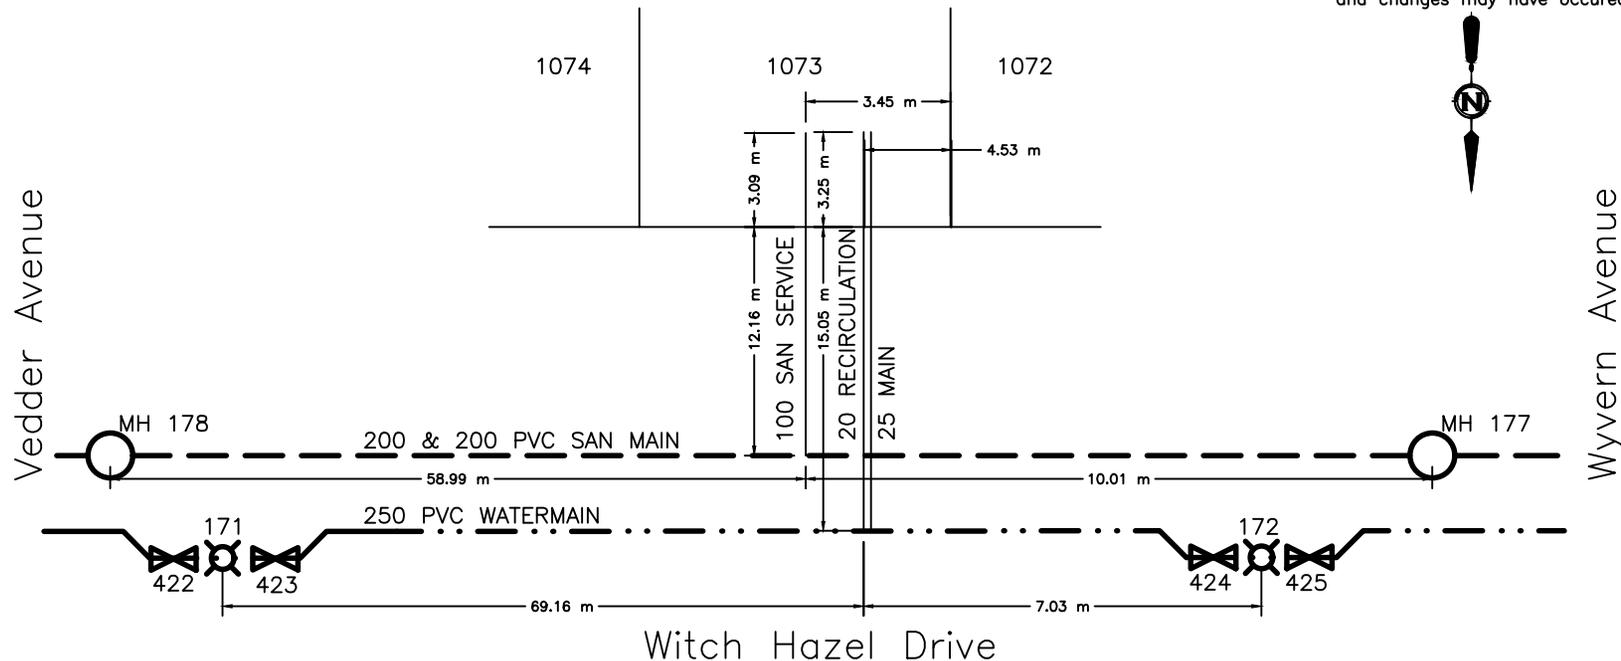



CITY OF WHITEHORSE SERVICE CONNECTION RECORD

FIELD BOOK


No.

ADDRESS 216 Witch Hazel Drive BLOCK LOT 1074

DATES		WATER		SEWER
On at Main 2020-JUL-31		Depth at P/L: 2.78 m	2.81 m	
On at Building		Depth at Main: 3.13 m	3.20 m	
Frost Plug:		Pipe Size: 25 mm / 20 mm	100 mm	
Memo:		Pipe Material: HDPE	Insul. <input checked="" type="checkbox"/> Yes / <input type="checkbox"/> No	PVC
		Length from Main to P/L: 15.09 m		12.08 m
		Squirt Test: <input checked="" type="checkbox"/> Pass / <input type="checkbox"/> Fail		N/A
Booster Pump Required:	<input type="checkbox"/> Yes / <input type="checkbox"/> No	Frost Protection: Aquaflo / <input checked="" type="checkbox"/> Recirc / Heat Trace / Bleeder	N/A	
PRV Required:	<input type="checkbox"/> Yes / <input type="checkbox"/> No	Greased @ CC: <input checked="" type="checkbox"/> Yes / <input type="checkbox"/> No	N/A	
Water Meter Installed:	<input type="checkbox"/> Yes / <input type="checkbox"/> No	Continuity Test: <input checked="" type="checkbox"/> N/A	Pass / Fail	N/A

CLEARLY INDICATE LOCATION OF CC AND ROUTE OF PIPES ON DRAWING BELOW

1. Show main valves required to isolate this service. 2. All dimensions to be tied to property line 3. All dimensions to be metric 4. Depth @ property line is based on elevation after construction and changes may have occurred.

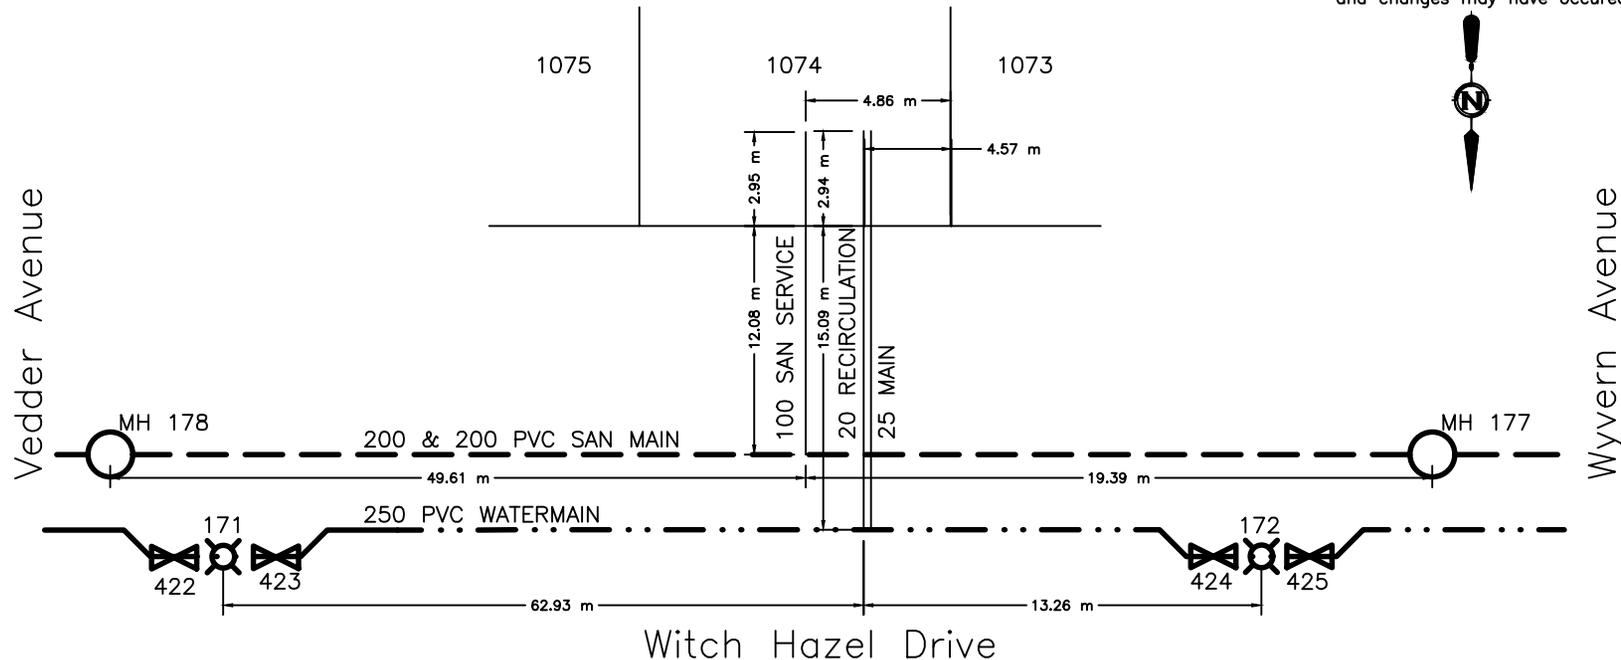



CITY OF WHITEHORSE SERVICE CONNECTION RECORD

FIELD BOOK


No.

ADDRESS 214 Witch Hazel Drive BLOCK LOT 1075

DATES		WATER		SEWER
On at Main	2020-JUL-30	Depth at P/L:	2.72 m	2.75 m
On at Building		Depth at Main:	3.09 m	3.21 m
Frost Plug:		Pipe Size:	25 mm / 20 mm	100 mm
Memo:		Pipe Material:	HDPE	PVC
		Insul.:	(Yes)/No	Insul. (Yes)/(No)
		Length from Main to P/L:	15.07 m	12.09 m
		Squirt Test:	(Pass)/Fail	N/A
Booster Pump Required:	Yes/No	Frost Protection:	Aquaflow/(Recirc)/Heat Trace/Bleeder	N/A
PRV Required:	Yes/No	Greased @ CC:	(Yes)/No	N/A
Water Meter Installed:	Yes/No	Continuity Test:	(N/A) Pass/Fail	N/A

CLEARLY INDICATE LOCATION OF CC AND ROUTE OF PIPES ON DRAWING BELOW

1. Show main valves required to isolate this service. 2. All dimensions to be tied to property line 3. All dimensions to be metric 4. Depth @ property line is based on elevation after construction and changes may have occurred.

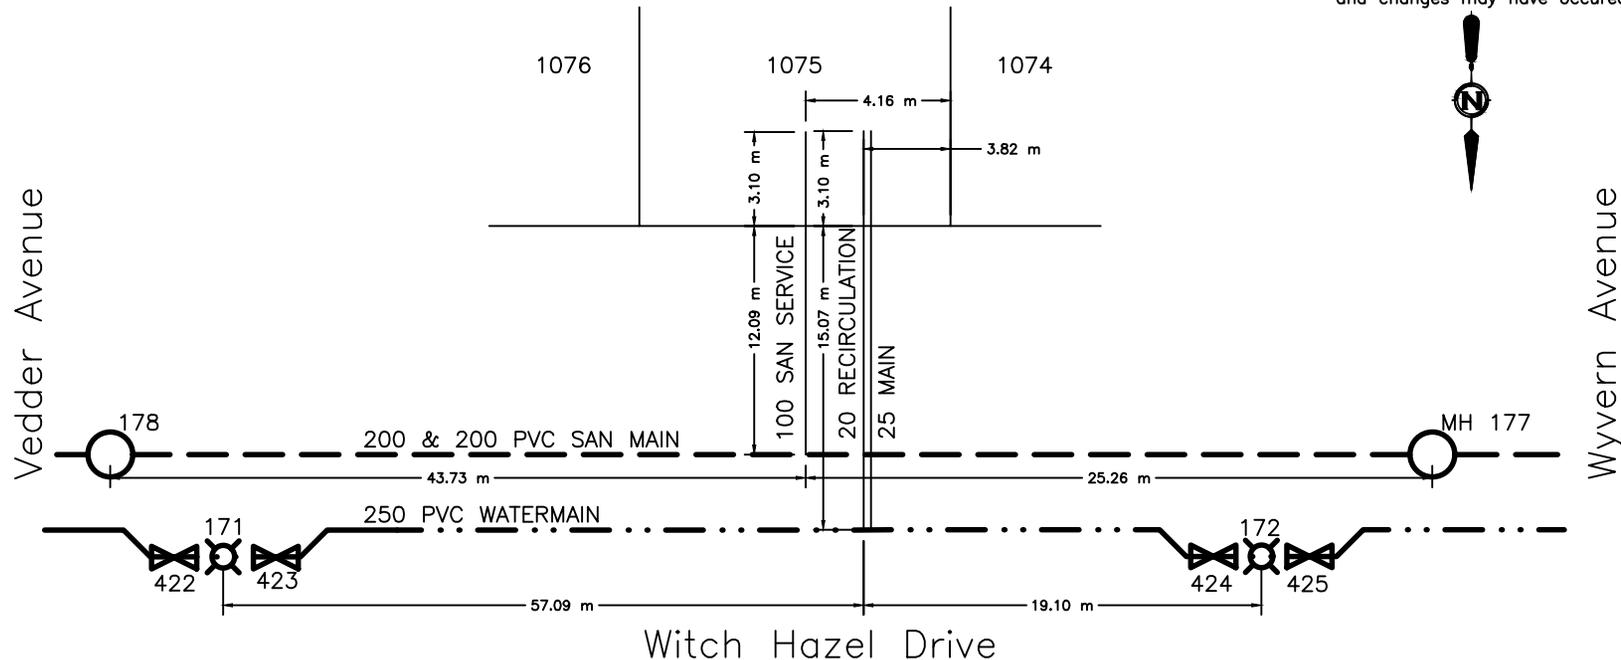



CITY OF WHITEHORSE SERVICE CONNECTION RECORD

FIELD BOOK


No.

ADDRESS 212 Witch Hazel Drive BLOCK LOT 1076

DATES		WATER		SEWER
On at Main	2020-JUL-25	Depth at P/L:	2.70 m	2.75 m
On at Building		Depth at Main:	3.10 m	3.19 m
Frost Plug:		Pipe Size:	25 mm / 20 mm	100 mm
Memo:		Pipe Material:	HDPE Insul. <input checked="" type="checkbox"/> Yes/ <input type="checkbox"/> No	PVC Insul. <input checked="" type="checkbox"/> Yes/ <input type="checkbox"/> No
		Length from Main to P/L:	15.01 m	12.01 m
		Squirt Test:	<input checked="" type="checkbox"/> Pass/ <input type="checkbox"/> Fail	N/A
Booster Pump Required:	<input type="checkbox"/> Yes/ <input type="checkbox"/> No	Frost Protection:	Aquaflow/ <input checked="" type="checkbox"/> Recirc/Heat Trace/Bleeder	N/A
PRV Required:	<input type="checkbox"/> Yes/ <input type="checkbox"/> No	Greased @ CC:	<input checked="" type="checkbox"/> Yes/ <input type="checkbox"/> No	N/A
Water Meter Installed:	<input type="checkbox"/> Yes/ <input type="checkbox"/> No	Continuity Test:	<input checked="" type="checkbox"/> N/A <input type="checkbox"/> Pass/ <input type="checkbox"/> Fail	N/A

CLEARLY INDICATE LOCATION OF CC AND ROUTE OF PIPES ON DRAWING BELOW

1. Show main valves required to isolate this service. 2. All dimensions to be tied to property line 3. All dimensions to be metric 4. Depth @ property line is based on elevation after construction and changes may have occurred.

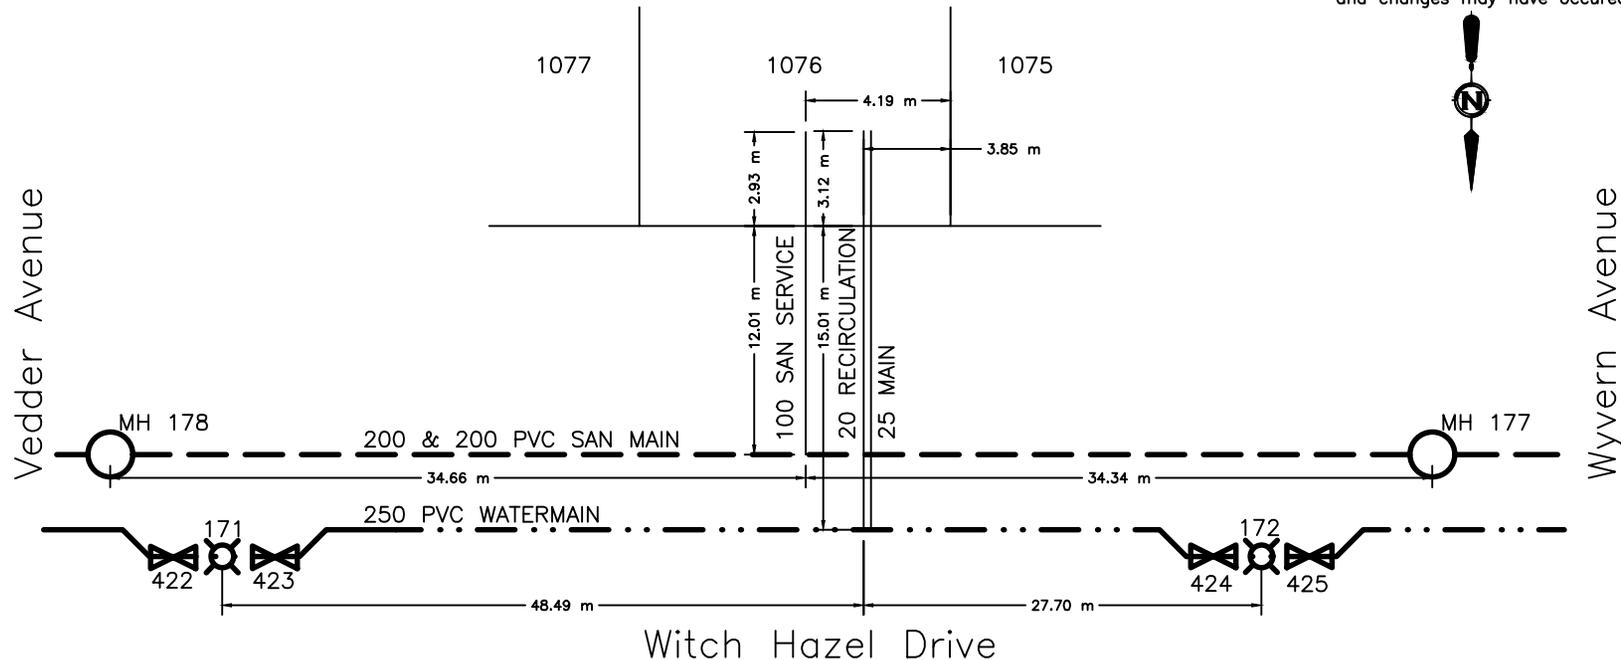



CITY OF WHITEHORSE SERVICE CONNECTION RECORD

FIELD BOOK


No.

ADDRESS 210 Witch Hazel Drive BLOCK LOT 1077

DATES		WATER		SEWER
On at Main 2020-JUL-31		Depth at P/L: 2.70 m	2.75 m	
On at Building		Depth at Main: 3.10 m	3.19 m	
Frost Plug:		Pipe Size: 25 mm / 20 mm	100 mm	
Memo:		Pipe Material: HDPE	Insul. <input checked="" type="checkbox"/> Yes / <input type="checkbox"/> No	PVC
		Length from Main to P/L: 15.04 m		12.10 m
		Squirt Test: <input checked="" type="checkbox"/> Pass / <input type="checkbox"/> Fail		N/A
Booster Pump Required:	<input type="checkbox"/> Yes / <input type="checkbox"/> No	Frost Protection: Aquaflo / <input checked="" type="checkbox"/> Recirc / Heat Trace / Bleeder	N/A	
PRV Required:	<input type="checkbox"/> Yes / <input type="checkbox"/> No	Greased @ CC: <input checked="" type="checkbox"/> Yes / <input type="checkbox"/> No	N/A	
Water Meter Installed:	<input type="checkbox"/> Yes / <input type="checkbox"/> No	Continuity Test: <input type="checkbox"/> N/A	Pass / Fail	N/A

CLEARLY INDICATE LOCATION OF CC AND ROUTE OF PIPES ON DRAWING BELOW

1. Show main valves required to isolate this service. 2. All dimensions to be tied to property line 3. All dimensions to be metric 4. Depth @ property line is based on elevation after construction and changes may have occurred.

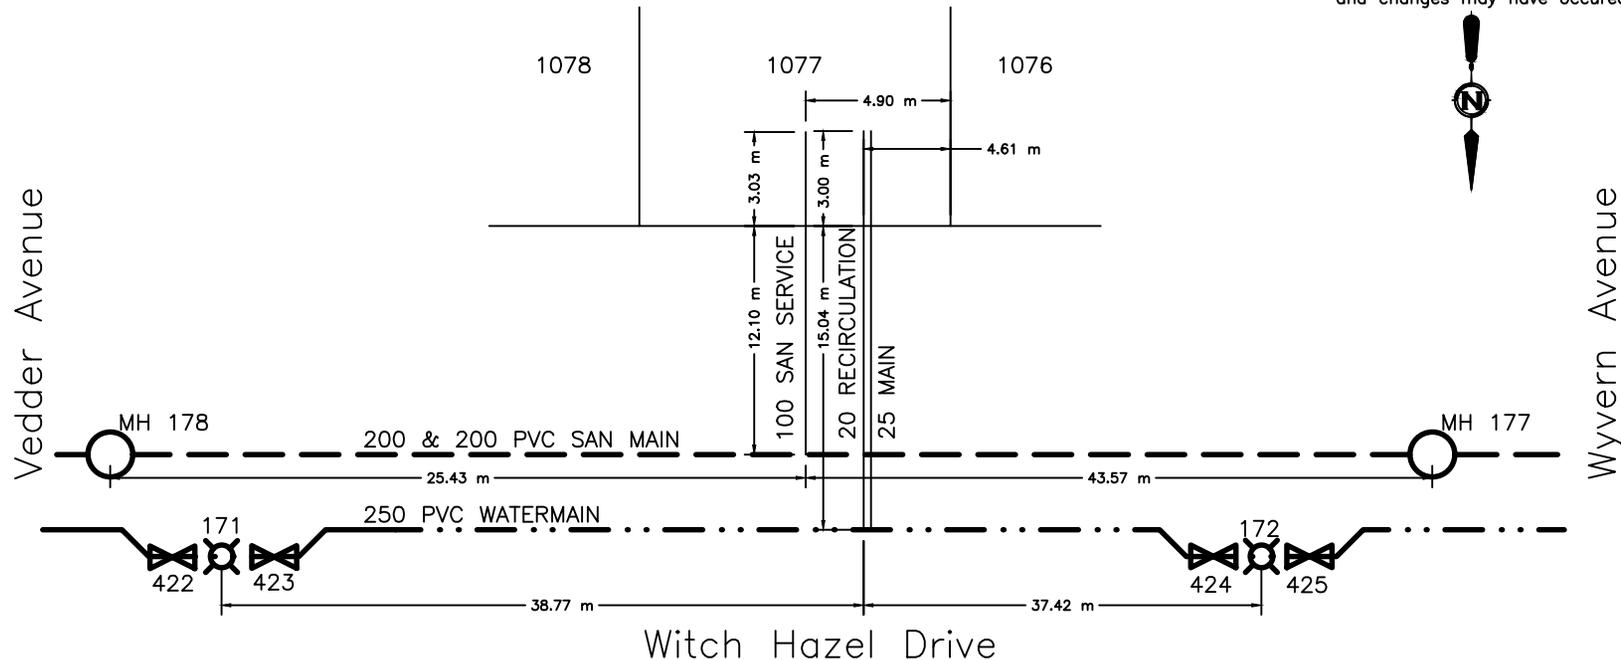



CITY OF WHITEHORSE SERVICE CONNECTION RECORD

FIELD BOOK


No.

ADDRESS 208 Witch Hazel Drive BLOCK LOT 1078

DATES		WATER		SEWER
On at Main 2020-JUL-30		Depth at P/L: 2.68 m	2.74 m	
On at Building		Depth at Main: 3.11 m	3.18 m	
Frost Plug:		Pipe Size: 25 mm / 20 mm	100 mm	
Memo:		Pipe Material: HDPE	Insul. <input checked="" type="checkbox"/> Yes / <input type="checkbox"/> No	PVC
		Length from Main to P/L: 15.01 m		12.11 m
		Squirt Test: <input checked="" type="checkbox"/> Pass / <input type="checkbox"/> Fail		N/A
Booster Pump Required:	<input type="checkbox"/> Yes / <input type="checkbox"/> No	Frost Protection: Aquaflo / <input checked="" type="checkbox"/> Recirc / Heat Trace / Bleeder		N/A
PRV Required:	<input type="checkbox"/> Yes / <input type="checkbox"/> No	Greased @ CC: <input checked="" type="checkbox"/> Yes / <input type="checkbox"/> No		N/A
Water Meter Installed:	<input type="checkbox"/> Yes / <input type="checkbox"/> No	Continuity Test: <input type="checkbox"/> N/A / <input type="checkbox"/> Pass / <input type="checkbox"/> Fail		N/A

CLEARLY INDICATE LOCATION OF CC AND ROUTE OF PIPES ON DRAWING BELOW

1. Show main valves required to isolate this service. 2. All dimensions to be tied to property line 3. All dimensions to be metric 4. Depth @ property line is based on elevation after construction and changes may have occurred.

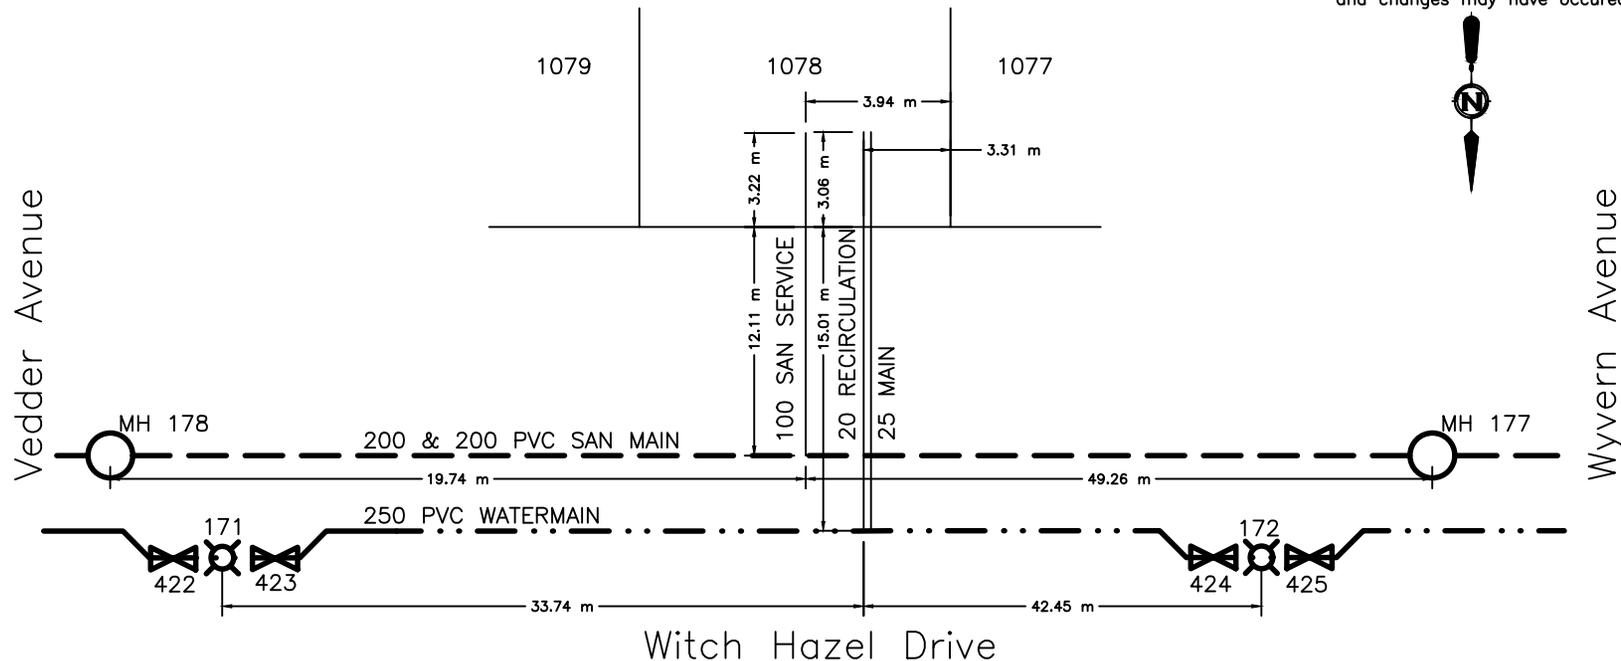



CITY OF WHITEHORSE SERVICE CONNECTION RECORD

FIELD BOOK


No.

ADDRESS 206 Witch Hazel Drive BLOCK LOT 1079

DATES		WATER		SEWER
On at Main 2020-JUL-25		Depth at P/L: 2.73 m	2.84 m	
On at Building		Depth at Main: 3.08 m	3.19 m	
Frost Plug:		Pipe Size: 25 mm / 20 mm	100 mm	
Memo:		Pipe Material: HDPE	Insul. <u>(Yes)</u> /No	PVC
		Length from Main to P/L: 15.04 m	12.07 m	Insul. Yes/ <u>(No)</u>
		Squirt Test:	<u>(Pass)</u> /Fail	N/A
Booster Pump Required:	Yes/No	Frost Protection: Aquaflo/ <u>(Recirc)</u> /Heat Trace/Bleeder		N/A
PRV Required:	Yes/No	Greased @ CC:	<u>(Yes)</u> /No	N/A
Water Meter Installed:	Yes/No	Continuity Test: <u>(N/A)</u>	Pass/Fail	N/A

CLEARLY INDICATE LOCATION OF CC AND ROUTE OF PIPES ON DRAWING BELOW

1. Show main valves required to isolate this service. 2. All dimensions to be tied to property line 3. All dimensions to be metric 4. Depth @ property line is based on elevation after construction and changes may have occurred.

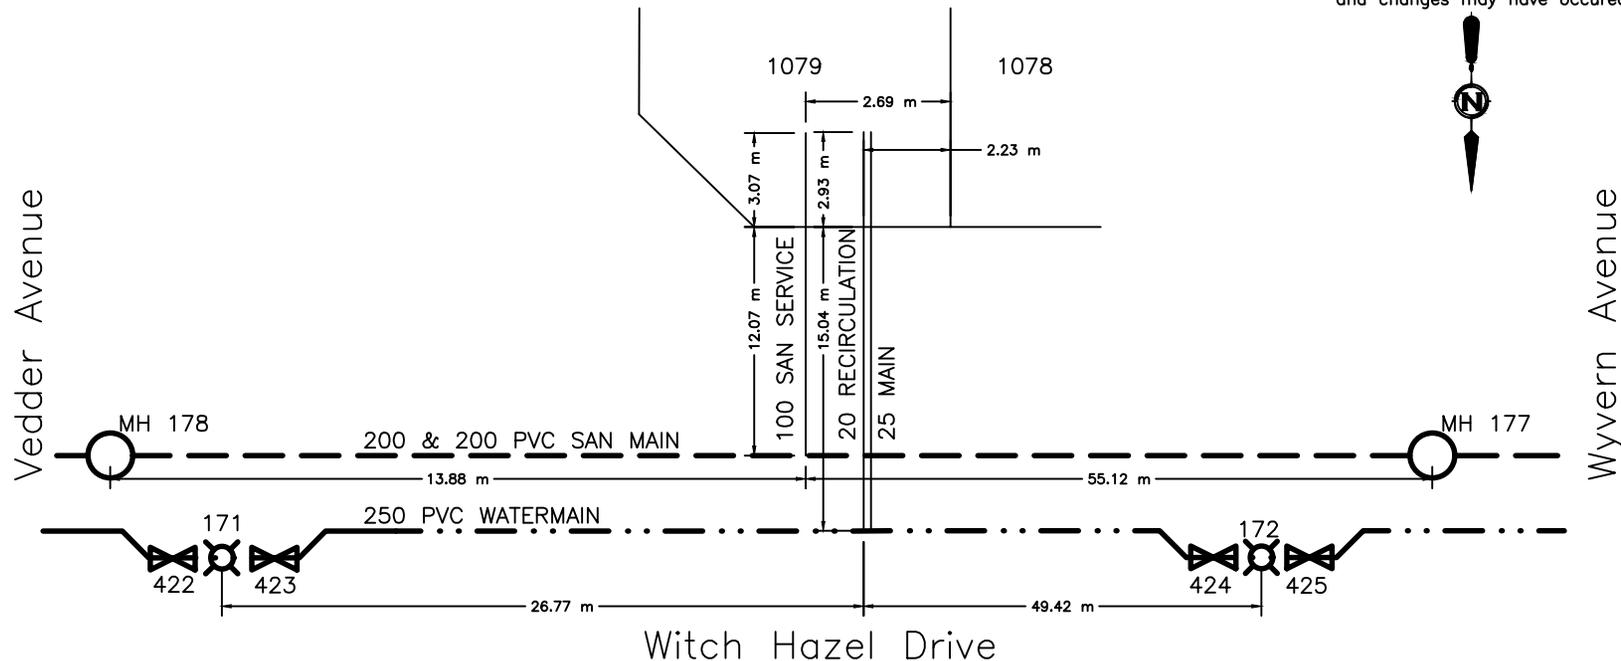



CITY OF WHITEHORSE SERVICE CONNECTION RECORD

FIELD BOOK


No.

ADDRESS 3 Fulton Lane BLOCK LOT 1098

DATES		WATER		SEWER
On at Main	2020-AUG-20	Depth at P/L:	2.83 m	2.90 m
On at Building		Depth at Main:	3.33 m	3.52 m
Frost Plug:		Pipe Size:	25 mm / 20 mm	100 mm
Memo:		Pipe Material:	HDPE	PVC
		Insul.:	(Yes/No)	Insul. (Yes/No)
		Length from Main to P/L:	4.48 m	9.17 m
		Squirt Test:	(Pass/Fail)	N/A
Booster Pump Required:	Yes/No	Frost Protection:	Aquaflow/Recirc/Heat Trace/Bleeder	N/A
PRV Required:	Yes/No	Greased @ CC:	(Yes/No)	N/A
Water Meter Installed:	Yes/No	Continuity Test:	(N/A) Pass/Fail	N/A

CLEARLY INDICATE LOCATION OF CC AND ROUTE OF PIPES ON DRAWING BELOW

1. Show main valves required to isolate this service. 2. All dimensions to be tied to property line 3. All dimensions to be metric 4. Depth @ property line is based on elevation after construction and changes may have occurred.

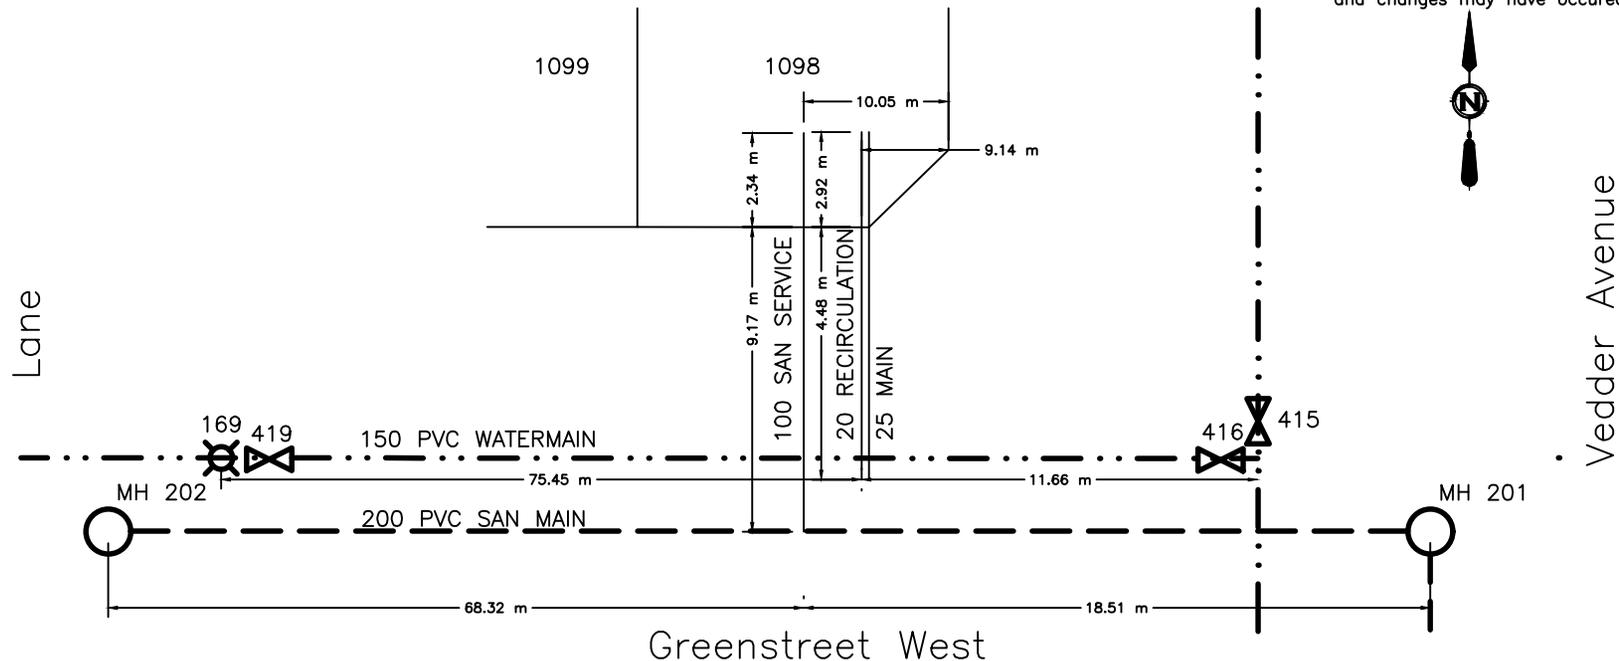



CITY OF WHITEHORSE SERVICE CONNECTION RECORD

FIELD BOOK


No.

ADDRESS 5 Fulton Lane BLOCK LOT 1099

DATES		WATER		SEWER
On at Main 2020-AUG-19		Depth at P/L: 3.05 m	3.09 m	
On at Building		Depth at Main: 3.31 m	3.36 m	
Frost Plug:		Pipe Size: 25 mm / 20 mm	100 mm	
Memo:	Pipe Material: HDPE		Insul. <input checked="" type="checkbox"/> Yes / <input type="checkbox"/> No	PVC
	Length from Main to P/L: 4.52 m		8.40 m	
	Squirt Test:		<input checked="" type="checkbox"/> Pass / <input type="checkbox"/> Fail	
Booster Pump Required:	<input type="checkbox"/> Yes / <input type="checkbox"/> No	Frost Protection: Aquaflo / <input checked="" type="checkbox"/> Recirc / Heat Trace / Bleeder		N/A
PRV Required:	<input type="checkbox"/> Yes / <input type="checkbox"/> No	Greased @ CC: <input checked="" type="checkbox"/> Yes / <input type="checkbox"/> No		N/A
Water Meter Installed:	<input type="checkbox"/> Yes / <input type="checkbox"/> No	Continuity Test: <input type="checkbox"/> N/A		Pass / Fail

CLEARLY INDICATE LOCATION OF CC AND ROUTE OF PIPES ON DRAWING BELOW

1. Show main valves required to isolate this service. 2. All dimensions to be tied to property line 3. All dimensions to be metric 4. Depth @ property line is based on elevation after construction and changes may have occurred.

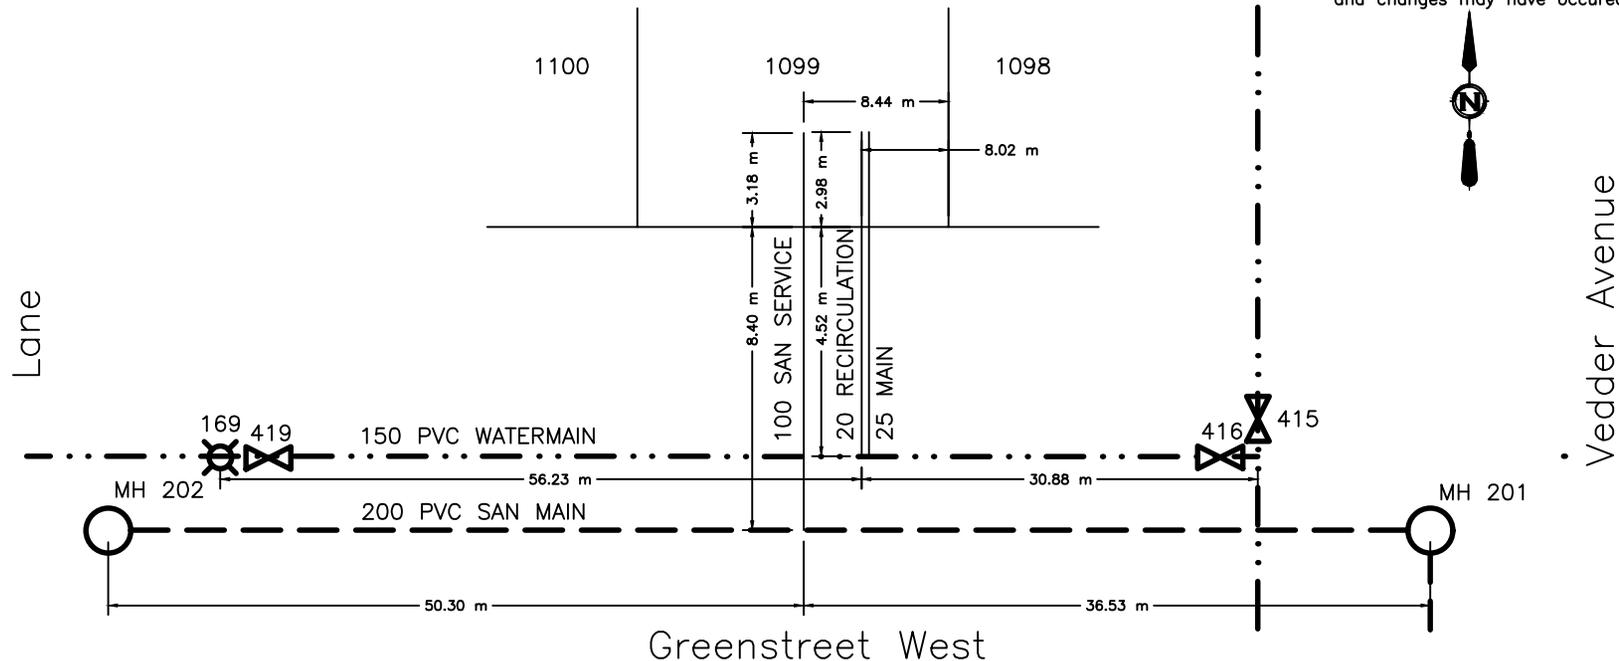



CITY OF WHITEHORSE SERVICE CONNECTION RECORD

FIELD BOOK


No.

ADDRESS 7 Fulton Lane BLOCK LOT 1100

DATES		WATER		SEWER
On at Main	2020-AUG-19	Depth at P/L:	2.89 m	2.99 m
On at Building		Depth at Main:	3.24 m	3.15 m
Frost Plug:		Pipe Size:	25 mm / 20 mm	100 mm
Memo:		Pipe Material:	HDPE Insul. <input checked="" type="checkbox"/> Yes/ <input type="checkbox"/> No	PVC Insul. <input checked="" type="checkbox"/> Yes/ <input type="checkbox"/> No
		Length from Main to P/L:	4.57 m	8.42 m
		Squirt Test:	<input checked="" type="checkbox"/> Pass/ <input type="checkbox"/> Fail	N/A
Booster Pump Required:	<input type="checkbox"/> Yes/ <input type="checkbox"/> No	Frost Protection:	Aquaflow/ <input checked="" type="checkbox"/> Recirc/Heat Trace/Bleeder	N/A
PRV Required:	<input type="checkbox"/> Yes/ <input type="checkbox"/> No	Greased @ CC:	<input checked="" type="checkbox"/> Yes/ <input type="checkbox"/> No	N/A
Water Meter Installed:	<input type="checkbox"/> Yes/ <input type="checkbox"/> No	Continuity Test:	<input checked="" type="checkbox"/> N/A <input type="checkbox"/> Pass/ <input type="checkbox"/> Fail	N/A

CLEARLY INDICATE LOCATION OF CC AND ROUTE OF PIPES ON DRAWING BELOW

1. Show main valves required to isolate this service. 2. All dimensions to be tied to property line 3. All dimensions to be metric 4. Depth @ property line is based on elevation after construction and changes may have occurred.

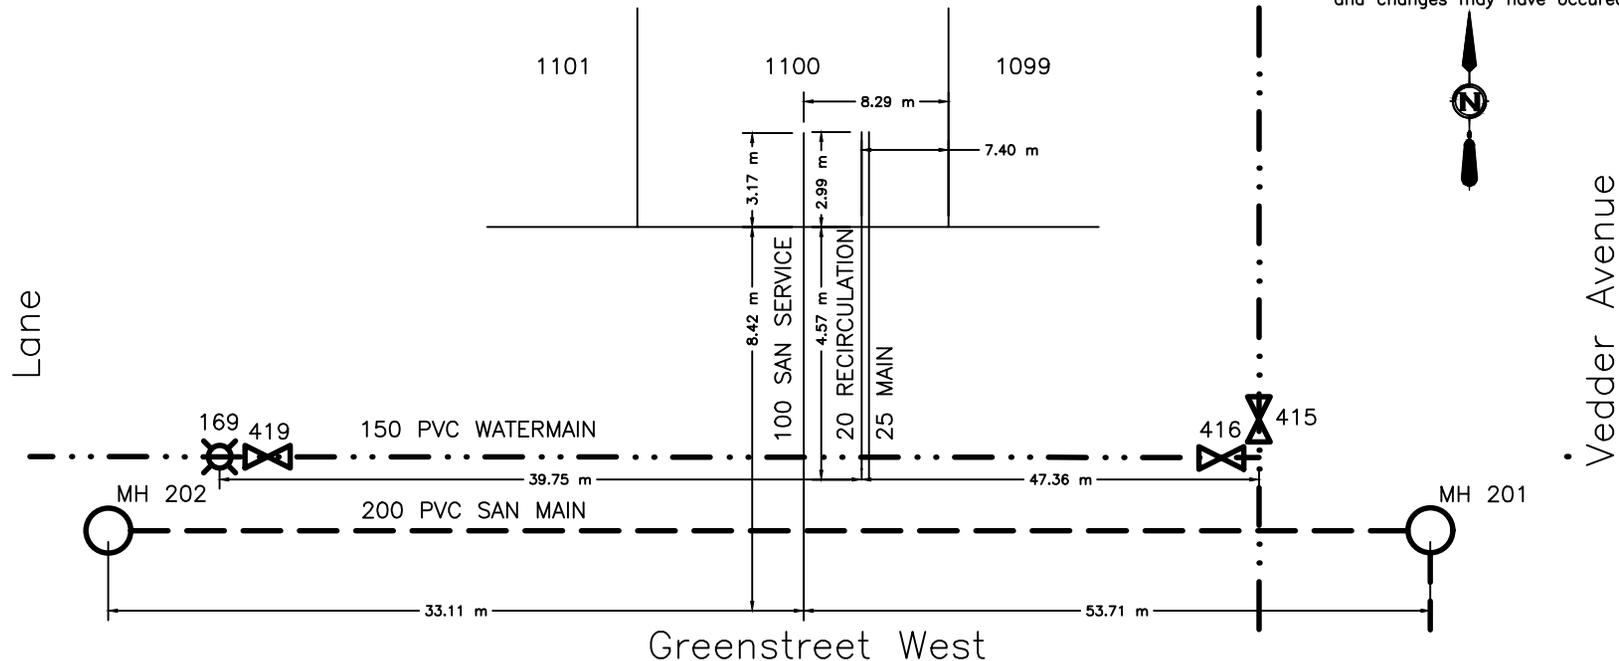



CITY OF WHITEHORSE SERVICE CONNECTION RECORD

FIELD BOOK


No.

ADDRESS 9 Fulton Lane BLOCK LOT 1101

DATES		WATER		SEWER
On at Main	2020-AUG-19	Depth at P/L:	2.69 m	2.75 m
On at Building		Depth at Main:	3.26 m	2.98 m
Frost Plug:		Pipe Size:	25 mm / 20 mm	100 mm
Memo:		Pipe Material:	HDPE	PVC
		Insul.	(Yes/No)	Insul. (Yes/No)
		Length from Main to P/L:	4.56 m	8.58 m
		Squirt Test:	(Pass/Fail)	N/A
Booster Pump Required:	Yes/No	Frost Protection:	Aquaflow/(Recirc)/Heat Trace/Bleeder	N/A
PRV Required:	Yes/No	Greased @ CC:	(Yes/No)	N/A
Water Meter Installed:	Yes/No	Continuity Test:	(N/A) Pass/Fail	N/A

CLEARLY INDICATE LOCATION OF CC AND ROUTE OF PIPES ON DRAWING BELOW

1. Show main valves required to isolate this service. 2. All dimensions to be tied to property line 3. All dimensions to be metric 4. Depth @ property line is based on elevation after construction and changes may have occurred.

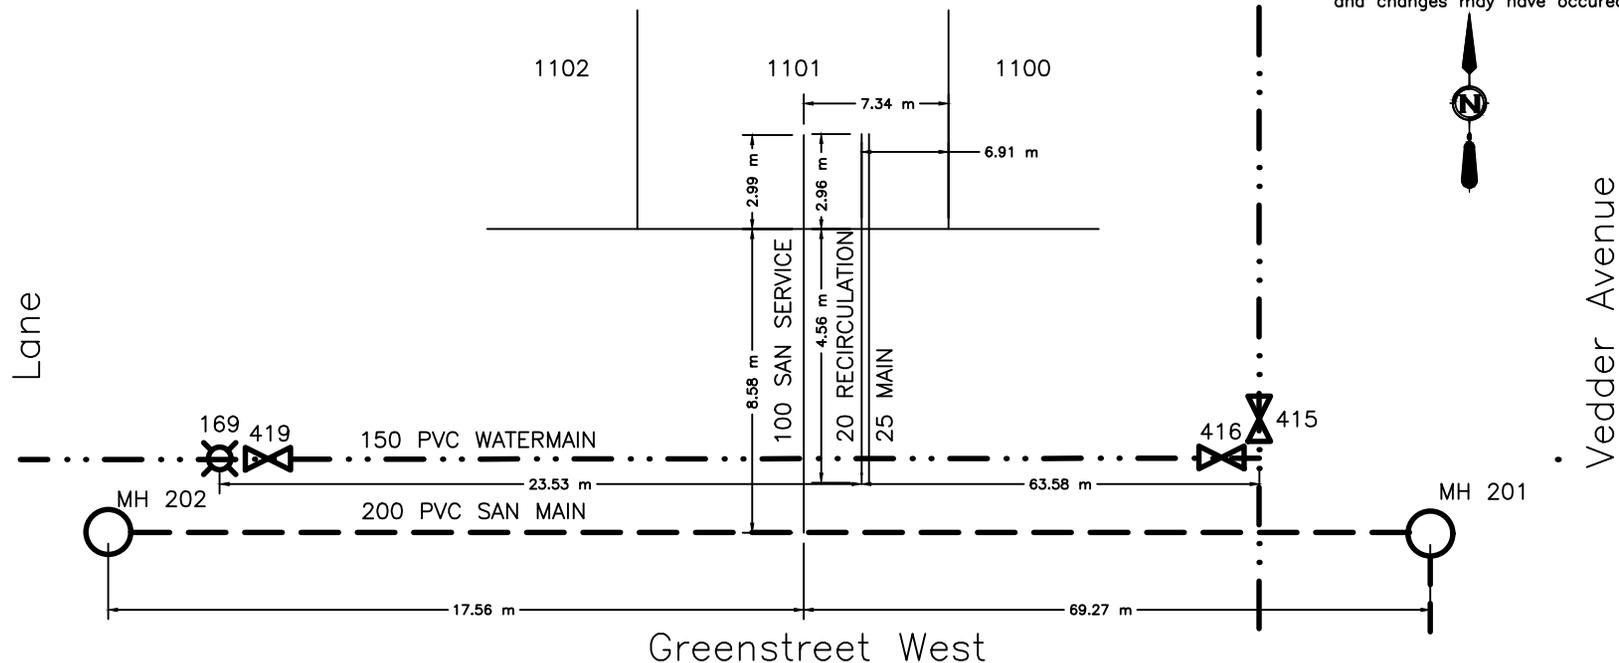



CITY OF WHITEHORSE SERVICE CONNECTION RECORD

FIELD BOOK


No.

ADDRESS 10 Breadwinner Lane BLOCK LOT 1103

DATES	WATER	SEWER
On at Main 2020-AUG-20	Depth at P/L: 2.56 m	2.54 m
On at Building	Depth at Main: 3.24 m	2.53 m
Frost Plug:	Pipe Size: 25 mm / 20 mm	100 mm
Memo:	Pipe Material: HDPE Insul. <input checked="" type="checkbox"/> Yes / <input type="checkbox"/> No	PVC Insul. <input checked="" type="checkbox"/> Yes / <input type="checkbox"/> No
	Length from Main to P/L: 9.34 m	3.45 m
	Squirt Test: <input checked="" type="checkbox"/> Pass / <input type="checkbox"/> Fail	N/A
Booster Pump Required: <input type="checkbox"/> Yes / <input checked="" type="checkbox"/> No	Frost Protection: Aquaflo / <input checked="" type="checkbox"/> Recirc / Heat Trace / Bleeder	N/A
PRV Required: <input type="checkbox"/> Yes / <input checked="" type="checkbox"/> No	Greased @ CC: <input checked="" type="checkbox"/> Yes / <input type="checkbox"/> No	N/A
Water Meter Installed: <input type="checkbox"/> Yes / <input checked="" type="checkbox"/> No	Continuity Test: <input checked="" type="checkbox"/> N/A / <input type="checkbox"/> Pass / <input type="checkbox"/> Fail	N/A

CLEARLY INDICATE LOCATION OF CC AND ROUTE OF PIPES ON DRAWING BELOW

1. Show main valves required to isolate this service. 2. All dimensions to be tied to property line 3. All dimensions to be metric 4. Depth @ property line is based on elevation after construction and changes may have occurred.

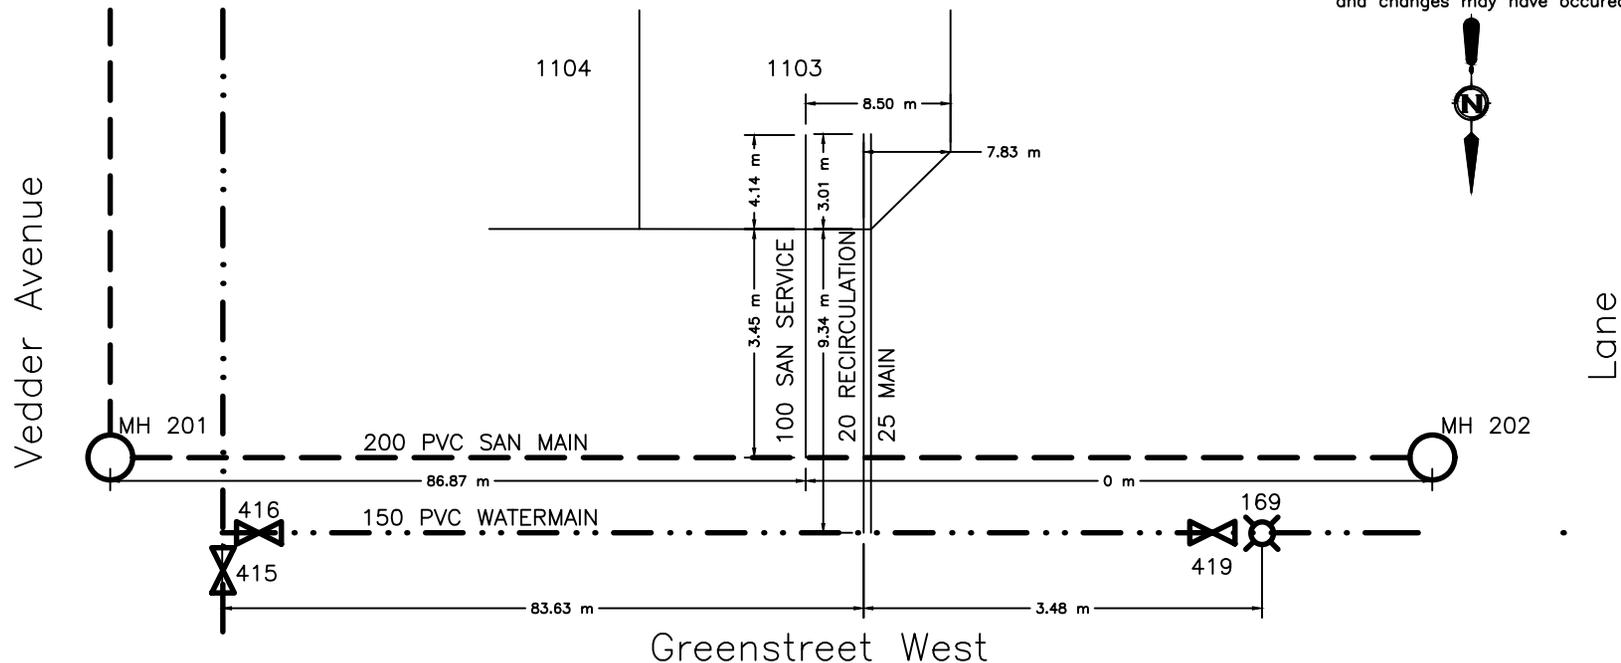



CITY OF WHITEHORSE SERVICE CONNECTION RECORD

FIELD BOOK


No.

ADDRESS 8 Breadwinner Lane BLOCK LOT 1104

DATES		WATER		SEWER
On at Main	2020-AUG-19	Depth at P/L:	2.81 m	2.87 m
On at Building		Depth at Main:	3.23 m	2.97 m
Frost Plug:		Pipe Size:	25 mm / 20 mm	100 mm
Memo:		Pipe Material:	HDPE Insul. <input checked="" type="checkbox"/> Yes/ <input type="checkbox"/> No	PVC Insul. <input checked="" type="checkbox"/> Yes/ <input type="checkbox"/> No
		Length from Main to P/L:	9.27 m	4.45 m
		Squirt Test:	<input checked="" type="checkbox"/> Pass/ <input type="checkbox"/> Fail	N/A
Booster Pump Required:	<input type="checkbox"/> Yes/ <input type="checkbox"/> No	Frost Protection:	Aquaflow/ <input checked="" type="checkbox"/> Recirc/Heat Trace/Bleeder	N/A
PRV Required:	<input type="checkbox"/> Yes/ <input type="checkbox"/> No	Greased @ CC:	<input checked="" type="checkbox"/> Yes/ <input type="checkbox"/> No	N/A
Water Meter Installed:	<input type="checkbox"/> Yes/ <input type="checkbox"/> No	Continuity Test:	<input checked="" type="checkbox"/> N/A <input type="checkbox"/> Pass/ <input type="checkbox"/> Fail	N/A

CLEARLY INDICATE LOCATION OF CC AND ROUTE OF PIPES ON DRAWING BELOW

1. Show main valves required to isolate this service. 2. All dimensions to be tied to property line 3. All dimensions to be metric 4. Depth @ property line is based on elevation after construction and changes may have occurred.

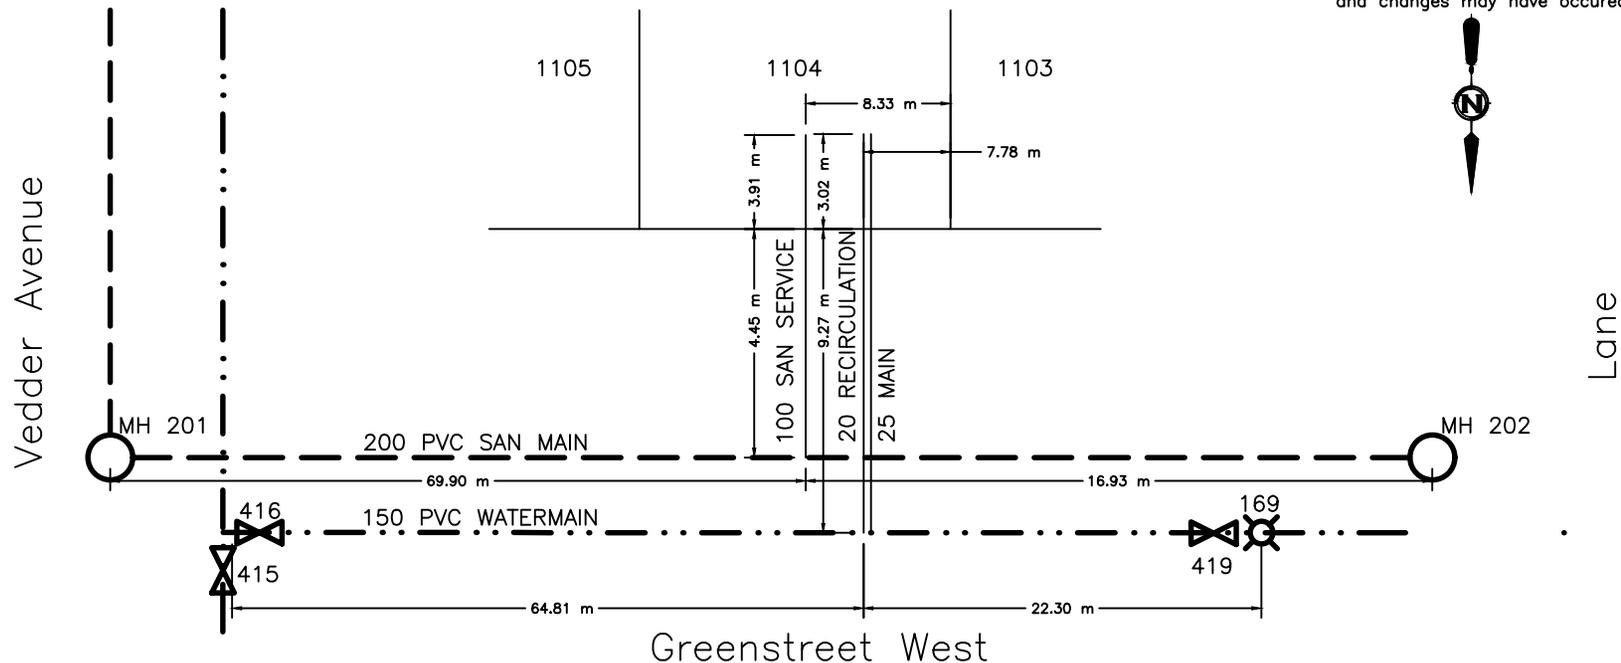



CITY OF WHITEHORSE SERVICE CONNECTION RECORD

FIELD BOOK


No.

ADDRESS 6 Breadwinner Lane BLOCK LOT 1105

DATES		WATER		SEWER
On at Main	2020-AUG-19	Depth at P/L:	2.94 m	2.99 m
On at Building		Depth at Main:	3.27 m	3.15 m
Frost Plug:		Pipe Size:	25 mm / 20 mm	100 mm
Memo:		Pipe Material:	HDPE	PVC
		Insul.:	(Yes/No)	Insul. (Yes/No)
		Length from Main to P/L:	9.27 m	4.47 m
		Squirt Test:	(Pass/Fail)	N/A
Booster Pump Required:	Yes/No	Frost Protection:	Aquaflow/(Recirc)/Heat Trace/Bleeder	N/A
PRV Required:	Yes/No	Greased @ CC:	(Yes/No)	N/A
Water Meter Installed:	Yes/No	Continuity Test:	(N/A) Pass/Fail	N/A

CLEARLY INDICATE LOCATION OF CC AND ROUTE OF PIPES ON DRAWING BELOW

1. Show main valves required to isolate this service. 2. All dimensions to be tied to property line 3. All dimensions to be metric 4. Depth @ property line is based on elevation after construction and changes may have occurred.

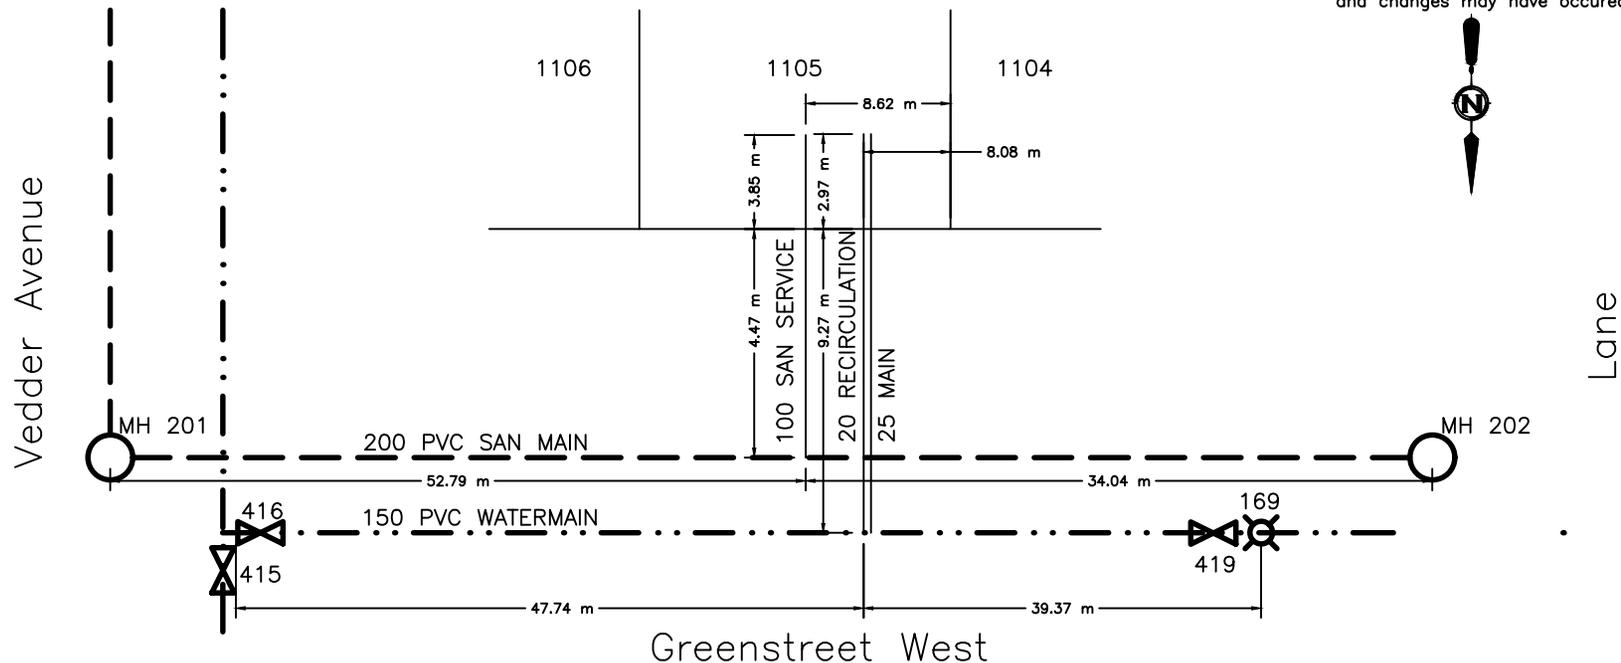



CITY OF WHITEHORSE SERVICE CONNECTION RECORD

FIELD BOOK


No.

ADDRESS 4 Breadwinner Lane BLOCK LOT 1106

DATES		WATER		SEWER
On at Main	2020-AUG-19	Depth at P/L:	3.16 m	3.18 m
On at Building		Depth at Main:	3.30 m	3.35 m
Frost Plug:		Pipe Size:	25 mm / 20 mm	100 mm
Memo:		Pipe Material:	HDPE	PVC
		Insul.:	(Yes/No)	Insul. (Yes/No)
		Length from Main to P/L:	9.31 m	4.42 m
		Squirt Test:	(Pass/Fail)	N/A
Booster Pump Required:	Yes/No	Frost Protection:	Aquaflow/Recirc/Heat Trace/Bleeder	N/A
PRV Required:	Yes/No	Greased @ CC:	(Yes/No)	N/A
Water Meter Installed:	Yes/No	Continuity Test:	(N/A) Pass/Fail	N/A

CLEARLY INDICATE LOCATION OF CC AND ROUTE OF PIPES ON DRAWING BELOW

1. Show main valves required to isolate this service. 2. All dimensions to be tied to property line 3. All dimensions to be metric 4. Depth @ property line is based on elevation after construction and changes may have occurred.

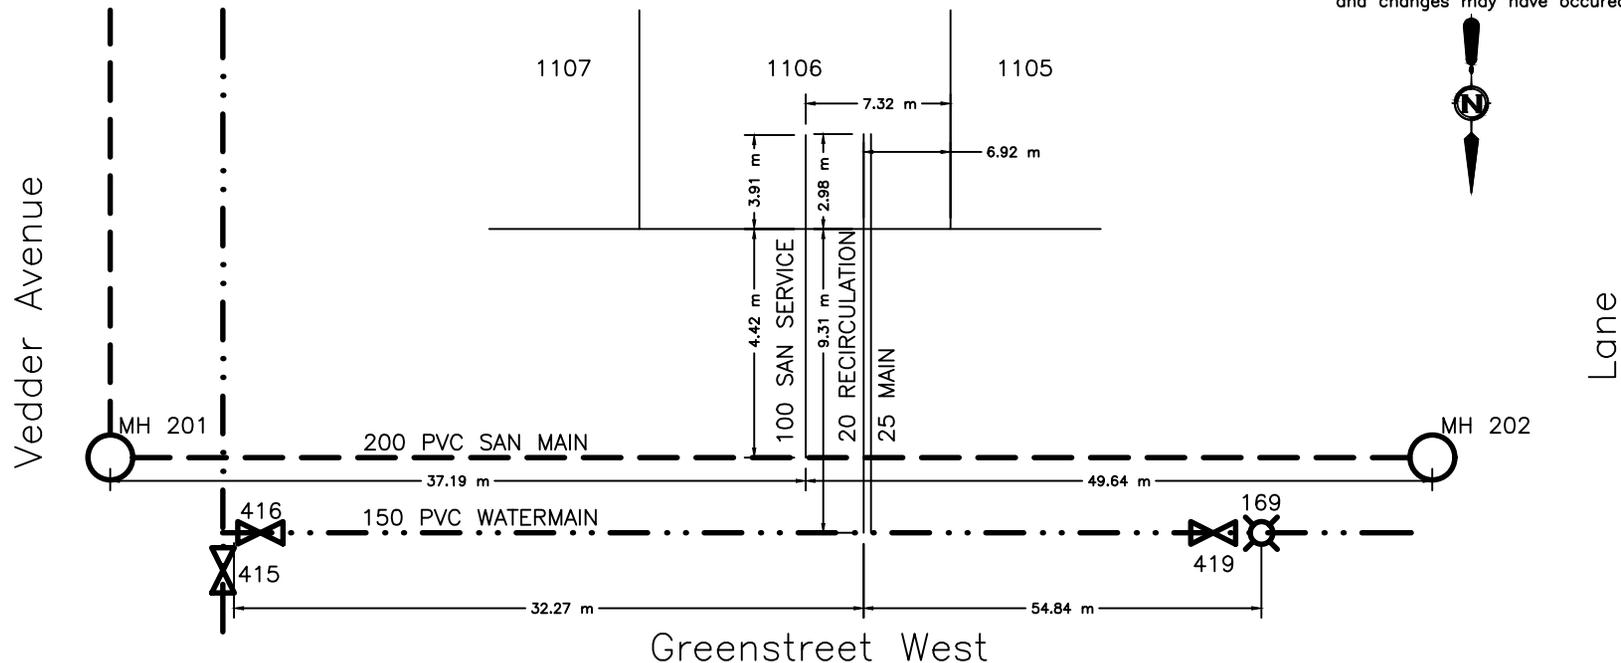



CITY OF WHITEHORSE SERVICE CONNECTION RECORD

FIELD BOOK


No.

ADDRESS 2 Breadwinner Lane BLOCK LOT 1107

DATES		WATER		SEWER
On at Main	2020-AUG-20	Depth at P/L:	2.89 m	2.95 m
On at Building		Depth at Main:	3.32 m	3.54 m
Frost Plug:		Pipe Size:	25 mm / 20 mm	100 mm
Memo:		Pipe Material:	HDPE	PVC
		Insul.:	<input checked="" type="checkbox"/> Yes / <input type="checkbox"/> No	Insul. <input checked="" type="checkbox"/> Yes / <input type="checkbox"/> No
		Length from Main to P/L:	9.33 m	5.28 m
		Squirt Test:	<input checked="" type="checkbox"/> Pass / <input type="checkbox"/> Fail	N/A
Booster Pump Required:	<input type="checkbox"/> Yes / <input type="checkbox"/> No	Frost Protection:	Aquaflow / <input checked="" type="checkbox"/> Recirc / Heat Trace / Bleeder	N/A
PRV Required:	<input type="checkbox"/> Yes / <input type="checkbox"/> No	Greased @ CC:	<input checked="" type="checkbox"/> Yes / <input type="checkbox"/> No	N/A
Water Meter Installed:	<input type="checkbox"/> Yes / <input type="checkbox"/> No	Continuity Test:	<input checked="" type="checkbox"/> N/A / <input type="checkbox"/> Pass / <input type="checkbox"/> Fail	N/A

CLEARLY INDICATE LOCATION OF CC AND ROUTE OF PIPES ON DRAWING BELOW

- Show main valves required to isolate this service.
- All dimensions to be tied to property line
- All dimensions to be metric
- Depth @ property line is based on elevation after construction and changes may have occurred.

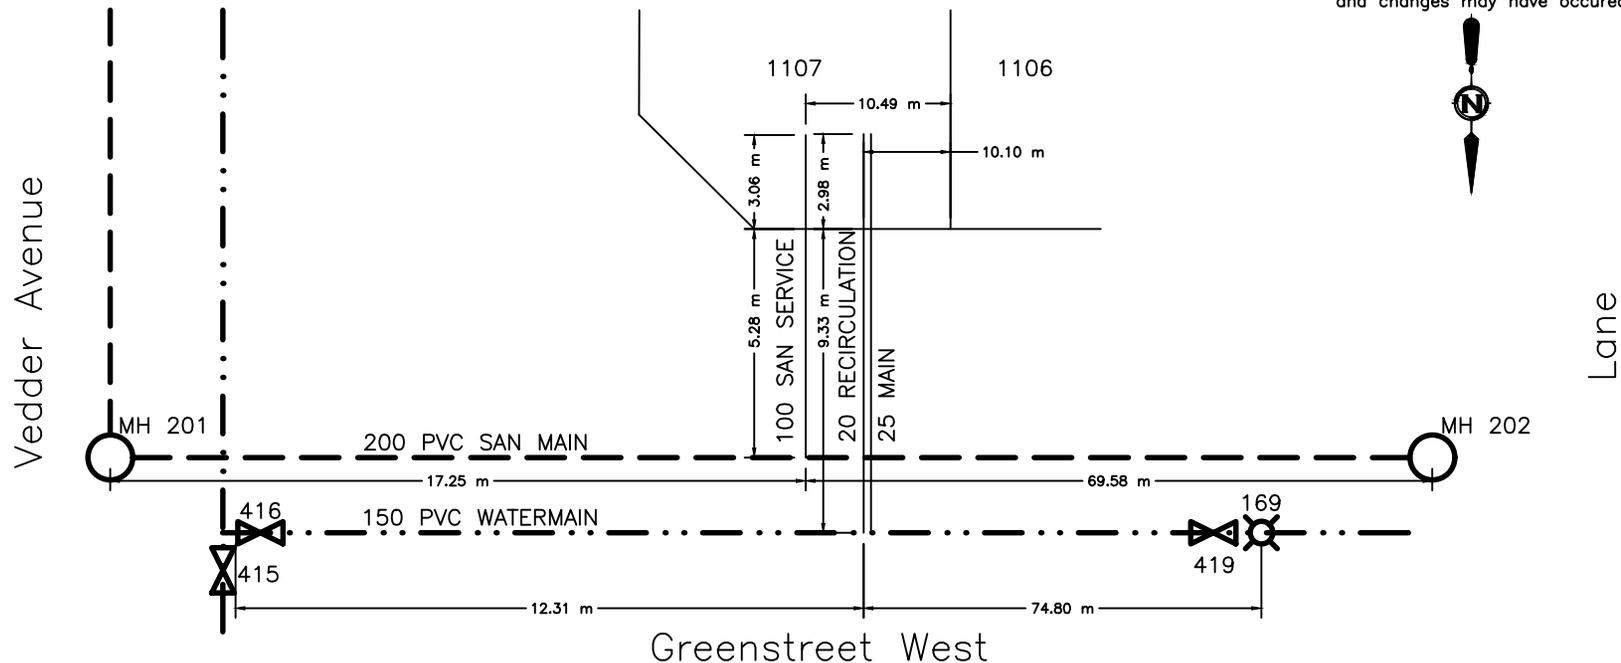



CITY OF WHITEHORSE SERVICE CONNECTION RECORD

FIELD BOOK


No.

ADDRESS 5 Omega Street BLOCK LOT 1108

DATES	WATER	SEWER
On at Main 2020-SEPT-15	Depth at P/L: 2.55 m	2.65 m
On at Building	Depth at Main: 2.91 m	3.36 m
Frost Plug:	Pipe Size: 25 mm / 20 mm	100 mm
Memo:	Pipe Material: HDPE Insul. <input checked="" type="checkbox"/> Yes / <input type="checkbox"/> No	PVC Insul. <input checked="" type="checkbox"/> Yes / <input type="checkbox"/> No
	Length from Main to P/L: 2.96 m	9.04 m
	Squirt Test: <input checked="" type="checkbox"/> Pass / <input type="checkbox"/> Fail	N/A
Booster Pump Required: <input type="checkbox"/> Yes / <input checked="" type="checkbox"/> No	Frost Protection: <input checked="" type="checkbox"/> Aquaflo / <input type="checkbox"/> Recirc / <input type="checkbox"/> Heat Trace / <input type="checkbox"/> Bleeder	N/A
PRV Required: <input type="checkbox"/> Yes / <input checked="" type="checkbox"/> No	Greased @ CC: <input checked="" type="checkbox"/> Yes / <input type="checkbox"/> No	N/A
Water Meter Installed: <input type="checkbox"/> Yes / <input checked="" type="checkbox"/> No	Continuity Test: <input checked="" type="checkbox"/> N/A / <input type="checkbox"/> Pass / <input type="checkbox"/> Fail	N/A

CLEARLY INDICATE LOCATION OF CC AND ROUTE OF PIPES ON DRAWING BELOW

1. Show main valves required to isolate this service. 2. All dimensions to be tied to property line 3. All dimensions to be metric 4. Depth @ property line is based on elevation after construction and changes may have occurred.

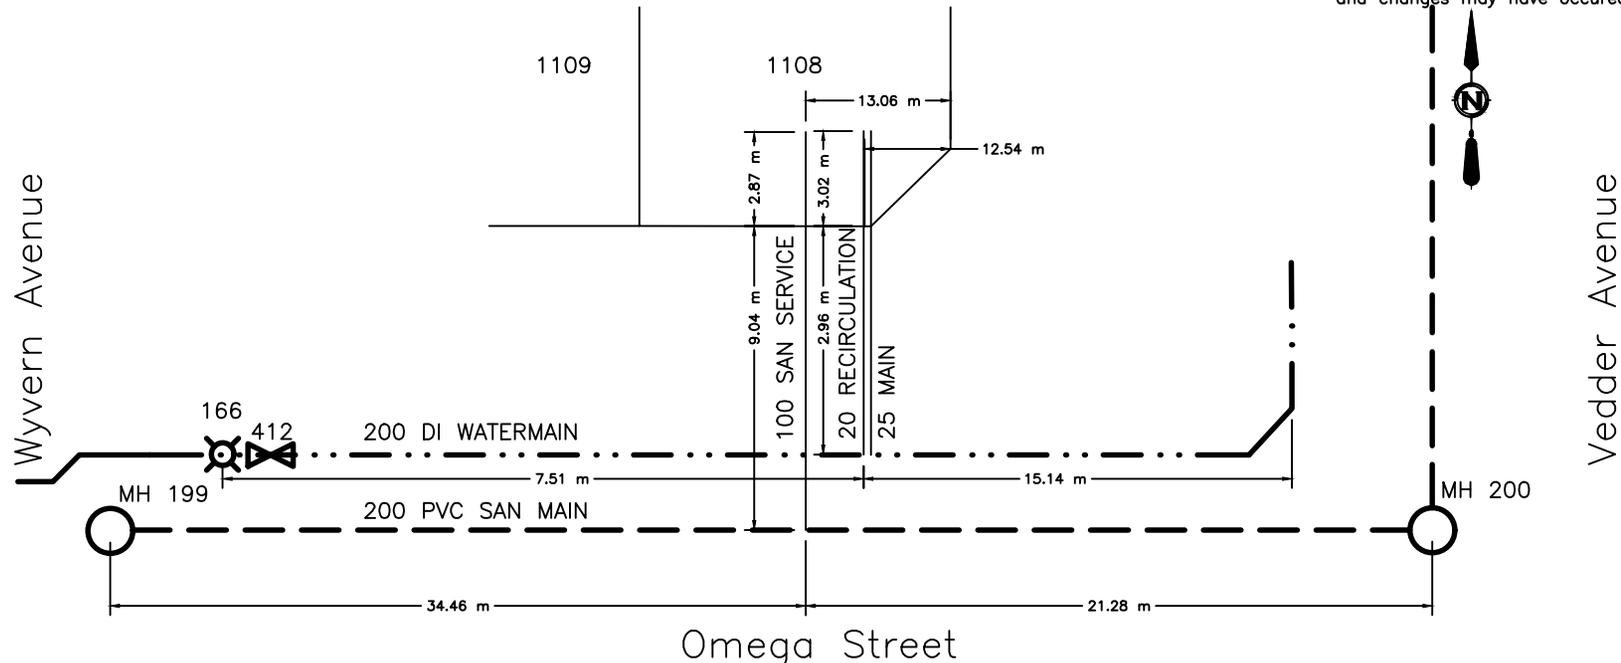



CITY OF WHITEHORSE SERVICE CONNECTION RECORD

FIELD BOOK


No.

ADDRESS 7 Omega Street BLOCK LOT 1109

DATES		WATER		SEWER
On at Main 2020-SEPT-15		Depth at P/L: 2.57 m	2.67 m	
On at Building		Depth at Main: 2.91 m	3.32 m	
Frost Plug:		Pipe Size: 25 mm / 20 mm	100 mm	
Memo:		Pipe Material: HDPE	Insul. <input checked="" type="checkbox"/> Yes / <input type="checkbox"/> No	PVC
		Length from Main to P/L: 5.93 m		9.00 m
		Squirt Test: <input checked="" type="checkbox"/> Pass / <input type="checkbox"/> Fail		N/A
Booster Pump Required:	<input type="checkbox"/> Yes / <input type="checkbox"/> No	Frost Protection: Aquaflo / <input checked="" type="checkbox"/> Recirc / Heat Trace / Bleeder		N/A
PRV Required:	<input type="checkbox"/> Yes / <input type="checkbox"/> No	Greased @ CC: <input checked="" type="checkbox"/> Yes / <input type="checkbox"/> No		N/A
Water Meter Installed:	<input type="checkbox"/> Yes / <input type="checkbox"/> No	Continuity Test: <input type="checkbox"/> N/A / <input type="checkbox"/> Pass / <input type="checkbox"/> Fail		N/A

CLEARLY INDICATE LOCATION OF CC AND ROUTE OF PIPES ON DRAWING BELOW

1. Show main valves required to isolate this service. 2. All dimensions to be tied to property line 3. All dimensions to be metric 4. Depth @ property line is based on elevation after construction and changes may have occurred.

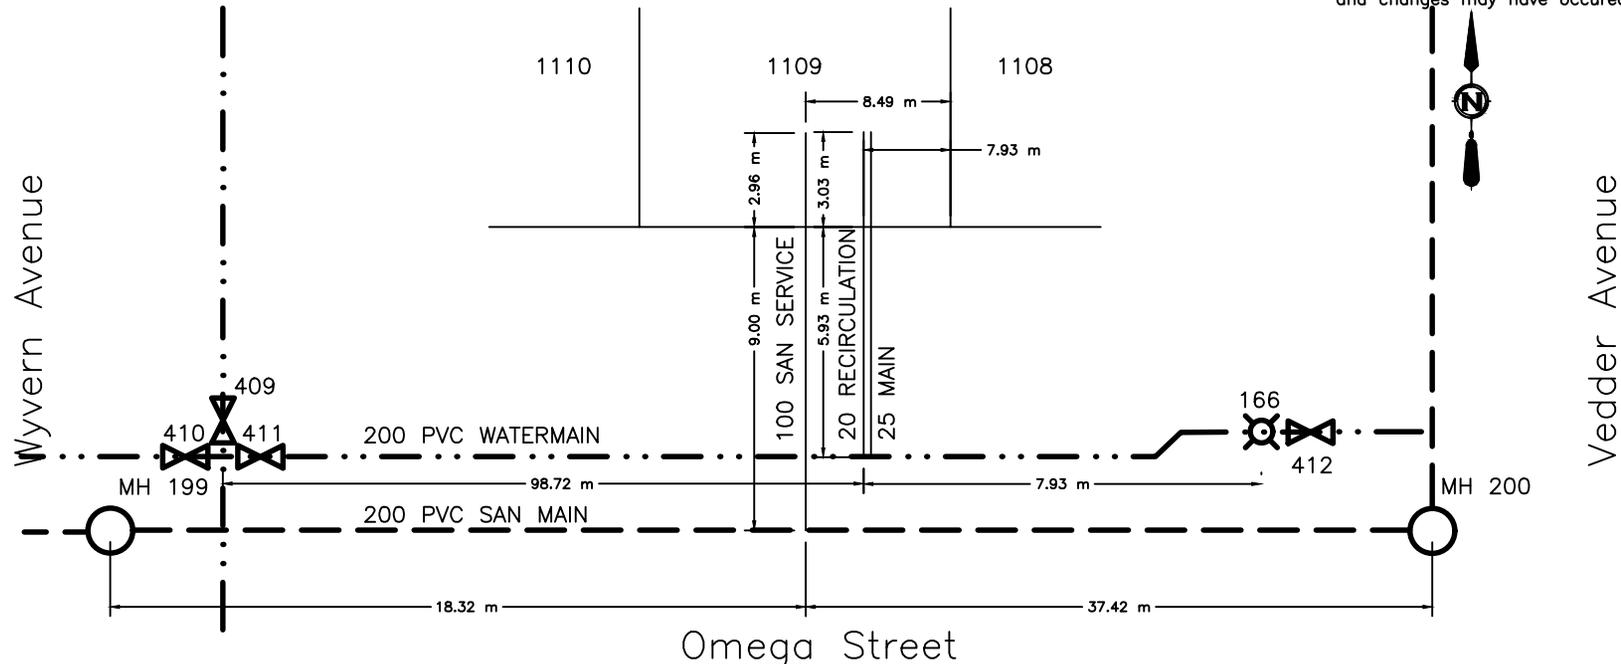



CITY OF WHITEHORSE SERVICE CONNECTION RECORD

FIELD BOOK


No.

ADDRESS 9 Omega Street BLOCK LOT 1110

DATES		WATER		SEWER
On at Main 2020-SEPT-15		Depth at P/L: 2.46 m	2.68 m	
On at Building		Depth at Main: 2.99 m	3.30 m	
Frost Plug:		Pipe Size: 25 mm / 20 mm	100 mm	
Memo:		Pipe Material: HDPE	Insul. <input checked="" type="checkbox"/> Yes / <input type="checkbox"/> No	PVC
		Length from Main to P/L: 5.90 m		8.97 m
		Squirt Test: <input checked="" type="checkbox"/> Pass / <input type="checkbox"/> Fail		N/A
Booster Pump Required:	<input type="checkbox"/> Yes / <input type="checkbox"/> No	Frost Protection: Aquaflo / <input checked="" type="checkbox"/> Recirc / Heat Trace / Bleeder	N/A	
PRV Required:	<input type="checkbox"/> Yes / <input type="checkbox"/> No	Greased @ CC: <input checked="" type="checkbox"/> Yes / <input type="checkbox"/> No	N/A	
Water Meter Installed:	<input type="checkbox"/> Yes / <input type="checkbox"/> No	Continuity Test: <input type="checkbox"/> N/A	Pass / Fail	N/A

CLEARLY INDICATE LOCATION OF CC AND ROUTE OF PIPES ON DRAWING BELOW

1. Show main valves required to isolate this service. 2. All dimensions to be tied to property line 3. All dimensions to be metric 4. Depth @ property line is based on elevation after construction and changes may have occurred.

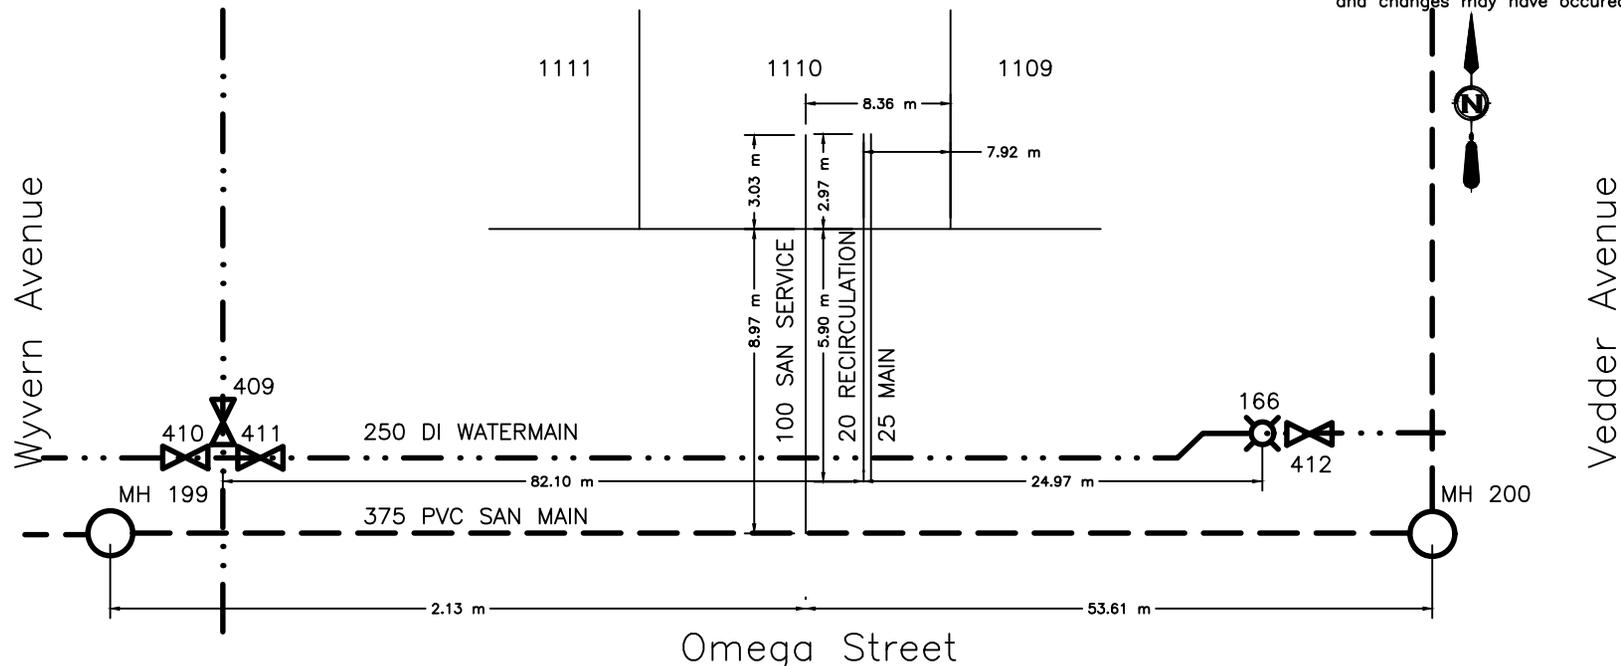



CITY OF WHITEHORSE SERVICE CONNECTION RECORD

FIELD BOOK


No.

ADDRESS 11 Omega Street BLOCK LOT 1111

DATES		WATER		SEWER	
On at Main 2020-SEPT-15		Depth at P/L: 2.64 m		2.78 m	
On at Building		Depth at Main: 3.06 m		3.30 m	
Frost Plug:		Pipe Size: 25 mm / 20 mm		100 mm	
Memo:		Pipe Material: HDPE Insul. <input checked="" type="checkbox"/> Yes / <input type="checkbox"/> No		PVC Insul. Yes / <input checked="" type="checkbox"/> No	
		Length from Main to P/L: 5.89 m		9.24 m	
		Squirt Test: <input checked="" type="checkbox"/> Pass / <input type="checkbox"/> Fail		N/A	
Booster Pump Required:	<input type="checkbox"/> Yes / <input type="checkbox"/> No	Frost Protection: Aquaflo / <input checked="" type="checkbox"/> Recirc / Heat Trace / Bleeder		N/A	
PRV Required:	<input type="checkbox"/> Yes / <input type="checkbox"/> No	Greased @ CC: <input checked="" type="checkbox"/> Yes / <input type="checkbox"/> No		N/A	
Water Meter Installed:	<input type="checkbox"/> Yes / <input type="checkbox"/> No	Continuity Test: <input checked="" type="checkbox"/> N/A <input type="checkbox"/> Pass / <input type="checkbox"/> Fail		N/A	

CLEARLY INDICATE LOCATION OF CC AND ROUTE OF PIPES ON DRAWING BELOW

1. Show main valves required to isolate this service. 2. All dimensions to be tied to property line 3. All dimensions to be metric 4. Depth @ property line is based on elevation after construction and changes may have occurred.

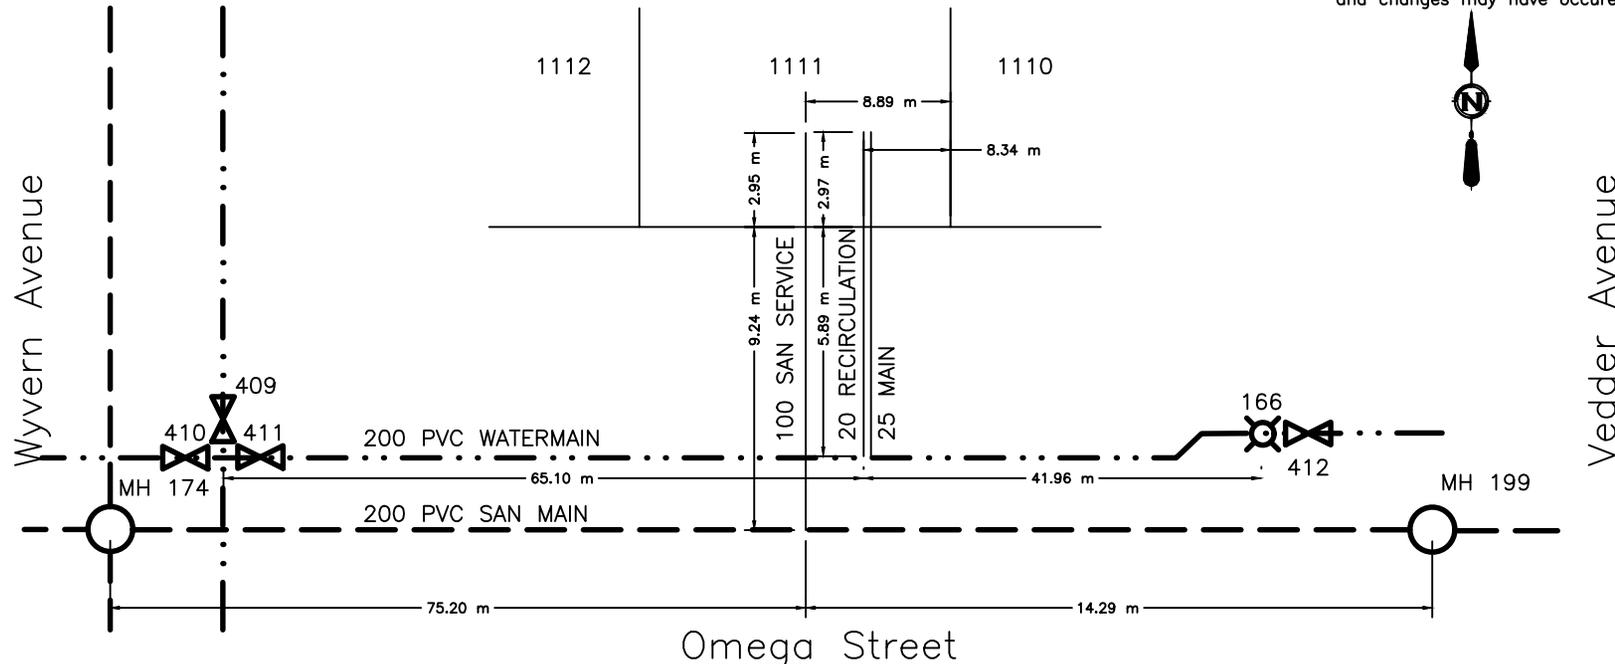



CITY OF WHITEHORSE SERVICE CONNECTION RECORD

FIELD BOOK


No.

ADDRESS 13 Omega Street BLOCK _____ LOT 1112

DATES		WATER		SEWER
On at Main	2020-AUG-07	Depth at P/L:	2.77 m	2.90 m
On at Building		Depth at Main:	3.13 m	3.29 m
Frost Plug:		Pipe Size:	25 mm / 20 mm	100 mm
Memo:		Pipe Material:	HDPE	Insul. <input checked="" type="checkbox"/> Yes/ <input type="checkbox"/> No
		Length from Main to P/L:	5.97 m	PVC
		Squirt Test:	<input checked="" type="checkbox"/> Pass/ <input type="checkbox"/> Fail	Insul. <input checked="" type="checkbox"/> Yes/ <input type="checkbox"/> No
Booster Pump Required:	<input type="checkbox"/> Yes/ <input type="checkbox"/> No	Frost Protection:	Aquaflow/ <input checked="" type="checkbox"/> Recirc/Heat Trace/Bleeder	N/A
PRV Required:	<input type="checkbox"/> Yes/ <input type="checkbox"/> No	Greased @ CC:	<input checked="" type="checkbox"/> Yes/ <input type="checkbox"/> No	N/A
Water Meter Installed:	<input type="checkbox"/> Yes/ <input type="checkbox"/> No	Continuity Test:	<input checked="" type="checkbox"/> N/A	Pass/Fail

CLEARLY INDICATE LOCATION OF CC AND ROUTE OF PIPES ON DRAWING BELOW

1. Show main valves required to isolate this service. 2. All dimensions to be tied to property line 3. All dimensions to be metric 4. Depth @ property line is based on elevation after construction and changes may have occurred.

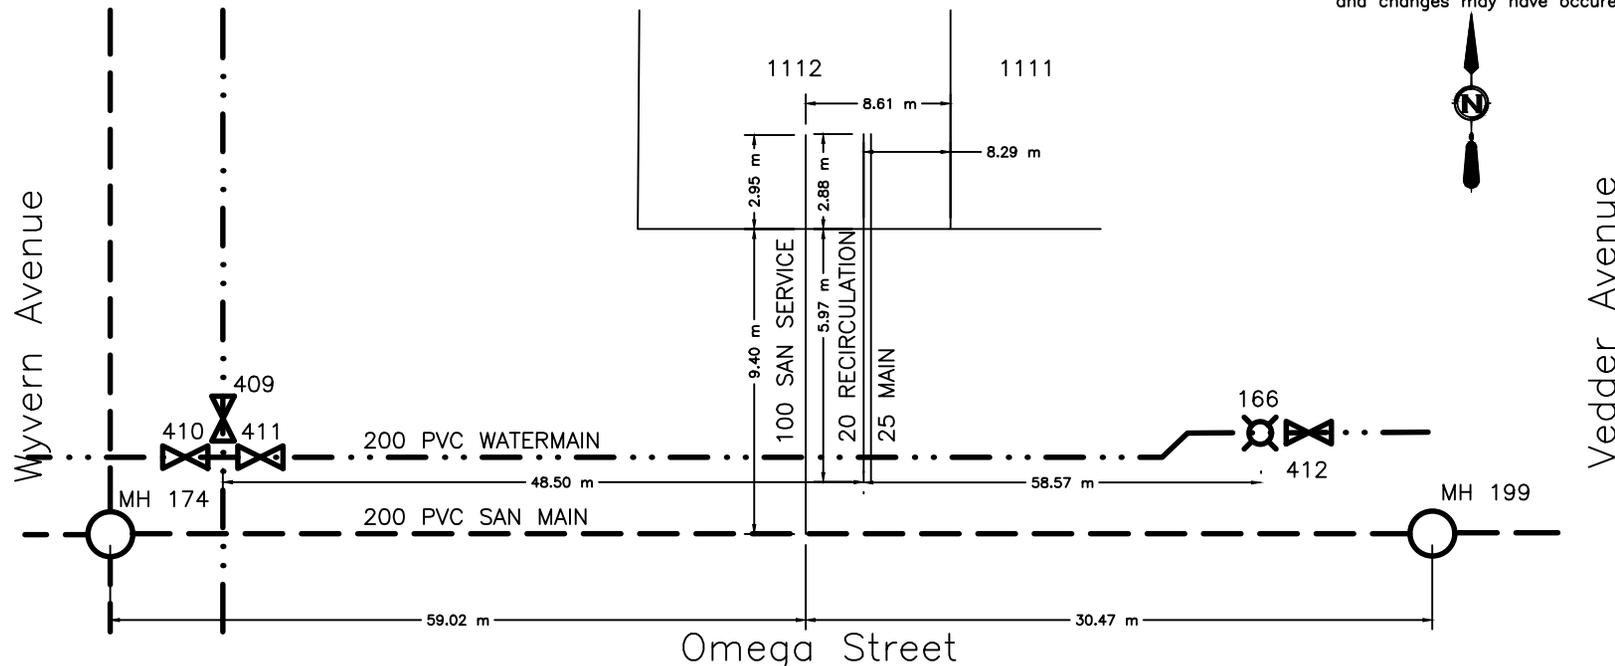



CITY OF WHITEHORSE SERVICE CONNECTION RECORD

FIELD BOOK


No.

ADDRESS 18 Omega Street BLOCK LOT 1113

DATES	WATER	SEWER
On at Main 2020-SEPT-15	Depth at P/L: 2.77 m	2.83 m
On at Building	Depth at Main: 3.30 m	3.26 m
Frost Plug:	Pipe Size: 25 mm / 20 mm	100 mm
Memo:	Pipe Material: HDPE Insul. <input checked="" type="checkbox"/> Yes / <input type="checkbox"/> No	PVC Insul. <input checked="" type="checkbox"/> Yes / <input type="checkbox"/> No
	Length from Main to P/L: 11.97 m	8.11 m
	Squirt Test: <input checked="" type="checkbox"/> Pass / <input type="checkbox"/> Fail	N/A
Booster Pump Required: <input type="checkbox"/> Yes / <input checked="" type="checkbox"/> No	Frost Protection: Aquaflo / <input checked="" type="checkbox"/> Recirc / Heat Trace / Bleeder	N/A
PRV Required: <input type="checkbox"/> Yes / <input checked="" type="checkbox"/> No	Greased @ CC: <input checked="" type="checkbox"/> Yes / <input type="checkbox"/> No	N/A
Water Meter Installed: <input type="checkbox"/> Yes / <input checked="" type="checkbox"/> No	Continuity Test: <input checked="" type="checkbox"/> N/A / <input type="checkbox"/> Pass / <input type="checkbox"/> Fail	N/A

CLEARLY INDICATE LOCATION OF CC AND ROUTE OF PIPES ON DRAWING BELOW

1. Show main valves required to isolate this service. 2. All dimensions to be tied to property line 3. All dimensions to be metric 4. Depth @ property line is based on elevation after construction and changes may have occurred.

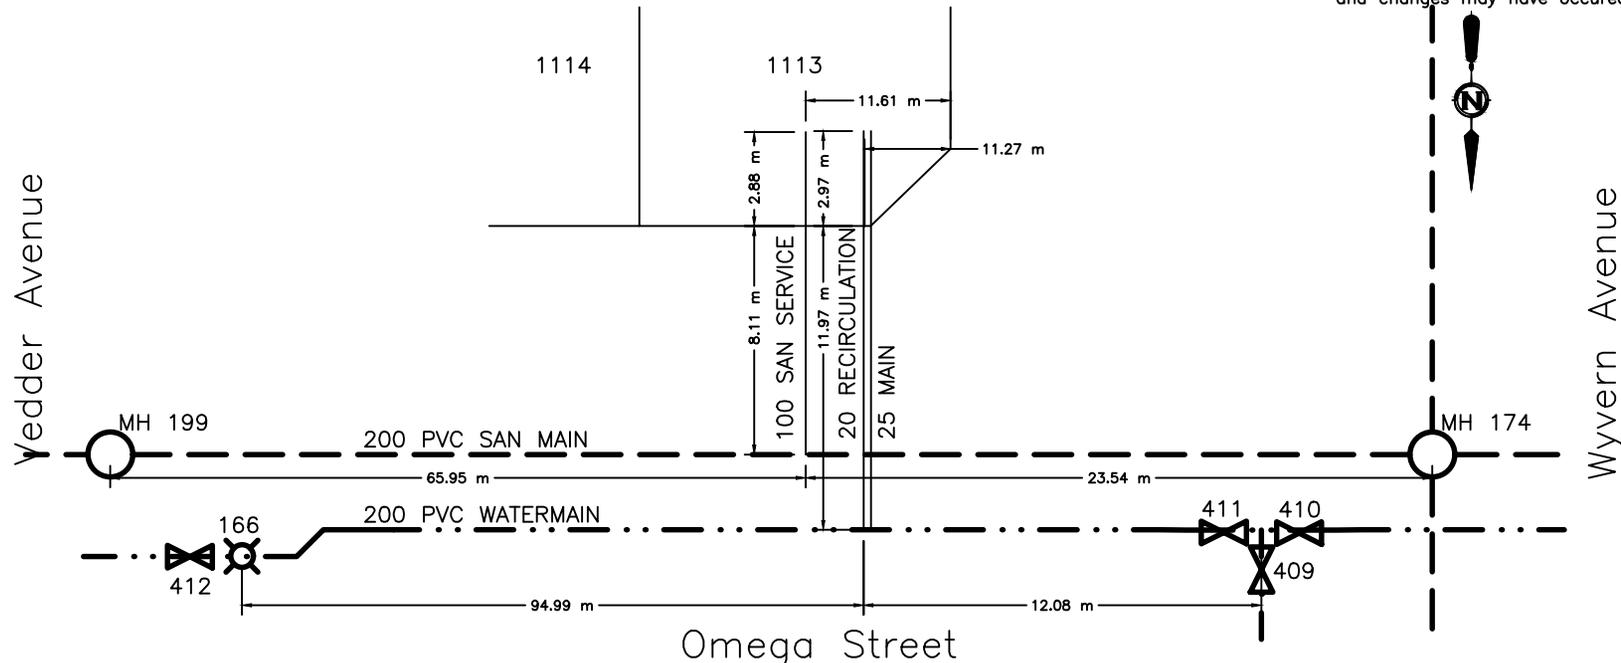



CITY OF WHITEHORSE SERVICE CONNECTION RECORD

FIELD BOOK


No.

ADDRESS 16 Omega Street BLOCK _____ LOT 1114

DATES		WATER		SEWER
On at Main	2020-AUG-07	Depth at P/L:	2.95 m	2.97 m
On at Building		Depth at Main:	3.26 m	3.2 m
Frost Plug:		Pipe Size:	25 mm / 20 mm	100 mm
Memo:		Pipe Material:	HDPE	PVC
		Insul.:	(Yes/No)	Insul. (Yes/No)
		Length from Main to P/L:	11.95 m	8.37 m
		Squirt Test:	(Pass/Fail)	N/A
Booster Pump Required:	Yes/No	Frost Protection:	Aquaflow/(Recirc)/Heat Trace/Bleeder	N/A
PRV Required:	Yes/No	Greased @ CC:	(Yes/No)	N/A
Water Meter Installed:	Yes/No	Continuity Test:	(N/A) Pass/Fail	N/A

CLEARLY INDICATE LOCATION OF CC AND ROUTE OF PIPES ON DRAWING BELOW

1. Show main valves required to isolate this service. 2. All dimensions to be tied to property line 3. All dimensions to be metric 4. Depth @ property line is based on elevation after construction and changes may have occurred.

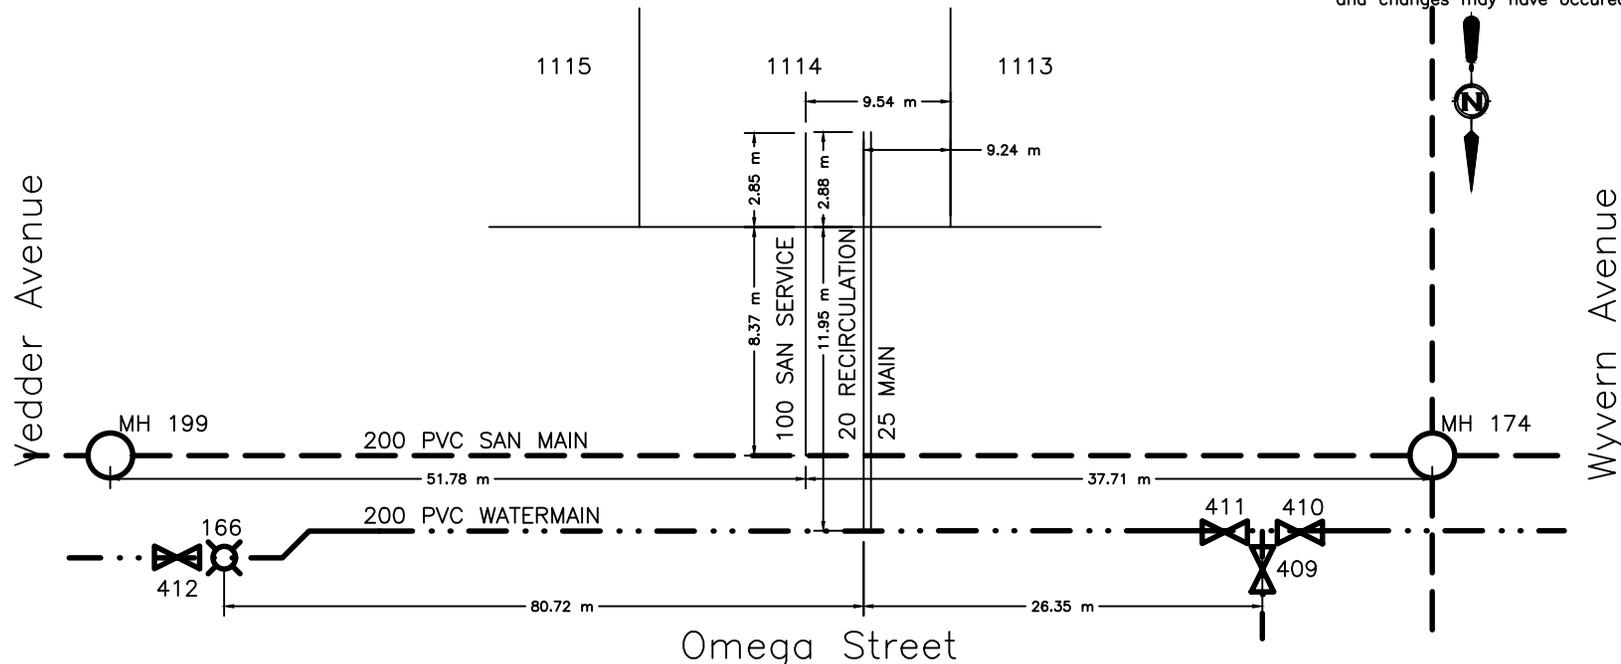



CITY OF WHITEHORSE SERVICE CONNECTION RECORD

FIELD BOOK


No.

ADDRESS 14 Omega Street BLOCK LOT 1115

DATES	WATER	SEWER
On at Main 2020-AUG-07	Depth at P/L: 2.87 m	2.90 m
On at Building	Depth at Main: 3.19 m	3.27 m
Frost Plug:	Pipe Size: 25 mm / 20 mm	100 mm
Memo:	Pipe Material: HDPE Insul. <input checked="" type="checkbox"/> Yes / <input type="checkbox"/> No	PVC Insul. <input checked="" type="checkbox"/> Yes / <input type="checkbox"/> No
	Length from Main to P/L: 11.98 m	8.40 m
	Squirt Test: <input checked="" type="checkbox"/> Pass / <input type="checkbox"/> Fail	N/A
Booster Pump Required: <input type="checkbox"/> Yes / <input checked="" type="checkbox"/> No	Frost Protection: Aquaflo / <input checked="" type="checkbox"/> Recirc / Heat Trace / Bleeder	N/A
PRV Required: <input type="checkbox"/> Yes / <input checked="" type="checkbox"/> No	Greased @ CC: <input checked="" type="checkbox"/> Yes / <input type="checkbox"/> No	N/A
Water Meter Installed: <input type="checkbox"/> Yes / <input checked="" type="checkbox"/> No	Continuity Test: <input checked="" type="checkbox"/> N/A / <input type="checkbox"/> Pass / <input type="checkbox"/> Fail	N/A

CLEARLY INDICATE LOCATION OF CC AND ROUTE OF PIPES ON DRAWING BELOW

1. Show main valves required to isolate this service. 2. All dimensions to be tied to property line 3. All dimensions to be metric 4. Depth @ property line is based on elevation after construction and changes may have occurred.

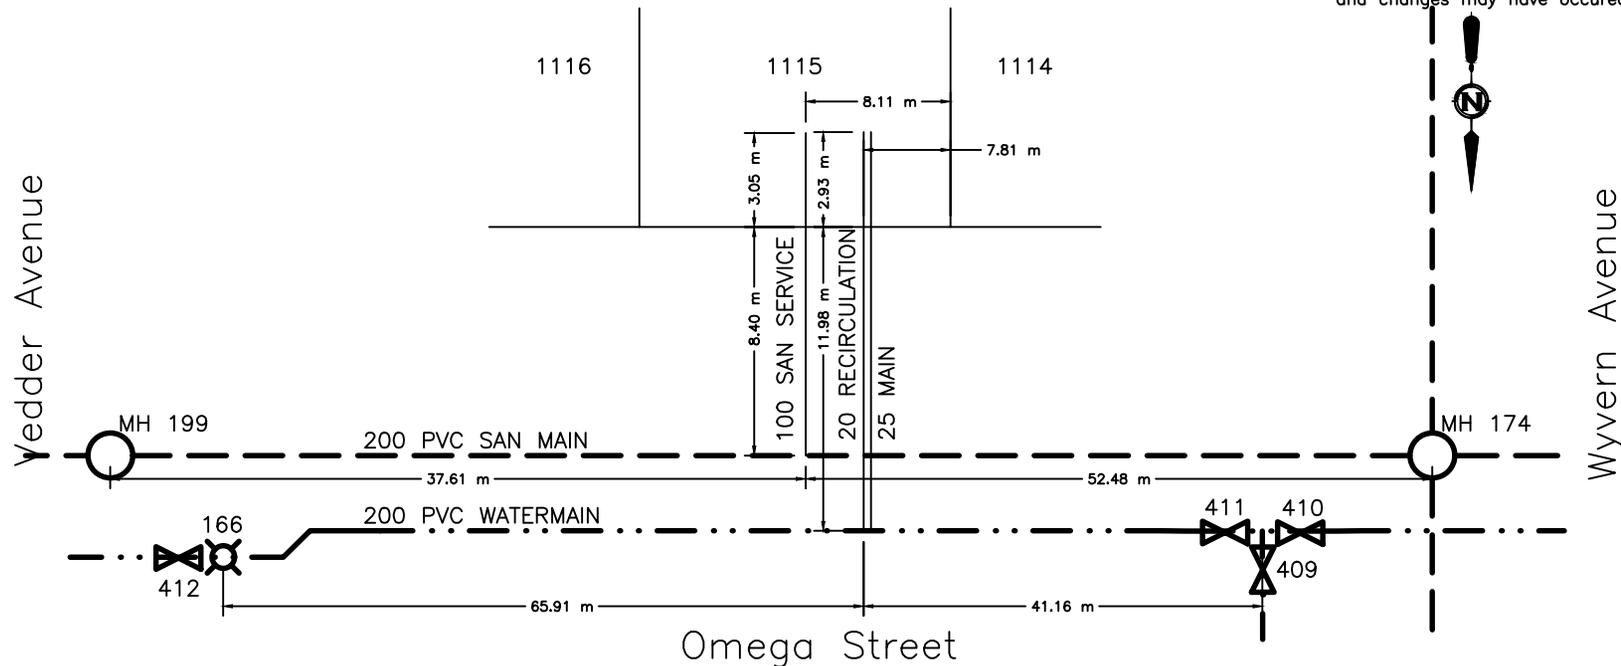



CITY OF WHITEHORSE SERVICE CONNECTION RECORD

FIELD BOOK


No.

ADDRESS 12 Omega Street BLOCK _____ LOT 1116

DATES		WATER		SEWER
On at Main	2020-AUG-07	Depth at P/L:	2.90 m	2.95 m
On at Building		Depth at Main:	3.11 m	3.28 m
Frost Plug:		Pipe Size:	25 mm / 20 mm	100 mm
Memo:		Pipe Material:	HDPE	PVC
		Insul.:	(Yes/No)	Insul. (Yes/No)
		Length from Main to P/L:	11.99 m	8.63 m
		Squirt Test:	(Pass/Fail)	N/A
Booster Pump Required:	Yes/No	Frost Protection:	Aquaflow/(Recirc)/Heat Trace/Bleeder	N/A
PRV Required:	Yes/No	Greased @ CC:	(Yes/No)	N/A
Water Meter Installed:	Yes/No	Continuity Test:	(N/A) Pass/Fail	N/A

CLEARLY INDICATE LOCATION OF CC AND ROUTE OF PIPES ON DRAWING BELOW

1. Show main valves required to isolate this service. 2. All dimensions to be tied to property line 3. All dimensions to be metric 4. Depth @ property line is based on elevation after construction and changes may have occurred.

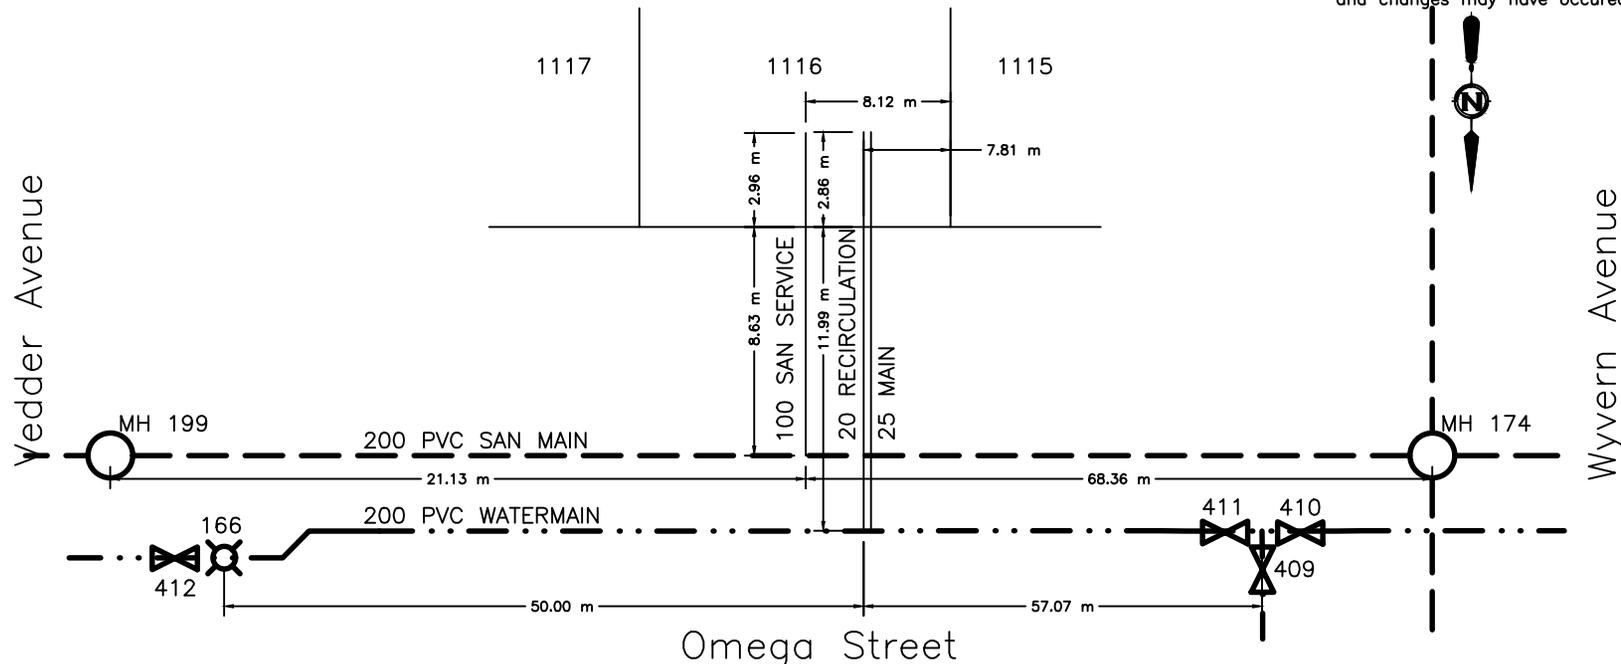



CITY OF WHITEHORSE SERVICE CONNECTION RECORD

FIELD BOOK


No.

ADDRESS 10 Omega Street BLOCK LOT 1117

DATES	WATER	SEWER
On at Main 2020-AUG-07	Depth at P/L: 2.89 m	2.89 m
On at Building	Depth at Main: 3.04 m	3.31 m
Frost Plug:	Pipe Size: 25 mm / 20 mm	100 mm
Memo:	Pipe Material: HDPE Insul. <input checked="" type="checkbox"/> Yes / <input type="checkbox"/> No	PVC Insul. <input checked="" type="checkbox"/> Yes / <input type="checkbox"/> No
	Length from Main to P/L: 12.07 m	8.87 m
	Squirt Test: <input checked="" type="checkbox"/> Pass / <input type="checkbox"/> Fail	N/A
Booster Pump Required: <input type="checkbox"/> Yes / <input checked="" type="checkbox"/> No	Frost Protection: Aquaflo / <input checked="" type="checkbox"/> Recirc / Heat Trace / Bleeder	N/A
PRV Required: <input type="checkbox"/> Yes / <input checked="" type="checkbox"/> No	Greased @ CC: <input checked="" type="checkbox"/> Yes / <input type="checkbox"/> No	N/A
Water Meter Installed: <input type="checkbox"/> Yes / <input checked="" type="checkbox"/> No	Continuity Test: <input checked="" type="checkbox"/> N/A / <input type="checkbox"/> Pass / <input type="checkbox"/> Fail	N/A

CLEARLY INDICATE LOCATION OF CC AND ROUTE OF PIPES ON DRAWING BELOW

1. Show main valves required to isolate this service. 2. All dimensions to be tied to property line 3. All dimensions to be metric 4. Depth @ property line is based on elevation after construction and changes may have occurred.

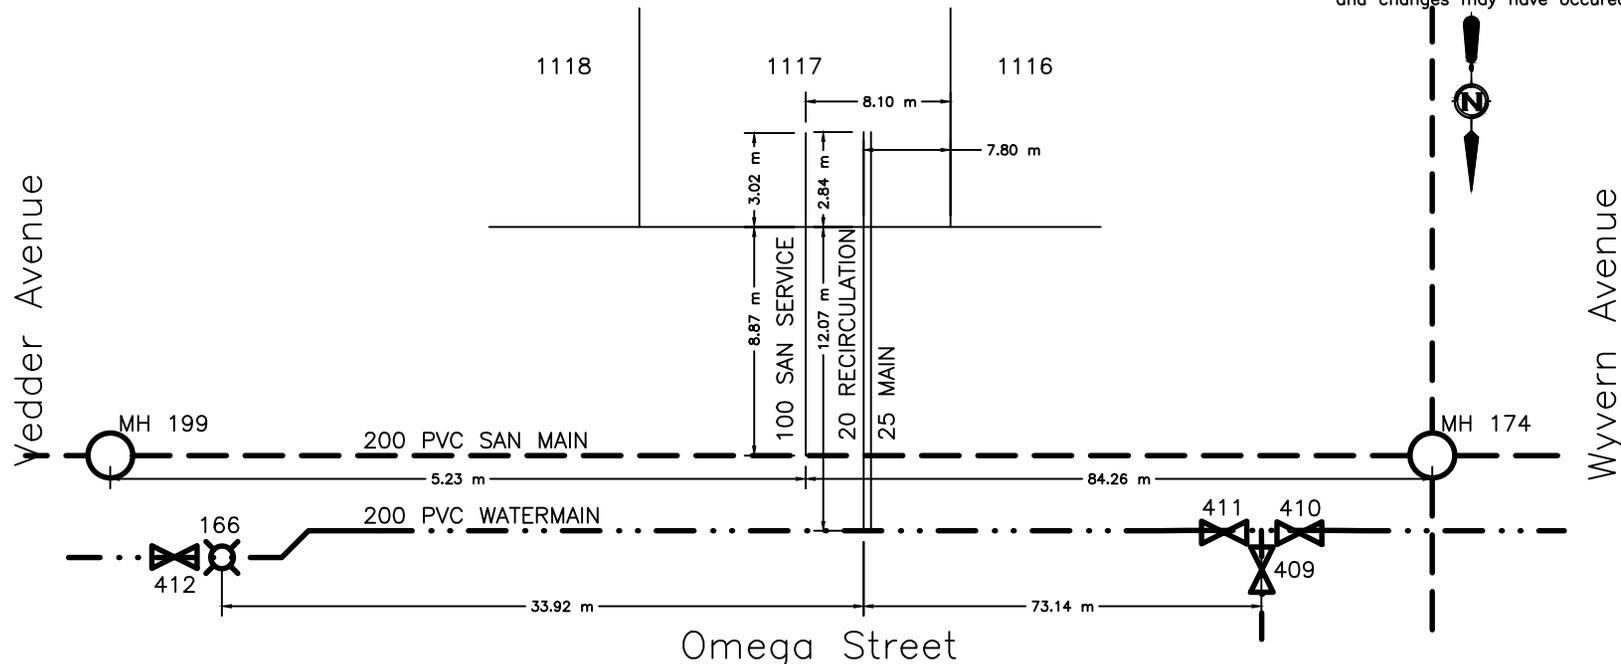



CITY OF WHITEHORSE SERVICE CONNECTION RECORD

FIELD BOOK


No.

ADDRESS 8 Omega Street BLOCK LOT 1118

DATES		WATER		SEWER		
On at Main	2020-AUG-07	Depth at P/L:	2.78 m		2.85 m	
On at Building		Depth at Main:	2.97 m		3.30 m	
Frost Plug:		Pipe Size:	25 mm / 20 mm		100 mm	
Memo:		Pipe Material:	HDPE	Insul. <input checked="" type="checkbox"/> Yes / <input type="checkbox"/> No	PVC	Insul. <input type="checkbox"/> Yes / <input checked="" type="checkbox"/> No
		Length from Main to P/L:	12.01 m		8.96 m	
		Squirt Test:	<input checked="" type="checkbox"/> Pass / <input type="checkbox"/> Fail			N/A
Booster Pump Required:	<input type="checkbox"/> Yes / <input type="checkbox"/> No	Frost Protection:	Aquaflow / <input checked="" type="checkbox"/> Recirc / Heat Trace / Bleeder		N/A	
PRV Required:	<input type="checkbox"/> Yes / <input type="checkbox"/> No	Greased @ CC:	<input checked="" type="checkbox"/> Yes / <input type="checkbox"/> No		N/A	
Water Meter Installed:	<input type="checkbox"/> Yes / <input type="checkbox"/> No	Continuity Test:	<input checked="" type="checkbox"/> N/A / <input type="checkbox"/> Pass / <input type="checkbox"/> Fail		N/A	

CLEARLY INDICATE LOCATION OF CC AND ROUTE OF PIPES ON DRAWING BELOW

1. Show main valves required to isolate this service. 2. All dimensions to be tied to property line 3. All dimensions to be metric 4. Depth @ property line is based on elevation after construction and changes may have occurred.

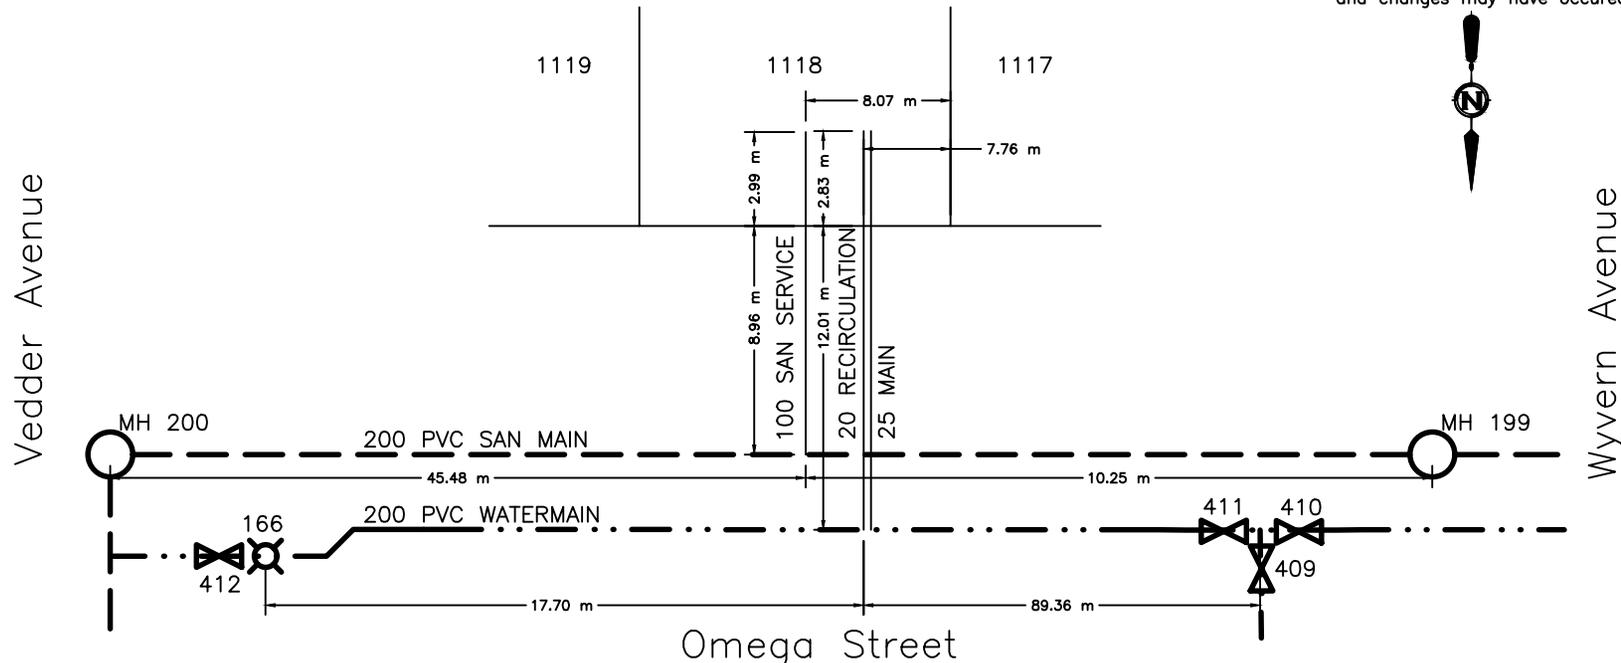



CITY OF WHITEHORSE SERVICE CONNECTION RECORD

FIELD BOOK


No.

ADDRESS 6 Omega Street BLOCK LOT 1119

DATES		WATER		SEWER		
On at Main	2020-AUG-12	Depth at P/L:	2.74 m		2.78 m	
On at Building		Depth at Main:	2.88 m		3.32 m	
Frost Plug:		Pipe Size:	25 mm / 20 mm		100 mm	
Memo:		Pipe Material:	HDPE	Insul. <input checked="" type="checkbox"/> Yes / <input type="checkbox"/> No	PVC	Insul. <input checked="" type="checkbox"/> Yes / <input type="checkbox"/> No
		Length from Main to P/L:	14.83 m		8.98 m	
		Squirt Test:	<input checked="" type="checkbox"/> Pass / <input type="checkbox"/> Fail			N/A
Booster Pump Required:	<input type="checkbox"/> Yes / <input type="checkbox"/> No	Frost Protection:	Aquaflow / <input checked="" type="checkbox"/> Recirc / Heat Trace / Bleeder		N/A	
PRV Required:	<input type="checkbox"/> Yes / <input type="checkbox"/> No	Greased @ CC:	<input checked="" type="checkbox"/> Yes / <input type="checkbox"/> No		N/A	
Water Meter Installed:	<input type="checkbox"/> Yes / <input type="checkbox"/> No	Continuity Test:	<input checked="" type="checkbox"/> N/A	<input type="checkbox"/> Pass / <input type="checkbox"/> Fail	N/A	

CLEARLY INDICATE LOCATION OF CC AND ROUTE OF PIPES ON DRAWING BELOW

1. Show main valves required to isolate this service. 2. All dimensions to be tied to property line 3. All dimensions to be metric 4. Depth @ property line is based on elevation after construction and changes may have occurred.

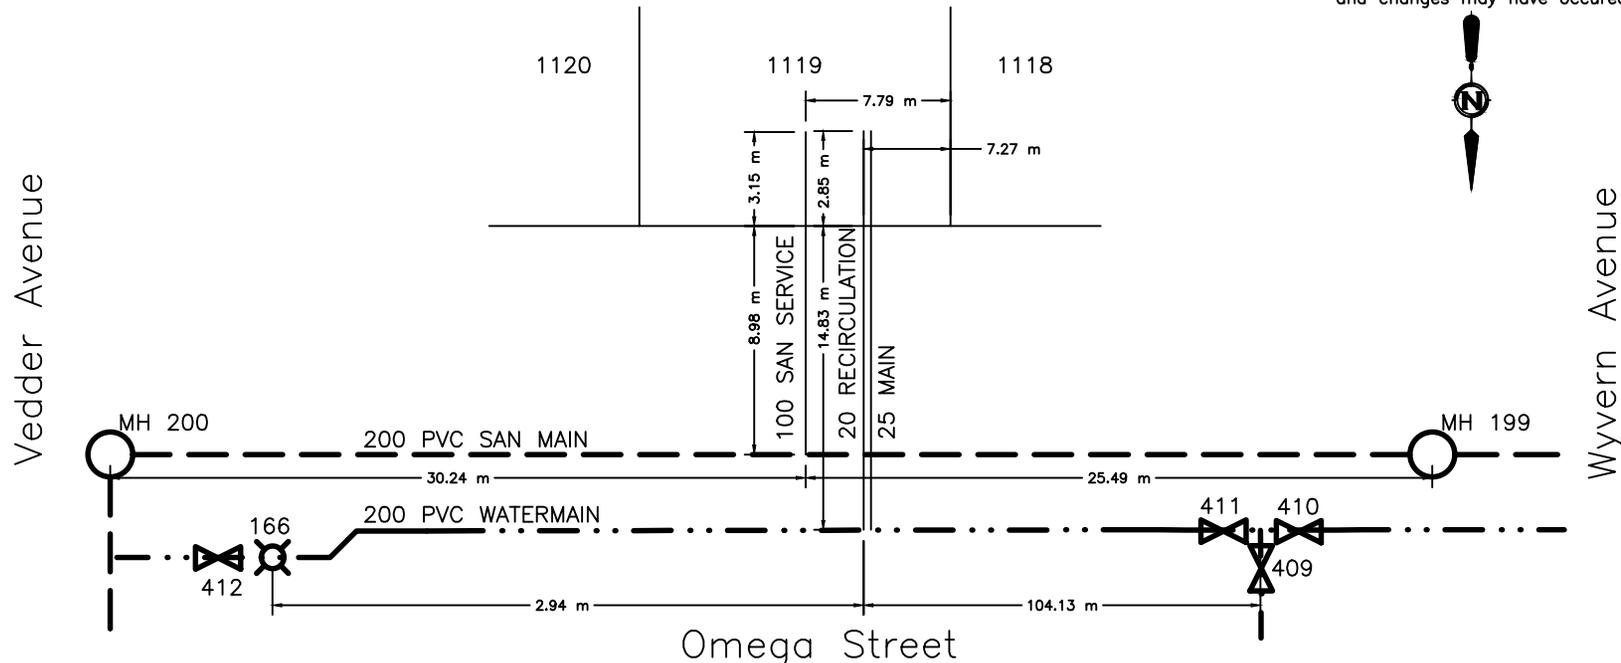



CITY OF WHITEHORSE SERVICE CONNECTION RECORD

FIELD BOOK


No.

ADDRESS 4 Omega Street BLOCK LOT 1120

DATES		WATER		SEWER
On at Main	2020-AUG-12	Depth at P/L:	2.69 m	2.78 m
On at Building		Depth at Main:	2.91 m	3.37 m
Frost Plug:		Pipe Size:	25 mm / 20 mm	100 mm
Memo:		Pipe Material:	HDPE	PVC
		Insul.:	(Yes)/No	Insul. Yes/(No)
		Length from Main to P/L:	14.83 m	8.98 m
		Squirt Test:	(Pass)/Fail	N/A
Booster Pump Required:	Yes/No	Frost Protection:	Aquaflow/(Recirc)/Heat Trace/Bleeder	N/A
PRV Required:	Yes/No	Greased @ CC:	(Yes)/No	N/A
Water Meter Installed:	Yes/No	Continuity Test:	(N/A) Pass/Fail	N/A

CLEARLY INDICATE LOCATION OF CC AND ROUTE OF PIPES ON DRAWING BELOW

1. Show main valves required to isolate this service. 2. All dimensions to be tied to property line 3. All dimensions to be metric 4. Depth @ property line is based on elevation after construction and changes may have occurred.

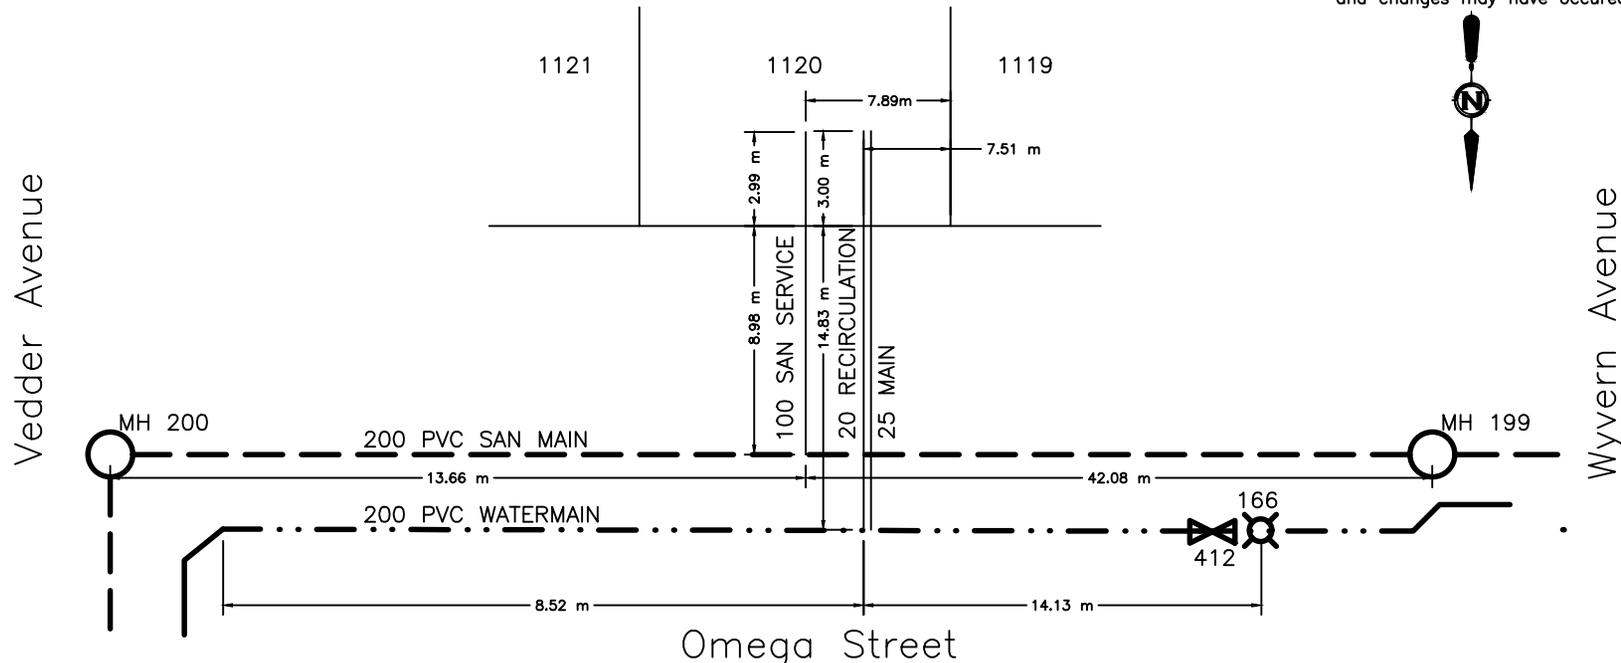



CITY OF WHITEHORSE SERVICE CONNECTION RECORD

FIELD BOOK

No.

ADDRESS 2 Omega Street BLOCK LOT 1121

DATES	WATER	SEWER
On at Main 2020-AUG-13	Depth at P/L: 2.69 m	3.00 m
On at Building	Depth at Main: 2.86 m	3.13 m
Frost Plug:	Pipe Size: 25 mm / 20 mm	100 mm
Memo:	Pipe Material: HDPE Insul. <input checked="" type="checkbox"/> Yes / <input type="checkbox"/> No	PVC Insul. <input checked="" type="checkbox"/> Yes / <input type="checkbox"/> No
	Length from Main to P/L: 18.88 m	8.99 m
	Squirt Test: <input checked="" type="checkbox"/> Pass / <input type="checkbox"/> Fail	N/A
Booster Pump Required: <input type="checkbox"/> Yes / <input checked="" type="checkbox"/> No	Frost Protection: Aquaflo / <input checked="" type="checkbox"/> Recirc / Heat Trace / Bleeder	N/A
PRV Required: <input type="checkbox"/> Yes / <input checked="" type="checkbox"/> No	Greased @ CC: <input checked="" type="checkbox"/> Yes / <input type="checkbox"/> No	N/A
Water Meter Installed: <input type="checkbox"/> Yes / <input checked="" type="checkbox"/> No	Continuity Test: <input checked="" type="checkbox"/> N/A / <input type="checkbox"/> Pass / <input type="checkbox"/> Fail	N/A

CLEARLY INDICATE LOCATION OF CC AND ROUTE OF PIPES ON DRAWING BELOW

1. Show main valves required to isolate this service. 2. All dimensions to be tied to property line 3. All dimensions to be metric 4. Depth @ property line is based on elevation after construction and changes may have occurred.

