




CITY OF WHITEHORSE

SERVICE CONNECTION RECORD

NAME Castle Rock Enterprises ADDRESS 34 Flora Ave BLOCK LOT 1167

DATES	WATER	SEWER
On at Main Sept 14, 2022	Depth at P/L: 672.89m (2.5 m)	Depth at P/L: 672.84m (2.5 m)
On at CC	Depth at Main: 672.14m (3.1 m)	Depth at Main: 672.41m (2.9 m)
Frost Plug	Pipe Size: 25 mm/20 mm	Pipe Size: 100 mm
Memo:	Pipe Material: HDPE Insul. ☒ Yes ☐ No	Pipe Material: PVC Insul. Yes ☒ No ☐ Yes
	Length from Main to P/L: 5.95m	Length from Main to P/L: 9.05m
		STORM
	Squirt Test: ☒ Pass ☐ fail	Depth at P/L:
	Frost Protection: ☒ Recirc ☐ Heat Trace	Depth at Main:
	Continuity Test: n/a Pass/Fail	Pipe Size:
	PRV Required: Yes ☒ No ☐ Yes	Pipe Material:
		Length from Main to P/L:

CLEARLY INDICATE LOCATION OF CC AND ROUTE OF PIPES ON DRAWING BELOW

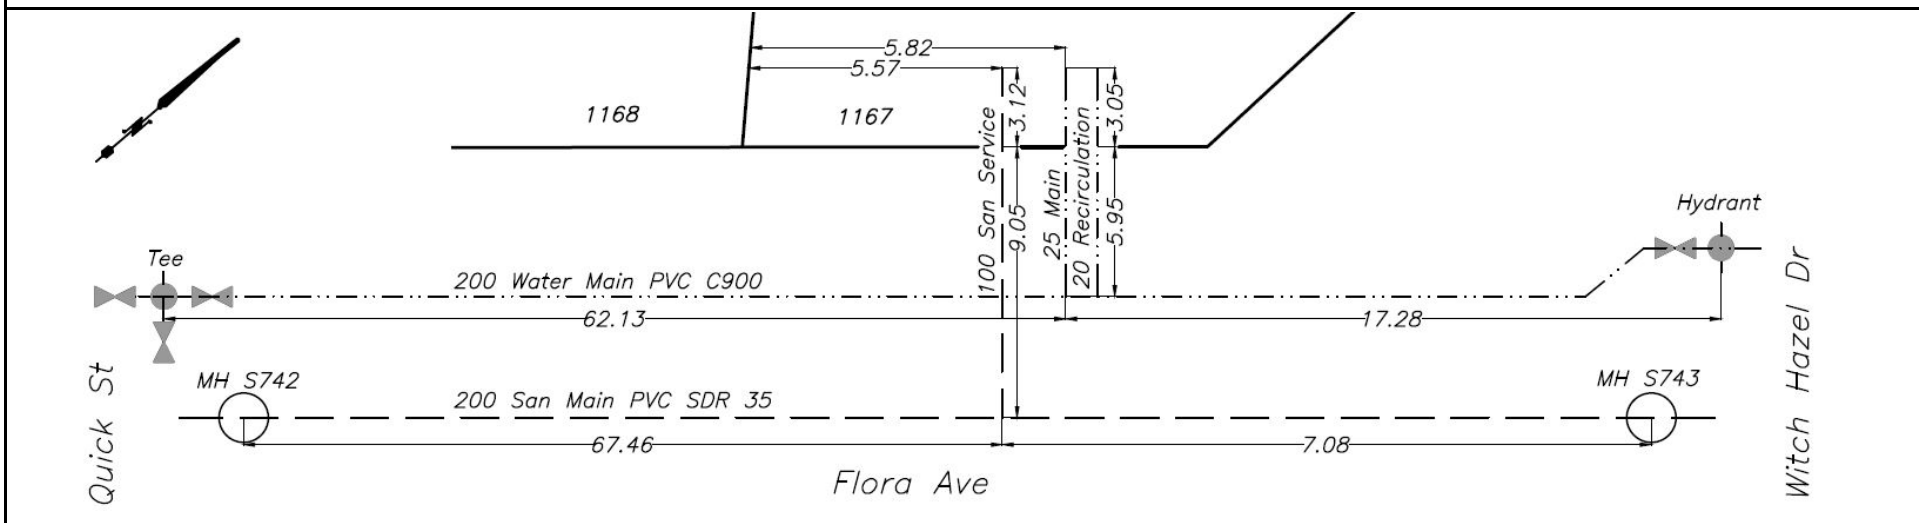




CITY OF WHITEHORSE

SERVICE CONNECTION RECORD

NAME Castle Rock Enterprises ADDRESS 32 Flora Ave BLOCK LOT 1168

DATES	WATER	SEWER
On at Main <u>Sept 14, 2022</u>	Depth at P/L: 672.80m (2.5 m)	Depth at P/L: 672.76m (2.6 m)
On at CC	Depth at Main: 672.05m (3.2 m)	Depth at Main: 672.33m (2.9 m)
Frost Plug	Pipe Size: 25 mm/20 mm	Pipe Size: 100 mm
Memo:	Pipe Material: HDPE Insul. <u>(Yes)</u> No	Pipe Material: PVC Insul. Yes <u>(No)</u>
	Length from Main to P/L: 5.94m	Length from Main to P/L: 9.05m
		STORM
	Squirt Test: <u>(Pass)</u> fail	Depth at P/L:
	Frost Protection: <u>(Recirc)</u> Heat Trace	Depth at Main:
	Continuity Test: n/a Pass/Fail	Pipe Size:
	PRV Required: Yes/ <u>(No)</u>	Pipe Material:
		Length from Main to P/L:

CLEARLY INDICATE LOCATION OF CC AND ROUTE OF PIPES ON DRAWING BELOW

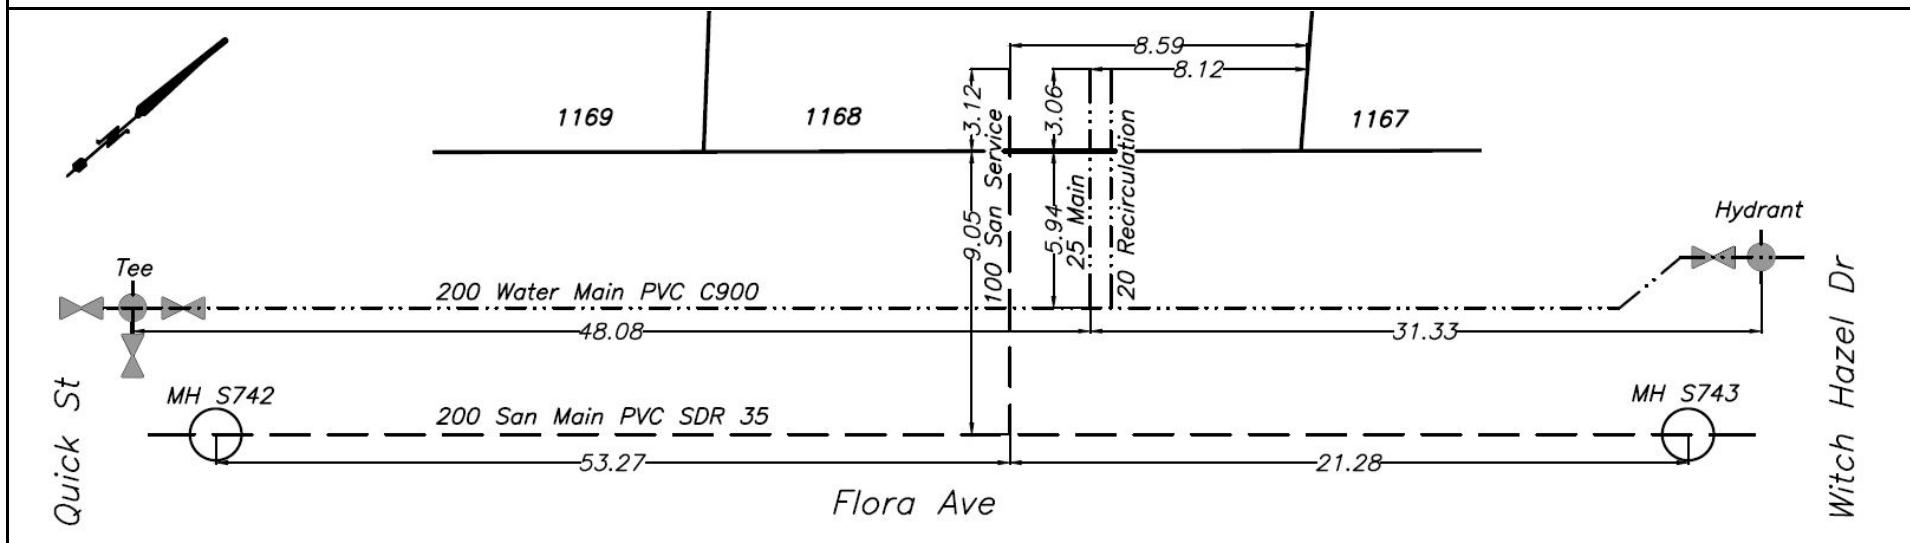




CITY OF WHITEHORSE

SERVICE CONNECTION RECORD

NAME Castle Rock Enterprises ADDRESS 30 Flora Ave BLOCK LOT 1169

DATES	WATER	SEWER
On at Main Sept 14, 2022	Depth at P/L: 672.72m (2.5 m)	Depth at P/L: 672.68m (2.6 m)
On at CC	Depth at Main: 671.93m (3.2 m)	Depth at Main: 672.22m (3.0 m)
Frost Plug	Pipe Size: 25 mm/20 mm	Pipe Size: 100 mm
Memo:	Pipe Material: HDPE Insul. ☒ Yes ☐ No	Pipe Material: PVC Insul. Yes ☒ No ☐ Yes
	Length from Main to P/L: 6.01m	Length from Main to P/L: 8.97m
		STORM
	Squirt Test: ☒ Pass ☐ fail	Depth at P/L:
	Frost Protection: ☒ Recirc ☐ Heat Trace	Depth at Main:
	Continuity Test: n/a Pass/Fail	Pipe Size:
	PRV Required: Yes ☒ No ☐ Yes	Pipe Material:
		Length from Main to P/L:

CLEARLY INDICATE LOCATION OF CC AND ROUTE OF PIPES ON DRAWING BELOW

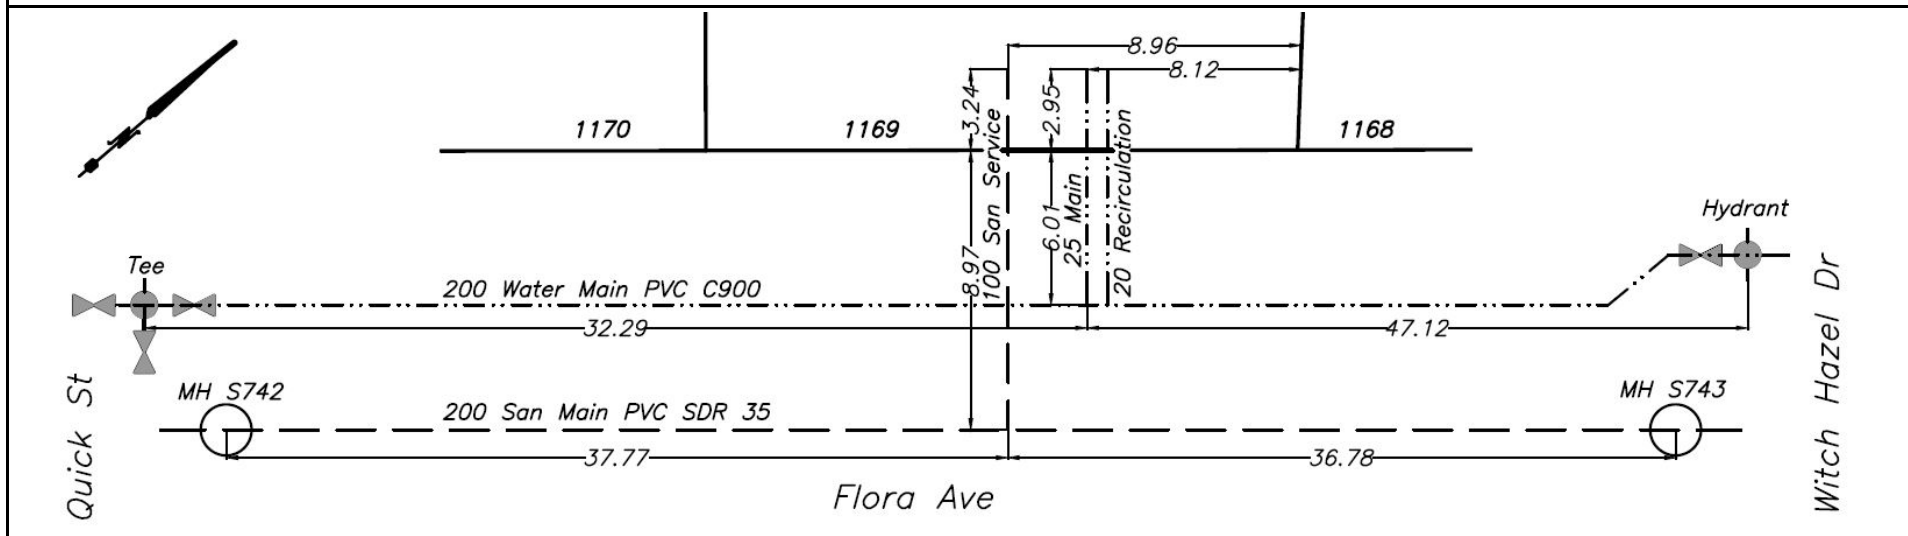




CITY OF WHITEHORSE

SERVICE CONNECTION RECORD

NAME Castle Rock Enterprises ADDRESS 28 Flora Ave BLOCK LOT 1170

DATES	WATER	SEWER
On at Main Sept 14, 2022	Depth at P/L: 672.57m (2.6 m)	Depth at P/L: 672.52m (2.6 m)
On at CC	Depth at Main: 671.78m (3.3 m)	Depth at Main: 672.13m (3.0 m)
Frost Plug	Pipe Size: 25 mm/20 mm	Pipe Size: 100 mm
Memo:	Pipe Material: HDPE Insul. ☒ Yes ☐ No	Pipe Material: PVC Insul. Yes ☒ No ☐ Yes
	Length from Main to P/L: 5.98m	Length from Main to P/L: 9.09m
		STORM
	Squirt Test: ☒ Pass ☐ fail	Depth at P/L:
	Frost Protection: ☒ Recirc ☐ Heat Trace	Depth at Main:
	Continuity Test: n/a Pass/Fail	Pipe Size:
	PRV Required: Yes ☒ No ☐ Yes	Pipe Material:
		Length from Main to P/L:

CLEARLY INDICATE LOCATION OF CC AND ROUTE OF PIPES ON DRAWING BELOW

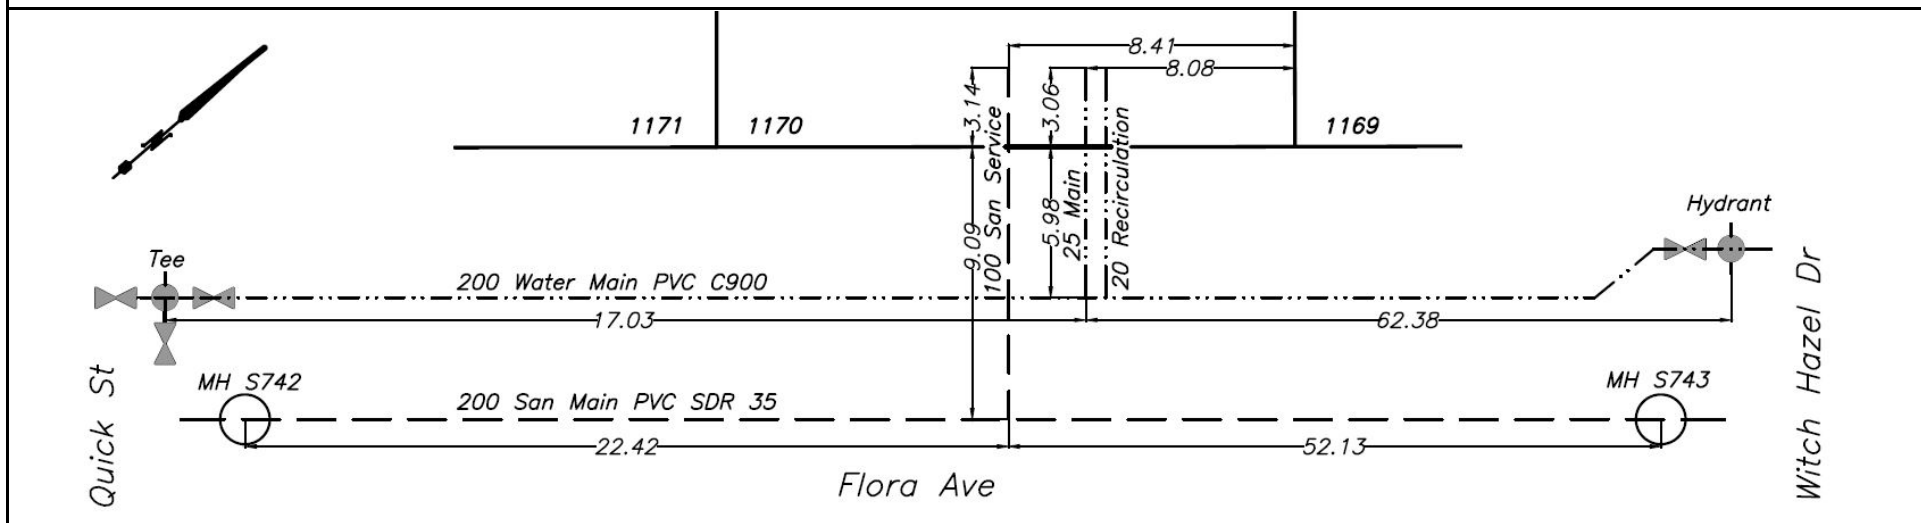




CITY OF WHITEHORSE

SERVICE CONNECTION RECORD

NAME Castle Rock Enterprises ADDRESS 26 Flora Ave BLOCK LOT 1171

DATES	WATER	SEWER
On at Main Sept 14, 2022	Depth at P/L: 672.55m (2.5 m)	Depth at P/L: 672.49m (2.6 m)
On at CC	Depth at Main: 671.72m (3.3 m)	Depth at Main: 672.03m (3.0 m)
Frost Plug	Pipe Size: 25 mm/20 mm	Pipe Size: 100 mm
Memo:	Pipe Material: HDPE Insul. ☒ Yes ☐ No	Pipe Material: PVC Insul. Yes ☒ No ☐ Yes
	Length from Main to P/L: 6.00m	Length from Main to P/L: 8.96m
		STORM
	Squirt Test: ☒ Pass ☐ fail	Depth at P/L:
	Frost Protection: ☒ Recirc ☐ Heat Trace	Depth at Main:
	Continuity Test: n/a Pass/Fail	Pipe Size:
	PRV Required: Yes ☒ No ☐ Yes	Pipe Material:
		Length from Main to P/L:

CLEARLY INDICATE LOCATION OF CC AND ROUTE OF PIPES ON DRAWING BELOW

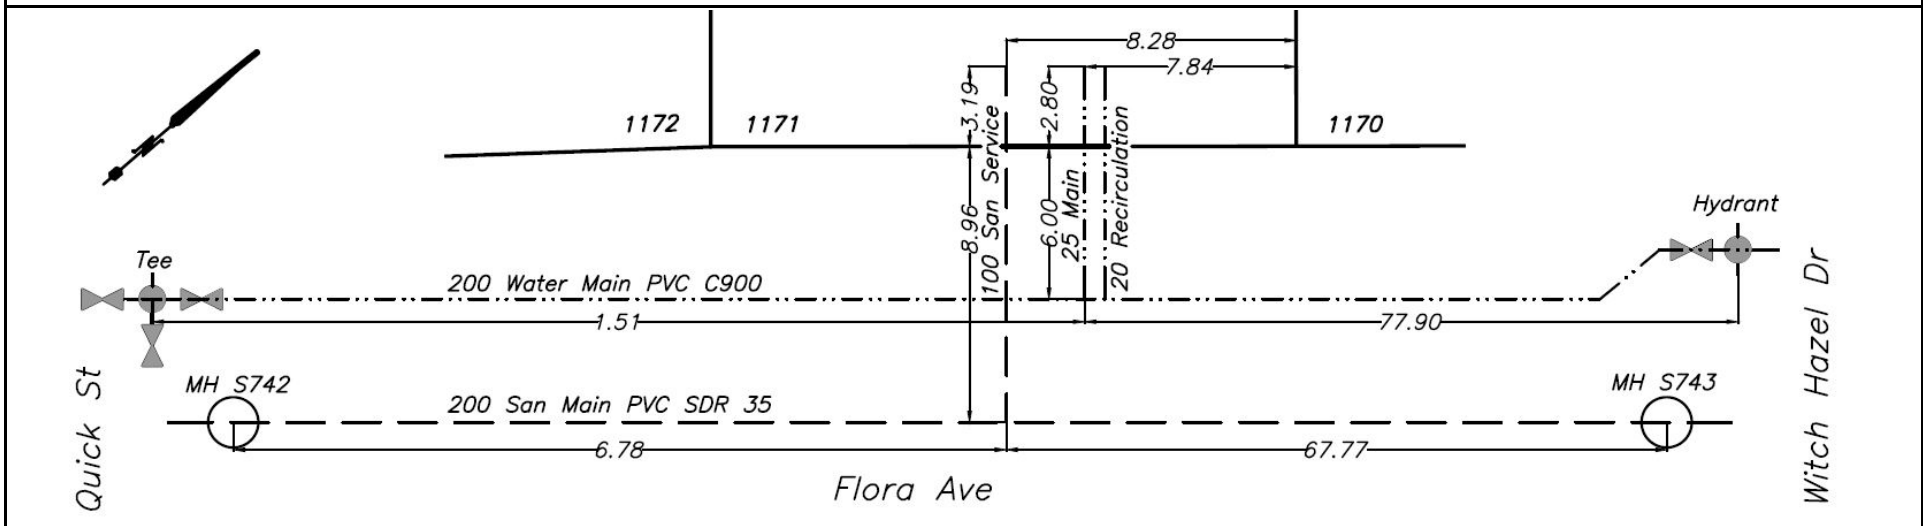




CITY OF WHITEHORSE

SERVICE CONNECTION RECORD

NAME Castle Rock Enterprises ADDRESS 24 Flora Ave BLOCK LOT 1172

DATES	WATER	SEWER
On at Main July 27, 2022	Depth at P/L: 672.43m (2.6 m)	Depth at P/L: 672.31m (2.7 m)
On at CC	Depth at Main: 671.64m (3.3 m)	Depth at Main: 670.31m (4.6 m)
Frost Plug	Pipe Size: 25 mm/20 mm	Pipe Size: 100 mm
Memo:	Pipe Material: HDPE Insul. ☒ Yes ☐ No	Pipe Material: PVC Insul. Yes ☒ No ☐ Yes
	Length from Main to P/L: 6.21m	Length from Main to P/L: 9.23m
		STORM
	Squirt Test: ☒ Pass ☐ fail	Depth at P/L:
	Frost Protection: ☒ Recirc ☐ Heat Trace	Depth at Main:
	Continuity Test: n/a Pass/Fail	Pipe Size:
	PRV Required: Yes ☒ No ☐ Yes	Pipe Material:
		Length from Main to P/L:

CLEARLY INDICATE LOCATION OF CC AND ROUTE OF PIPES ON DRAWING BELOW

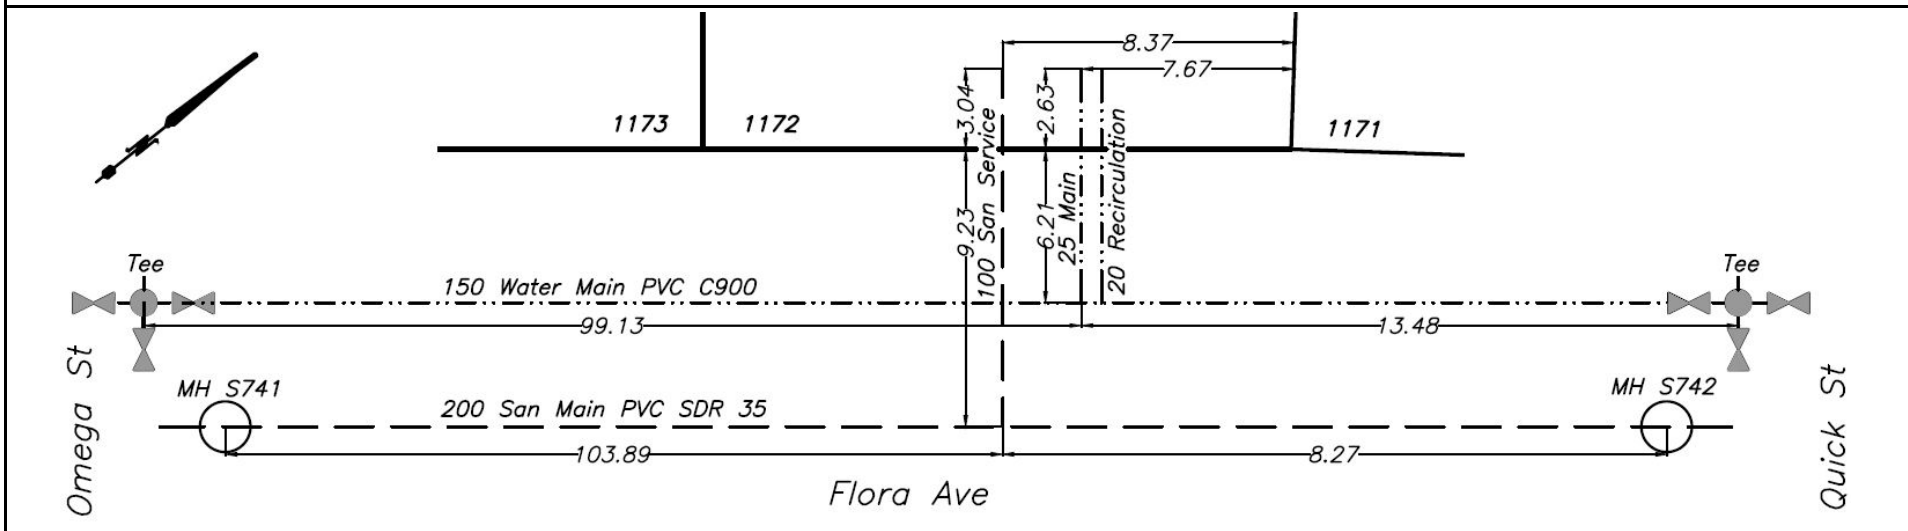




CITY OF WHITEHORSE

SERVICE CONNECTION RECORD

NAME Castle Rock Enterprises ADDRESS 22 Flora Ave BLOCK LOT 1173

DATES	WATER	SEWER
On at Main July 27, 2022	Depth at P/L: 672.33m (2.6 m)	Depth at P/L: 672.26m (2.7 m)
On at CC	Depth at Main: 671.59m (3.2 m)	Depth at Main: 670.39m (4.5 m)
Frost Plug	Pipe Size: 25 mm/20 mm	Pipe Size: 100 mm
Memo:	Pipe Material: HDPE Insul. ☒ Yes ☐ No	Pipe Material: PVC Insul. Yes ☒ No ☐ Yes
	Length from Main to P/L: 6.18m	Length from Main to P/L: 9.17m
		STORM
	Squirt Test: ☒ Pass ☐ fail	Depth at P/L:
	Frost Protection: ☒ Recirc ☐ Heat Trace	Depth at Main:
	Continuity Test: n/a Pass/Fail	Pipe Size:
	PRV Required: Yes ☒ No ☐ Yes	Pipe Material:
		Length from Main to P/L:

CLEARLY INDICATE LOCATION OF CC AND ROUTE OF PIPES ON DRAWING BELOW

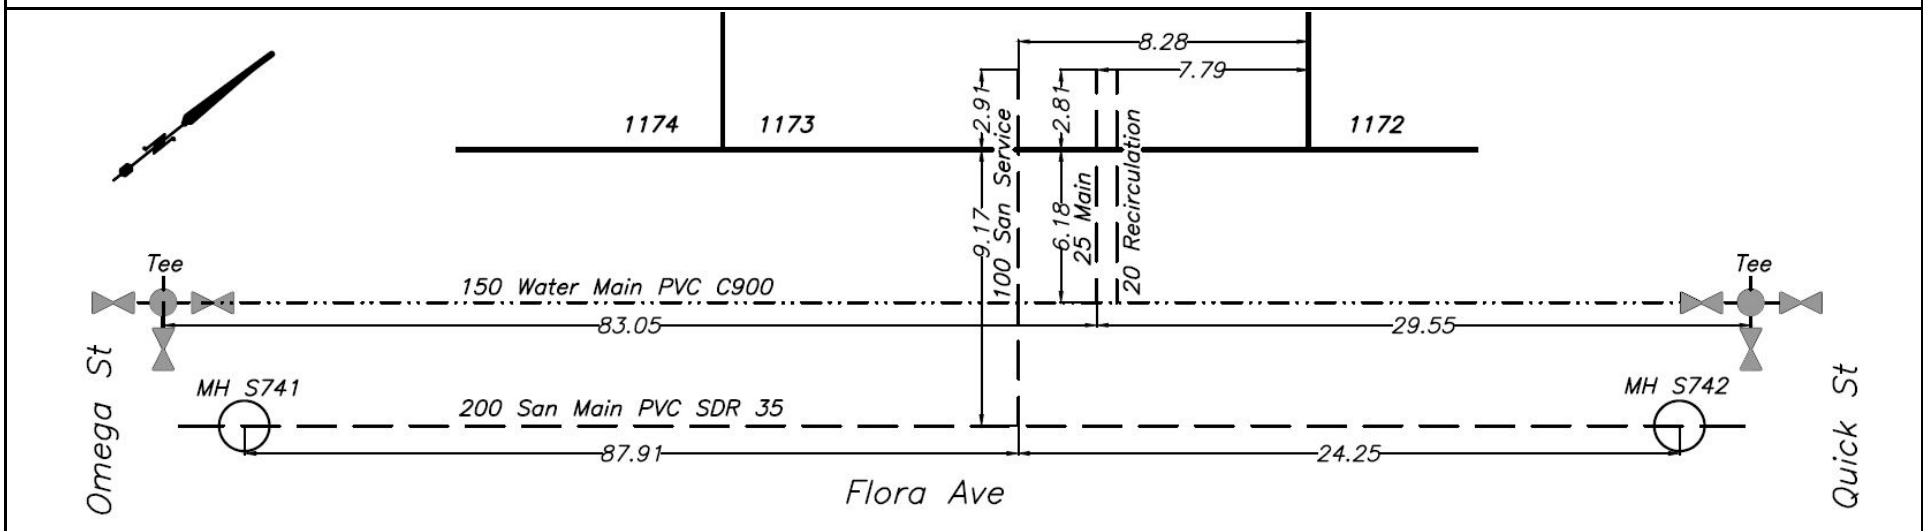




CITY OF WHITEHORSE

SERVICE CONNECTION RECORD

NAME Castle Rock Enterprises ADDRESS 20 Flora Ave BLOCK LOT 1174

DATES	WATER	SEWER
On at Main July 27, 2022	Depth at P/L: 672.25m (2.6 m)	Depth at P/L: 672.16m (2.7 m)
On at CC	Depth at Main: 671.52m (3.2 m)	Depth at Main: 670.45m (4.3 m)
Frost Plug	Pipe Size: 25 mm/20 mm	Pipe Size: 100 mm
Memo:	Pipe Material: HDPE Insul. <u>(Yes)</u> No	Pipe Material: PVC Insul. Yes <u>(No)</u>
	Length from Main to P/L: 6.20m	Length from Main to P/L: 9.23m
		STORM
	Squirt Test: <u>(Pass)</u> fail	Depth at P/L:
	Frost Protection: <u>(Recirc)</u> Heat Trace	Depth at Main:
	Continuity Test: n/a Pass/Fail	Pipe Size:
	PRV Required: Yes/ <u>(No)</u>	Pipe Material:
		Length from Main to P/L:

CLEARLY INDICATE LOCATION OF CC AND ROUTE OF PIPES ON DRAWING BELOW

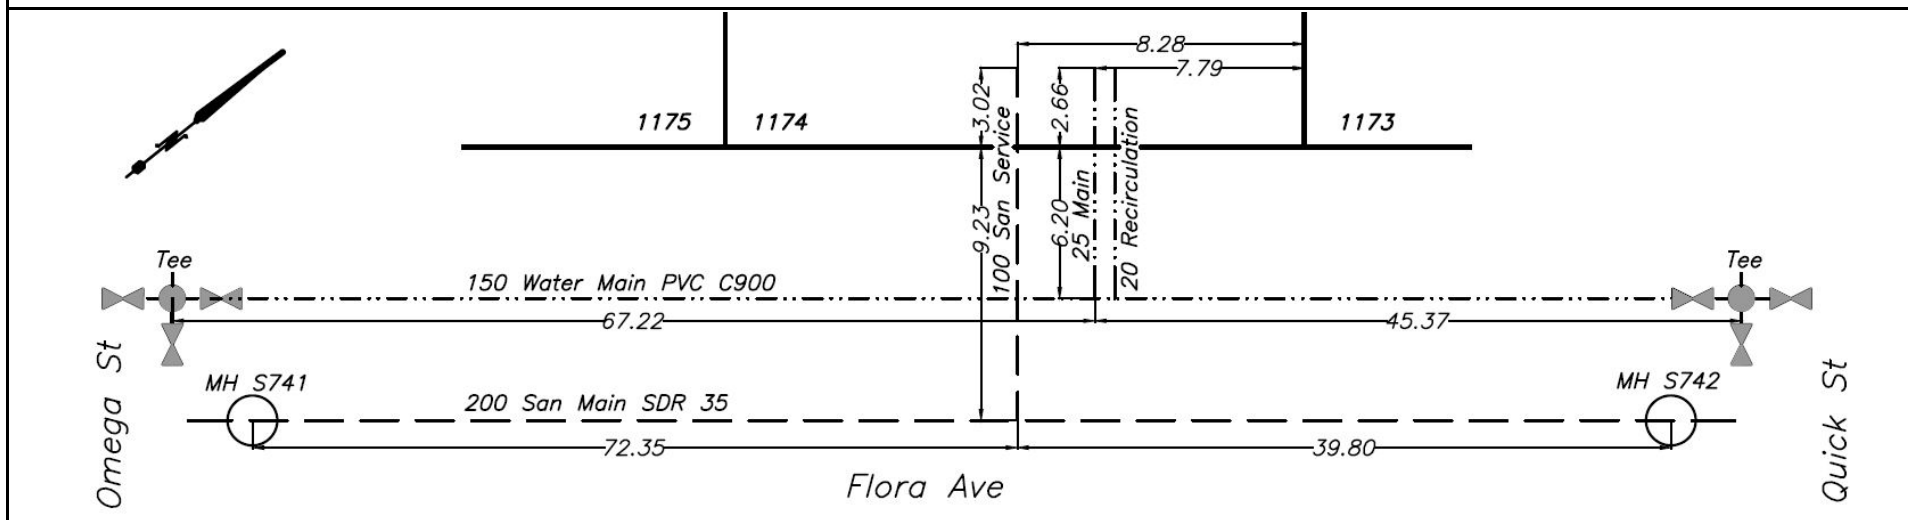




CITY OF WHITEHORSE

SERVICE CONNECTION RECORD

NAME Castle Rock Enterprises ADDRESS 18 Flora Ave BLOCK LOT 1175

DATES	WATER	SEWER
On at Main July 27, 2022	Depth at P/L: 672.10m (2.7 m)	Depth at P/L: 672.07m (2.7 m)
On at CC	Depth at Main: 671.46m (3.2 m)	Depth at Main: 670.50m (4.2 m)
Frost Plug	Pipe Size: 25 mm/20 mm	Pipe Size: 100 mm
Memo:	Pipe Material: HDPE Insul. ☒ Yes ☐ No	Pipe Material: PVC Insul. Yes ☒ No ☐ Yes
	Length from Main to P/L: 6.17m	Length from Main to P/L: 9.11m
		STORM
	Squirt Test: ☒ Pass ☐ fail	Depth at P/L:
	Frost Protection: ☒ Recirc ☐ Heat Trace	Depth at Main:
	Continuity Test: n/a Pass/Fail	Pipe Size:
	PRV Required: Yes ☒ No ☐ Yes	Pipe Material:
		Length from Main to P/L:

CLEARLY INDICATE LOCATION OF CC AND ROUTE OF PIPES ON DRAWING BELOW

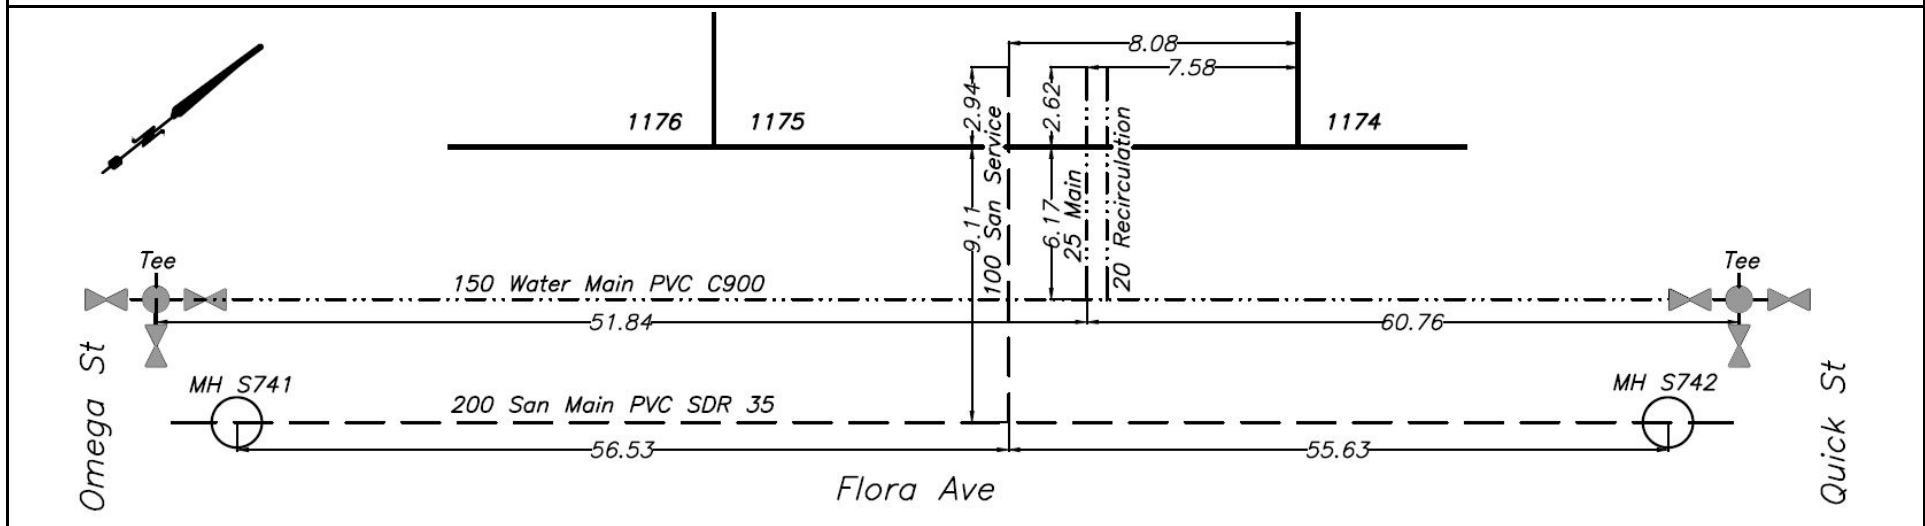




CITY OF WHITEHORSE

SERVICE CONNECTION RECORD

NAME Castle Rock Enterprises ADDRESS 16 Flora Ave BLOCK LOT 1176

DATES	WATER	SEWER
On at Main July 27, 2022	Depth at P/L: 672.13m (2.6 m)	Depth at P/L: 672.01m (2.7 m)
On at CC	Depth at Main: 671.40m (3.2 m)	Depth at Main: 670.56m (4.1 m)
Frost Plug	Pipe Size: 25 mm/20 mm	Pipe Size: 100 mm
Memo:	Pipe Material: HDPE Insul. ☒ Yes ☐ No	Pipe Material: PVC Insul. Yes ☒ No ☐ Yes
	Length from Main to P/L: 6.18m	Length from Main to P/L: 9.10m
		STORM
	Squirt Test: ☒ Pass ☐ fail	Depth at P/L:
	Frost Protection: ☒ Recirc ☐ Heat Trace	Depth at Main:
	Continuity Test: n/a Pass/Fail	Pipe Size:
	PRV Required: Yes ☒ No ☐ Yes	Pipe Material:
		Length from Main to P/L:

CLEARLY INDICATE LOCATION OF CC AND ROUTE OF PIPES ON DRAWING BELOW

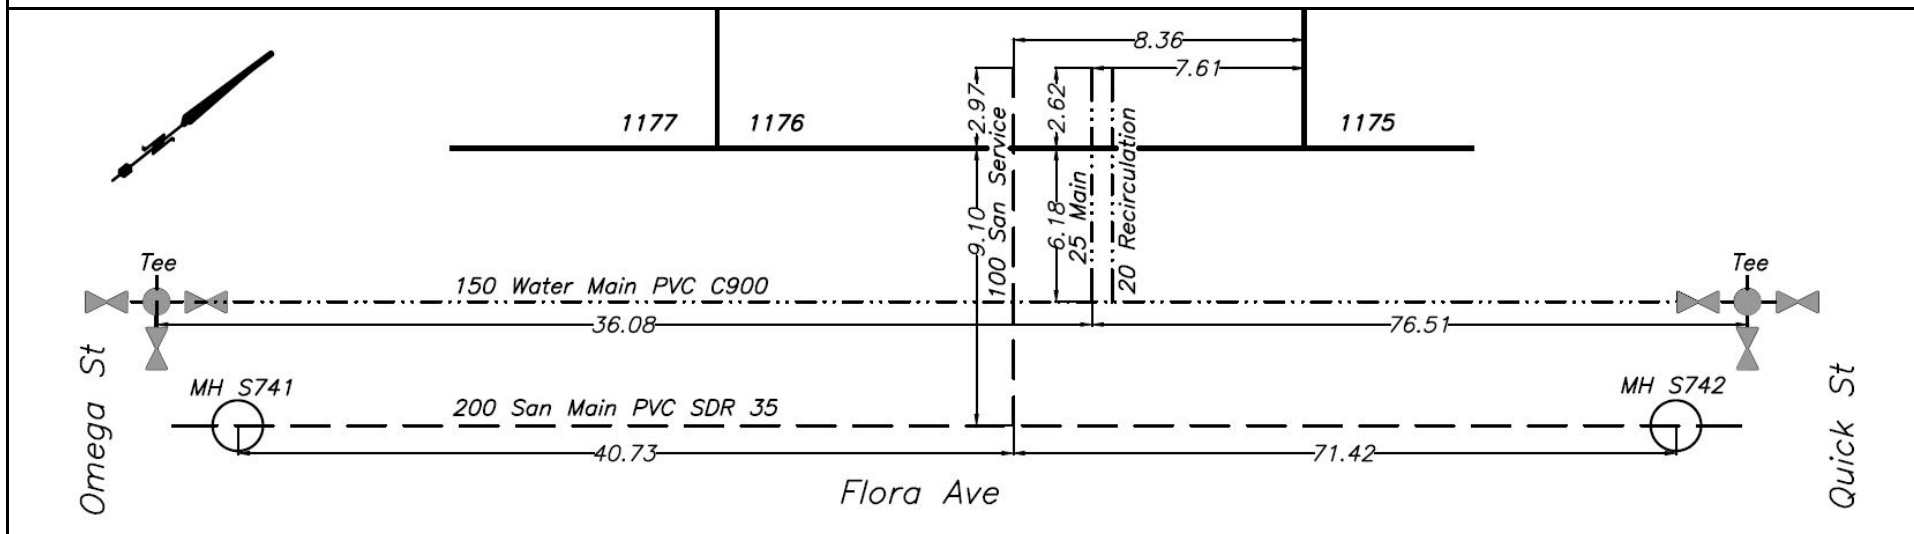




CITY OF WHITEHORSE

SERVICE CONNECTION RECORD

NAME Castle Rock Enterprises ADDRESS 14 Flora Ave BLOCK LOT 1177

DATES	WATER	SEWER
On at Main July 27, 2022	Depth at P/L: 671.96m (2.7 m)	Depth at P/L: 671.81m (2.8 m)
On at CC	Depth at Main: 671.30m (3.2 m)	Depth at Main: 670.59m (4.0 m)
Frost Plug	Pipe Size: 25 mm/20 mm	Pipe Size: 100 mm
Memo:	Pipe Material: HDPE Insul. ☒ Yes ☐ No	Pipe Material: PVC Insul. Yes ☒ No ☐ Yes
	Length from Main to P/L: 6.17m	Length from Main to P/L: 8.99m
		STORM
	Squirt Test: ☒ Pass ☐ fail	Depth at P/L:
	Frost Protection: ☒ Recirc ☐ Heat Trace	Depth at Main:
	Continuity Test: n/a Pass/Fail	Pipe Size:
	PRV Required: Yes ☒ No ☐ Yes	Pipe Material:
		Length from Main to P/L:

CLEARLY INDICATE LOCATION OF CC AND ROUTE OF PIPES ON DRAWING BELOW

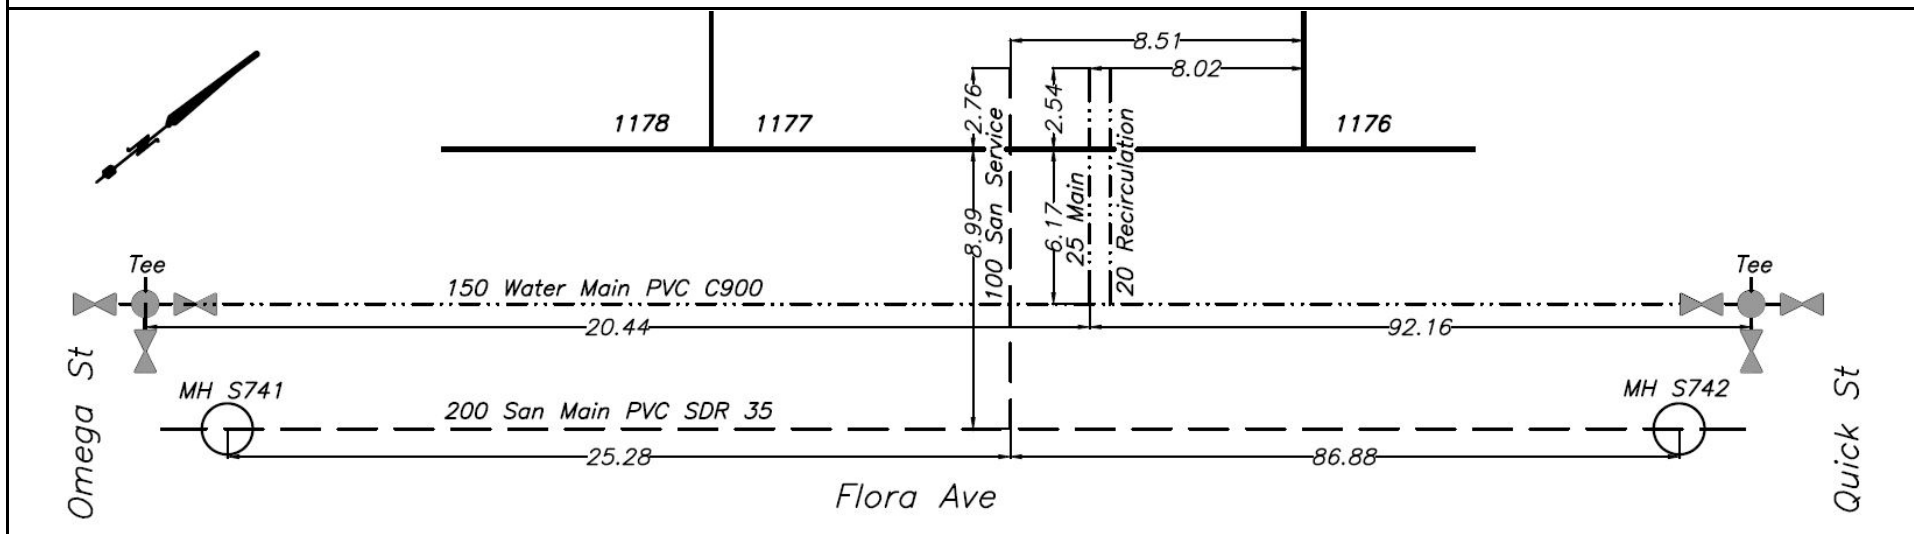




CITY OF WHITEHORSE

SERVICE CONNECTION RECORD

NAME Castle Rock Enterprises ADDRESS 12 Flora Ave BLOCK LOT 1178

DATES	WATER	SEWER
On at Main July 27, 2022	Depth at P/L: 671.89m (2.6 m)	Depth at P/L: 671.84m (2.7 m)
On at CC	Depth at Main: 671.26m (3.2 mm)	Depth at Main: 670.65m (3.8 m)
Frost Plug	Pipe Size: 25 mm/20 mm	Pipe Size: 100 mm
Memo:	Pipe Material: HDPE Insul. ☒ Yes ☐ No	Pipe Material: PVC Insul. Yes ☒ No ☐ Yes
	Length from Main to P/L: 6.25m	Length from Main to P/L: 9.04m
		STORM
	Squirt Test: ☒ Pass ☐ fail	Depth at P/L:
	Frost Protection: ☒ Recirc ☐ Heat Trace	Depth at Main:
	Continuity Test: n/a Pass/Fail	Pipe Size:
	PRV Required: Yes ☒ No ☐ Yes	Pipe Material:
		Length from Main to P/L:

CLEARLY INDICATE LOCATION OF CC AND ROUTE OF PIPES ON DRAWING BELOW

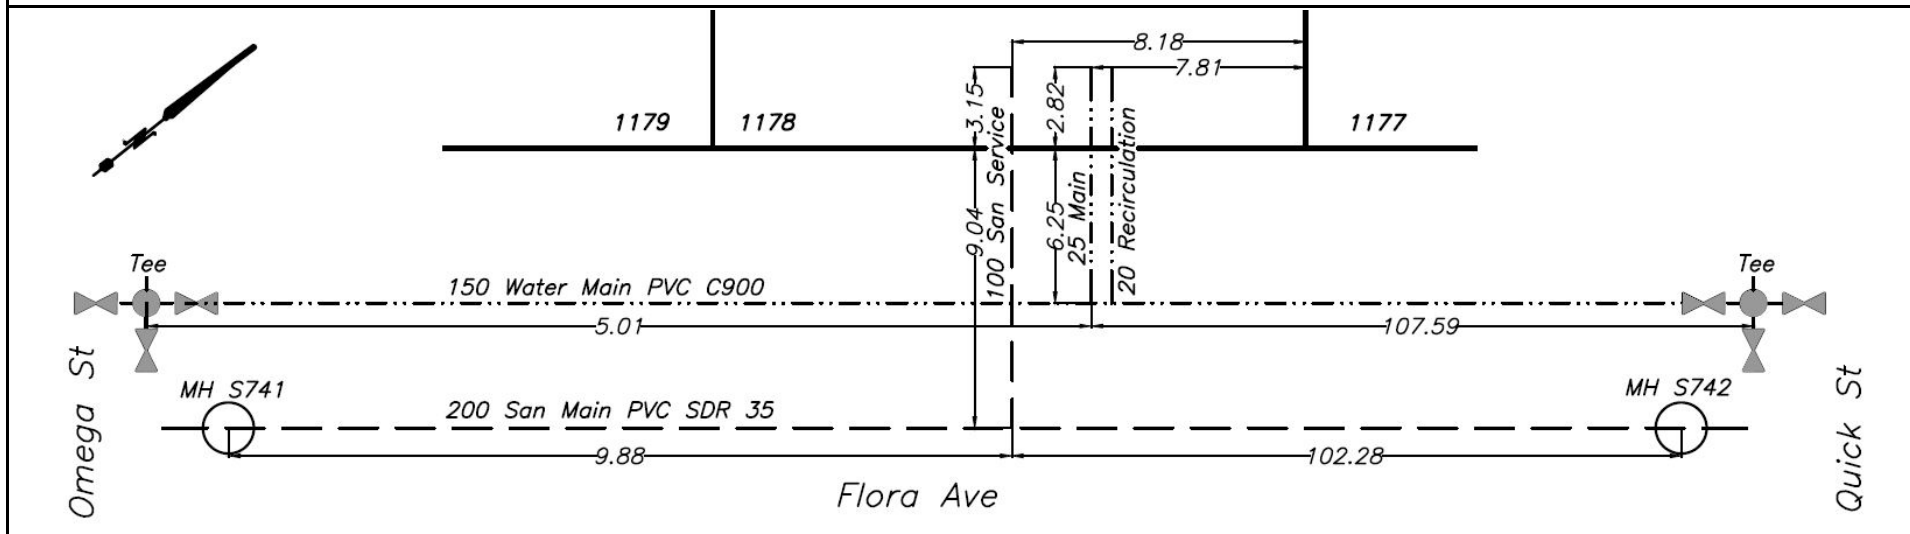




CITY OF WHITEHORSE

SERVICE CONNECTION RECORD

NAME Castle Rock Enterprises ADDRESS 10 Flora Ave BLOCK LOT 1179

DATES	WATER	SEWER
On at Main July 27, 2022	Depth at P/L: 671.82m (2.6 m)	Depth at P/L: 671.76m (2.7 m)
On at CC	Depth at Main: 671.17m (3.2 m)	Depth at Main: 670.76m (3.6 m)
Frost Plug	Pipe Size: 25 mm/20 mm	Pipe Size: 100 mm
Memo:	Pipe Material: HDPE Insul. ☒ Yes ☐ No	Pipe Material: PVC Insul. Yes ☐ Yes ☒ No
	Length from Main to P/L: 5.44m	Length from Main to P/L: 9.20m
		STORM
	Squirt Test: ☒ Pass ☐ fail	Depth at P/L:
	Frost Protection: ☒ Recirc ☐ Heat Trace	Depth at Main:
	Continuity Test: n/a Pass/Fail	Pipe Size:
	PRV Required: Yes ☐ No ☒	Pipe Material:
		Length from Main to P/L:

CLEARLY INDICATE LOCATION OF CC AND ROUTE OF PIPES ON DRAWING BELOW

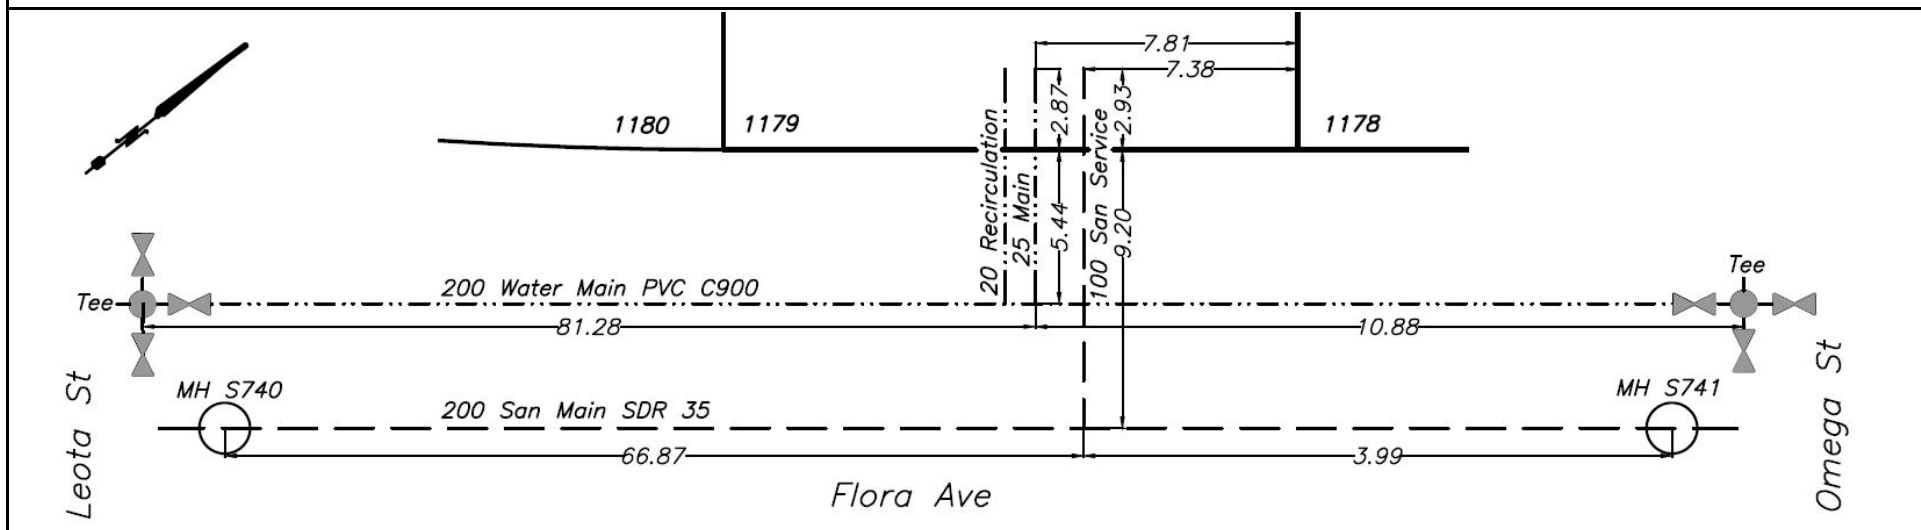




CITY OF WHITEHORSE

SERVICE CONNECTION RECORD

NAME Castle Rock Enterprises ADDRESS 8 Flora Ave BLOCK LOT 1180

DATES	WATER	SEWER
On at Main July 27, 2022	Depth at P/L: 671.55m (2.8 m)	Depth at P/L: 671.51m (2.9 m)
On at CC	Depth at Main: 671.12m (3.1 m)	Depth at Main: 670.87m (3.5 m)
Frost Plug	Pipe Size: 25 mm/20 mm	Pipe Size: 100 mm
Memo:	Pipe Material: HDPE Insul. ☒ Yes ☐ No	Pipe Material: PVC Insul. Yes ☒ No ☐ Yes
	Length from Main to P/L: 5.73m	Length from Main to P/L: 9.03m
		STORM
	Squirt Test: ☒ Pass ☐ fail	Depth at P/L:
	Frost Protection: ☒ Recirc ☐ Heat Trace	Depth at Main:
	Continuity Test: n/a Pass/Fail	Pipe Size:
	PRV Required: Yes ☒ No ☐ Yes	Pipe Material:
		Length from Main to P/L:

CLEARLY INDICATE LOCATION OF CC AND ROUTE OF PIPES ON DRAWING BELOW

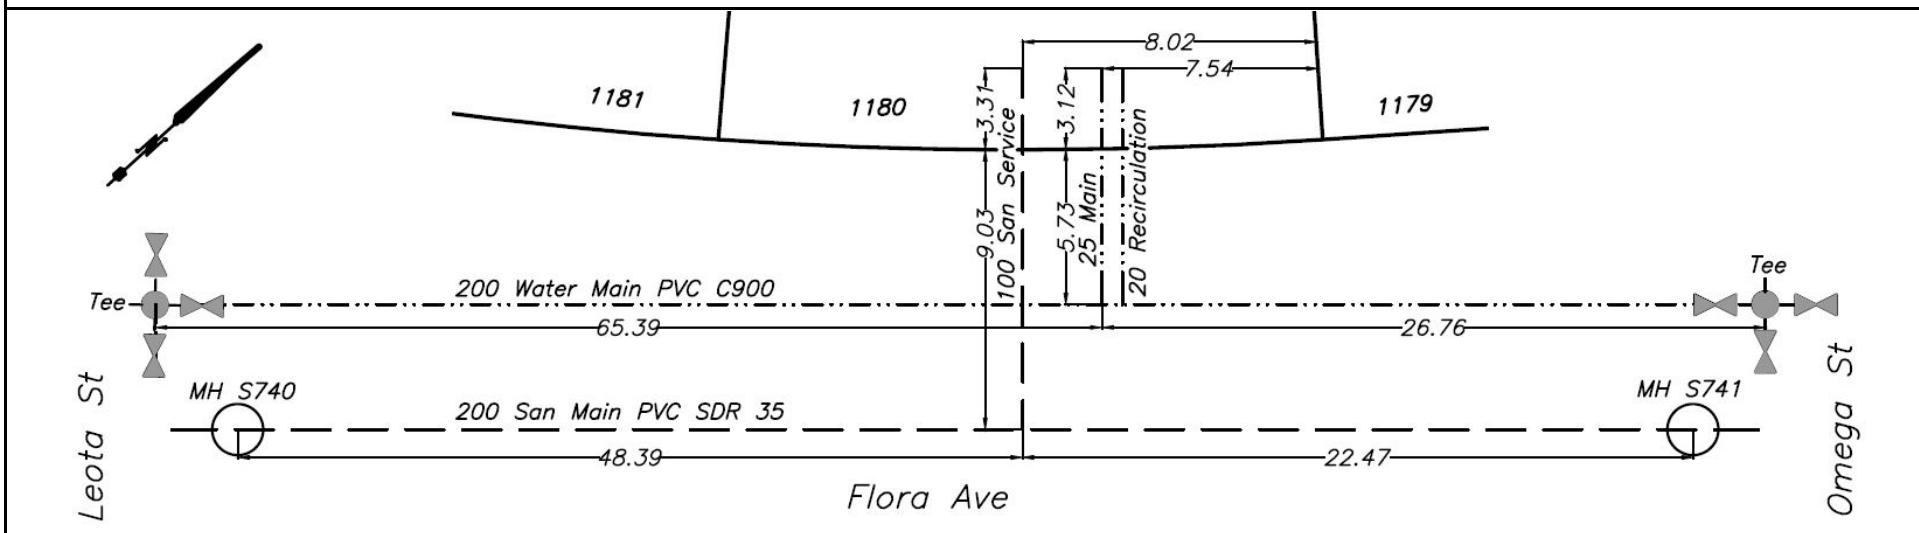




CITY OF WHITEHORSE

SERVICE CONNECTION RECORD

NAME Castle Rock Enterprises ADDRESS 6 Flora Ave BLOCK LOT 1181

DATES	WATER	SEWER
On at Main July 27, 2022	Depth at P/L: 671.65m (2.6 m)	Depth at P/L: 671.49m (2.8 m)
On at CC	Depth at Main: 671.08m (3.1 m)	Depth at Main: 670.98m (3.3 m)
Frost Plug	Pipe Size: 25 mm/20 mm	Pipe Size: 100 mm
Memo:	Pipe Material: HDPE Insul. ☒ Yes ☐ No	Pipe Material: PVC Insul. Yes ☐ No ☒
	Length from Main to P/L: 5.99m	Length from Main to P/L: 8.75m
		STORM
	Squirt Test: ☒ Pass ☐ fail	Depth at P/L:
	Frost Protection: ☒ Recirc ☐ Heat Trace	Depth at Main:
	Continuity Test: n/a Pass/Fail	Pipe Size:
	PRV Required: Yes ☐ No ☒	Pipe Material:
		Length from Main to P/L:

CLEARLY INDICATE LOCATION OF CC AND ROUTE OF PIPES ON DRAWING BELOW

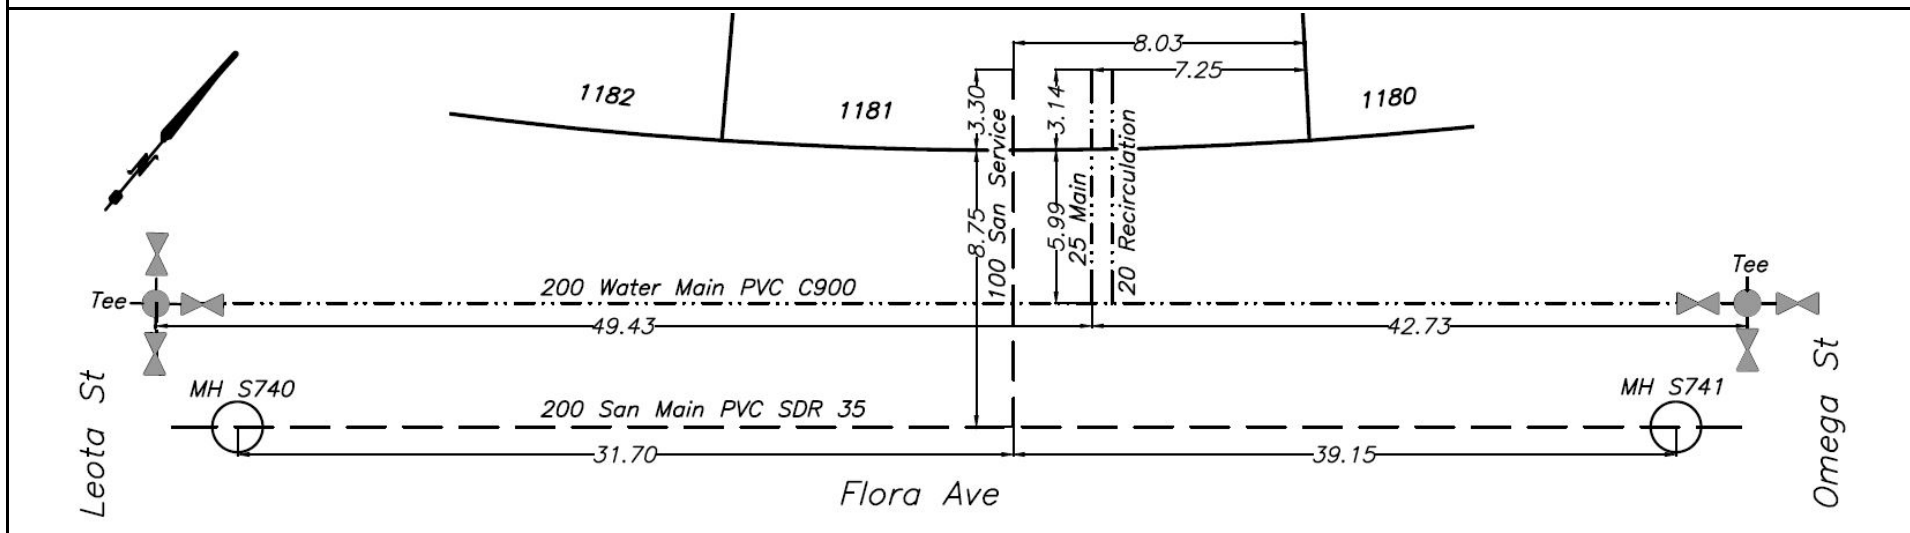




CITY OF WHITEHORSE

SERVICE CONNECTION RECORD

NAME Castle Rock Enterprises ADDRESS 4 Flora Ave BLOCK LOT 1182

DATES	WATER	SEWER
On at Main July 27, 2022	Depth at P/L: 671.58m (2.6 m)	Depth at P/L: 671.46m (2.8 m)
On at CC	Depth at Main: 671.02m (3.1 m)	Depth at Main: 671.08m (3.1 m)
Frost Plug	Pipe Size: 25 mm/20 mm	Pipe Size: 100 mm
Memo:	Pipe Material: HDPE Insul. ☒ Yes ☐ No	Pipe Material: PVC Insul. Yes ☒ No ☐ Yes
	Length from Main to P/L: 5.96m	Length from Main to P/L: 8.35m
		STORM
	Squirt Test: ☒ Pass ☐ fail	Depth at P/L:
	Frost Protection: ☒ Recirc ☐ Heat Trace	Depth at Main:
	Continuity Test: n/a Pass/Fail	Pipe Size:
	PRV Required: Yes ☒ No ☐	Pipe Material:
		Length from Main to P/L:

CLEARLY INDICATE LOCATION OF CC AND ROUTE OF PIPES ON DRAWING BELOW

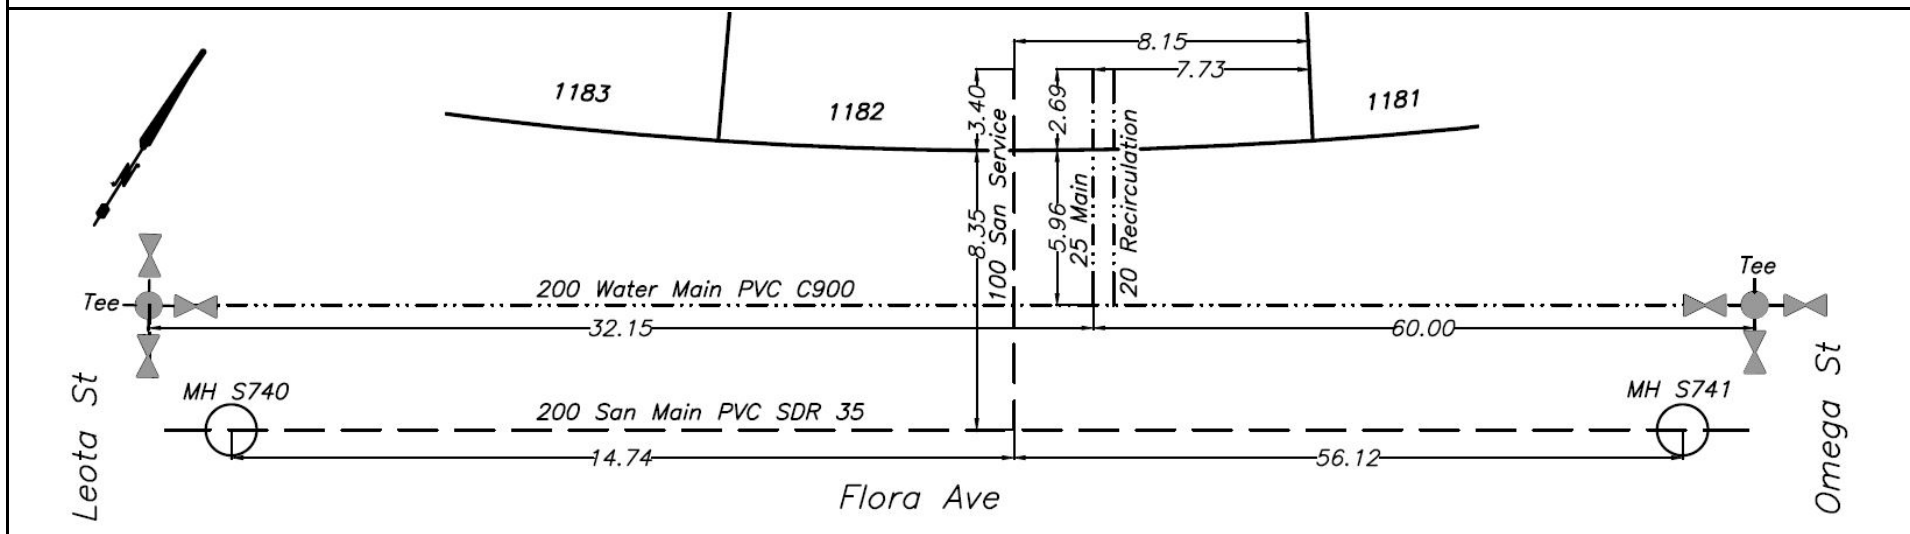




CITY OF WHITEHORSE

SERVICE CONNECTION RECORD

NAME Castle Rock Enterprises ADDRESS 2 Flora Ave BLOCK LOT 1183

DATES	WATER	SEWER
On at Main July 29, 2022	Depth at P/L: 671.63m (2.5 m)	Depth at P/L: 671.61m (2.5 m)
On at CC	Depth at Main: 671.01m (3.0 m)	Depth at Main: 671.19m (2.9 m)
Frost Plug	Pipe Size: 25 mm/20 mm	Pipe Size: 100 mm
Memo:	Pipe Material: HDPE Insul. ☒ Yes ☐ No	Pipe Material: PVC Insul. Yes ☒ No ☐ Yes
	Length from Main to P/L: 6.09m	Length from Main to P/L: 8.28m
		STORM
	Squirt Test: ☒ Pass ☐ fail	Depth at P/L:
	Frost Protection: ☒ Recirc ☐ Heat Trace	Depth at Main:
	Continuity Test: n/a Pass/Fail	Pipe Size:
	PRV Required: Yes ☒ No ☐ No	Pipe Material:
		Length from Main to P/L:

CLEARLY INDICATE LOCATION OF CC AND ROUTE OF PIPES ON DRAWING BELOW

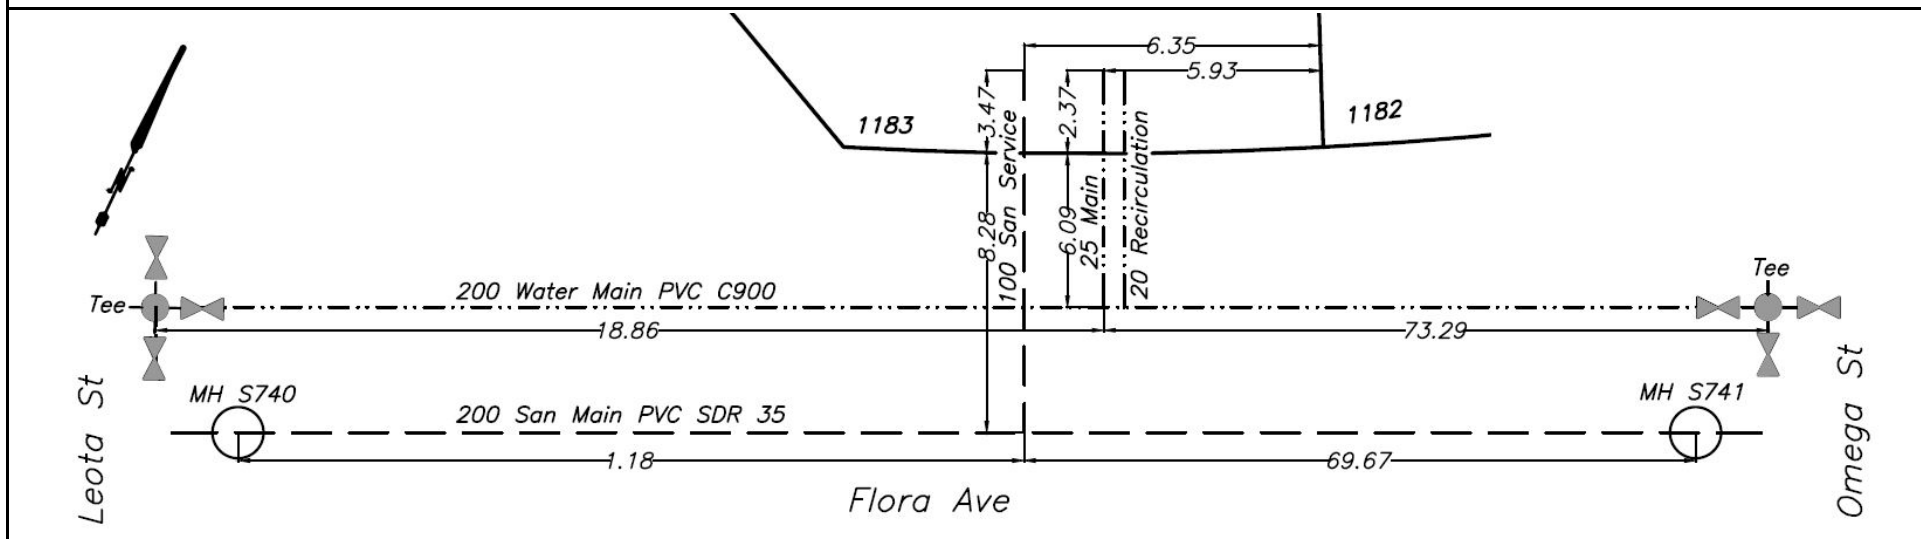




CITY OF WHITEHORSE

SERVICE CONNECTION RECORD

NAME Castle Rock Enterprises ADDRESS 23 Quick St BLOCK LOT 1188

DATES	WATER	SEWER
On at Main September 7, 2022	Depth at P/L: 672.51m (2.6 m)	Depth at P/L: 672.48m (2.6 m)
On at CC	Depth at Main: 672.17m (2.9 m)	Depth at Main: 671.97m (3.1 m)
Frost Plug	Pipe Size: 25 mm/20 mm	Pipe Size: 100 mm
Memo:	Pipe Material: HDPE Insul. ☒ Yes ☐ No	Pipe Material: PVC Insul. Yes ☒ No ☐ Yes
	Length from Main to P/L: 6.06m	Length from Main to P/L: 8.96m
		STORM
	Squirt Test: ☒ Pass ☐ fail	Depth at P/L:
	Frost Protection: ☒ Recirc ☐ Heat Trace	Depth at Main:
	Continuity Test: n/a Pass/Fail	Pipe Size:
	PRV Required: Yes ☒ No ☐ Yes	Pipe Material:
		Length from Main to P/L:

CLEARLY INDICATE LOCATION OF CC AND ROUTE OF PIPES ON DRAWING BELOW

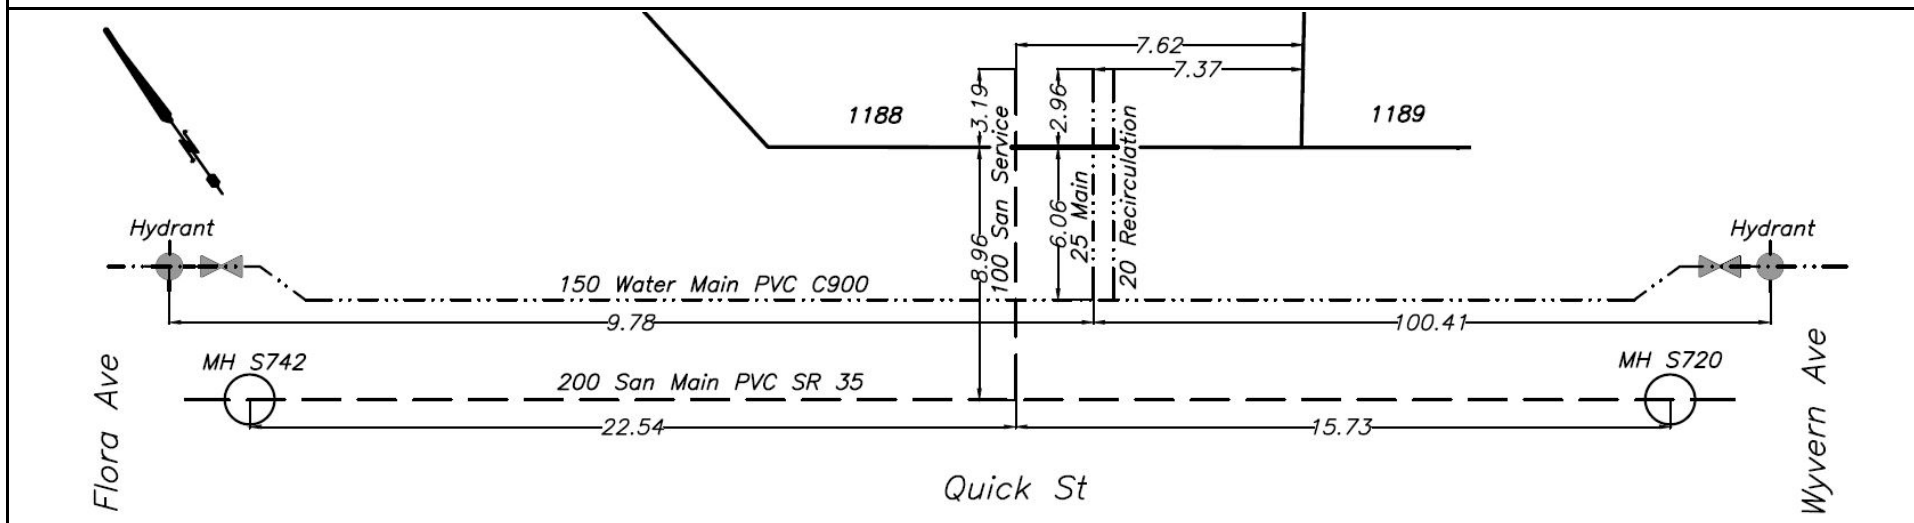




CITY OF WHITEHORSE

SERVICE CONNECTION RECORD

NAME Castle Rock Enterprises ADDRESS 21 Quick St BLOCK LOT 1189

DATES	WATER	SEWER
On at Main September 7, 2022	Depth at P/L: 672.82m (2.5 m)	Depth at P/L: 672.79m (2.5 m)
On at CC	Depth at Main: 672.11m (3.1 m)	Depth at Main: 672.39m (2.8 m)
Frost Plug	Pipe Size: 25 mm/20 mm	Pipe Size: 100 mm
Memo:	Pipe Material: HDPE Insul. ☒ Yes ☐ No	Pipe Material: PVC Insul. Yes ☒ No ☐ Yes
	Length from Main to P/L: 6.02m	Length from Main to P/L: 8.85m
		STORM
	Squirt Test: ☒ Pass ☐ fail	Depth at P/L:
	Frost Protection: ☒ Recirc ☐ Heat Trace	Depth at Main:
	Continuity Test: n/a Pass/Fail	Pipe Size:
	PRV Required: Yes ☒ No ☐ Yes	Pipe Material:
		Length from Main to P/L:

CLEARLY INDICATE LOCATION OF CC AND ROUTE OF PIPES ON DRAWING BELOW

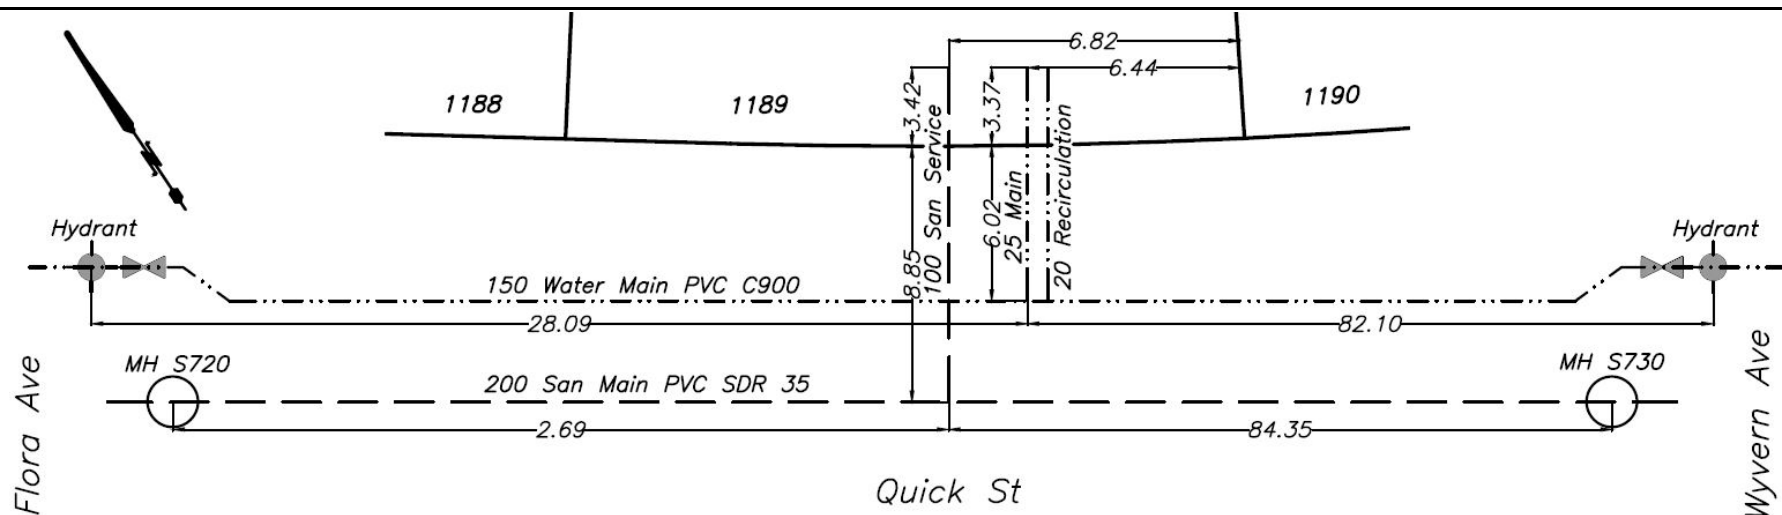




CITY OF WHITEHORSE

SERVICE CONNECTION RECORD

NAME Castle Rock Enterprises ADDRESS 19 Quick St BLOCK LOT 1190

DATES	WATER	SEWER
On at Main September 7, 2022	Depth at P/L: 672.79m (2.6 m)	Depth at P/L: 672.76m (2.7 m)
On at CC	Depth at Main: 672.26m (3.1 m)	Depth at Main: 672.29m (3.1 m)
Frost Plug	Pipe Size: 25 mm/20 mm	Pipe Size: 100 mm
Memo:	Pipe Material: HDPE Insul. ☒ Yes ☐ No	Pipe Material: PVC Insul. Yes ☒ No ☐ Yes
	Length from Main to P/L: 6.11m	Length from Main to P/L: 8.96m
		STORM
	Squirt Test: ☒ Pass ☐ fail	Depth at P/L:
	Frost Protection: ☒ Recirc ☐ Heat Trace	Depth at Main:
	Continuity Test: n/a Pass/Fail	Pipe Size:
	PRV Required: Yes ☒ No ☐ Yes	Pipe Material:
		Length from Main to P/L:

CLEARLY INDICATE LOCATION OF CC AND ROUTE OF PIPES ON DRAWING BELOW

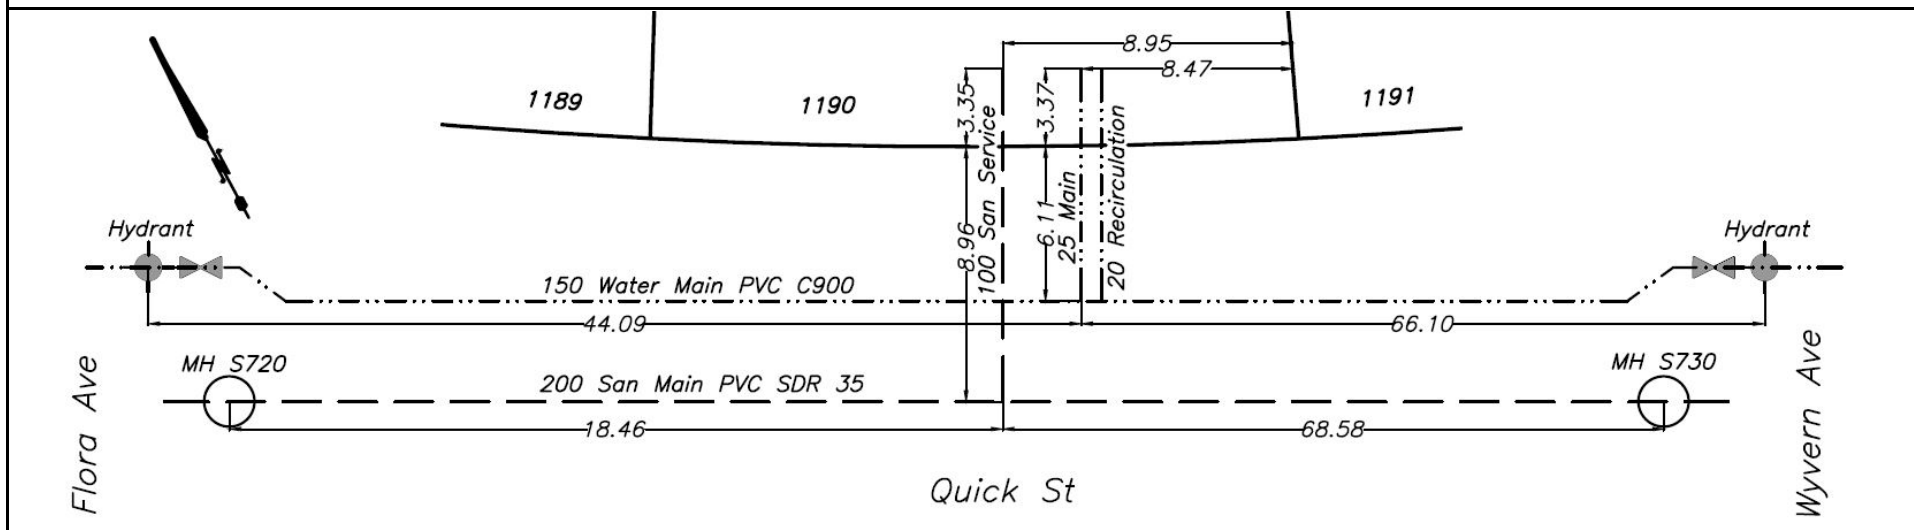



DATES		WATER		SEWER	
On at Main	September 7, 2022	Depth at P/L: 672.93m (2.7 m)		Depth at P/L: 672.90m (2.7 m)	
On at CC		Depth at Main: 672.44m (3.0 m)		Depth at Main: 672.18m (3.4 m)	
Frost Plug		Pipe Size: 25 mm/20 mm		Pipe Size: 100 mm	
Memo:		Pipe Material: HDPE	Insul. Yes /No	Pipe Material: PVC	Insul. Yes/ No
		Length from Main to P/L: 5.87m		Length from Main to P/L: 8.97m	
				STORM	
		Squirt Test: Pass /fail		Depth at P/L:	
		Frost Protection: Recirc /Heat Trace		Depth at Main:	
		Continuity Test: n/a	Pass/Fail	Pipe Size:	
		PRV Required:	Yes/ No	Pipe Material:	
				Length from Main to P/L:	

Sanitary Sewer Main Rehabilitation Project Plan View

Flora Ave

Hydrant

150 Water Main PVC C900

61.29

MH S720

200 San Main PVC SDR 35

36.06

Quick St

8.97

100 San Service

3.66

3.42

5.87

25 Main

20 Recirculation

9.14

8.77

1190

1191

1192

48.91

MH S730

50.98

Hydrant

Wyvern Ave




CITY OF WHITEHORSE

SERVICE CONNECTION RECORD

NAME Castle Rock Enterprises ADDRESS 15 Quick St BLOCK LOT 1192

DATES	WATER	SEWER
On at Main September 6, 2022	Depth at P/L: 673.08m (2.7 m)	Depth at P/L: 673.06m (2.7 m)
On at CC	Depth at Main: 672.89m (2.8 m)	Depth at Main: 672.07m (3.6 m)
Frost Plug	Pipe Size: 25 mm/20 mm	Pipe Size: 100 mm
Memo:	Pipe Material: HDPE Insul. ☒ Yes ☐ No	Pipe Material: PVC Insul. Yes ☐ No ☒
	Length from Main to P/L: 5.88m	Length from Main to P/L: 9.00m
		STORM
	Squirt Test: ☒ Pass ☐ fail	Depth at P/L:
	Frost Protection: ☒ Recirc ☐ Heat Trace	Depth at Main:
	Continuity Test: n/a Pass/Fail	Pipe Size:
	PRV Required: Yes ☐ No ☒	Pipe Material:
		Length from Main to P/L:

CLEARLY INDICATE LOCATION OF CC AND ROUTE OF PIPES ON DRAWING BELOW

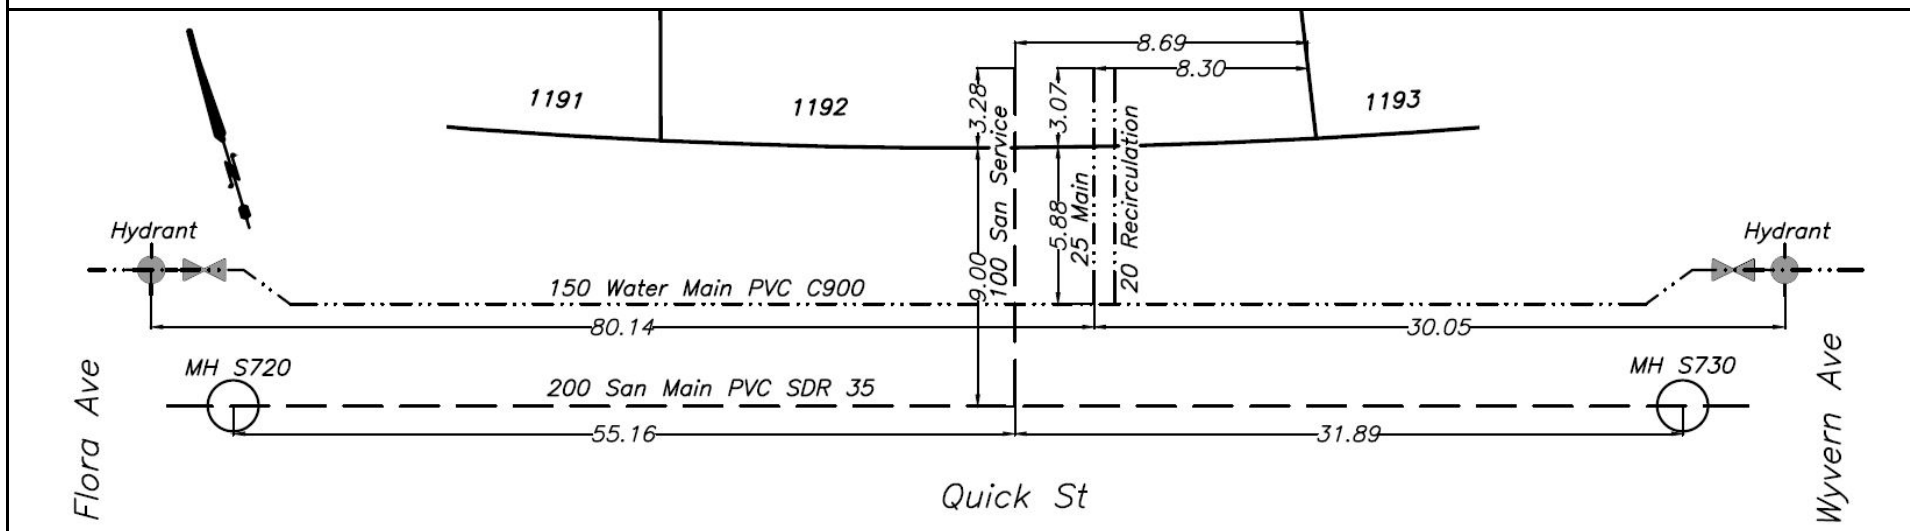




CITY OF WHITEHORSE

SERVICE CONNECTION RECORD

NAME Castle Rock Enterprises ADDRESS 13 Quick St BLOCK LOT 1193

DATES	WATER		SEWER
On at Main September 6, 2022	Depth at P/L: 673.25m (2.7 m)		Depth at P/L: 673.20m (2.7 m)
On at CC	Depth at Main: 672.90m (2.9 m)		Depth at Main: 671.96m (3.9 m)
Frost Plug	Pipe Size: 25 mm/20 mm		Pipe Size: 100 mm
Memo:	Pipe Material: HDPE	Insul. ☒ Yes ☐ No	Pipe Material: PVC
	Length from Main to P/L: 5.85m		Length from Main to P/L: 8.96m
			STORM
	Squirt Test: ☒ Pass ☐ fail		Depth at P/L:
	Frost Protection: ☒ Recirc ☐ Heat Trace		Depth at Main:
	Continuity Test: n/a		Pipe Size:
	PRV Required: Yes ☒ No ☐		Pipe Material:
			Length from Main to P/L:

CLEARLY INDICATE LOCATION OF CC AND ROUTE OF PIPES ON DRAWING BELOW

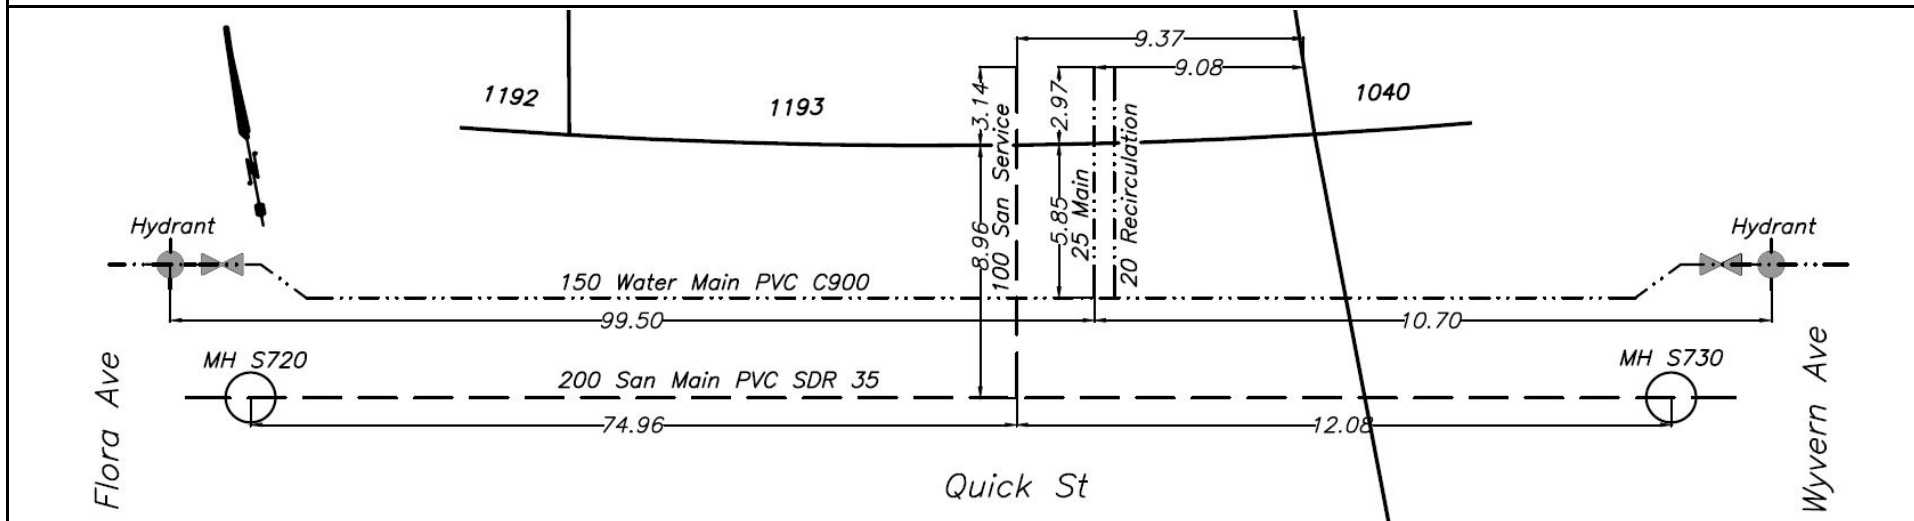




CITY OF WHITEHORSE

SERVICE CONNECTION RECORD

NAME Castle Rock Enterprises ADDRESS 25 Flora Ave BLOCK LOT 1194

DATES	WATER	SEWER
On at Main August 16, 2022	Depth at P/L: 672.19m (2.7 m)	Depth at P/L: 672.15m (2.7 m)
On at CC	Depth at Main: 671.57m (3.3 m)	Depth at Main: 670.36m (4.5 m)
Frost Plug	Pipe Size: 25 mm/20 mm	Pipe Size: 100 mm
Memo:	Pipe Material: HDPE Insul. <u>(Yes)</u> No	Pipe Material: PVC Insul. Yes <u>(No)</u>
	Length from Main to P/L: 11.82m	Length from Main to P/L: 9.15m
		STORM
	Squirt Test: <u>(Pass)</u> fail	Depth at P/L:
	Frost Protection: <u>(Recirc)</u> Heat Trace	Depth at Main:
	Continuity Test: n/a Pass/Fail	Pipe Size:
	PRV Required: Yes/ <u>(No)</u>	Pipe Material:
		Length from Main to P/L:

CLEARLY INDICATE LOCATION OF CC AND ROUTE OF PIPES ON DRAWING BELOW

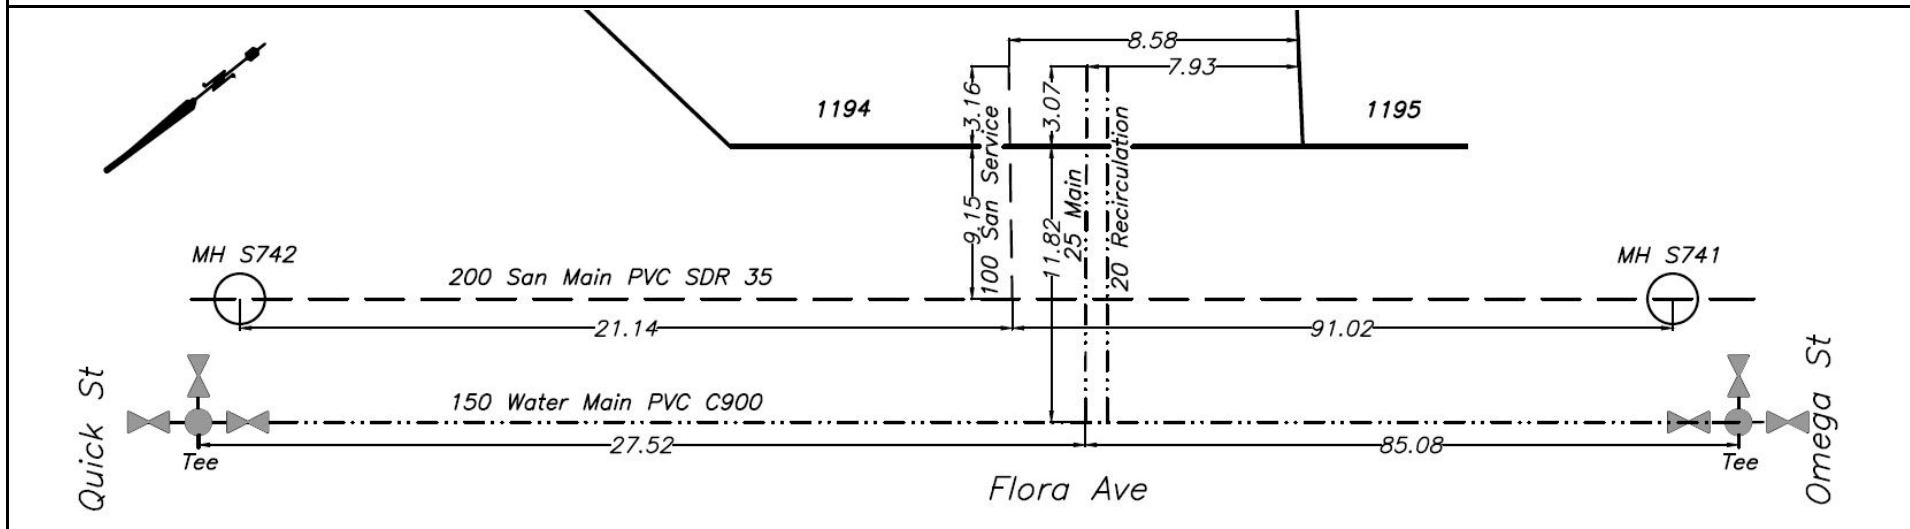




CITY OF WHITEHORSE

SERVICE CONNECTION RECORD

NAME Castle Rock Enterprises ADDRESS 21 Flora Ave BLOCK LOT 1195

DATES	WATER	SEWER
On at Main August 16, 2022	Depth at P/L: 672.14m (2.8 m)	Depth at P/L: 672.05m (2.9 m)
On at CC	Depth at Main: 671.52m (3.2 m)	Depth at Main: 670.43m (4.4 m)
Frost Plug	Pipe Size: 25 mm/20 mm	Pipe Size: 100 mm
Memo:	Pipe Material: HDPE Insul. ☒ Yes ☐ No	Pipe Material: PVC Insul. Yes ☐ No ☒
	Length from Main to P/L: 11.75m	Length from Main to P/L: 9.08m
		STORM
	Squirt Test: ☒ Pass ☐ fail	Depth at P/L:
	Frost Protection: ☒ Recirc ☐ Heat Trace	Depth at Main:
	Continuity Test: n/a Pass/Fail	Pipe Size:
	PRV Required: Yes ☐ No ☒	Pipe Material:
		Length from Main to P/L:

CLEARLY INDICATE LOCATION OF CC AND ROUTE OF PIPES ON DRAWING BELOW

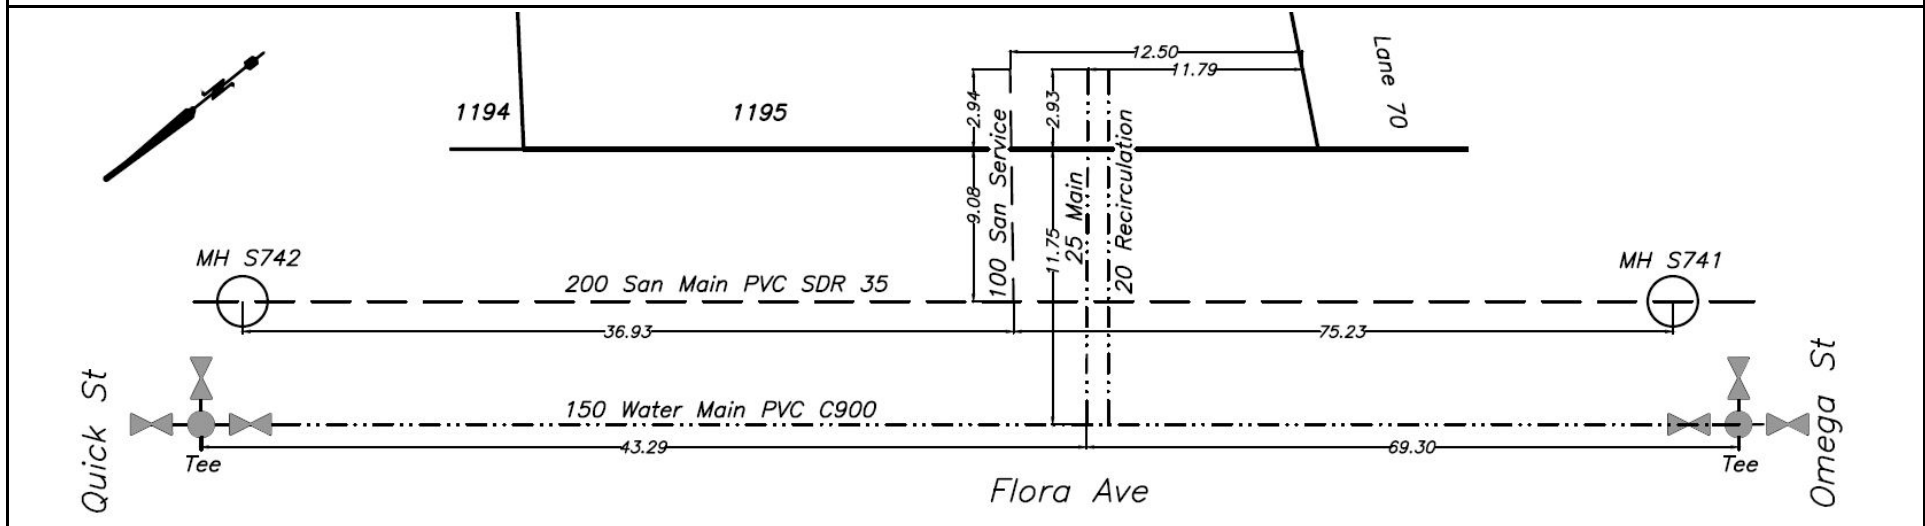




CITY OF WHITEHORSE

SERVICE CONNECTION RECORD

NAME Castle Rock Enterprises ADDRESS 22 Quick St BLOCK LOT 1196

DATES	WATER	SEWER
On at Main August 17, 2022	Depth at P/L: 672.89m (2.5 m)	Depth at P/L: 672.76m (2.6 m)
On at CC	Depth at Main: 672.15m (3.1 m)	Depth at Main: 672.34m (3.6 m)
Frost Plug	Pipe Size: 25 mm/20 mm	Pipe Size: 100 mm
Memo:	Pipe Material: HDPE Insul. ☒ Yes ☐ No	Pipe Material: PVC Insul. Yes ☒ No ☐ Yes
	Length from Main to P/L: 11.92m	Length from Main to P/L: 9.17m
		STORM
	Squirt Test: ☒ Pass ☐ fail	Depth at P/L:
	Frost Protection: ☒ Recirc ☐ Heat Trace	Depth at Main:
	Continuity Test: n/a Pass/Fail	Pipe Size:
	PRV Required: Yes ☒ No ☐ Yes	Pipe Material:
		Length from Main to P/L:

CLEARLY INDICATE LOCATION OF CC AND ROUTE OF PIPES ON DRAWING BELOW

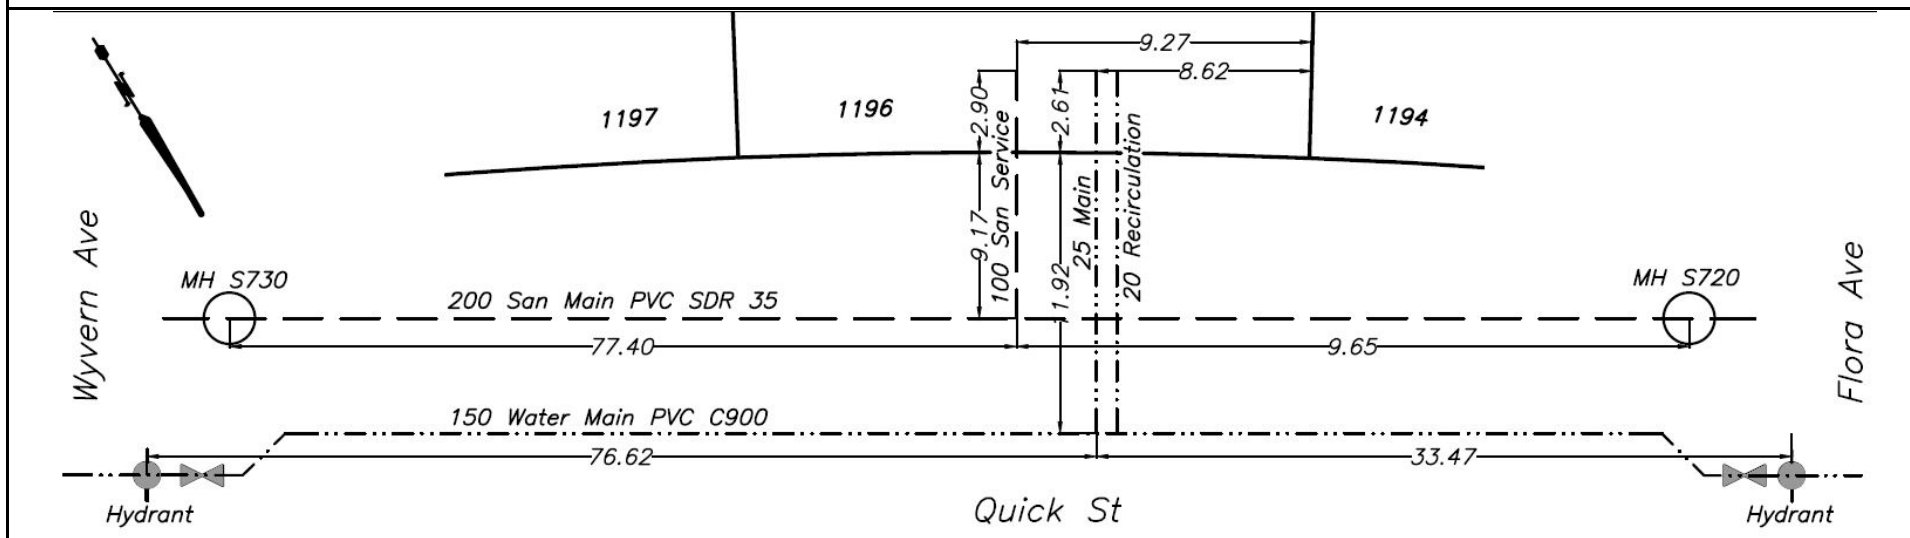




CITY OF WHITEHORSE

SERVICE CONNECTION RECORD

NAME Castle Rock Enterprises ADDRESS 20 Quick St BLOCK LOT 1197

DATES	WATER	SEWER
On at Main August 17, 2022	Depth at P/L: 672.72m (2.8 m)	Depth at P/L: 672.64m (2.9 m)
On at CC	Depth at Main: 672.32m (3.0 m)	Depth at Main: 672.25m (3.2 m)
Frost Plug	Pipe Size: 25 mm/20 mm	Pipe Size: 100 mm
Memo:	Pipe Material: HDPE Insul. ☒ Yes ☐ No	Pipe Material: PVC Insul. Yes ☒ No ☐ Yes
	Length from Main to P/L: 11.80m	Length from Main to P/L: 8.98m
		STORM
	Squirt Test: ☒ Pass ☐ fail	Depth at P/L:
	Frost Protection: ☒ Recirc ☐ Heat Trace	Depth at Main:
	Continuity Test: n/a Pass/Fail	Pipe Size:
	PRV Required: Yes ☒ No ☐ Yes	Pipe Material:
		Length from Main to P/L:

CLEARLY INDICATE LOCATION OF CC AND ROUTE OF PIPES ON DRAWING BELOW

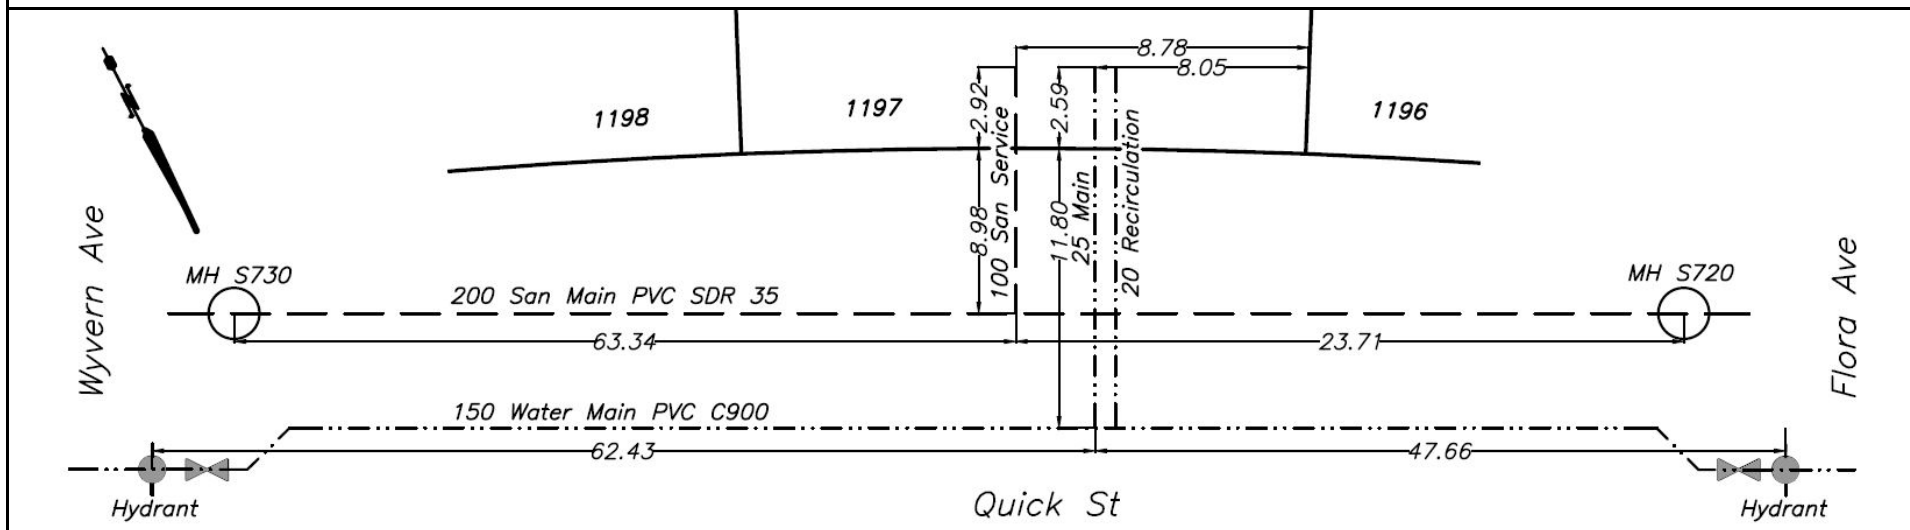




CITY OF WHITEHORSE

SERVICE CONNECTION RECORD

NAME Castle Rock Enterprises ADDRESS 18 Quick St BLOCK LOT 1198

DATES	WATER	SEWER
On at Main August 17, 2022	Depth at P/L: 672.77m (2.8 m)	Depth at P/L: 672.69m (2.9 m)
On at CC	Depth at Main: 672.48m (3.0 m)	Depth at Main: 672.15m (3.4 m)
Frost Plug	Pipe Size: 25 mm/20 mm	Pipe Size: 100 mm
Memo:	Pipe Material: HDPE Insul. ☒ Yes ☐ No	Pipe Material: PVC Insul. Yes ☐ No ☒
	Length from Main to P/L: 12.00m	Length from Main to P/L: 9.02m
		STORM
	Squirt Test: ☒ Pass ☐ fail	Depth at P/L:
	Frost Protection: ☒ Recirc ☐ Heat Trace	Depth at Main:
	Continuity Test: n/a Pass/Fail	Pipe Size:
	PRV Required: Yes ☐ No ☒	Pipe Material:
		Length from Main to P/L:

CLEARLY INDICATE LOCATION OF CC AND ROUTE OF PIPES ON DRAWING BELOW

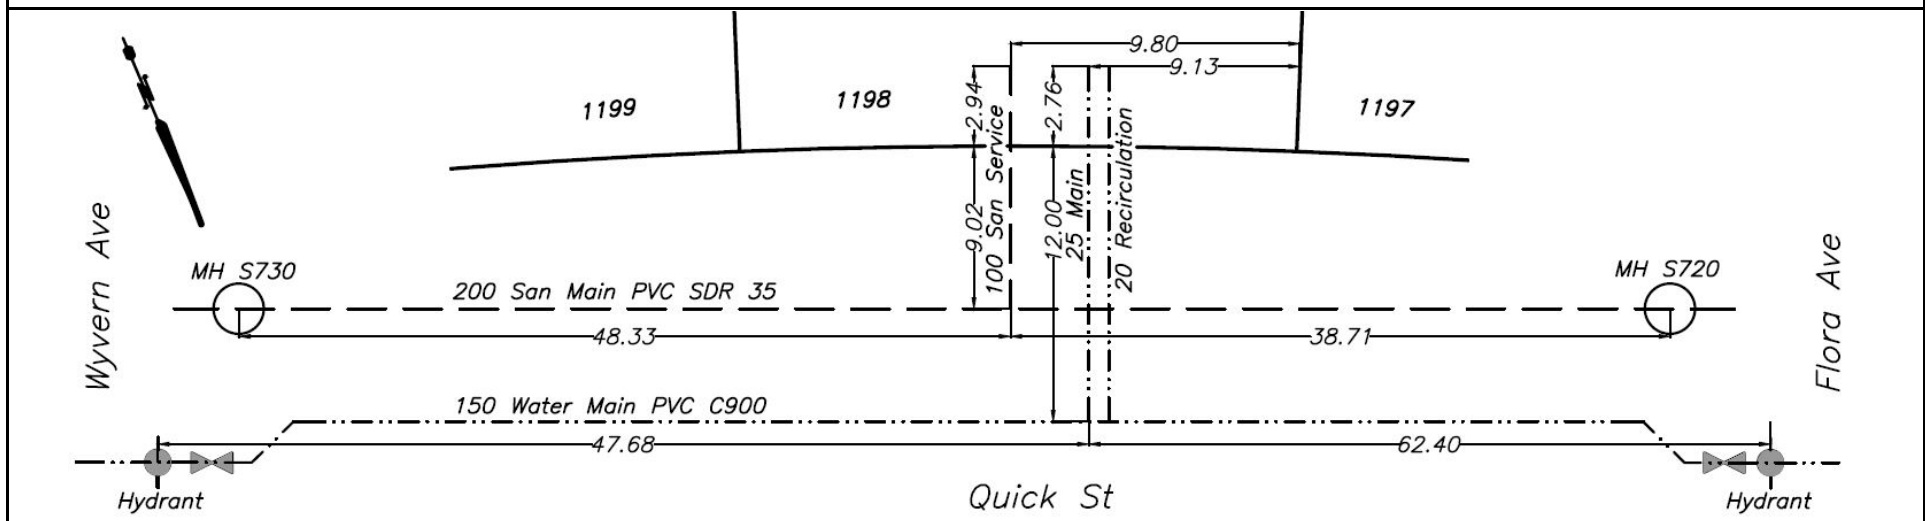




CITY OF WHITEHORSE

SERVICE CONNECTION RECORD

NAME Castle Rock Enterprises ADDRESS 16 Quick St BLOCK LOT 1199

DATES	WATER	SEWER
On at Main August 17, 2022	Depth at P/L: 672.82m (2.9 m)	Depth at P/L: 672.74m (3.0 m)
On at CC	Depth at Main: 672.63m (3.0 m)	Depth at Main: 672.09m (3.6 m)
Frost Plug	Pipe Size: 25 mm/20 mm	Pipe Size: 100 mm
Memo:	Pipe Material: HDPE Insul. <u>Yes</u> /No	Pipe Material: PVC Insul. Yes/ <u>No</u>
	Length from Main to P/L: 11.99m	Length from Main to P/L: 9.04m
		STORM
	Squirt Test: <u>Pass</u> /fail	Depth at P/L:
	Frost Protection: <u>Recirc</u> Heat Trace	Depth at Main:
	Continuity Test: n/a Pass/Fail	Pipe Size:
	PRV Required: Yes/ <u>No</u>	Pipe Material:
		Length from Main to P/L:

CLEARLY INDICATE LOCATION OF CC AND ROUTE OF PIPES ON DRAWING BELOW

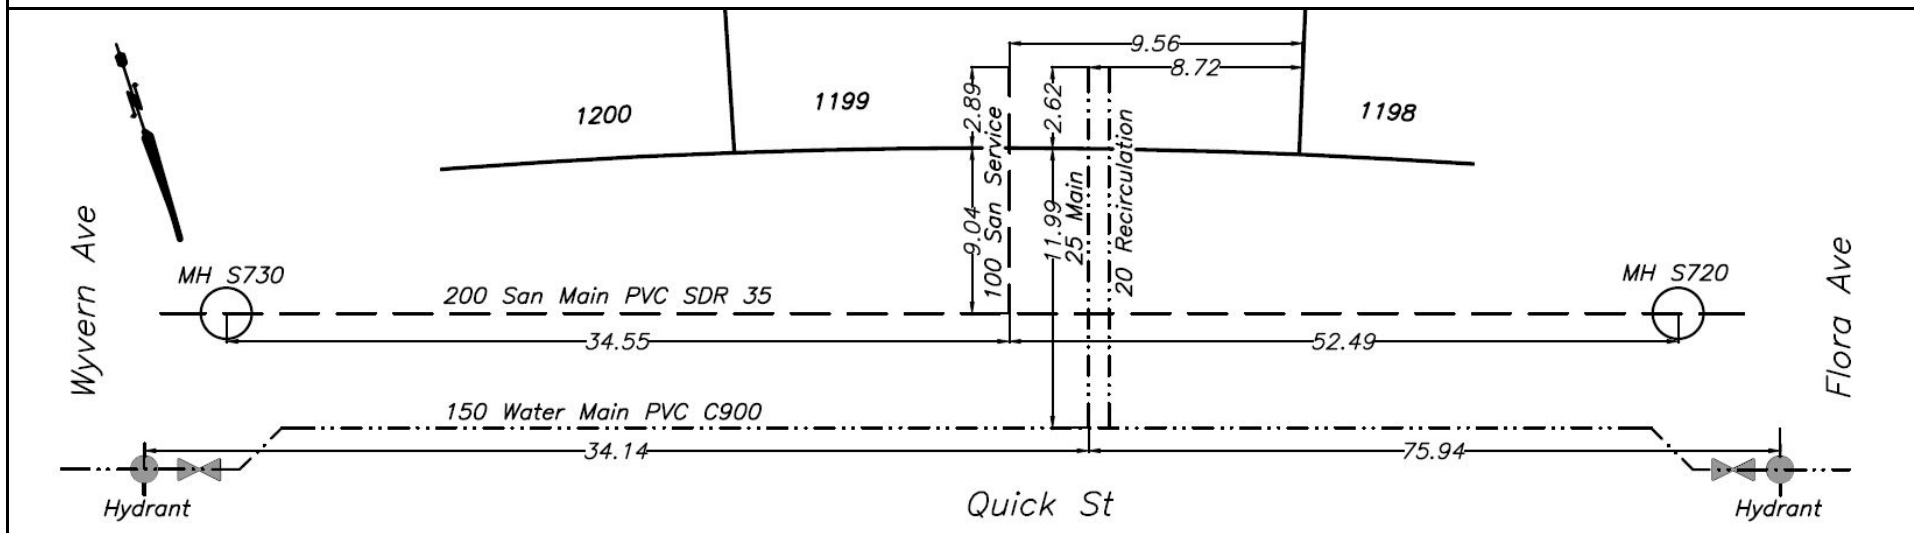




CITY OF WHITEHORSE

SERVICE CONNECTION RECORD

NAME Castle Rock Enterprises ADDRESS 14 Quick St BLOCK LOT 1200

DATES	WATER	SEWER
On at Main August 17, 2022	Depth at P/L: 672.79m (3.1 m)	Depth at P/L: 672.63m (3.2 m)
On at CC	Depth at Main: 672.79m (2.9 m)	Depth at Main: 672.03m (3.8 m)
Frost Plug	Pipe Size: 25 mm/20 mm	Pipe Size: 100 mm
Memo:	Pipe Material: HDPE Insul. ☒ Yes ☐ No	Pipe Material: PVC Insul. Yes ☐ Yes ☒ No
	Length from Main to P/L: 12.01m	Length from Main to P/L: 9.20m
		STORM
	Squirt Test: ☒ Pass ☐ fail	Depth at P/L:
	Frost Protection: ☒ Recirc ☐ Heat Trace	Depth at Main:
	Continuity Test: n/a Pass/Fail	Pipe Size:
	PRV Required: Yes ☒ No ☐ No	Pipe Material:
		Length from Main to P/L:

CLEARLY INDICATE LOCATION OF CC AND ROUTE OF PIPES ON DRAWING BELOW

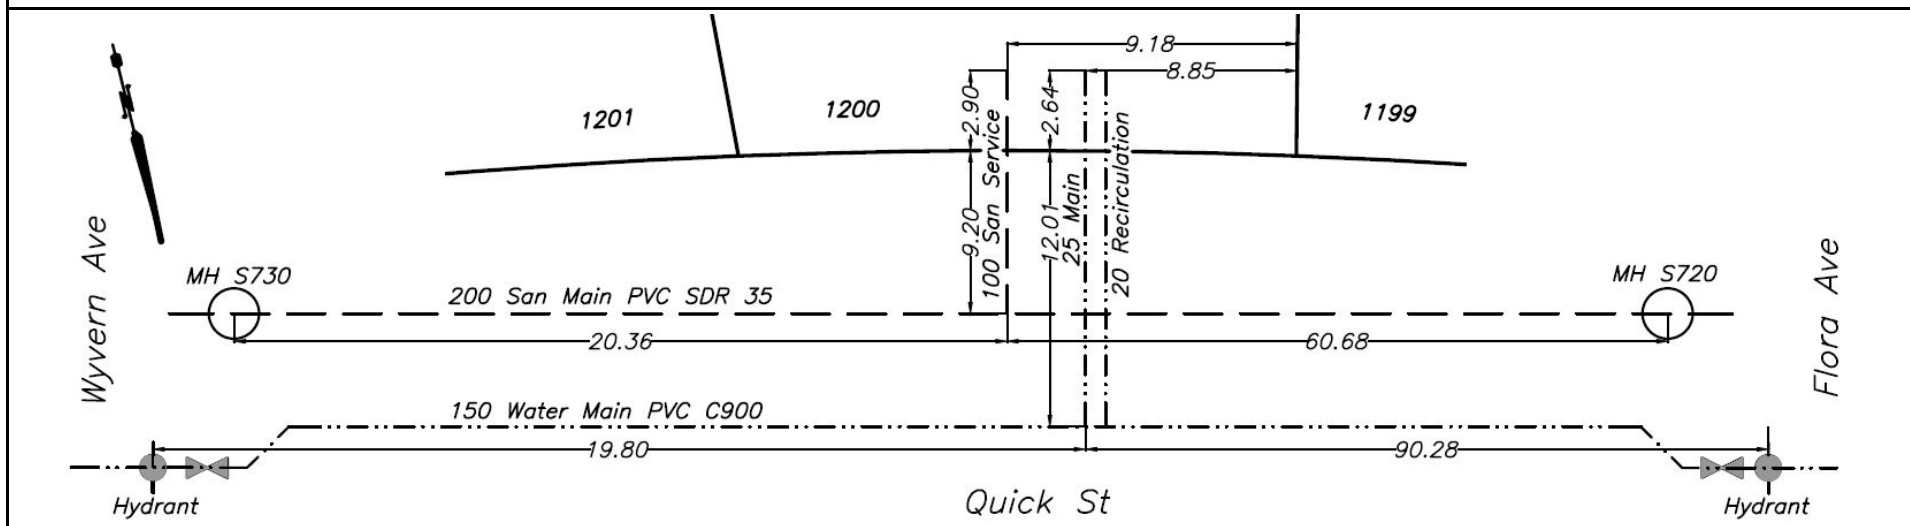




CITY OF WHITEHORSE

SERVICE CONNECTION RECORD

NAME Castle Rock Enterprises ADDRESS 12 Quick St BLOCK LOT 1201

DATES	WATER	SEWER
On at Main August 18, 2022	Depth at P/L: 673.29m (2.7 m)	Depth at P/L: 673.24m (2.8 m)
On at CC	Depth at Main: 672.92m (2.9 m)	Depth at Main: 671.92m (4.0 m)
Frost Plug	Pipe Size: 25 mm/20 mm	Pipe Size: 100 mm
Memo:	Pipe Material: HDPE Insul. ☒ Yes ☐ No	Pipe Material: PVC Insul. Yes ☒ No ☐ Yes
	Length from Main to P/L: 12.04m	Length from Main to P/L: 9.24m
		STORM
	Squirt Test: ☒ Pass ☐ fail	Depth at P/L:
	Frost Protection: ☒ Recirc ☐ Heat Trace	Depth at Main:
	Continuity Test: n/a Pass/Fail	Pipe Size:
	PRV Required: Yes ☒ No ☐ Yes	Pipe Material:
		Length from Main to P/L:

CLEARLY INDICATE LOCATION OF CC AND ROUTE OF PIPES ON DRAWING BELOW

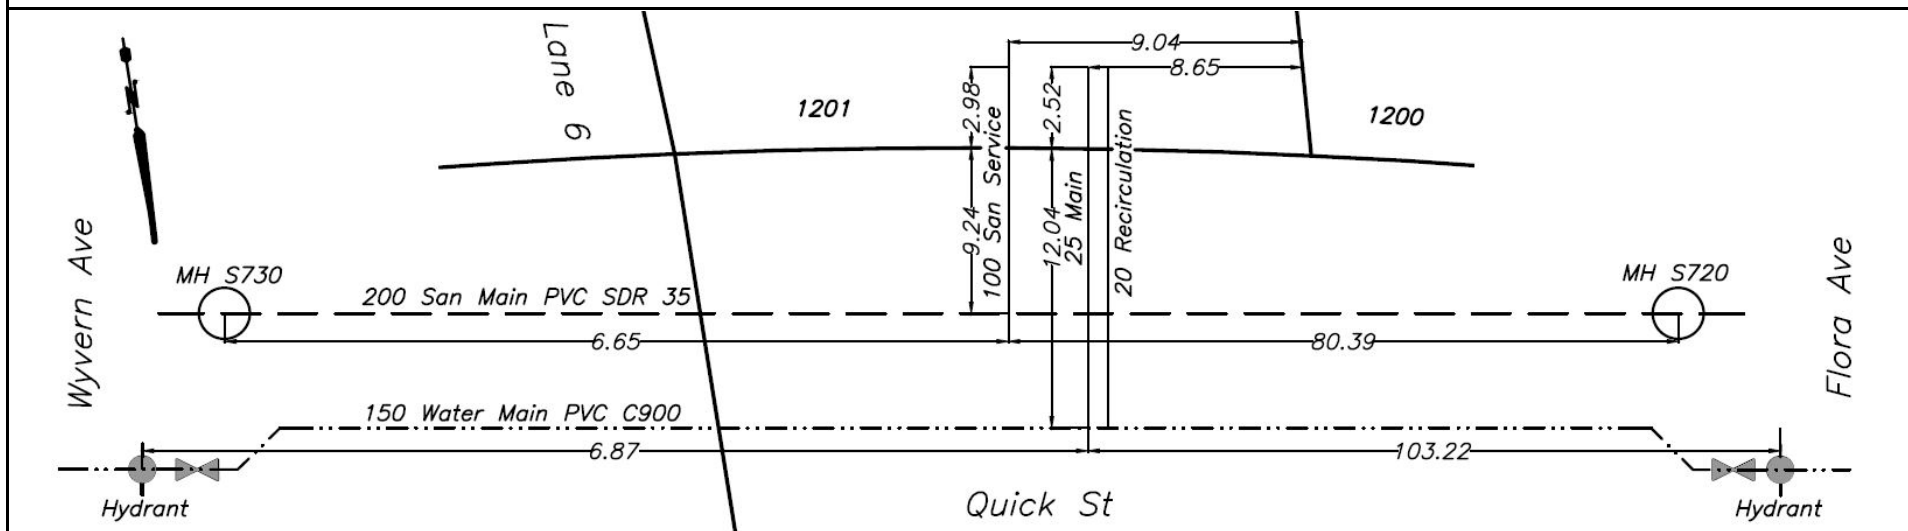




CITY OF WHITEHORSE

SERVICE CONNECTION RECORD

NAME Castle Rock Enterprises ADDRESS 53 Omega St BLOCK LOT 1202

DATES	WATER	SEWER
On at Main July 21, 2022	Depth at P/L: 671.89m (2.6 m)	Depth at P/L: 671.79m (2.7 m)
On at CC	Depth at Main: 671.30m (3.1 m)	Depth at Main: 671.12m (3.3 m)
Frost Plug	Pipe Size: 25 mm/20 mm	Pipe Size: 100 mm
Memo:	Pipe Material: HDPE Insul. ☒ Yes ☐ No	Pipe Material: PVC Insul. Yes ☒ No ☐ Yes
	Length from Main to P/L: 5.95m	Length from Main to P/L: 9.01m
		STORM
	Squirt Test: ☒ Pass ☐ fail	Depth at P/L:
	Frost Protection: ☒ Recirc ☐ Heat Trace	Depth at Main:
	Continuity Test: n/a Pass/Fail	Pipe Size:
	PRV Required: Yes ☒ No ☐ Yes	Pipe Material:
		Length from Main to P/L:

CLEARLY INDICATE LOCATION OF CC AND ROUTE OF PIPES ON DRAWING BELOW

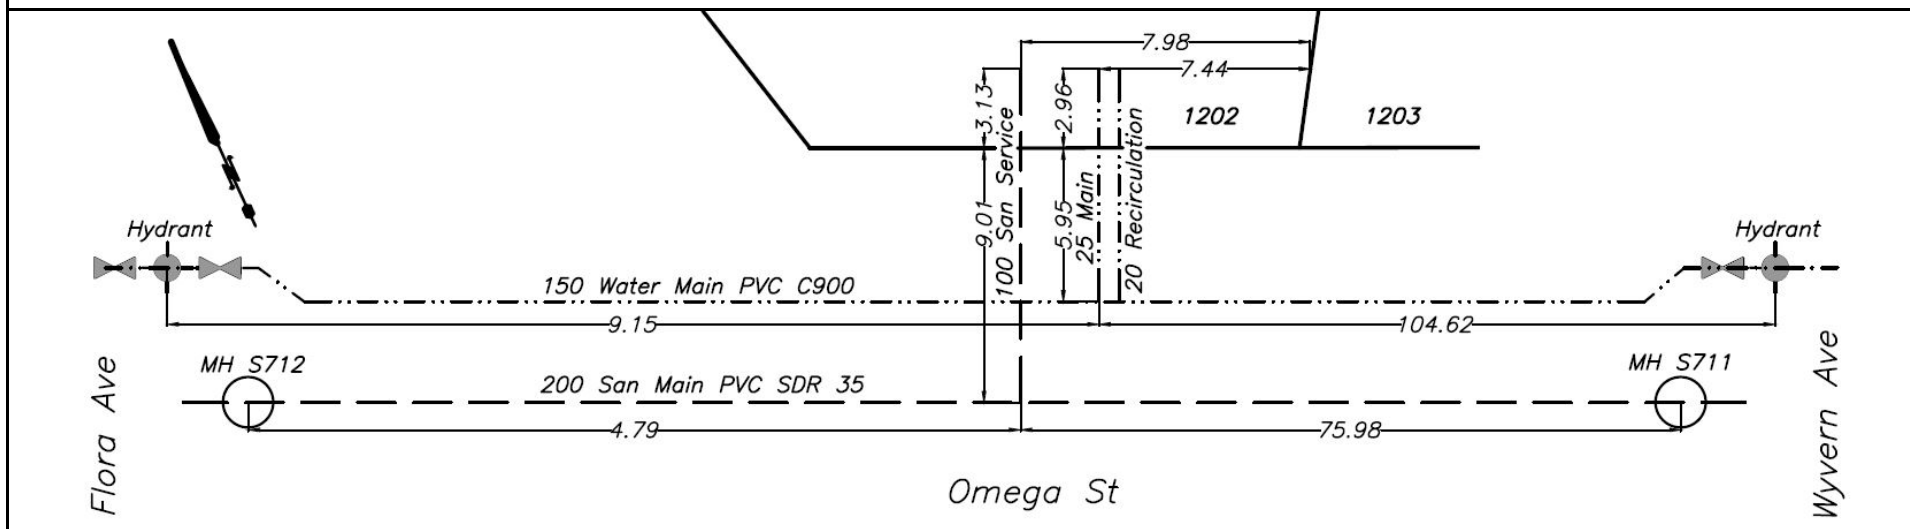




CITY OF WHITEHORSE

SERVICE CONNECTION RECORD

NAME Castle Rock Enterprises ADDRESS 51 Omega St BLOCK LOT 1203

DATES	WATER	SEWER
On at Main July 21, 2022	Depth at P/L: 671.78m (2.8 m)	Depth at P/L: 671.76m (2.8 m)
On at CC	Depth at Main: 671.39m (3.1 m)	Depth at Main: 671.03m (3.5 m)
Frost Plug	Pipe Size: 25 mm/20 mm	Pipe Size: 100 mm
Memo:	Pipe Material: HDPE Insul. ☒ Yes ☐ No	Pipe Material: PVC Insul. Yes ☒ No ☐ Yes
	Length from Main to P/L: 5.94m	Length from Main to P/L: 8.95m
		STORM
	Squirt Test: ☒ Pass ☐ fail	Depth at P/L:
	Frost Protection: ☒ Recirc ☐ Heat Trace	Depth at Main:
	Continuity Test: n/a Pass/Fail	Pipe Size:
	PRV Required: Yes ☒ No ☐ Yes	Pipe Material:
		Length from Main to P/L:

CLEARLY INDICATE LOCATION OF CC AND ROUTE OF PIPES ON DRAWING BELOW

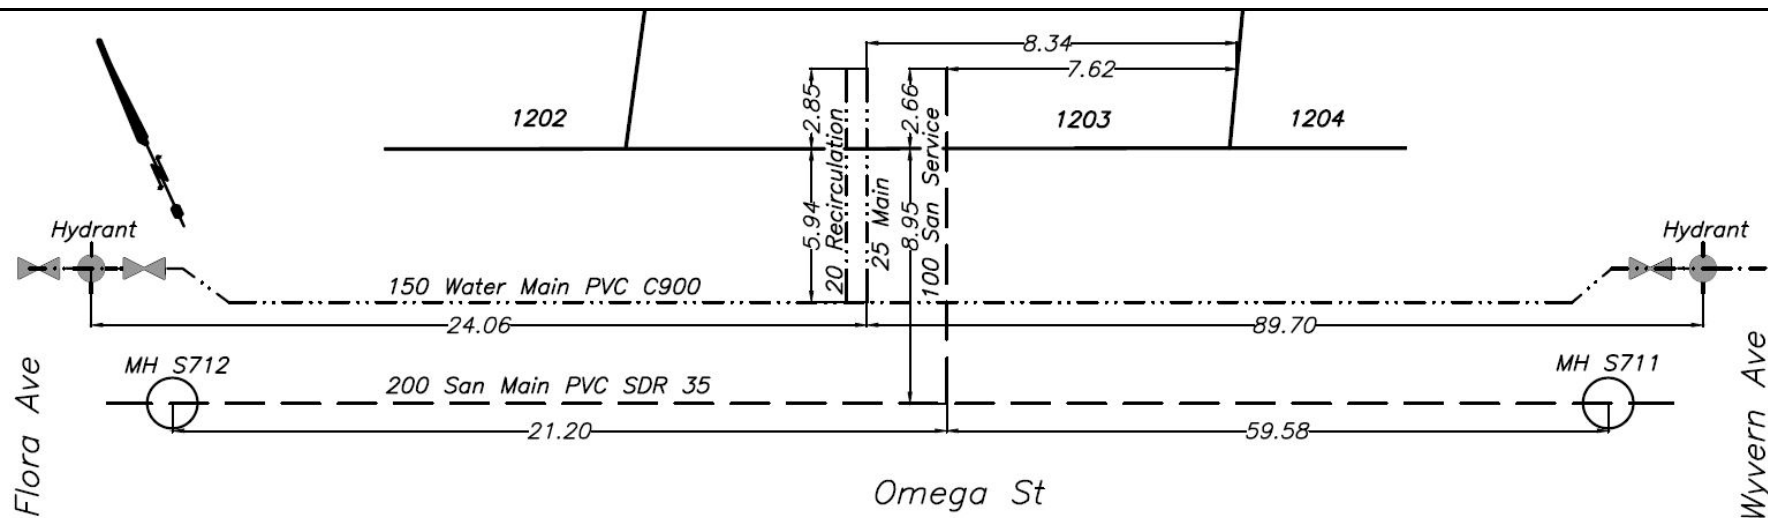




CITY OF WHITEHORSE

SERVICE CONNECTION RECORD

NAME Castle Rock Enterprises ADDRESS 49 Omega St BLOCK LOT 1204

DATES	WATER	SEWER
On at Main July 21, 2022	Depth at P/L: 671.94m (2.7 m)	Depth at P/L: 671.89m (2.8 m)
On at CC	Depth at Main: 671.49m (3.0 m)	Depth at Main: 670.92m (3.7 m)
Frost Plug	Pipe Size: 25 mm/20 mm	Pipe Size: 100 mm
Memo:	Pipe Material: HDPE Insul. ☒ Yes ☐ No	Pipe Material: PVC Insul. Yes ☒ No ☐ Yes
	Length from Main to P/L: 5.96m	Length from Main to P/L: 9.04m
		STORM
	Squirt Test: ☒ Pass ☐ fail	Depth at P/L:
	Frost Protection: ☒ Recirc ☐ Heat Trace	Depth at Main:
	Continuity Test: n/a Pass/Fail	Pipe Size:
	PRV Required: Yes ☒ No ☐ Yes	Pipe Material:
		Length from Main to P/L:

CLEARLY INDICATE LOCATION OF CC AND ROUTE OF PIPES ON DRAWING BELOW

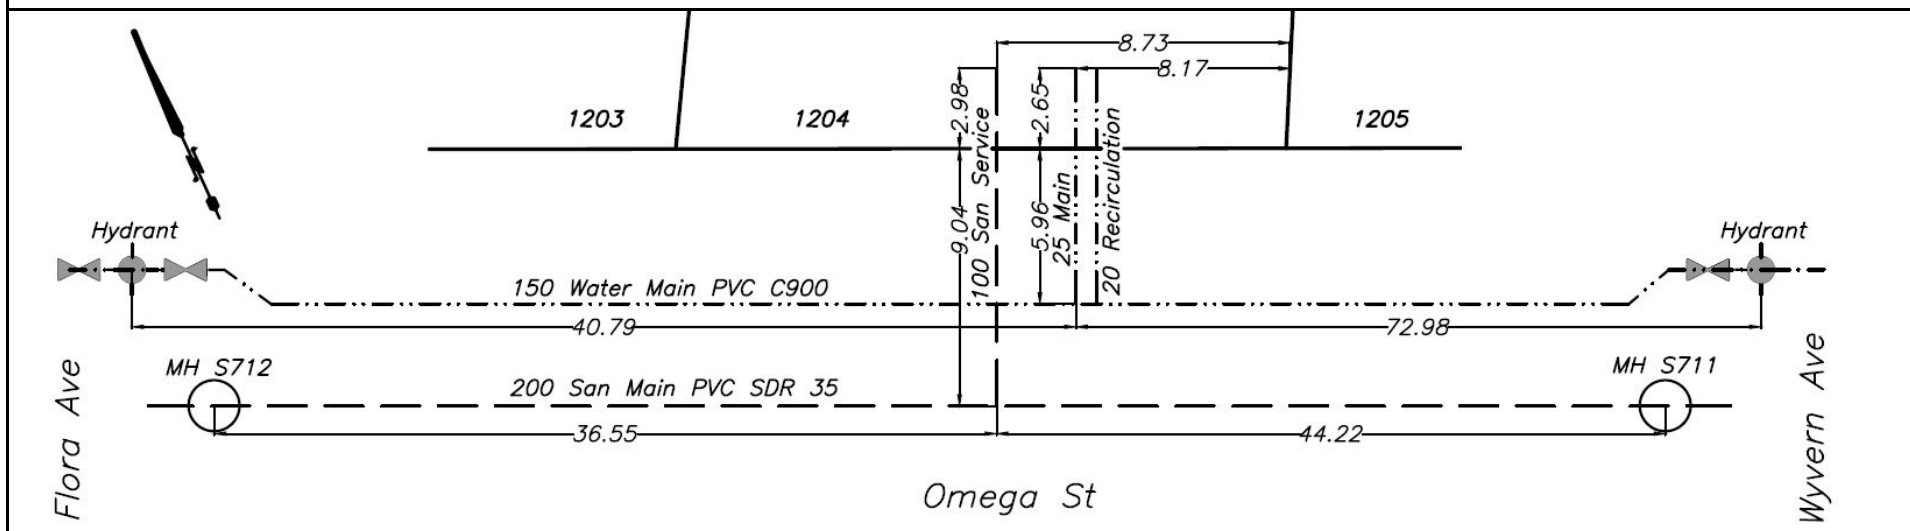




CITY OF WHITEHORSE

SERVICE CONNECTION RECORD

NAME Castle Rock Enterprises ADDRESS 47 Omega St BLOCK LOT 1205

DATES	WATER	SEWER
On at Main July 21, 2022	Depth at P/L: 672.05m (2.7 m)	Depth at P/L: 672.00m (2.7 m)
On at CC	Depth at Main: 671.52m (3.1 m)	Depth at Main: 670.81m (3.9 m)
Frost Plug	Pipe Size: 25 mm/20 mm	Pipe Size: 100 mm
Memo:	Pipe Material: HDPE Insul. ☒ Yes ☐ No	Pipe Material: PVC Insul. Yes ☒ No ☐ Yes
	Length from Main to P/L: 5.96m	Length from Main to P/L: 9.08m
		STORM
	Squirt Test: ☒ Pass ☐ fail	Depth at P/L:
	Frost Protection: ☒ Recirc ☐ Heat Trace	Depth at Main:
	Continuity Test: n/a Pass/Fail	Pipe Size:
	PRV Required: Yes ☒ No ☐ Yes	Pipe Material:
		Length from Main to P/L:

CLEARLY INDICATE LOCATION OF CC AND ROUTE OF PIPES ON DRAWING BELOW

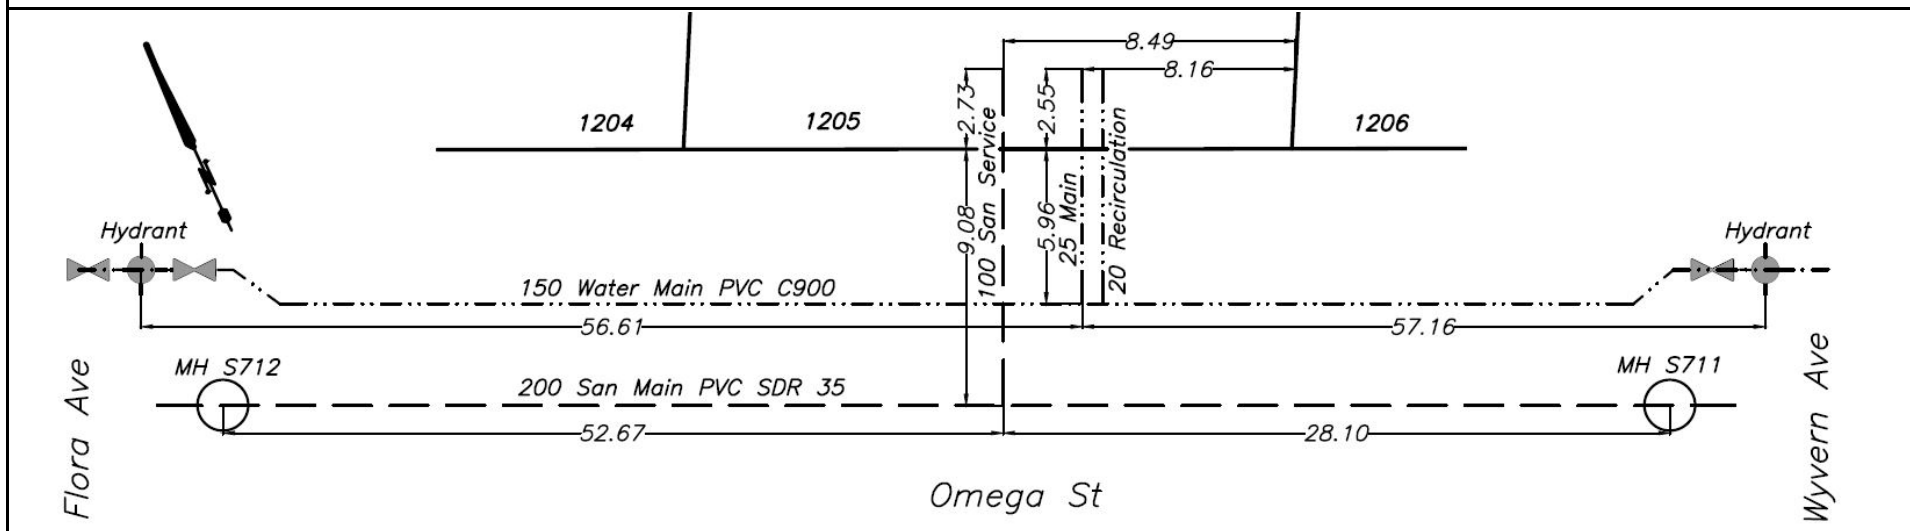




CITY OF WHITEHORSE

SERVICE CONNECTION RECORD

NAME Castle Rock Enterprises ADDRESS 45 Omega St BLOCK LOT 1206

DATES	WATER	SEWER
On at Main July 21, 2022	Depth at P/L: 671.88m (2.9 m)	Depth at P/L: 671.86m (2.9 m)
On at CC	Depth at Main: 671.61m (3.1 m)	Depth at Main: 670.71m (4.0 m)
Frost Plug	Pipe Size: 25 mm/20 mm	Pipe Size: 100 mm
Memo:	Pipe Material: HDPE Insul. ☒ Yes ☐ No	Pipe Material: PVC Insul. Yes ☒ No ☐ Yes
	Length from Main to P/L: 5.92m	Length from Main to P/L: 9.05m
		STORM
	Squirt Test: ☒ Pass ☐ fail	Depth at P/L:
	Frost Protection: ☒ Recirc ☐ Heat Trace	Depth at Main:
	Continuity Test: n/a Pass/Fail	Pipe Size:
	PRV Required: Yes ☒ No ☐ Yes	Pipe Material:
		Length from Main to P/L:

CLEARLY INDICATE LOCATION OF CC AND ROUTE OF PIPES ON DRAWING BELOW

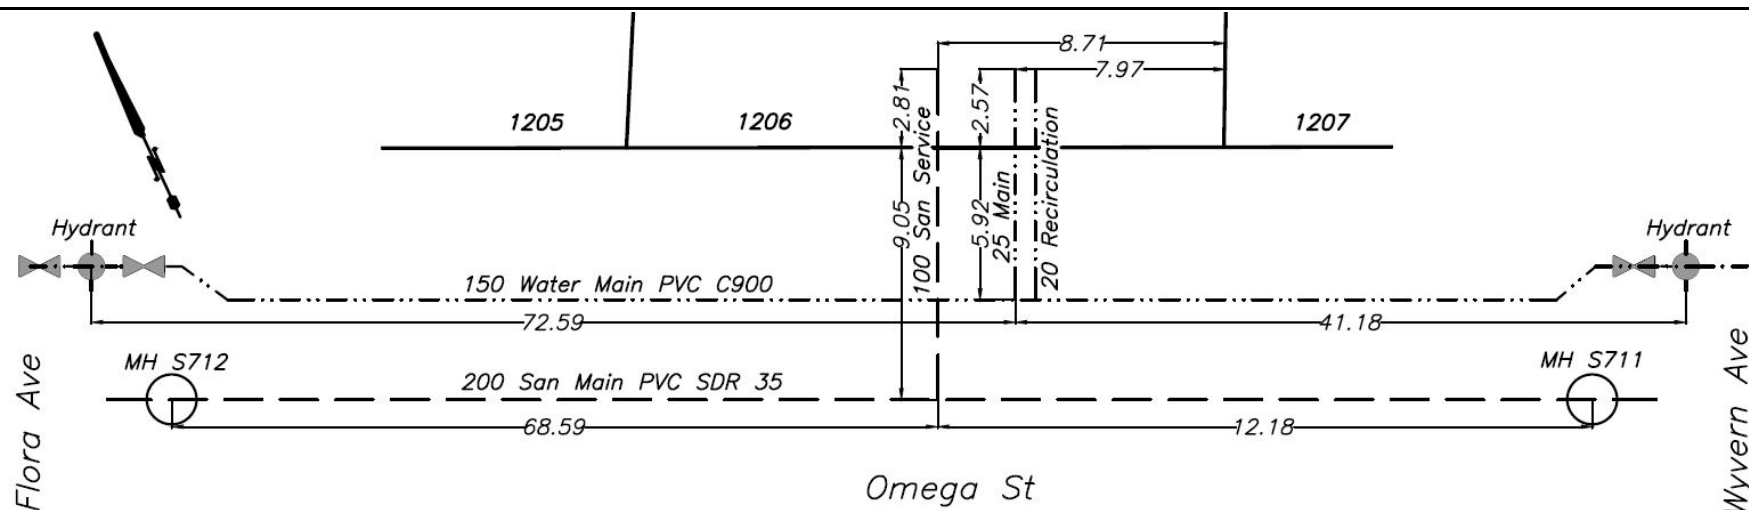




CITY OF WHITEHORSE

SERVICE CONNECTION RECORD

NAME Castle Rock Enterprises ADDRESS 43 Omega St BLOCK LOT 1207

DATES	WATER	SEWER
On at Main July 20, 2022	Depth at P/L: 672.06m (2.8 m)	Depth at P/L: 672.02m (2.9 m)
On at CC	Depth at Main: 671.65m (3.1 m)	Depth at Main: 670.43m (4.4 m)
Frost Plug	Pipe Size: 25 mm/20 mm	Pipe Size: 100 mm
Memo:	Pipe Material: HDPE Insul. <u>Yes</u> /No	Pipe Material: PVC Insul. Yes/ <u>No</u>
	Length from Main to P/L: 5.83m	Length from Main to P/L: 9.12m
		STORM
	Squirt Test: <u>Pass</u> /fail	Depth at P/L:
	Frost Protection: <u>Recirc</u> Heat Trace	Depth at Main:
	Continuity Test: n/a Pass/Fail	Pipe Size:
	PRV Required: Yes/ <u>No</u>	Pipe Material:
		Length from Main to P/L:

CLEARLY INDICATE LOCATION OF CC AND ROUTE OF PIPES ON DRAWING BELOW

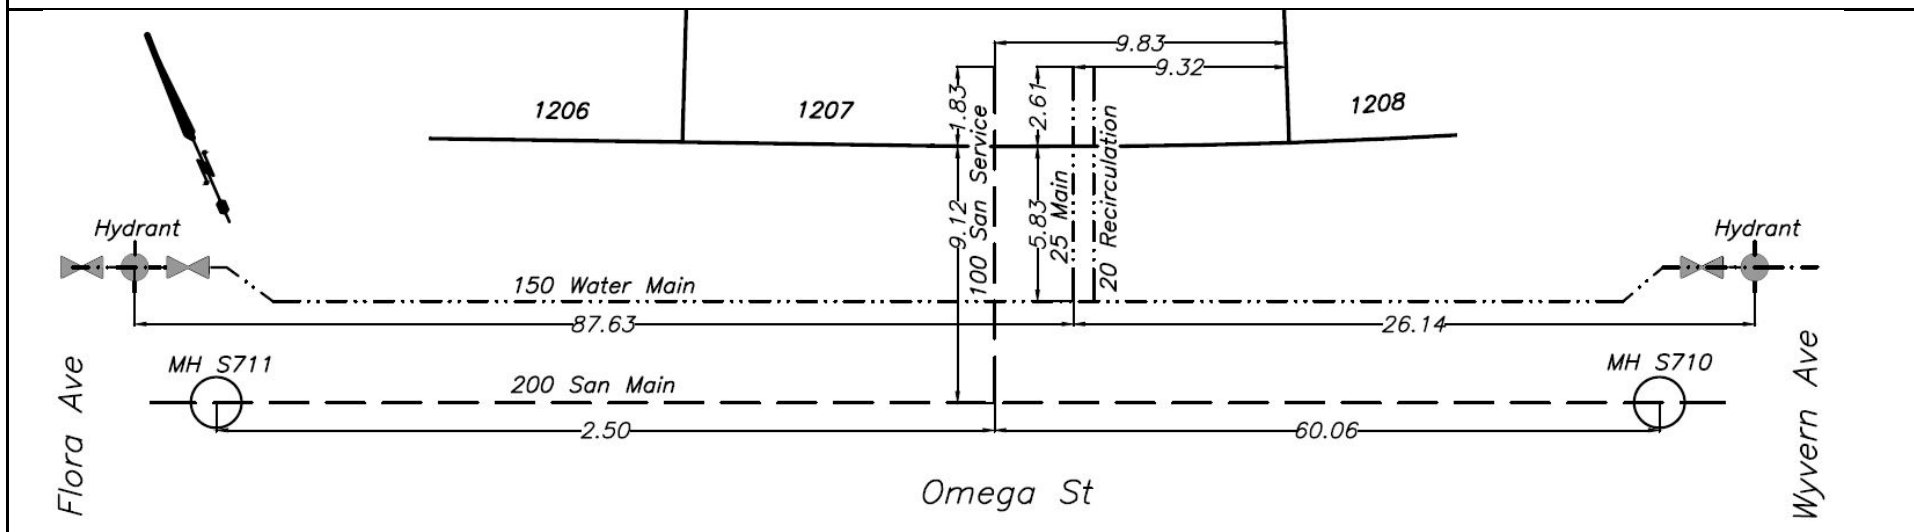




CITY OF WHITEHORSE

SERVICE CONNECTION RECORD

NAME Castle Rock Enterprises ADDRESS 41 Omega St BLOCK LOT 1208

DATES	WATER		SEWER
On at Main July 20, 2022	Depth at P/L: 672.08m (2.6 m)		Depth at P/L: 672.06m (2.6 m)
On at CC	Depth at Main: 671.71m (3.1 m)		Depth at Main: 670.27m (4.6 m)
Frost Plug	Pipe Size: 25 mm/20 mm		Pipe Size: 100 mm
Memo:	Pipe Material: HDPE	Insul. ☒ Yes ☐ No	Pipe Material: PVC
	Length from Main to P/L: 5.80m		Length from Main to P/L: 9.19m
			STORM
	Squirt Test: ☒ Pass ☐ fail		Depth at P/L:
	Frost Protection: ☒ Recirc ☐ Heat Trace		Depth at Main:
	Continuity Test: n/a		Pipe Size:
	PRV Required: Yes ☒ No ☐		Pipe Material:
			Length from Main to P/L:

CLEARLY INDICATE LOCATION OF CC AND ROUTE OF PIPES ON DRAWING BELOW

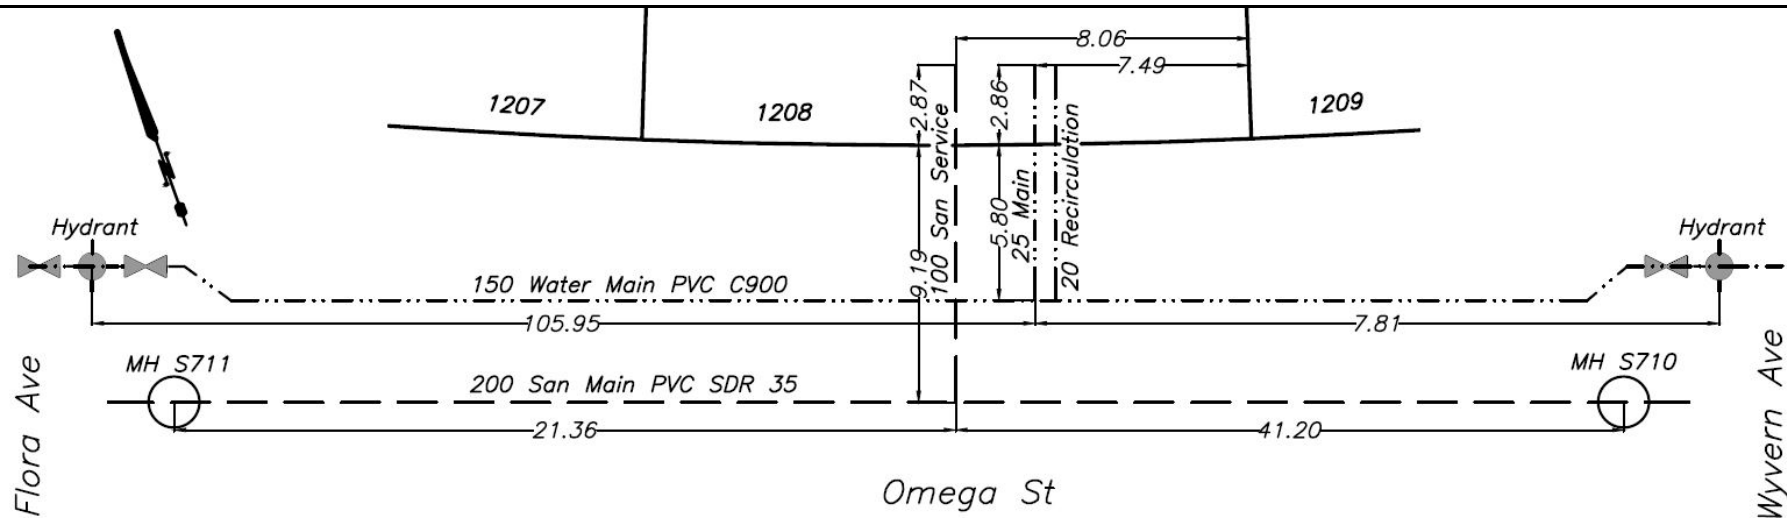




CITY OF WHITEHORSE

SERVICE CONNECTION RECORD

NAME Castle Rock Enterprises ADDRESS 39 Omega St BLOCK LOT 1209

DATES	WATER	SEWER
On at Main July 20, 2022	Depth at P/L: 672.41m (2.6 m)	Depth at P/L: 672.33m (2.7 m)
On at CC	Depth at Main: 671.73m (3.2 m)	Depth at Main: 670.10m (4.9 m)
Frost Plug	Pipe Size: 25 mm/20 mm	Pipe Size: 100 mm
Memo:	Pipe Material: HDPE Insul. ☒ Yes ☐ No	Pipe Material: PVC Insul. Yes ☒ No ☐ Yes
	Length from Main to P/L: 5.97m	Length from Main to P/L: 9.11m
		STORM
	Squirt Test: ☒ Pass ☐ fail	Depth at P/L:
	Frost Protection: ☒ Recirc ☐ Heat Trace	Depth at Main:
	Continuity Test: n/a Pass/Fail	Pipe Size:
	PRV Required: Yes ☒ No ☐ Yes	Pipe Material:
		Length from Main to P/L:

CLEARLY INDICATE LOCATION OF CC AND ROUTE OF PIPES ON DRAWING BELOW

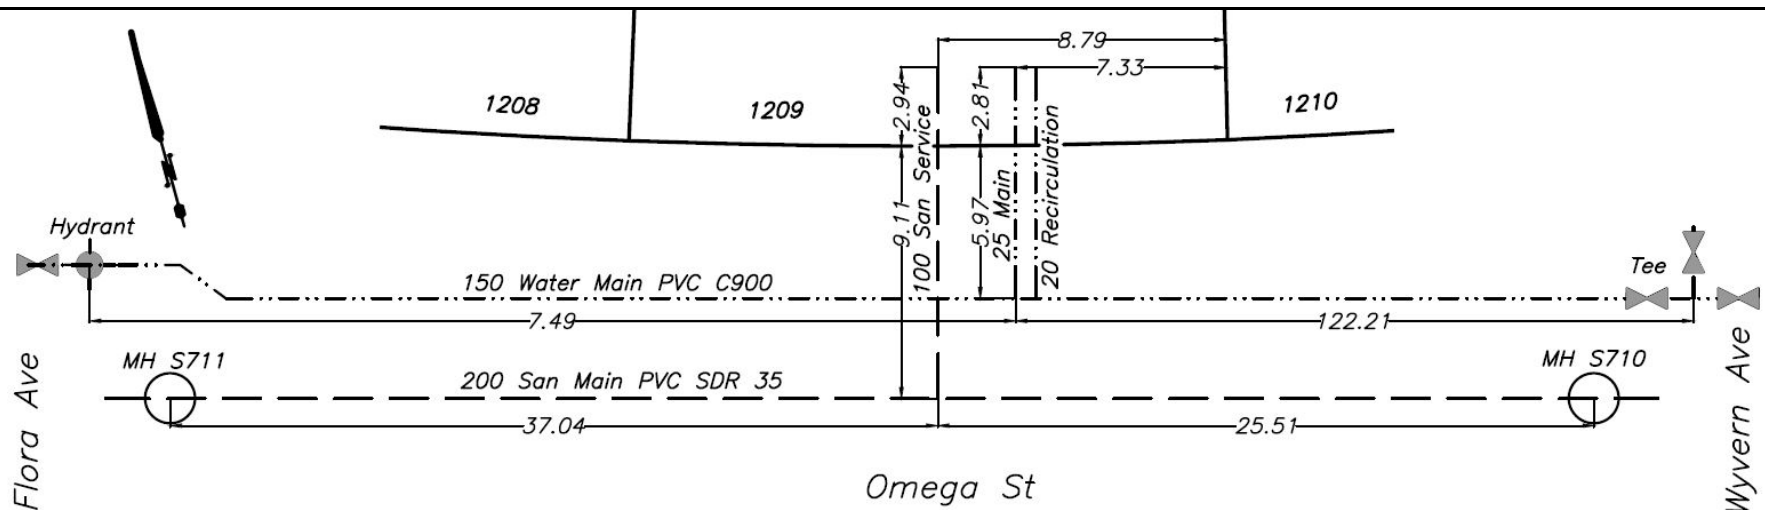




CITY OF WHITEHORSE

SERVICE CONNECTION RECORD

NAME Castle Rock Enterprises ADDRESS 37 Omega St BLOCK LOT 1210

DATES	WATER	SEWER
On at Main July 9, 2022	Depth at P/L: 672.51m (2.6 m)	Depth at P/L: 672.48m (2.6 m)
On at CC	Depth at Main: 671.76m (3.3 m)	Depth at Main: 669.90m (5.2 m)
Frost Plug	Pipe Size: 25 mm/20 mm	Pipe Size: 100 mm
Memo:	Pipe Material: HDPE Insul. ☒ Yes ☐ No	Pipe Material: PVC Insul. Yes ☒ No ☐ Yes
	Length from Main to P/L: 6.04m	Length from Main to P/L: 9.40m
		STORM
	Squirt Test: ☒ Pass ☐ fail	Depth at P/L:
	Frost Protection: ☒ Recirc ☐ Heat Trace	Depth at Main:
	Continuity Test: n/a Pass/Fail	Pipe Size:
	PRV Required: Yes ☒ No ☐ Yes	Pipe Material:
		Length from Main to P/L:

CLEARLY INDICATE LOCATION OF CC AND ROUTE OF PIPES ON DRAWING BELOW

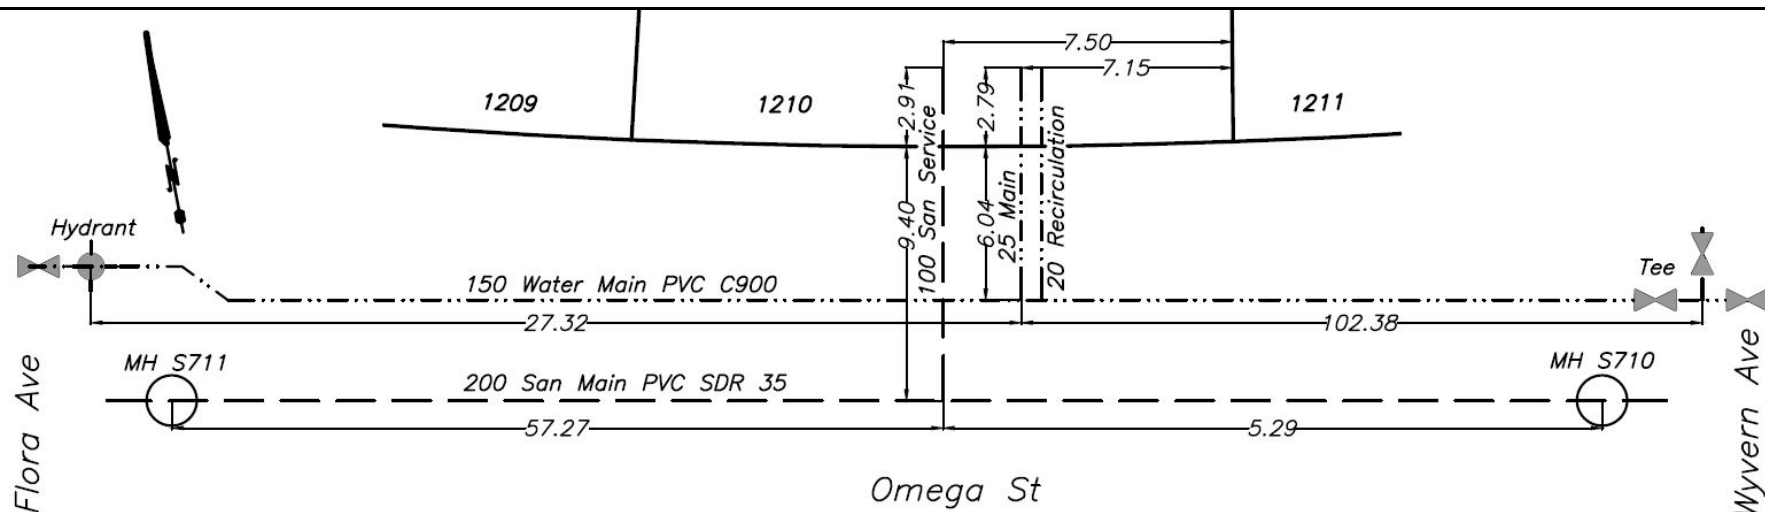




CITY OF WHITEHORSE

SERVICE CONNECTION RECORD

NAME Castle Rock Enterprises ADDRESS 35 Omega St BLOCK LOT 1211

DATES	WATER	SEWER
On at Main July 11, 2022	Depth at P/L: 672.56m (2.7 m)	Depth at P/L: 672.50m (2.7 m)
On at CC	Depth at Main: 671.80m (3.3 m)	Depth at Main: 672.01m (3.1 m)
Frost Plug	Pipe Size: 25 mm/20 mm	Pipe Size: 100 mm
Memo:	Pipe Material: HDPE Insul. ☒ Yes ☐ No	Pipe Material: PVC Insul. Yes ☒ No ☐ Yes
	Length from Main to P/L: 5.95m	Length from Main to P/L: 8.82m
		STORM
	Squirt Test: ☒ Pass ☐ fail	Depth at P/L:
	Frost Protection: ☒ Recirc ☐ Heat Trace	Depth at Main:
	Continuity Test: n/a Pass/Fail	Pipe Size:
	PRV Required: Yes ☒ No ☐ Yes	Pipe Material:
		Length from Main to P/L:

CLEARLY INDICATE LOCATION OF CC AND ROUTE OF PIPES ON DRAWING BELOW

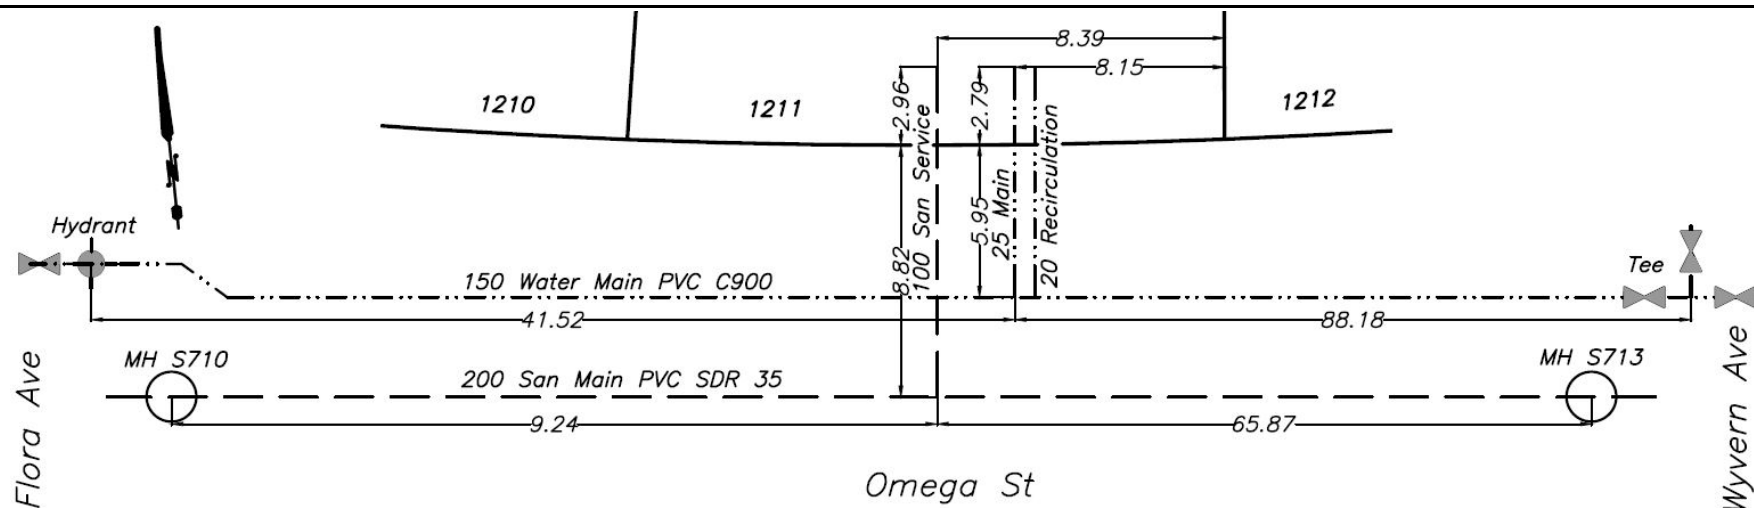




CITY OF WHITEHORSE

SERVICE CONNECTION RECORD

NAME Castle Rock Enterprises ADDRESS 33 Omega St BLOCK LOT 1212

DATES	WATER	SEWER
On at Main July 9, 2022	Depth at P/L: 672.60m (2.7 m)	Depth at P/L: 672.61m (2.7 m)
On at CC	Depth at Main: 671.82m (3.4 m)	Depth at Main: 672.11m (3.1 m)
Frost Plug	Pipe Size: 25 mm/20 mm	Pipe Size: 100 mm
Memo:	Pipe Material: HDPE Insul. ☒ Yes ☐ No	Pipe Material: PVC Insul. Yes ☒ No ☐ Yes
	Length from Main to P/L: 5.95m	Length from Main to P/L: 8.87m
		STORM
	Squirt Test: ☒ Pass ☐ fail	Depth at P/L:
	Frost Protection: ☒ Recirc ☐ Heat Trace	Depth at Main:
	Continuity Test: n/a Pass/Fail	Pipe Size:
	PRV Required: Yes ☒ No ☐ Yes	Pipe Material:
		Length from Main to P/L:

CLEARLY INDICATE LOCATION OF CC AND ROUTE OF PIPES ON DRAWING BELOW

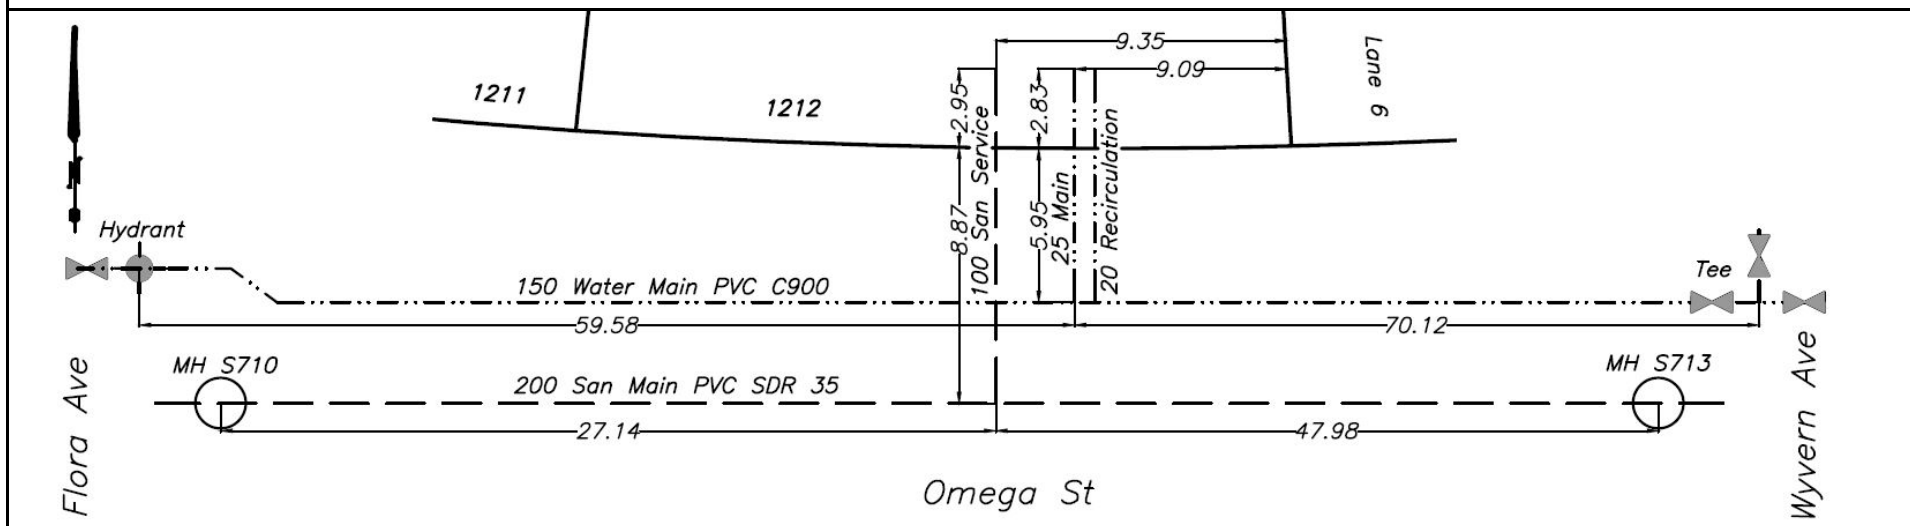




CITY OF WHITEHORSE

SERVICE CONNECTION RECORD

NAME Castle Rock Enterprises ADDRESS 54 Omega St BLOCK LOT 1213

DATES	WATER	SEWER
On at Main July 8, 2022	Depth at P/L: 671.75m (2.7 m)	Depth at P/L: 671.72m (2.7 m)
On at CC	Depth at Main: 671.31m (3.0 m)	Depth at Main: 671.15m (3.3 m)
Frost Plug	Pipe Size: 25 mm/20 mm	Pipe Size: 100 mm
Memo:	Pipe Material: HDPE Insul. <u>Yes</u> /No	Pipe Material: PVC Insul. Yes/ <u>No</u>
	Length from Main to P/L: 11.91m	Length from Main to P/L: 8.96m
		STORM
	Squirt Test: <u>Pass</u> /fail	Depth at P/L:
	Frost Protection: <u>Recirc</u> Heat Trace	Depth at Main:
	Continuity Test: n/a Pass/Fail	Pipe Size:
	PRV Required: Yes/ <u>No</u>	Pipe Material:
		Length from Main to P/L:

CLEARLY INDICATE LOCATION OF CC AND ROUTE OF PIPES ON DRAWING BELOW

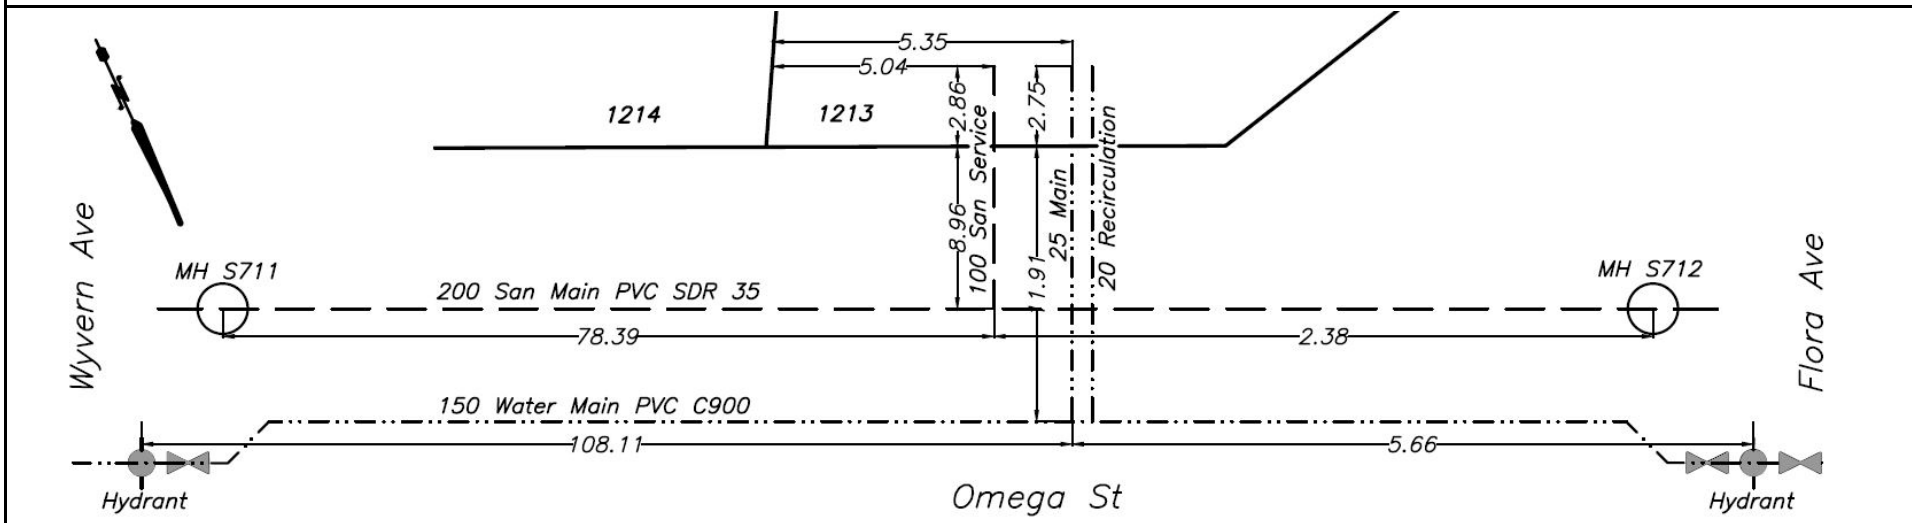




CITY OF WHITEHORSE

SERVICE CONNECTION RECORD

NAME Castle Rock Enterprises ADDRESS 52 Omega St BLOCK LOT 1214

DATES	WATER	SEWER
On at Main July 6, 2022	Depth at P/L: 671.86m (2.7 m)	Depth at P/L: 671.84m (2.7 m)
On at CC	Depth at Main: 671.34m (3.1 m)	Depth at Main: 671.05m (3.4 m)
Frost Plug	Pipe Size: 25 mm/20 mm	Pipe Size: 100 mm
Memo:	Pipe Material: HDPE Insul. <u>(Yes)</u> No	Pipe Material: PVC Insul. Yes <u>(No)</u>
	Length from Main to P/L: 11.91m	Length from Main to P/L: 9.04m
		STORM
	Squirt Test: <u>(Pass)</u> fail	Depth at P/L:
	Frost Protection: <u>(Recirc)</u> Heat Trace	Depth at Main:
	Continuity Test: n/a Pass/Fail	Pipe Size:
	PRV Required: Yes/ <u>(No)</u>	Pipe Material:
		Length from Main to P/L:

CLEARLY INDICATE LOCATION OF CC AND ROUTE OF PIPES ON DRAWING BELOW

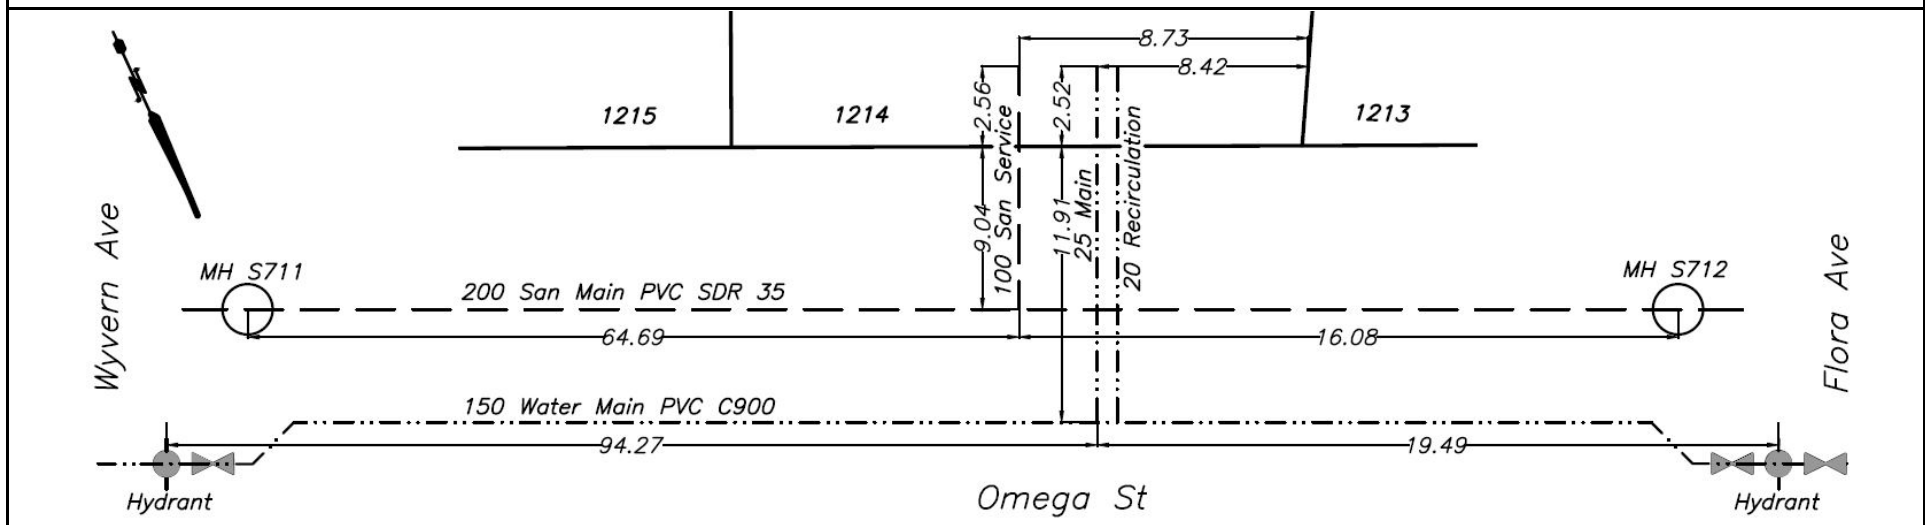




CITY OF WHITEHORSE

SERVICE CONNECTION RECORD

NAME Castle Rock Enterprises ADDRESS 50 Omega St BLOCK LOT 1215

DATES	WATER	SEWER
On at Main July 6, 2022	Depth at P/L: 671.98m (2.6 m)	Depth at P/L: 671.94m (2.7 m)
On at CC	Depth at Main: 671.48m (3.0 m)	Depth at Main: 670.95m (3.6 m)
Frost Plug	Pipe Size: 25 mm/20 mm	Pipe Size: 100 mm
Memo:	Pipe Material: HDPE Insul. ☒ Yes ☐ No	Pipe Material: PVC Insul. Yes ☐ No ☒
	Length from Main to P/L: 11.94m	Length from Main to P/L: 9.06m
		STORM
	Squirt Test: ☒ Pass ☐ fail	Depth at P/L:
	Frost Protection: ☒ Recirc ☐ Heat Trace	Depth at Main:
	Continuity Test: n/a Pass/Fail	Pipe Size:
	PRV Required: Yes ☐ No ☒	Pipe Material:
		Length from Main to P/L:

CLEARLY INDICATE LOCATION OF CC AND ROUTE OF PIPES ON DRAWING BELOW

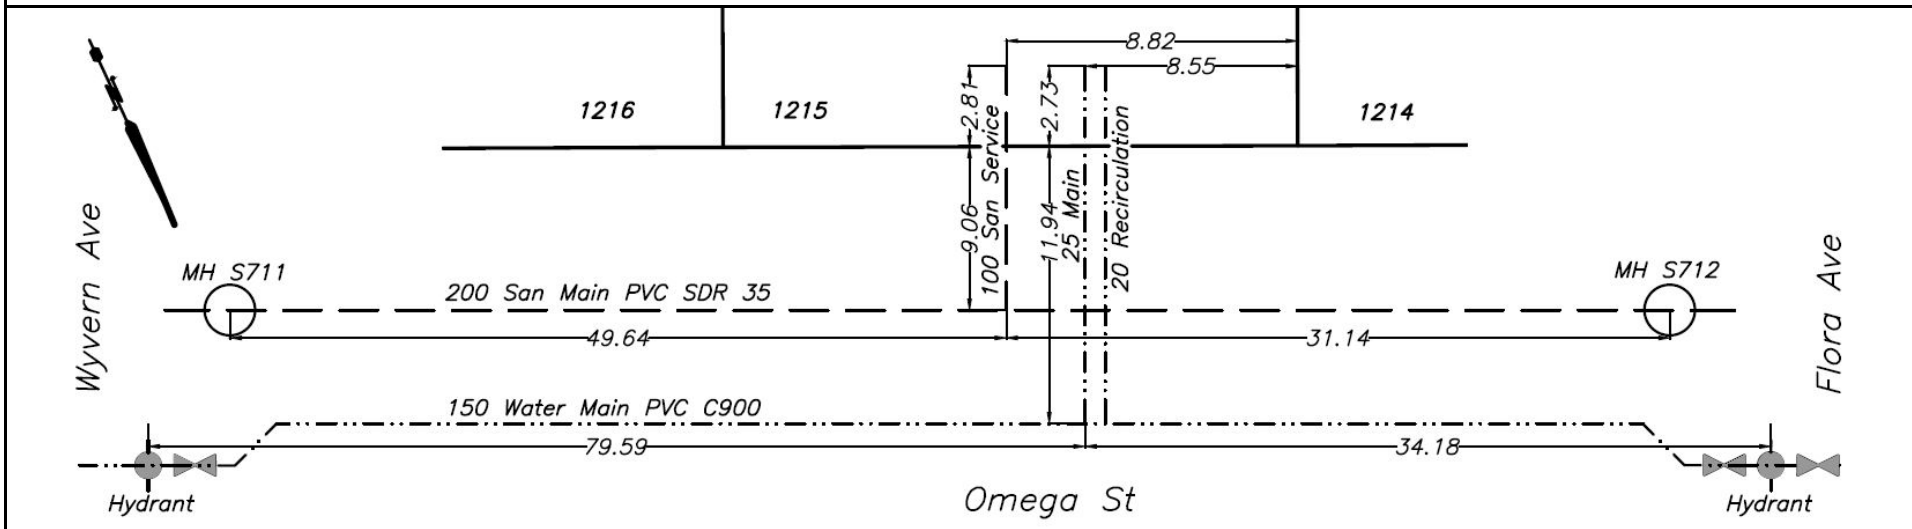




CITY OF WHITEHORSE

SERVICE CONNECTION RECORD

NAME Castle Rock Enterprises ADDRESS 48 Omega St BLOCK LOT 1216

DATES	WATER	SEWER
On at Main July 6, 2022	Depth at P/L: 671.95m (2.7 m)	Depth at P/L: 671.87m (2.8 m)
On at CC	Depth at Main: 671.49m (3.1 m)	Depth at Main: 670.86m (3.8 m)
Frost Plug	Pipe Size: 25 mm/20 mm	Pipe Size: 100 mm
Memo:	Pipe Material: HDPE Insul. ☒ Yes ☐ No	Pipe Material: PVC Insul. Yes ☒ No ☐ Yes
	Length from Main to P/L: 11.91m	Length from Main to P/L: 9.03m
		STORM
	Squirt Test: ☒ Pass ☐ fail	Depth at P/L:
	Frost Protection: ☒ Recirc ☐ Heat Trace	Depth at Main:
	Continuity Test: n/a Pass/Fail	Pipe Size:
	PRV Required: Yes ☒ No ☐ Yes	Pipe Material:
		Length from Main to P/L:

CLEARLY INDICATE LOCATION OF CC AND ROUTE OF PIPES ON DRAWING BELOW

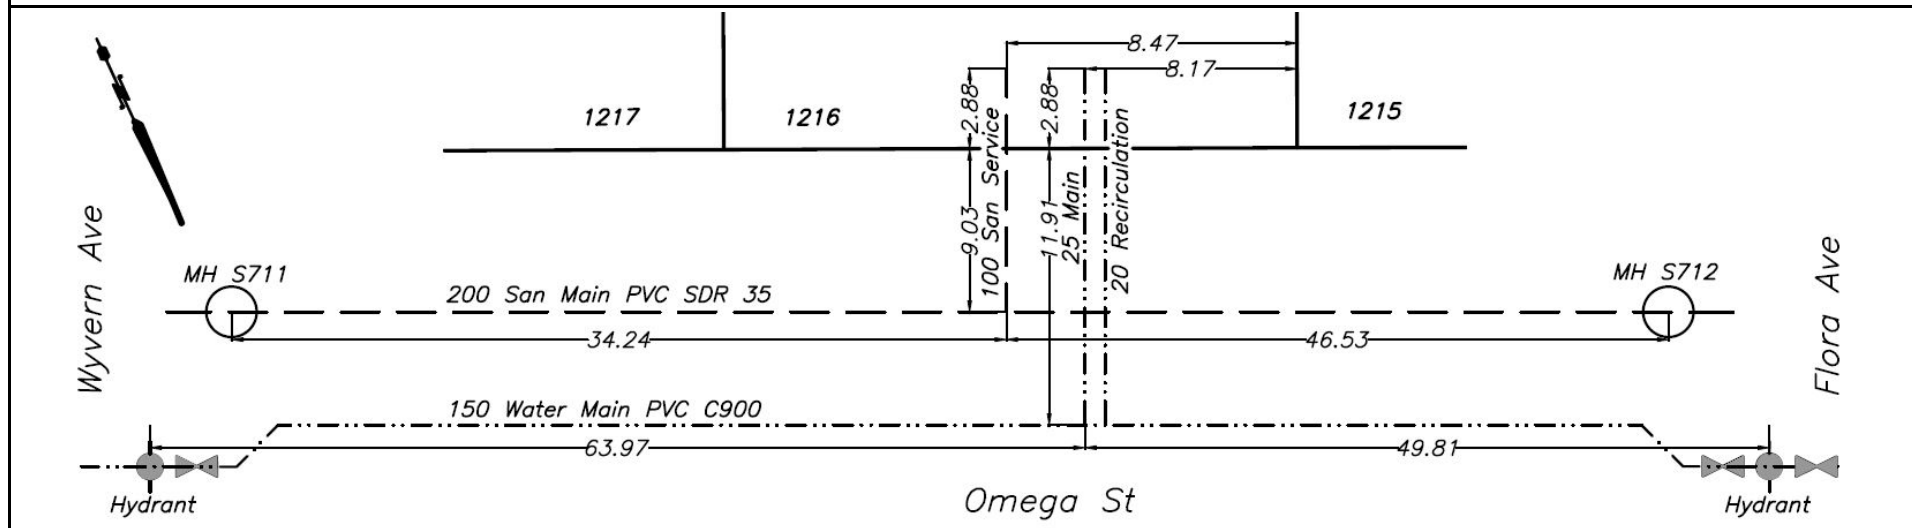




CITY OF WHITEHORSE

SERVICE CONNECTION RECORD

NAME Castle Rock Enterprises ADDRESS 46 Omega St BLOCK LOT 1217

DATES	WATER	SEWER
On at Main July 6, 2022	Depth at P/L: 672.09m (2.7 m)	Depth at P/L: 671.99m (2.8 m)
On at CC	Depth at Main: 671.57m (3.1 m)	Depth at Main: 670.78m (3.9 m)
Frost Plug	Pipe Size: 25 mm/20 mm	Pipe Size: 100 mm
Memo:	Pipe Material: HDPE Insul. ☒ Yes ☐ No	Pipe Material: PVC Insul. Yes ☒ No ☐ Yes
	Length from Main to P/L: 11.93m	Length from Main to P/L: 9.09m
		STORM
	Squirt Test: ☒ Pass ☐ fail	Depth at P/L:
	Frost Protection: ☒ Recirc ☐ Heat Trace	Depth at Main:
	Continuity Test: n/a Pass/Fail	Pipe Size:
	PRV Required: Yes ☒ No ☐ Yes	Pipe Material:
		Length from Main to P/L:

CLEARLY INDICATE LOCATION OF CC AND ROUTE OF PIPES ON DRAWING BELOW

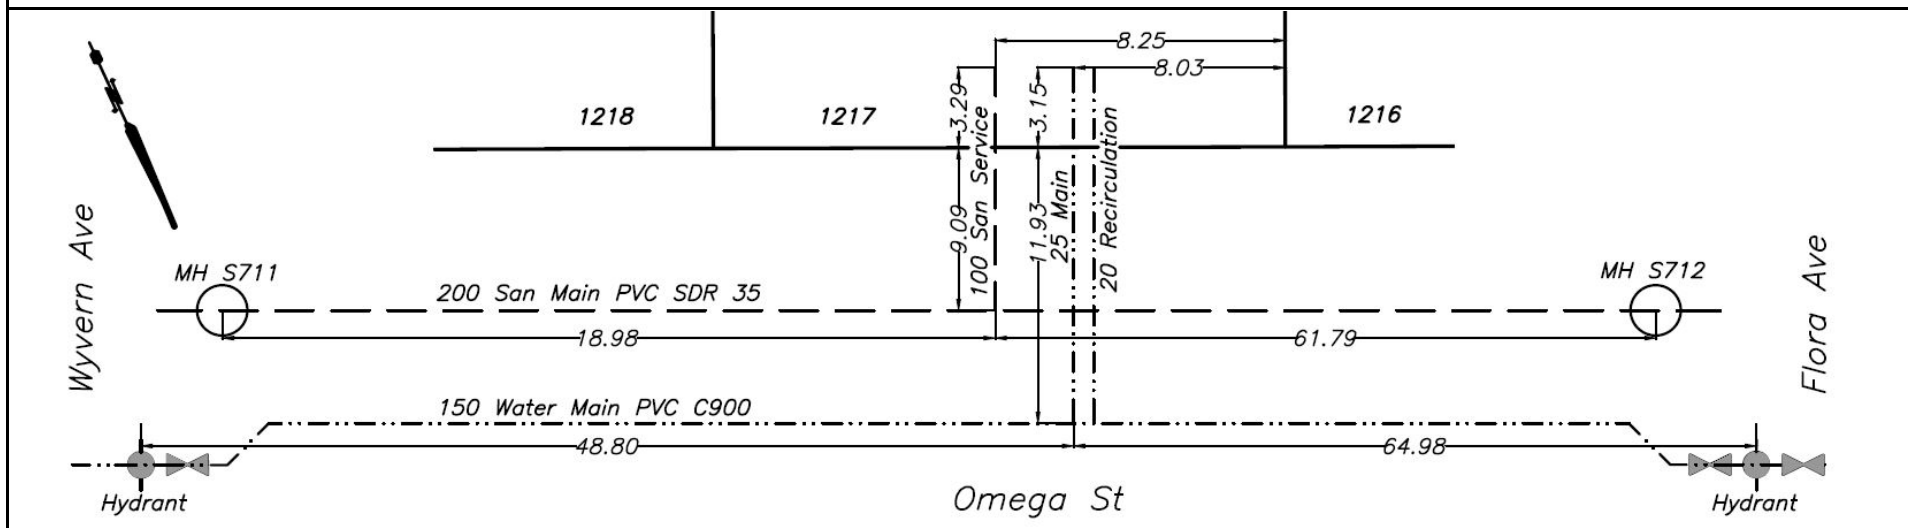




CITY OF WHITEHORSE

SERVICE CONNECTION RECORD

NAME Castle Rock Enterprises ADDRESS 44 Omega St BLOCK LOT 1218

DATES	WATER	SEWER
On at Main July 6, 2022	Depth at P/L: 672.11m (2.7 m)	Depth at P/L: 672.04m (2.8 m)
On at CC	Depth at Main: 671.64m (3.1 m)	Depth at Main: 670.70m (4.1 m)
Frost Plug	Pipe Size: 25 mm/20 mm	Pipe Size: 100 mm
Memo:	Pipe Material: HDPE Insul. <u>Yes</u> /No	Pipe Material: PVC Insul. Yes/ <u>No</u>
	Length from Main to P/L: 12.01m	Length from Main to P/L: 9.24m
		STORM
	Squirt Test: <u>Pass</u> /fail	Depth at P/L:
	Frost Protection: <u>Recirc</u> Heat Trace	Depth at Main:
	Continuity Test: n/a Pass/Fail	Pipe Size:
	PRV Required: Yes/ <u>No</u>	Pipe Material:
		Length from Main to P/L:

CLEARLY INDICATE LOCATION OF CC AND ROUTE OF PIPES ON DRAWING BELOW

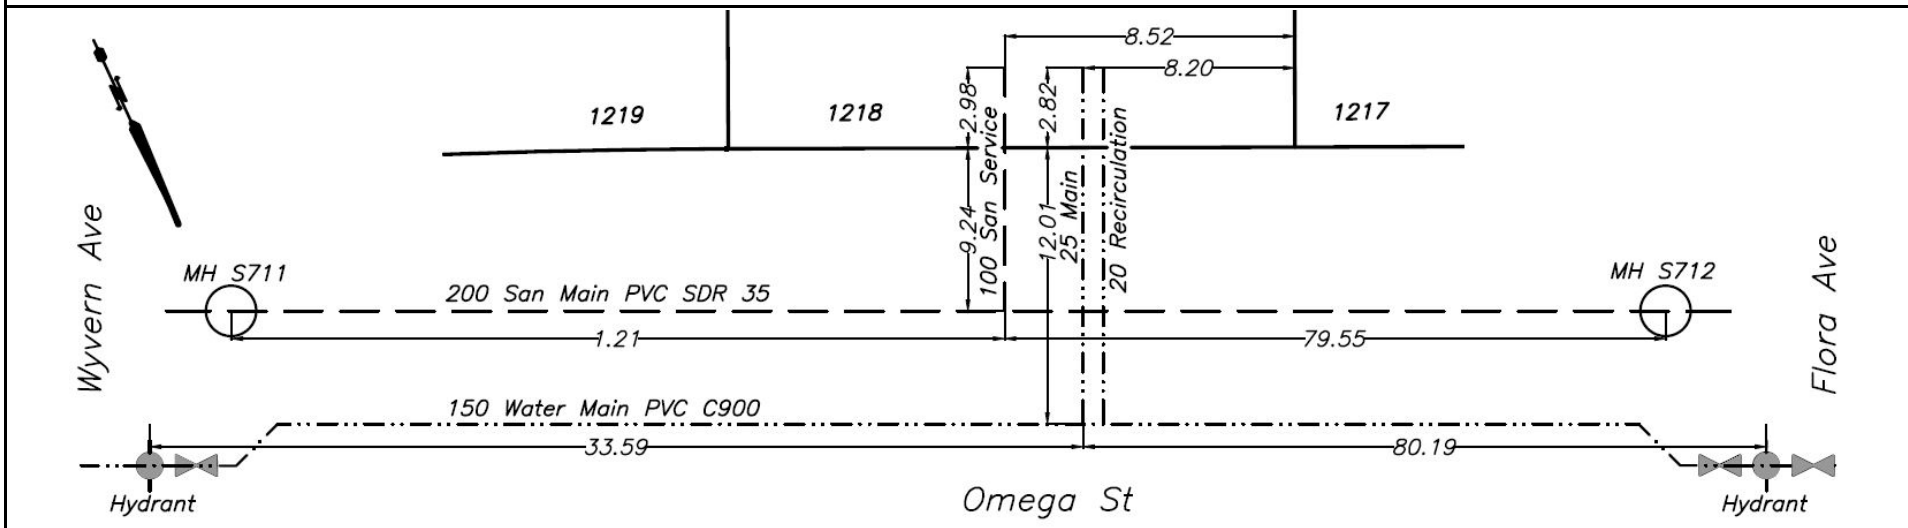




CITY OF WHITEHORSE

SERVICE CONNECTION RECORD

NAME Castle Rock Enterprises ADDRESS 42 Omega St BLOCK LOT 1219

DATES	WATER	SEWER
On at Main July 5, 2022	Depth at P/L: 672.24m (2.7 m)	Depth at P/L: 672.22m (2.7 m)
On at CC	Depth at Main: 671.70m (3.1 m)	Depth at Main: 670.36m (4.5 m)
Frost Plug	Pipe Size: 25 mm/20 mm	Pipe Size: 100 mm
Memo:	Pipe Material: HDPE Insul. <u>(Yes)</u> No	Pipe Material: PVC Insul. Yes <u>(No)</u>
	Length from Main to P/L: 12.29m	Length from Main to P/L: 9.18m
		STORM
	Squirt Test: <u>(Pass)</u> fail	Depth at P/L:
	Frost Protection: <u>(Recirc)</u> Heat Trace	Depth at Main:
	Continuity Test: n/a Pass/Fail	Pipe Size:
	PRV Required: Yes/ <u>(No)</u>	Pipe Material:
		Length from Main to P/L:

CLEARLY INDICATE LOCATION OF CC AND ROUTE OF PIPES ON DRAWING BELOW

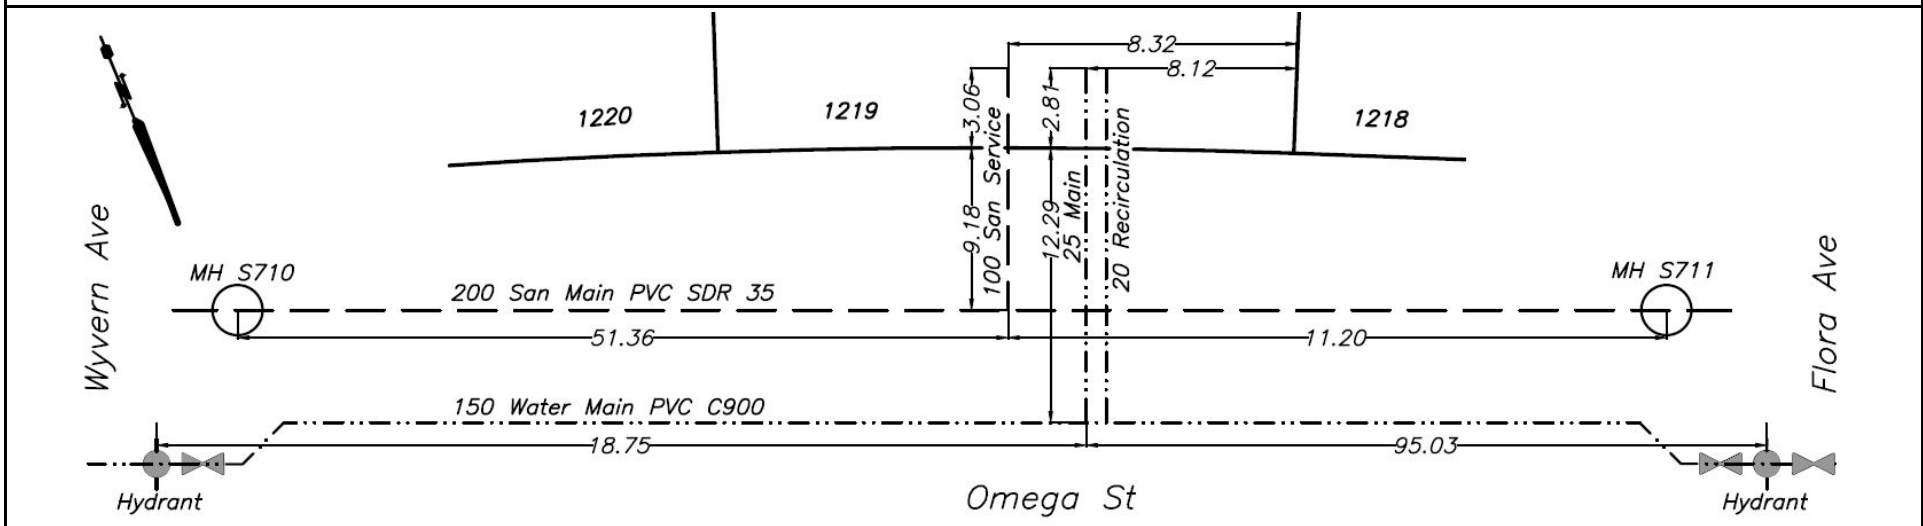




CITY OF WHITEHORSE

SERVICE CONNECTION RECORD

NAME Castle Rock Interpr ADDRESS 40 Omega St BLOCK LOT 1220

DATES	WATER	SEWER
On at Main July 8, 2022	Depth at P/L: 672.36m (2.6 m)	Depth at P/L: 672.25m (2.7 m)
On at CC	Depth at Main: 671.69m (3.2 m)	Depth at Main: 670.23m (4.7 m)
Frost Plug	Pipe Size: 25 mm/20 mm	Pipe Size: 100 mm
Memo:	Pipe Material: HDPE Insul. ☒ Yes ☐ No	Pipe Material: PVC Insul. Yes ☐ No ☒
	Length from Main to P/L: 12.10m	Length from Main to P/L: 9.31m
		STORM
	Squirt Test: ☒ Pass ☐ fail	Depth at P/L:
	Frost Protection: ☒ Recirc ☐ Heat Trace	Depth at Main:
	Continuity Test: n/a Pass/Fail	Pipe Size:
	PRV Required: Yes ☐ No ☒	Pipe Material:
		Length from Main to P/L:

CLEARLY INDICATE LOCATION OF CC AND ROUTE OF PIPES ON DRAWING BELOW

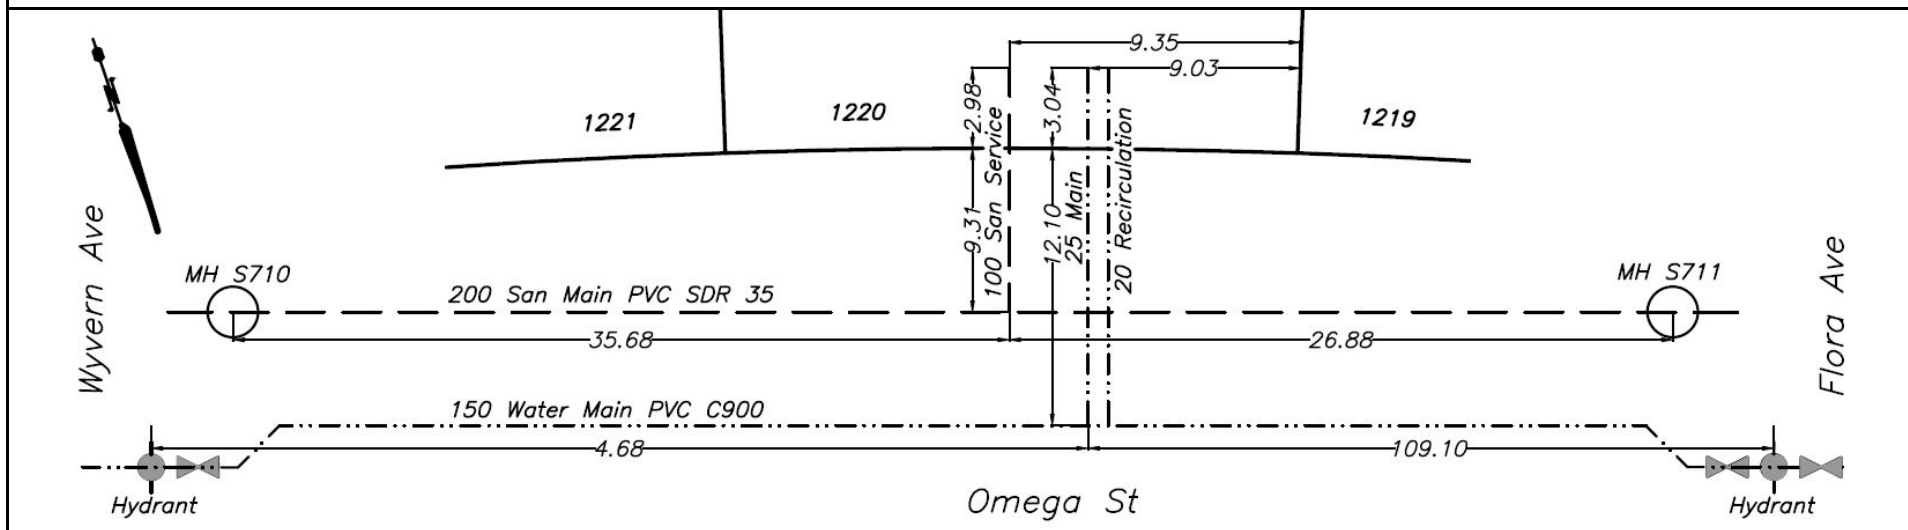




CITY OF WHITEHORSE

SERVICE CONNECTION RECORD

NAME Castle Rock Enterprises ADDRESS 38 Omega St BLOCK LOT 1221

DATES	WATER	SEWER
On at Main July 7, 2022	Depth at P/L: 672.21m (2.8 m)	Depth at P/L: 672.20m (2.9 m)
On at CC	Depth at Main: 671.73m (3.2 m)	Depth at Main: 670.05m (5.0 m)
Frost Plug	Pipe Size: 25 mm/20 mm	Pipe Size: 100 mm
Memo:	Pipe Material: HDPE Insul. ☒ Yes ☐ No	Pipe Material: PVC Insul. Yes ☒ No ☐ Yes
	Length from Main to P/L: 12.05m	Length from Main to P/L: 9.38m
		STORM
	Squirt Test: ☒ Pass ☐ fail	Depth at P/L:
	Frost Protection: ☒ Recirc ☐ Heat Trace	Depth at Main:
	Continuity Test: n/a Pass/Fail	Pipe Size:
	PRV Required: Yes ☒ No ☐ Yes	Pipe Material:
		Length from Main to P/L:

CLEARLY INDICATE LOCATION OF CC AND ROUTE OF PIPES ON DRAWING BELOW

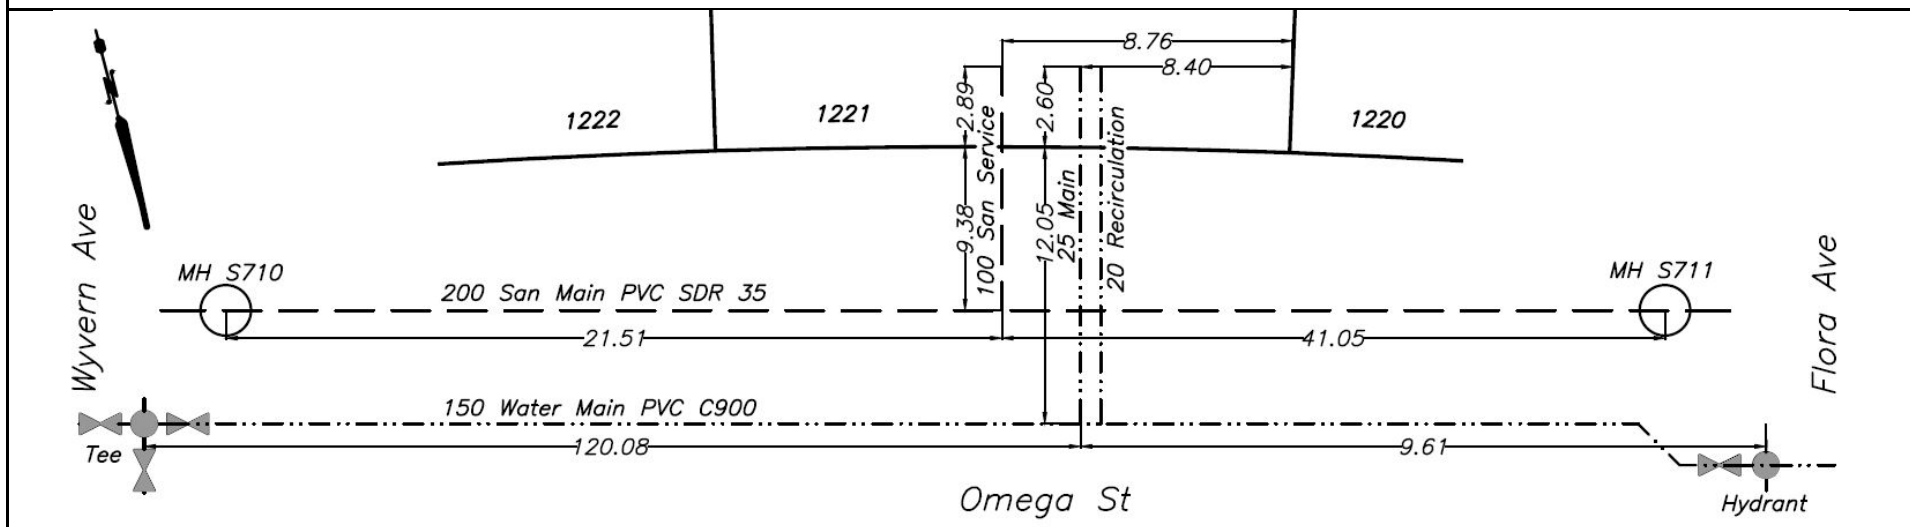




CITY OF WHITEHORSE

SERVICE CONNECTION RECORD

NAME Castle Rock Enterprises ADDRESS 36 Omega St BLOCK LOT 1222

DATES	WATER	SEWER
On at Main July 5, 2022	Depth at P/L: 672.24m (2.9 m)	Depth at P/L: 672.43m (2.7 m)
On at CC	Depth at Main: 671.75m (3.3 m)	Depth at Main: 670.55m (4.5 m)
Frost Plug	Pipe Size: 25 mm/20 mm	Pipe Size: 100 mm
Memo:	Pipe Material: HDPE Insul. ☒ Yes ☐ No	Pipe Material: PVC Insul. Yes ☒ No ☐ Yes
	Length from Main to P/L: 12.11m	Length from Main to P/L: 8.55m
		STORM
	Squirt Test: ☒ Pass ☐ fail	Depth at P/L:
	Frost Protection: ☒ Recirc ☐ Heat Trace	Depth at Main:
	Continuity Test: n/a Pass/Fail	Pipe Size:
	PRV Required: Yes ☒ No ☐ Yes	Pipe Material:
		Length from Main to P/L:

CLEARLY INDICATE LOCATION OF CC AND ROUTE OF PIPES ON DRAWING BELOW

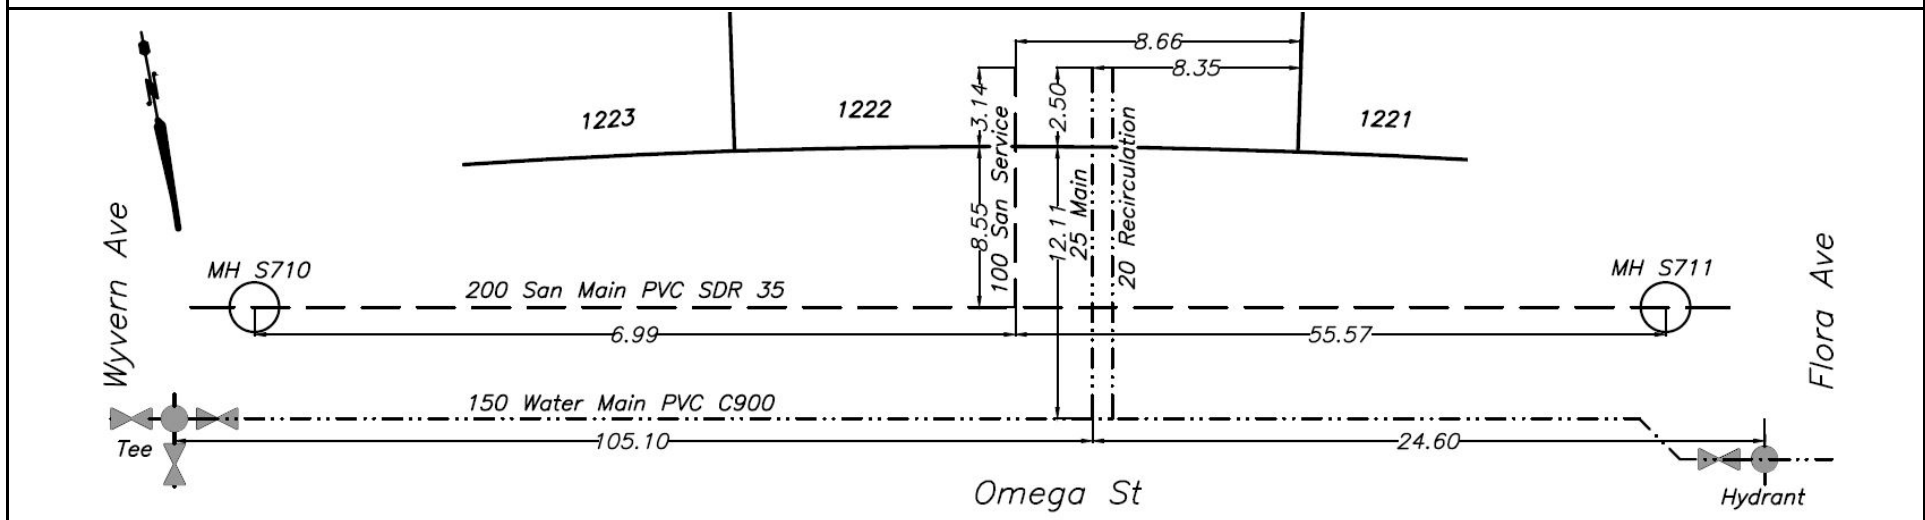




CITY OF WHITEHORSE

SERVICE CONNECTION RECORD

NAME Castle Rock Enterprises ADDRESS 34 Omega St BLOCK LOT 1223

DATES	WATER	SEWER
On at Main July 7, 2022	Depth at P/L: 672.42m (2.8 m)	Depth at P/L: 672.40m (2.8 m)
On at CC	Depth at Main: 671.78m (3.3 m)	Depth at Main: 671.98m (3.2 m)
Frost Plug	Pipe Size: 25 mm/20 mm	Pipe Size: 100 mm
Memo:	Pipe Material: HDPE Insul. ☒ Yes ☐ No	Pipe Material: PVC Insul. Yes ☒ No ☐ Yes
	Length from Main to P/L: 12.04m	Length from Main to P/L: 9.13m
		STORM
	Squirt Test: ☒ Pass ☐ fail	Depth at P/L:
	Frost Protection: ☒ Recirc ☐ Heat Trace	Depth at Main:
	Continuity Test: n/a Pass/Fail	Pipe Size:
	PRV Required: Yes ☒ No ☐ Yes	Pipe Material:
		Length from Main to P/L:

CLEARLY INDICATE LOCATION OF CC AND ROUTE OF PIPES ON DRAWING BELOW

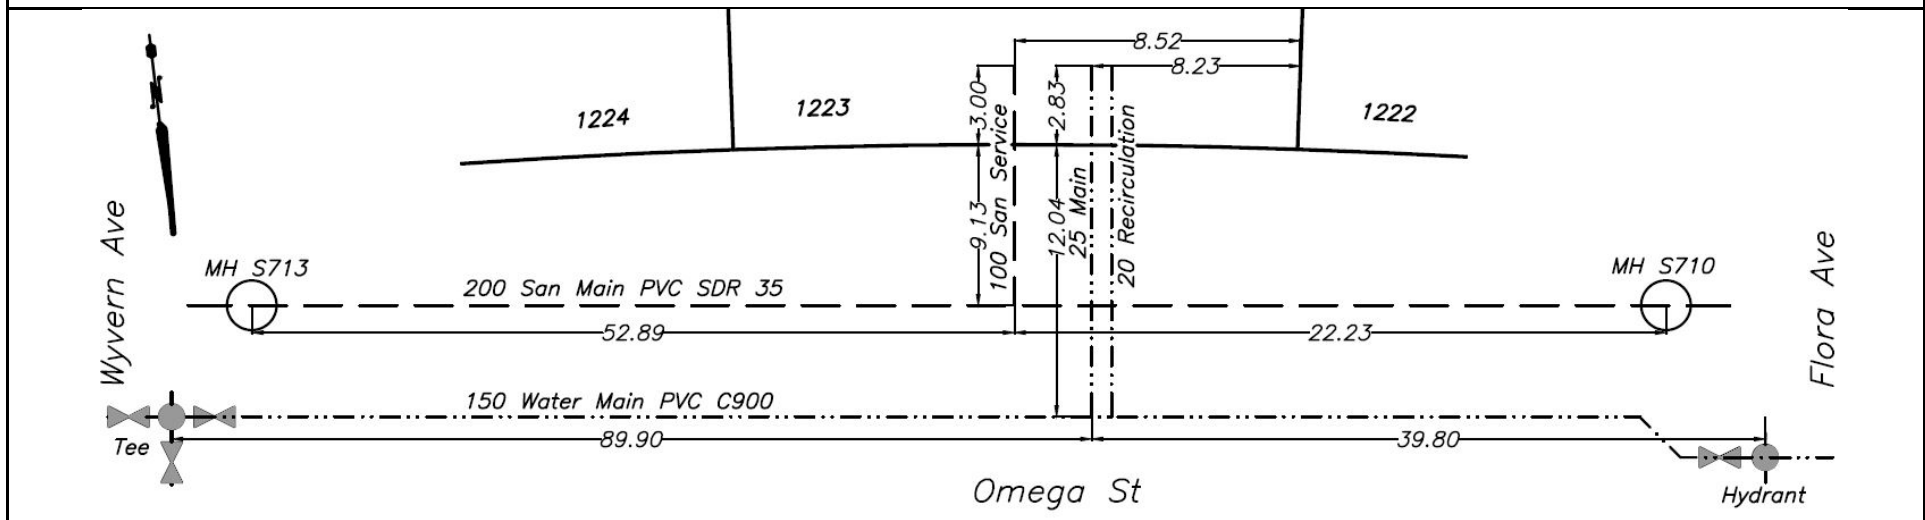




CITY OF WHITEHORSE

SERVICE CONNECTION RECORD

NAME Castle Rock Enterprises ADDRESS 32 Omega St BLOCK LOT 1224

DATES	WATER	SEWER
On at Main July 7, 2022	Depth at P/L: 672.54m (2.7 m)	Depth at P/L: 672.52m (2.8 m)
On at CC	Depth at Main: 671.79m (3.4 m)	Depth at Main: 672.08m (3.1 m)
Frost Plug	Pipe Size: 25 mm/20 mm	Pipe Size: 100 mm
Memo:	Pipe Material: HDPE Insul. ☒ Yes ☐ No	Pipe Material: PVC Insul. Yes ☐ No ☒
	Length from Main to P/L: 12.11m	Length from Main to P/L: 9.14m
		STORM
	Squirt Test: ☒ Pass ☐ Fail	Depth at P/L:
	Frost Protection: ☒ Recirc ☐ Heat Trace	Depth at Main:
	Continuity Test: n/a	Pipe Size:
	PRV Required: Yes ☐ No ☒	Pipe Material:
		Length from Main to P/L:

CLEARLY INDICATE LOCATION OF CC AND ROUTE OF PIPES ON DRAWING BELOW

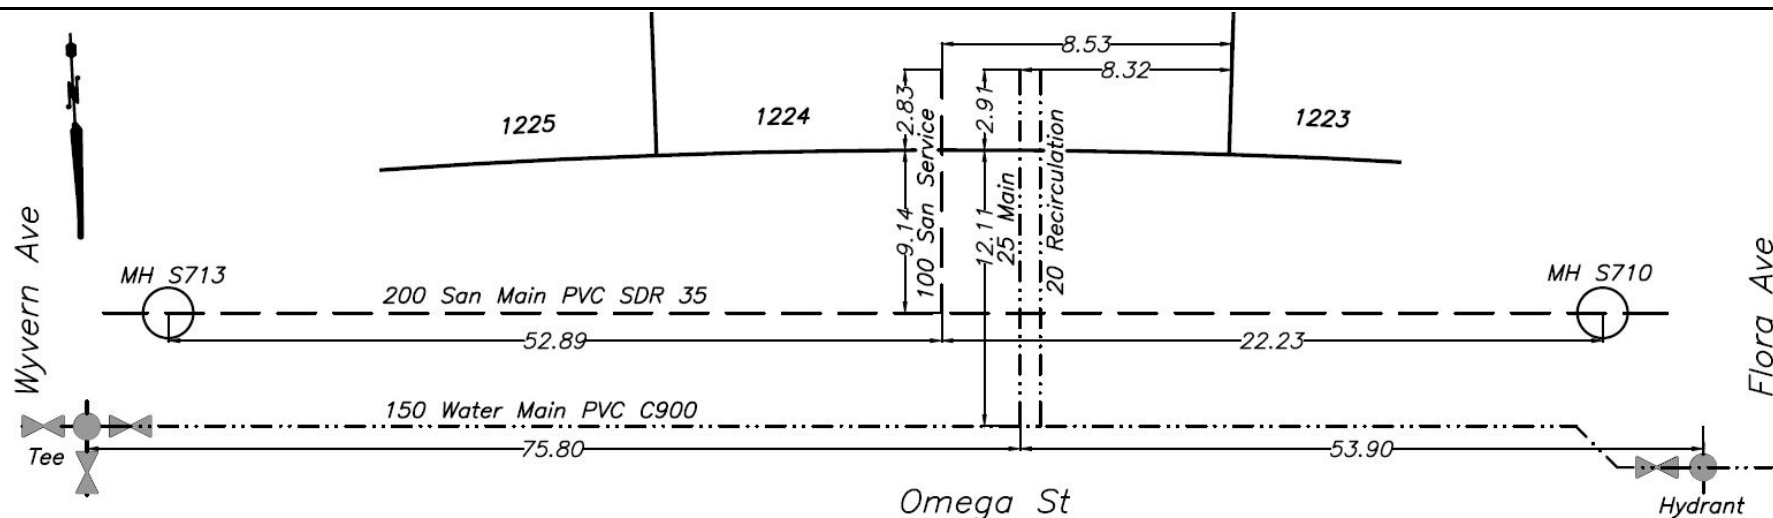




CITY OF WHITEHORSE

SERVICE CONNECTION RECORD

NAME Castle Rock Enterprises ADDRESS 30 Omega St BLOCK LOT 1225

DATES	WATER	SEWER
On at Main July 4, 2022	Depth at P/L: 672.55m (2.8 m)	Depth at P/L: 672.51m (2.9 m)
On at CC	Depth at Main: 671.80m (3.4 m)	Depth at Main: 672.19m (3.1 m)
Frost Plug	Pipe Size: 25 mm/20 mm	Pipe Size: 100 mm
Memo:	Pipe Material: HDPE Insul. ☒ Yes ☐ No	Pipe Material: PVC Insul. Yes ☒ No ☐ Yes
	Length from Main to P/L: 12.01m	Length from Main to P/L: 8.89m
		STORM
	Squirt Test: ☒ Pass ☐ fail	Depth at P/L:
	Frost Protection: ☒ Recirc ☐ Heat Trace	Depth at Main:
	Continuity Test: n/a Pass/Fail	Pipe Size:
	PRV Required: Yes ☒ No ☐ Yes	Pipe Material:
		Length from Main to P/L:

CLEARLY INDICATE LOCATION OF CC AND ROUTE OF PIPES ON DRAWING BELOW

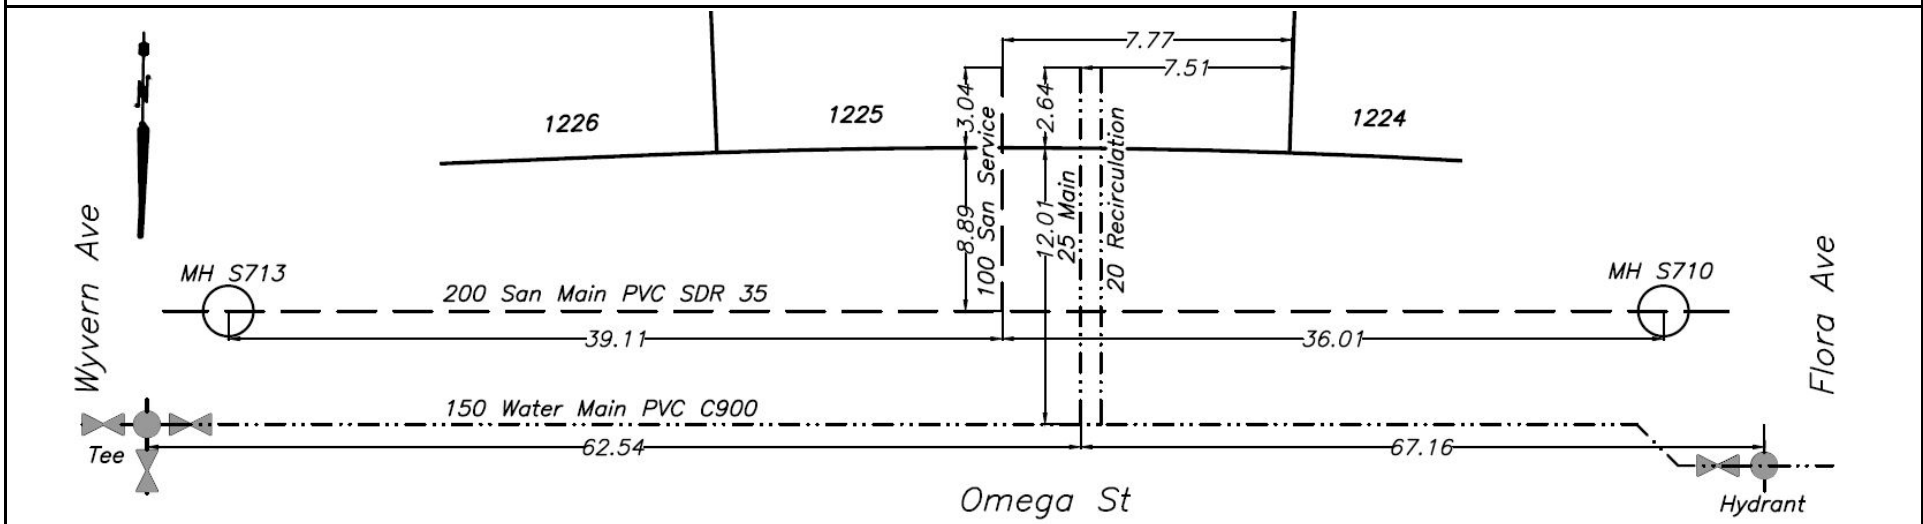




CITY OF WHITEHORSE

SERVICE CONNECTION RECORD

NAME Castle Rock Enterprises ADDRESS 28 Omega St BLOCK LOT 1226

DATES	WATER	SEWER
On at Main July 11, 2022	Depth at P/L: 672.73m (2.7 m)	Depth at P/L: 672.64m (2.8 m)
On at CC	Depth at Main: 671.89m (3.4 m)	Depth at Main: 672.27m (3.1 m)
Frost Plug	Pipe Size: 25 mm/20 mm	Pipe Size: 100 mm
Memo:	Pipe Material: HDPE Insul. ☒ Yes ☐ No	Pipe Material: PVC Insul. Yes ☒ No ☐ Yes
	Length from Main to P/L: 11.99m	Length from Main to P/L: 8.39m
		STORM
	Squirt Test: ☒ Pass ☐ fail	Depth at P/L:
	Frost Protection: ☒ Recirc ☐ Heat Trace	Depth at Main:
	Continuity Test: n/a Pass/Fail	Pipe Size:
	PRV Required: Yes ☒ No ☐	Pipe Material:
		Length from Main to P/L:

CLEARLY INDICATE LOCATION OF CC AND ROUTE OF PIPES ON DRAWING BELOW

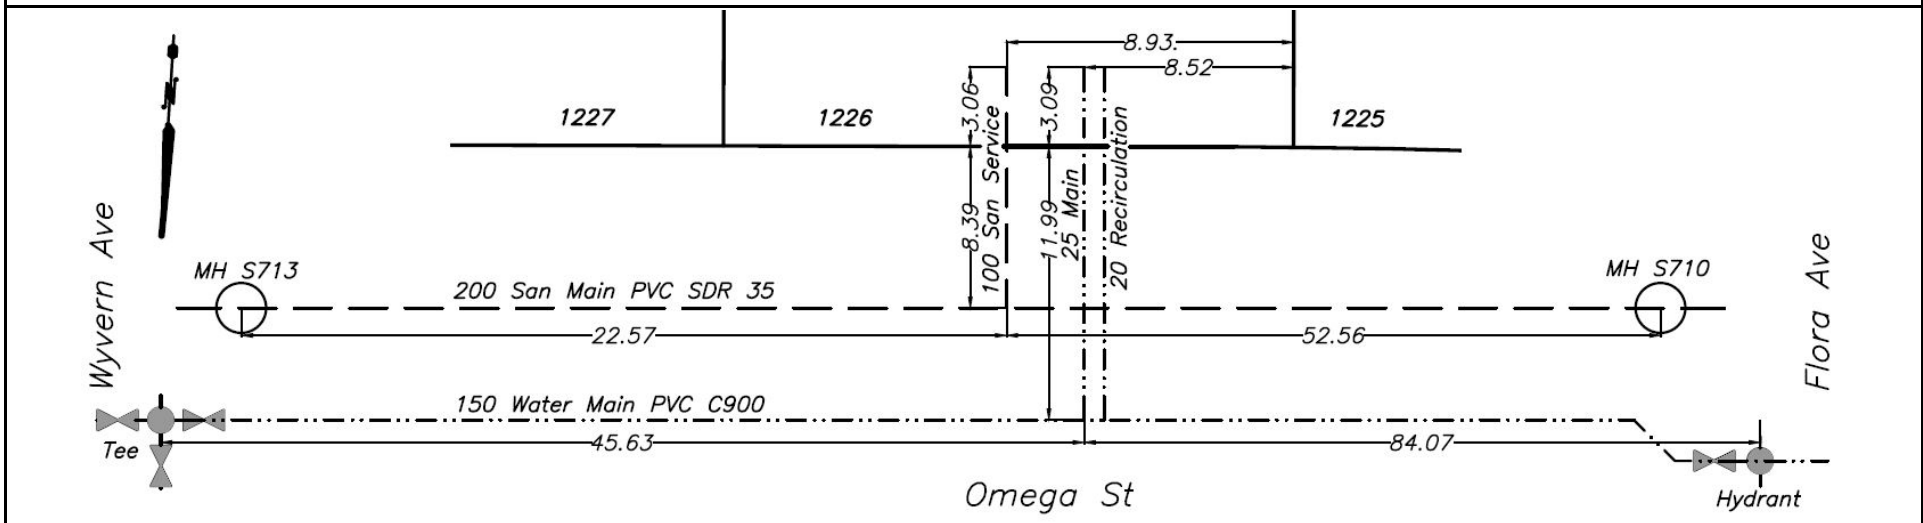




CITY OF WHITEHORSE

SERVICE CONNECTION RECORD

NAME Castle Rock Enterprises ADDRESS 26 Omega St BLOCK LOT 1227

DATES	WATER	SEWER
On at Main July 11, 2022	Depth at P/L: 672.62m (2.9 m)	Depth at P/L: 672.66m (2.8 m)
On at CC	Depth at Main: 671.90m (3.5 m)	Depth at Main: 672.36m (3.1 m)
Frost Plug	Pipe Size: 25 mm/20 mm	Pipe Size: 100 mm
Memo:	Pipe Material: HDPE Insul. ☒ Yes ☐ No	Pipe Material: PVC Insul. Yes ☒ No ☐ Yes
	Length from Main to P/L: 11.94m	Length from Main to P/L: 8.44m
		STORM
	Squirt Test: ☒ Pass ☐ fail	Depth at P/L:
	Frost Protection: ☒ Recirc ☐ Heat Trace	Depth at Main:
	Continuity Test: n/a Pass/Fail	Pipe Size:
	PRV Required: Yes ☒ No ☐ Yes	Pipe Material:
		Length from Main to P/L:

CLEARLY INDICATE LOCATION OF CC AND ROUTE OF PIPES ON DRAWING BELOW

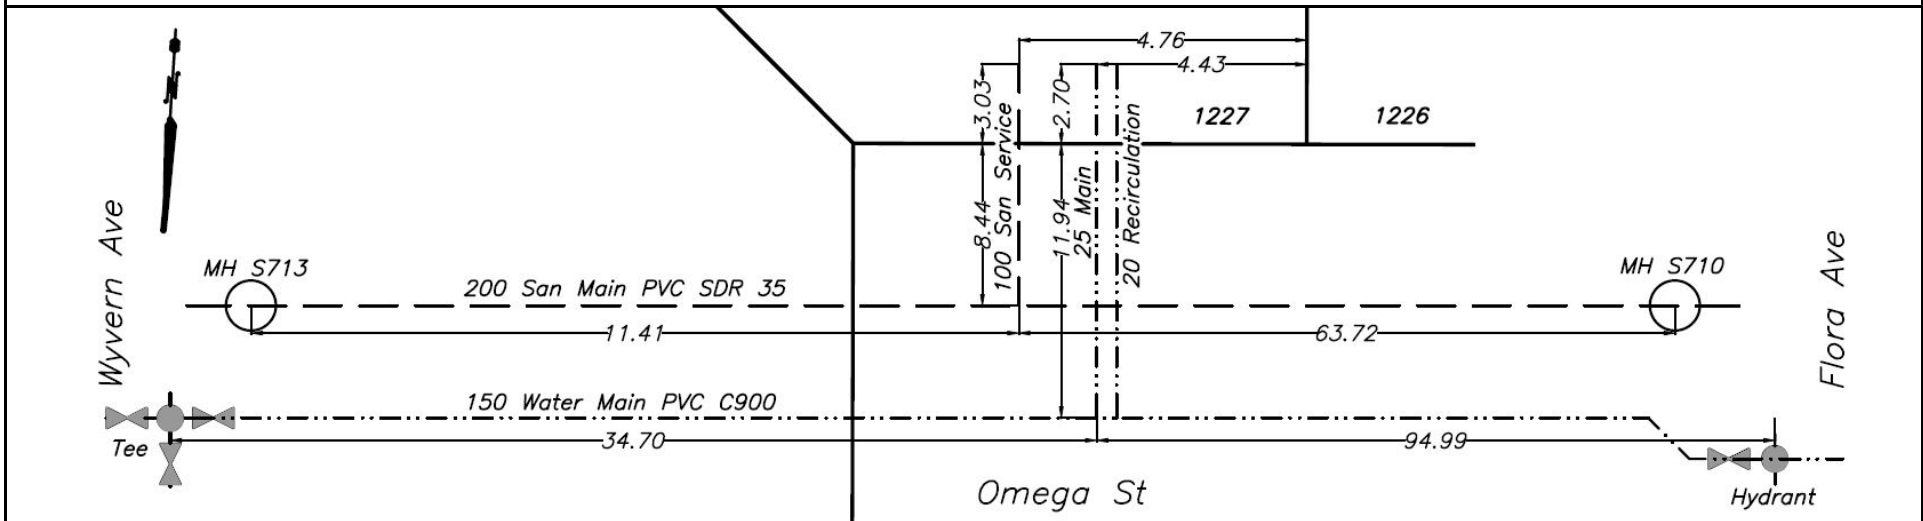




CITY OF WHITEHORSE

SERVICE CONNECTION RECORD

NAME Castle Rock Enterprises ADDRESS 243 Leota St BLOCK LOT 1229

DATES	WATER	SEWER
On at Main June 27, 2023	Depth at P/L: 671.99m (2.7 m)	Depth at P/L: 672.06m (2.6 m)
On at CC	Depth at Main: 671.41m (3.2 m)	Depth at Main: 671.60m (3.2 m)
Frost Plug	Pipe Size: 25 mm/20 mm	Pipe Size: 100 mm
Memo:	Pipe Material: HDPE Insul. ☒ Yes ☐ No	Pipe Material: PVC Insul. Yes ☒ No ☐ Yes
	Length from Main to P/L: 3.53m	Length from Main to P/L: 10.87m
		STORM
	Squirt Test: ☒ Pass ☐ fail	Depth at P/L:
	Frost Protection: ☒ Recirc ☐ Heat Trace	Depth at Main:
	Continuity Test: n/a Pass/Fail	Pipe Size:
	PRV Required: Yes ☒ No ☐ Yes	Pipe Material:
		Length from Main to P/L:

CLEARLY INDICATE LOCATION OF CC AND ROUTE OF PIPES ON DRAWING BELOW

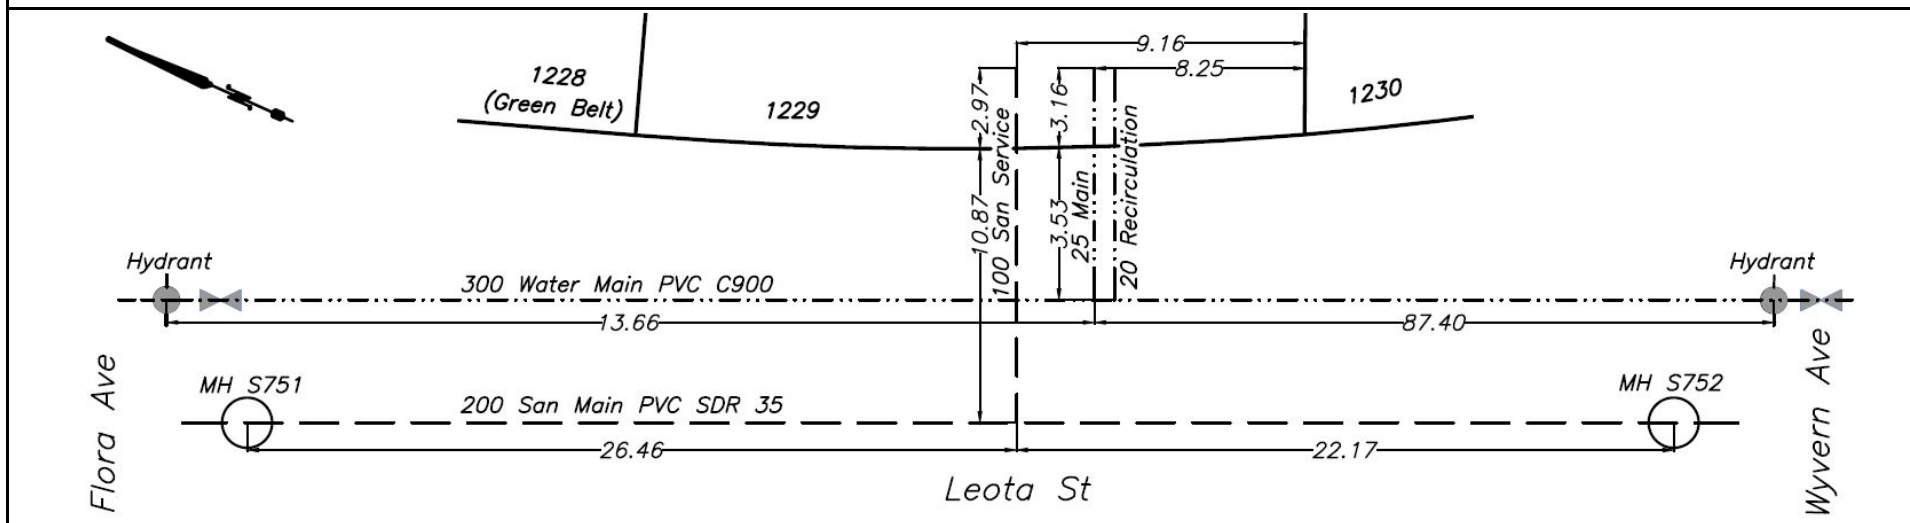




CITY OF WHITEHORSE

SERVICE CONNECTION RECORD

NAME Castle Rock Enterprises ADDRESS 241 Leota St BLOCK LOT 1230

DATES	WATER	SEWER
On at Main June 23, 2023	Depth at P/L: 672.02m (2.8 m)	Depth at P/L: 672.14m (2.7 m)
On at CC	Depth at Main: 671.66m (3.1 m)	Depth at Main: 671.70m (3.2 m)
Frost Plug	Pipe Size: 25 mm/20 mm	Pipe Size: 100 mm
Memo:	Pipe Material: HDPE Insul. ☒ Yes ☐ No	Pipe Material: PVC Insul. Yes ☒ No ☐ Yes
	Length from Main to P/L: 3.63m	Length from Main to P/L: 10.91m
		STORM
	Squirt Test: ☒ Pass ☐ fail	Depth at P/L:
	Frost Protection: ☒ Recirc ☐ Heat Trace	Depth at Main:
	Continuity Test: n/a Pass/Fail	Pipe Size:
	PRV Required: Yes ☒ No ☐	Pipe Material:
		Length from Main to P/L:

CLEARLY INDICATE LOCATION OF CC AND ROUTE OF PIPES ON DRAWING BELOW

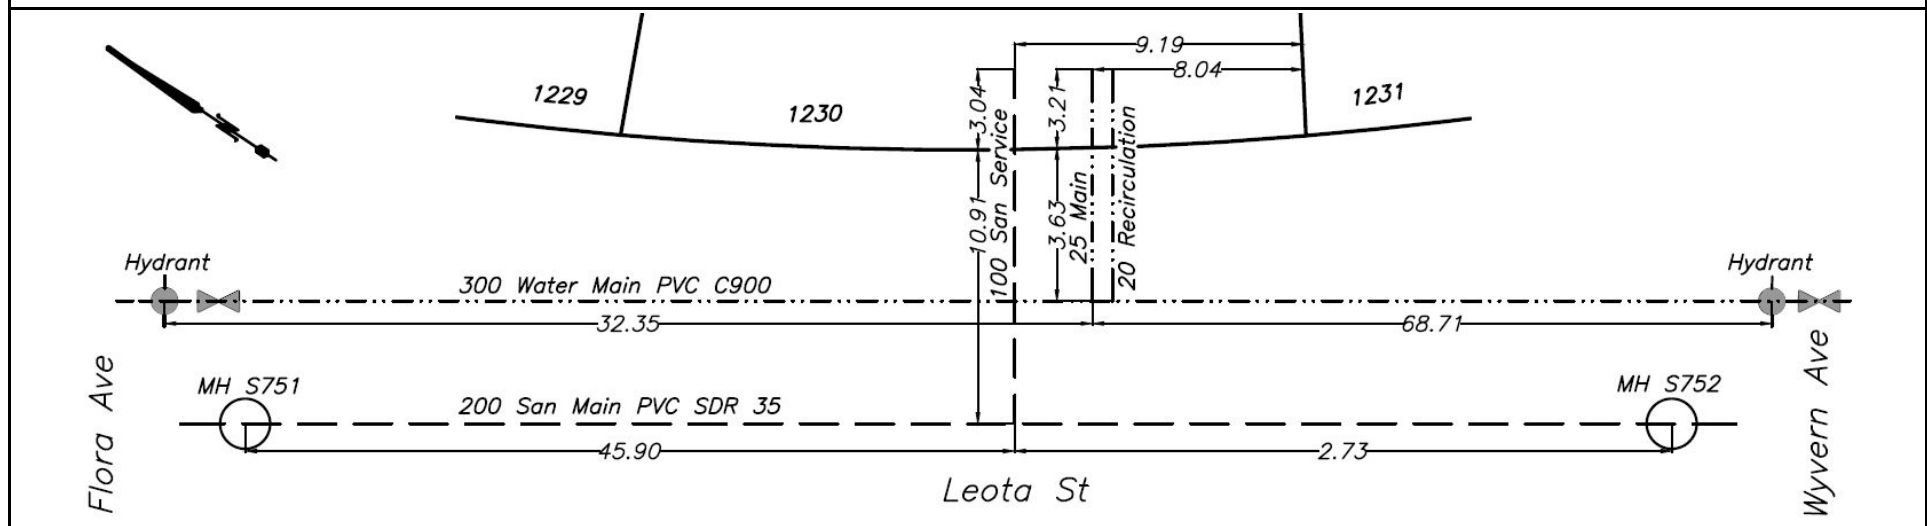




CITY OF WHITEHORSE

SERVICE CONNECTION RECORD

NAME Castle Rock Enterprises ADDRESS 239 Leota St BLOCK LOT 1231

DATES	WATER	SEWER
On at Main June 27, 2023	Depth at P/L: 672.34m (2.6 m)	Depth at P/L: 672.28m (2.7 m)
On at CC	Depth at Main: 671.93m (3.0 m)	Depth at Main: 671.83m (3.3 m)
Frost Plug	Pipe Size: 25 mm/20 mm	Pipe Size: 100 mm
Memo:	Pipe Material: HDPE Insul. ☒ Yes ☐ No	Pipe Material: PVC Insul. Yes ☒ No ☐ Yes
	Length from Main to P/L: 3.69m	Length from Main to P/L: 10.93m
		STORM
	Squirt Test: ☒ Pass ☐ fail	Depth at P/L:
	Frost Protection: ☒ Recirc ☐ Heat Trace	Depth at Main:
	Continuity Test: n/a Pass/Fail	Pipe Size:
	PRV Required: Yes ☒ No ☐ Yes	Pipe Material:
		Length from Main to P/L:

CLEARLY INDICATE LOCATION OF CC AND ROUTE OF PIPES ON DRAWING BELOW

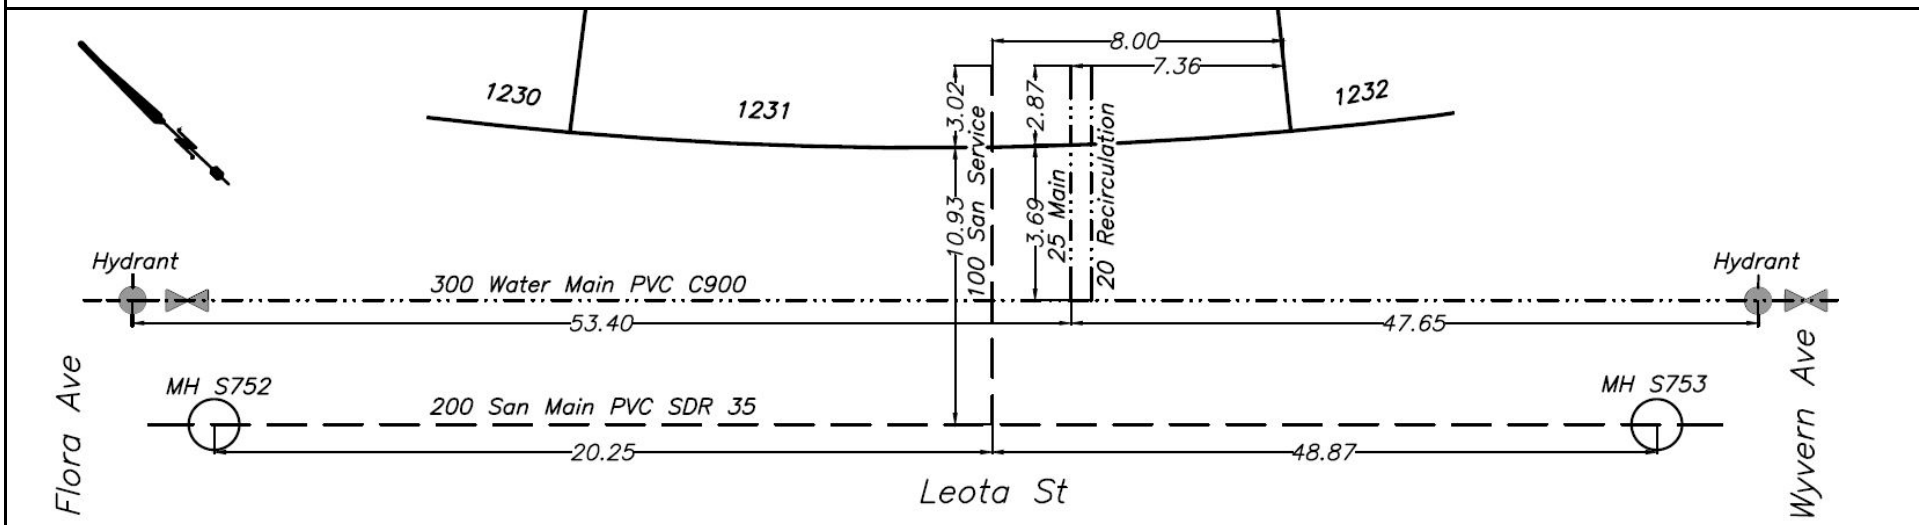




CITY OF WHITEHORSE

SERVICE CONNECTION RECORD

NAME Castle Rock Enterprises ADDRESS 237 Leota St BLOCK LOT 1232

DATES	WATER	SEWER
On at Main June 23, 2023	Depth at P/L: 672.49m (2.6 m)	Depth at P/L: 672.57m (2.5 m)
On at CC	Depth at Main: 672.16m (2.9 m)	Depth at Main: 671.95m (3.3 m)
Frost Plug	Pipe Size: 25 mm/20 mm	Pipe Size: 100 mm
Memo:	Pipe Material: HDPE Insul. ☒ Yes ☐ No	Pipe Material: PVC Insul. Yes ☒ No ☐ Yes
	Length from Main to P/L: 3.73m	Length from Main to P/L: 10.95m
		STORM
	Squirt Test: ☒ Pass ☐ fail	Depth at P/L:
	Frost Protection: ☒ Recirc ☐ Heat Trace	Depth at Main:
	Continuity Test: n/a Pass/Fail	Pipe Size:
	PRV Required: Yes ☒ No ☐ Yes	Pipe Material:
		Length from Main to P/L:

CLEARLY INDICATE LOCATION OF CC AND ROUTE OF PIPES ON DRAWING BELOW

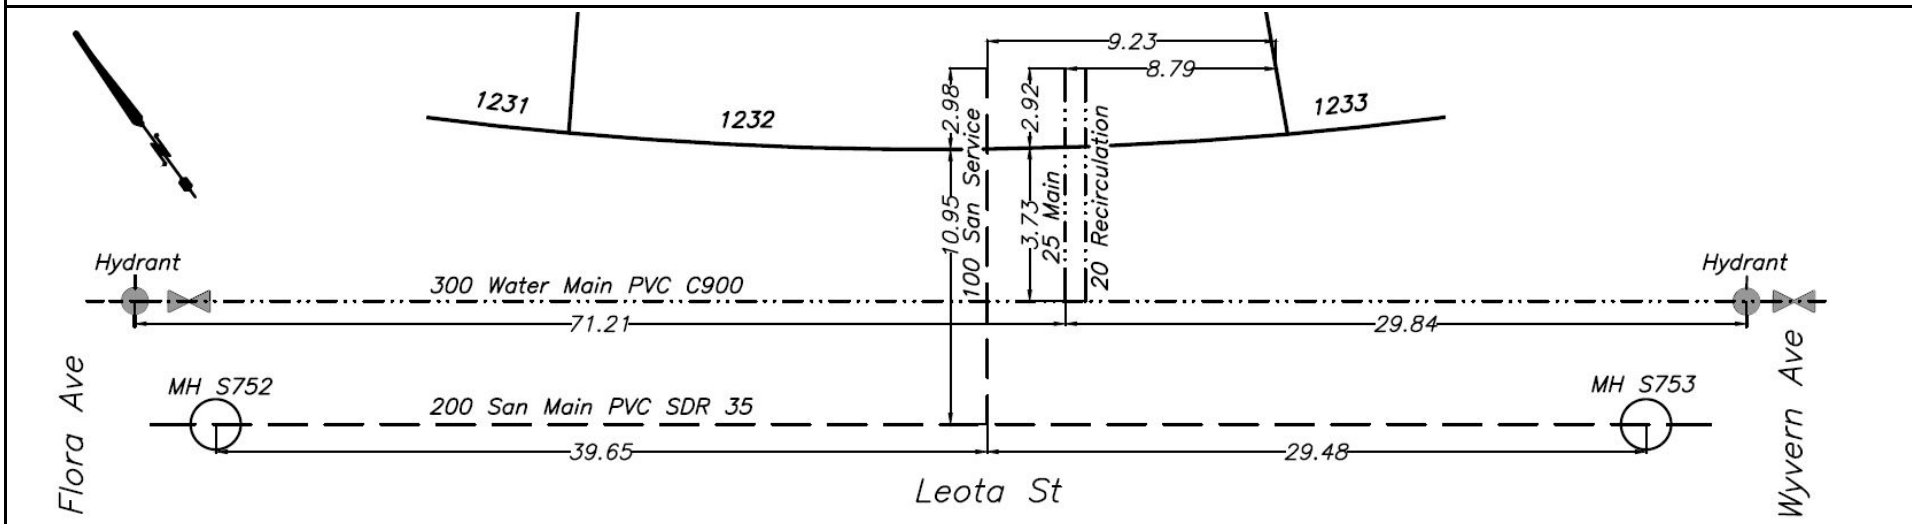




CITY OF WHITEHORSE

SERVICE CONNECTION RECORD

NAME Castle Rock Enterprises ADDRESS 235 Leota St BLOCK LOT 1233

DATES	WATER	SEWER
On at Main June 27, 2023	Depth at P/L: 672.78m (2.5 m)	Depth at P/L: 672.78m (2.5 m)
On at CC	Depth at Main: 672.55m (2.6 m)	Depth at Main: 672.07m (3.3 m)
Frost Plug	Pipe Size: 25 mm/20 mm	Pipe Size: 100 mm
Memo:	Pipe Material: HDPE Insul. ☒ Yes ☐ No	Pipe Material: PVC Insul. Yes ☐ No ☒
	Length from Main to P/L: 3.66m	Length from Main to P/L: 11.07m
		STORM
	Squirt Test: ☒ Pass ☐ fail	Depth at P/L:
	Frost Protection: ☒ Recirc ☐ Heat Trace	Depth at Main:
	Continuity Test: n/a Pass/Fail	Pipe Size:
	PRV Required: Yes ☐ No ☒	Pipe Material:
		Length from Main to P/L:

CLEARLY INDICATE LOCATION OF CC AND ROUTE OF PIPES ON DRAWING BELOW

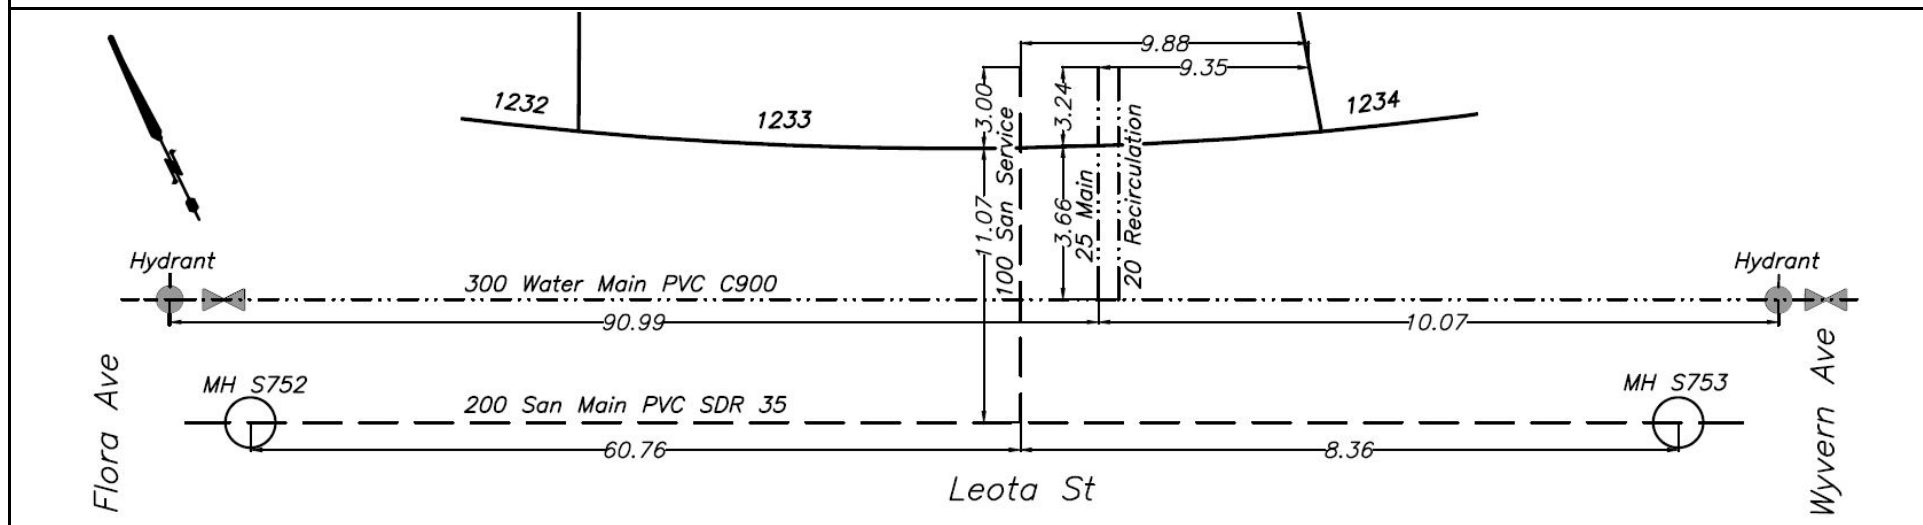




CITY OF WHITEHORSE

SERVICE CONNECTION RECORD

NAME Castle Rock Enterprises ADDRESS 233 Leota St BLOCK LOT 1234

DATES	WATER		SEWER
On at Main July 4, 2023	Depth at P/L: 673.43m (2.0 m)		Depth at P/L: 673.57m (1.9 m)
On at CC	Depth at Main: 672.66m (2.7 m)		Depth at Main: 673.19m (2.3 m)
Frost Plug	Pipe Size: 25 mm/20 mm		Pipe Size: 100 mm
Memo:	Pipe Material: HDPE	Insul. <u>Yes</u> /No	Pipe Material: PVC
	Length from Main to P/L: 3.71m		Length from Main to P/L: 10.97m
			STORM
	Squirt Test: <u>Pass</u> /fail		Depth at P/L:
	Frost Protection: <u>Recirc</u> /Heat Trace		Depth at Main:
	Continuity Test: n/a		Pipe Size:
	PRV Required: Yes/ <u>No</u>		Pipe Material:
			Length from Main to P/L:

CLEARLY INDICATE LOCATION OF CC AND ROUTE OF PIPES ON DRAWING BELOW

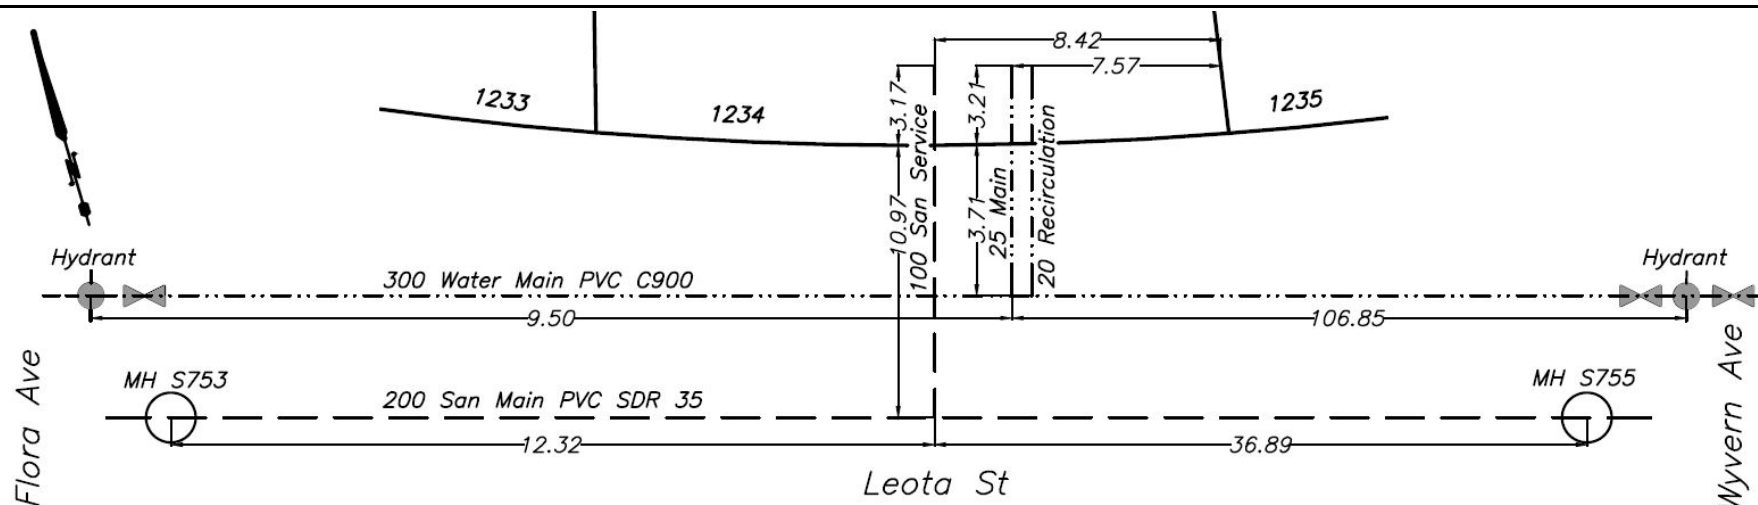




CITY OF WHITEHORSE

SERVICE CONNECTION RECORD

NAME Castle Rock Enterprises ADDRESS 231 Leota St BLOCK LOT 1235

DATES	WATER		SEWER
On at Main June 24, 2023	Depth at P/L: 673.29m (2.3 m)		Depth at P/L: 673.52m (2.1 m)
On at CC	Depth at Main: 672.76m (2.7 m)		Depth at Main: 673.13m (2.5 m)
Frost Plug	Pipe Size: 25 mm/20 mm		Pipe Size: 100 mm
Memo:	Pipe Material: HDPE	Insul. ☒ Yes ☐ No	Pipe Material: PVC
	Length from Main to P/L: 3.60m		Length from Main to P/L: 10.98m
			STORM
	Squirt Test: ☒ Pass ☐ fail		Depth at P/L:
	Frost Protection: ☒ Recirc ☐ Heat Trace		Depth at Main:
	Continuity Test: n/a		Pipe Size:
	PRV Required: Yes ☒ No ☐		Pipe Material:
			Length from Main to P/L:

CLEARLY INDICATE LOCATION OF CC AND ROUTE OF PIPES ON DRAWING BELOW

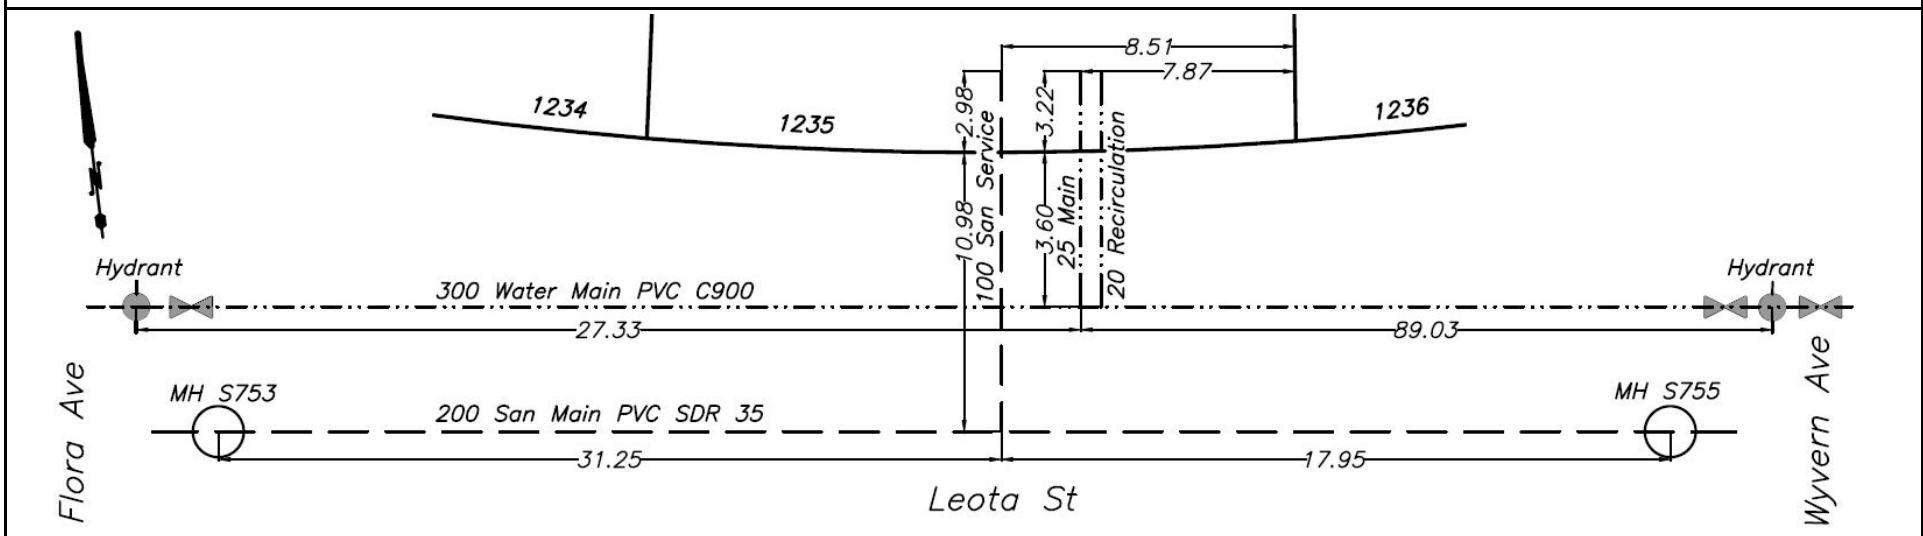




CITY OF WHITEHORSE

SERVICE CONNECTION RECORD

NAME Castle Rock Enterprises ADDRESS 229 Leota St BLOCK LOT 1236

DATES	WATER	SEWER
On at Main June 24, 2023	Depth at P/L: 673.39m (2.4 m)	Depth at P/L: 673.47m (2.3 m)
On at CC	Depth at Main: 672.85m (2.8 m)	Depth at Main: 673.20m (2.6 m)
Frost Plug	Pipe Size: 25 mm/20 mm	Pipe Size: 100 mm
Memo:	Pipe Material: HDPE Insul. ☒ Yes ☐ No	Pipe Material: PVC Insul. Yes ☒ No ☐ Yes
	Length from Main to P/L: 3.59m	Length from Main to P/L: 11.01m
		STORM
	Squirt Test: ☒ Pass ☐ fail	Depth at P/L:
	Frost Protection: ☒ Recirc ☐ Heat Trace	Depth at Main:
	Continuity Test: n/a Pass/Fail	Pipe Size:
	PRV Required: Yes ☒ No ☐ Yes	Pipe Material:
		Length from Main to P/L:

CLEARLY INDICATE LOCATION OF CC AND ROUTE OF PIPES ON DRAWING BELOW

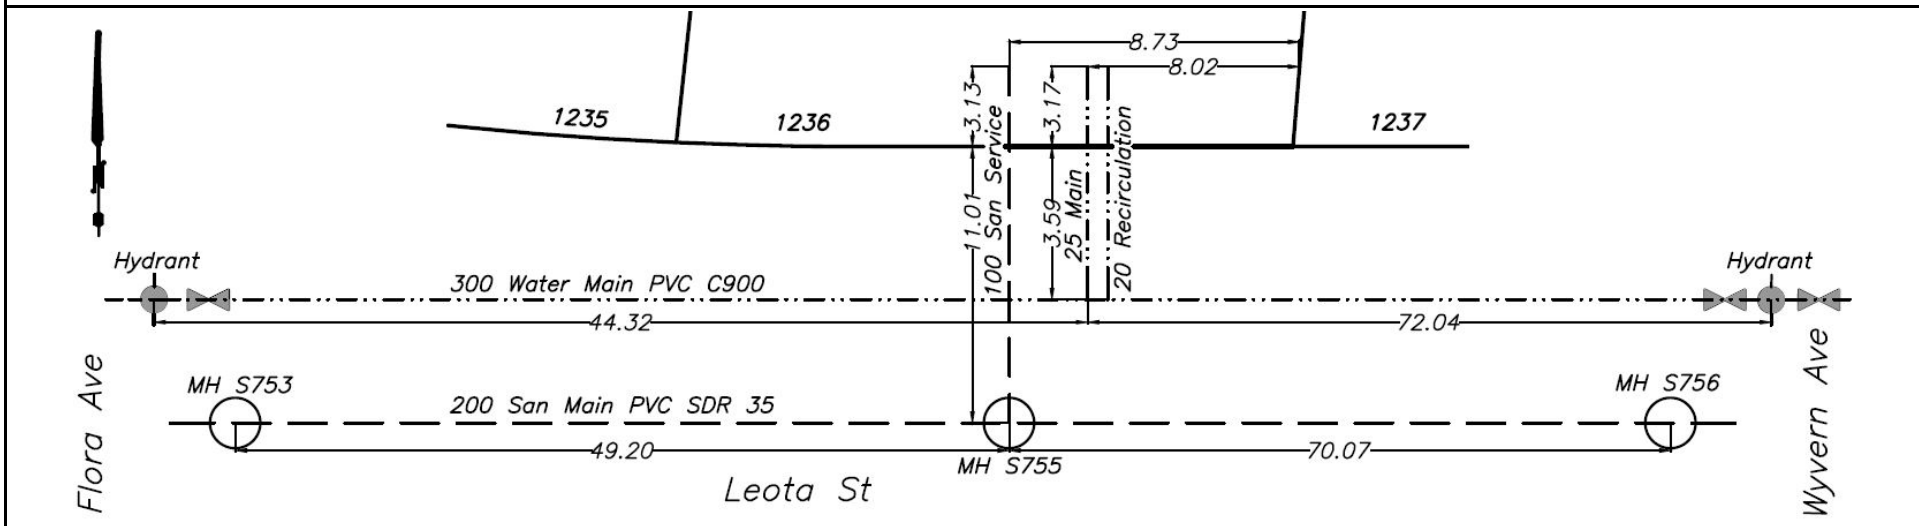




CITY OF WHITEHORSE

SERVICE CONNECTION RECORD

NAME Castle Rock Enterprises ADDRESS 227 Leota St BLOCK LOT 1237

DATES	WATER	SEWER
On at Main June 27, 2023	Depth at P/L: 673.37m (2.5 m)	Depth at P/L: 673.35m (2.6 m)
On at CC	Depth at Main: 672.91m (2.9 m)	Depth at Main: 672.88m (3.0 m)
Frost Plug	Pipe Size: 25 mm/20 mm	Pipe Size: 100 mm
Memo:	Pipe Material: HDPE Insul. ☒ Yes ☐ No	Pipe Material: PVC Insul. Yes ☒ No ☐ Yes
	Length from Main to P/L: 3.54m	Length from Main to P/L: 11.03m
		STORM
	Squirt Test: ☒ Pass ☐ fail	Depth at P/L:
	Frost Protection: ☒ Recirc ☐ Heat Trace	Depth at Main:
	Continuity Test: n/a Pass/Fail	Pipe Size:
	PRV Required: Yes ☒ No ☐ Yes	Pipe Material:
		Length from Main to P/L:

CLEARLY INDICATE LOCATION OF CC AND ROUTE OF PIPES ON DRAWING BELOW

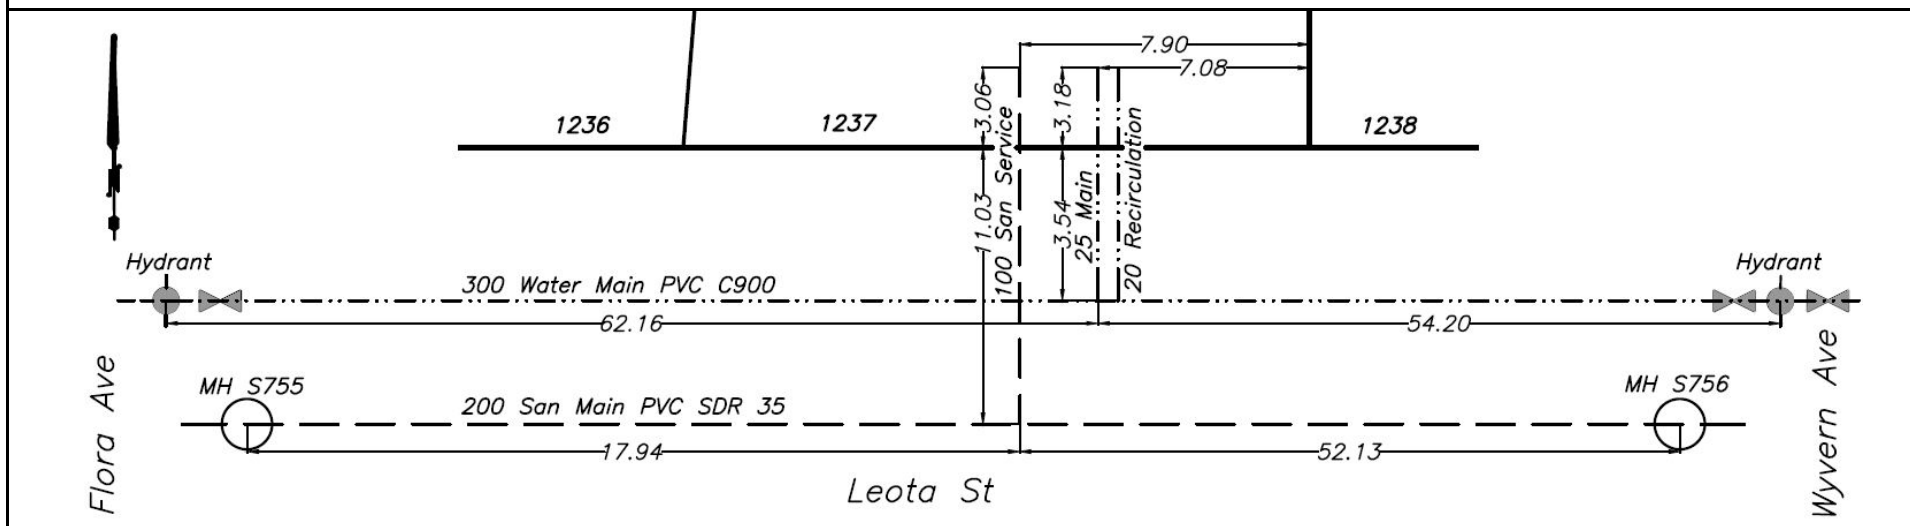




CITY OF WHITEHORSE

SERVICE CONNECTION RECORD

NAME Castle Rock Enterprises ADDRESS 225 Leota St BLOCK LOT 1238

DATES	WATER	SEWER
On at Main June 22, 2023	Depth at P/L: 673.60m (2.4 m)	Depth at P/L: 673.58m (2.4 m)
On at CC	Depth at Main: 673.03m (2.9 m)	Depth at Main: 672.81m (3.2 m)
Frost Plug	Pipe Size: 25 mm/20 mm	Pipe Size: 100 mm
Memo:	Pipe Material: HDPE Insul. ☒ Yes ☐ No	Pipe Material: PVC Insul. Yes ☒ No ☐ Yes
	Length from Main to P/L: 3.55m	Length from Main to P/L: 11.09m
		STORM
	Squirt Test: ☒ Pass ☐ fail	Depth at P/L:
	Frost Protection: ☒ Recirc ☐ Heat Trace	Depth at Main:
	Continuity Test: n/a	Pipe Size:
	PRV Required: Yes ☒ No ☐	Pipe Material:
		Length from Main to P/L:

CLEARLY INDICATE LOCATION OF CC AND ROUTE OF PIPES ON DRAWING BELOW

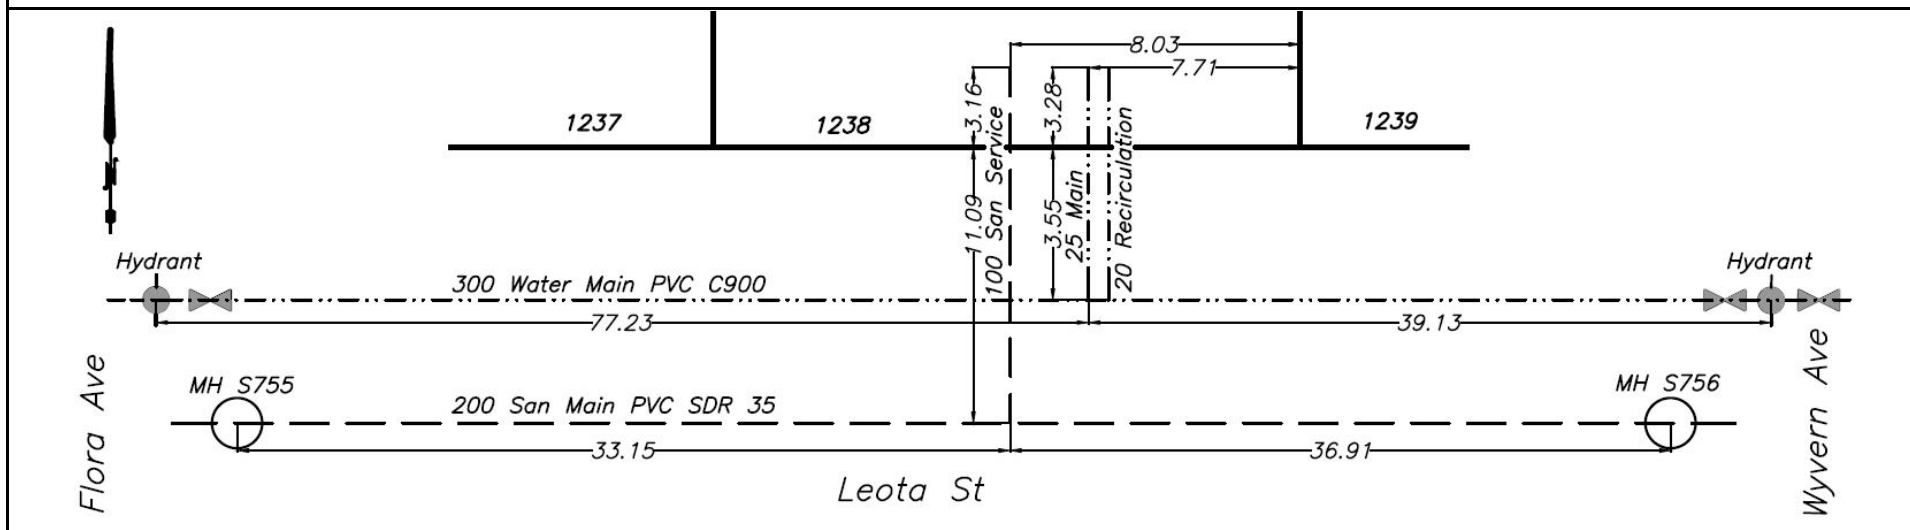




CITY OF WHITEHORSE

SERVICE CONNECTION RECORD

NAME Castle Rock Enterprises ADDRESS 223 Leota St BLOCK LOT 1239

DATES	WATER	SEWER
On at Main June 24, 2023	Depth at P/L: 673.44m (2.7 m)	Depth at P/L: 673.52m (2.6 m)
On at CC	Depth at Main: 673.22m (2.8 m)	Depth at Main: 672.75m (3.4 m)
Frost Plug	Pipe Size: 25 mm/20 mm	Pipe Size: 100 mm
Memo:	Pipe Material: HDPE Insul. ☒ Yes ☐ No	Pipe Material: PVC Insul. Yes ☒ No ☐ Yes
	Length from Main to P/L: 3.51m	Length from Main to P/L: 11.00m
		STORM
	Squirt Test: ☒ Pass ☐ fail	Depth at P/L:
	Frost Protection: ☒ Recirc ☐ Heat Trace	Depth at Main:
	Continuity Test: n/a Pass/Fail	Pipe Size:
	PRV Required: Yes ☒ No ☐ Yes	Pipe Material:
		Length from Main to P/L:

CLEARLY INDICATE LOCATION OF CC AND ROUTE OF PIPES ON DRAWING BELOW

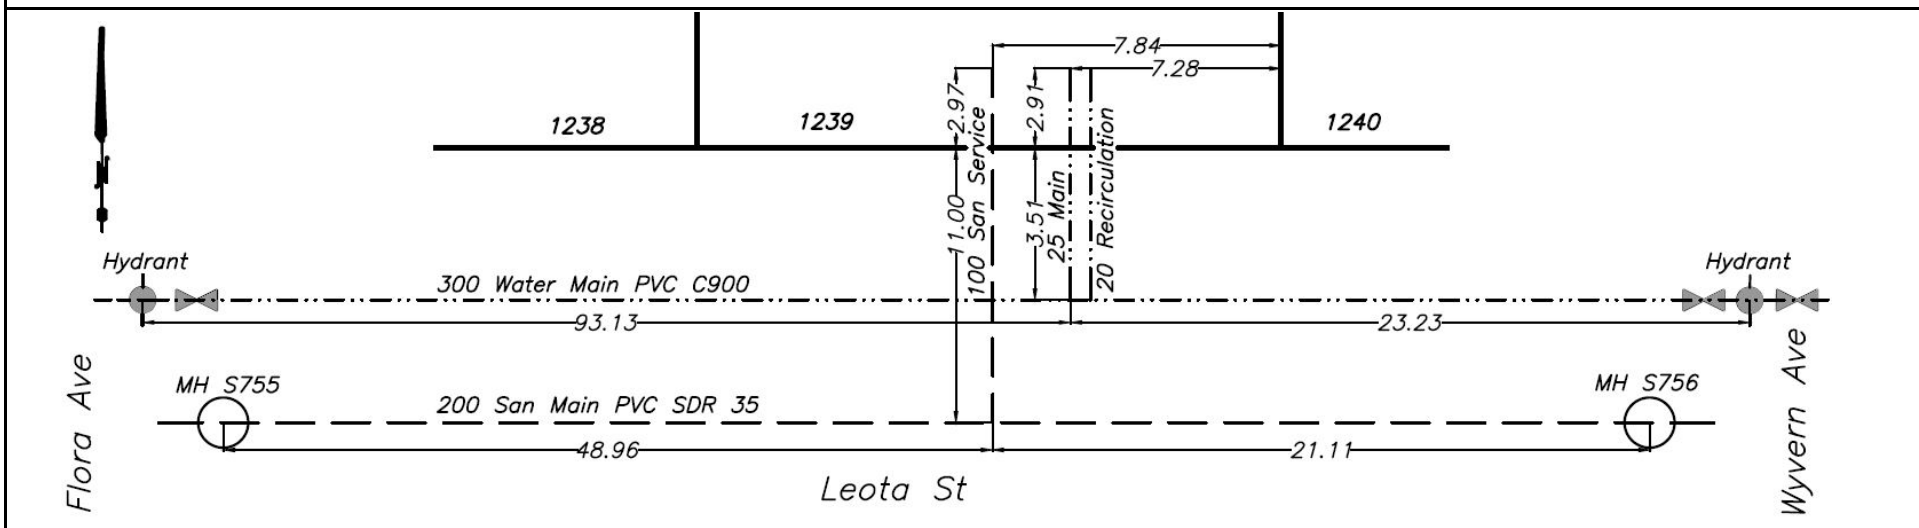




CITY OF WHITEHORSE

SERVICE CONNECTION RECORD

NAME Castle Rock Enterprises ADDRESS 221 Leota St BLOCK LOT 1240

DATES	WATER	SEWER
On at Main June 22, 2023	Depth at P/L: 673.65m (2.6 m)	Depth at P/L: 673.64m (2.6 m)
On at CC	Depth at Main: 673.36m (2.8 m)	Depth at Main: 672.64m (3.6 m)
Frost Plug	Pipe Size: 25 mm/20 mm	Pipe Size: 100 mm
Memo:	Pipe Material: HDPE Insul. ☒ Yes ☐ No	Pipe Material: PVC Insul. Yes ☒ No ☐ Yes
	Length from Main to P/L: 3.54m	Length from Main to P/L: 10.90m
		STORM
	Squirt Test: ☒ Pass ☐ fail	Depth at P/L:
	Frost Protection: ☒ Recirc ☐ Heat Trace	Depth at Main:
	Continuity Test: n/a Pass/Fail	Pipe Size:
	PRV Required: Yes ☒ No ☐ Yes	Pipe Material:
		Length from Main to P/L:

CLEARLY INDICATE LOCATION OF CC AND ROUTE OF PIPES ON DRAWING BELOW

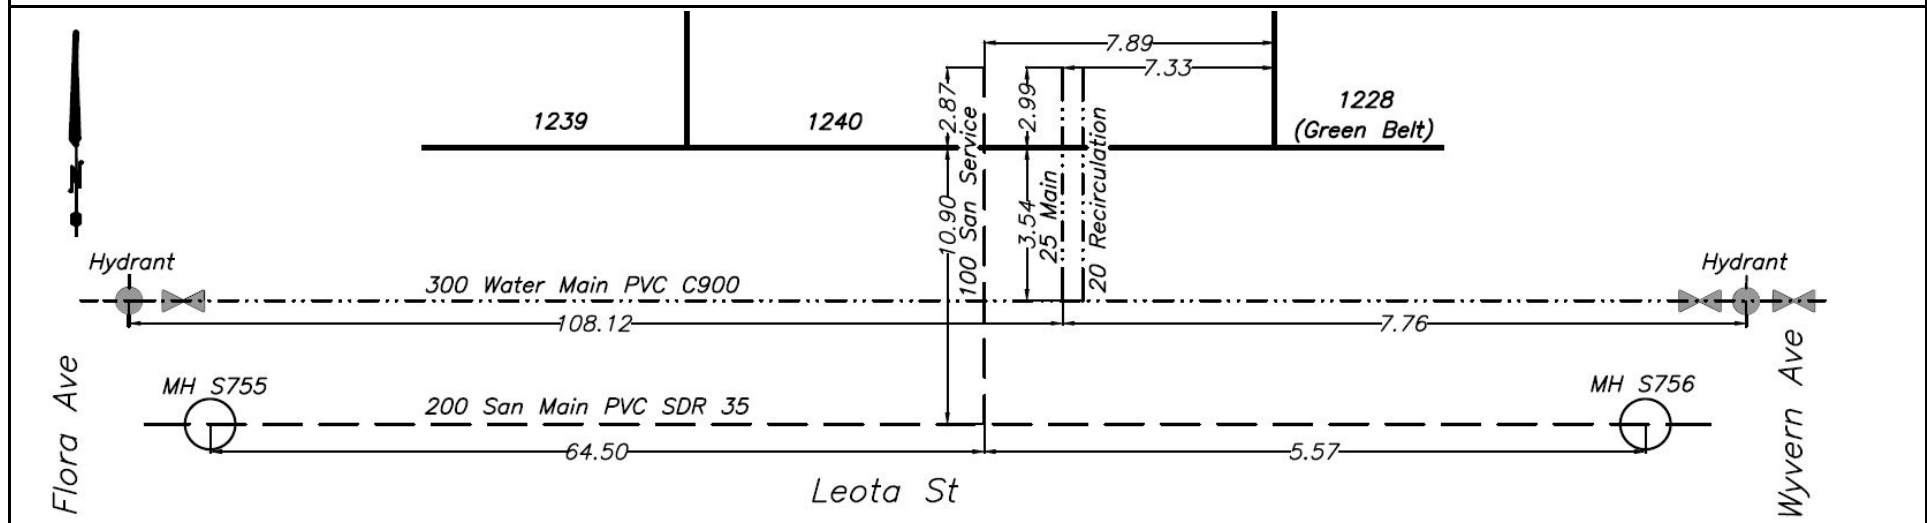




CITY OF WHITEHORSE

SERVICE CONNECTION RECORD

NAME Castle Rock Enterprises ADDRESS 215 Leota St BLOCK LOT 1241

DATES	WATER	SEWER
On at Main July 6, 2023	Depth at P/L: 673.79m (2.6 m)	Depth at P/L: 673.74m (2.6 m)
On at CC	Depth at Main: 673.16m (3.1 m)	Depth at Main: 672.47m (3.9 m)
Frost Plug	Pipe Size: 25 mm/20 mm	Pipe Size: 100 mm
Memo:	Pipe Material: HDPE Insul. ☒ Yes ☐ No	Pipe Material: PVC Insul. Yes ☒ No ☐ Yes
	Length from Main to P/L: 4.20m	Length from Main to P/L: 11.97m
		STORM
	Squirt Test: ☒ Pass ☐ fail	Depth at P/L:
	Frost Protection: ☒ Recirc ☐ Heat Trace	Depth at Main:
	Continuity Test: n/a Pass/Fail	Pipe Size:
	PRV Required: Yes ☒ No ☐ Yes	Pipe Material:
		Length from Main to P/L:

CLEARLY INDICATE LOCATION OF CC AND ROUTE OF PIPES ON DRAWING BELOW

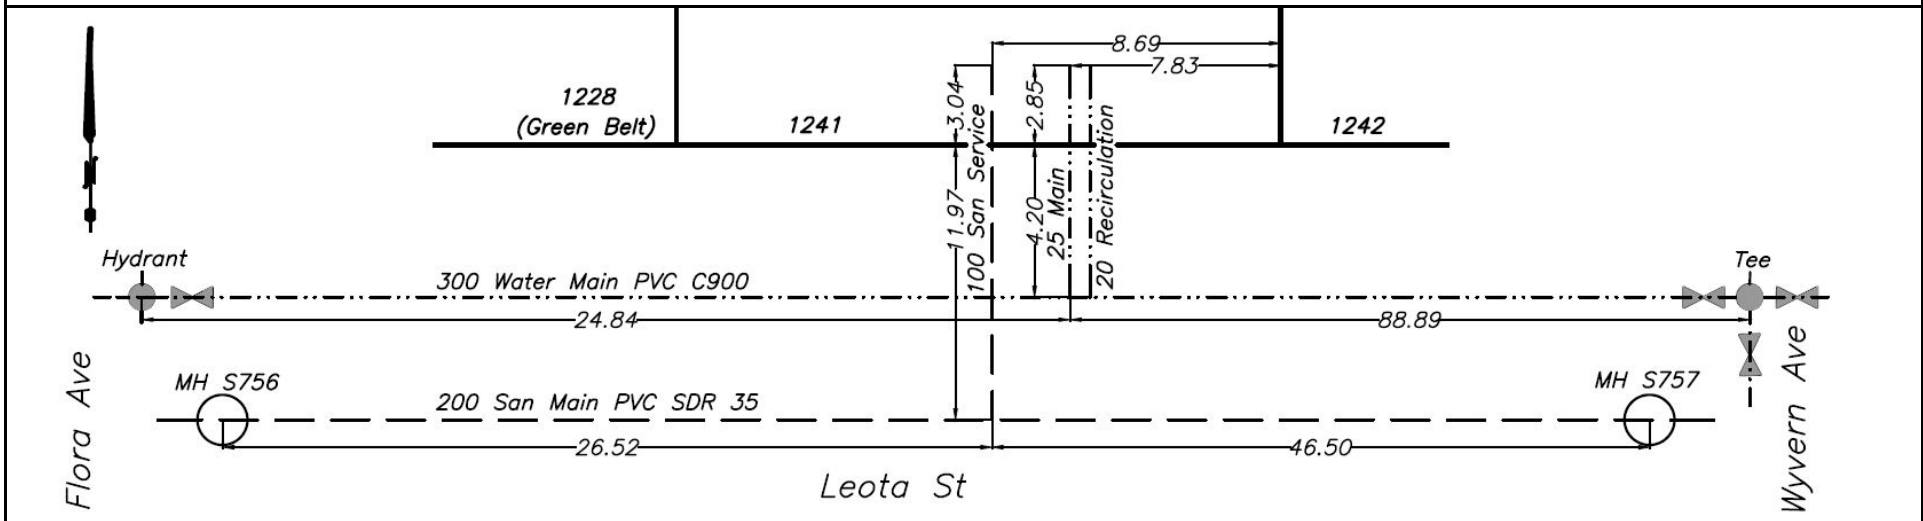




CITY OF WHITEHORSE

SERVICE CONNECTION RECORD

NAME Castle Rock Enterprises ADDRESS 213 Leota St BLOCK LOT 1242

DATES	WATER	SEWER
On at Main July 6, 2023	Depth at P/L: 673.84m (2.5 m)	Depth at P/L: 673.79m (2.6 m)
On at CC	Depth at Main: 673.02m (3.3 m)	Depth at Main: 672.39m (3.9 m)
Frost Plug	Pipe Size: 25 mm/20 mm	Pipe Size: 100 mm
Memo:	Pipe Material: HDPE Insul. ☒ Yes ☐ No	Pipe Material: PVC Insul. Yes ☒ No ☐ Yes
	Length from Main to P/L: 5.32m	Length from Main to P/L: 12.53m
		STORM
	Squirt Test: ☒ Pass ☐ fail	Depth at P/L:
	Frost Protection: ☒ Recirc ☐ Heat Trace	Depth at Main:
	Continuity Test: n/a Pass/Fail	Pipe Size:
	PRV Required: Yes ☒ No ☐ Yes	Pipe Material:
		Length from Main to P/L:

CLEARLY INDICATE LOCATION OF CC AND ROUTE OF PIPES ON DRAWING BELOW

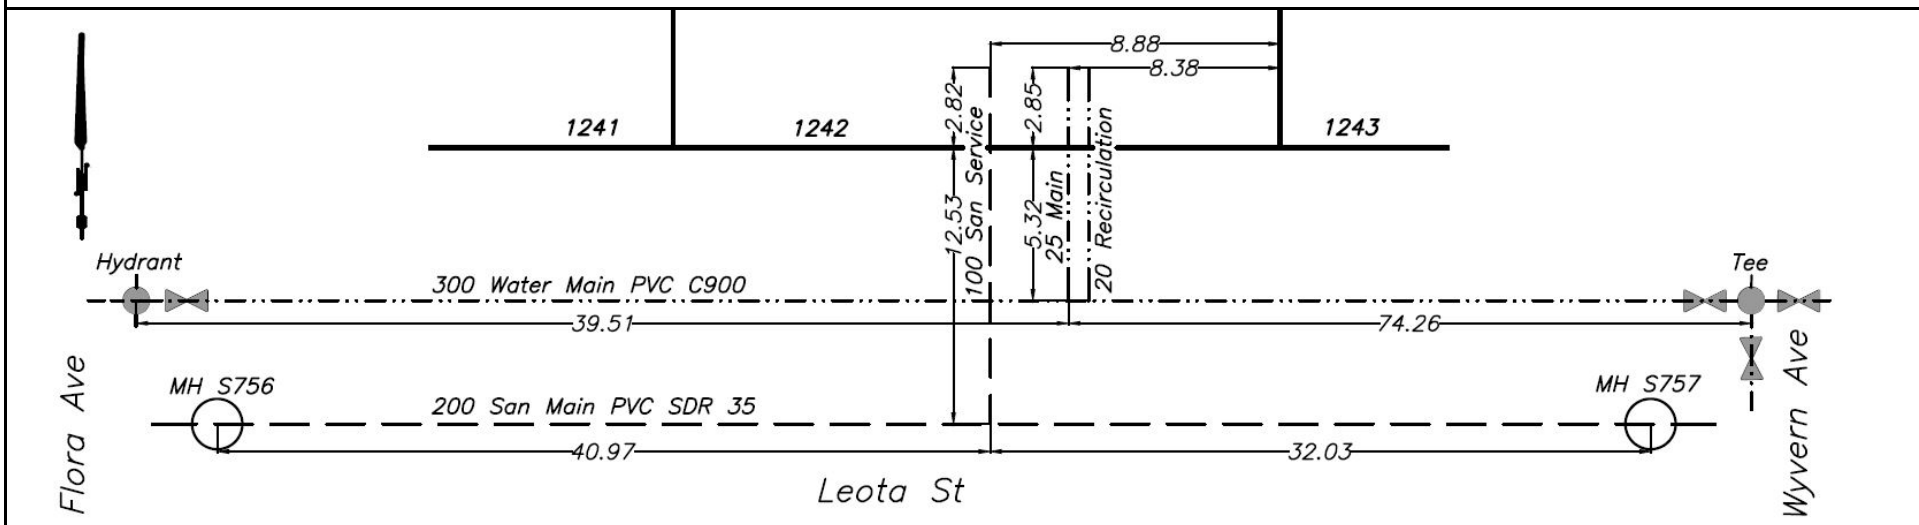




CITY OF WHITEHORSE

SERVICE CONNECTION RECORD

NAME Castle Rock Enterprises ADDRESS 211 Leota St BLOCK LOT 1243

DATES	WATER	SEWER
On at Main July 6, 2023	Depth at P/L: 673.59m (2.7 m)	Depth at P/L: 673.54m (2.7 m)
On at CC	Depth at Main: 672.80m (3.4 m)	Depth at Main: 672.31m (3.9 m)
Frost Plug	Pipe Size: 25 mm/20 mm	Pipe Size: 100 mm
Memo:	Pipe Material: HDPE Insul. <u>Yes</u> /No	Pipe Material: PVC Insul. Yes/ <u>No</u>
	Length from Main to P/L: 7.14m	Length from Main to P/L: 13.01m
		STORM
	Squirt Test: <u>Pass</u> /fail	Depth at P/L:
	Frost Protection: <u>Recirc</u> Heat Trace	Depth at Main:
	Continuity Test: n/a Pass/Fail	Pipe Size:
	PRV Required: Yes/ <u>No</u>	Pipe Material:
		Length from Main to P/L:

CLEARLY INDICATE LOCATION OF CC AND ROUTE OF PIPES ON DRAWING BELOW

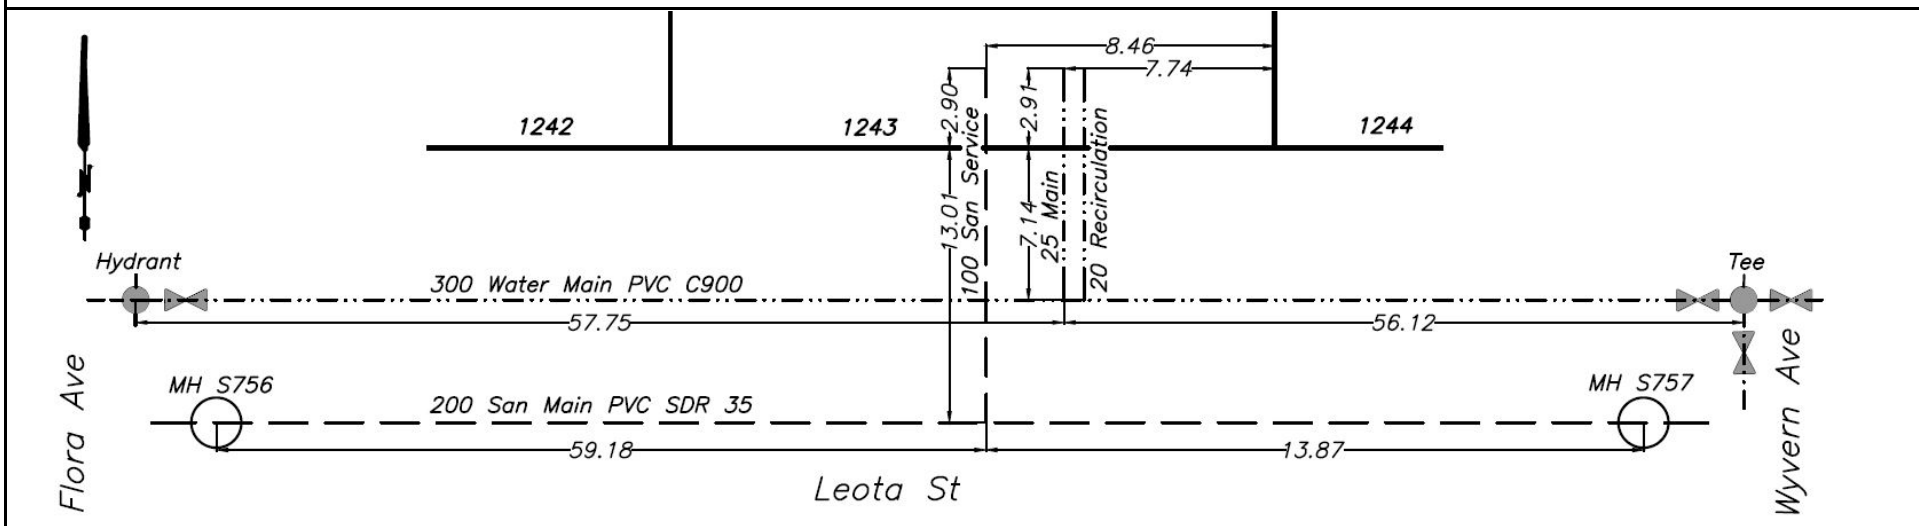




CITY OF WHITEHORSE

SERVICE CONNECTION RECORD

NAME Castle Rock Enterprises ADDRESS 209 Leota St BLOCK LOT 1244

DATES	WATER	SEWER
On at Main July 6, 2023	Depth at P/L: 673.42m (2.7 m)	Depth at P/L: 673.39m (2.7 m)
On at CC	Depth at Main: 672.63m (3.4 m)	Depth at Main: 672.24m (3.8 m)
Frost Plug	Pipe Size: 25 mm/20 mm	Pipe Size: 100 mm
Memo:	Pipe Material: HDPE Insul. ☒ Yes ☐ No	Pipe Material: PVC Insul. Yes ☒ No ☐ Yes
	Length from Main to P/L: 7.06m	Length from Main to P/L: 13.55m
		STORM
	Squirt Test: ☒ Pass ☐ fail	Depth at P/L:
	Frost Protection: ☒ Recirc ☐ Heat Trace	Depth at Main:
	Continuity Test: n/a	Pipe Size:
	PRV Required: Yes ☒ No ☐ Yes	Pipe Material:
		Length from Main to P/L:

CLEARLY INDICATE LOCATION OF CC AND ROUTE OF PIPES ON DRAWING BELOW

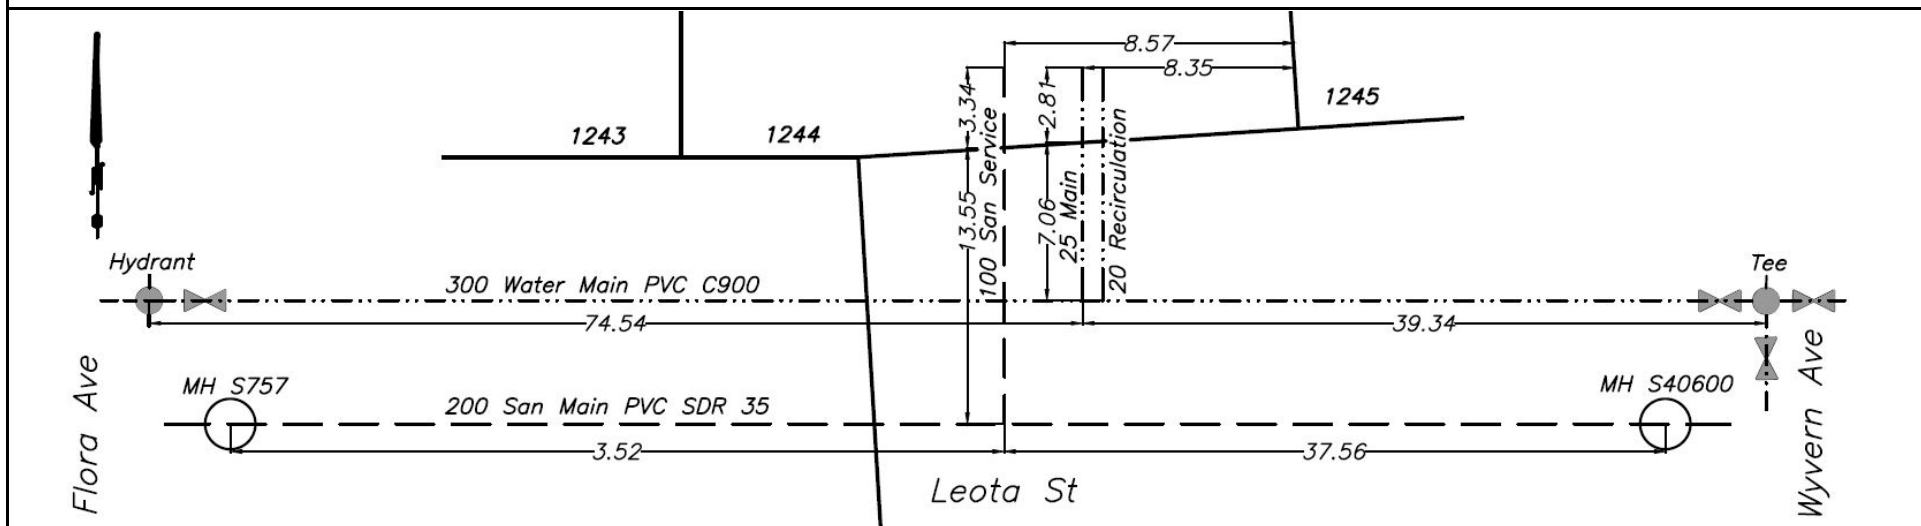




CITY OF WHITEHORSE

SERVICE CONNECTION RECORD

NAME Castle Rock Enterprises ADDRESS 207 Leota St BLOCK LOT 1245

DATES	WATER	SEWER
On at Main August 3, 2023	Depth at P/L: 673.20m (2.7 m)	Depth at P/L: 673.18m (2.7 m)
On at CC	Depth at Main: 672.30m (3.3 m)	Depth at Main: 672.47m (3.4 m)
Frost Plug	Pipe Size: 25 mm/20 mm	Pipe Size: 100 mm
Memo:	Pipe Material: HDPE Insul. ☒ Yes ☐ No	Pipe Material: PVC Insul. Yes ☒ No ☐ Yes
	Length from Main to P/L: 6.98m	Length from Main to P/L: 12.95m
		STORM
	Squirt Test: ☒ Pass ☐ fail	Depth at P/L:
	Frost Protection: ☒ Recirc ☐ Heat Trace	Depth at Main:
	Continuity Test: n/a Pass/Fail	Pipe Size:
	PRV Required: Yes ☒ No ☐ Yes	Pipe Material:
		Length from Main to P/L:

CLEARLY INDICATE LOCATION OF CC AND ROUTE OF PIPES ON DRAWING BELOW

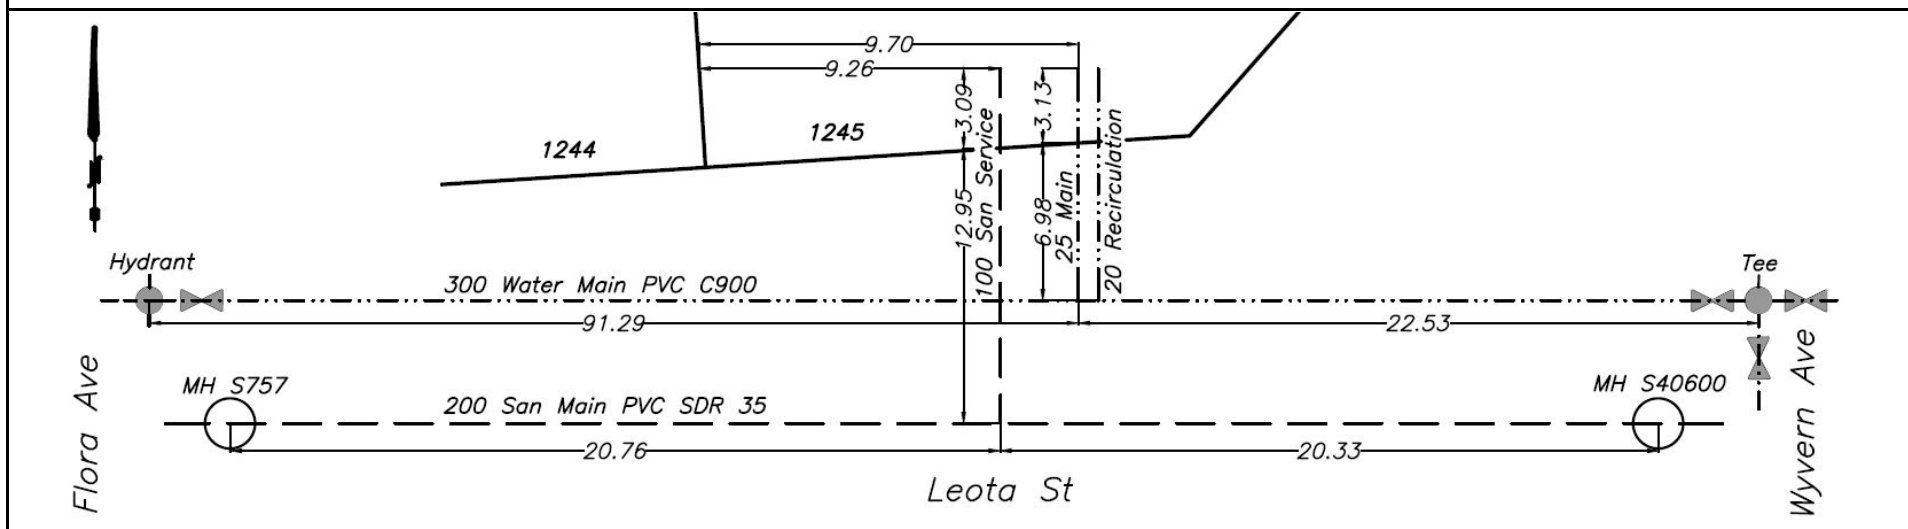




CITY OF WHITEHORSE

SERVICE CONNECTION RECORD

NAME Castle Rock Enterprises ADDRESS 248 Leota St BLOCK LOT 1246

DATES	WATER	SEWER
On at Main June 28, 2023	Depth at P/L: 672.04m (2.6 m)	Depth at P/L: 671.99m (2.7 m)
On at CC	Depth at Main: 671.19m (3.2 m)	Depth at Main: 671.51m (3.1 m)
Frost Plug	Pipe Size: 25 mm/20 mm	Pipe Size: 100 mm
Memo:	Pipe Material: HDPE Insul. ☒ Yes ☐ No	Pipe Material: PVC Insul. Yes ☒ No ☐ Yes
	Length from Main to P/L: 18.34m	Length from Main to P/L: 11.08m
		STORM
	Squirt Test: ☒ Pass ☐ fail	Depth at P/L:
	Frost Protection: ☒ Recirc ☐ Heat Trace	Depth at Main:
	Continuity Test: n/a Pass/Fail	Pipe Size:
	PRV Required: Yes ☒ No ☐	Pipe Material:
		Length from Main to P/L:

CLEARLY INDICATE LOCATION OF CC AND ROUTE OF PIPES ON DRAWING BELOW

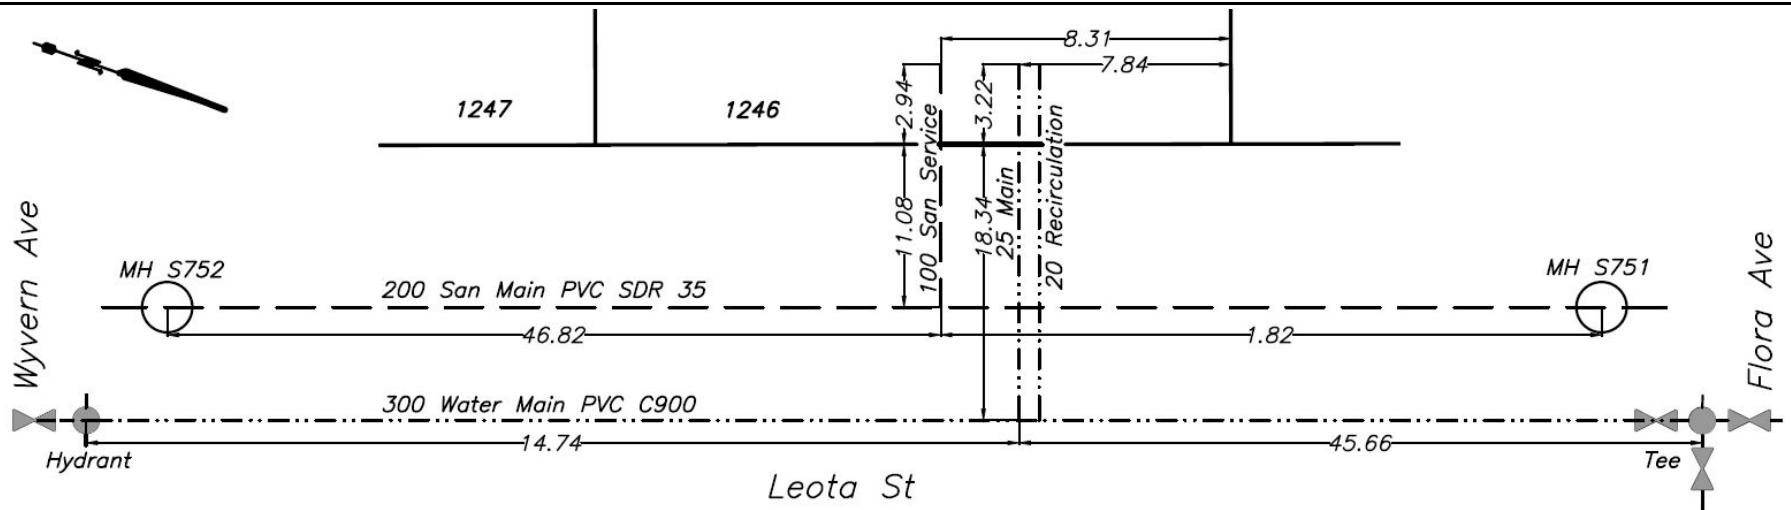




CITY OF WHITEHORSE

SERVICE CONNECTION RECORD

NAME Castle Rock Enterprises ADDRESS 246 Leota St BLOCK LOT 1247

DATES	WATER	SEWER
On at Main June 6, 2023	Depth at P/L: 672.13m (2.9 m)	Depth at P/L: 672.23m (2.8 m)
On at CC	Depth at Main: 671.26m (3.3 m)	Depth at Main: 671.58m (3.1 m)
Frost Plug	Pipe Size: 25 mm/20 mm	Pipe Size: 100 mm
Memo:	Pipe Material: HDPE Insul. ☒ Yes ☐ No	Pipe Material: PVC Insul. Yes ☒ No ☐ Yes
	Length from Main to P/L: 18.54m	Length from Main to P/L: 10.85m
		STORM
	Squirt Test: ☒ Pass ☐ fail	Depth at P/L:
	Frost Protection: ☒ Recirc ☐ Heat Trace	Depth at Main:
	Continuity Test: n/a Pass/Fail	Pipe Size:
	PRV Required: Yes ☒ No ☐ Yes	Pipe Material:
		Length from Main to P/L:

CLEARLY INDICATE LOCATION OF CC AND ROUTE OF PIPES ON DRAWING BELOW

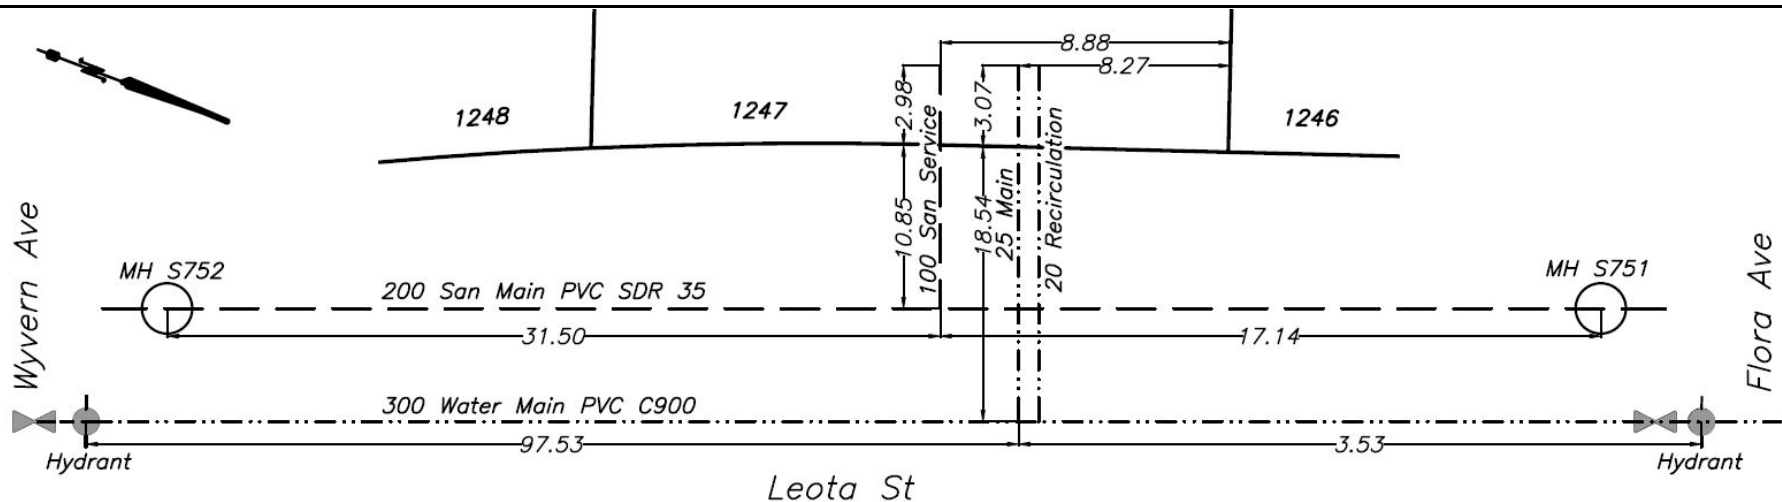




CITY OF WHITEHORSE

SERVICE CONNECTION RECORD

NAME Castle Rock Enterprises ADDRESS 244 Leota St BLOCK LOT 1248

DATES	WATER	SEWER
On at Main June 28, 2023	Depth at P/L: 672.61m (2.6 m)	Depth at P/L: 672.51m (2.7 m)
On at CC	Depth at Main: 671.47m (3.1 m)	Depth at Main: 671.62m (3.2 m)
Frost Plug	Pipe Size: 25 mm/20 mm	Pipe Size: 100 mm
Memo:	Pipe Material: HDPE Insul. ☒ Yes ☐ No	Pipe Material: PVC Insul. Yes ☒ No ☐ Yes
	Length from Main to P/L: 18.40m	Length from Main to P/L: 11.31m
		STORM
	Squirt Test: ☒ Pass ☐ fail	Depth at P/L:
	Frost Protection: ☒ Recirc ☐ Heat Trace	Depth at Main:
	Continuity Test: n/a Pass/Fail	Pipe Size:
	PRV Required: Yes ☒ No ☐ Yes	Pipe Material:
		Length from Main to P/L:

CLEARLY INDICATE LOCATION OF CC AND ROUTE OF PIPES ON DRAWING BELOW

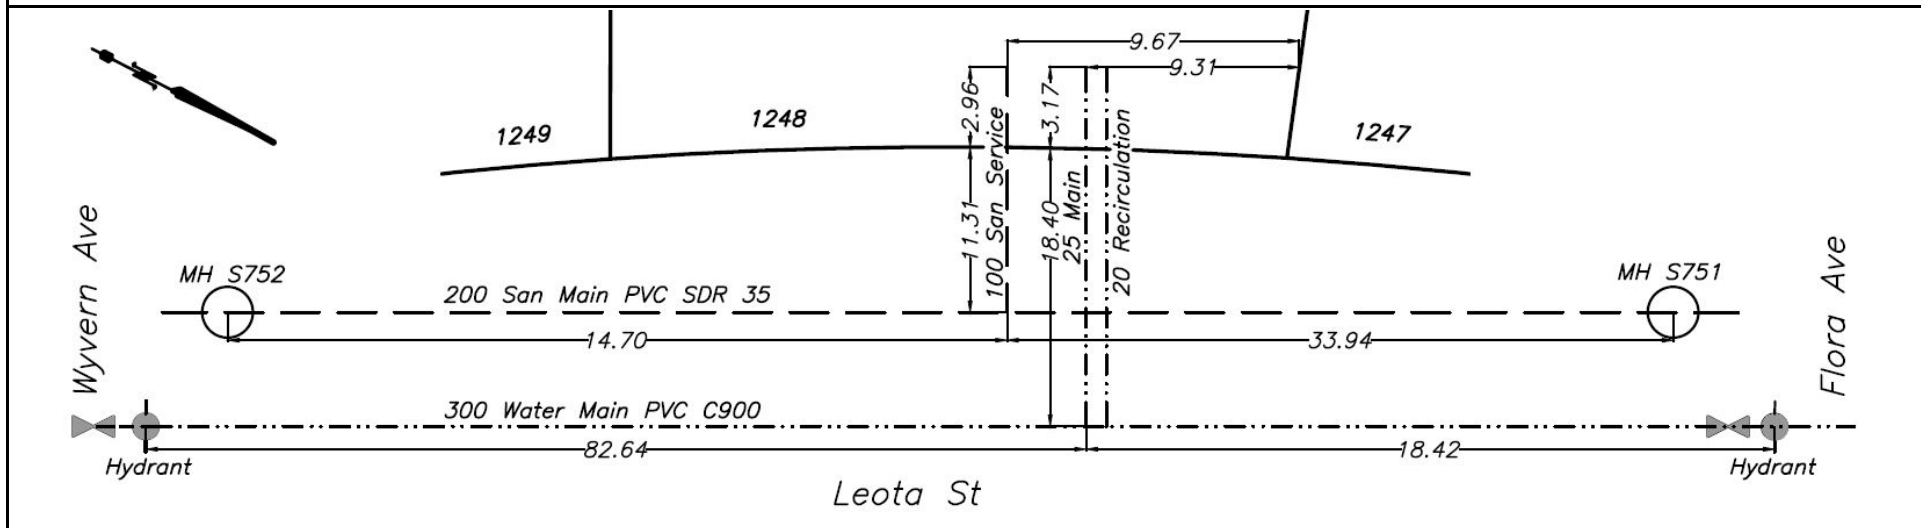




CITY OF WHITEHORSE

SERVICE CONNECTION RECORD

NAME Castle Rock Enterprises ADDRESS 242 Leota St BLOCK LOT 1249

DATES	WATER	SEWER
On at Main June 24, 2023	Depth at P/L: 672.49m (2.8 m)	Depth at P/L: 672.51m (2.8 m)
On at CC	Depth at Main: 671.74m (3.0 m)	Depth at Main: 672.05m (2.9 m)
Frost Plug	Pipe Size: 25 mm/20 mm	Pipe Size: 100 mm
Memo:	Pipe Material: HDPE Insul. ☒ Yes ☐ No	Pipe Material: PVC Insul. Yes ☒ No ☐ Yes
	Length from Main to P/L: 18.50m	Length from Main to P/L: 11.00m
		STORM
	Squirt Test: ☒ Pass ☐ fail	Depth at P/L:
	Frost Protection: ☒ Recirc ☐ Heat Trace	Depth at Main:
	Continuity Test: n/a Pass/Fail	Pipe Size:
	PRV Required: Yes ☒ No ☐ Yes	Pipe Material:
		Length from Main to P/L:

CLEARLY INDICATE LOCATION OF CC AND ROUTE OF PIPES ON DRAWING BELOW

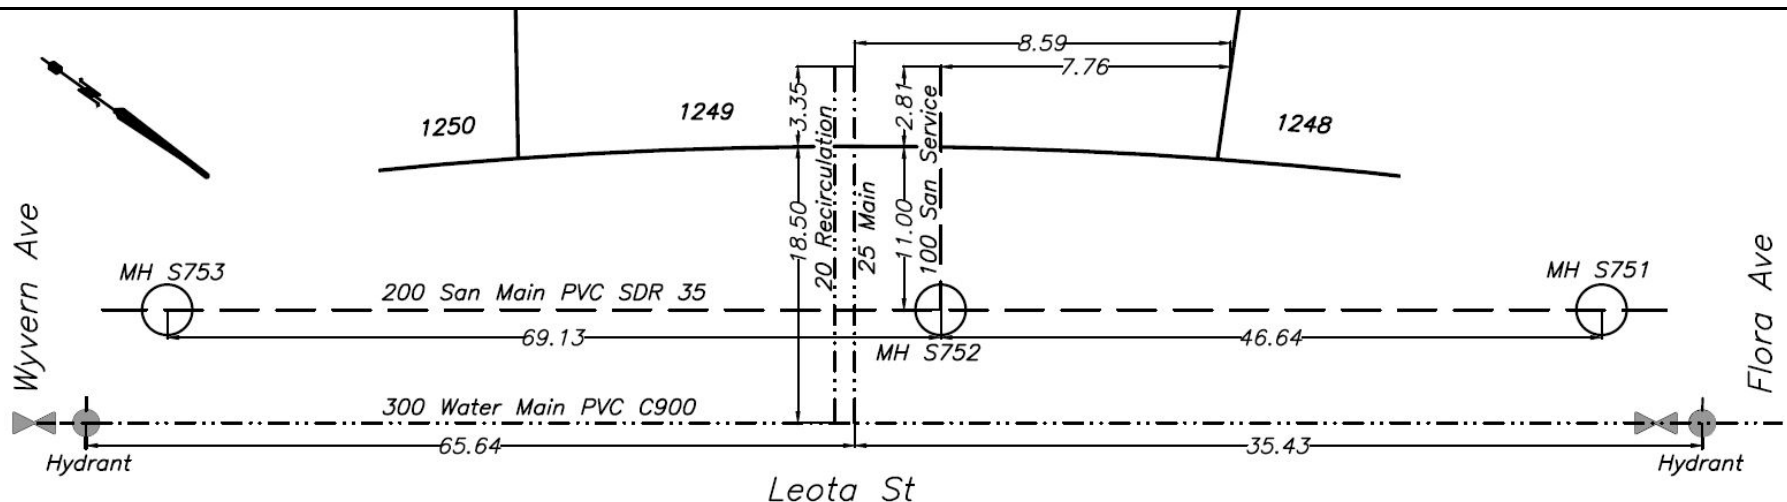




CITY OF WHITEHORSE

SERVICE CONNECTION RECORD

NAME Castle Rock Enterprises ADDRESS 240 Leota St BLOCK LOT 1250

DATES	WATER	SEWER
On at Main June 26, 2023	Depth at P/L: 672.71m (2.7 m)	Depth at P/L: 672.70m (2.7 m)
On at CC	Depth at Main: 671.92m (2.9 m)	Depth at Main: 671.84m (3.2 m)
Frost Plug	Pipe Size: 25 mm/20 mm	Pipe Size: 100 mm
Memo:	Pipe Material: HDPE Insul. ☒ Yes ☐ No	Pipe Material: PVC Insul. Yes ☒ No ☐ Yes
	Length from Main to P/L: 18.31m	Length from Main to P/L: 11.17m
		STORM
	Squirt Test: ☒ Pass ☐ fail	Depth at P/L:
	Frost Protection: ☒ Recirc ☐ Heat Trace	Depth at Main:
	Continuity Test: n/a Pass/Fail	Pipe Size:
	PRV Required: Yes ☒ No ☐ Yes	Pipe Material:
		Length from Main to P/L:

CLEARLY INDICATE LOCATION OF CC AND ROUTE OF PIPES ON DRAWING BELOW

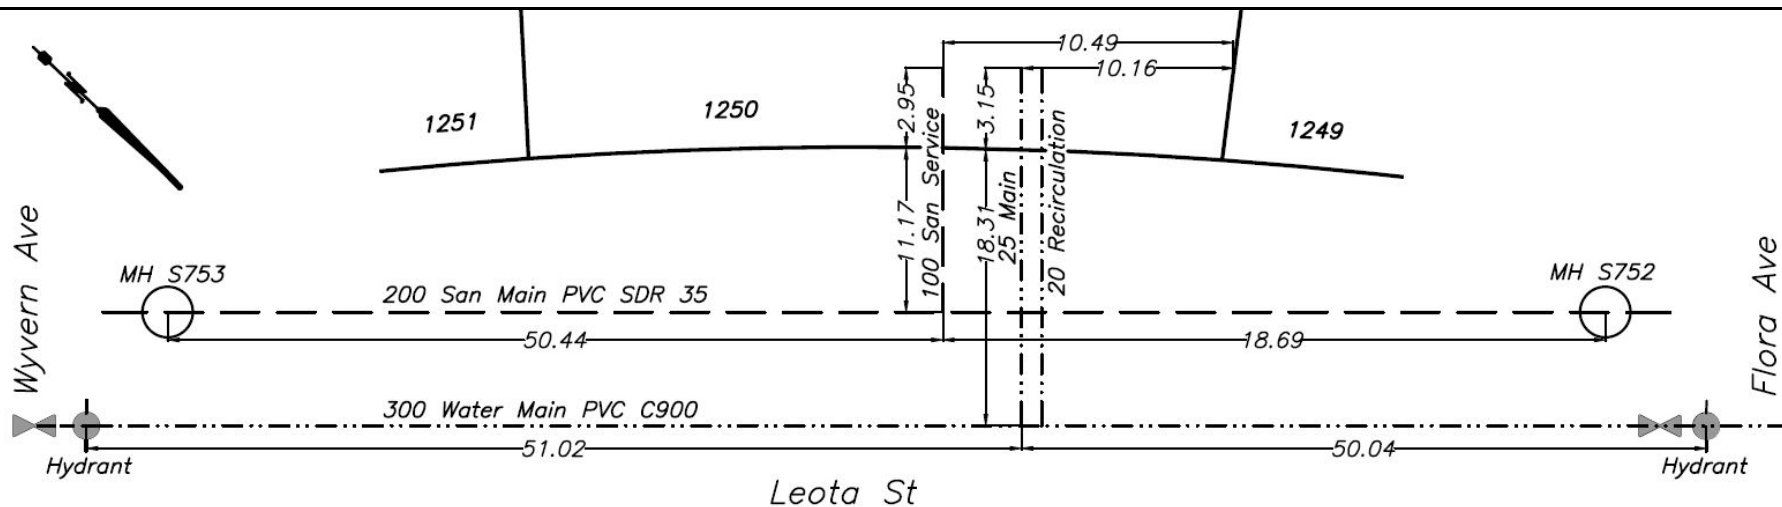




CITY OF WHITEHORSE

SERVICE CONNECTION RECORD

NAME Castle Rock Enterprises ADDRESS 238 Leota St BLOCK LOT 1251

DATES	WATER	SEWER
On at Main June 24, 2023	Depth at P/L: 672.73m (2.8 m)	Depth at P/L: 672.81m (2.8 m)
On at CC	Depth at Main: 672.06m (2.9 m)	Depth at Main: 671.97m (3.2 m)
Frost Plug	Pipe Size: 25 mm/20 mm	Pipe Size: 100 mm
Memo:	Pipe Material: HDPE Insul. ☒ Yes ☐ No	Pipe Material: PVC Insul. Yes ☒ No ☐ Yes
	Length from Main to P/L: 18.34m	Length from Main to P/L: 11.16m
		STORM
	Squirt Test: ☒ Pass ☐ fail	Depth at P/L:
	Frost Protection: ☒ Recirc ☐ Heat Trace	Depth at Main:
	Continuity Test: n/a Pass/Fail	Pipe Size:
	PRV Required: Yes ☒ No ☐ Yes	Pipe Material:
		Length from Main to P/L:

CLEARLY INDICATE LOCATION OF CC AND ROUTE OF PIPES ON DRAWING BELOW

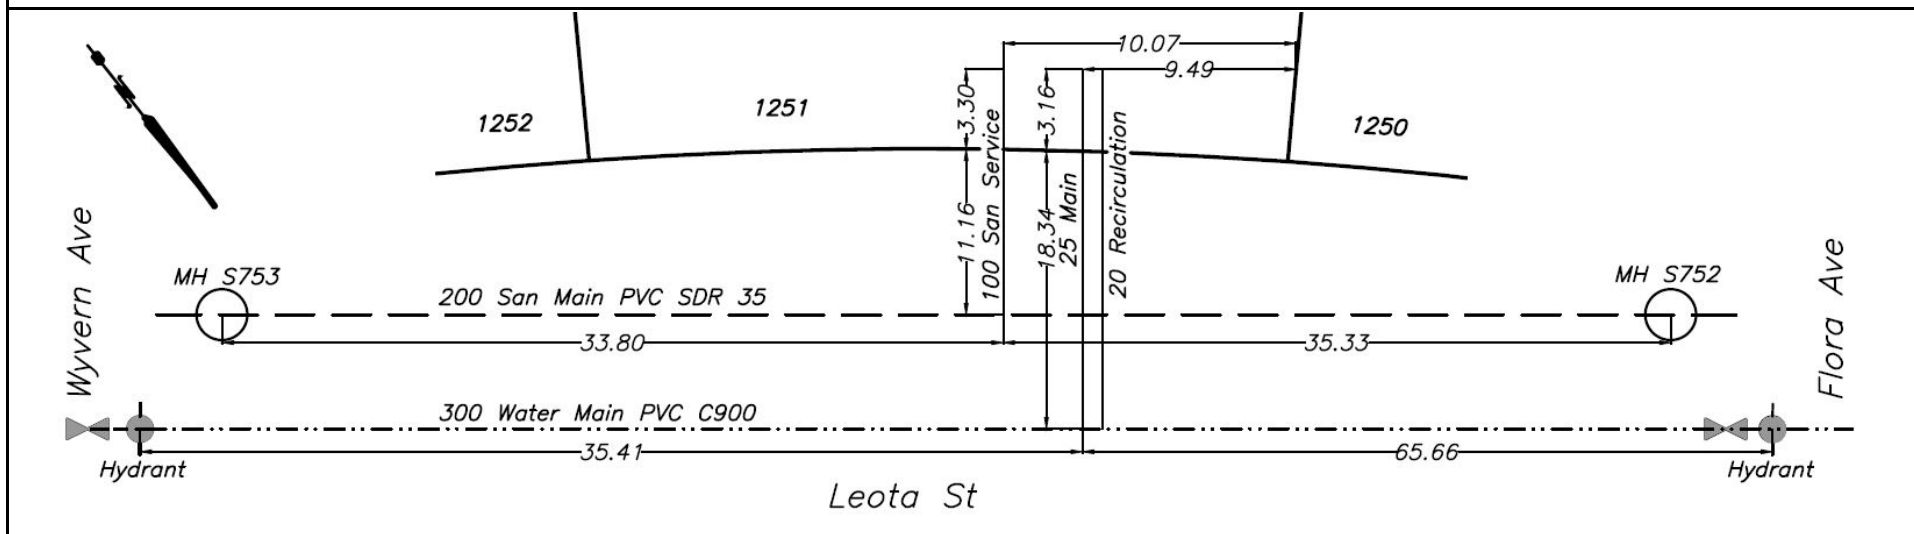




CITY OF WHITEHORSE

SERVICE CONNECTION RECORD

NAME Castle Rock Enterprises ADDRESS 236 Leota St BLOCK LOT 1252

DATES	WATER	SEWER
On at Main June 26, 2023	Depth at P/L: 672.94m (2.8 m)	Depth at P/L: 672.85m (2.8 m)
On at CC	Depth at Main: 672.33m (2.8 m)	Depth at Main: 672.02m (3.3 m)
Frost Plug	Pipe Size: 25 mm/20 mm	Pipe Size: 100 mm
Memo:	Pipe Material: HDPE Insul. ☒ Yes ☐ No	Pipe Material: PVC Insul. Yes ☒ No ☐ Yes
	Length from Main to P/L: 18.38m	Length from Main to P/L: 11.00m
		STORM
	Squirt Test: ☒ Pass ☐ fail	Depth at P/L:
	Frost Protection: ☒ Recirc ☐ Heat Trace	Depth at Main:
	Continuity Test: n/a Pass/Fail	Pipe Size:
	PRV Required: Yes ☒ No ☐ Yes	Pipe Material:
		Length from Main to P/L:

CLEARLY INDICATE LOCATION OF CC AND ROUTE OF PIPES ON DRAWING BELOW

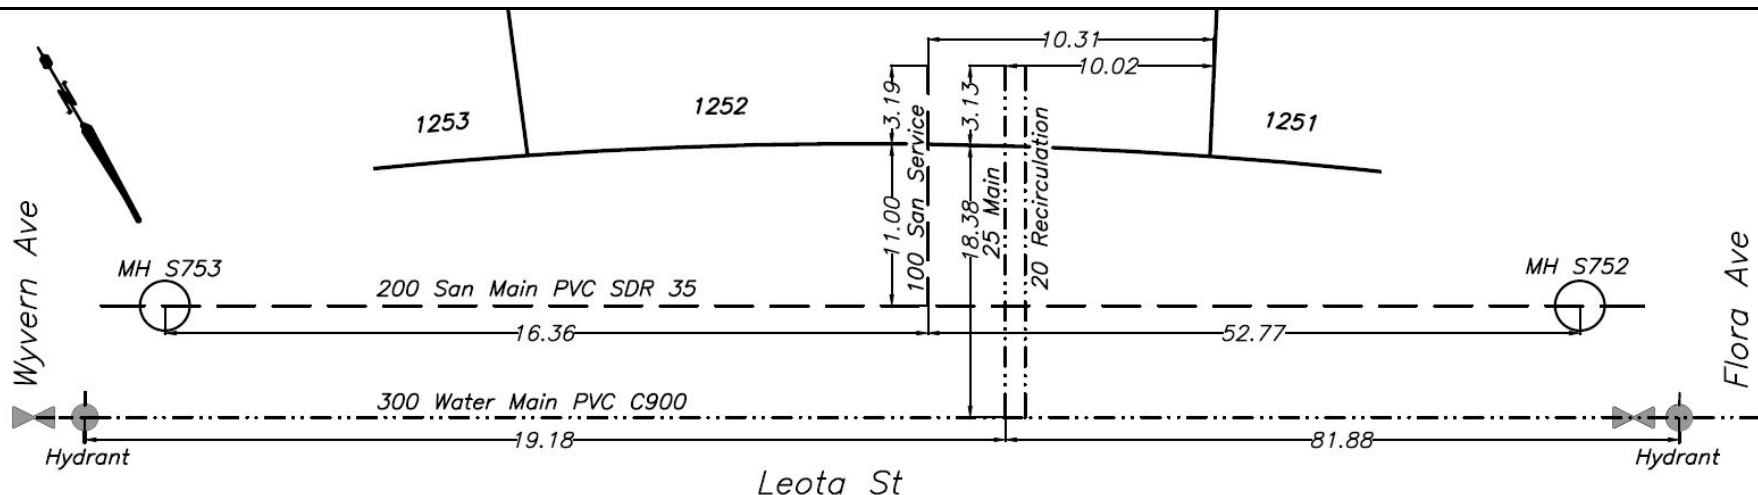




CITY OF WHITEHORSE

SERVICE CONNECTION RECORD

NAME Castle Rock Enterprises ADDRESS 234 Leota St BLOCK LOT 1253

DATES	WATER	SEWER
On at Main June 26, 2023	Depth at P/L: 672.93m (2.9 m)	Depth at P/L: 672.90m (2.9 m)
On at CC	Depth at Main: 672.63m (2.6 m)	Depth at Main: 672.13m (3.3 m)
Frost Plug	Pipe Size: 25 mm/20 mm	Pipe Size: 100 mm
Memo:	Pipe Material: HDPE Insul. ☒ Yes ☐ No	Pipe Material: PVC Insul. Yes ☒ No ☐ Yes
	Length from Main to P/L: 18.45m	Length from Main to P/L: 11.01m
		STORM
	Squirt Test: ☒ Pass ☐ fail	Depth at P/L:
	Frost Protection: ☒ Recirc ☐ Heat Trace	Depth at Main:
	Continuity Test: n/a Pass/Fail	Pipe Size:
	PRV Required: Yes ☒ No ☐ Yes	Pipe Material:
		Length from Main to P/L:

CLEARLY INDICATE LOCATION OF CC AND ROUTE OF PIPES ON DRAWING BELOW

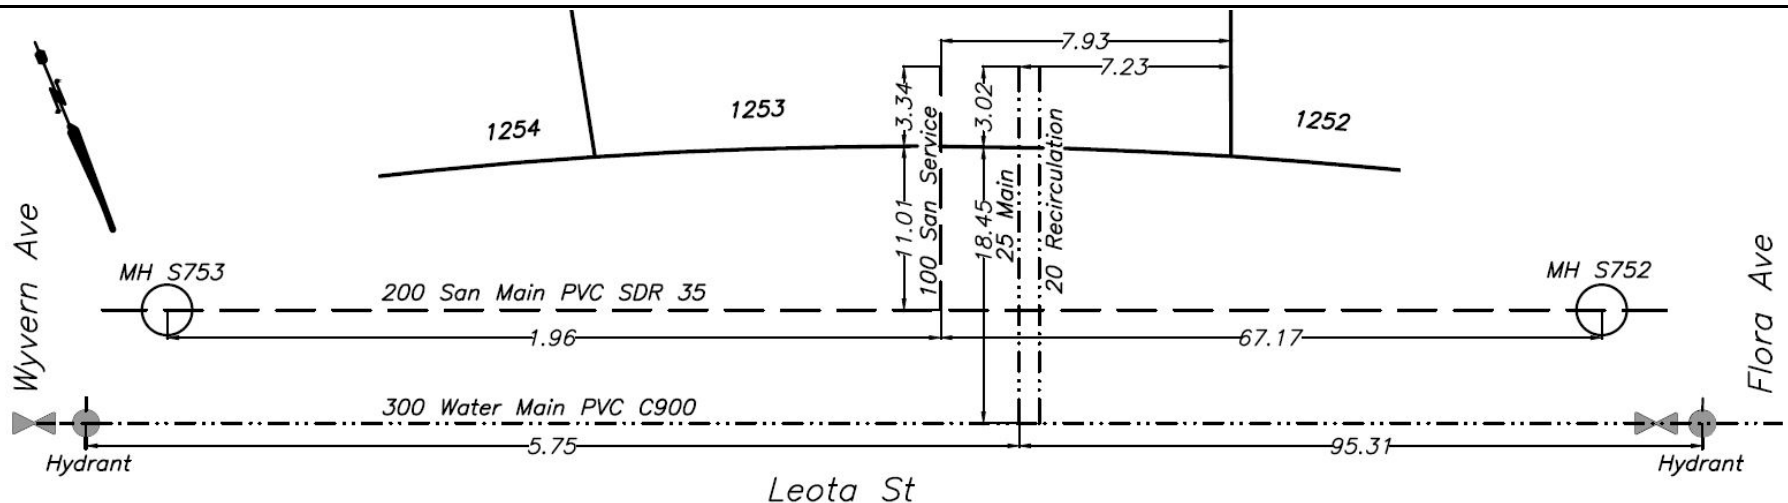




CITY OF WHITEHORSE

SERVICE CONNECTION RECORD

NAME Castle Rock Enterprises ADDRESS 232 Leota St BLOCK LOT 1254

DATES	WATER	SEWER
On at Main June 26, 2023	Depth at P/L: 673.67m (2.3 m)	Depth at P/L: 673.70m (2.2 m)
On at CC	Depth at Main: 672.60m (2.7 m)	Depth at Main: 673.18m (2.4 m)
Frost Plug	Pipe Size: 25 mm/20 mm	Pipe Size: 100 mm
Memo:	Pipe Material: HDPE Insul. ☒ Yes ☐ No	Pipe Material: PVC Insul. ☒ Yes ☐ No
	Length from Main to P/L: 18.43m	Length from Main to P/L: 11.09m
		STORM
	Squirt Test: ☒ Pass ☐ fail	Depth at P/L:
	Frost Protection: ☒ Recirc ☐ Heat Trace	Depth at Main:
	Continuity Test: n/a Pass/Fail	Pipe Size:
	PRV Required: Yes ☒ No ☐	Pipe Material:
		Length from Main to P/L:

CLEARLY INDICATE LOCATION OF CC AND ROUTE OF PIPES ON DRAWING BELOW

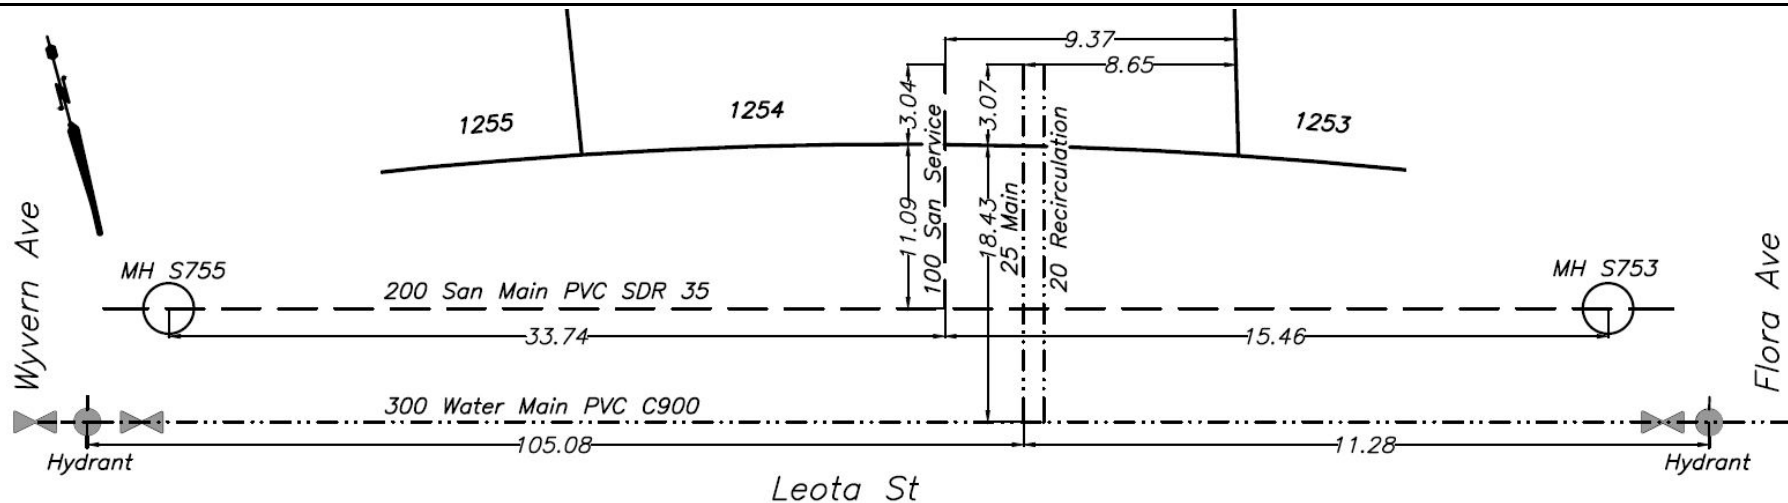




CITY OF WHITEHORSE

SERVICE CONNECTION RECORD

NAME Castle Rock Enterprises ADDRESS 230 Leota St BLOCK LOT 1255

DATES	WATER	SEWER
On at Main June 28, 2023	Depth at P/L: 673.59m (2.4 m)	Depth at P/L: 673.52m (2.5 m)
On at CC	Depth at Main: 672.75m (2.7 m)	Depth at Main: 673.12m (2.5 m)
Frost Plug	Pipe Size: 25 mm/20 mm	Pipe Size: 100 mm
Memo:	Pipe Material: HDPE Insul. ☒ Yes ☐ No	Pipe Material: PVC Insul. Yes ☒ No ☐ Yes
	Length from Main to P/L: 18.53m	Length from Main to P/L: 11.06m
		STORM
	Squirt Test: ☒ Pass ☐ fail	Depth at P/L:
	Frost Protection: ☒ Recirc ☐ Heat Trace	Depth at Main:
	Continuity Test: n/a Pass/Fail	Pipe Size:
	PRV Required: Yes ☒ No ☐ Yes	Pipe Material:
		Length from Main to P/L:

CLEARLY INDICATE LOCATION OF CC AND ROUTE OF PIPES ON DRAWING BELOW

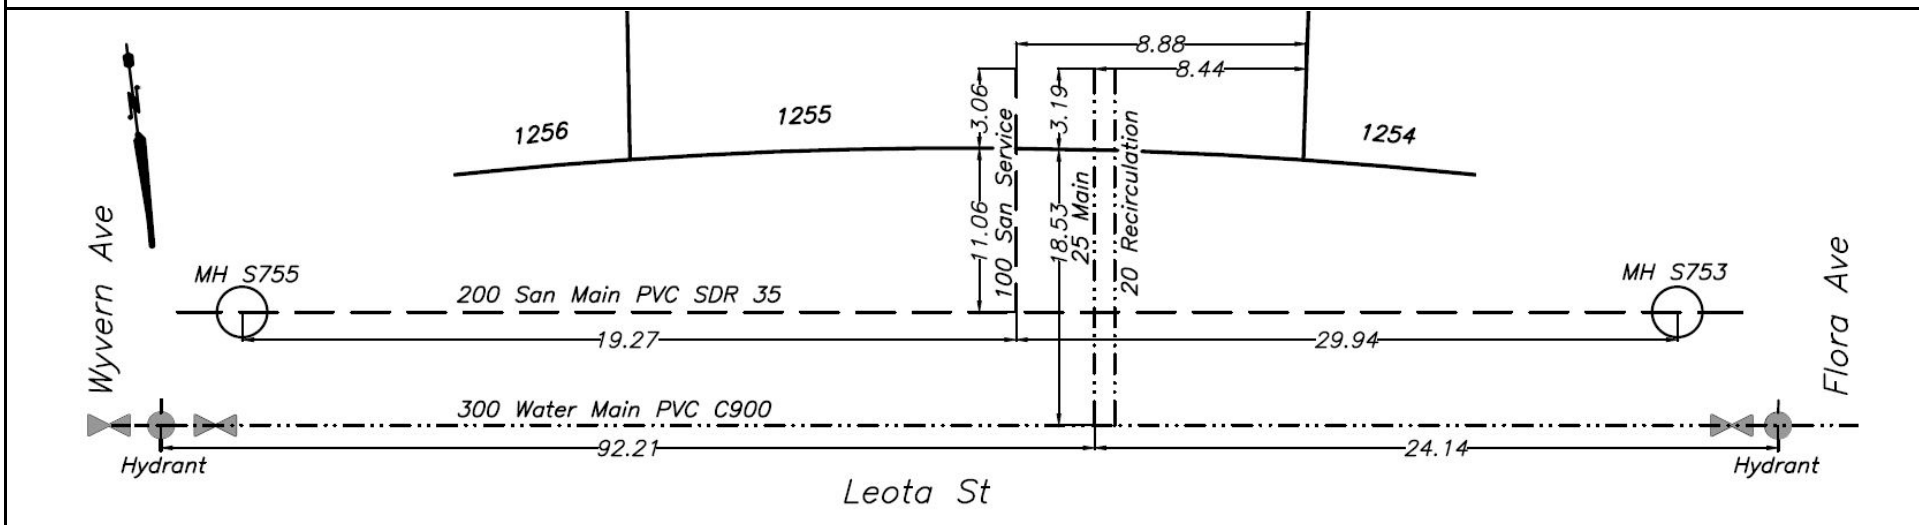




CITY OF WHITEHORSE

SERVICE CONNECTION RECORD

NAME Castle Rock Enterprises ADDRESS 228 Leota St BLOCK LOT 1256

DATES	WATER	SEWER
On at Main June 24, 2023	Depth at P/L: 673.35m (2.7 m)	Depth at P/L: 673.42m (2.7 m)
On at CC	Depth at Main: 672.83m (2.8 m)	Depth at Main: 673.22m (2.6 m)
Frost Plug	Pipe Size: 25 mm/20 mm	Pipe Size: 100 mm
Memo:	Pipe Material: HDPE Insul. ☒ Yes ☐ No	Pipe Material: PVC Insul. Yes ☒ No ☐ Yes
	Length from Main to P/L: 18.53m	Length from Main to P/L: 11.02m
		STORM
	Squirt Test: ☒ Pass ☐ fail	Depth at P/L:
	Frost Protection: ☒ Recirc ☐ Heat Trace	Depth at Main:
	Continuity Test: n/a Pass/Fail	Pipe Size:
	PRV Required: Yes ☒ No ☐	Pipe Material:
		Length from Main to P/L:

CLEARLY INDICATE LOCATION OF CC AND ROUTE OF PIPES ON DRAWING BELOW

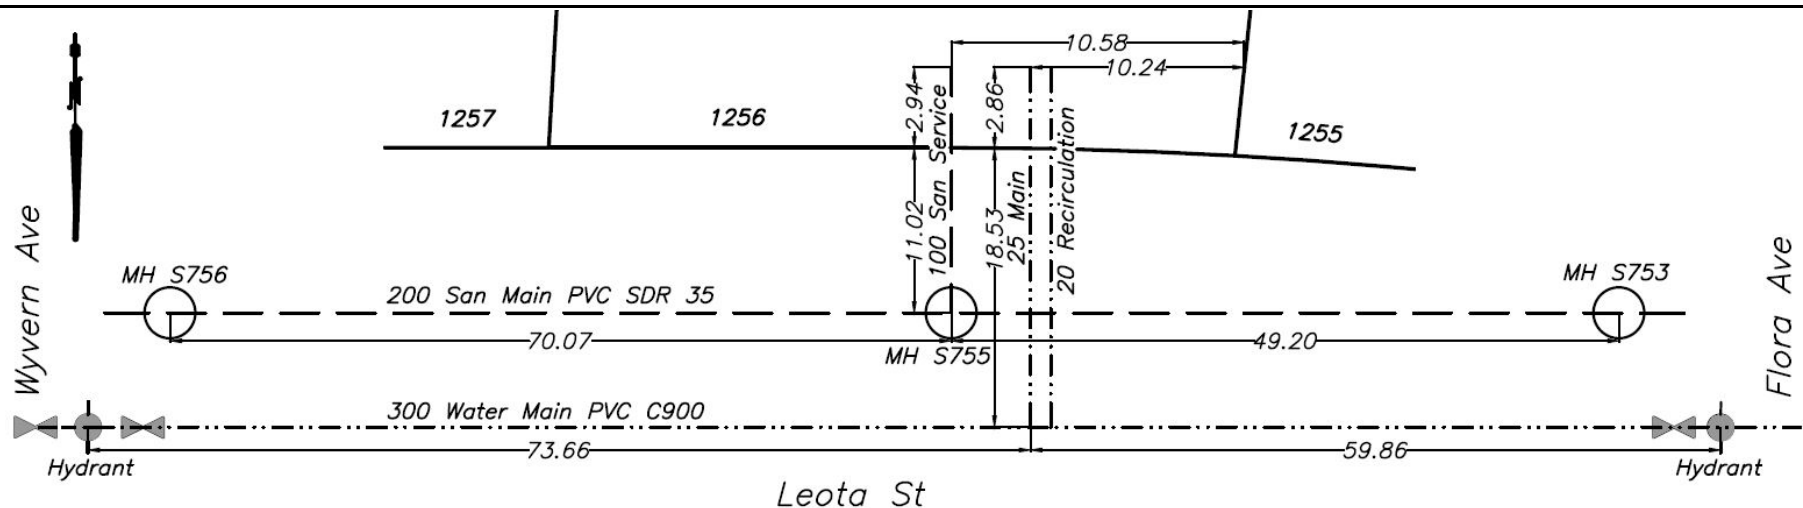




CITY OF WHITEHORSE

SERVICE CONNECTION RECORD

NAME Castle Rock Enterprises ADDRESS 226 Leota St BLOCK LOT 1257

DATES	WATER	SEWER
On at Main June 24, 2023	Depth at P/L: 673.30m (2.7 m)	Depth at P/L: 673.37m (2.6 m)
On at CC	Depth at Main: 672.91m (2.9 m)	Depth at Main: 672.89m (3.0 m)
Frost Plug	Pipe Size: 25 mm/20 mm	Pipe Size: 100 mm
Memo:	Pipe Material: HDPE Insul. <u>Yes</u> /No	Pipe Material: PVC Insul. Yes/ <u>No</u>
	Length from Main to P/L: 18.53m	Length from Main to P/L: 10.97m
		STORM
	Squirt Test: <u>Pass</u> /fail	Depth at P/L:
	Frost Protection: <u>Recirc</u> Heat Trace	Depth at Main:
	Continuity Test: n/a Pass/Fail	Pipe Size:
	PRV Required: Yes/ <u>No</u>	Pipe Material:
		Length from Main to P/L:

CLEARLY INDICATE LOCATION OF CC AND ROUTE OF PIPES ON DRAWING BELOW

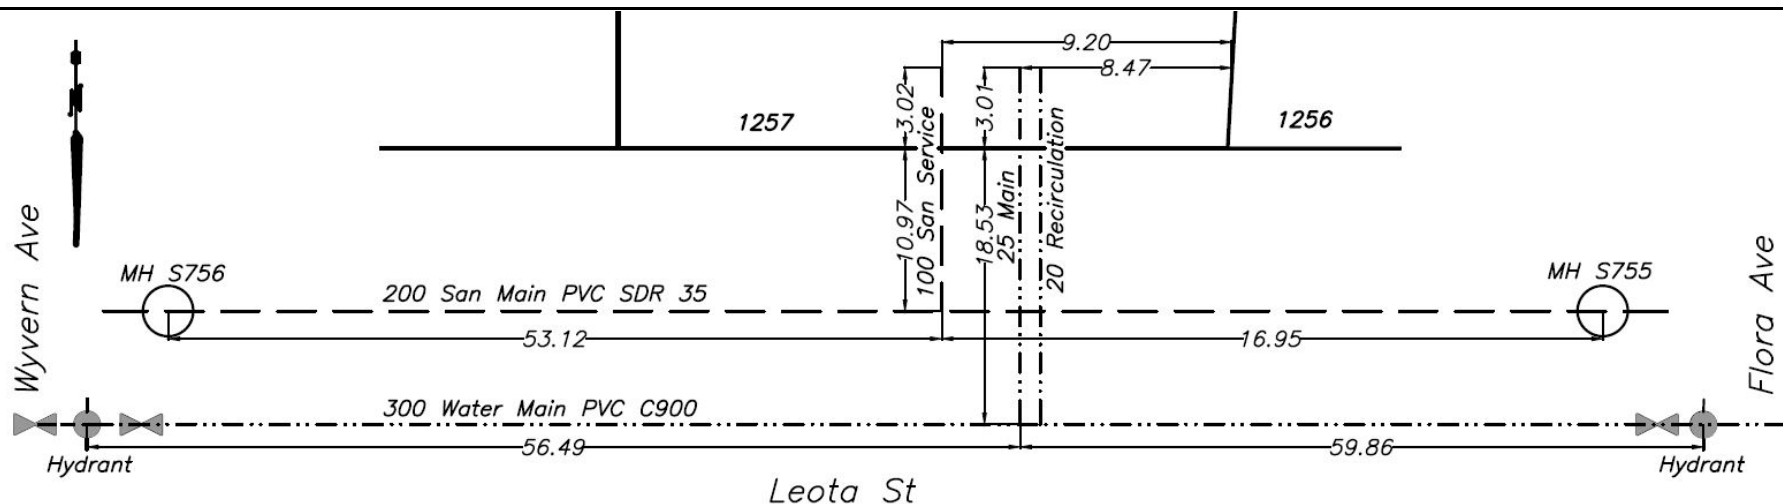




CITY OF WHITEHORSE

SERVICE CONNECTION RECORD

NAME Castle Rock Enterprises ADDRESS 339 Witch Hazel Dr BLOCK _____ LOT 1124

DATES	WATER	SEWER
On at Main August 1, 2023	Depth at P/L: 673.28m (2.6m)	Depth at P/L: 673.21m (2.7m)
On at CC	Depth at Main: 673.01m (2.8m)	Depth at Main: 672.80m (3.1m)
Frost Plug	Pipe Size: 25mm/20mm	Pipe Size: 100mm
Memo:	Pipe Material: HDPE Insul. <u>Yes</u> /No	Pipe Material: PVC Insul. Yes/ <u>No</u>
	Length from Main to P/L: 3.15m	Length from Main to P/L: 10.44m
		STORM
	Squirt Test: <u>Pass</u> /Fail	Depth at P/L:
	Frost Protection: <u>Recirc</u> /Heat Trace	Depth at Main:
	Continuity Test: n/a Pass/Fail	Pipe Size:
	PRV Required: Yes/ <u>No</u>	Pipe Material:
		Length from Main to P/L:

CLEARLY INDICATE LOCATION OF CC AND ROUTE OF PIPES ON DRAWING BELOW

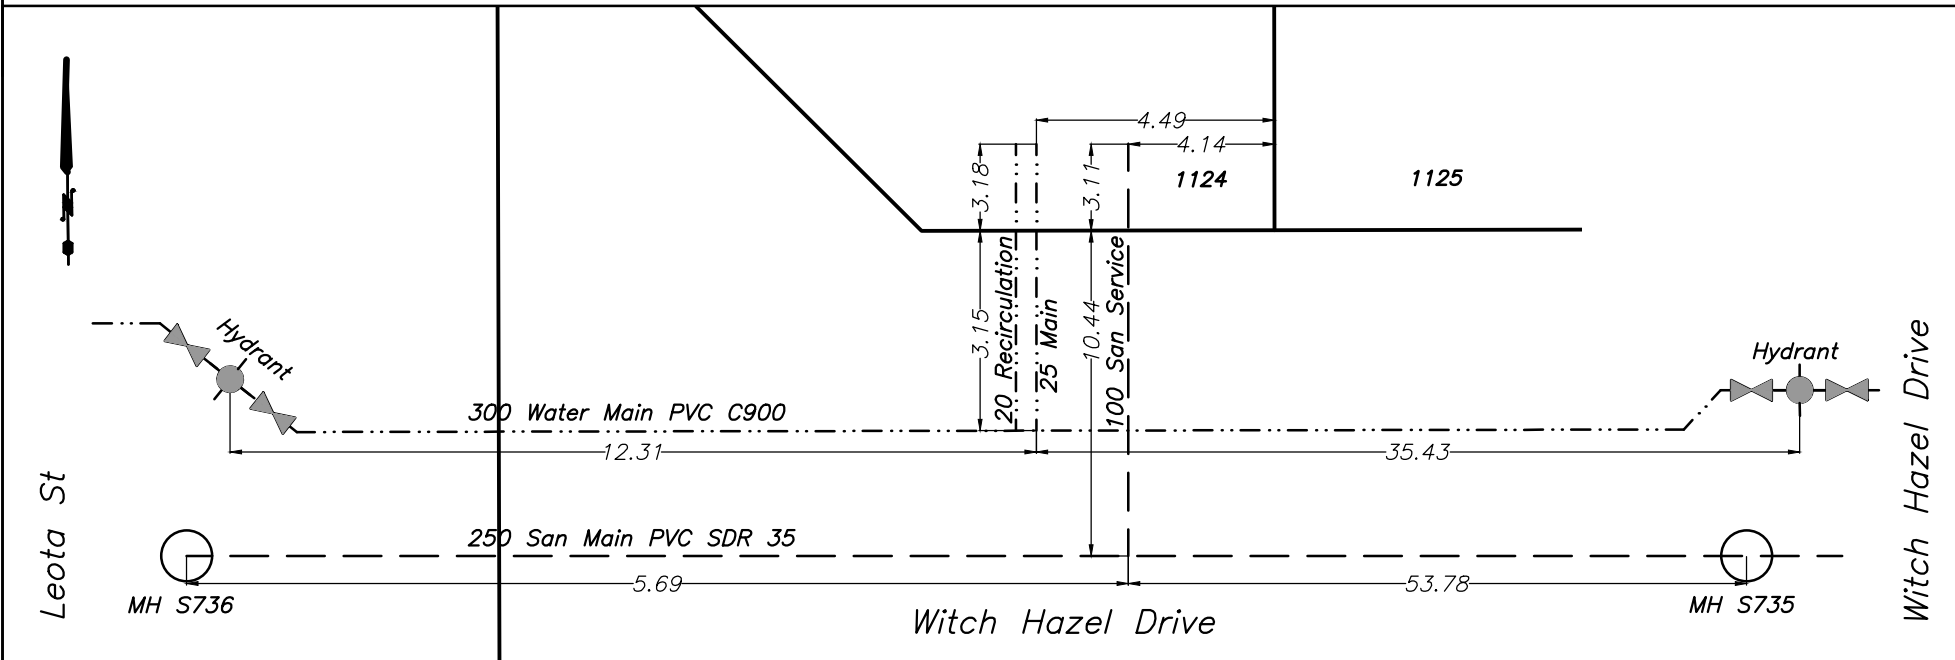




CITY OF WHITEHORSE

SERVICE CONNECTION RECORD

NAME Castle Rock Enterprises ADDRESS 337 Witch Hazel Dr BLOCK _____ LOT 1125

DATES	WATER	SEWER
On at Main July 31, 2023	Depth at P/L: 673.36m (2.6m)	Depth at P/L: 673.27m (2.7m)
On at CC	Depth at Main: 673.06m (2.9m)	Depth at Main: 672.76m (3.2m)
Frost Plug	Pipe Size: 25mm/20mm	Pipe Size: 100mm
Memo:	Pipe Material: HDPE	Pipe Material: PVC
	Insul. <u>Yes</u> /No	Insul. Yes/ <u>No</u>
	Length from Main to P/L: 7.49m	Length from Main to P/L: 10.47m
		STORM
	Squirt Test: <u>Pass</u> /Fail	Depth at P/L:
	Frost Protection: <u>Recirc</u> /Heat Trace	Depth at Main:
	Continuity Test: n/a	Pipe Size:
	PRV Required: Yes/ <u>No</u>	Pipe Material:
		Length from Main to P/L:

CLEARLY INDICATE LOCATION OF CC AND ROUTE OF PIPES ON DRAWING BELOW

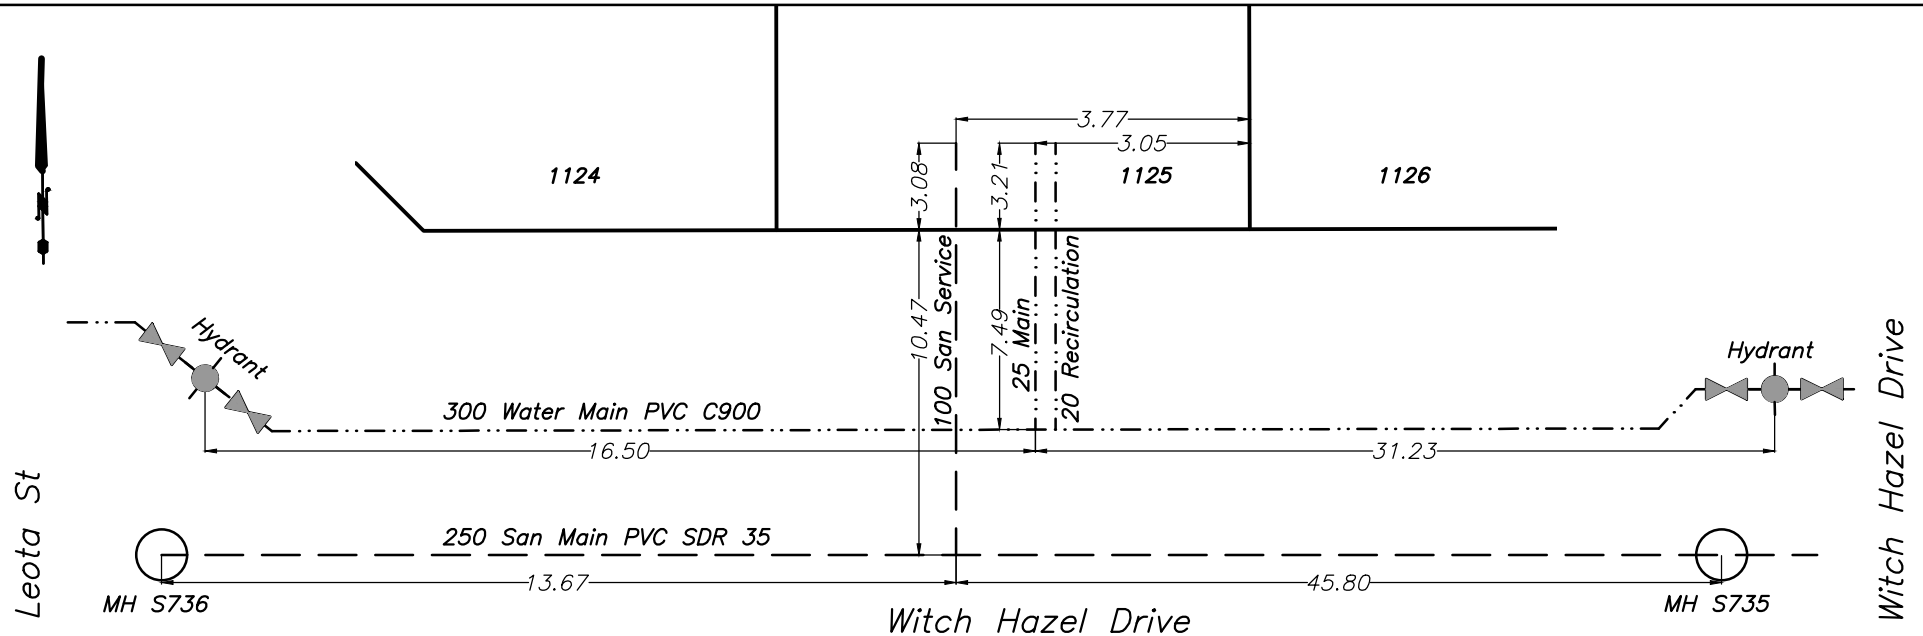




CITY OF WHITEHORSE

SERVICE CONNECTION RECORD

NAME Castle Rock Enterprises ADDRESS 335 Witch Hazel Dr BLOCK _____ LOT 1126

DATES	WATER	SEWER
On at Main August 2, 2023	Depth at P/L: 673.38m (2.6m)	Depth at P/L: 673.31m (2.7m)
On at CC	Depth at Main: 673.08m (2.9m)	Depth at Main: 672.74m (3.3m)
Frost Plug	Pipe Size: 25mm/20mm	Pipe Size: 100mm
Memo:	Pipe Material: HDPE	Pipe Material: PVC
	Insul. <u>Yes</u> /No	Insul. Yes/ <u>No</u>
	Length from Main to P/L: 7.56m	Length from Main to P/L: 10.48m
		STORM
	Squirt Test: <u>Pass</u> /Fail	Depth at P/L:
	Frost Protection: <u>Recirc</u> /Heat Trace	Depth at Main:
	Continuity Test: n/a	Pipe Size:
	PRV Required: Yes/ <u>No</u>	Pipe Material:
		Length from Main to P/L:

CLEARLY INDICATE LOCATION OF CC AND ROUTE OF PIPES ON DRAWING BELOW

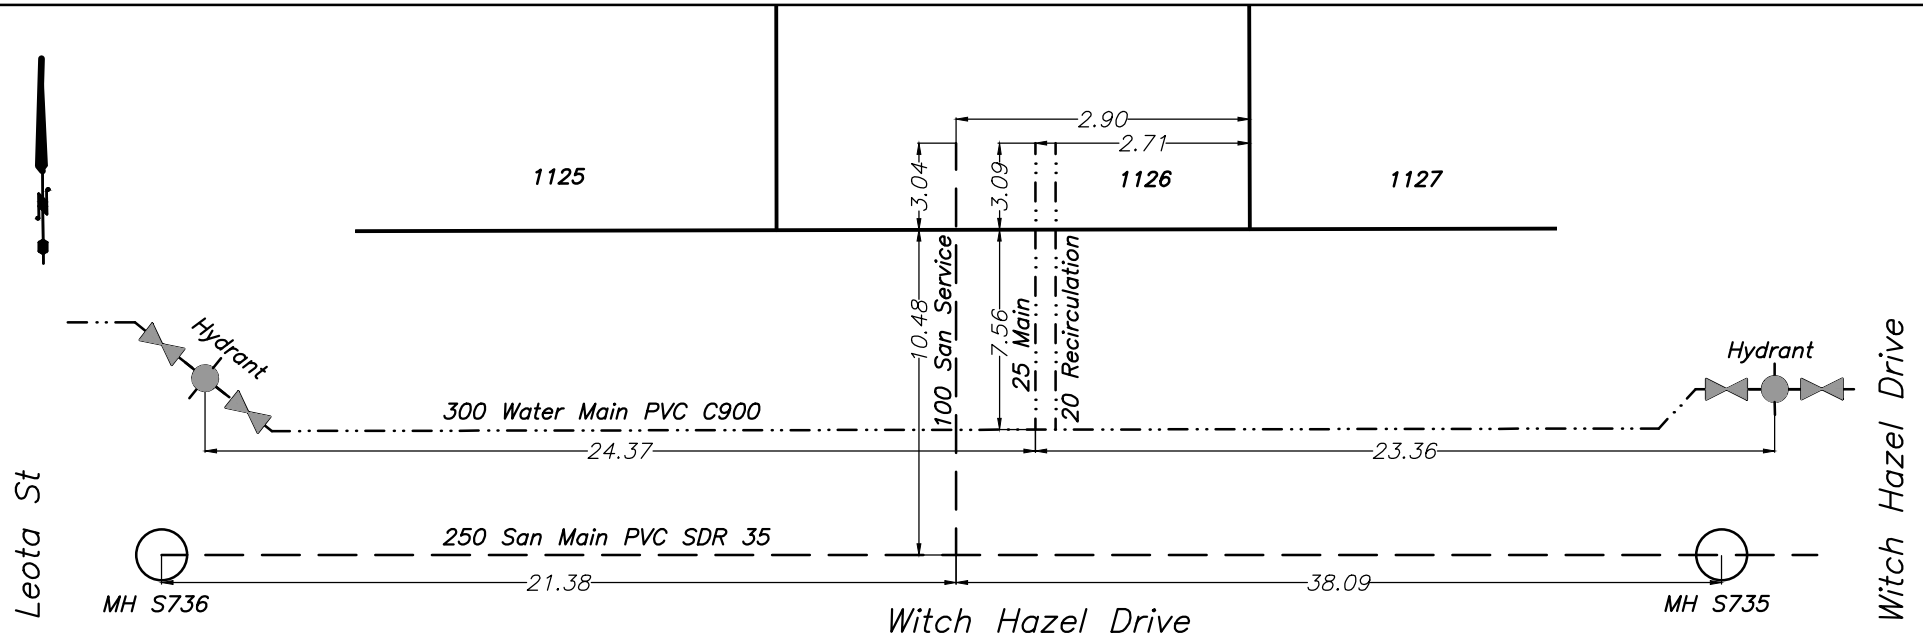




CITY OF WHITEHORSE

SERVICE CONNECTION RECORD

NAME Castle Rock Enterprises ADDRESS 333 Witch Hazel Dr BLOCK _____ LOT 1127

DATES	WATER	SEWER
On at Main July 27, 2023	Depth at P/L: 673.39m (2.6m)	Depth at P/L: 673.40m (2.6m)
On at CC	Depth at Main: 673.11m (2.9m)	Depth at Main: 672.70m (3.4m)
Frost Plug	Pipe Size: 25mm/20mm	Pipe Size: 100mm
Memo:	Pipe Material: HDPE Insul. <u>Yes</u> /No	Pipe Material: PVC Insul. Yes/ <u>No</u>
	Length from Main to P/L: 7.53m	Length from Main to P/L: 10.48m
		STORM
	Squirt Test: <u>Pass</u> /Fail	Depth at P/L:
	Frost Protection: <u>Recirc</u> /Heat Trace	Depth at Main:
	Continuity Test: n/a Pass/Fail	Pipe Size:
	PRV Required: Yes/ <u>No</u>	Pipe Material:
		Length from Main to P/L:

CLEARLY INDICATE LOCATION OF CC AND ROUTE OF PIPES ON DRAWING BELOW

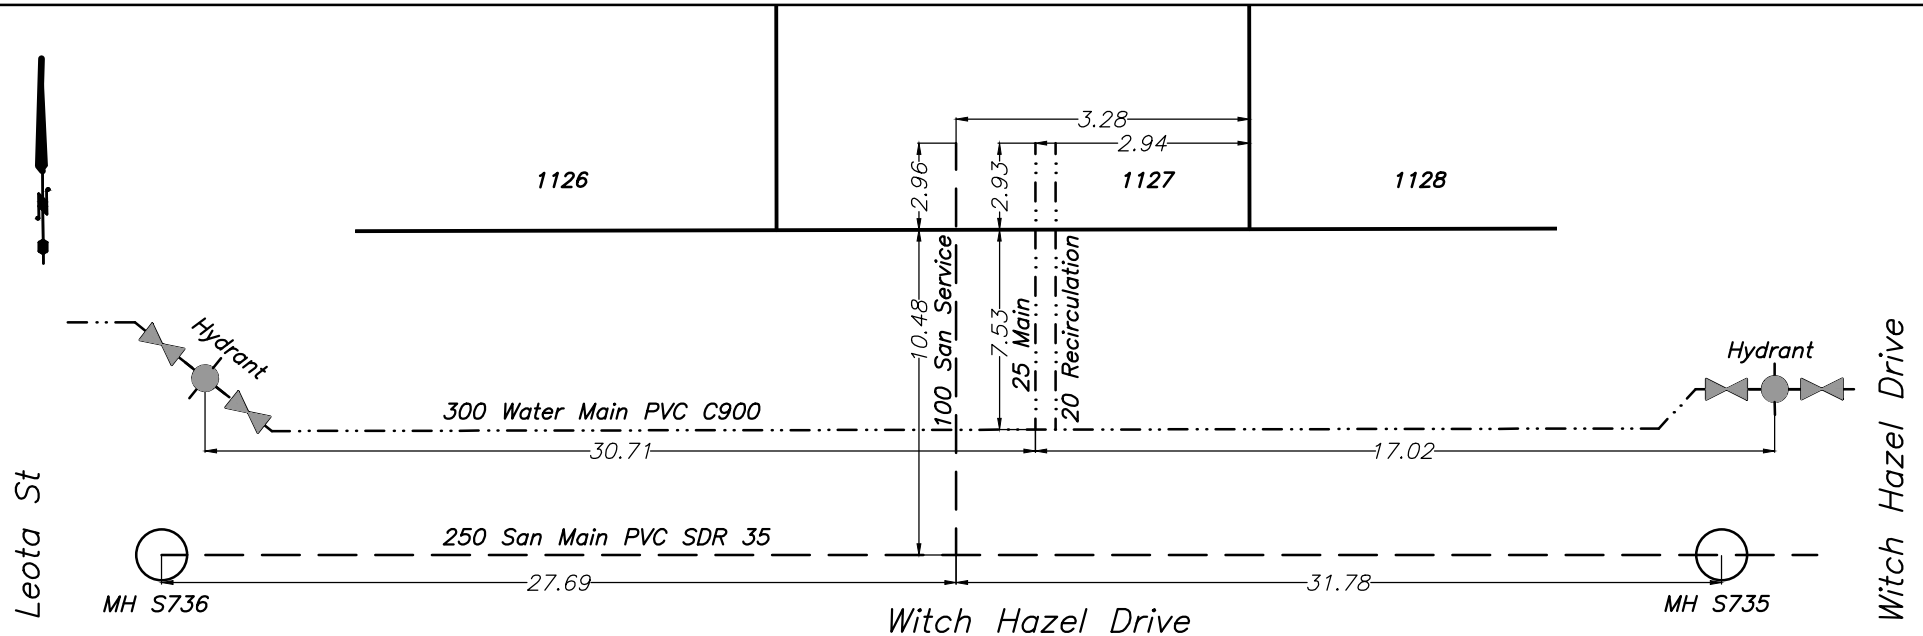




CITY OF WHITEHORSE

SERVICE CONNECTION RECORD

NAME Castle Rock Enterprises ADDRESS 331 Witch Hazel Dr BLOCK _____ LOT 1128

DATES	WATER	SEWER
On at Main July 31, 2023	Depth at P/L: 673.47m (2.6m)	Depth at P/L: 673.38m (2.7m)
On at CC	Depth at Main: 673.13m (2.9m)	Depth at Main: 672.63m (3.5m)
Frost Plug	Pipe Size: 25mm/20mm	Pipe Size: 100mm
Memo:	Pipe Material: HDPE	Pipe Material: PVC
	Insul. <u>Yes</u> /No	Insul. Yes/ <u>No</u>
	Length from Main to P/L: 7.51m	Length from Main to P/L: 10.45m
		STORM
	Squirt Test: <u>Pass</u> /Fail	Depth at P/L:
	Frost Protection: <u>Recirc</u> /Heat Trace	Depth at Main:
	Continuity Test: n/a	Pipe Size:
	PRV Required: Yes/ <u>No</u>	Pipe Material:
		Length from Main to P/L:

CLEARLY INDICATE LOCATION OF CC AND ROUTE OF PIPES ON DRAWING BELOW

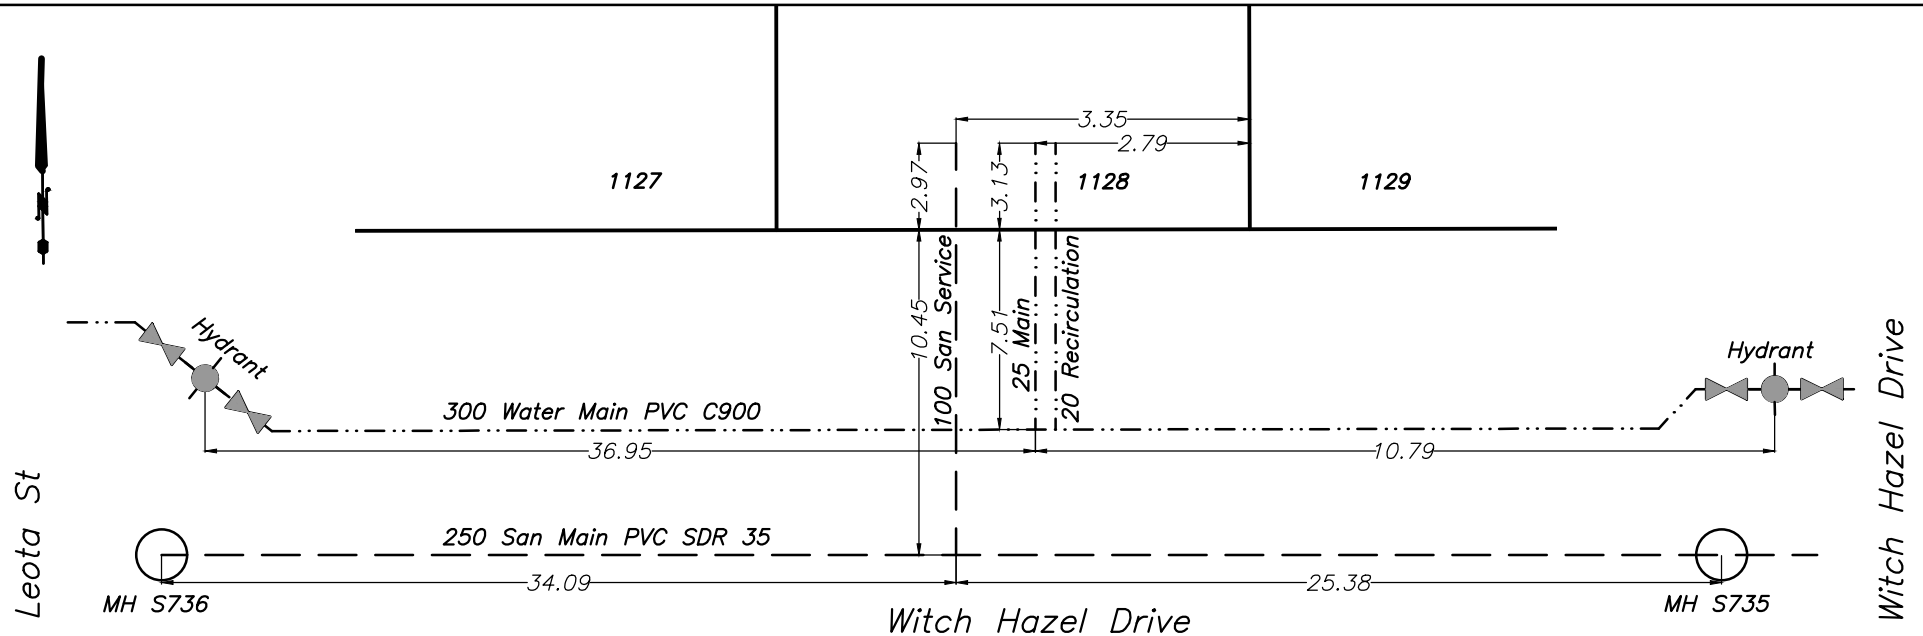




CITY OF WHITEHORSE

SERVICE CONNECTION RECORD

NAME Castle Rock Enterprises ADDRESS 329 Witch Hazel Dr BLOCK _____ LOT 1129

DATES	WATER	SEWER
On at Main July 25, 2023	Depth at P/L: 673.41m (2.7m)	Depth at P/L: 673.44m (2.7m)
On at CC	Depth at Main: 673.19m (2.8m)	Depth at Main: 672.58m (3.6m)
Frost Plug	Pipe Size: 25mm/20mm	Pipe Size: 100mm
Memo:	Pipe Material: HDPE	Pipe Material: PVC
	Insul. <u>Yes</u> /No	Insul. Yes/ <u>No</u>
	Length from Main to P/L: 5.02	Length from Main to P/L: 10.51m
		STORM
	Squirt Test: <u>Pass</u> /Fail	Depth at P/L:
	Frost Protection: <u>Recirc</u> /Heat Trace	Depth at Main:
	Continuity Test: n/a	Pipe Size:
	PRV Required: Yes/ <u>No</u>	Pipe Material:
		Length from Main to P/L:

CLEARLY INDICATE LOCATION OF CC AND ROUTE OF PIPES ON DRAWING BELOW

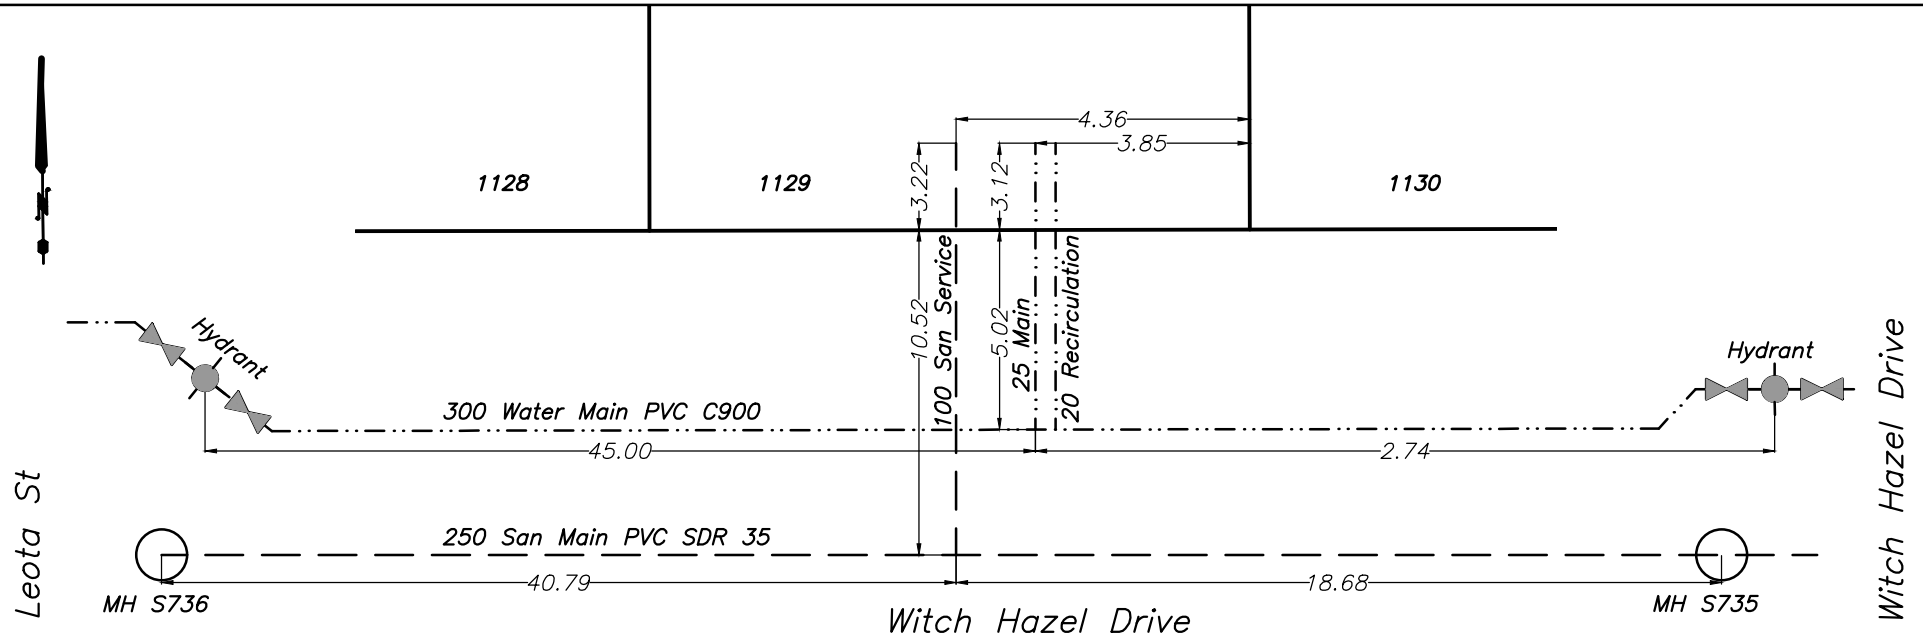




CITY OF WHITEHORSE

SERVICE CONNECTION RECORD

NAME Castle Rock Enterprises ADDRESS 327 Witch Hazel Dr BLOCK _____ LOT 1130

DATES	WATER	SEWER
On at Main July 28, 2023	Depth at P/L: 673.52m (2.6m)	Depth at P/L: 673.56m (2.6m)
On at CC	Depth at Main: 673.22m (2.9m)	Depth at Main: 672.57m (3.6m)
Frost Plug	Pipe Size: 25mm/20mm	Pipe Size: 100mm
Memo:	Pipe Material: HDPE	Pipe Material: PVC
	Insul. <u>Yes</u> /No	Insul. Yes/ <u>No</u>
	Length from Main to P/L: 7.76	Length from Main to P/L: 10.42m
		STORM
	Squirt Test: <u>Pass</u> /Fail	Depth at P/L:
	Frost Protection: <u>Recirc</u> /Heat Trace	Depth at Main:
	Continuity Test: n/a	Pipe Size:
	PRV Required: Yes/ <u>No</u>	Pipe Material:
		Length from Main to P/L:

CLEARLY INDICATE LOCATION OF CC AND ROUTE OF PIPES ON DRAWING BELOW

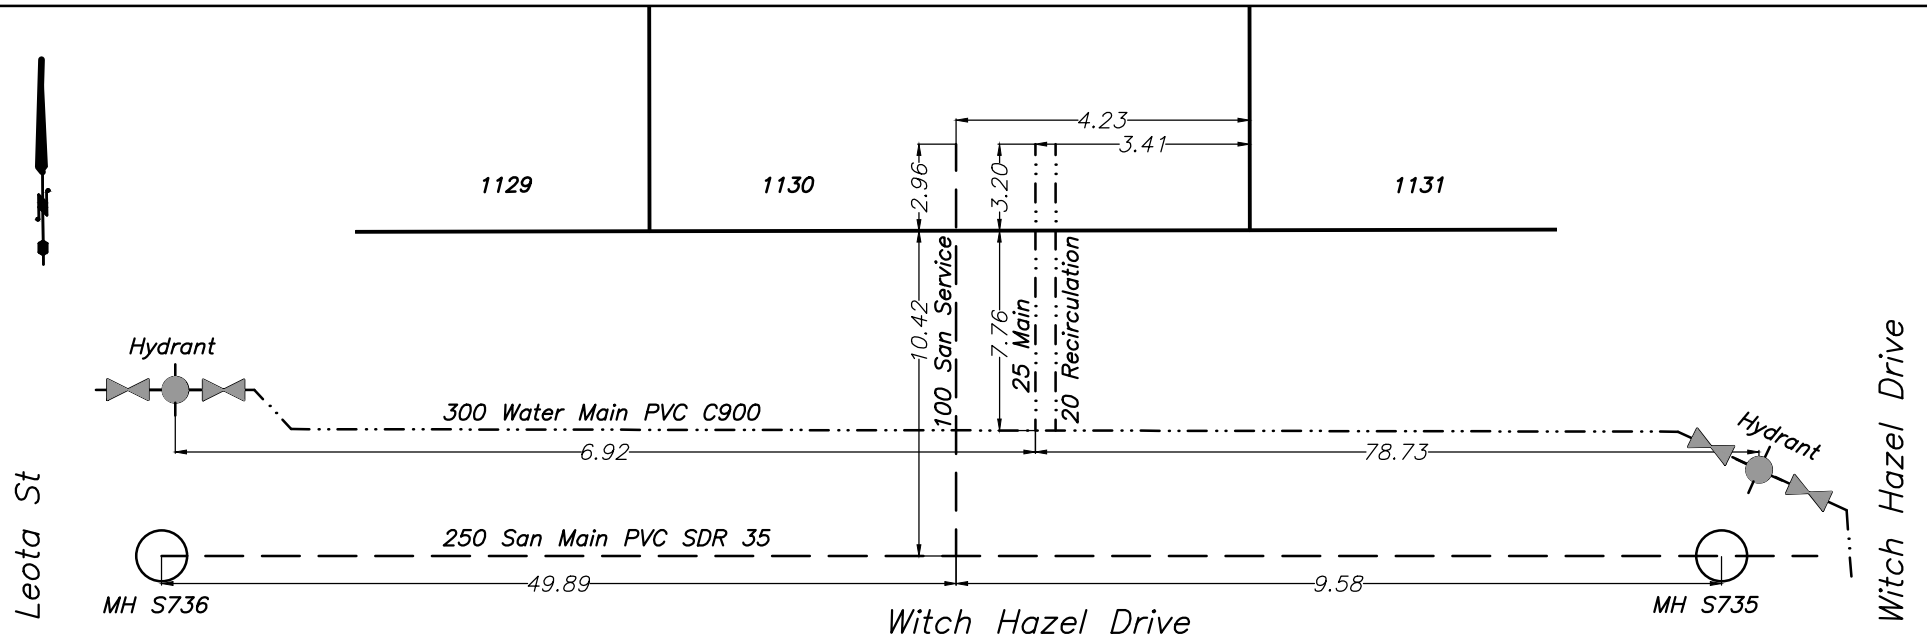




CITY OF WHITEHORSE

SERVICE CONNECTION RECORD

NAME Castle Rock Enterprises ADDRESS 325 Witch Hazel Dr BLOCK _____ LOT 1131

DATES	WATER	SEWER
On at Main July 25, 2023	Depth at P/L: 673.60m (2.6m)	Depth at P/L: 673.56m (2.7m)
On at CC	Depth at Main: 673.20m (3.0m)	Depth at Main: 672.48m (3.8m)
Frost Plug	Pipe Size: 25mm/20mm	Pipe Size: 100mm
Memo:	Pipe Material: HDPE	Pipe Material: PVC
	Insul. <u>Yes</u> /No	Insul. Yes/ <u>No</u>
	Length from Main to P/L: 7.47	Length from Main to P/L: 10.57m
		STORM
	Squirt Test: <u>Pass</u> /Fail	Depth at P/L:
	Frost Protection: <u>Recirc</u> /Heat Trace	Depth at Main:
	Continuity Test: n/a	Pipe Size:
	PRV Required: Yes/ <u>No</u>	Pipe Material:
		Length from Main to P/L:

CLEARLY INDICATE LOCATION OF CC AND ROUTE OF PIPES ON DRAWING BELOW

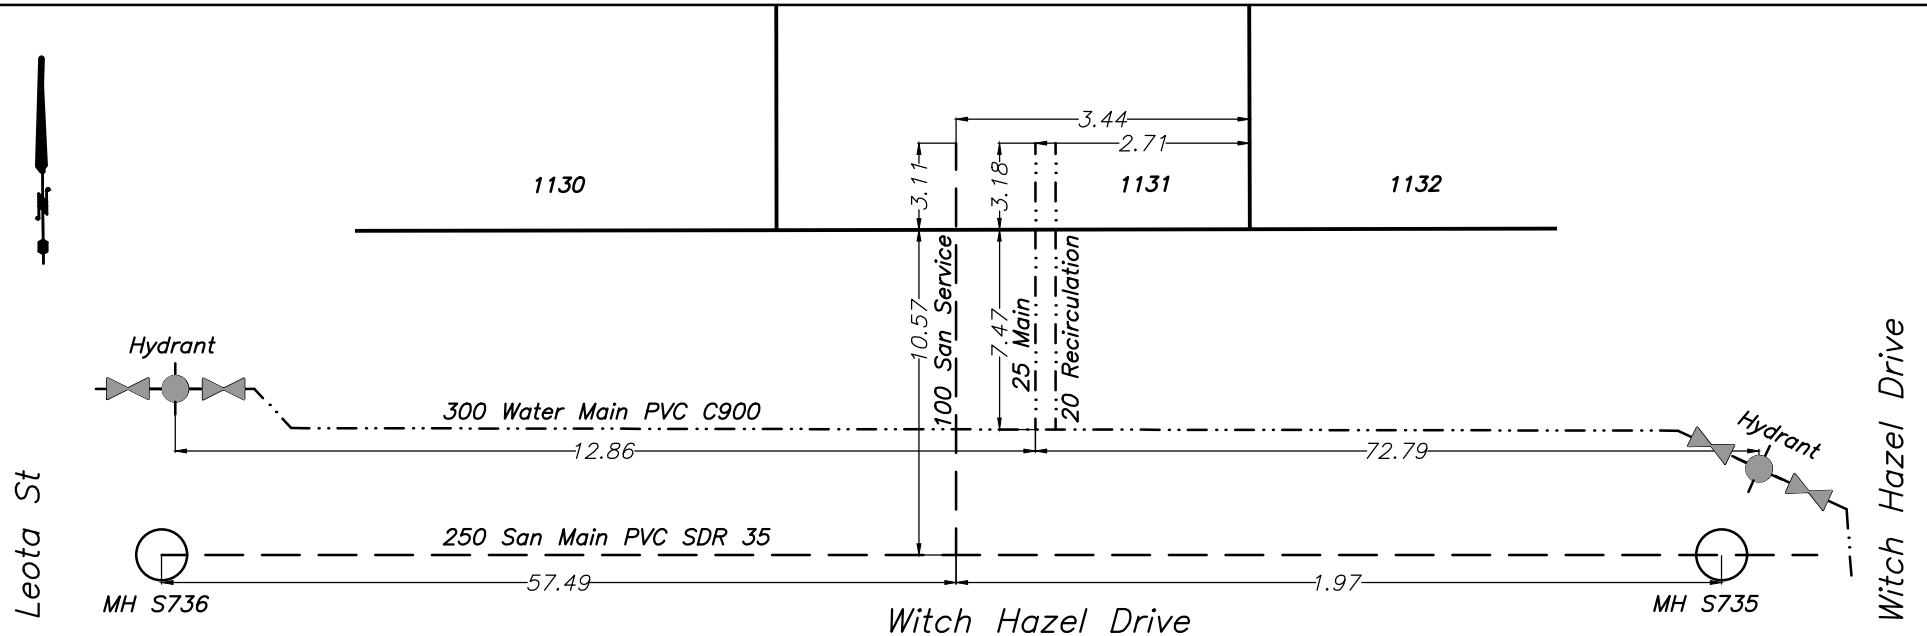




CITY OF WHITEHORSE

SERVICE CONNECTION RECORD

NAME Castle Rock Enterprises ADDRESS 323 Witch Hazel Dr BLOCK _____ LOT 1132

DATES	WATER	SEWER
On at Main July 8, 2023	Depth at P/L: 673.81m (2.5m)	Depth at P/L: 673.79m (2.5m)
On at CC	Depth at Main: 673.24m (3.0m)	Depth at Main: 672.46m (3.8m)
Frost Plug	Pipe Size: 25mm/20mm	Pipe Size: 100mm
Memo:	Pipe Material: HDPE	Pipe Material: PVC
	Insul. <u>Yes</u> /No	Insul. Yes/ <u>No</u>
	Length from Main to P/L: 7.45	Length from Main to P/L: 10.66m
		STORM
	Squirt Test: <u>Pass</u> /Fail	Depth at P/L:
	Frost Protection: <u>Recirc</u> /Heat Trace	Depth at Main:
	Continuity Test: n/a	Pipe Size:
	PRV Required: Yes/ <u>No</u>	Pipe Material:
		Length from Main to P/L:

CLEARLY INDICATE LOCATION OF CC AND ROUTE OF PIPES ON DRAWING BELOW

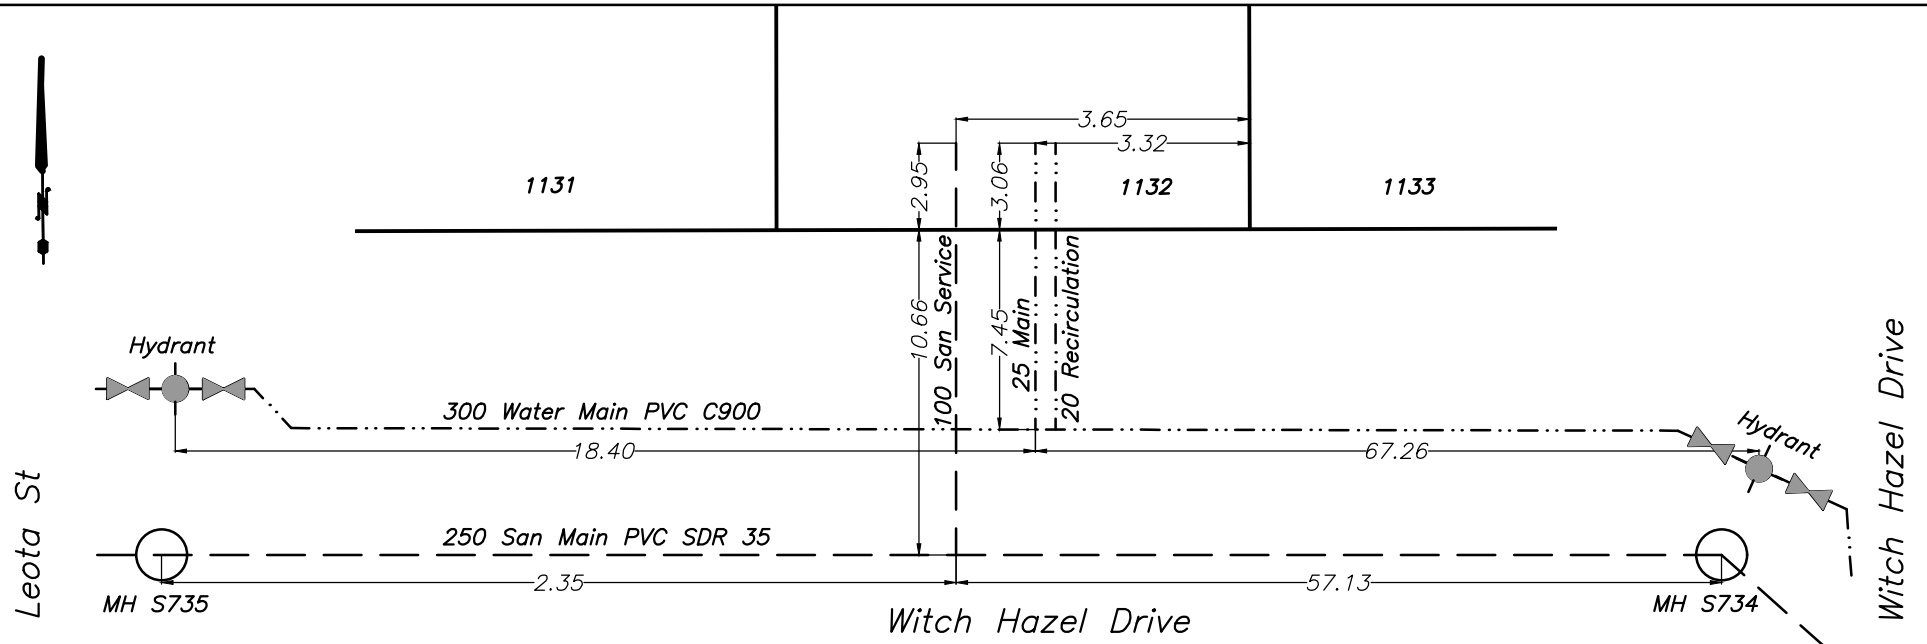




CITY OF WHITEHORSE

SERVICE CONNECTION RECORD

NAME Castle Rock Enterprises ADDRESS 321 Witch Hazel Dr BLOCK LOT 1133

DATES	WATER		SEWER
On at Main July 26, 2023	Depth at P/L: 673.64m (2.7m)		Depth at P/L: 673.60m (2.7m)
On at CC	Depth at Main: 673.25m (3.0m)		Depth at Main: 672.43m (3.9m)
Frost Plug	Pipe Size: 25mm/20mm		Pipe Size: 100mm
Memo:	Pipe Material: HDPE	Insul. <u>Yes</u> /No	Pipe Material: PVC
	Length from Main to P/L: 7.49		Length from Main to P/L: 10.60m
			STORM
	Squirt Test: <u>Pass</u> /Fail		Depth at P/L:
	Frost Protection: <u>Recirc</u> /Heat Trace		Depth at Main:
	Continuity Test: n/a		Pipe Size:
	PRV Required: Yes/ <u>No</u>		Pipe Material:
			Length from Main to P/L:

CLEARLY INDICATE LOCATION OF CC AND ROUTE OF PIPES ON DRAWING BELOW

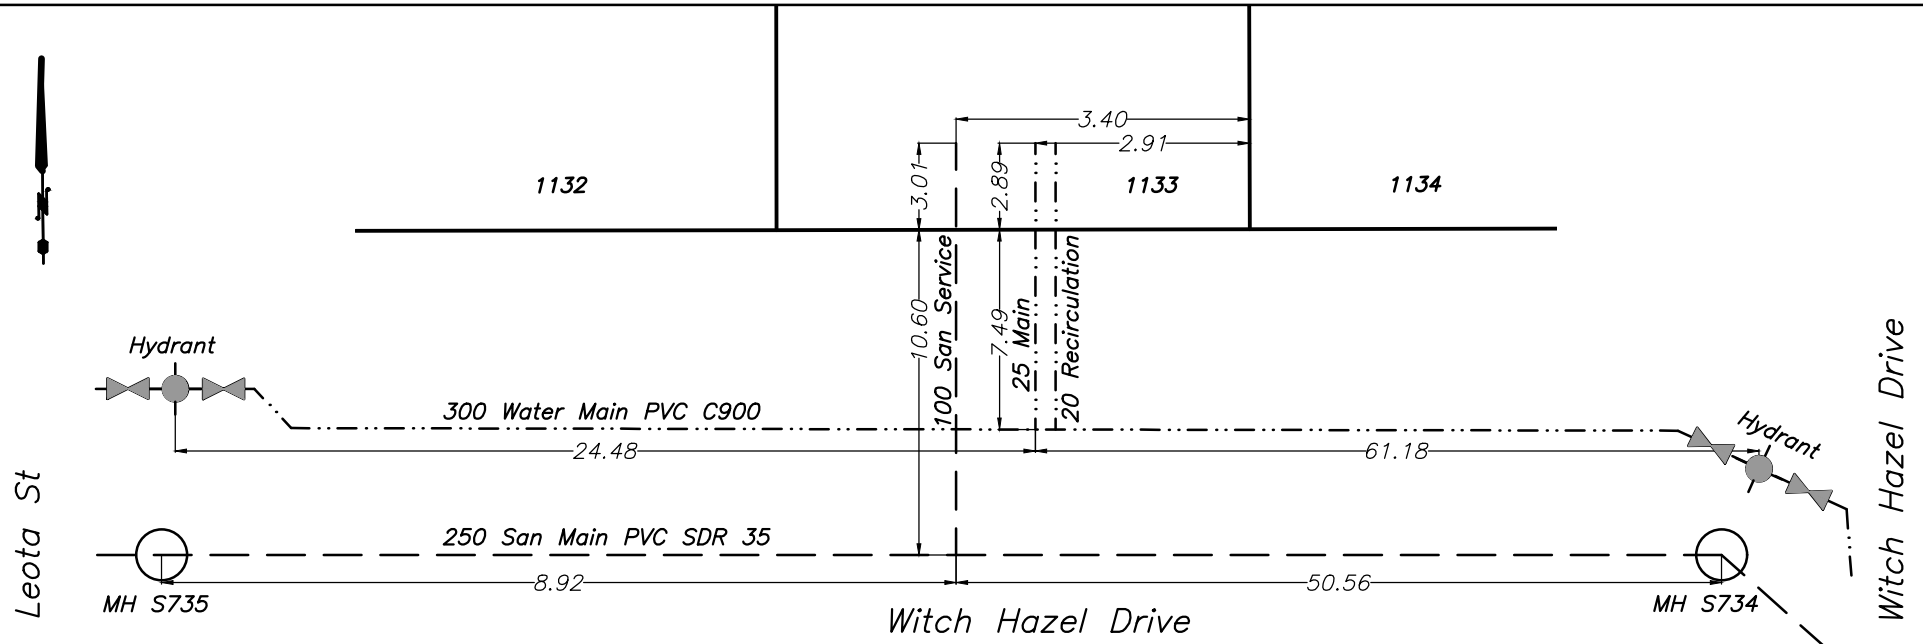




CITY OF WHITEHORSE

SERVICE CONNECTION RECORD

NAME Castle Rock Enterprises ADDRESS 319 Witch Hazel Dr BLOCK _____ LOT 1134

DATES	WATER		SEWER
On at Main July 7, 2023	Depth at P/L: 673.73m (2.6m)		Depth at P/L: 673.72m (2.6m)
On at CC	Depth at Main: 673.30m (3.0m)		Depth at Main: 672.40m (4.0m)
Frost Plug	Pipe Size: 25mm/20mm		Pipe Size: 100mm
Memo:	Pipe Material: HDPE	Insul. <u>Yes</u> /No	Pipe Material: PVC
	Length from Main to P/L: 7.42		Length from Main to P/L: 10.49m
			STORM
	Squirt Test: <u>Pass</u> /Fail		Depth at P/L:
	Frost Protection: <u>Recirc</u> /Heat Trace		Depth at Main:
	Continuity Test: n/a		Pipe Size:
	PRV Required: Yes/ <u>No</u>		Pipe Material:
			Length from Main to P/L:

CLEARLY INDICATE LOCATION OF CC AND ROUTE OF PIPES ON DRAWING BELOW

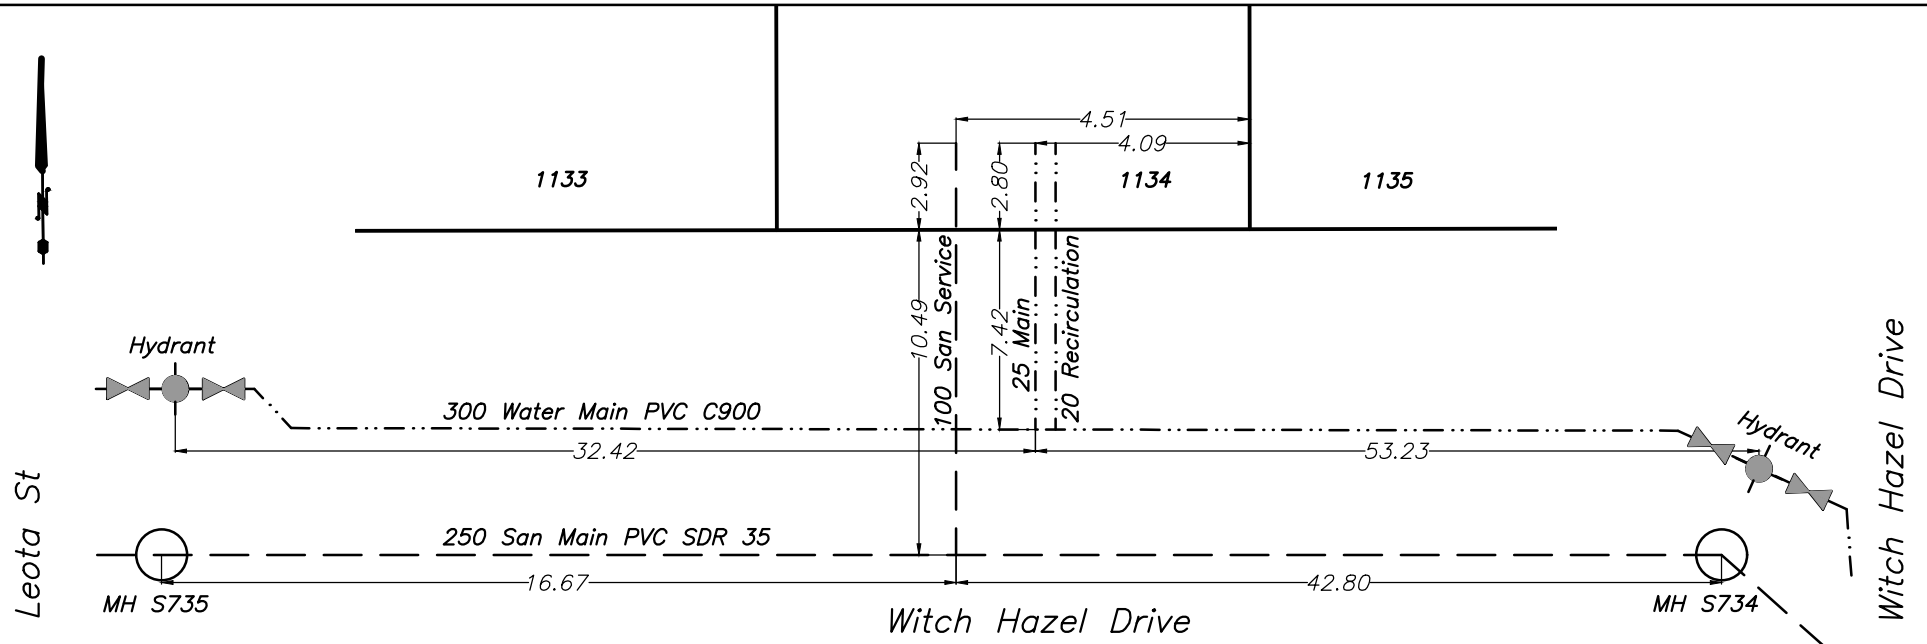




CITY OF WHITEHORSE

SERVICE CONNECTION RECORD

NAME Castle Rock Enterprises ADDRESS 317 Witch Hazel Dr BLOCK _____ LOT 1135

DATES	WATER	SEWER
On at Main July 26, 2023	Depth at P/L: 673.75m (2.6m)	Depth at P/L: 673.69m (2.7m)
On at CC	Depth at Main: 673.32m (3.0m)	Depth at Main: 672.36m (4.1m)
Frost Plug	Pipe Size: 25mm/20mm	Pipe Size: 100mm
Memo:	Pipe Material: HDPE Insul. <u>Yes</u> /No	Pipe Material: PVC Insul. Yes/ <u>No</u>
	Length from Main to P/L: 7.06	Length from Main to P/L: 10.53m
		STORM
	Squirt Test: <u>Pass</u> /Fail	Depth at P/L:
	Frost Protection: <u>Recirc</u> /Heat Trace	Depth at Main:
	Continuity Test: n/a Pass/Fail	Pipe Size:
	PRV Required: Yes/ <u>No</u>	Pipe Material:
		Length from Main to P/L:

CLEARLY INDICATE LOCATION OF CC AND ROUTE OF PIPES ON DRAWING BELOW

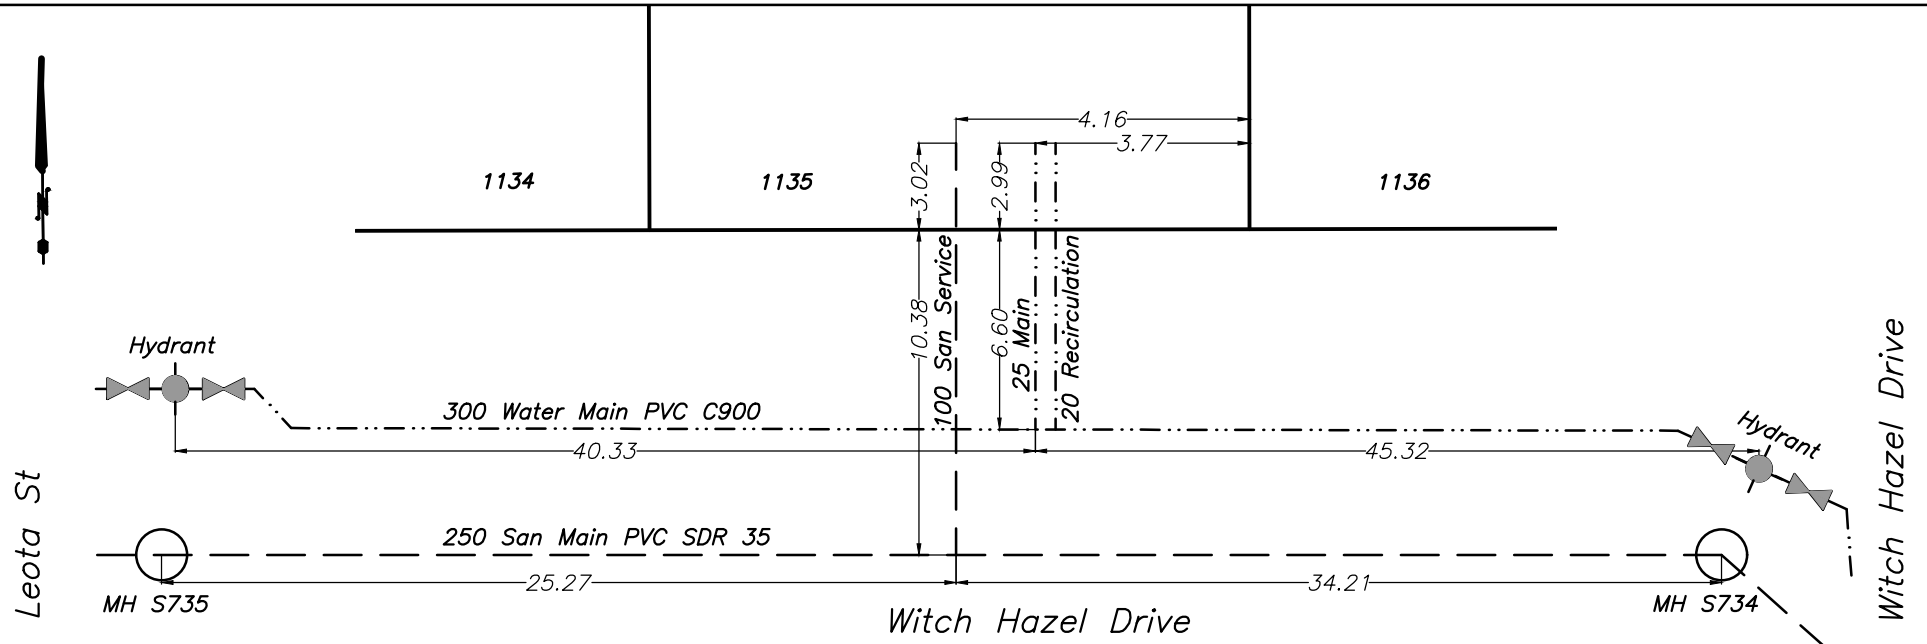




CITY OF WHITEHORSE

SERVICE CONNECTION RECORD

NAME Castle Rock Enterprises ADDRESS 315 Witch Hazel Dr BLOCK _____ LOT 1136

DATES	WATER	SEWER
On at Main August 1, 2023	Depth at P/L: 673.77m (2.7m)	Depth at P/L: 673.76m (2.7m)
On at CC	Depth at Main: 673.33m (3.1m)	Depth at Main: 672.30m (4.2m)
Frost Plug	Pipe Size: 25mm/20mm	Pipe Size: 100mm
Memo:	Pipe Material: HDPE Insul. <u>Yes</u> /No	Pipe Material: PVC Insul. Yes/ <u>No</u>
	Length from Main to P/L: 6.60m	Length from Main to P/L: 10.38m
		STORM
	Squirt Test: <u>Pass</u> /Fail	Depth at P/L:
	Frost Protection: <u>Recirc</u> /Heat Trace	Depth at Main:
	Continuity Test: n/a Pass/Fail	Pipe Size:
	PRV Required: Yes/ <u>No</u>	Pipe Material:
		Length from Main to P/L:

CLEARLY INDICATE LOCATION OF CC AND ROUTE OF PIPES ON DRAWING BELOW

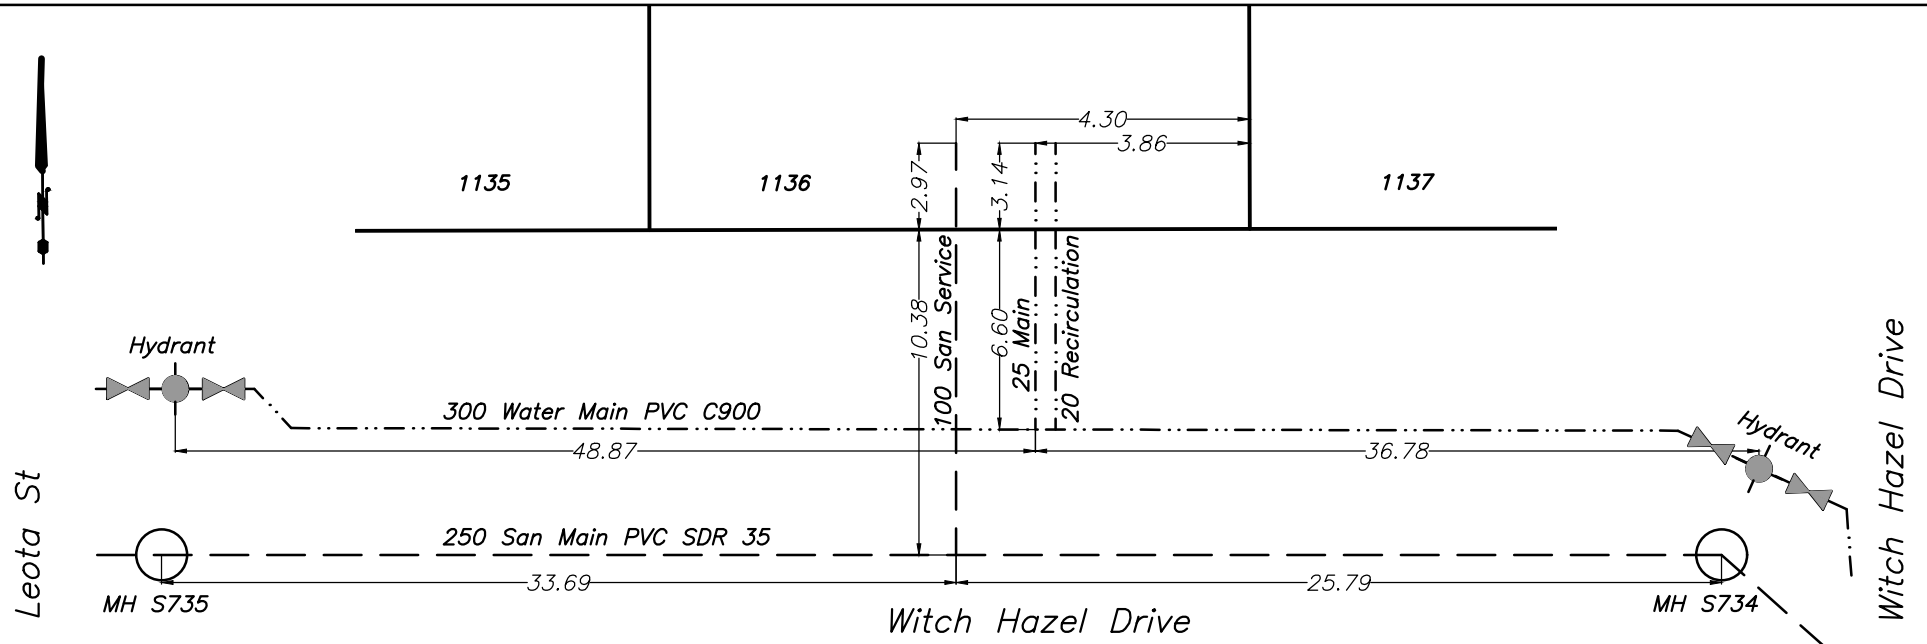




CITY OF WHITEHORSE

SERVICE CONNECTION RECORD

NAME Castle Rock Enterprises ADDRESS 313 Witch Hazel Dr BLOCK _____ LOT 1137

DATES	WATER	SEWER
On at Main July 28, 2023	Depth at P/L: 673.81m (2.7m)	Depth at P/L: 673.78m (2.7m)
On at CC	Depth at Main: 673.38m (3.1m)	Depth at Main: 672.26m (4.3m)
Frost Plug	Pipe Size: 25mm/20mm	Pipe Size: 100mm
Memo:	Pipe Material: HDPE Insul. <u>Yes</u> /No	Pipe Material: PVC Insul. Yes/ <u>No</u>
	Length from Main to P/L: 6.39m	Length from Main to P/L: 10.44m
		STORM
	Squirt Test: <u>Pass</u> /Fail	Depth at P/L:
	Frost Protection: <u>Recirc</u> /Heat Trace	Depth at Main:
	Continuity Test: n/a Pass/Fail	Pipe Size:
	PRV Required: Yes/ <u>No</u>	Pipe Material:
		Length from Main to P/L:

CLEARLY INDICATE LOCATION OF CC AND ROUTE OF PIPES ON DRAWING BELOW

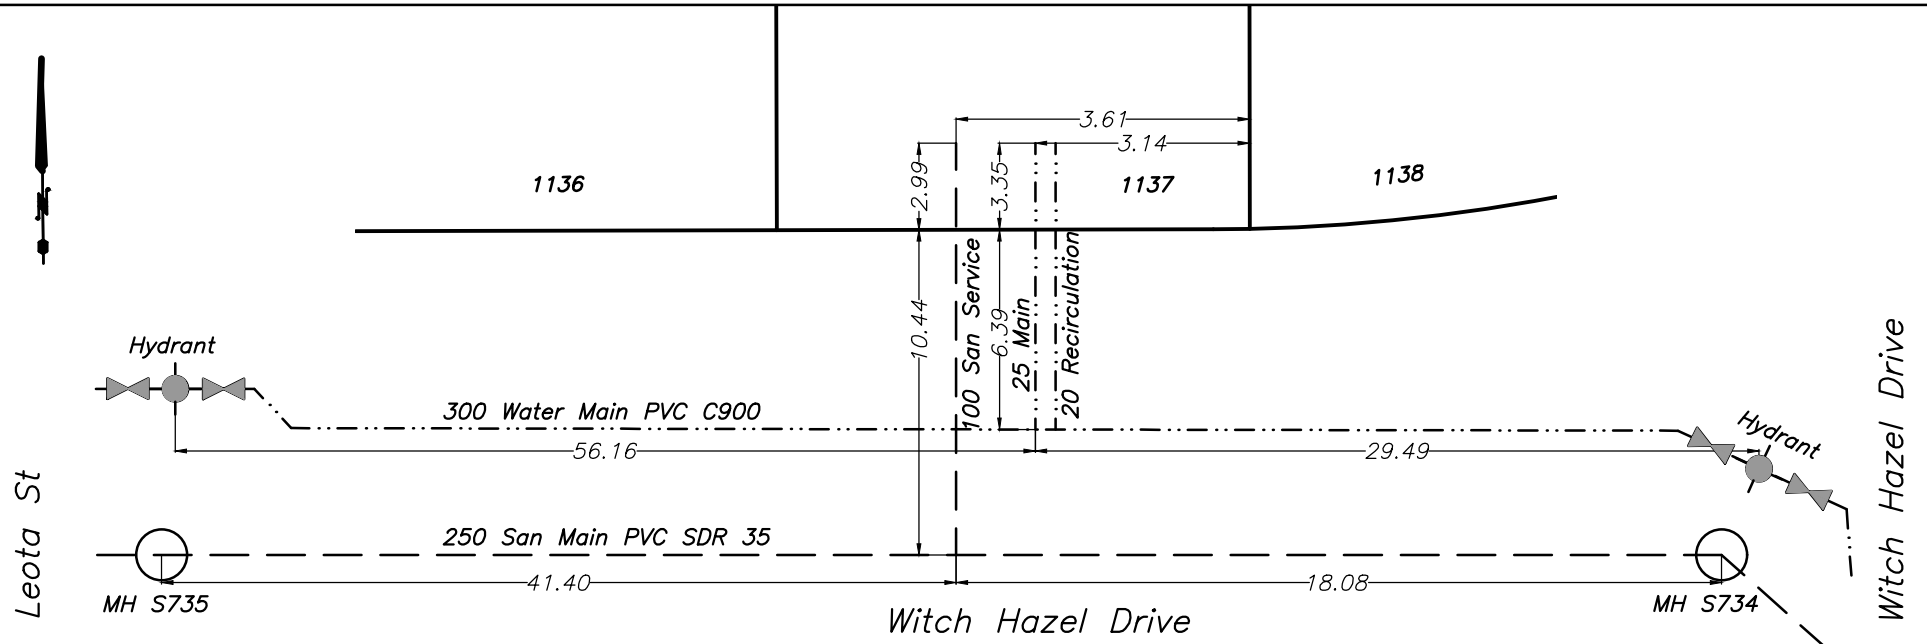




CITY OF WHITEHORSE

SERVICE CONNECTION RECORD

NAME Castle Rock Enterprises ADDRESS 311 Witch Hazel Dr BLOCK _____ LOT 1138

DATES	WATER	SEWER
On at Main July 7, 2023	Depth at P/L: 673.96m (2.6m)	Depth at P/L: 673.91m (2.6m)
On at CC	Depth at Main: 673.43m (3.1m)	Depth at Main: 672.24m (4.3m)
Frost Plug	Pipe Size: 25mm/20mm	Pipe Size: 100mm
Memo:	Pipe Material: HDPE Insul. <u>Yes</u> /No	Pipe Material: PVC Insul. Yes/ <u>No</u>
	Length from Main to P/L: 7.29m	Length from Main to P/L: 11.16m
		STORM
	Squirt Test: <u>Pass</u> /Fail	Depth at P/L:
	Frost Protection: <u>Recirc</u> /Heat Trace	Depth at Main:
	Continuity Test: n/a Pass/Fail	Pipe Size:
	PRV Required: Yes/ <u>No</u>	Pipe Material:
		Length from Main to P/L:

CLEARLY INDICATE LOCATION OF CC AND ROUTE OF PIPES ON DRAWING BELOW

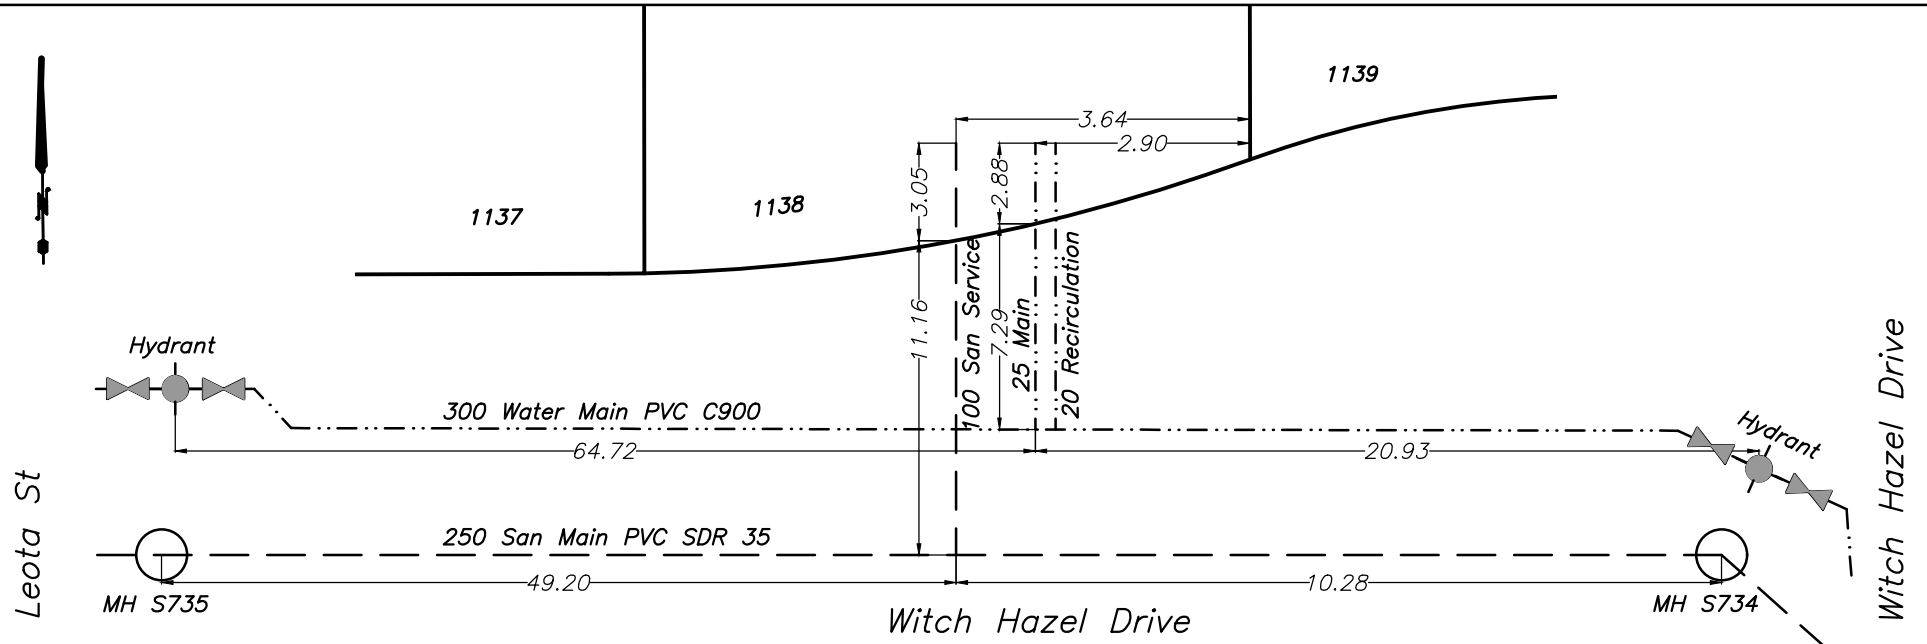




CITY OF WHITEHORSE

SERVICE CONNECTION RECORD

NAME Castle Rock Enterprises ADDRESS 309 Witch Hazel Dr BLOCK _____ LOT 1139

DATES	WATER	SEWER
On at Main July 18, 2023	Depth at P/L: 673.42m (3.3m)	Depth at P/L: 673.47m (3.2m)
On at CC	Depth at Main: 673.40m (3.1m)	Depth at Main: 672.85m (4.3m)
Frost Plug	Pipe Size: 50mm/20mm	Pipe Size: 150mm
Memo:	Pipe Material: HDPE	Pipe Material: PVC
	Insul. <u>Yes</u> /No	Insul. Yes/ <u>No</u>
	Length from Main to P/L: 8.91m	Length from Main to P/L: 11.90m
		STORM
	Squirt Test: <u>Pass</u> /Fail	Depth at P/L:
	Frost Protection: <u>Recirc</u> /Heat Trace	Depth at Main:
	Continuity Test: n/a	Pipe Size:
	PRV Required: Yes/ <u>No</u>	Pipe Material:
		Length from Main to P/L:

CLEARLY INDICATE LOCATION OF CC AND ROUTE OF PIPES ON DRAWING BELOW

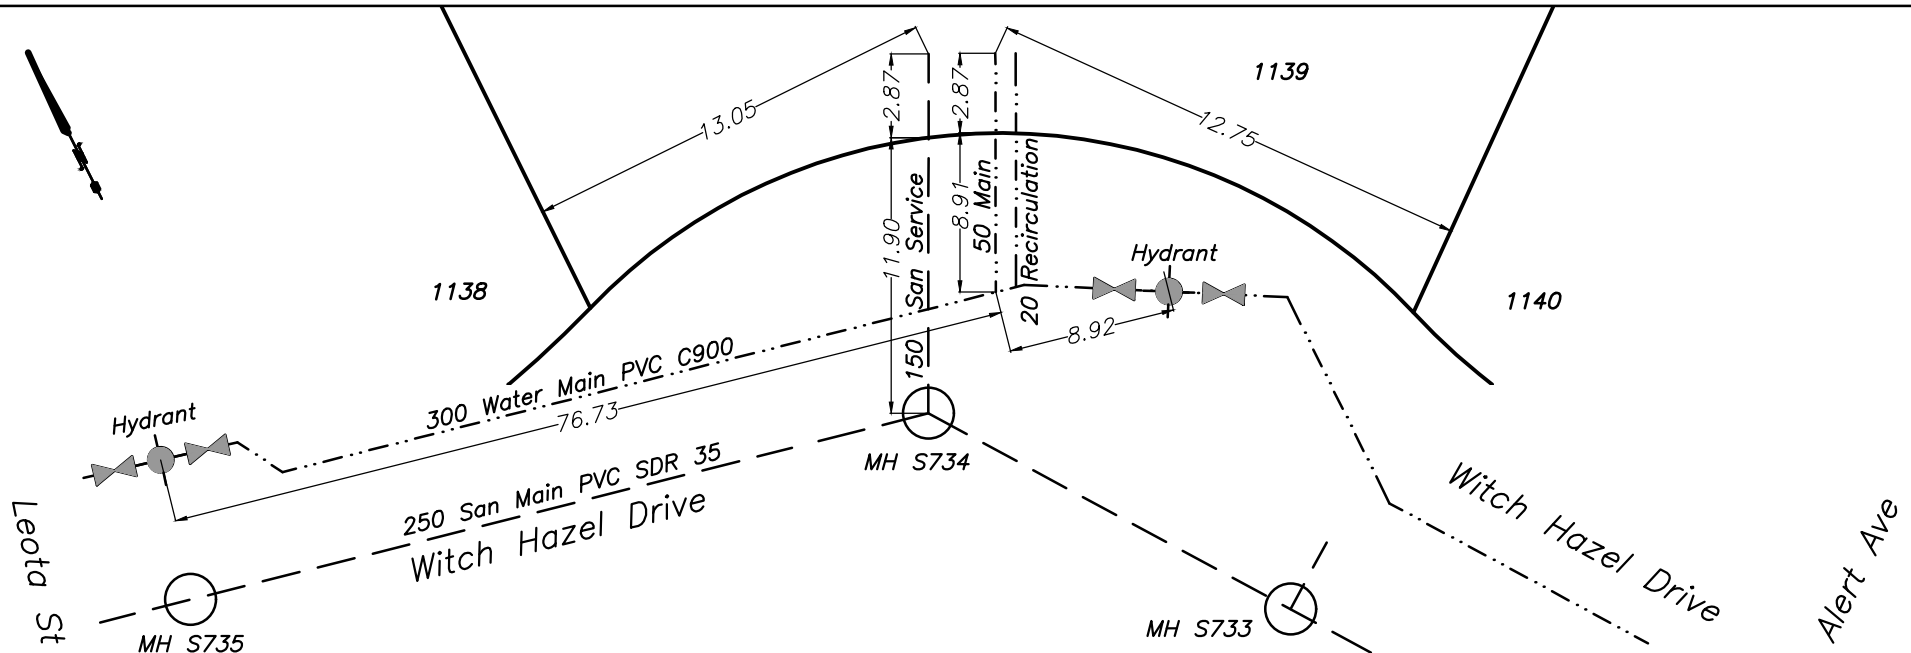




CITY OF WHITEHORSE

SERVICE CONNECTION RECORD

NAME Castle Rock Enterprises ADDRESS 305 Witch Hazel Dr BLOCK _____ LOT 1140

DATES	WATER	SEWER
On at Main July 28, 2023	Depth at P/L: 674.03m (2.6m)	Depth at P/L: 673.98m (2.7m)
On at CC	Depth at Main: 673.49m (3.1m)	Depth at Main: 672.10m (4.6m)
Frost Plug	Pipe Size: 25mm/20mm	Pipe Size: 100mm
Memo:	Pipe Material: HDPE	Pipe Material: PVC
	Insul. <u>Yes</u> /No	Insul. Yes/ <u>No</u>
	Length from Main to P/L: 4.50m	Length from Main to P/L: 10.70m
		STORM
	Squirt Test: <u>Pass</u> /Fail	Depth at P/L:
	Frost Protection: <u>Recirc</u> /Heat Trace	Depth at Main:
	Continuity Test: n/a	Pipe Size:
	PRV Required: Yes/ <u>No</u>	Pipe Material:
		Length from Main to P/L:

CLEARLY INDICATE LOCATION OF CC AND ROUTE OF PIPES ON DRAWING BELOW

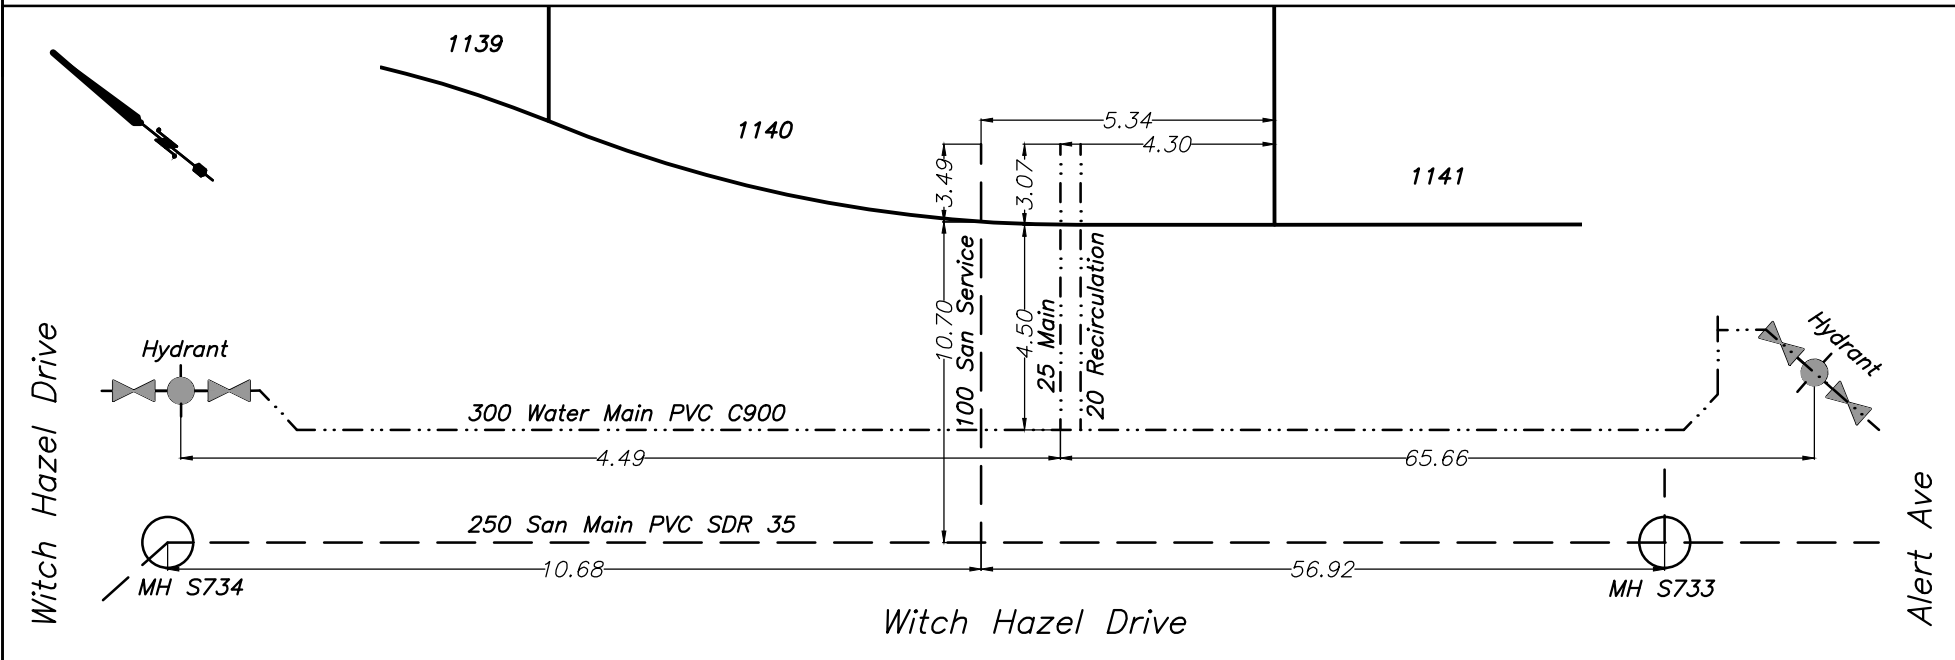




CITY OF WHITEHORSE

SERVICE CONNECTION RECORD

NAME Castle Rock Enterprises ADDRESS 303 Witch Hazel Dr BLOCK LOT 1141

DATES	WATER	SEWER
On at Main July 26, 2023	Depth at P/L: 673.95m (2.8m)	Depth at P/L: 673.98m (2.7m)
On at CC	Depth at Main: 673.53m (3.1m)	Depth at Main: 672.08m (4.7m)
Frost Plug	Pipe Size: 25mm/20mm	Pipe Size: 100mm
Memo:	Pipe Material: HDPE	Pipe Material: PVC
	Insul. <u>Yes</u> /No	Insul. Yes/ <u>No</u>
	Length from Main to P/L: 7.54m	Length from Main to P/L: 10.48m
		STORM
	Squirt Test: <u>Pass</u> /Fail	Depth at P/L:
	Frost Protection: <u>Recirc</u> /Heat Trace	Depth at Main:
	Continuity Test: n/a	Pipe Size:
	PRV Required: Yes/ <u>No</u>	Pipe Material:
		Length from Main to P/L:

CLEARLY INDICATE LOCATION OF CC AND ROUTE OF PIPES ON DRAWING BELOW

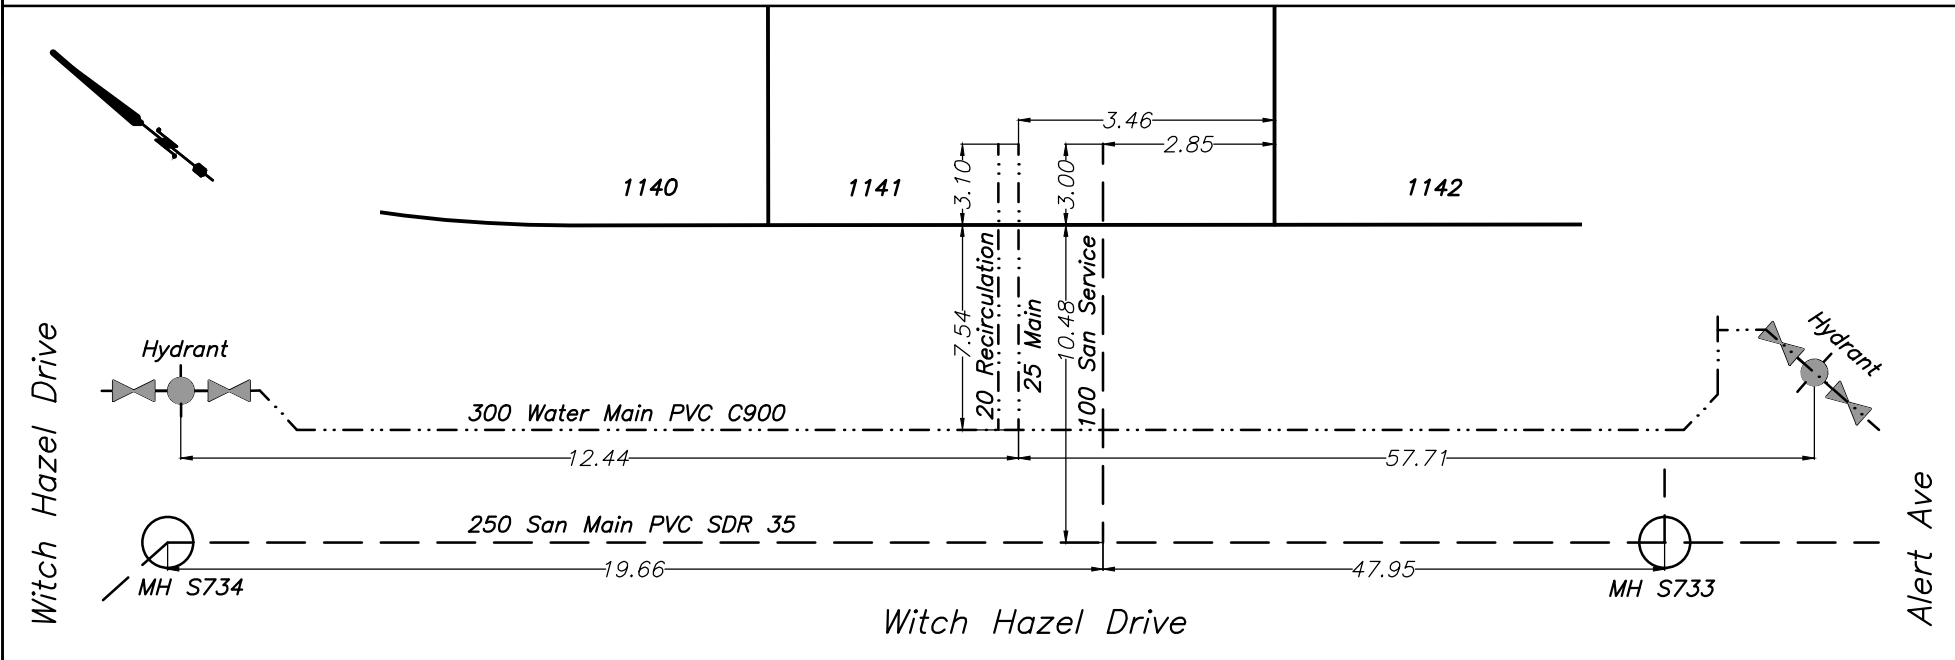




CITY OF WHITEHORSE

SERVICE CONNECTION RECORD

NAME Castle Rock Enterprises ADDRESS 301 Witch Hazel Dr BLOCK _____ LOT 1142

DATES	WATER	SEWER
On at Main July 6, 2023	Depth at P/L: 674.17m (2.6m)	Depth at P/L: 674.14m (2.6m)
On at CC	Depth at Main: 673.62m (3.1m)	Depth at Main: 672.04m (4.8m)
Frost Plug	Pipe Size: 25mm/20mm	Pipe Size: 100mm
Memo:	Pipe Material: HDPE Insul. <u>Yes</u> /No	Pipe Material: PVC Insul. Yes/ <u>No</u>
	Length from Main to P/L: 7.61m	Length from Main to P/L: 10.74m
		STORM
	Squirt Test: <u>Pass</u> /Fail	Depth at P/L:
	Frost Protection: <u>Recirc</u> /Heat Trace	Depth at Main:
	Continuity Test: n/a Pass/Fail	Pipe Size:
	PRV Required: Yes/ <u>No</u>	Pipe Material:
		Length from Main to P/L:

CLEARLY INDICATE LOCATION OF CC AND ROUTE OF PIPES ON DRAWING BELOW

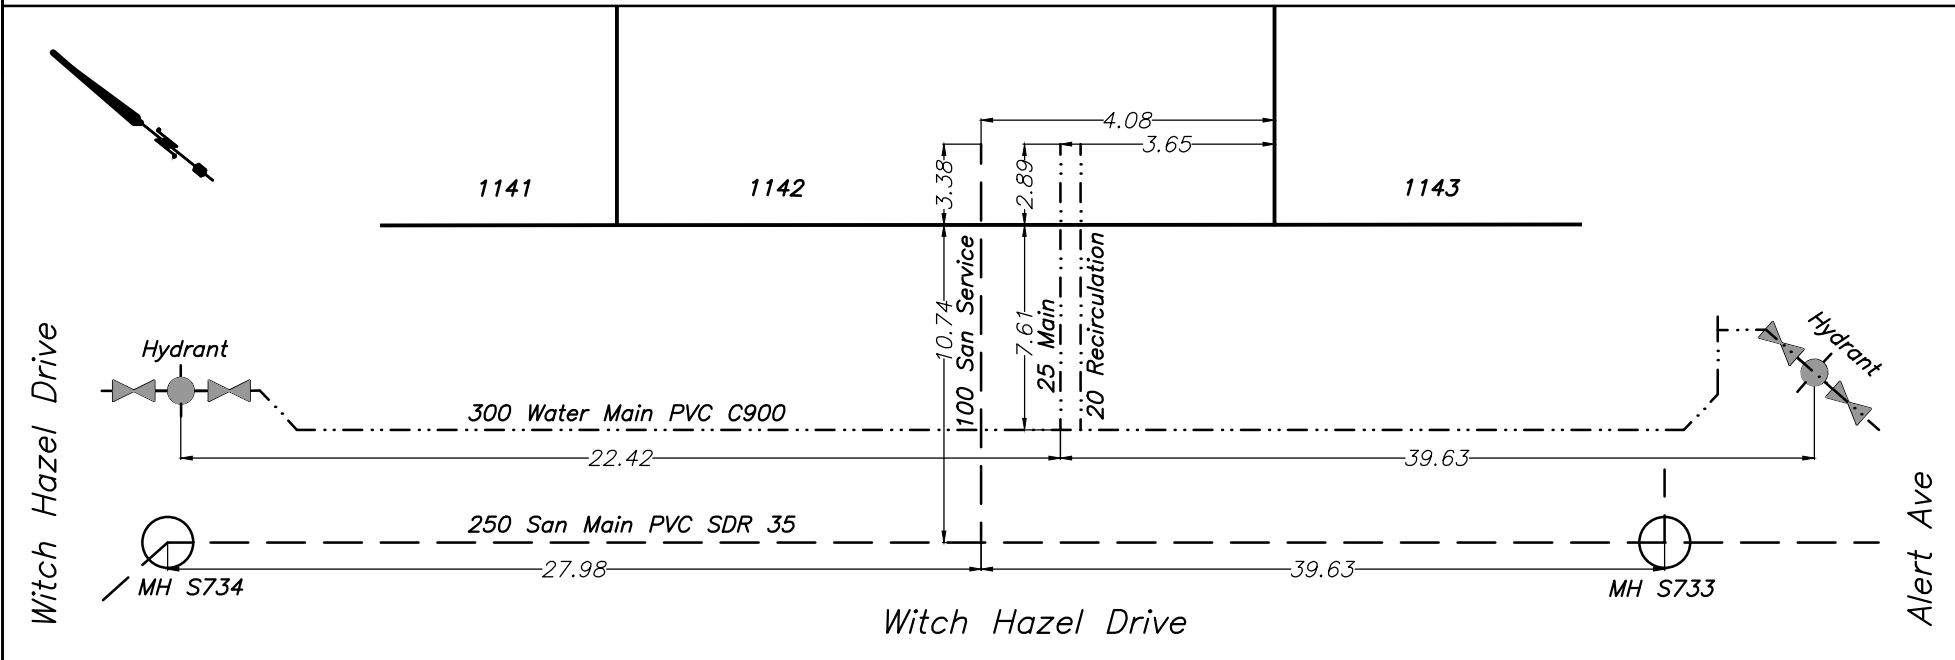




CITY OF WHITEHORSE

SERVICE CONNECTION RECORD

NAME Castle Rock Enterprises ADDRESS 299 Witch Hazel Dr BLOCK LOT 1143

DATES	WATER		SEWER
On at Main July 5, 2023	Depth at P/L: 674.16m (2.6m)		Depth at P/L: 674.09m (2.7m)
On at CC	Depth at Main: 673.66m (3.1m)		Depth at Main: 672.02m (4.8m)
Frost Plug	Pipe Size: 25mm/20mm		Pipe Size: 100mm
Memo:	Pipe Material: HDPE	Insul. <u>Yes</u> /No	Pipe Material: PVC
	Length from Main to P/L: 7.59m		Length from Main to P/L: 10.66m
			STORM
	Squirt Test: <u>Pass</u> /Fail		Depth at P/L:
	Frost Protection: <u>Recirc</u> /Heat Trace		Depth at Main:
	Continuity Test: n/a		Pipe Size:
	PRV Required: Yes/ <u>No</u>		Pipe Material:
			Length from Main to P/L:

CLEARLY INDICATE LOCATION OF CC AND ROUTE OF PIPES ON DRAWING BELOW

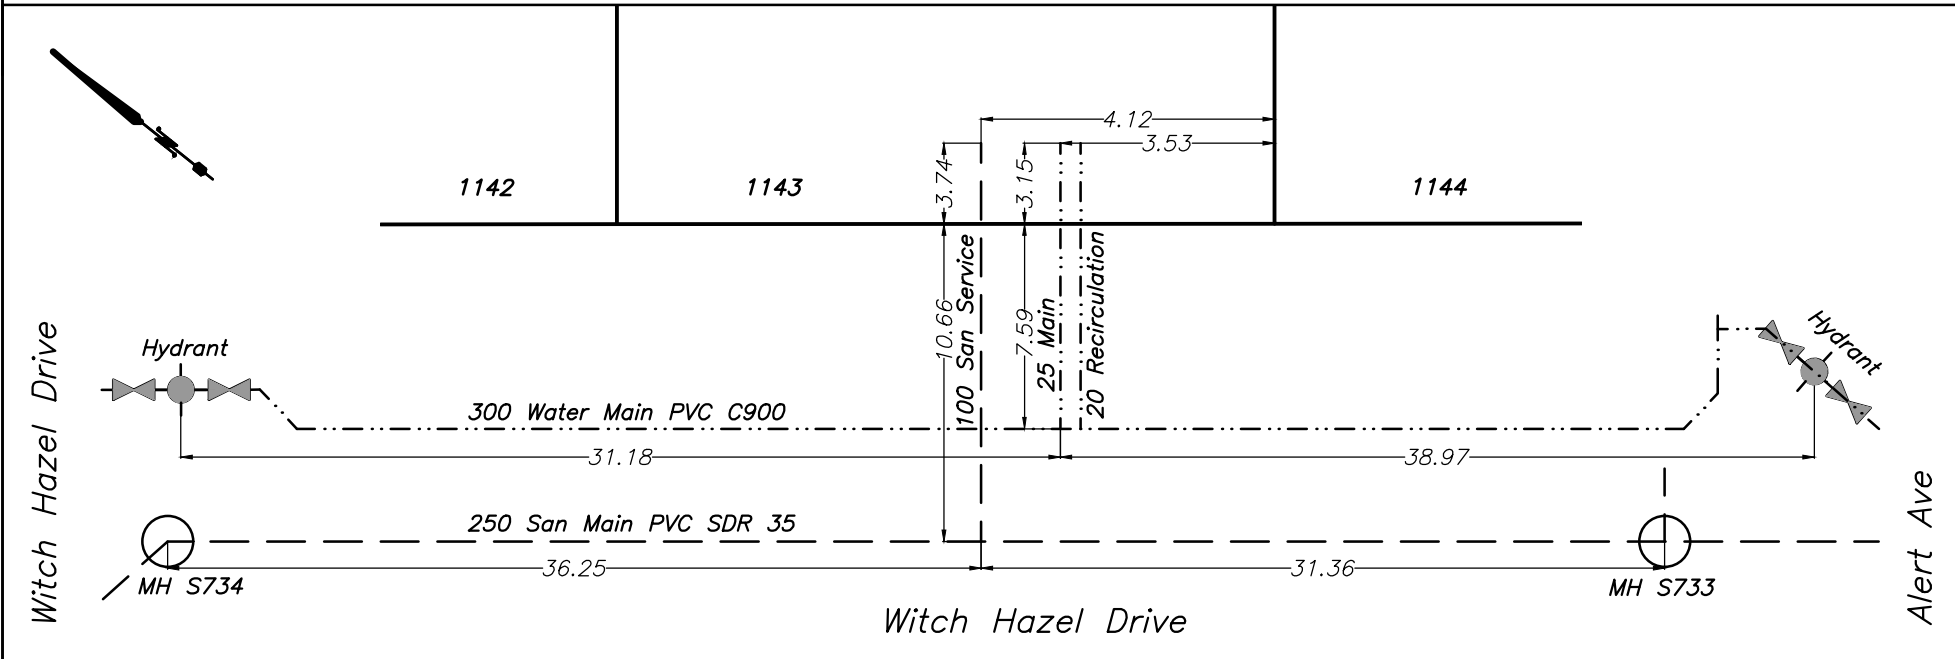




CITY OF WHITEHORSE

SERVICE CONNECTION RECORD

NAME Castle Rock Enterprises ADDRESS 297 Witch Hazel Dr BLOCK _____ LOT 1144

DATES	WATER		SEWER
On at Main June 27, 2023	Depth at P/L: 674.21m (2.6m)		Depth at P/L: 674.21m (2.6m)
On at CC	Depth at Main: 673.74m (3.1m)		Depth at Main: 672.00m (4.9m)
Frost Plug	Pipe Size: 25mm/20mm		Pipe Size: 100mm
Memo:	Pipe Material: HDPE	Insul. <u>Yes</u> /No	Pipe Material: PVC
	Length from Main to P/L: 7.69m		Length from Main to P/L: 11.56m
			STORM
	Squirt Test: <u>Pass</u> /Fail		Depth at P/L:
	Frost Protection: <u>Recirc</u> /Heat Trace		Depth at Main:
	Continuity Test: n/a		Pipe Size:
	PRV Required: Yes/ <u>No</u>		Pipe Material:
			Length from Main to P/L:

CLEARLY INDICATE LOCATION OF CC AND ROUTE OF PIPES ON DRAWING BELOW

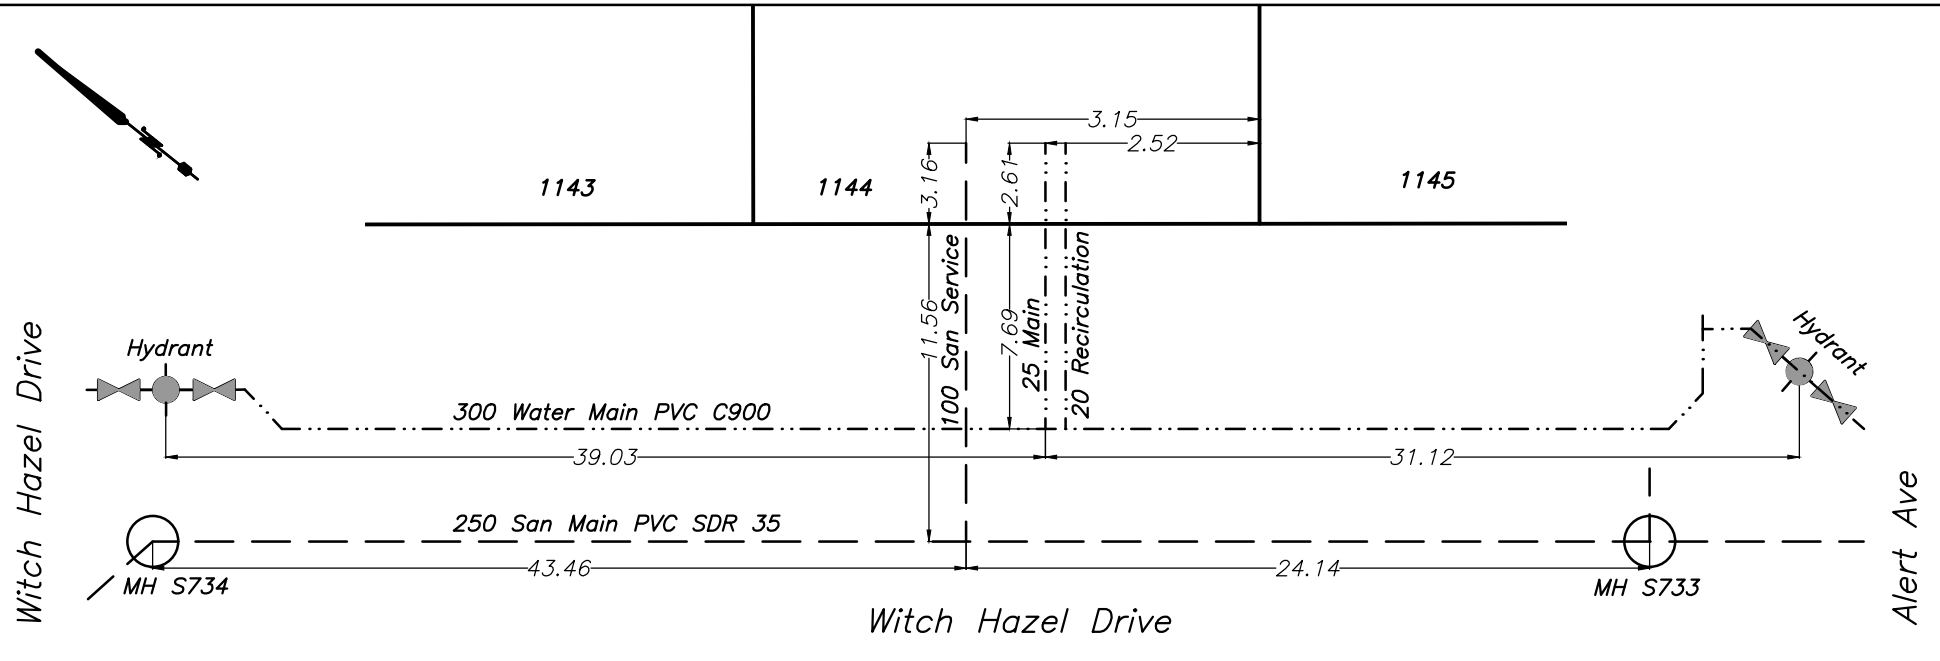




CITY OF WHITEHORSE

SERVICE CONNECTION RECORD

NAME Castle Rock Enterprises ADDRESS 295 Witch Hazel Dr BLOCK LOT 1145

DATES	WATER		SEWER
On at Main July 5, 2023	Depth at P/L: 674.40m (2.5m)		Depth at P/L: 674.34m (2.6m)
On at CC	Depth at Main: 673.78m (3.1m)		Depth at Main: 671.94m (5.0m)
Frost Plug	Pipe Size: 25mm/20mm		Pipe Size: 100mm
Memo:	Pipe Material: HDPE	Insul. <u>Yes</u> /No	Pipe Material: PVC
	Length from Main to P/L: 7.61m		Length from Main to P/L: 11.63m
			STORM
	Squirt Test: <u>Pass</u> /Fail		Depth at P/L:
	Frost Protection: <u>Recirc</u> /Heat Trace		Depth at Main:
	Continuity Test: n/a		Pipe Size:
	PRV Required: Yes/ <u>No</u>		Pipe Material:
			Length from Main to P/L:

CLEARLY INDICATE LOCATION OF CC AND ROUTE OF PIPES ON DRAWING BELOW

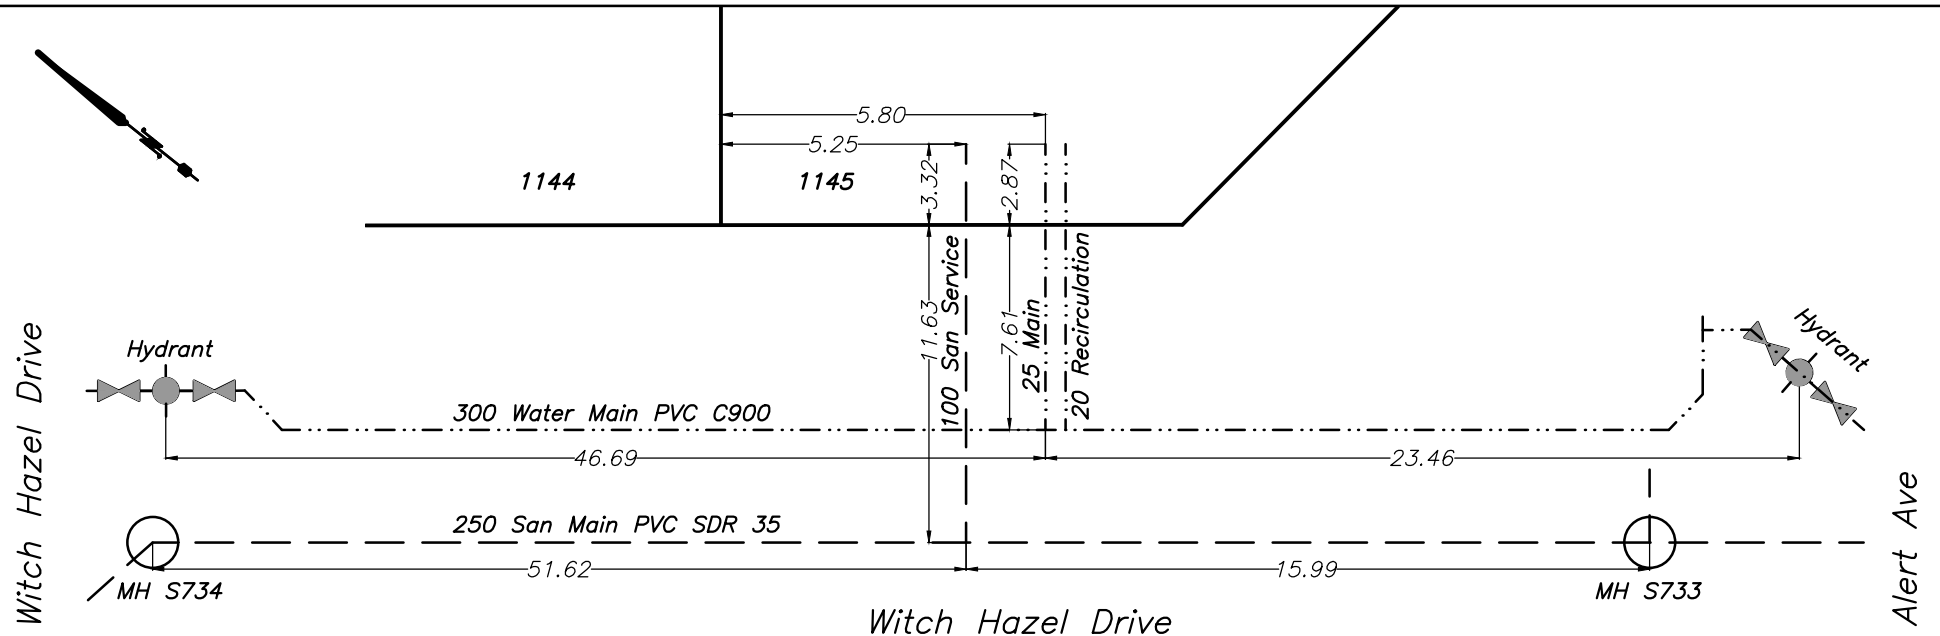



Sanitary Sewer Diagram showing the layout of sanitary sewer lines, manholes, and hydrants. The diagram includes dimensions for pipe lengths and elevations. Key features include MH S735, MH S736, a Hydrant, and various pipe materials and sizes like 250 San Main PVC SDR 35, 20 Recirculation, 25 Main, 100 San Service, and 300 Water Main PVC C900. The diagram is oriented with Witch Hazel Drive on the left and Leota St on the right.




CITY OF WHITEHORSE

SERVICE CONNECTION RECORD

NAME Castle Rock Enterprises ADDRESS 336 Witch Hazel Dr BLOCK LOT 1147

DATES	WATER	SEWER
On at Main July 31, 2023	Depth at P/L: 673.45m (2.5m)	Depth at P/L: 673.38m (2.6m)
On at CC	Depth at Main: 673.06m (2.9m)	Depth at Main: 672.77m (3.2m)
Frost Plug	Pipe Size: 25mm/20mm	Pipe Size: 100mm
Memo:	Pipe Material: HDPE	Pipe Material: PVC
	Insul. <u>Yes</u> /No	Insul. Yes/ <u>No</u>
	Length from Main to P/L: 14.57m	Length from Main to P/L: 11.60m
		STORM
	Squirt Test: <u>Pass</u> /Fail	Depth at P/L:
	Frost Protection: <u>Recirc</u> /Heat Trace	Depth at Main:
	Continuity Test: n/a	Pipe Size:
	PRV Required: Yes/ <u>No</u>	Pipe Material:
		Length from Main to P/L:

CLEARLY INDICATE LOCATION OF CC AND ROUTE OF PIPES ON DRAWING BELOW

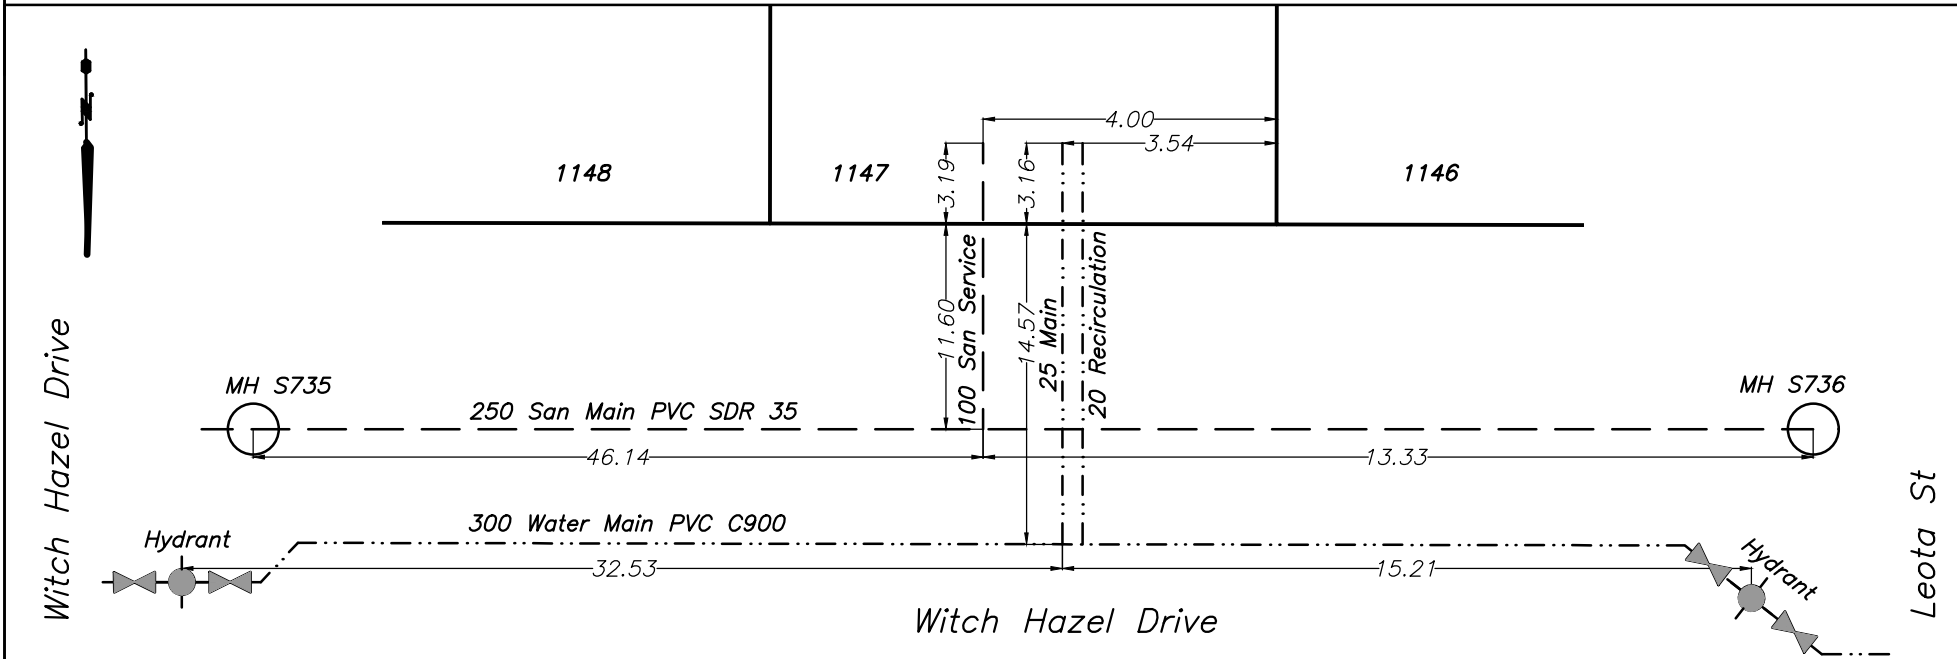




CITY OF WHITEHORSE

SERVICE CONNECTION RECORD

NAME Castle Rock Enterprises ADDRESS 334 Witch Hazel Dr BLOCK LOT 1148

DATES	WATER	SEWER
On at Main August 2, 2023	Depth at P/L: 673.32m (2.7m)	Depth at P/L: 673.29m (2.7m)
On at CC	Depth at Main: 673.09m (2.9m)	Depth at Main: 672.74m (3.3m)
Frost Plug	Pipe Size: 25mm/20mm	Pipe Size: 100mm
Memo:	Pipe Material: HDPE Insul. <u>Yes</u> /No	Pipe Material: PVC Insul. Yes/ <u>No</u>
	Length from Main to P/L: 14.47m	Length from Main to P/L: 11.54m
		STORM
	Squirt Test: <u>Pass</u> /Fail	Depth at P/L:
	Frost Protection: <u>Recirc</u> /Heat Trace	Depth at Main:
	Continuity Test: n/a Pass/Fail	Pipe Size:
	PRV Required: Yes/ <u>No</u>	Pipe Material:
		Length from Main to P/L:

CLEARLY INDICATE LOCATION OF CC AND ROUTE OF PIPES ON DRAWING BELOW

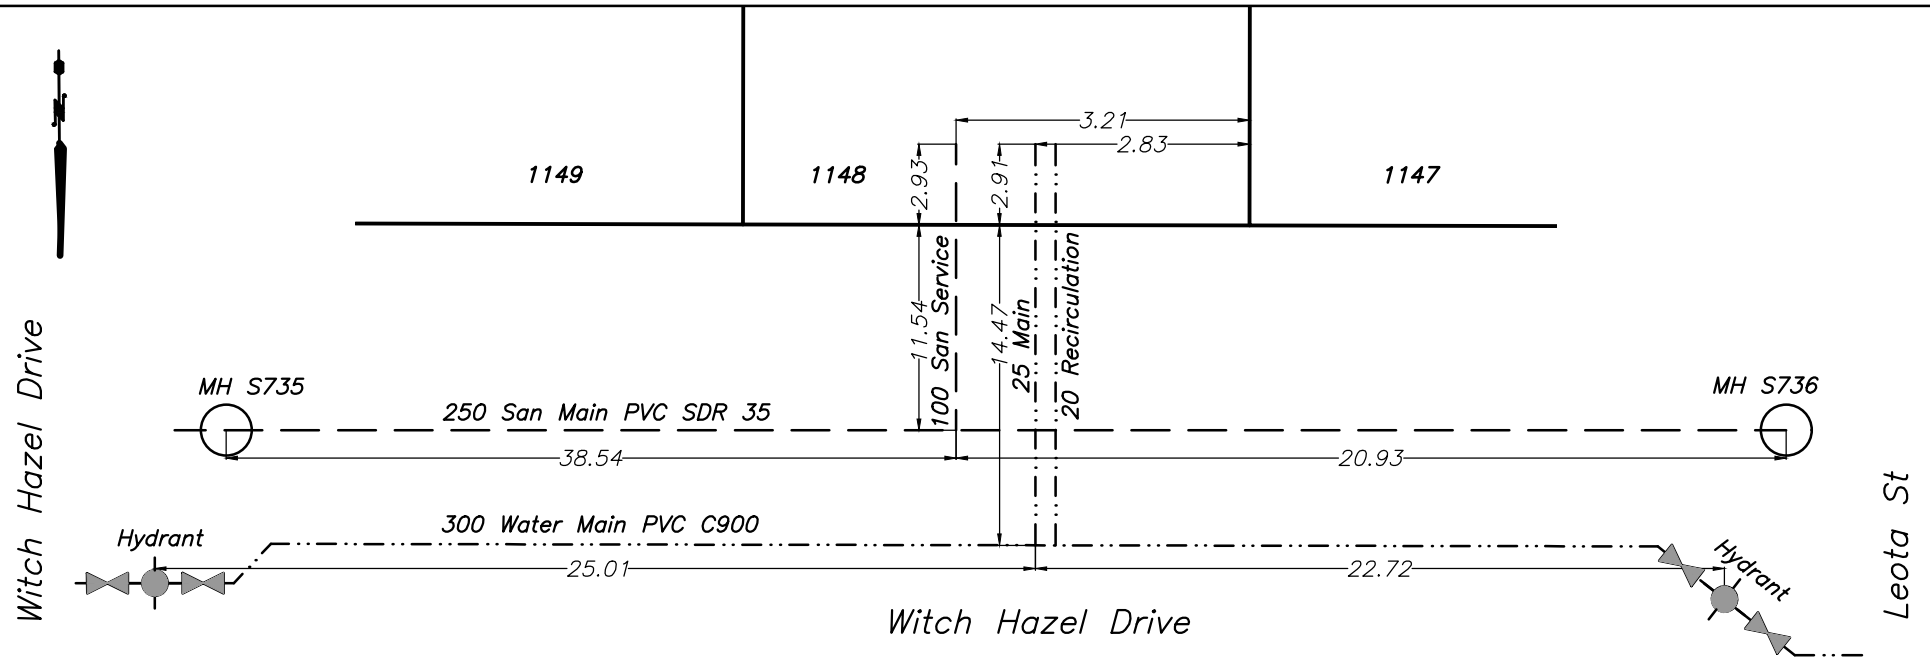




CITY OF WHITEHORSE

SERVICE CONNECTION RECORD

NAME Castle Rock Enterprises ADDRESS 332 Witch Hazel Dr BLOCK _____ LOT 1149

DATES	WATER	SEWER
On at Main July 26, 2023	Depth at P/L: 673.46m (2.6m)	Depth at P/L: 673.35m (2.7m)
On at CC	Depth at Main: 673.10m (2.9m)	Depth at Main: 672.67m (3.4m)
Frost Plug	Pipe Size: 25mm/20mm	Pipe Size: 100mm
Memo:	Pipe Material: HDPE Insul. <u>Yes</u> /No	Pipe Material: PVC Insul. Yes/ <u>No</u>
	Length from Main to P/L: 14.51m	Length from Main to P/L: 11.54m
		STORM
	Squirt Test: <u>Pass</u> /Fail	Depth at P/L:
	Frost Protection: <u>Recirc</u> /Heat Trace	Depth at Main:
	Continuity Test: n/a Pass/Fail	Pipe Size:
	PRV Required: Yes/ <u>No</u>	Pipe Material:
		Length from Main to P/L:

CLEARLY INDICATE LOCATION OF CC AND ROUTE OF PIPES ON DRAWING BELOW

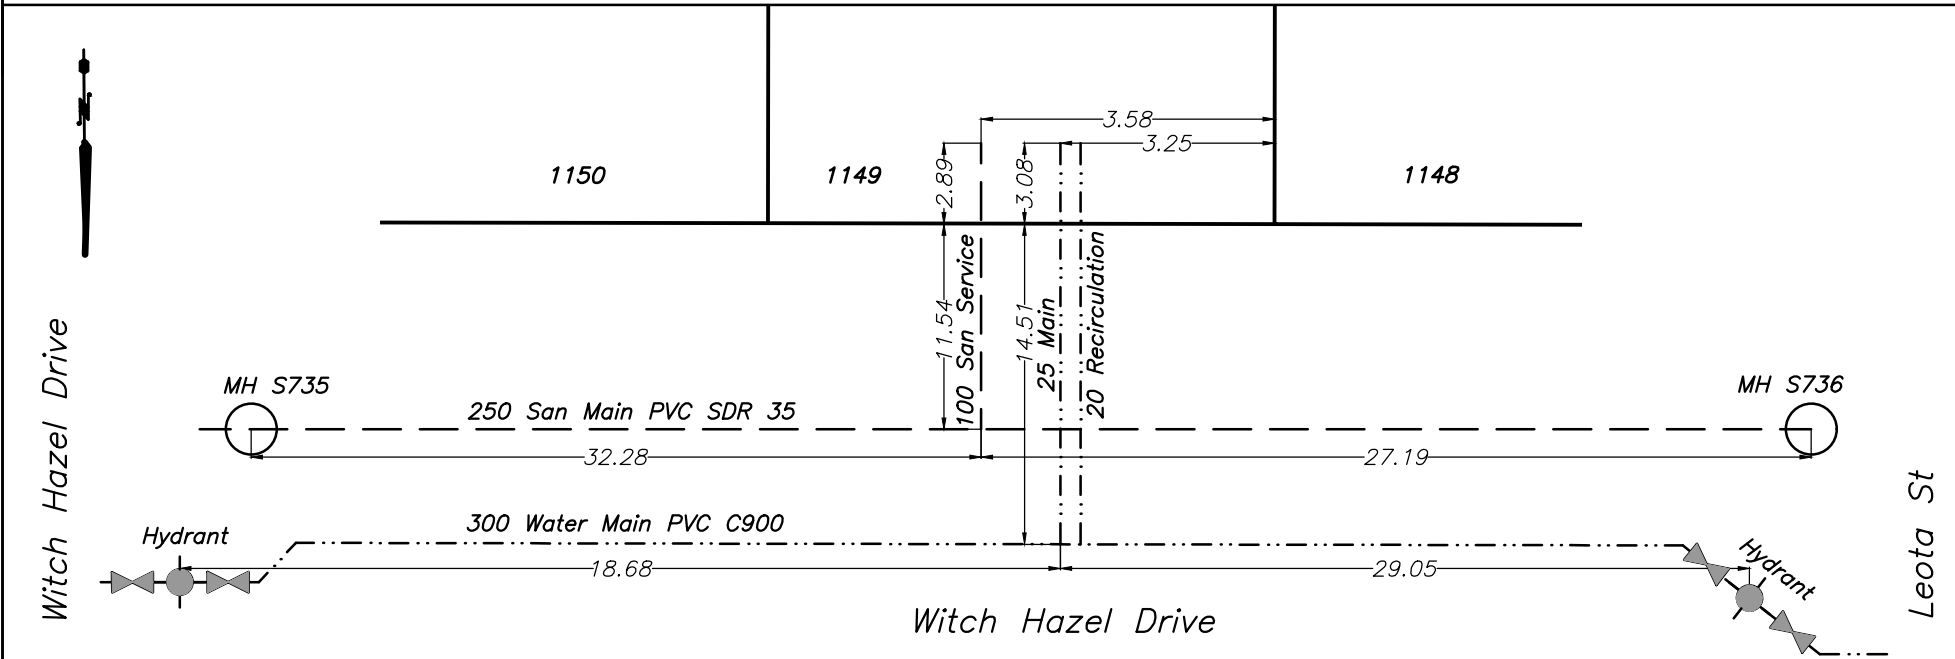




CITY OF WHITEHORSE

SERVICE CONNECTION RECORD

NAME Castle Rock Enterprises ADDRESS 330 Witch Hazel Dr BLOCK _____ LOT 1150

DATES	WATER	SEWER
On at Main July 31, 2023	Depth at P/L: 673.43m (2.6m)	Depth at P/L: 673.33m (2.7m)
On at CC	Depth at Main: 673.12m (2.9m)	Depth at Main: 672.64m (3.5m)
Frost Plug	Pipe Size: 25mm/20mm	Pipe Size: 100mm
Memo:	Pipe Material: HDPE	Pipe Material: PVC
	Insul. <u>Yes</u> /No	Insul. Yes/ <u>No</u>
	Length from Main to P/L: 14.54m	Length from Main to P/L: 11.57m
		STORM
	Squirt Test: <u>Pass</u> /Fail	Depth at P/L:
	Frost Protection: <u>Recirc</u> /Heat Trace	Depth at Main:
	Continuity Test: n/a	Pipe Size:
	PRV Required: Yes/ <u>No</u>	Pipe Material:
		Length from Main to P/L:

CLEARLY INDICATE LOCATION OF CC AND ROUTE OF PIPES ON DRAWING BELOW

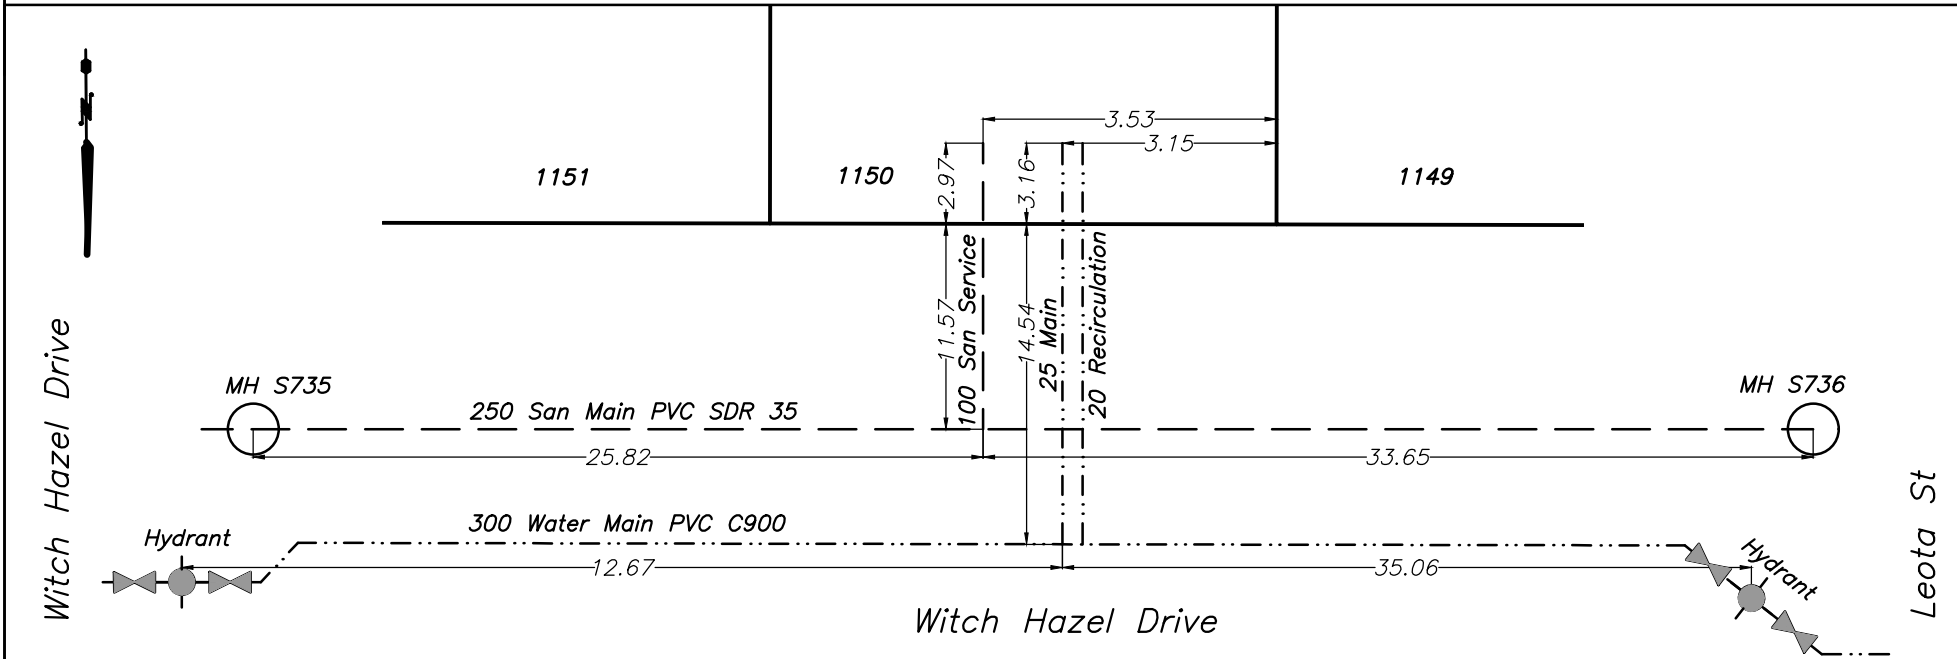




CITY OF WHITEHORSE

SERVICE CONNECTION RECORD

NAME Castle Rock Enterprises ADDRESS 328 Witch Hazel Dr BLOCK _____ LOT 1151

DATES	WATER	SEWER
On at Main July 27, 2023	Depth at P/L: 673.45m (2.7m)	Depth at P/L: 673.42m (2.7m)
On at CC	Depth at Main: 673.13m (2.9m)	Depth at Main: 672.57m (3.6m)
Frost Plug	Pipe Size: 25mm/20mm	Pipe Size: 100mm
Memo:	Pipe Material: HDPE Insul. <u>Yes</u> /No	Pipe Material: PVC Insul. Yes/ <u>No</u>
	Length from Main to P/L: 14.85m	Length from Main to P/L: 11.60m
		STORM
	Squirt Test: <u>Pass</u> /Fail	Depth at P/L:
	Frost Protection: <u>Recirc</u> /Heat Trace	Depth at Main:
	Continuity Test: n/a Pass/Fail	Pipe Size:
	PRV Required: Yes/ <u>No</u>	Pipe Material:
		Length from Main to P/L:

CLEARLY INDICATE LOCATION OF CC AND ROUTE OF PIPES ON DRAWING BELOW

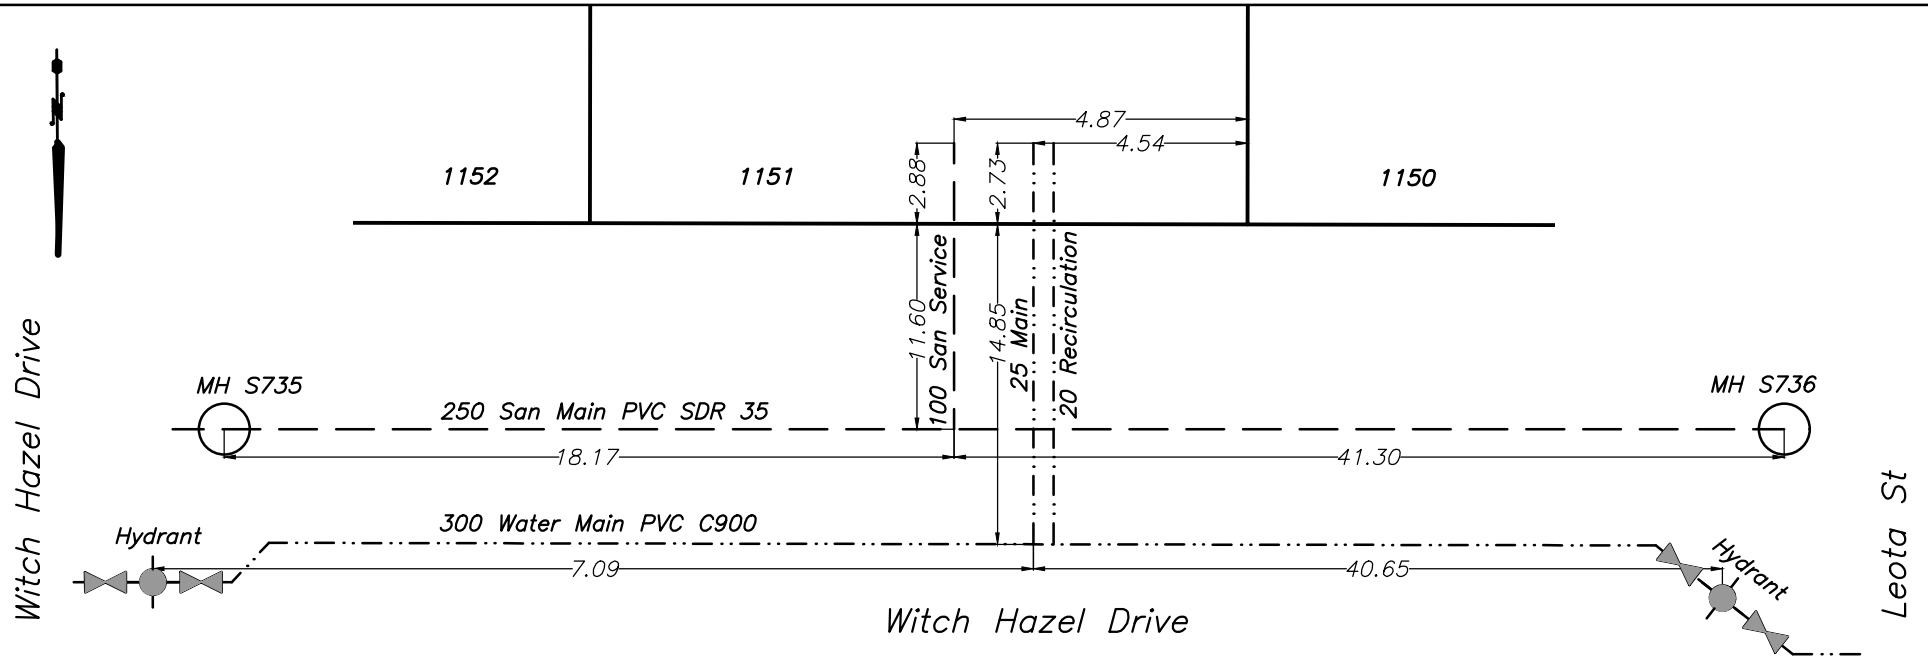




CITY OF WHITEHORSE

SERVICE CONNECTION RECORD

NAME Castle Rock Enterprises ADDRESS 326 Witch Hazel Dr BLOCK LOT 1152

DATES	WATER	SEWER
On at Main July 29, 2023	Depth at P/L: 673.43m (2.7m)	Depth at P/L: 673.46m (2.6m)
On at CC	Depth at Main: 673.21m (3.0m)	Depth at Main: 672.57m (3.6m)
Frost Plug	Pipe Size: 25mm/20mm	Pipe Size: 100mm
Memo:	Pipe Material: HDPE	Pipe Material: PVC
	Insul. <u>Yes</u> /No	Insul. Yes/ <u>No</u>
	Length from Main to P/L: 14.61m	Length from Main to P/L: 11.59m
		STORM
	Squirt Test: <u>Pass</u> /Fail	Depth at P/L:
	Frost Protection: <u>Recirc</u> /Heat Trace	Depth at Main:
	Continuity Test: n/a	Pipe Size:
	PRV Required: Yes/ <u>No</u>	Pipe Material:
		Length from Main to P/L:

CLEARLY INDICATE LOCATION OF CC AND ROUTE OF PIPES ON DRAWING BELOW

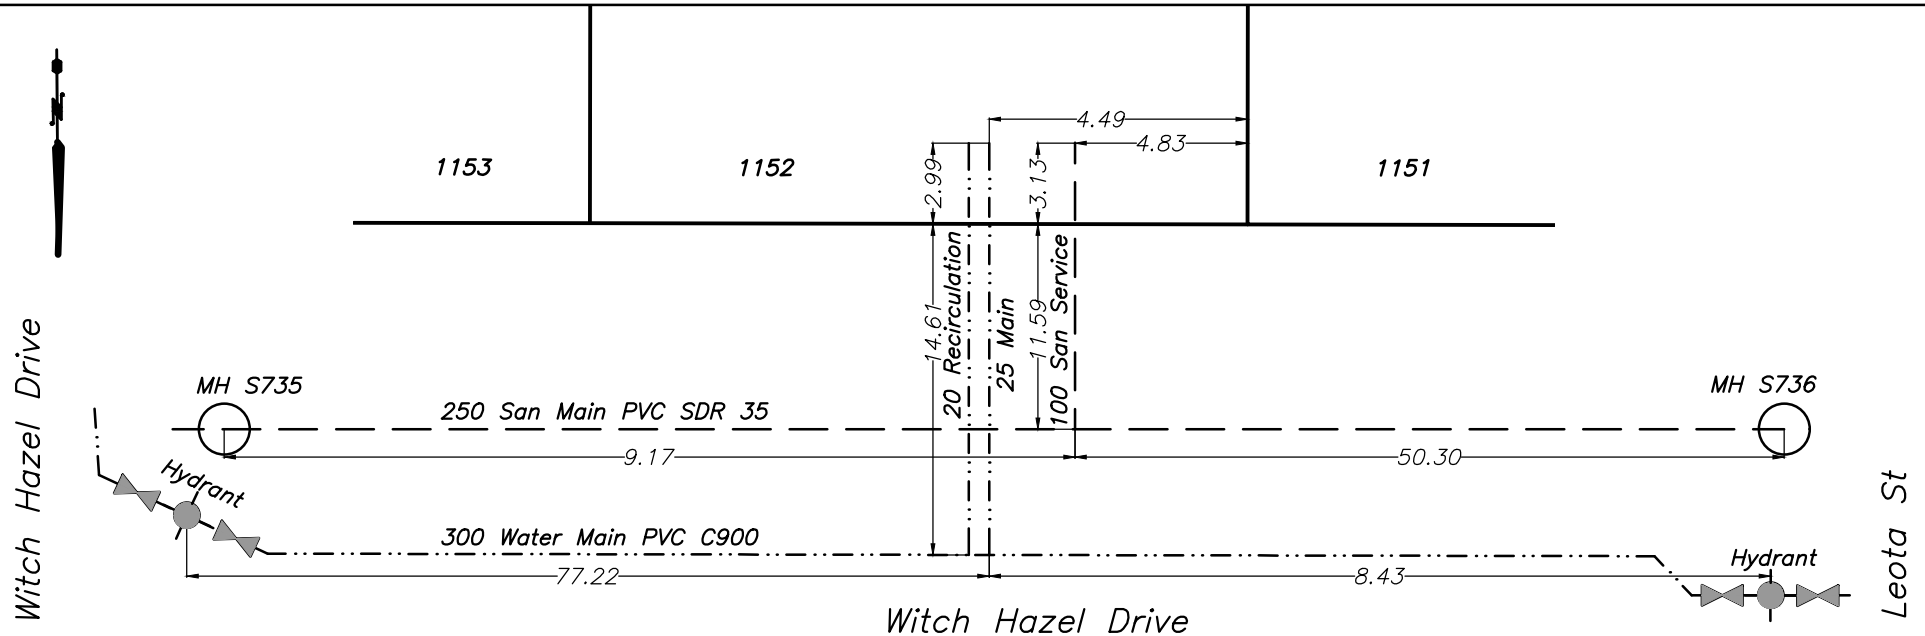




CITY OF WHITEHORSE

SERVICE CONNECTION RECORD

NAME Castle Rock Enterprises ADDRESS 324 Witch Hazel Dr BLOCK _____ LOT 1153

DATES	WATER	SEWER
On at Main July 22, 2023	Depth at P/L: 673.57m (2.6m)	Depth at P/L: 672.95m (3.3m)
On at CC	Depth at Main: 673.19m (3.0m)	Depth at Main: 672.49m (3.8m)
Frost Plug	Pipe Size: 25mm/20mm	Pipe Size: 100mm
Memo:	Pipe Material: HDPE	Pipe Material: PVC
	Insul. <u>Yes</u> /No	Insul. Yes/ <u>No</u>
	Length from Main to P/L: 14.54m	Length from Main to P/L: 11.70m
		STORM
	Squirt Test: <u>Pass</u> /Fail	Depth at P/L:
	Frost Protection: <u>Recirc</u> /Heat Trace	Depth at Main:
	Continuity Test: n/a	Pipe Size:
	PRV Required: Yes/ <u>No</u>	Pipe Material:
		Length from Main to P/L:

CLEARLY INDICATE LOCATION OF CC AND ROUTE OF PIPES ON DRAWING BELOW

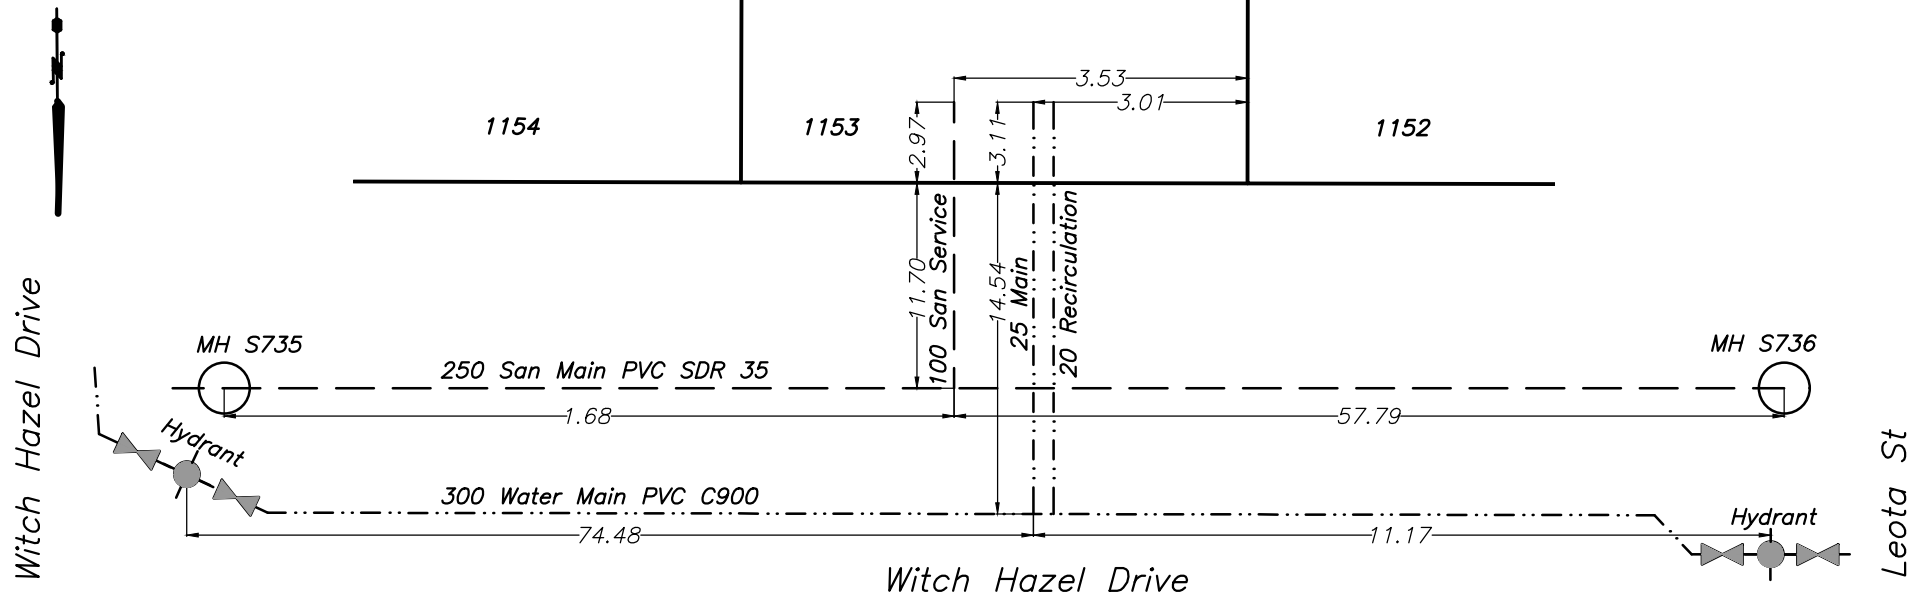




CITY OF WHITEHORSE

SERVICE CONNECTION RECORD

NAME Castle Rock Enterprises ADDRESS 322 Witch Hazel Dr BLOCK LOT 1154

DATES	WATER	SEWER
On at Main July 8, 2023	Depth at P/L: 673.63m (2.6m)	Depth at P/L: 673.61m (2.6m)
On at CC	Depth at Main: 673.23m (3.0m)	Depth at Main: 672.46m (3.8m)
Frost Plug	Pipe Size: 25mm/20mm	Pipe Size: 100mm
Memo:	Pipe Material: HDPE	Pipe Material: PVC
	Insul. <u>Yes</u> /No	Insul. Yes/ <u>No</u>
	Length from Main to P/L: 14.65m	Length from Main to P/L: 11.84m
		STORM
	Squirt Test: <u>Pass</u> /Fail	Depth at P/L:
	Frost Protection: <u>Recirc</u> /Heat Trace	Depth at Main:
	Continuity Test: n/a	Pipe Size:
	PRV Required: Yes/ <u>No</u>	Pipe Material:
		Length from Main to P/L:

CLEARLY INDICATE LOCATION OF CC AND ROUTE OF PIPES ON DRAWING BELOW

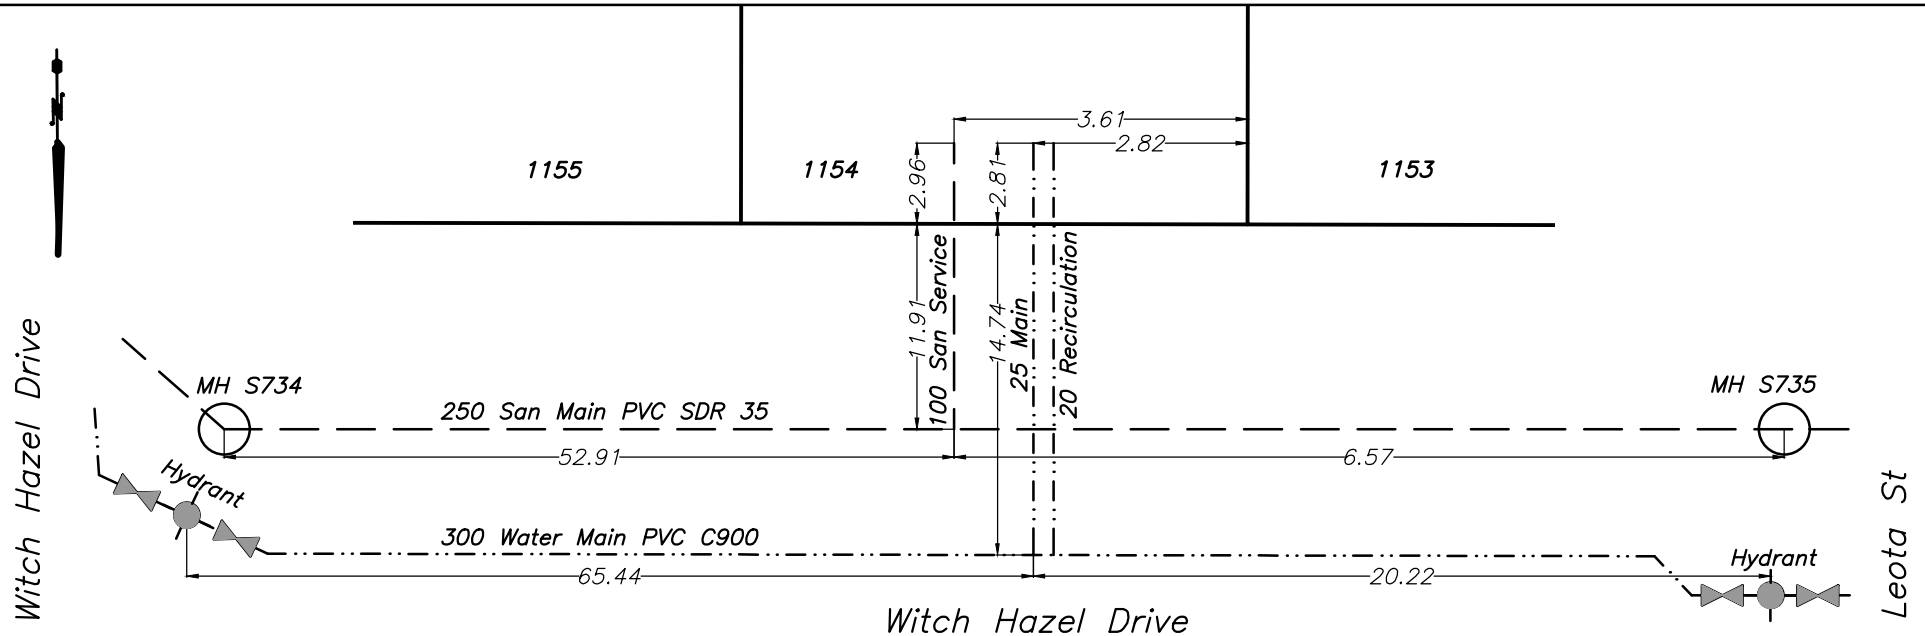




CITY OF WHITEHORSE

SERVICE CONNECTION RECORD

NAME Castle Rock Enterprises ADDRESS 320 Witch Hazel Dr BLOCK _____ LOT 1155

DATES	WATER	SEWER
On at Main July 22, 2023	Depth at P/L: 673.62m (2.7m)	Depth at P/L: 673.55m (2.8m)
On at CC	Depth at Main: 673.18m (3.1m)	Depth at Main: 672.42m (3.9m)
Frost Plug	Pipe Size: 25mm/20mm	Pipe Size: 100mm
Memo:	Pipe Material: HDPE Insul. <u>Yes</u> /No	Pipe Material: PVC Insul. Yes/ <u>No</u>
	Length from Main to P/L: 14.60m	Length from Main to P/L: 11.83m
		STORM
	Squirt Test: <u>Pass</u> /Fail	Depth at P/L:
	Frost Protection: <u>Recirc</u> /Heat Trace	Depth at Main:
	Continuity Test: n/a Pass/Fail	Pipe Size:
	PRV Required: Yes/ <u>No</u>	Pipe Material:
		Length from Main to P/L:

CLEARLY INDICATE LOCATION OF CC AND ROUTE OF PIPES ON DRAWING BELOW

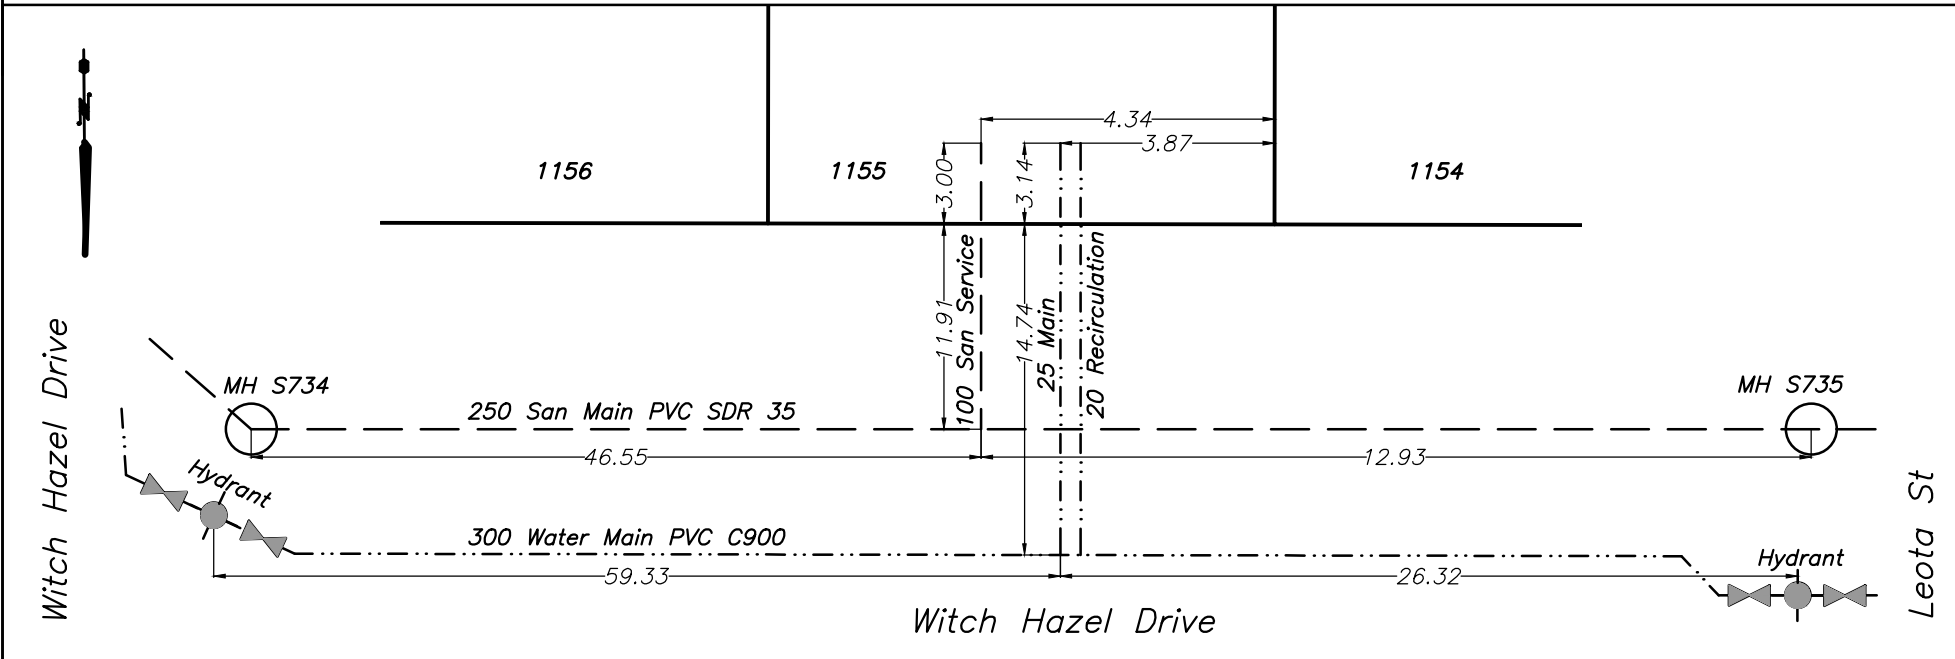




CITY OF WHITEHORSE

SERVICE CONNECTION RECORD

NAME Castle Rock Enterprises ADDRESS 318 Witch Hazel Dr BLOCK LOT 1156

DATES	WATER	SEWER
On at Main July 8, 2023	Depth at P/L: 673.77m (2.6m)	Depth at P/L: 673.75m (2.6m)
On at CC	Depth at Main: 673.32m (3.0m)	Depth at Main: 672.38m (4.0m)
Frost Plug	Pipe Size: 25mm/20mm	Pipe Size: 100mm
Memo:	Pipe Material: HDPE	Pipe Material: PVC
	Insul. <u>Yes</u> /No	Insul. Yes/ <u>No</u>
	Length from Main to P/L: 14.74m	Length from Main to P/L: 11.91m
		STORM
	Squirt Test: <u>Pass</u> /Fail	Depth at P/L:
	Frost Protection: <u>Recirc</u> /Heat Trace	Depth at Main:
	Continuity Test: n/a	Pipe Size:
	PRV Required: Yes/ <u>No</u>	Pipe Material:
		Length from Main to P/L:

CLEARLY INDICATE LOCATION OF CC AND ROUTE OF PIPES ON DRAWING BELOW

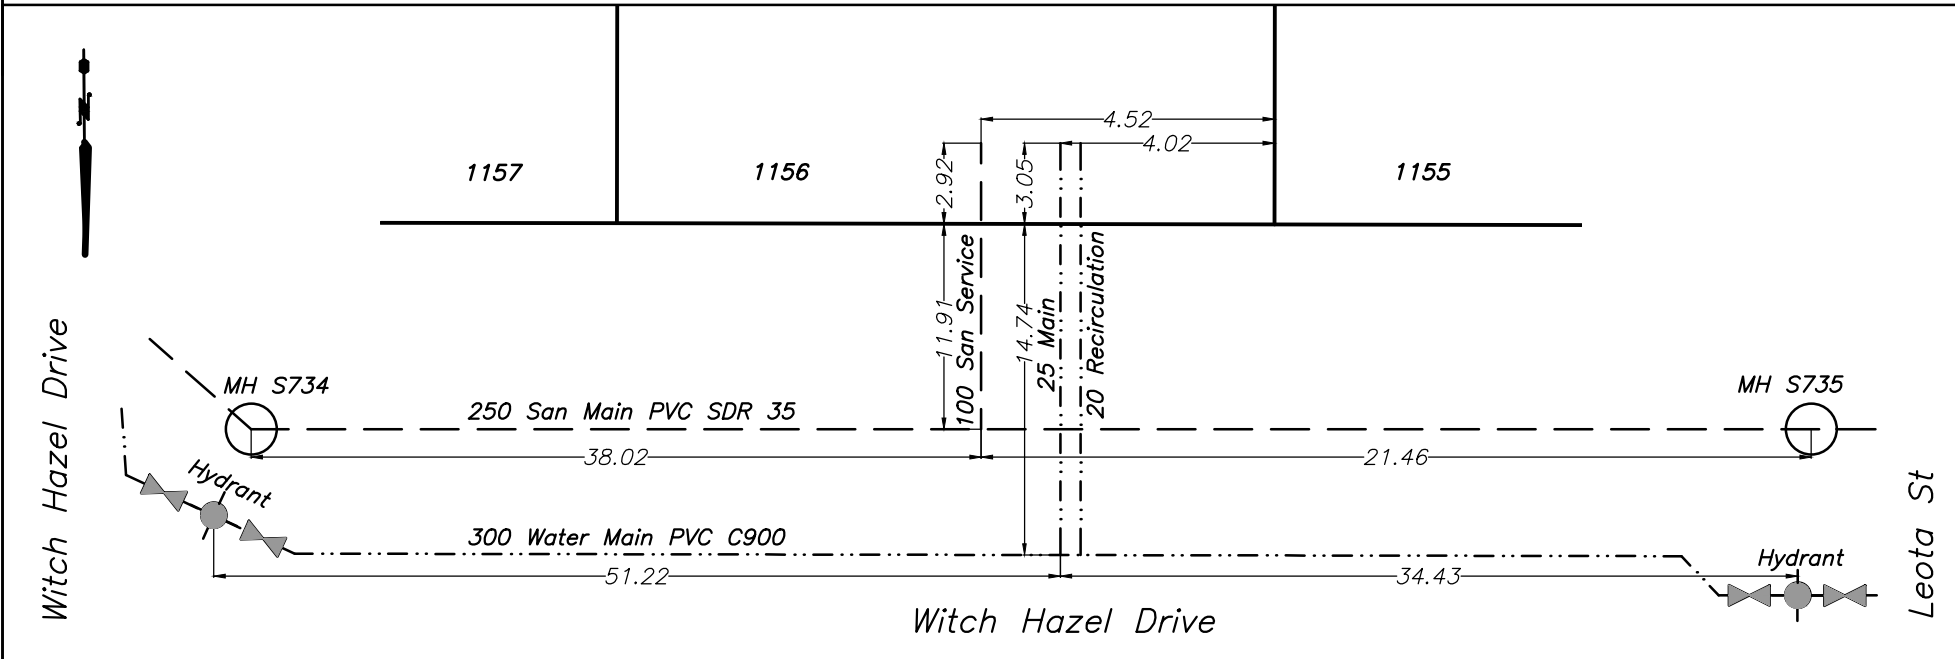




CITY OF WHITEHORSE

SERVICE CONNECTION RECORD

NAME Castle Rock Enterprises ADDRESS 308 Witch Hazel Dr BLOCK _____ LOT 1157

DATES	WATER		SEWER
On at Main July 18, 2023	Depth at P/L: 673.69m (2.9m)		Depth at P/L: 673.69m (2.9m)
On at CC	Depth at Main: 673.41m (3.1m)		Depth at Main: 672.80m (3.8m)
Frost Plug	Pipe Size: 50mm/20mm		Pipe Size: 150mm
Memo:	Pipe Material: HDPE	Insul. <u>Yes</u> /No	Pipe Material: PVC
	Length from Main to P/L: 17.81m		Length from Main to P/L: 14.45m
			STORM
	Squirt Test: <u>Pass</u> /Fail		Depth at P/L:
	Frost Protection: <u>Recirc</u> /Heat Trace		Depth at Main:
	Continuity Test: n/a		Pipe Size:
	PRV Required: Yes/ <u>No</u>		Pipe Material:
			Length from Main to P/L:

CLEARLY INDICATE LOCATION OF CC AND ROUTE OF PIPES ON DRAWING BELOW

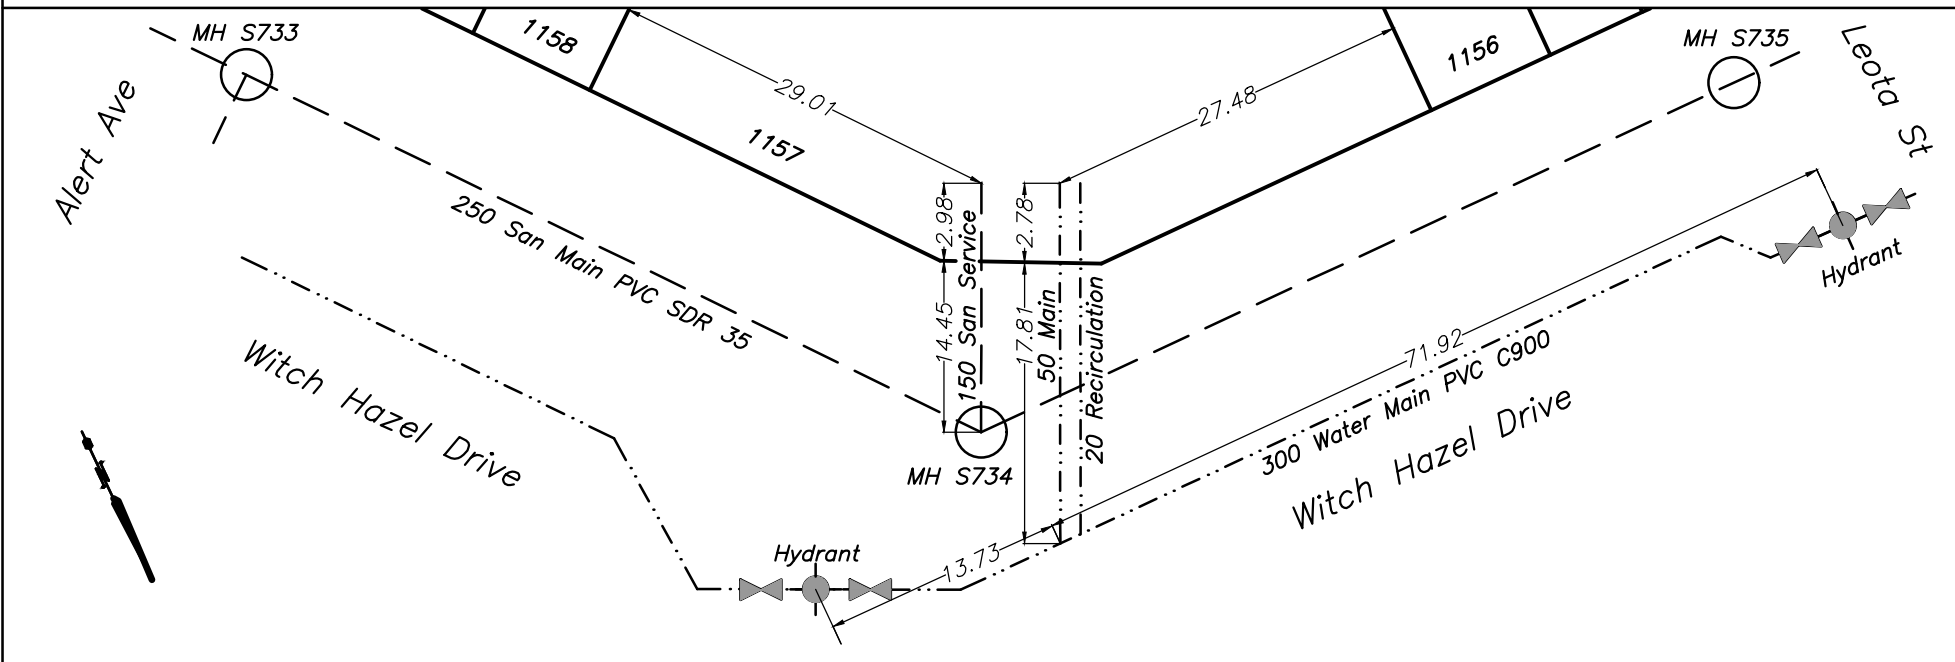




CITY OF WHITEHORSE

SERVICE CONNECTION RECORD

NAME Castle Rock Enterprises ADDRESS 296 Witch Hazel Dr BLOCK LOT 1158

DATES	WATER	SEWER
On at Main July 22, 2023	Depth at P/L: 674.32m (2.5m)	Depth at P/L: 674.26m (2.6m)
On at CC	Depth at Main: 673.69m (3.1m)	Depth at Main: 672.01m (4.9m)
Frost Plug	Pipe Size: 25mm/20mm	Pipe Size: 100mm
Memo:	Pipe Material: HDPE	Pipe Material: PVC
	Insul. <u>Yes</u> /No	Insul. Yes/ <u>No</u>
	Length from Main to P/L: 14.48m	Length from Main to P/L: 11.84m
		STORM
	Squirt Test: <u>Pass</u> /Fail	Depth at P/L:
	Frost Protection: <u>Recirc</u> /Heat Trace	Depth at Main:
	Continuity Test: n/a	Pipe Size:
	PRV Required: Yes/ <u>No</u>	Pipe Material:
		Length from Main to P/L:

CLEARLY INDICATE LOCATION OF CC AND ROUTE OF PIPES ON DRAWING BELOW

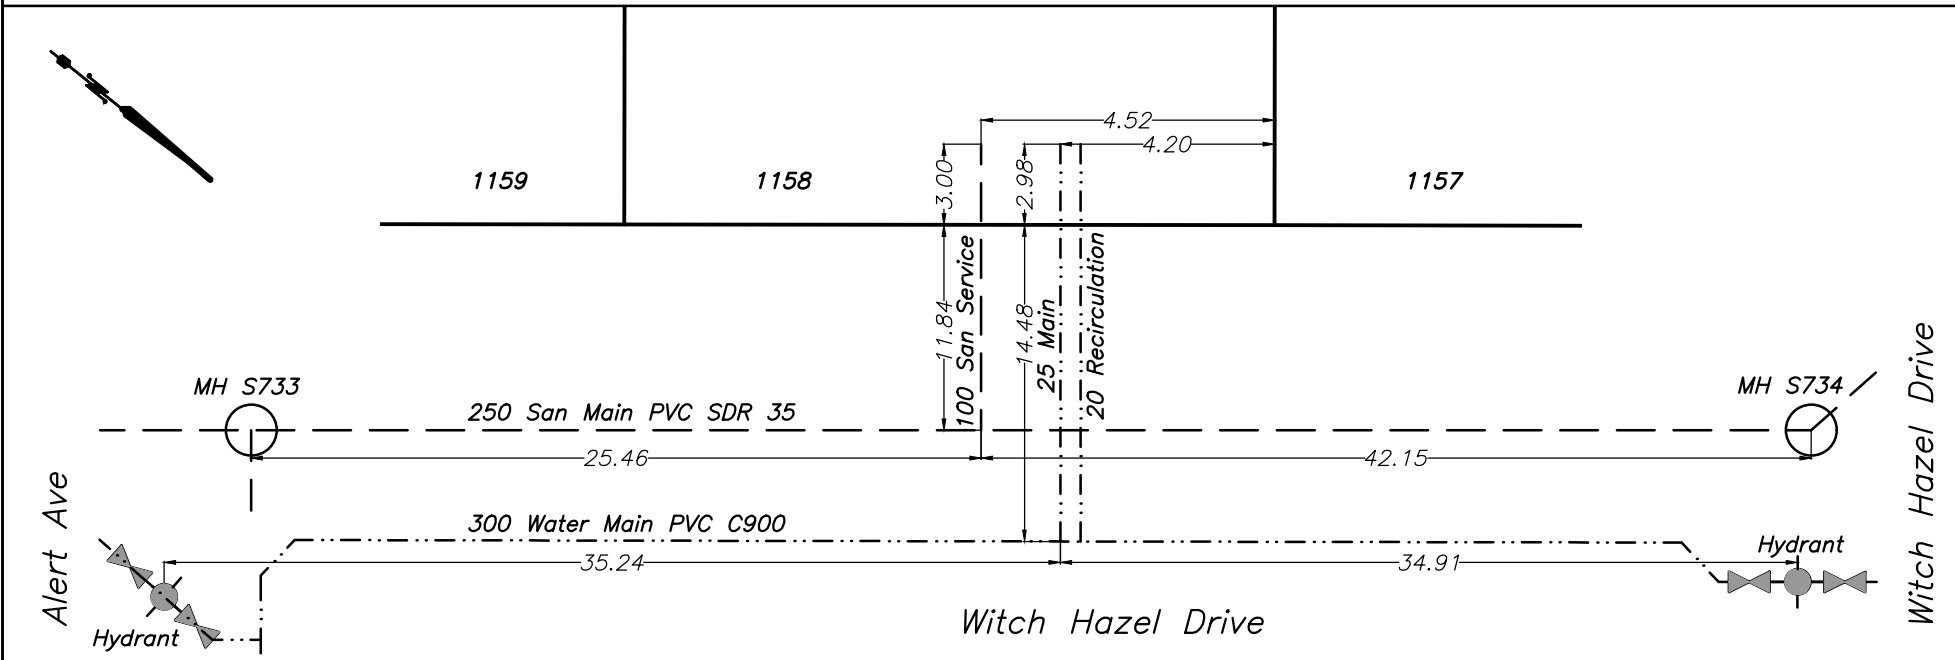




CITY OF WHITEHORSE

SERVICE CONNECTION RECORD

NAME Castle Rock Enterprises ADDRESS 294 Witch Hazel Dr BLOCK _____ LOT 1159

DATES	WATER	SEWER
On at Main June 27, 2023	Depth at P/L: 674.33m (2.6m)	Depth at P/L: 674.30m (2.6m)
On at CC	Depth at Main: 673.75m (3.1m)	Depth at Main: 671.99m (4.9m)
Frost Plug	Pipe Size: 25mm/20mm	Pipe Size: 100mm
Memo:	Pipe Material: HDPE Insul. <u>Yes</u> /No	Pipe Material: PVC Insul. Yes/ <u>No</u>
	Length from Main to P/L: 14.43m	Length from Main to P/L: 11.83m
		STORM
	Squirt Test: <u>Pass</u> /Fail	Depth at P/L:
	Frost Protection: <u>Recirc</u> /Heat Trace	Depth at Main:
	Continuity Test: n/a Pass/Fail	Pipe Size:
	PRV Required: Yes/ <u>No</u>	Pipe Material:
		Length from Main to P/L:

CLEARLY INDICATE LOCATION OF CC AND ROUTE OF PIPES ON DRAWING BELOW

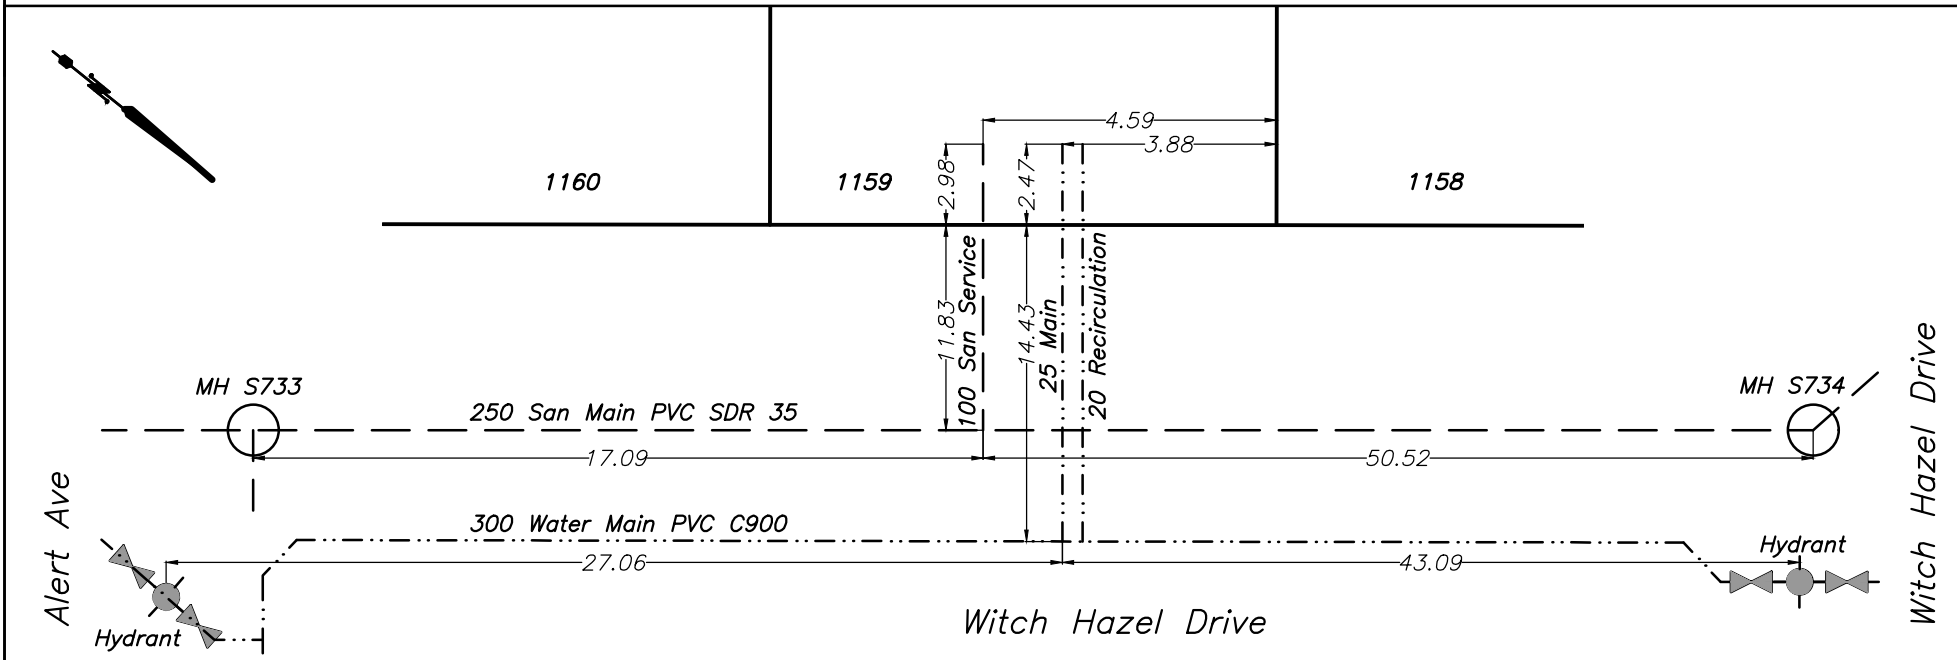




CITY OF WHITEHORSE

SERVICE CONNECTION RECORD

NAME Castle Rock Enterprises ADDRESS 292 Witch Hazel Dr BLOCK _____ LOT 1160

DATES	WATER	SEWER
On at Main July 5, 2023	Depth at P/L: 674.17m (2.8m)	Depth at P/L: 674.07m (2.8m)
On at CC	Depth at Main: 673.71m (3.2m)	Depth at Main: 671.93m (5.0m)
Frost Plug	Pipe Size: 25mm/20mm	Pipe Size: 100mm
Memo:	Pipe Material: HDPE Insul. <u>Yes</u> /No	Pipe Material: PVC Insul. Yes/ <u>No</u>
	Length from Main to P/L: 14.46m	Length from Main to P/L: 11.91m
		STORM
	Squirt Test: <u>Pass</u> /Fail	Depth at P/L:
	Frost Protection: <u>Recirc</u> /Heat Trace	Depth at Main:
	Continuity Test: n/a Pass/Fail	Pipe Size:
	PRV Required: Yes/ <u>No</u>	Pipe Material:
		Length from Main to P/L:

CLEARLY INDICATE LOCATION OF CC AND ROUTE OF PIPES ON DRAWING BELOW

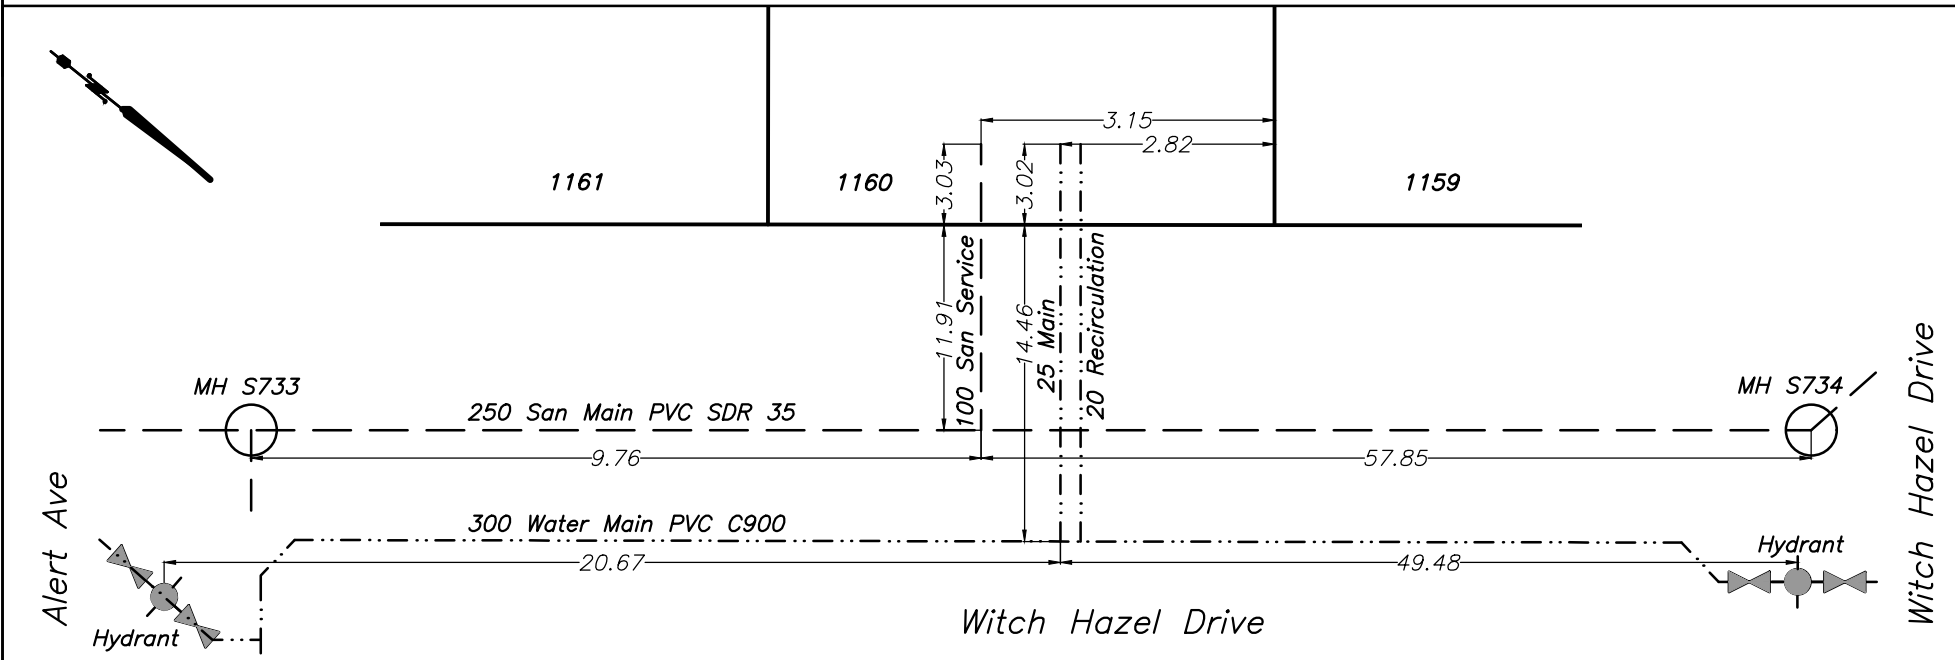




CITY OF WHITEHORSE

SERVICE CONNECTION RECORD

NAME Castle Rock Enterprises ADDRESS 290 Witch Hazel Dr BLOCK _____ LOT 1161

DATES	WATER	SEWER
On at Main July 22, 2023	Depth at P/L: 674.32m (2.6m)	Depth at P/L: 674.15m (2.8m)
On at CC	Depth at Main: 673.79m (3.1m)	Depth at Main: 671.96m (5.0m)
Frost Plug	Pipe Size: 25mm/20mm	Pipe Size: 100mm
Memo:	Pipe Material: HDPE	Pipe Material: PVC
	Insul. <u>Yes</u> /No	Insul. Yes/ <u>No</u>
	Length from Main to P/L: 14.56m	Length from Main to P/L: 11.73m
		STORM
	Squirt Test: <u>Pass</u> /Fail	Depth at P/L:
	Frost Protection: <u>Recirc</u> /Heat Trace	Depth at Main:
	Continuity Test: n/a	Pipe Size:
	PRV Required: Yes/ <u>No</u>	Pipe Material:
		Length from Main to P/L:

CLEARLY INDICATE LOCATION OF CC AND ROUTE OF PIPES ON DRAWING BELOW

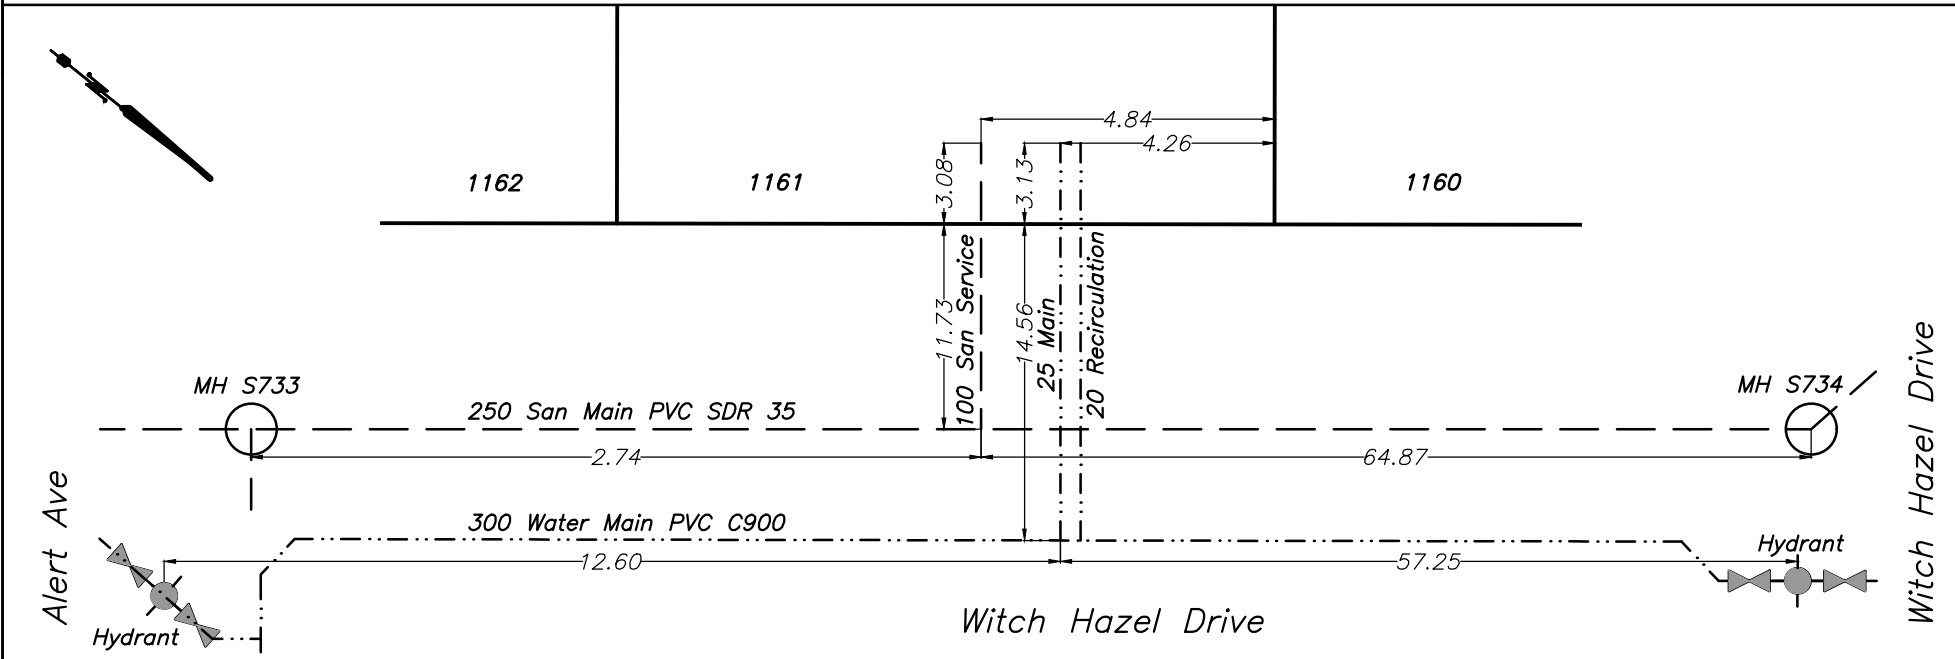




CITY OF WHITEHORSE

SERVICE CONNECTION RECORD

NAME Castle Rock Enterprises ADDRESS 288 Witch Hazel Dr BLOCK _____ LOT 1162

DATES	WATER	SEWER
On at Main June 27, 2023	Depth at P/L: 674.48m (2.4m)	Depth at P/L: 674.44m (2.4m)
On at CC	Depth at Main: 673.99m (2.6m)	Depth at Main: 673.92m (3.1m)
Frost Plug	Pipe Size: 25mm/20mm	Pipe Size: 100mm
Memo:	Pipe Material: HDPE	Pipe Material: PVC
	Insul. <u>Yes</u> /No	Insul. Yes/ <u>No</u>
	Length from Main to P/L: 24.58m	Length from Main to P/L: 11.60m
		STORM
	Squirt Test: <u>Pass</u> /Fail	Depth at P/L:
	Frost Protection: <u>Recirc</u> /Heat Trace	Depth at Main:
	Continuity Test: n/a	Pipe Size:
	PRV Required: Yes/ <u>No</u>	Pipe Material:
		Length from Main to P/L:

CLEARLY INDICATE LOCATION OF CC AND ROUTE OF PIPES ON DRAWING BELOW

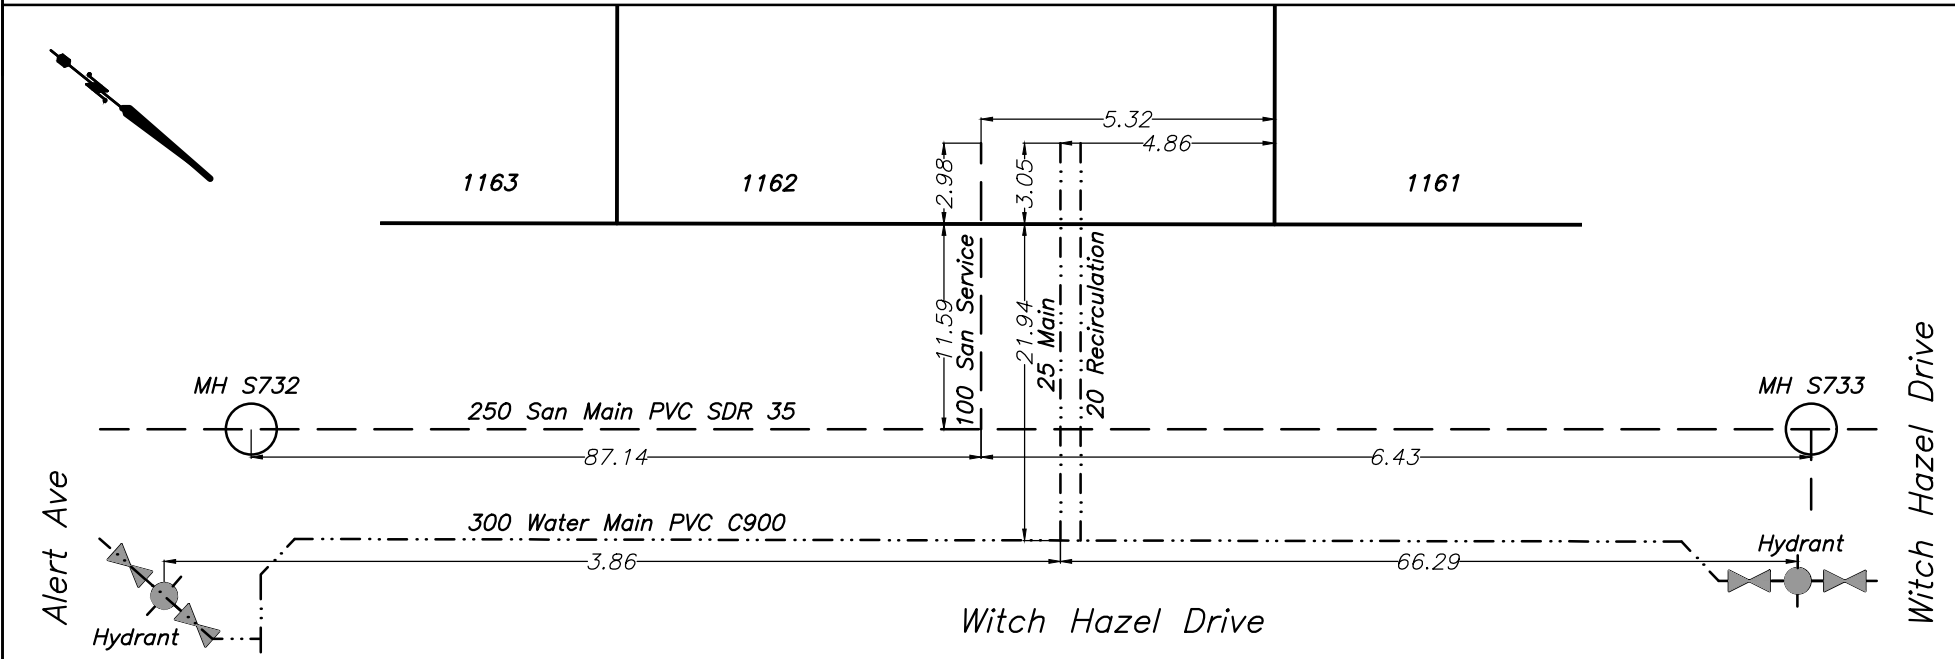




CITY OF WHITEHORSE

SERVICE CONNECTION RECORD

NAME Castle Rock Enterprises ADDRESS 286 Witch Hazel Dr BLOCK LOT 1163

DATES	WATER	SEWER
On at Main July 5, 2023	Depth at P/L: 674.37m (2.5m)	Depth at P/L: 674.33m (2.5m)
On at CC	Depth at Main: 674.01m (2.9m)	Depth at Main: 673.89m (3.0m)
Frost Plug	Pipe Size: 25mm/20mm	Pipe Size: 100mm
Memo:	Pipe Material: HDPE	Pipe Material: PVC
	Insul. <u>Yes</u> /No	Insul. Yes/ <u>No</u>
	Length from Main to P/L: 21.94m	Length from Main to P/L: 11.59m
		STORM
	Squirt Test: <u>Pass</u> /Fail	Depth at P/L:
	Frost Protection: <u>Recirc</u> /Heat Trace	Depth at Main:
	Continuity Test: n/a	Pipe Size:
	PRV Required: Yes/ <u>No</u>	Pipe Material:
		Length from Main to P/L:

CLEARLY INDICATE LOCATION OF CC AND ROUTE OF PIPES ON DRAWING BELOW

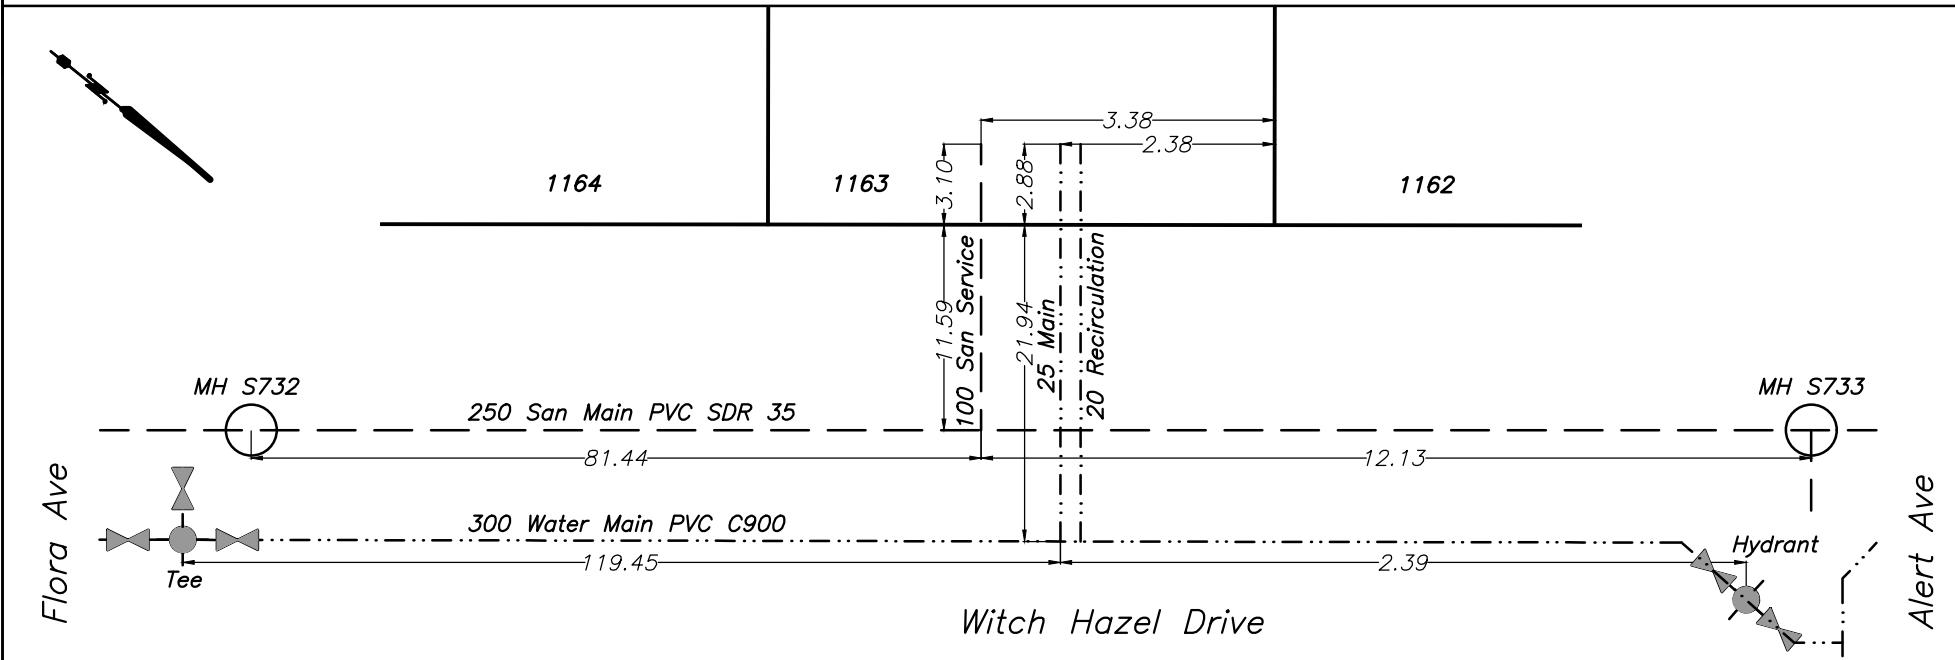




CITY OF WHITEHORSE

SERVICE CONNECTION RECORD

NAME Castle Rock Enterprises ADDRESS 284 Witch Hazel Dr BLOCK _____ LOT 1164

DATES	WATER	SEWER
On at Main July 22, 2023	Depth at P/L: 674.38m (2.4m)	Depth at P/L: 674.28m (2.5m)
On at CC	Depth at Main: 673.82m (3.0m)	Depth at Main: 673.80m (3.0m)
Frost Plug	Pipe Size: 25mm/20mm	Pipe Size: 100mm
Memo:	Pipe Material: HDPE Insul. <u>Yes</u> /No	Pipe Material: PVC Insul. Yes/ <u>No</u>
	Length from Main to P/L: 14.54m	Length from Main to P/L: 11.69m
		STORM
	Squirt Test: <u>Pass</u> /Fail	Depth at P/L:
	Frost Protection: <u>Recirc</u> /Heat Trace	Depth at Main:
	Continuity Test: n/a Pass/Fail	Pipe Size:
	PRV Required: Yes/ <u>No</u>	Pipe Material:
		Length from Main to P/L:

CLEARLY INDICATE LOCATION OF CC AND ROUTE OF PIPES ON DRAWING BELOW

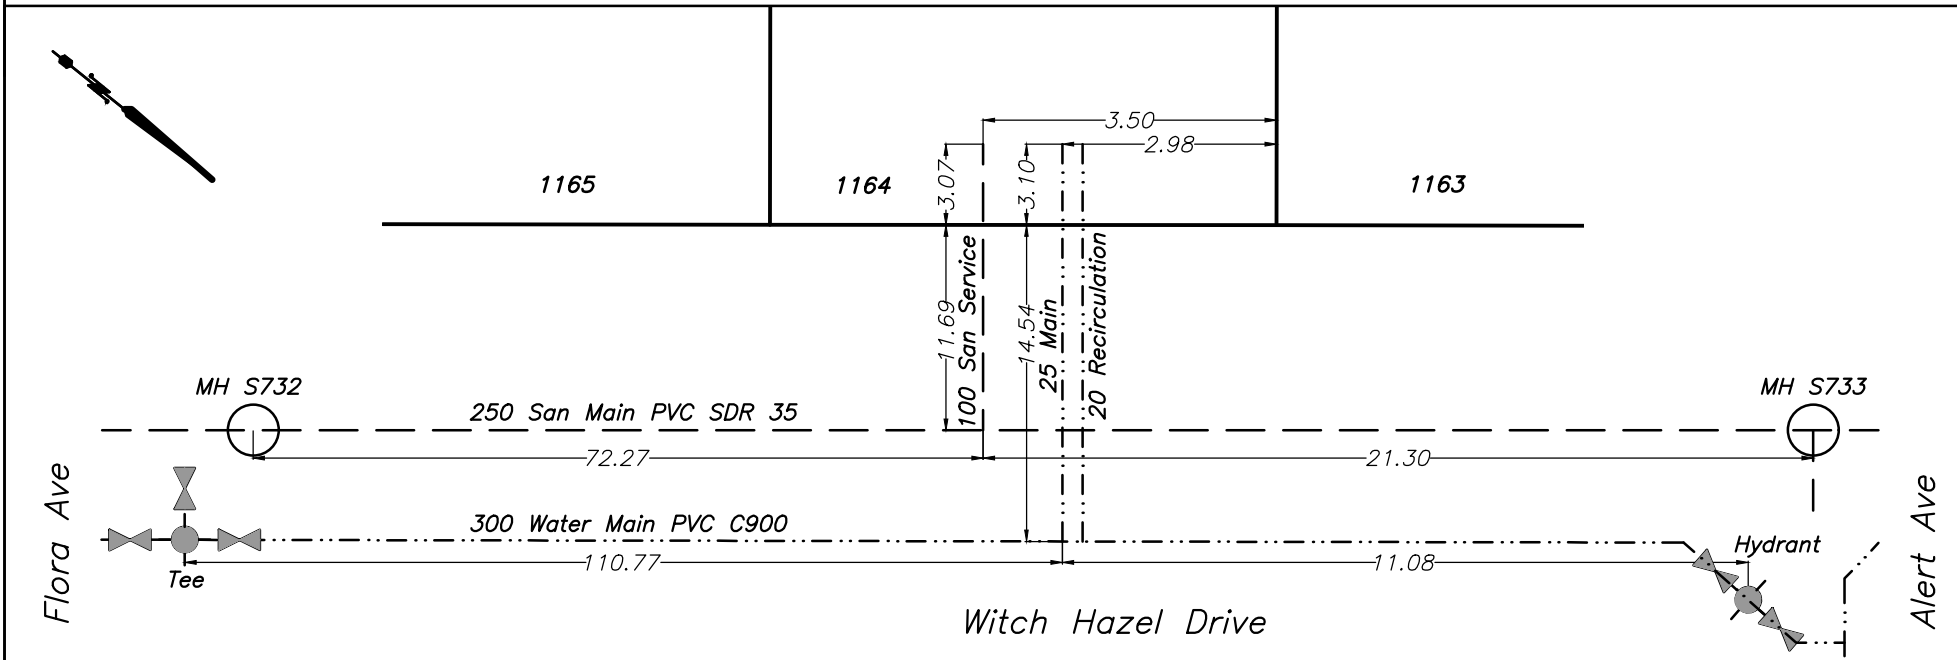




CITY OF WHITEHORSE

SERVICE CONNECTION RECORD

NAME Castle Rock Enterprises ADDRESS 282 Witch Hazel Dr BLOCK LOT 1165

DATES	WATER	SEWER
On at Main July 27, 2023	Depth at P/L: 674.37m (2.4m)	Depth at P/L: 674.26m (2.5m)
On at CC	Depth at Main: 673.78m (3.0m)	Depth at Main: 673.79m (3.0m)
Frost Plug	Pipe Size: 25mm/20mm	Pipe Size: 100mm
Memo:	Pipe Material: HDPE	Pipe Material: PVC
	Insul. <u>Yes</u> /No	Insul. Yes/ <u>No</u>
	Length from Main to P/L: 14.48m	Length from Main to P/L: 11.60m
		STORM
	Squirt Test: <u>Pass</u> /Fail	Depth at P/L:
	Frost Protection: <u>Recirc</u> /Heat Trace	Depth at Main:
	Continuity Test: n/a	Pipe Size:
	PRV Required: Yes/ <u>No</u>	Pipe Material:
		Length from Main to P/L:

CLEARLY INDICATE LOCATION OF CC AND ROUTE OF PIPES ON DRAWING BELOW

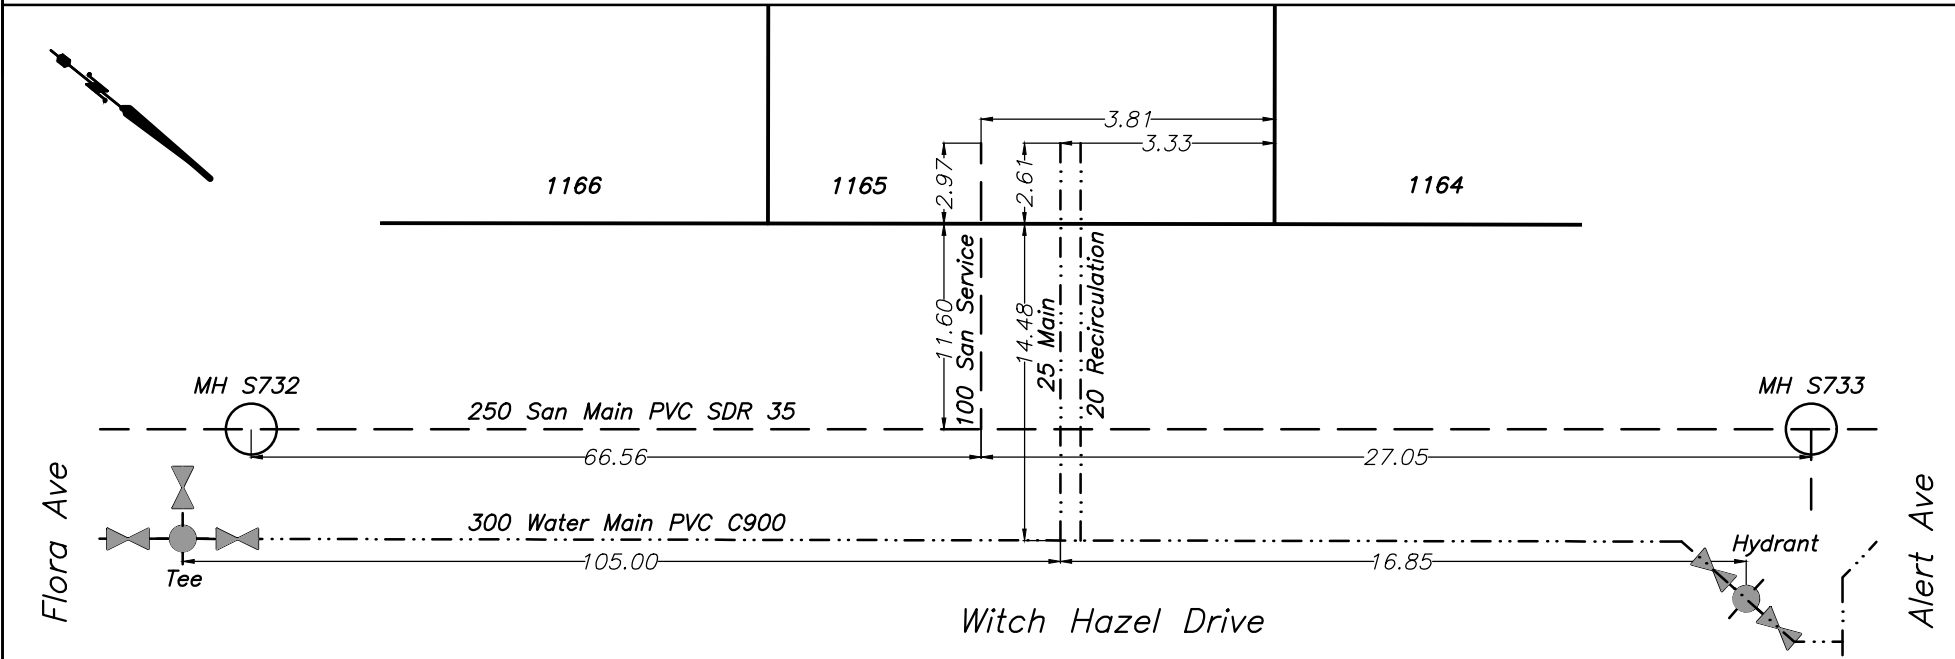




CITY OF WHITEHORSE

SERVICE CONNECTION RECORD

NAME Castle Rock Enterprises ADDRESS 280 Witch Hazel Dr BLOCK LOT 1166

DATES	WATER		SEWER
On at Main July 5, 2023	Depth at P/L: 674.25m (2.4m)		Depth at P/L: 674.20m (2.5m)
On at CC	Depth at Main: 673.72m (2.9m)		Depth at Main: 673.75m (3.0m)
Frost Plug	Pipe Size: 25mm/20mm		Pipe Size: 100mm
Memo:	Pipe Material: HDPE	Insul. <u>Yes</u> /No	Pipe Material: PVC
	Length from Main to P/L: 14.47m		Length from Main to P/L: 11.61m
			STORM
	Squirt Test: <u>Pass</u> /Fail		Depth at P/L:
	Frost Protection: <u>Recirc</u> /Heat Trace		Depth at Main:
	Continuity Test: n/a		Pipe Size:
	PRV Required: Yes/ <u>No</u>		Pipe Material:
			Length from Main to P/L:

CLEARLY INDICATE LOCATION OF CC AND ROUTE OF PIPES ON DRAWING BELOW

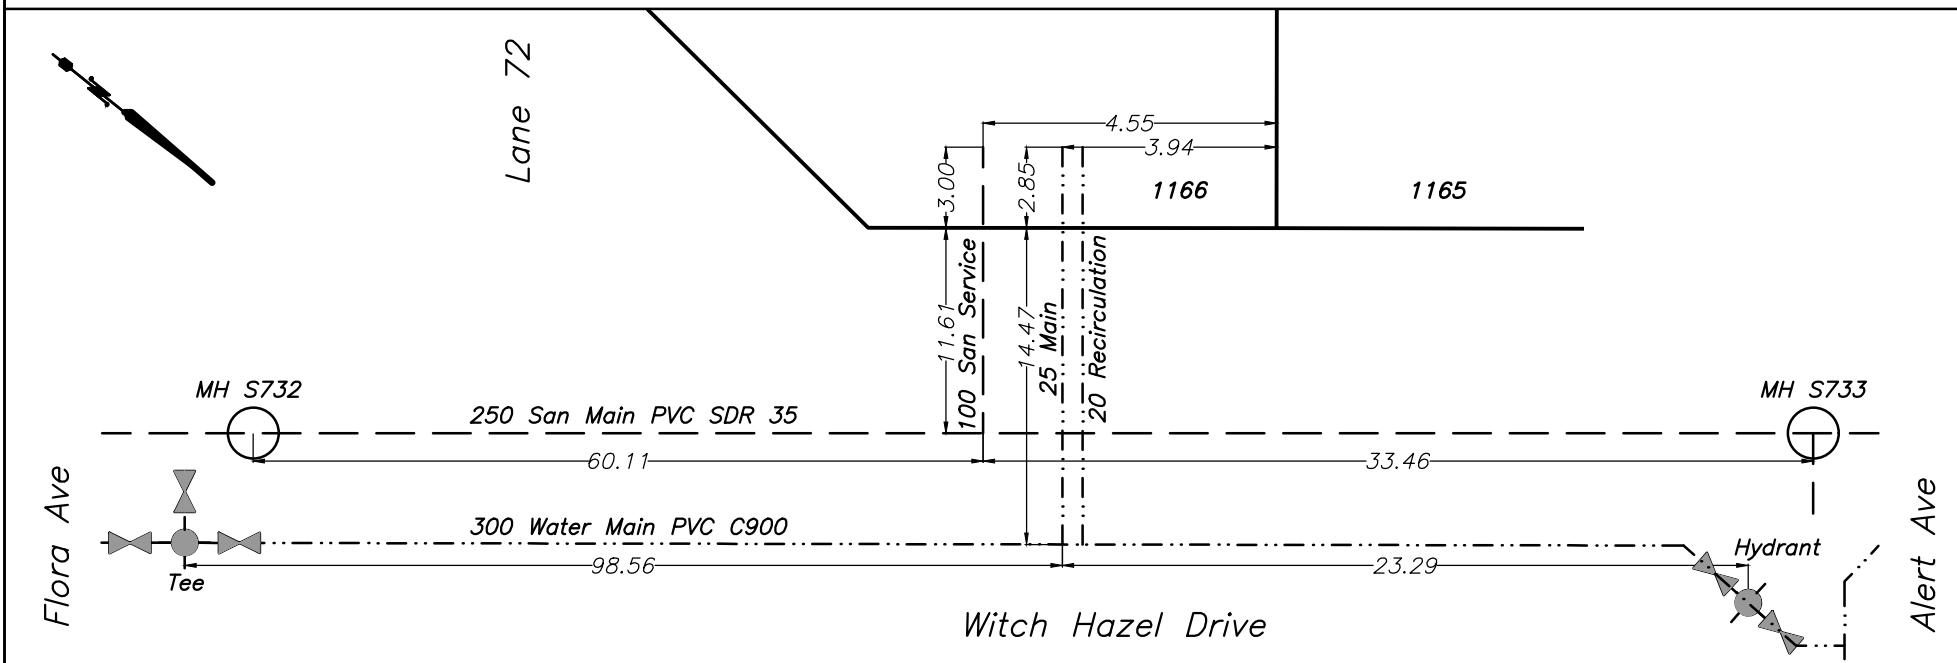




CITY OF WHITEHORSE


SERVICE CONNECTION RECORD

NAME Castle Rock Enterprises ADDRESS 258 Witch Hazel Dr BLOCK _____ LOT 1184

DATES	WATER	SEWER
On at Main October 12, 2022	Depth at P/L: 672.92m (2.6m)	Depth at P/L: 672.90m (2.6m)
On at CC	Depth at Main: 672.43m (3.0m)	Depth at Main: 669.96m (5.6m)
Frost Plug	Pipe Size: 25mm/20mm	Pipe Size: 100mm
Memo:	Pipe Material: HDPE	Pipe Material: PVC
	Insul. <u>Yes</u> /No	Insul. Yes/ <u>No</u>
	Length from Main to P/L: 14.42m	Length from Main to P/L: 11.82m
		STORM
	Squirt Test: <u>Pass</u> /Fail	Depth at P/L:
	Frost Protection: <u>Recirc</u> /Heat Trace	Depth at Main:
	Continuity Test: n/a	Pipe Size:
	PRV Required: Yes/ <u>No</u>	Pipe Material:
		Length from Main to P/L:

CLEARLY INDICATE LOCATION OF CC AND ROUTE OF PIPES ON DRAWING BELOW

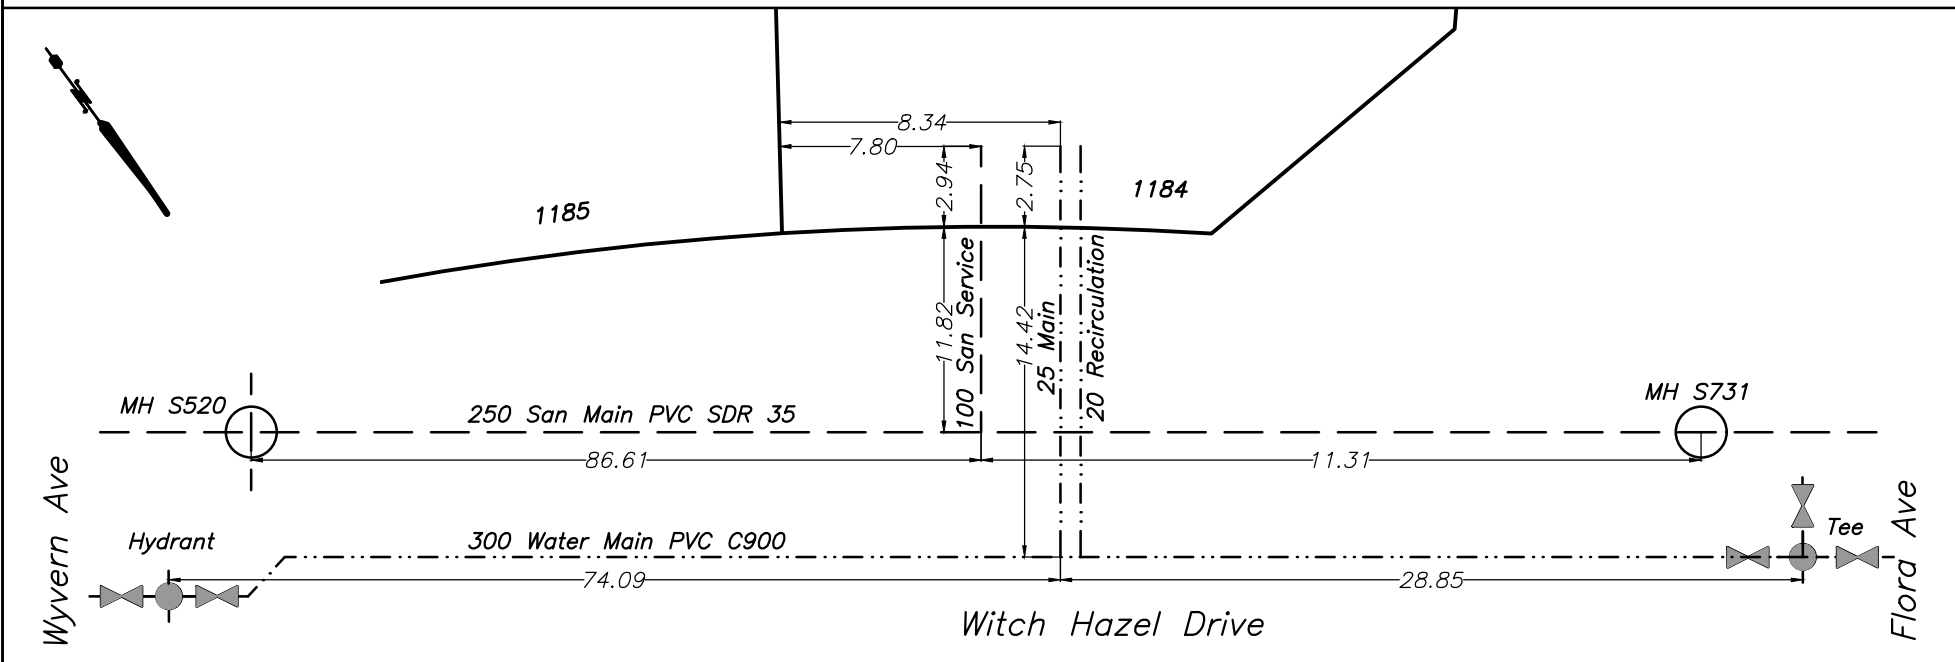

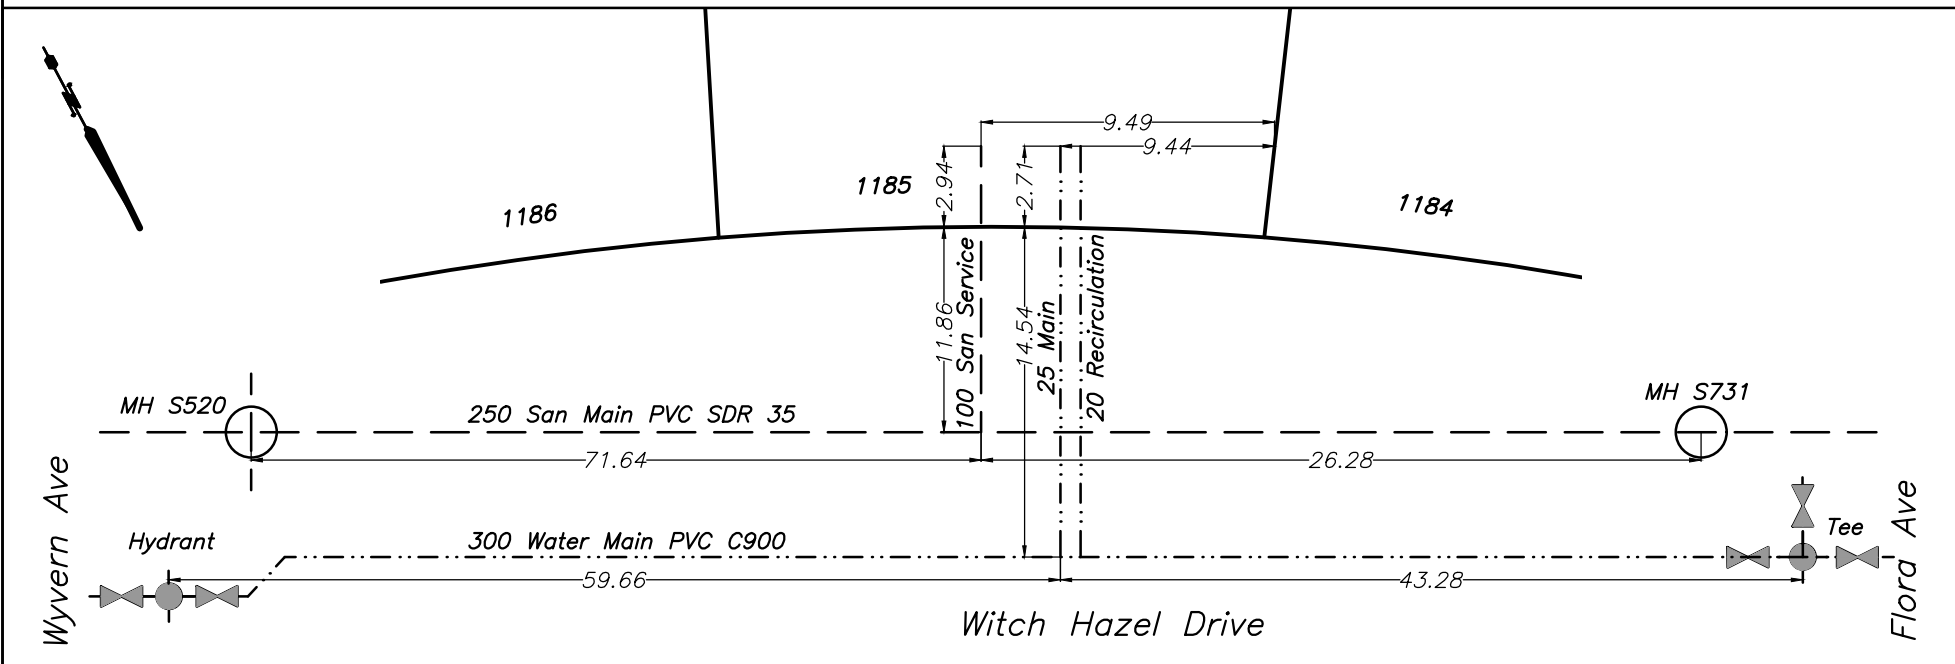




CITY OF WHITEHORSE

SERVICE CONNECTION RECORD

NAME Castle Rock Enterprises ADDRESS 254 Witch Hazel Dr BLOCK _____ LOT 1186

DATES	WATER	SEWER
On at Main October 12, 2022	Depth at P/L: 673.11m (2.5m)	Depth at P/L: 673.06m (2.6m)
On at CC	Depth at Main: 672.58m (3.0m)	Depth at Main: 669.83m (6.0m)
Frost Plug	Pipe Size: 25mm/20mm	Pipe Size: 100mm
Memo:	Pipe Material: HDPE	Pipe Material: PVC
	Insul. <u>Yes</u> /No	Insul. Yes/ <u>No</u>
	Length from Main to P/L: 14.39m	Length from Main to P/L: 11.86m
		STORM
	Squirt Test: <u>Pass</u> /Fail	Depth at P/L:
	Frost Protection: <u>Recirc</u> /Heat Trace	Depth at Main:
	Continuity Test: n/a	Pipe Size:
	PRV Required: Yes/ <u>No</u>	Pipe Material:
		Length from Main to P/L:

CLEARLY INDICATE LOCATION OF CC AND ROUTE OF PIPES ON DRAWING BELOW

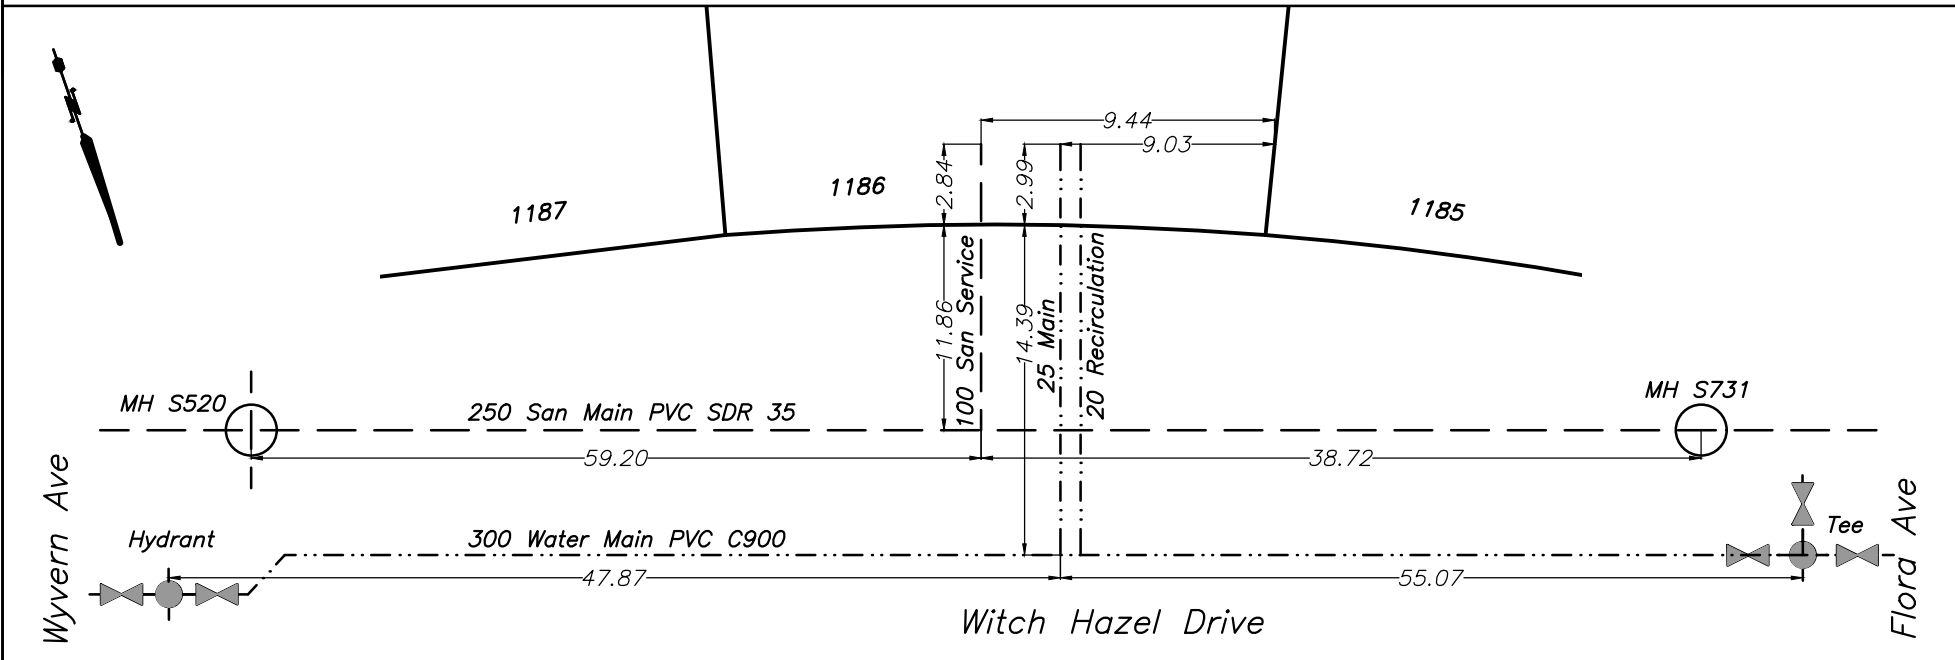



CITY OF WHITEHORSE

SERVICE CONNECTION RECORD

NAME Castle Rock Enterprises ADDRESS 252 Witch Hazel Dr BLOCK _____ LOT 1187

DATES	WATER		SEWER
On at Main October 12, 2022	Depth at P/L: 673.24m (2.5m)		Depth at P/L: 673.17m (2.6m)
On at CC	Depth at Main: 672.65m (3.0m)		Depth at Main: 669.72m (6.0m)
Frost Plug	Pipe Size: 25mm/20mm		Pipe Size: 100mm
Memo:	Pipe Material: HDPE	Insul. <u>Yes</u> /No	Pipe Material: PVC
	Length from Main to P/L: 14.54m		Length from Main to P/L: 12.11m
			STORM
	Squirt Test: <u>Pass</u> /Fail		Depth at P/L:
	Frost Protection: <u>Recirc</u> /Heat Trace		Depth at Main:
	Continuity Test: n/a		Pipe Size:
	PRV Required: Yes/ <u>No</u>		Pipe Material:
			Length from Main to P/L:

CLEARLY INDICATE LOCATION OF CC AND ROUTE OF PIPES ON DRAWING BELOW

