




# CITY OF WHITEHORSE

## SERVICE CONNECTION RECORD

NAME P S Sidhu Trucking Ltd. ADDRESS 1 Aurora Drive, Whistle Bend BLOCK \_\_\_\_\_ LOT 1349

| DATES                   | WATER                                       | SEWER                                          |
|-------------------------|---------------------------------------------|------------------------------------------------|
| On at Main June 20 2024 | Depth at P/L: 673.58 (2.53)                 | Depth at P/L: 673.52 (2.58)                    |
| On at CC                | Depth at Main: 673.09 (2.90)                | Depth at Main: 673.16 (2.89)                   |
| Frost Plug              | Pipe Size: 25mm/20mm                        | Pipe Size: 100mm                               |
| Memo:                   | Pipe Material: HDPE Insul. <u>Yes</u> /No   | Pipe Material: SDR28 PVC Insul. <u>Yes</u> /No |
|                         | Length from Main to P/L: 6.00               | Length from Main to P/L: 9.00                  |
|                         |                                             | STORM                                          |
|                         | Squirt Test: <u>Pass</u> /Fail              | Depth at P/L:                                  |
|                         | Frost Protection: <u>Recirc</u> /Heat Trace | Depth at Main:                                 |
|                         | Continuity Test: N/A Pass/Fail              | Pipe Size:                                     |
|                         | PRV Required: Yes/ <u>No</u>                | Pipe Material:                                 |
|                         |                                             | Length from Main to P/L:                       |

CLEARLY INDICATE LOCATION OF CC AND ROUTE OF PIPES ON DRAWING BELOW

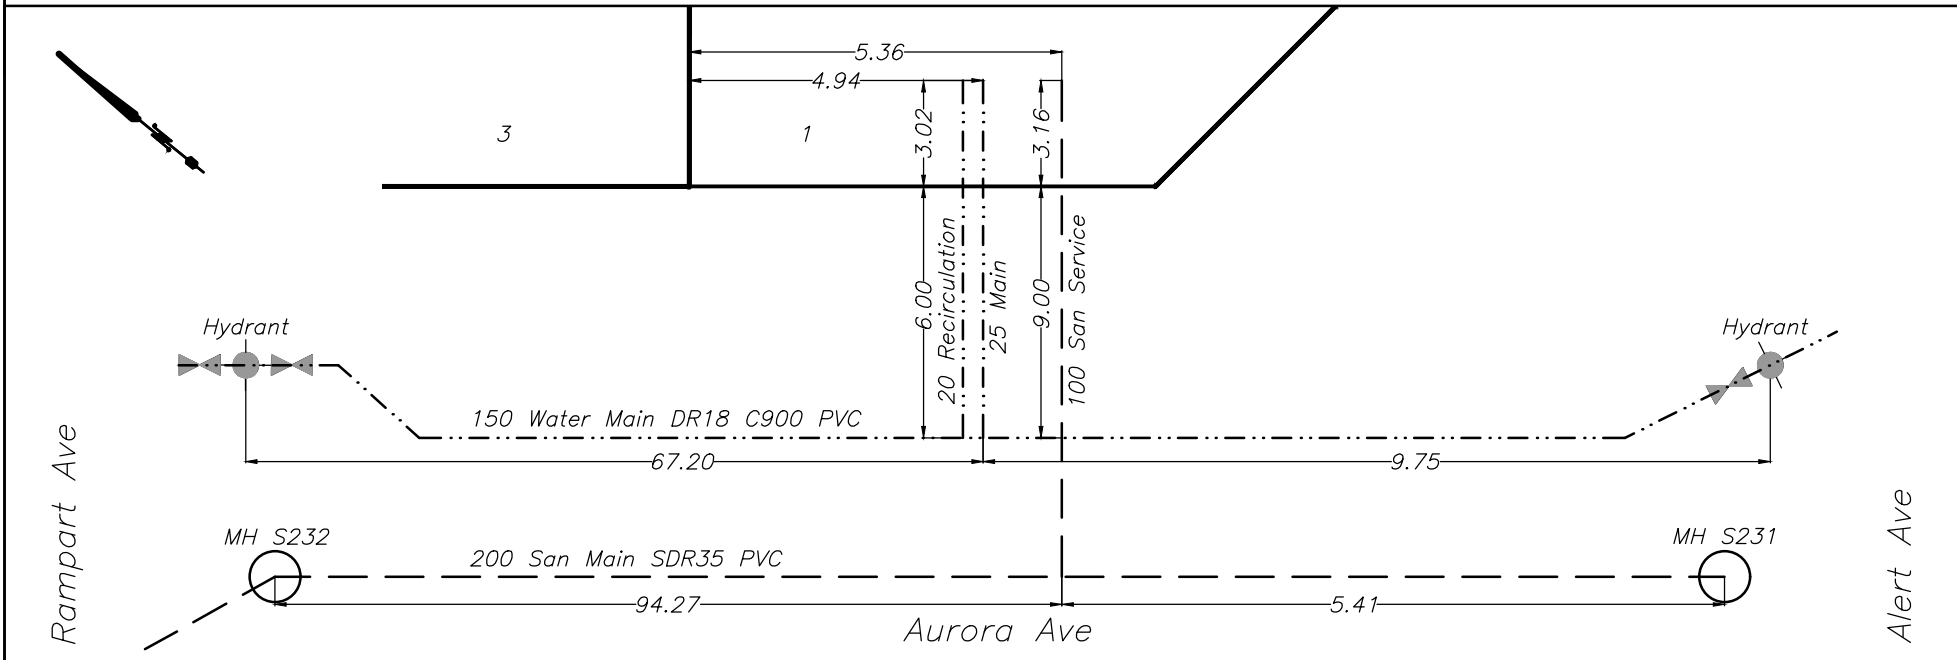




# CITY OF WHITEHORSE

## SERVICE CONNECTION RECORD

NAME P S Sidhu Trucking Ltd. ADDRESS 2 Aurora Drive, Whistle Bend BLOCK \_\_\_\_\_ LOT 1311

| DATES                   | WATER                                       | SEWER                                          |
|-------------------------|---------------------------------------------|------------------------------------------------|
| On at Main June 25 2024 | Depth at P/L: 673.53 (2.59)                 | Depth at P/L: 673.53 (2.59)                    |
| On at CC                | Depth at Main: 673.09 (2.91)                | Depth at Main: 673.17 (2.90)                   |
| Frost Plug              | Pipe Size: 25mm/20mm                        | Pipe Size: 100mm                               |
| Memo:                   | Pipe Material: HDPE Insul. <u>Yes</u> /No   | Pipe Material: SDR28 PVC Insul. <u>Yes</u> /No |
|                         | Length from Main to P/L: 12.26              | Length from Main to P/L: 9.10                  |
|                         |                                             | STORM                                          |
|                         | Squirt Test: <u>Pass</u> /Fail              | Depth at P/L:                                  |
|                         | Frost Protection: <u>Recirc</u> /Heat Trace | Depth at Main:                                 |
|                         | Continuity Test: N/A Pass/Fail              | Pipe Size:                                     |
|                         | PRV Required: Yes/ <u>No</u>                | Pipe Material:                                 |
|                         |                                             | Length from Main to P/L:                       |

CLEARLY INDICATE LOCATION OF CC AND ROUTE OF PIPES ON DRAWING BELOW

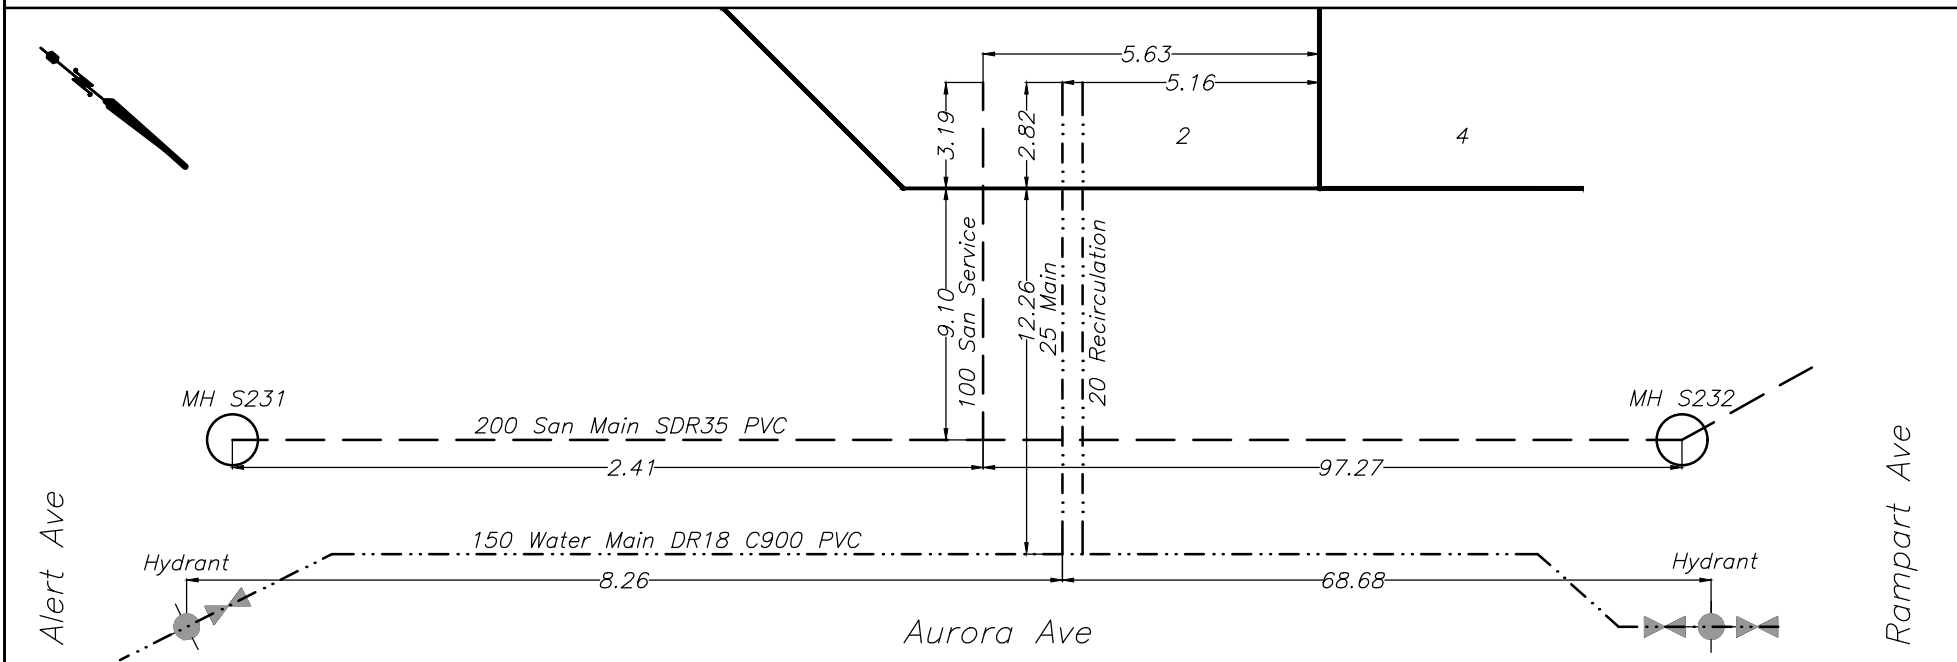




# CITY OF WHITEHORSE

## SERVICE CONNECTION RECORD

NAME P S Sidhu Trucking Ltd. ADDRESS 3 Aurora Drive, Whistle Bend BLOCK                      LOT 1348

| DATES                   | WATER                                       | SEWER                                          |
|-------------------------|---------------------------------------------|------------------------------------------------|
| On at Main June 19 2024 | Depth at P/L: 673.47 (2.56)                 | Depth at P/L: 673.45 (2.58)                    |
| On at CC                | Depth at Main: 673.02 (2.90)                | Depth at Main: 673.10 (2.83)                   |
| Frost Plug              | Pipe Size: 25mm/20mm                        | Pipe Size: 100mm                               |
| Memo:                   | Pipe Material: HDPE Insul. <u>Yes</u> /No   | Pipe Material: SDR28 PVC Insul. <u>Yes</u> /No |
|                         | Length from Main to P/L: 6.02               | Length from Main to P/L: 9.02                  |
|                         |                                             | STORM                                          |
|                         | Squirt Test: <u>Pass</u> /Fail              | Depth at P/L:                                  |
|                         | Frost Protection: <u>Recirc</u> /Heat Trace | Depth at Main:                                 |
|                         | Continuity Test: N/A Pass/Fail              | Pipe Size:                                     |
|                         | PRV Required: Yes/ <u>No</u>                | Pipe Material:                                 |
|                         |                                             | Length from Main to P/L:                       |

CLEARLY INDICATE LOCATION OF CC AND ROUTE OF PIPES ON DRAWING BELOW

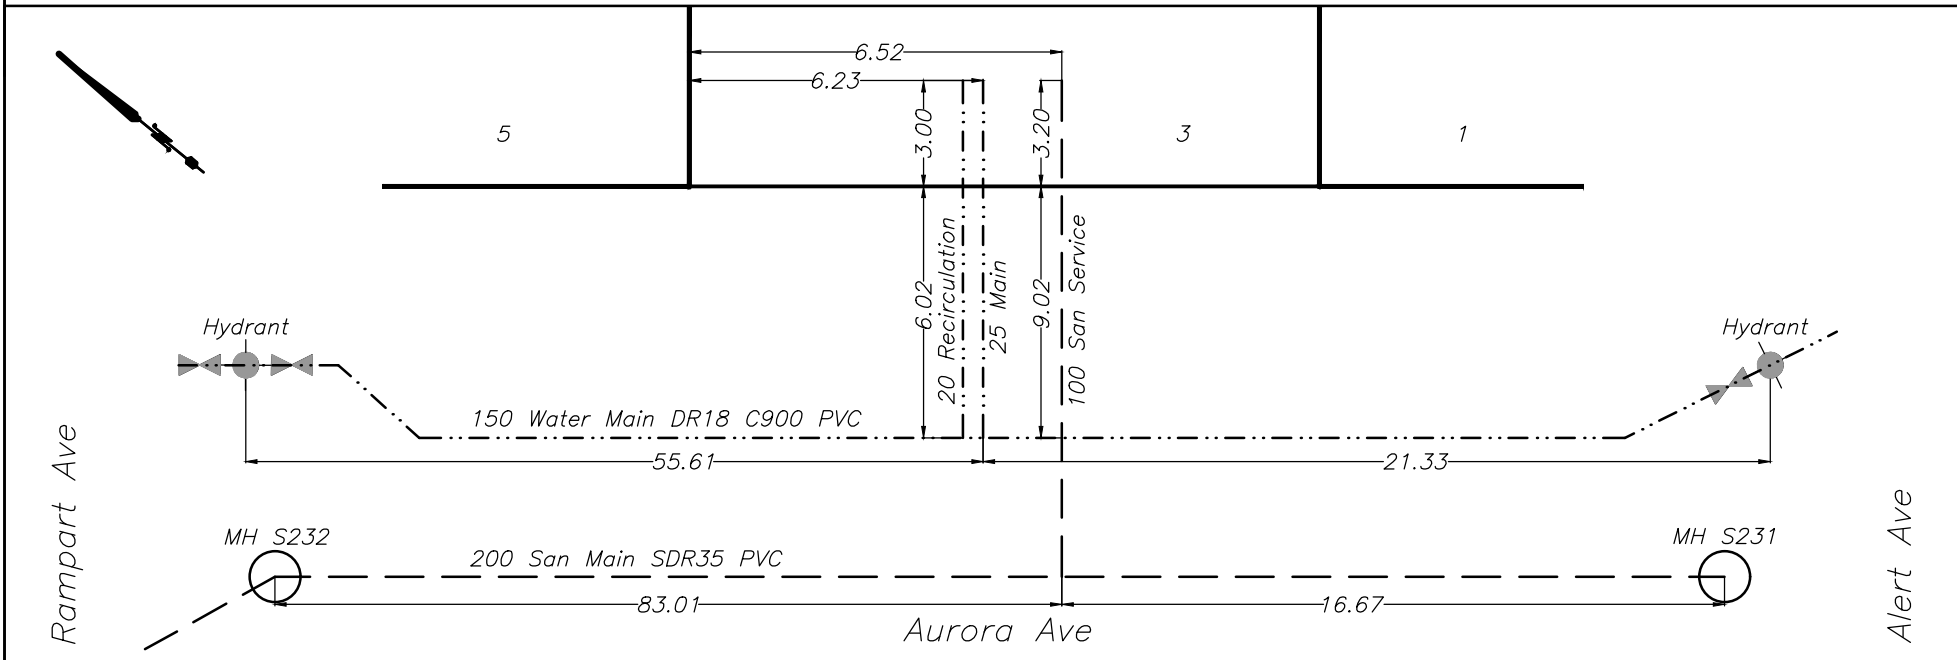




# CITY OF WHITEHORSE

## SERVICE CONNECTION RECORD

NAME P S Sidhu Trucking Ltd. ADDRESS 4 Aurora Drive, Whistle Bend BLOCK \_\_\_\_\_ LOT 1312

| DATES                   | WATER                                       | SEWER                                          |
|-------------------------|---------------------------------------------|------------------------------------------------|
| On at Main June 19 2024 | Depth at P/L: 673.48 (2.60)                 | Depth at P/L: 673.57 (2.59)                    |
| On at CC                | Depth at Main: 673.06 (2.91)                | Depth at Main: 673.15 (2.89)                   |
| Frost Plug              | Pipe Size: 25mm/20mm                        | Pipe Size: 100mm                               |
| Memo:                   | Pipe Material: HDPE Insul. <u>Yes</u> /No   | Pipe Material: SDR28 PVC Insul. <u>Yes</u> /No |
|                         | Length from Main to P/L: 12.02              | Length from Main to P/L: 9.01                  |
|                         |                                             | STORM                                          |
|                         | Squirt Test: <u>Pass</u> /Fail              | Depth at P/L:                                  |
|                         | Frost Protection: <u>Recirc</u> /Heat Trace | Depth at Main:                                 |
|                         | Continuity Test: N/A Pass/Fail              | Pipe Size:                                     |
|                         | PRV Required: Yes/ <u>No</u>                | Pipe Material:                                 |
|                         |                                             | Length from Main to P/L:                       |

CLEARLY INDICATE LOCATION OF CC AND ROUTE OF PIPES ON DRAWING BELOW

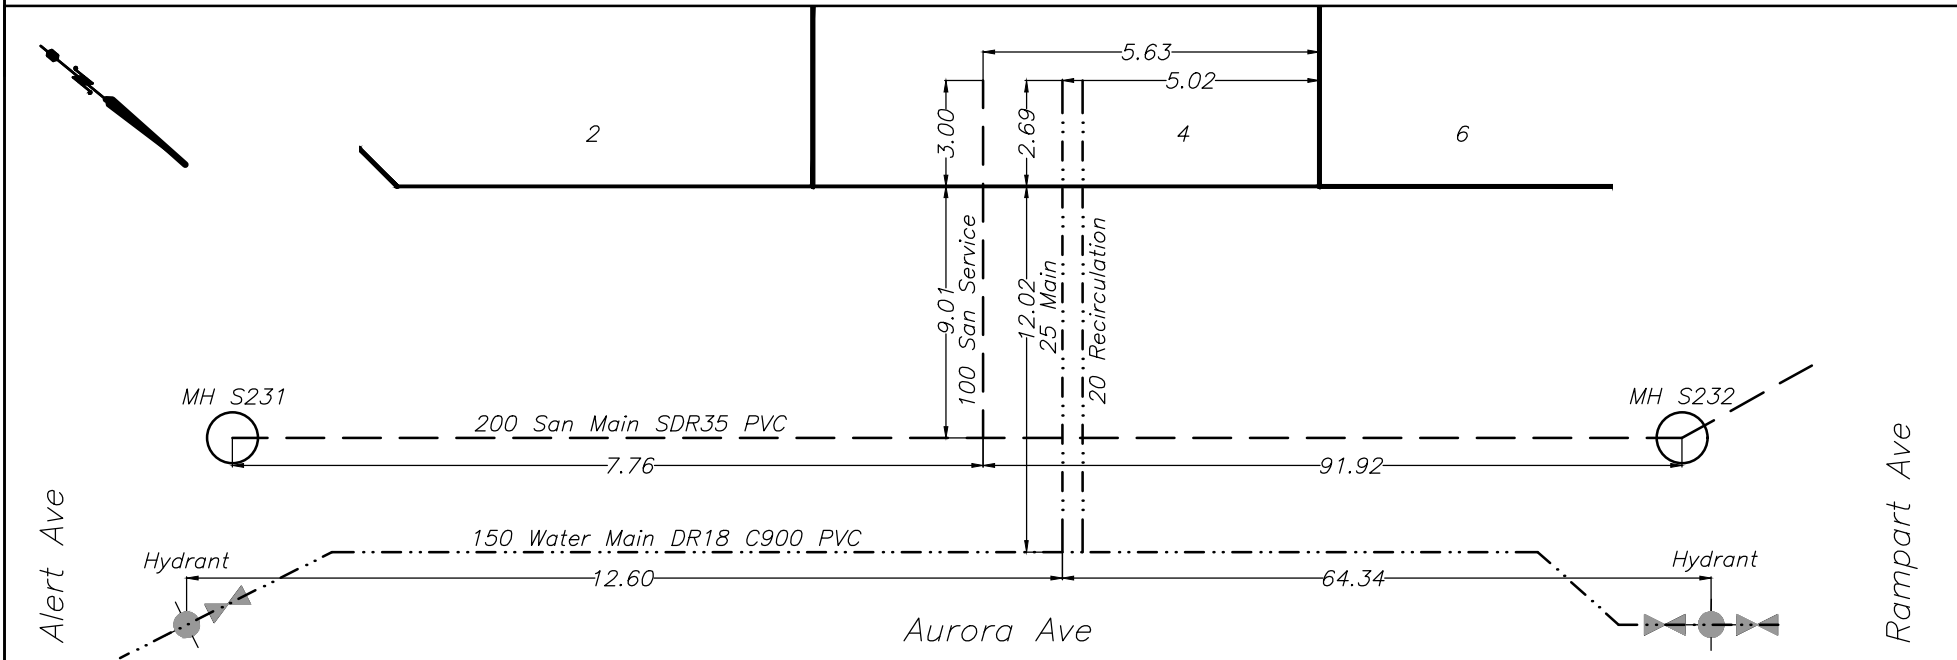




# CITY OF WHITEHORSE

## SERVICE CONNECTION RECORD

NAME P S Sidhu Trucking Ltd. ADDRESS 5 Aurora Drive, Whistle Bend BLOCK                      LOT 1347

| DATES                   | WATER                                       | SEWER                                          |
|-------------------------|---------------------------------------------|------------------------------------------------|
| On at Main June 19 2024 | Depth at P/L: 673.39 (2.56)                 | Depth at P/L: 673.35 (2.60)                    |
| On at CC                | Depth at Main: 672.90 (2.95)                | Depth at Main: 673.01 (2.89)                   |
| Frost Plug              | Pipe Size: 25mm/20mm                        | Pipe Size: 100mm                               |
| Memo:                   | Pipe Material: HDPE Insul. <u>Yes</u> /No   | Pipe Material: SDR28 PVC Insul. <u>Yes</u> /No |
|                         | Length from Main to P/L: 6.00               | Length from Main to P/L: 8.99                  |
|                         |                                             | STORM                                          |
|                         | Squirt Test: <u>Pass</u> /Fail              | Depth at P/L:                                  |
|                         | Frost Protection: <u>Recirc</u> /Heat Trace | Depth at Main:                                 |
|                         | Continuity Test: N/A Pass/Fail              | Pipe Size:                                     |
|                         | PRV Required: Yes/ <u>No</u>                | Pipe Material:                                 |
|                         |                                             | Length from Main to P/L:                       |

CLEARLY INDICATE LOCATION OF CC AND ROUTE OF PIPES ON DRAWING BELOW

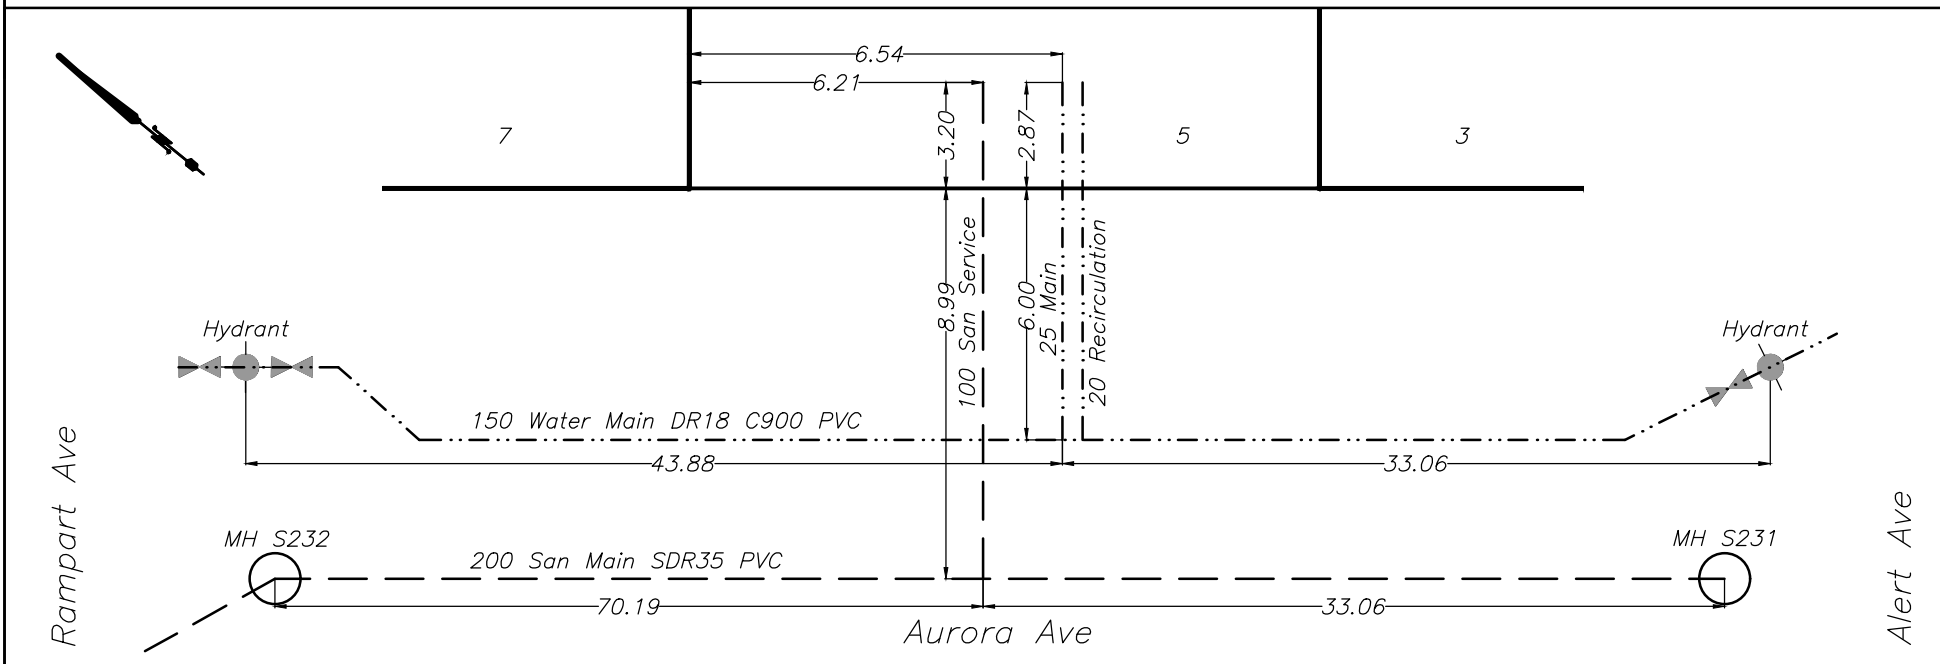




# CITY OF WHITEHORSE

## SERVICE CONNECTION RECORD

NAME P S Sidhu Trucking Ltd. ADDRESS 6 Aurora Drive, Whistle Bend BLOCK                      LOT 1313

| DATES                   | WATER                                         | SEWER                                            |
|-------------------------|-----------------------------------------------|--------------------------------------------------|
| On at Main June 27 2024 | Depth at P/L: 673.53 (2.50)                   | Depth at P/L: 673.44 (2.59)                      |
| On at CC                | Depth at Main: 673.01 (2.92)                  | Depth at Main: 673.07 (2.92)                     |
| Frost Plug              | Pipe Size: 25mm/20mm                          | Pipe Size: 100mm                                 |
| Memo:                   | Pipe Material: HDPE Insul. <u>(Yes)</u> /No   | Pipe Material: SDR28 PVC Insul. <u>(Yes)</u> /No |
|                         | Length from Main to P/L: 12.13                | Length from Main to P/L: 9.08                    |
|                         |                                               | STORM                                            |
|                         | Squirt Test: <u>(Pass)</u> /Fail              | Depth at P/L:                                    |
|                         | Frost Protection: <u>(Recirc)</u> /Heat Trace | Depth at Main:                                   |
|                         | Continuity Test: N/A Pass/Fail                | Pipe Size:                                       |
|                         | PRV Required: Yes/ <u>(No)</u>                | Pipe Material:                                   |
|                         |                                               | Length from Main to P/L:                         |

CLEARLY INDICATE LOCATION OF CC AND ROUTE OF PIPES ON DRAWING BELOW

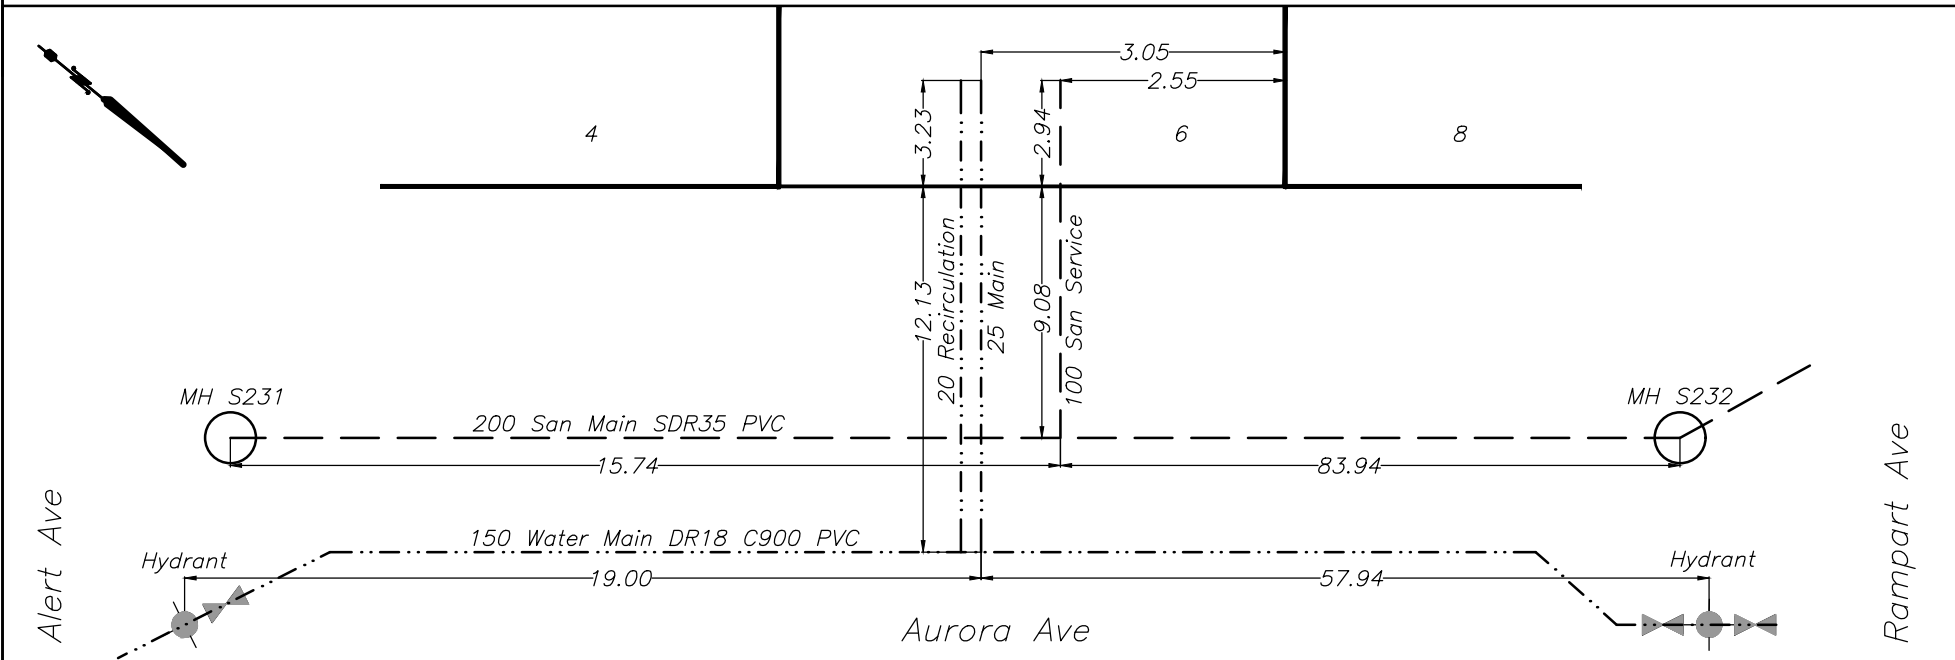




# CITY OF WHITEHORSE

## SERVICE CONNECTION RECORD

NAME P S Sidhu Trucking Ltd. ADDRESS 7 Aurora Drive, Whistle Bend BLOCK                      LOT 1346

| DATES                   | WATER                                       | SEWER                                          |
|-------------------------|---------------------------------------------|------------------------------------------------|
| On at Main June 19 2024 | Depth at P/L: 673.34 (2.53)                 | Depth at P/L: 673.30 (2.58)                    |
| On at CC                | Depth at Main: 672.86 (2.92)                | Depth at Main: 672.94 (2.89)                   |
| Frost Plug              | Pipe Size: 25mm/20mm                        | Pipe Size: 100mm                               |
| Memo:                   | Pipe Material: HDPE Insul. <u>Yes</u> /No   | Pipe Material: SDR28 PVC Insul. <u>Yes</u> /No |
|                         | Length from Main to P/L: 6.04               | Length from Main to P/L: 9.02                  |
|                         |                                             | STORM                                          |
|                         | Squirt Test: <u>Pass</u> /Fail              | Depth at P/L:                                  |
|                         | Frost Protection: <u>Recirc</u> /Heat Trace | Depth at Main:                                 |
|                         | Continuity Test: N/A Pass/Fail              | Pipe Size:                                     |
|                         | PRV Required: Yes/ <u>No</u>                | Pipe Material:                                 |
|                         |                                             | Length from Main to P/L:                       |

CLEARLY INDICATE LOCATION OF CC AND ROUTE OF PIPES ON DRAWING BELOW

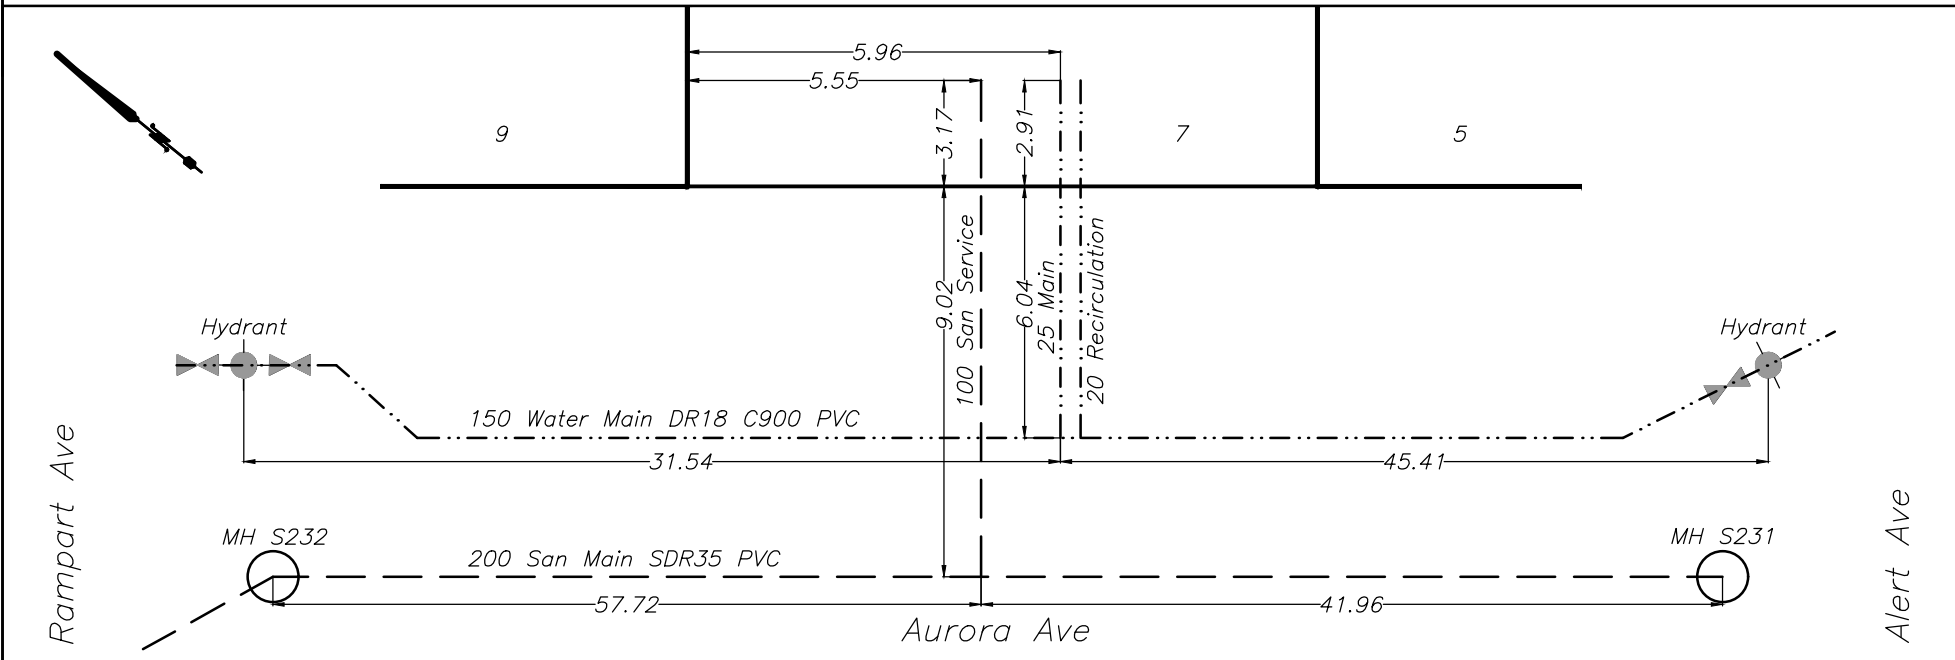




# CITY OF WHITEHORSE

## SERVICE CONNECTION RECORD

NAME P S Sidhu Trucking Ltd. ADDRESS 8 Aurora Drive, Whistle Bend BLOCK                      LOT 1314

| DATES                   | WATER                                       | SEWER                                          |
|-------------------------|---------------------------------------------|------------------------------------------------|
| On at Main June 21 2024 | Depth at P/L: 673.46 (2.53)                 | Depth at P/L: 673.45 (2.54)                    |
| On at CC                | Depth at Main: 672.97 (2.93)                | Depth at Main: 673.08 (2.89)                   |
| Frost Plug              | Pipe Size: 25mm/20mm                        | Pipe Size: 100mm                               |
| Memo:                   | Pipe Material: HDPE Insul. <u>Yes</u> /No   | Pipe Material: SDR28 PVC Insul. <u>Yes</u> /No |
|                         | Length from Main to P/L: 12.21              | Length from Main to P/L: 9.25                  |
|                         |                                             | STORM                                          |
|                         | Squirt Test: <u>Pass</u> /Fail              | Depth at P/L:                                  |
|                         | Frost Protection: <u>Recirc</u> /Heat Trace | Depth at Main:                                 |
|                         | Continuity Test: N/A Pass/Fail              | Pipe Size:                                     |
|                         | PRV Required: Yes/ <u>No</u>                | Pipe Material:                                 |
|                         |                                             | Length from Main to P/L:                       |

CLEARLY INDICATE LOCATION OF CC AND ROUTE OF PIPES ON DRAWING BELOW

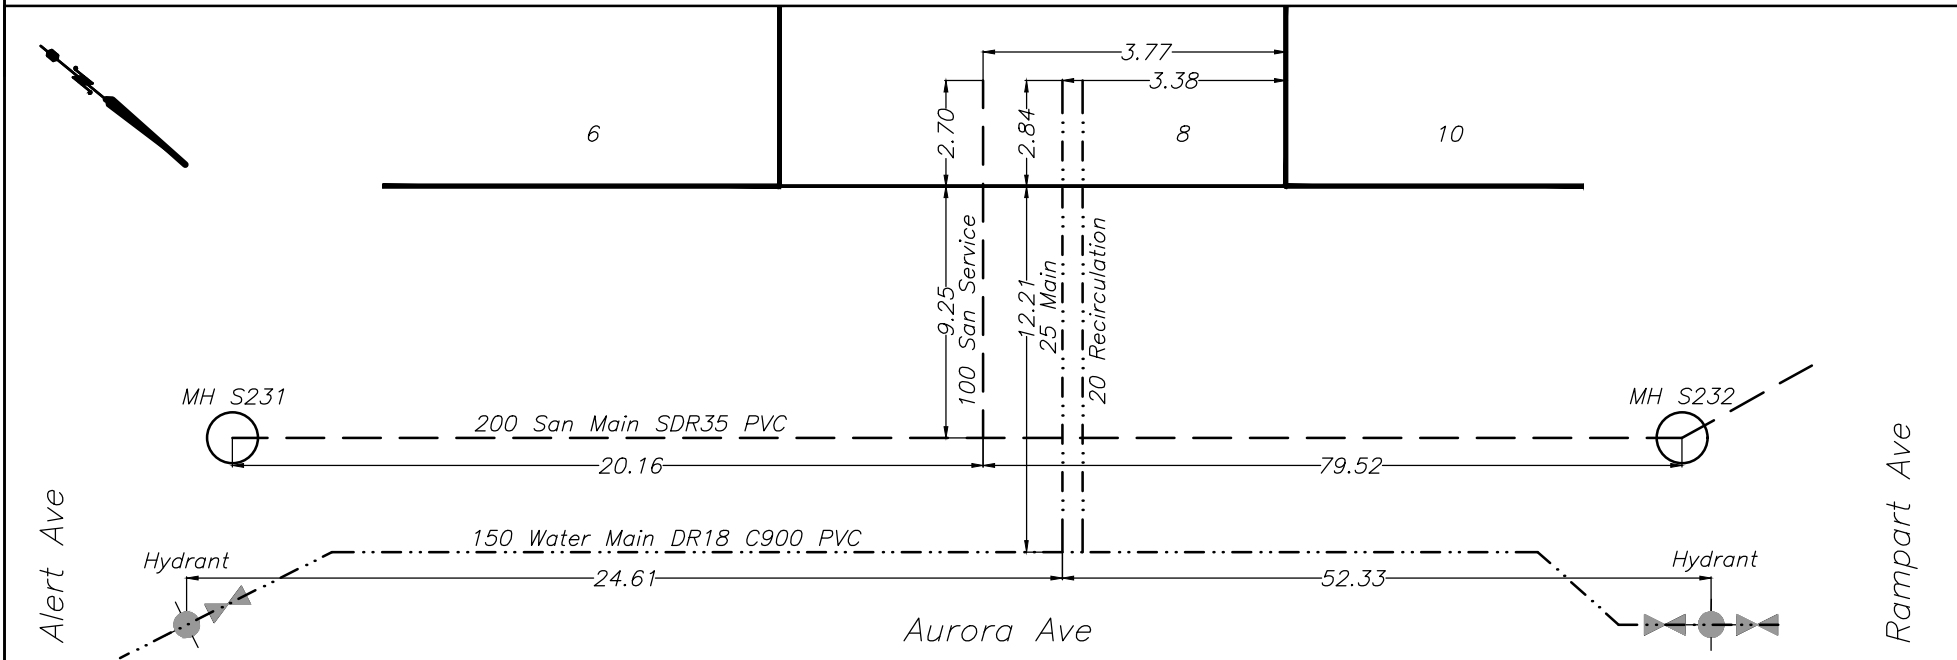




# CITY OF WHITEHORSE

## SERVICE CONNECTION RECORD

NAME P S Sidhu Trucking Ltd. ADDRESS 9 Aurora Drive, Whistle Bend BLOCK                      LOT 1345

| DATES                   | WATER                                       | SEWER                                          |
|-------------------------|---------------------------------------------|------------------------------------------------|
| On at Main June 18 2024 | Depth at P/L: 673.25 (2.54)                 | Depth at P/L: 673.20 (2.60)                    |
| On at CC                | Depth at Main: 672.74 (2.97)                | Depth at Main: 672.86 (2.89)                   |
| Frost Plug              | Pipe Size: 25mm/20mm                        | Pipe Size: 100mm                               |
| Memo:                   | Pipe Material: HDPE Insul. <u>Yes</u> /No   | Pipe Material: SDR28 PVC Insul. <u>Yes</u> /No |
|                         | Length from Main to P/L: 6.05               | Length from Main to P/L: 8.98                  |
|                         |                                             | STORM                                          |
|                         | Squirt Test: <u>Pass</u> /Fail              | Depth at P/L:                                  |
|                         | Frost Protection: <u>Recirc</u> /Heat Trace | Depth at Main:                                 |
|                         | Continuity Test: N/A Pass/Fail              | Pipe Size:                                     |
|                         | PRV Required: Yes/ <u>No</u>                | Pipe Material:                                 |
|                         |                                             | Length from Main to P/L:                       |

CLEARLY INDICATE LOCATION OF CC AND ROUTE OF PIPES ON DRAWING BELOW

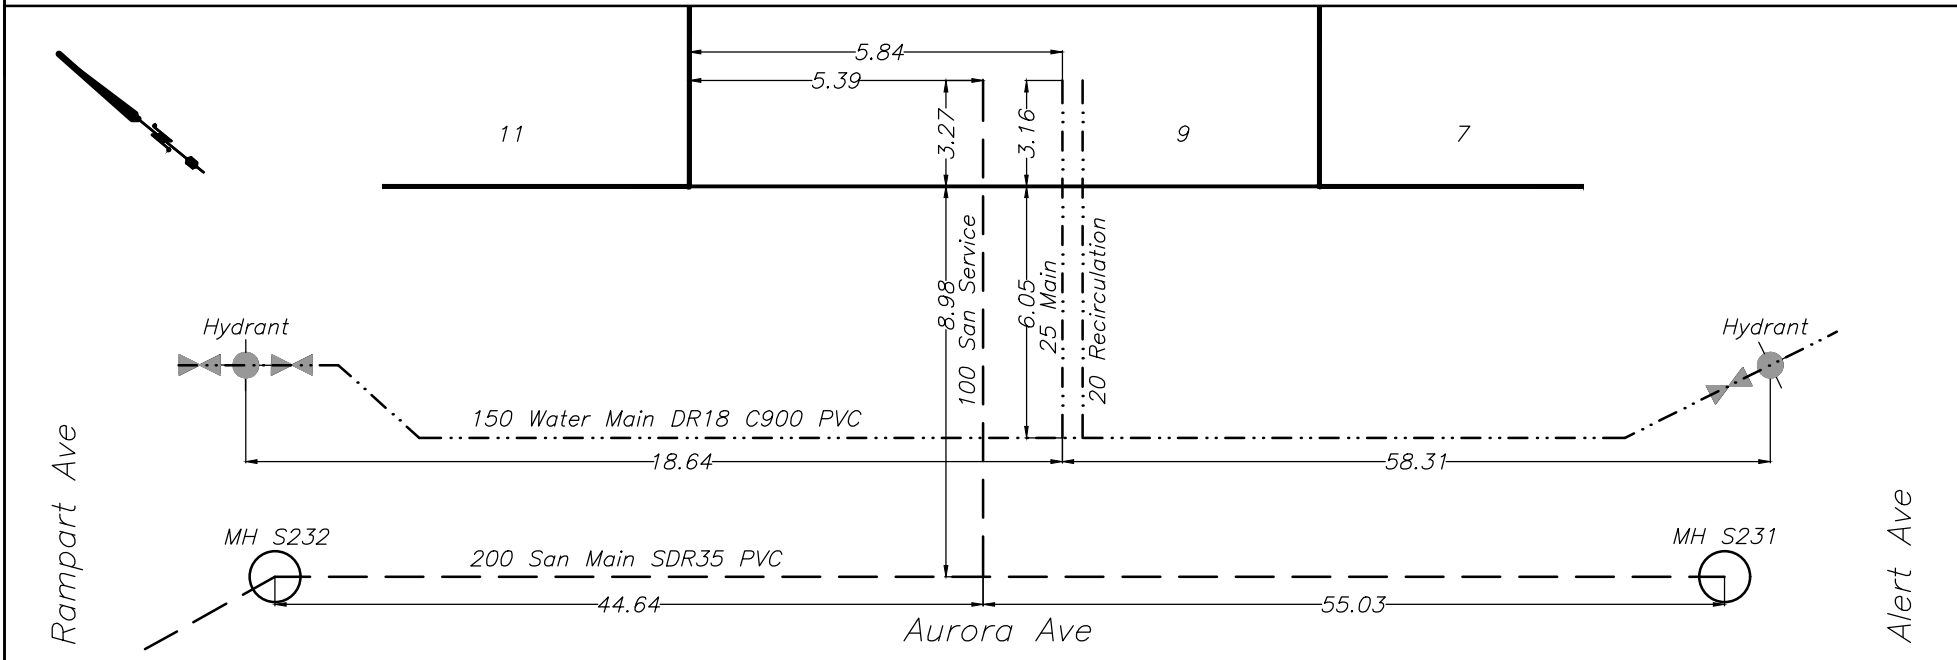




# CITY OF WHITEHORSE

## SERVICE CONNECTION RECORD

NAME P S Sidhu Trucking Ltd. ADDRESS 10 Aurora Drive, Whistle Bend BLOCK                      LOT 1315

| DATES                   | WATER                                       | SEWER                                          |
|-------------------------|---------------------------------------------|------------------------------------------------|
| On at Main June 27 2024 | Depth at P/L: 673.45 (2.50)                 | Depth at P/L: 673.33 (2.61)                    |
| On at CC                | Depth at Main: 672.91 (2.92)                | Depth at Main: 673.00 (2.90)                   |
| Frost Plug              | Pipe Size: 25mm/20mm                        | Pipe Size: 100mm                               |
| Memo:                   | Pipe Material: HDPE Insul. <u>Yes</u> /No   | Pipe Material: SDR28 PVC Insul. <u>Yes</u> /No |
|                         | Length from Main to P/L: 12.03              | Length from Main to P/L: 9.05                  |
|                         |                                             | STORM                                          |
|                         | Squirt Test: <u>Pass</u> /Fail              | Depth at P/L:                                  |
|                         | Frost Protection: <u>Recirc</u> /Heat Trace | Depth at Main:                                 |
|                         | Continuity Test: N/A Pass/Fail              | Pipe Size:                                     |
|                         | PRV Required: Yes/ <u>No</u>                | Pipe Material:                                 |
|                         |                                             | Length from Main to P/L:                       |

CLEARLY INDICATE LOCATION OF CC AND ROUTE OF PIPES ON DRAWING BELOW

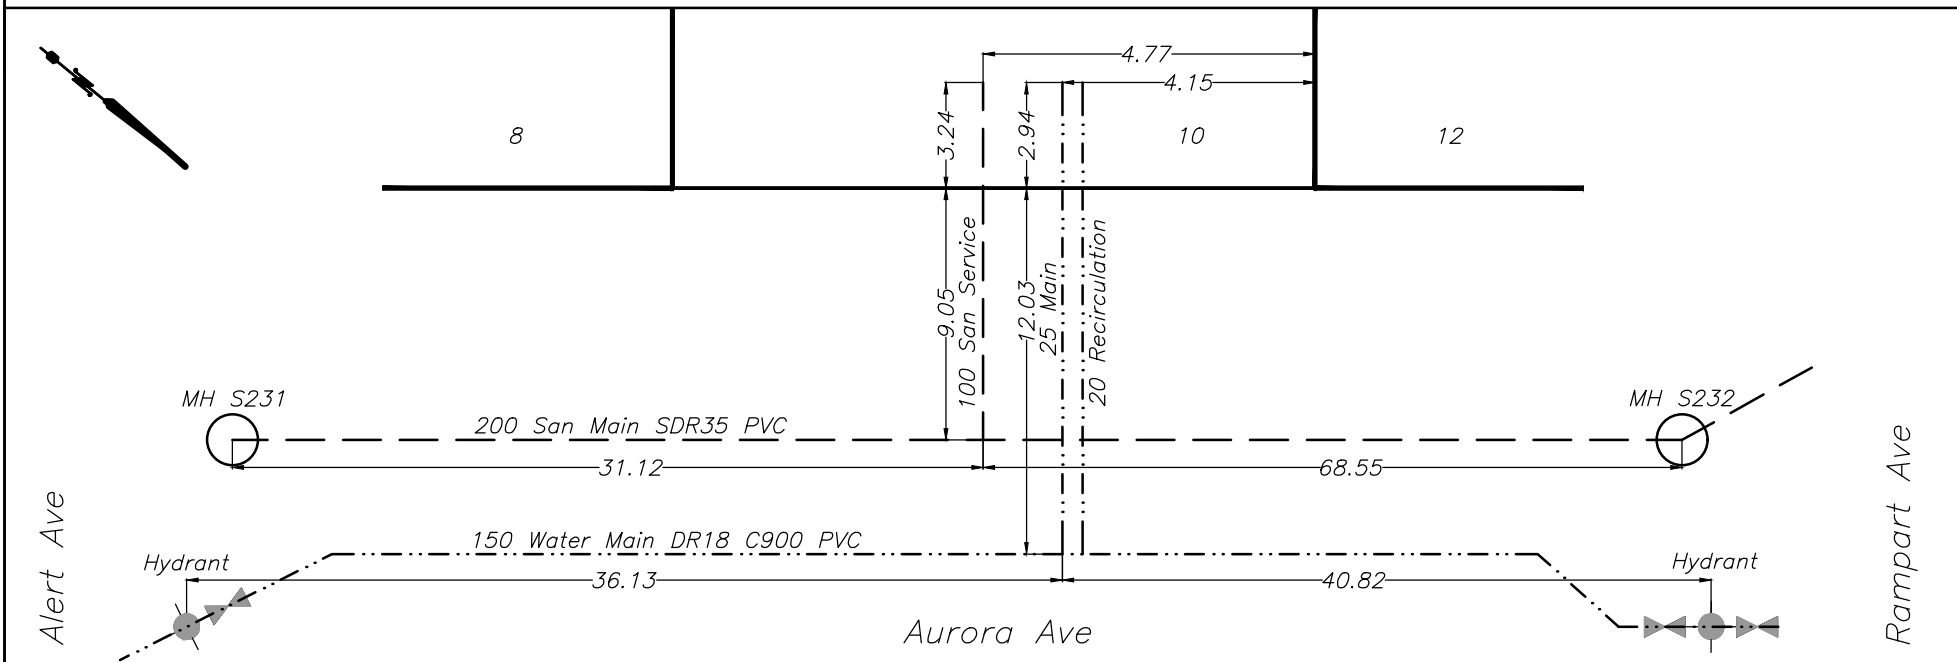




# CITY OF WHITEHORSE

## SERVICE CONNECTION RECORD

NAME P S Sidhu Trucking Ltd. ADDRESS 11 Aurora Drive, Whistle Bend BLOCK                      LOT 1344

| DATES                   | WATER                                       | SEWER                                          |
|-------------------------|---------------------------------------------|------------------------------------------------|
| On at Main June 17 2024 | Depth at P/L: 673.18 (2.55)                 | Depth at P/L: 673.15 (2.58)                    |
| On at CC                | Depth at Main: 672.68 (2.92)                | Depth at Main: 672.79 (2.89)                   |
| Frost Plug              | Pipe Size: 25mm/20mm                        | Pipe Size: 100mm                               |
| Memo:                   | Pipe Material: HDPE Insul. <u>Yes</u> /No   | Pipe Material: SDR28 PVC Insul. Yes/ <u>No</u> |
|                         | Length from Main to P/L: 4.80               | Length from Main to P/L: 8.99                  |
|                         |                                             | STORM                                          |
|                         | Squirt Test: <u>Pass</u> /Fail              | Depth at P/L:                                  |
|                         | Frost Protection: <u>Recirc</u> /Heat Trace | Depth at Main:                                 |
|                         | Continuity Test: N/A Pass/Fail              | Pipe Size:                                     |
|                         | PRV Required: Yes/ <u>No</u>                | Pipe Material:                                 |
|                         |                                             | Length from Main to P/L:                       |

CLEARLY INDICATE LOCATION OF CC AND ROUTE OF PIPES ON DRAWING BELOW

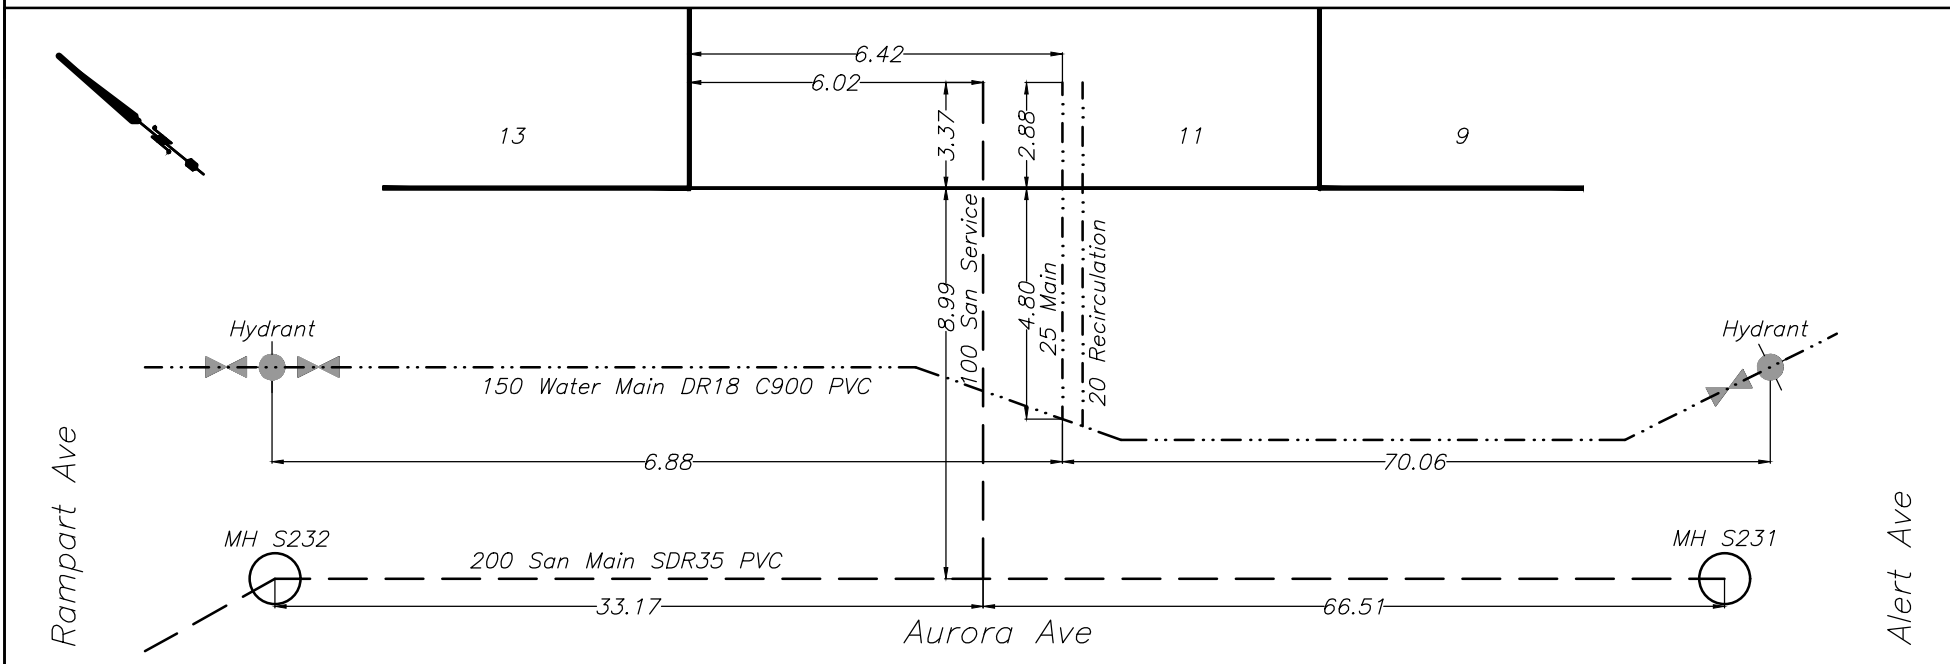




# CITY OF WHITEHORSE

## SERVICE CONNECTION RECORD

NAME P S Sidhu Trucking Ltd. ADDRESS 12 Aurora Drive, Whistle Bend BLOCK \_\_\_\_\_ LOT 1316

| DATES                   | WATER                                       | SEWER                                          |
|-------------------------|---------------------------------------------|------------------------------------------------|
| On at Main June 21 2024 | Depth at P/L: 673.42 (2.48)                 | Depth at P/L: 673.38 (2.52)                    |
| On at CC                | Depth at Main: 672.88 (2.93)                | Depth at Main: 672.97 (2.89)                   |
| Frost Plug              | Pipe Size: 25mm/20mm                        | Pipe Size: 100mm                               |
| Memo:                   | Pipe Material: HDPE Insul. <u>Yes</u> /No   | Pipe Material: SDR28 PVC Insul. <u>Yes</u> /No |
|                         | Length from Main to P/L: 12.14              | Length from Main to P/L: 9.26                  |
|                         |                                             | STORM                                          |
|                         | Squirt Test: <u>Pass</u> /Fail              | Depth at P/L:                                  |
|                         | Frost Protection: <u>Recirc</u> /Heat Trace | Depth at Main:                                 |
|                         | Continuity Test: N/A Pass/Fail              | Pipe Size:                                     |
|                         | PRV Required: Yes/ <u>No</u>                | Pipe Material:                                 |
|                         |                                             | Length from Main to P/L:                       |

CLEARLY INDICATE LOCATION OF CC AND ROUTE OF PIPES ON DRAWING BELOW

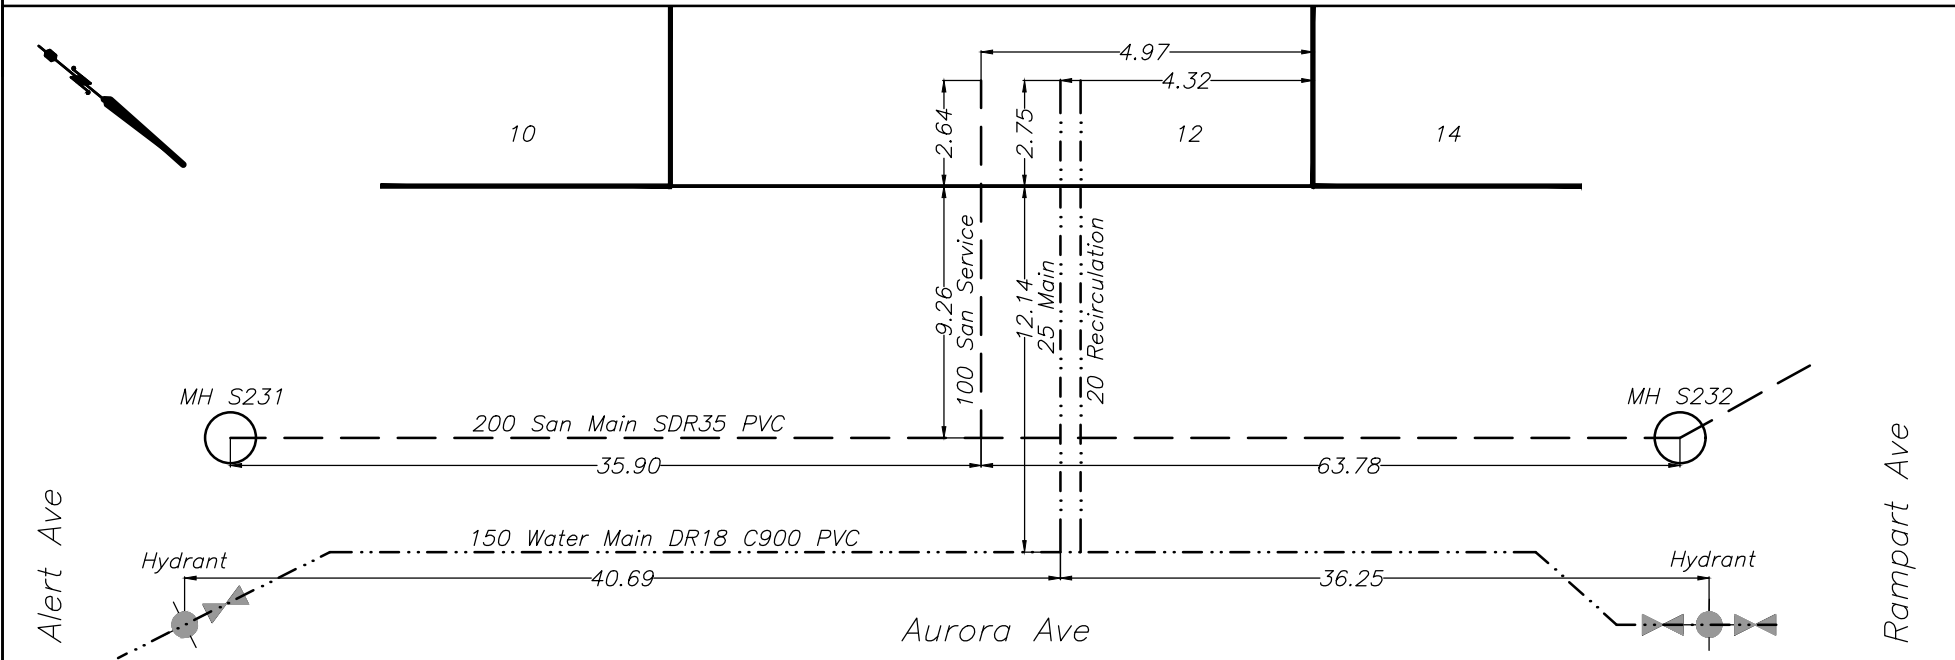




# CITY OF WHITEHORSE

## SERVICE CONNECTION RECORD

NAME P S Sidhu Trucking Ltd. ADDRESS 13 Aurora Drive, Whistle Bend BLOCK \_\_\_\_\_ LOT 1343

| DATES                   | WATER                                       | SEWER                                          |
|-------------------------|---------------------------------------------|------------------------------------------------|
| On at Main June 18 2024 | Depth at P/L: 673.14 (2.51)                 | Depth at P/L: 673.05 (2.61)                    |
| On at CC                | Depth at Main: 672.60 (2.99)                | Depth at Main: 672.70 (2.90)                   |
| Frost Plug              | Pipe Size: 25mm/20mm                        | Pipe Size: 100mm                               |
| Memo:                   | Pipe Material: HDPE Insul. <u>Yes</u> /No   | Pipe Material: SDR28 PVC Insul. Yes/ <u>No</u> |
|                         | Length from Main to P/L: 3.03               | Length from Main to P/L: 9.02                  |
|                         |                                             | STORM                                          |
|                         | Squirt Test: <u>Pass</u> /Fail              | Depth at P/L:                                  |
|                         | Frost Protection: <u>Recirc</u> /Heat Trace | Depth at Main:                                 |
|                         | Continuity Test: N/A Pass/Fail              | Pipe Size:                                     |
|                         | PRV Required: Yes/ <u>No</u>                | Pipe Material:                                 |
|                         |                                             | Length from Main to P/L:                       |

CLEARLY INDICATE LOCATION OF CC AND ROUTE OF PIPES ON DRAWING BELOW

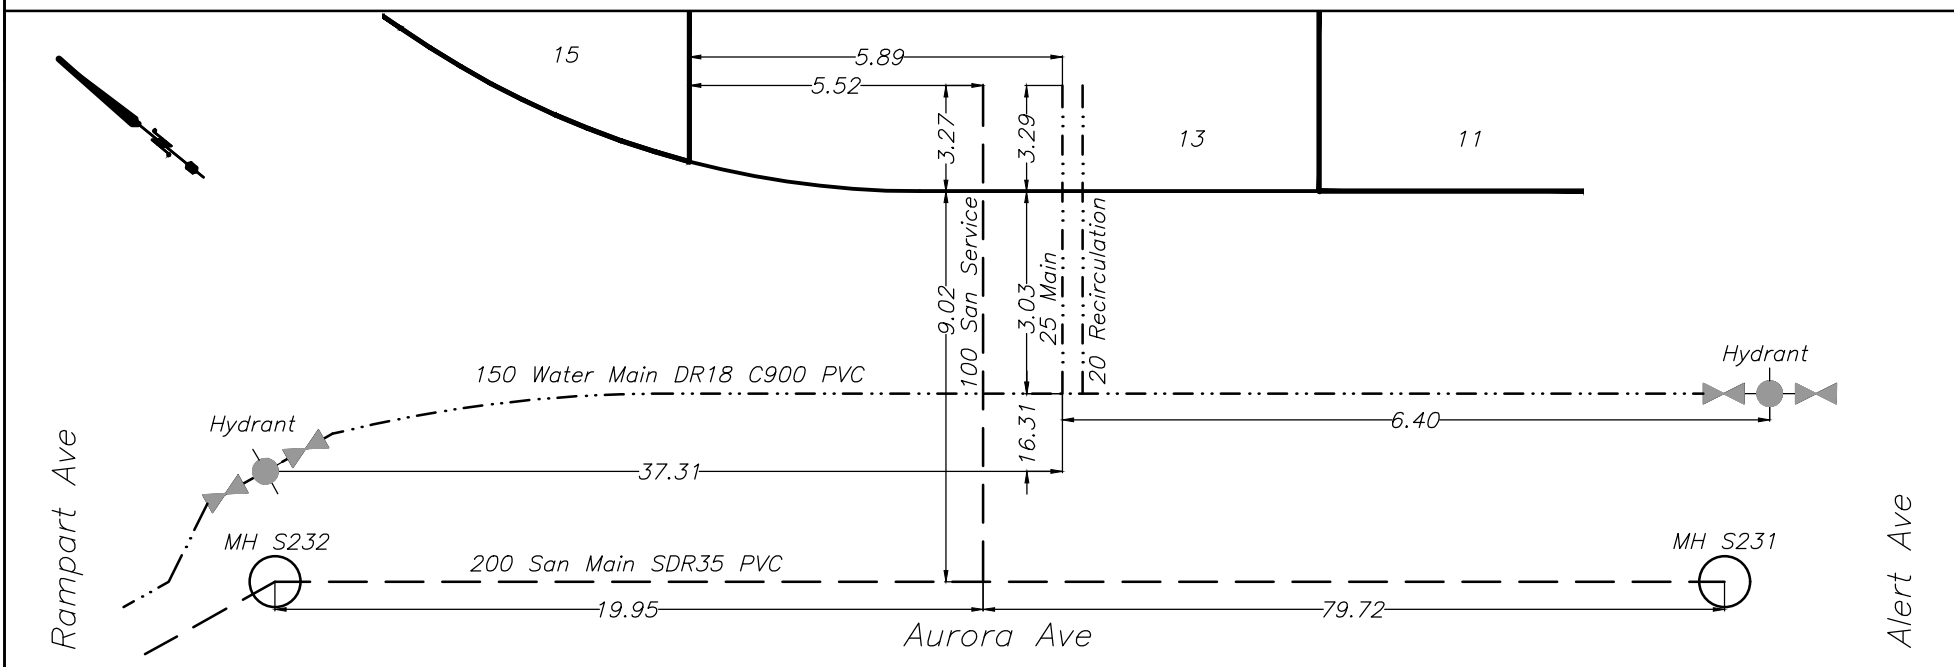




# CITY OF WHITEHORSE

## SERVICE CONNECTION RECORD

NAME P S Sidhu Trucking Ltd. ADDRESS 14 Aurora Drive, Whistle Bend BLOCK                      LOT 1317

| DATES                   | WATER                                       | SEWER                                          |
|-------------------------|---------------------------------------------|------------------------------------------------|
| On at Main June 27 2024 | Depth at P/L: 673.31 (2.54)                 | Depth at P/L: 673.25 (2.60)                    |
| On at CC                | Depth at Main: 672.79 (2.95)                | Depth at Main: 672.92 (2.88)                   |
| Frost Plug              | Pipe Size: 25mm/20mm                        | Pipe Size: 100mm                               |
| Memo:                   | Pipe Material: HDPE Insul. <u>Yes</u> /No   | Pipe Material: SDR28 PVC Insul. <u>Yes</u> /No |
|                         | Length from Main to P/L: 12.01              | Length from Main to P/L: 8.97                  |
|                         |                                             | STORM                                          |
|                         | Squirt Test: <u>Pass</u> /Fail              | Depth at P/L:                                  |
|                         | Frost Protection: <u>Recirc</u> /Heat Trace | Depth at Main:                                 |
|                         | Continuity Test: N/A Pass/Fail              | Pipe Size:                                     |
|                         | PRV Required: Yes/ <u>No</u>                | Pipe Material:                                 |
|                         |                                             | Length from Main to P/L:                       |

CLEARLY INDICATE LOCATION OF CC AND ROUTE OF PIPES ON DRAWING BELOW

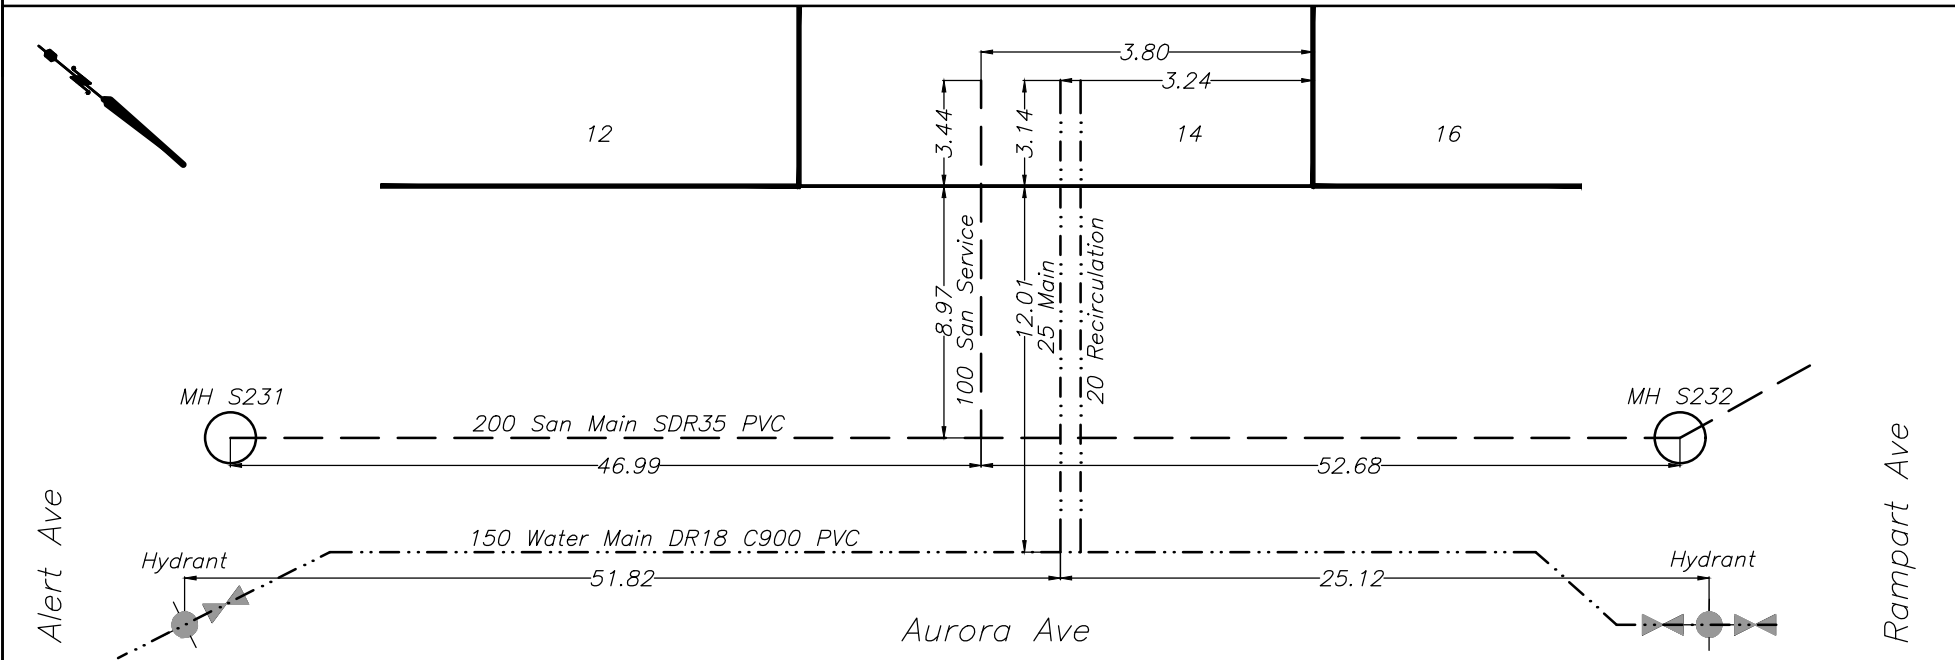




# CITY OF WHITEHORSE

## SERVICE CONNECTION RECORD

NAME P S Sidhu Trucking Ltd. ADDRESS 15 Aurora Drive, Whistle Bend BLOCK \_\_\_\_\_ LOT 1342

| DATES                   | WATER                                       | SEWER                                          |
|-------------------------|---------------------------------------------|------------------------------------------------|
| On at Main June 21 2024 | Depth at P/L: 673.05 (2.61)                 | Depth at P/L: 673.05 (2.61)                    |
| On at CC                | Depth at Main: 672.58 (2.96)                | Depth at Main: 672.63 (2.89)                   |
| Frost Plug              | Pipe Size: 25mm/20mm                        | Pipe Size: 100mm                               |
| Memo:                   | Pipe Material: HDPE Insul. <u>Yes</u> /No   | Pipe Material: SDR28 PVC Insul. <u>Yes</u> /No |
|                         | Length from Main to P/L: 6.78               | Length from Main to P/L: 13.02                 |
|                         |                                             | STORM                                          |
|                         | Squirt Test: <u>Pass</u> /Fail              | Depth at P/L:                                  |
|                         | Frost Protection: <u>Recirc</u> /Heat Trace | Depth at Main:                                 |
|                         | Continuity Test: N/A Pass/Fail              | Pipe Size:                                     |
|                         | PRV Required: Yes/ <u>No</u>                | Pipe Material:                                 |
|                         |                                             | Length from Main to P/L:                       |

CLEARLY INDICATE LOCATION OF CC AND ROUTE OF PIPES ON DRAWING BELOW

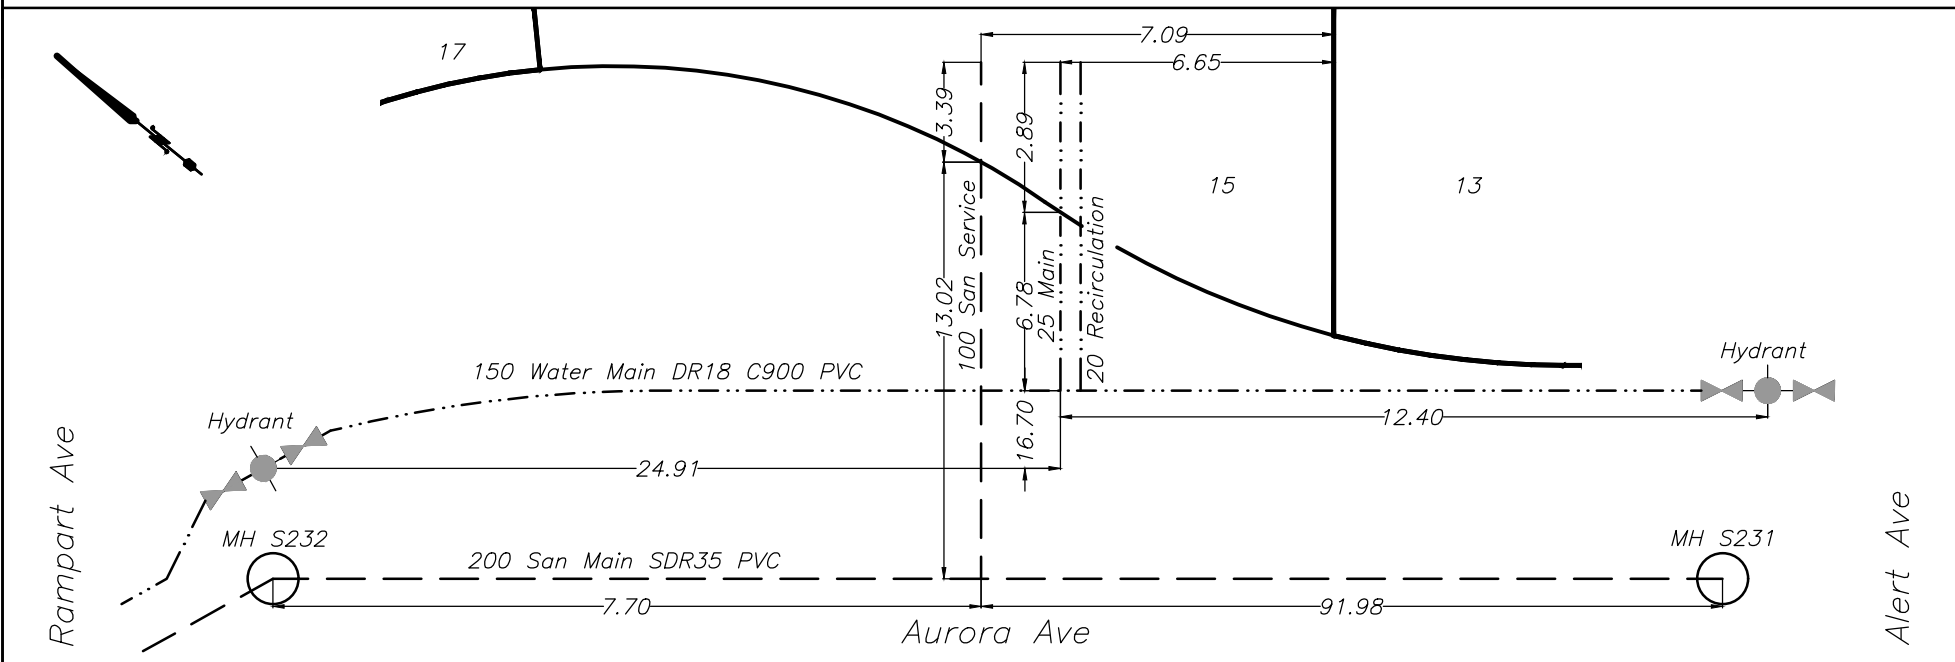




# CITY OF WHITEHORSE

## SERVICE CONNECTION RECORD

NAME P S Sidhu Trucking Ltd. ADDRESS 16 Aurora Drive, Whistle Bend BLOCK \_\_\_\_\_ LOT 1318

| DATES                   | WATER                                       | SEWER                                          |
|-------------------------|---------------------------------------------|------------------------------------------------|
| On at Main June 22 2024 | Depth at P/L: 673.25 (2.55)                 | Depth at P/L: 673.25 (2.55)                    |
| On at CC                | Depth at Main: 672.51 (3.21)                | Depth at Main: 672.88 (2.89)                   |
| Frost Plug              | Pipe Size: 25mm/20mm                        | Pipe Size: 100mm                               |
| Memo:                   | Pipe Material: HDPE Insul. <u>Yes</u> /No   | Pipe Material: SDR28 PVC Insul. <u>Yes</u> /No |
|                         | Length from Main to P/L: 12.53              | Length from Main to P/L: 9.40                  |
|                         |                                             | STORM                                          |
|                         | Squirt Test: <u>Pass</u> /Fail              | Depth at P/L:                                  |
|                         | Frost Protection: <u>Recirc</u> /Heat Trace | Depth at Main:                                 |
|                         | Continuity Test: N/A Pass/Fail              | Pipe Size:                                     |
|                         | PRV Required: Yes/ <u>No</u>                | Pipe Material:                                 |
|                         |                                             | Length from Main to P/L:                       |

CLEARLY INDICATE LOCATION OF CC AND ROUTE OF PIPES ON DRAWING BELOW

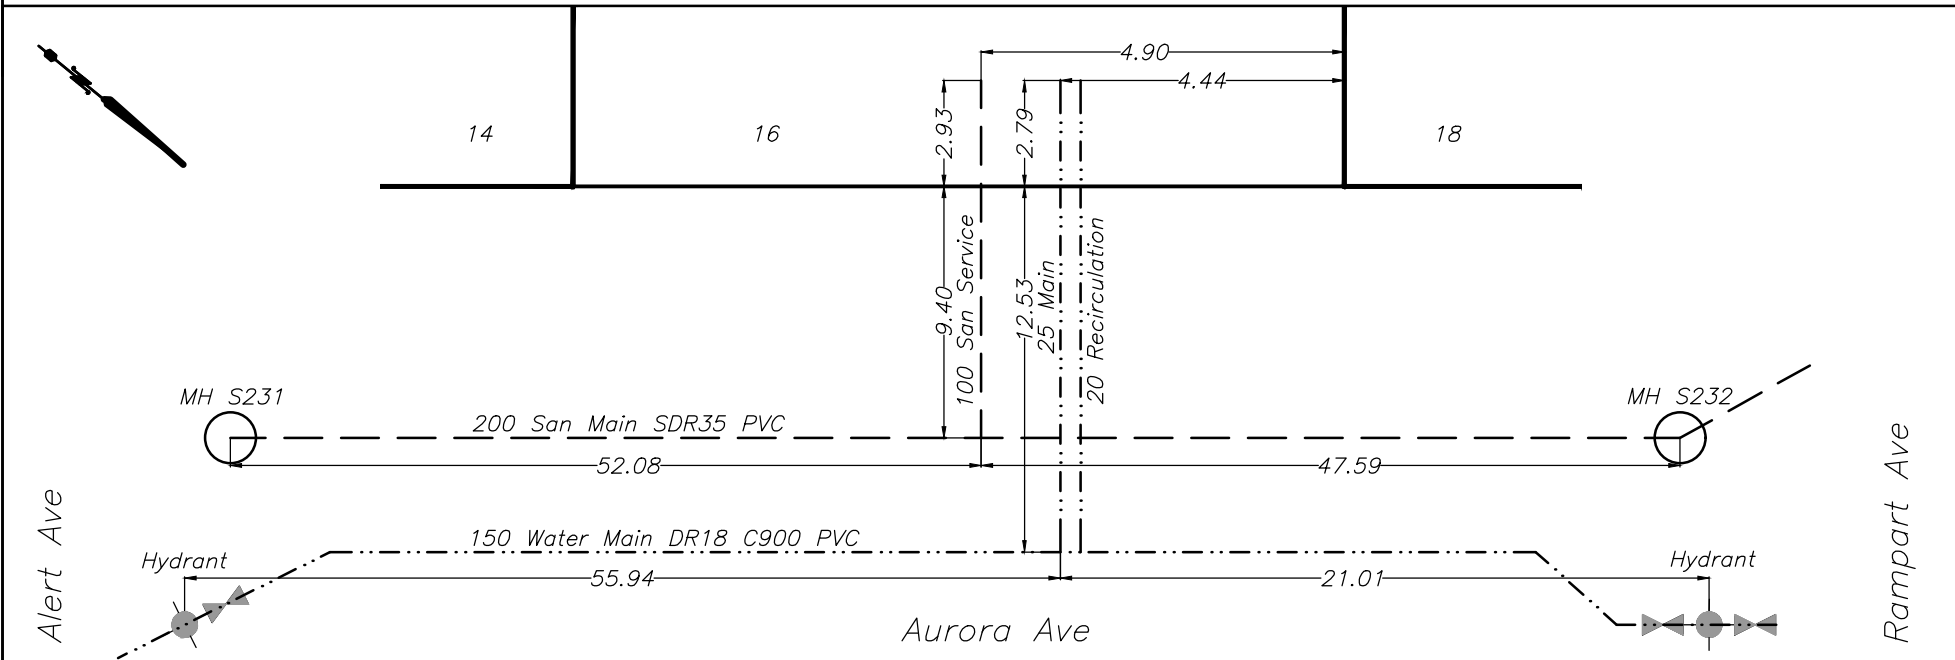




# CITY OF WHITEHORSE

## SERVICE CONNECTION RECORD

NAME P S Sidhu Trucking Ltd. ADDRESS 17 Aurora Drive, Whistle Bend BLOCK \_\_\_\_\_ LOT 1341

| DATES                   | WATER                                       | SEWER                                          |
|-------------------------|---------------------------------------------|------------------------------------------------|
| On at Main June 16 2024 | Depth at P/L: 672.49 (3.12)                 | Depth at P/L: 673.00 (2.61)                    |
| On at CC                | Depth at Main: 673.06 (2.41)                | Depth at Main: 672.60 (2.81)                   |
| Frost Plug              | Pipe Size: 25mm/20mm                        | Pipe Size: 100mm                               |
| Memo:                   | Pipe Material: HDPE Insul. <u>Yes</u> /No   | Pipe Material: SDR28 PVC Insul. <u>Yes</u> /No |
|                         | Length from Main to P/L: 11.98              | Length from Main to P/L: 14.91                 |
|                         |                                             | STORM                                          |
|                         | Squirt Test: <u>Pass</u> /Fail              | Depth at P/L:                                  |
|                         | Frost Protection: <u>Recirc</u> /Heat Trace | Depth at Main:                                 |
|                         | Continuity Test: N/A Pass/Fail              | Pipe Size:                                     |
|                         | PRV Required: Yes/ <u>No</u>                | Pipe Material:                                 |
|                         |                                             | Length from Main to P/L:                       |

CLEARLY INDICATE LOCATION OF CC AND ROUTE OF PIPES ON DRAWING BELOW

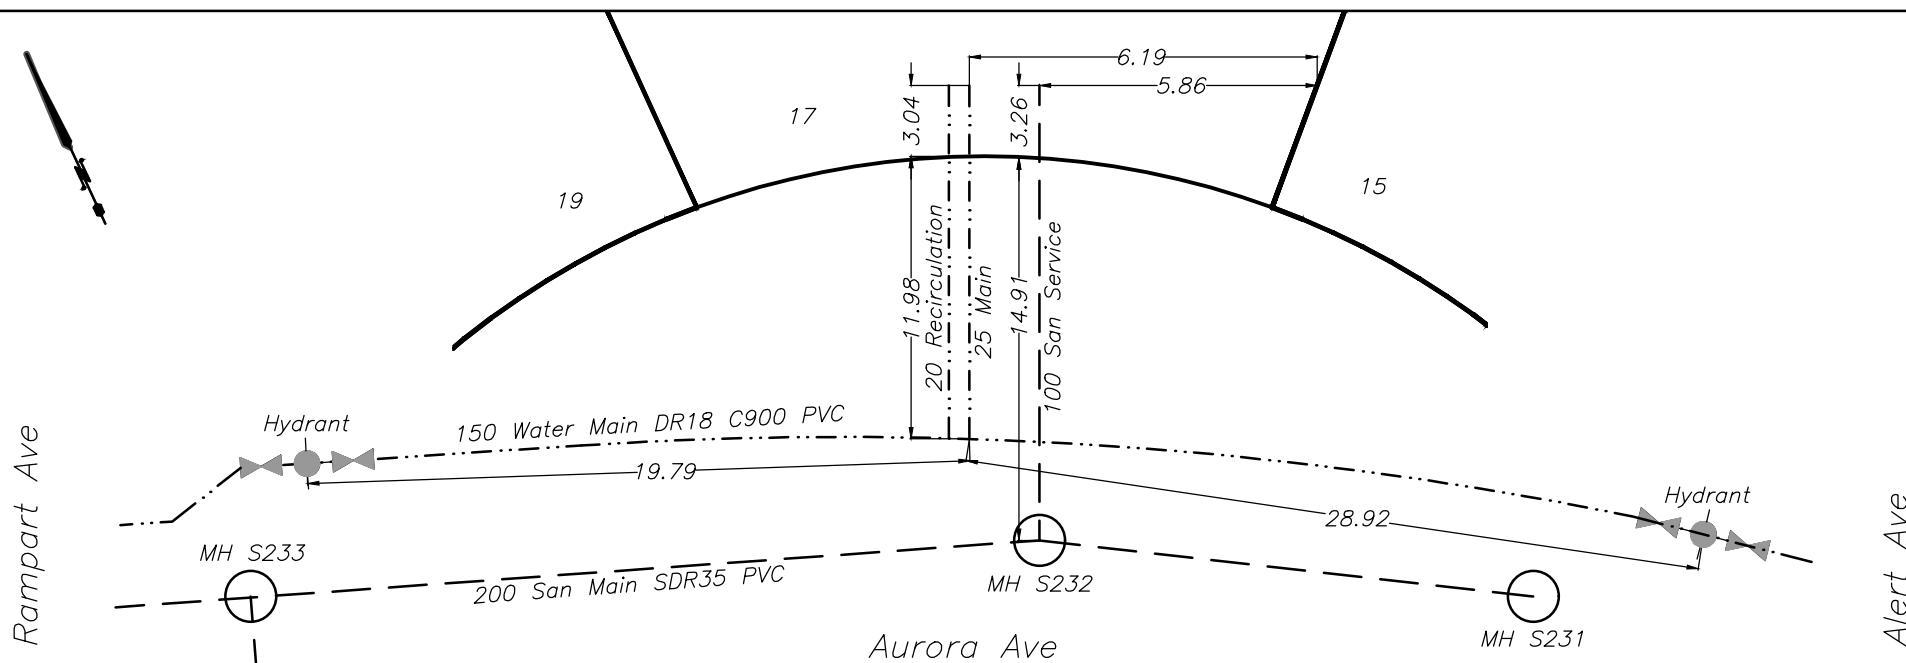




# CITY OF WHITEHORSE

## SERVICE CONNECTION RECORD

NAME P S Sidhu Trucking Ltd. ADDRESS 18 Aurora Drive, Whistle Bend BLOCK \_\_\_\_\_ LOT 1319

| DATES                   | WATER                                       | SEWER                                          |
|-------------------------|---------------------------------------------|------------------------------------------------|
| On at Main June 24 2024 | Depth at P/L: 673.15 (2.56)                 | Depth at P/L: 673.13 (2.58)                    |
| On at CC                | Depth at Main: 672.67 (2.98)                | Depth at Main: 672.78 (2.89)                   |
| Frost Plug              | Pipe Size: 25mm/20mm                        | Pipe Size: 100mm                               |
| Memo:                   | Pipe Material: HDPE Insul. <u>Yes</u> /No   | Pipe Material: SDR28 PVC Insul. <u>Yes</u> /No |
|                         | Length from Main to P/L: 15.07              | Length from Main to P/L: 9.01                  |
|                         |                                             | STORM                                          |
|                         | Squirt Test: <u>Pass</u> /Fail              | Depth at P/L:                                  |
|                         | Frost Protection: <u>Recirc</u> /Heat Trace | Depth at Main:                                 |
|                         | Continuity Test: N/A Pass/Fail              | Pipe Size:                                     |
|                         | PRV Required: Yes/ <u>No</u>                | Pipe Material:                                 |
|                         |                                             | Length from Main to P/L:                       |

CLEARLY INDICATE LOCATION OF CC AND ROUTE OF PIPES ON DRAWING BELOW

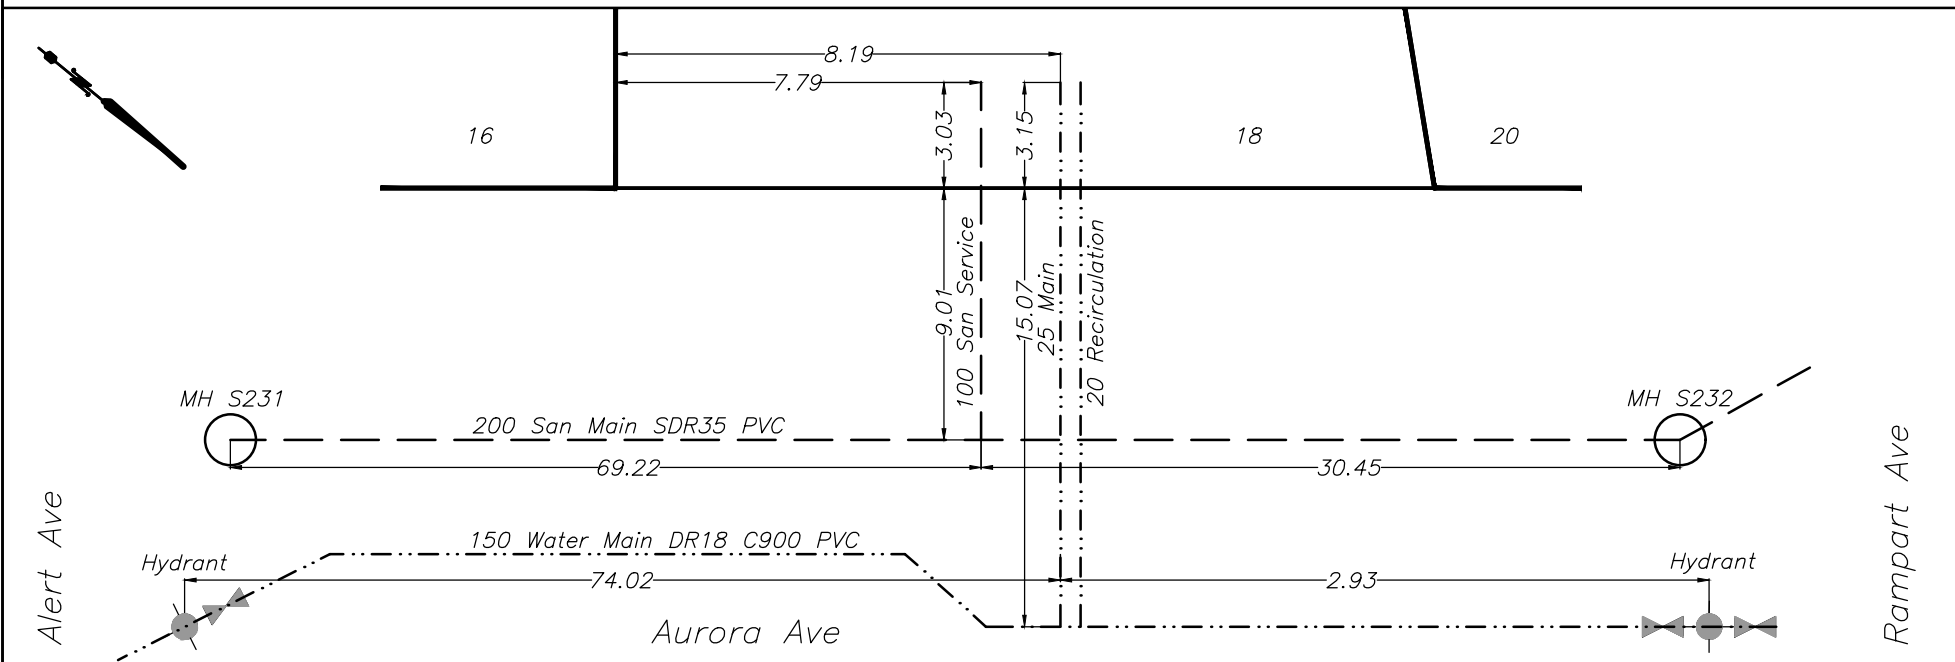




# CITY OF WHITEHORSE

## SERVICE CONNECTION RECORD

NAME P S Sidhu Trucking Ltd. ADDRESS 19 Aurora Drive, Whistle Bend BLOCK                      LOT 1340

| DATES                   | WATER                                       | SEWER                                          |
|-------------------------|---------------------------------------------|------------------------------------------------|
| On at Main June 21 2024 | Depth at P/L: 673.01 (2.54)                 | Depth at P/L: 672.97 (2.58)                    |
| On at CC                | Depth at Main: 672.44 (3.02)                | Depth at Main: 672.52 (2.92)                   |
| Frost Plug              | Pipe Size: 25mm/20mm                        | Pipe Size: 100mm                               |
| Memo:                   | Pipe Material: HDPE Insul. <u>Yes</u> /No   | Pipe Material: SDR28 PVC Insul. <u>Yes</u> /No |
|                         | Length from Main to P/L: 9.53               | Length from Main to P/L: 14.06                 |
|                         |                                             | STORM                                          |
|                         | Squirt Test: <u>Pass</u> /Fail              | Depth at P/L:                                  |
|                         | Frost Protection: <u>Recirc</u> /Heat Trace | Depth at Main:                                 |
|                         | Continuity Test: N/A Pass/Fail              | Pipe Size:                                     |
|                         | PRV Required: Yes/ <u>No</u>                | Pipe Material:                                 |
|                         |                                             | Length from Main to P/L:                       |


CLEARLY INDICATE LOCATION OF CC AND ROUTE OF PIPES ON DRAWING BELOW

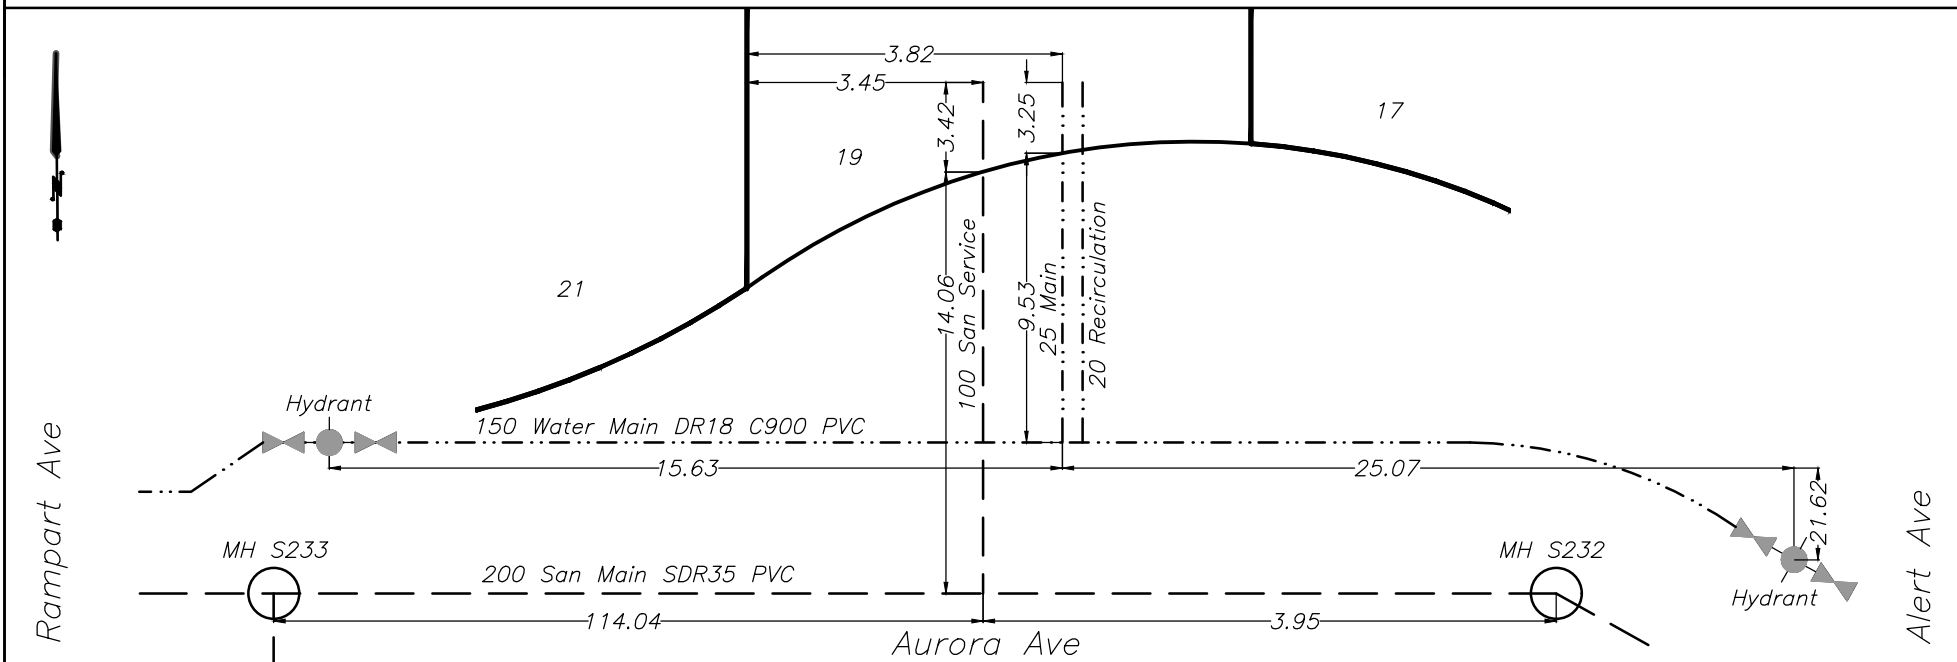



| DATES      |              | WATER                    |                           | SEWER                 |                          |           |
|------------|--------------|--------------------------|---------------------------|-----------------------|--------------------------|-----------|
| On at Main | June 25 2024 | Depth at P/L:            | 673.09 (2.55)             | Depth at P/L:         | 673.03 (2.61)            |           |
| On at CC   |              | Depth at Main:           | 672.60 (2.97)             | Depth at Main:        | 672.68 (2.90)            |           |
| Frost Plug |              | Pipe Size:               | 25mm/20mm                 | Pipe Size:            | 100mm                    |           |
| Memo:      |              | Pipe Material:           | HDPE                      | Insul. <u>Yes</u> /No | Pipe Material:           | SDR28 PVC |
|            |              | Length from Main to P/L: | 15.14                     |                       | Length from Main to P/L: | 9.10      |
|            |              |                          |                           |                       | STORM                    |           |
|            |              | Squirt Test:             | <u>Pass</u> /Fail         |                       | Depth at P/L:            |           |
|            |              | Frost Protection:        | <u>Recirc</u> /Heat Trace |                       | Depth at Main:           |           |
|            |              | Continuity Test:         | N/A                       | Pass/Fail             | Pipe Size:               |           |
|            |              | PRV Required:            | Yes/ <u>No</u>            |                       | Pipe Material:           |           |
|            |              |                          |                           |                       | Length from Main to P/L: |           |

*CLEARLY INDICATE LOCATION OF CC AND ROUTE OF PIPES ON DRAWING BELOW*

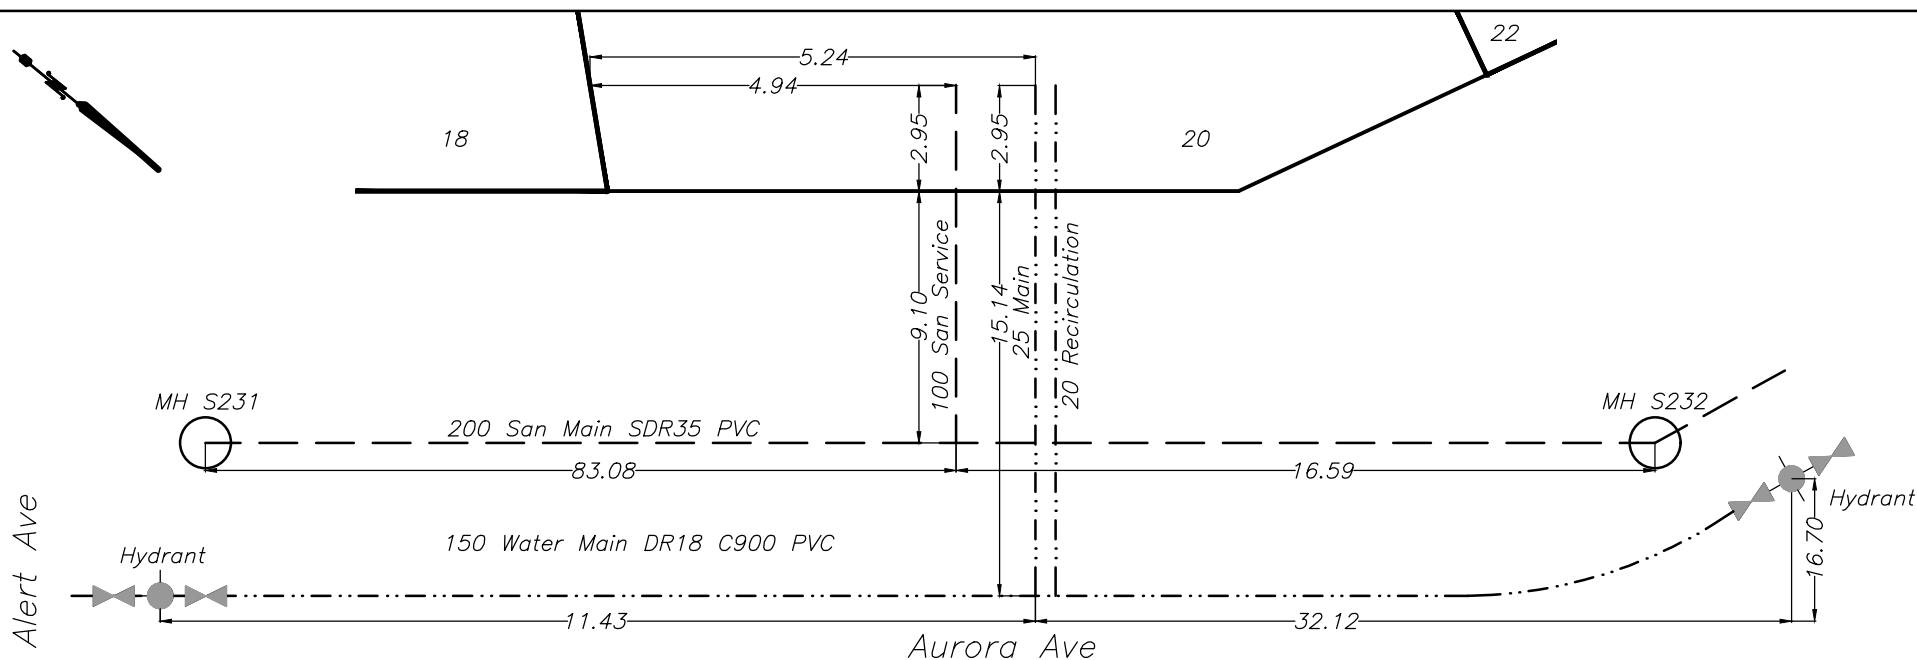




# CITY OF WHITEHORSE

## SERVICE CONNECTION RECORD

NAME P S Sidhu Trucking Ltd. ADDRESS 21 Aurora Avenue, Whistle Bend BLOCK \_\_\_\_\_ LOT 1339

| DATES                   | WATER                                       | SEWER                                          |
|-------------------------|---------------------------------------------|------------------------------------------------|
| On at Main June 22 2024 | Depth at P/L: 672.90 (2.58)                 | Depth at P/L: 672.84 (2.64)                    |
| On at CC                | Depth at Main: 672.43 (2.97)                | Depth at Main: 672.47 (2.94)                   |
| Frost Plug              | Pipe Size: 25mm/20mm                        | Pipe Size: 100mm                               |
| Memo:                   | Pipe Material: HDPE Insul. <u>Yes</u> /No   | Pipe Material: SDR28 PVC Insul. <u>Yes</u> /No |
|                         | Length from Main to P/L: 3.90               | Length from Main to P/L: 9.78                  |
|                         |                                             | STORM                                          |
|                         | Squirt Test: <u>Pass</u> /Fail              | Depth at P/L:                                  |
|                         | Frost Protection: <u>Recirc</u> /Heat Trace | Depth at Main:                                 |
|                         | Continuity Test: N/A Pass/Fail              | Pipe Size:                                     |
|                         | PRV Required: Yes/ <u>No</u>                | Pipe Material:                                 |
|                         |                                             | Length from Main to P/L:                       |

CLEARLY INDICATE LOCATION OF CC AND ROUTE OF PIPES ON DRAWING BELOW

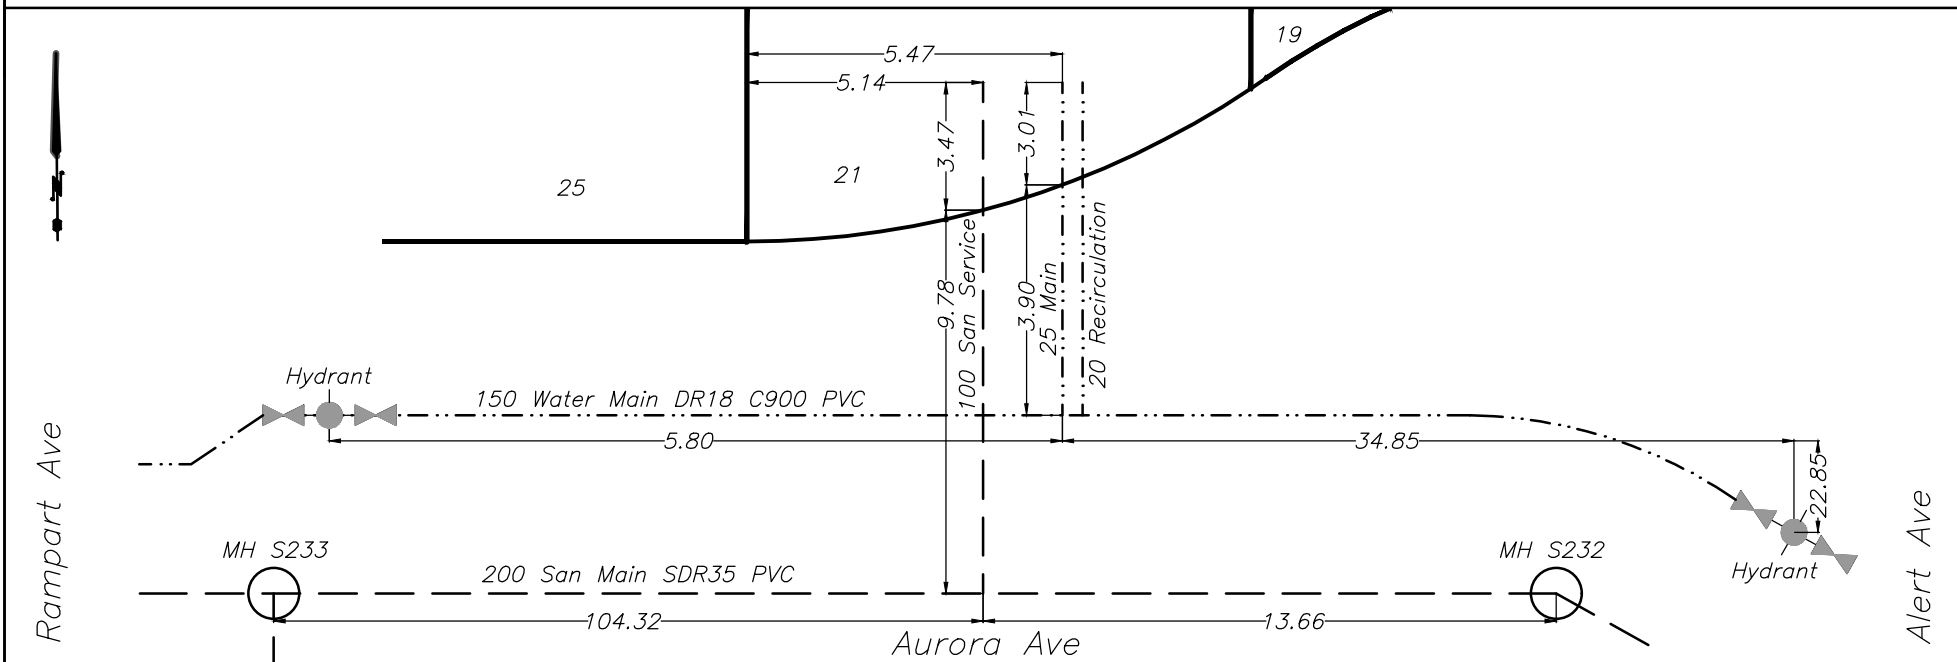




# CITY OF WHITEHORSE

## SERVICE CONNECTION RECORD

NAME P S Sidhu Trucking Ltd. ADDRESS 22 Aurora Drive, Whistle Bend BLOCK \_\_\_\_\_ LOT 1321

| DATES                   | WATER                                       | SEWER                                          |
|-------------------------|---------------------------------------------|------------------------------------------------|
| On at Main June 22 2024 | Depth at P/L: 672.88 (2.57)                 | Depth at P/L: 672.84 (2.61)                    |
| On at CC                | Depth at Main: 672.41 (2.98)                | Depth at Main: 672.47 (2.94)                   |
| Frost Plug              | Pipe Size: 25mm/20mm                        | Pipe Size: 100mm                               |
| Memo:                   | Pipe Material: HDPE Insul. <u>Yes</u> /No   | Pipe Material: SDR28 PVC Insul. <u>Yes</u> /No |
|                         | Length from Main to P/L: 15.02              | Length from Main to P/L: 8.99                  |
|                         |                                             | STORM                                          |
|                         | Squirt Test: <u>Pass</u> /Fail              | Depth at P/L:                                  |
|                         | Frost Protection: <u>Recirc</u> /Heat Trace | Depth at Main:                                 |
|                         | Continuity Test: N/A Pass/Fail              | Pipe Size:                                     |
|                         | PRV Required: Yes/ <u>No</u>                | Pipe Material:                                 |
|                         |                                             | Length from Main to P/L:                       |

CLEARLY INDICATE LOCATION OF CC AND ROUTE OF PIPES ON DRAWING BELOW

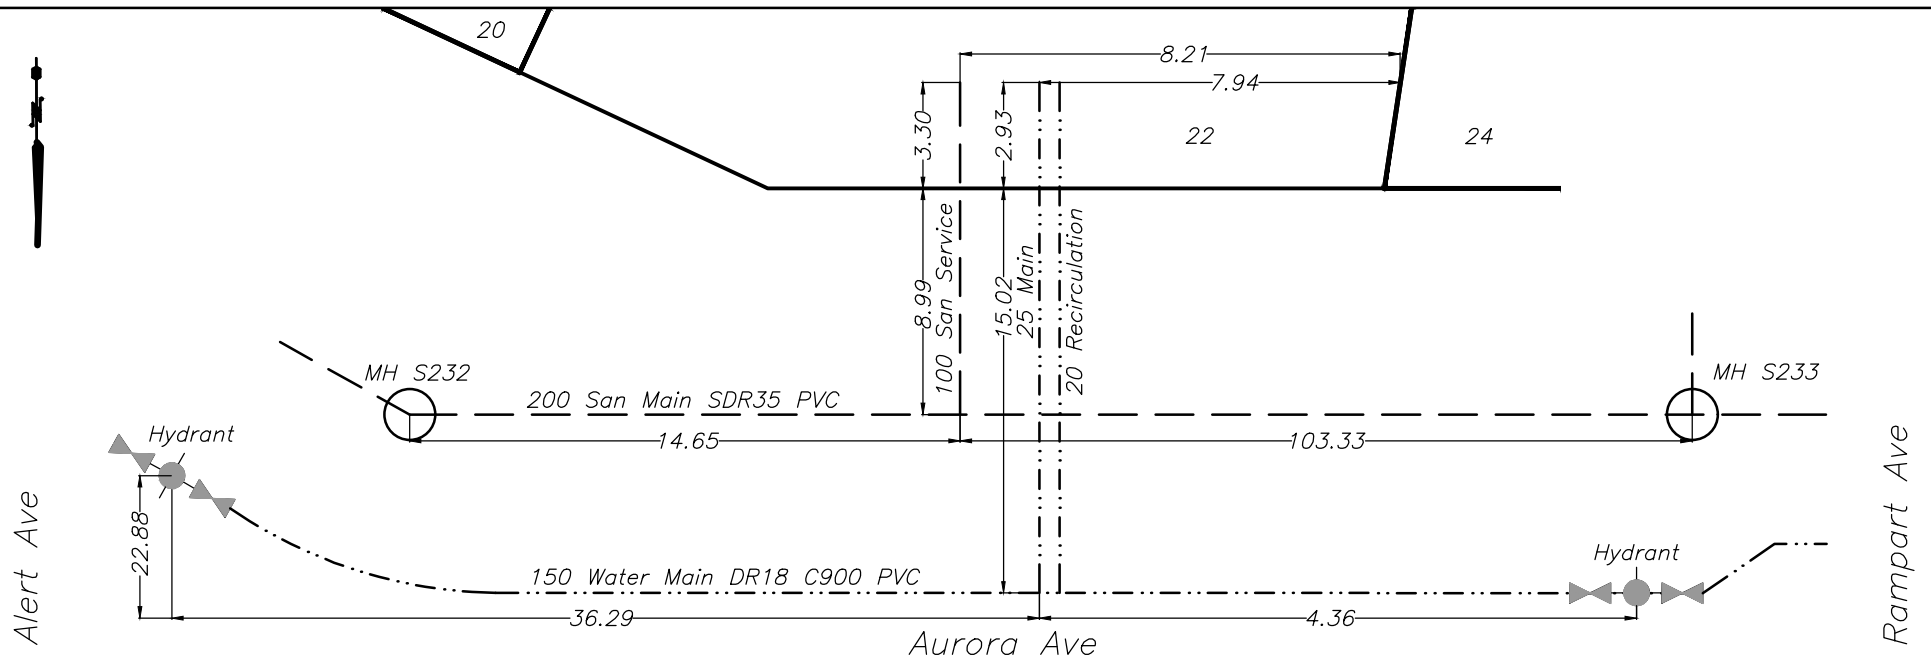




# CITY OF WHITEHORSE

## SERVICE CONNECTION RECORD

NAME P S Sidhu Trucking Ltd. ADDRESS 24 Aurora Drive, Whistle Bend BLOCK \_\_\_\_\_ LOT 1322

| DATES                   | WATER                                       | SEWER                                          |
|-------------------------|---------------------------------------------|------------------------------------------------|
| On at Main June 24 2024 | Depth at P/L: 672.79 (2.57)                 | Depth at P/L: 672.74 (2.63)                    |
| On at CC                | Depth at Main: 672.33 (2.92)                | Depth at Main: 672.38 (2.94)                   |
| Frost Plug              | Pipe Size: 25mm/20mm                        | Pipe Size: 100mm                               |
| Memo:                   | Pipe Material: HDPE Insul. <u>Yes</u> /No   | Pipe Material: SDR28 PVC Insul. <u>Yes</u> /No |
|                         | Length from Main to P/L: 12.02              | Length from Main to P/L: 8.97                  |
|                         |                                             | STORM                                          |
|                         | Squirt Test: <u>Pass</u> /Fail              | Depth at P/L:                                  |
|                         | Frost Protection: <u>Recirc</u> /Heat Trace | Depth at Main:                                 |
|                         | Continuity Test: N/A Pass/Fail              | Pipe Size:                                     |
|                         | PRV Required: Yes/ <u>No</u>                | Pipe Material:                                 |
|                         |                                             | Length from Main to P/L:                       |

CLEARLY INDICATE LOCATION OF CC AND ROUTE OF PIPES ON DRAWING BELOW

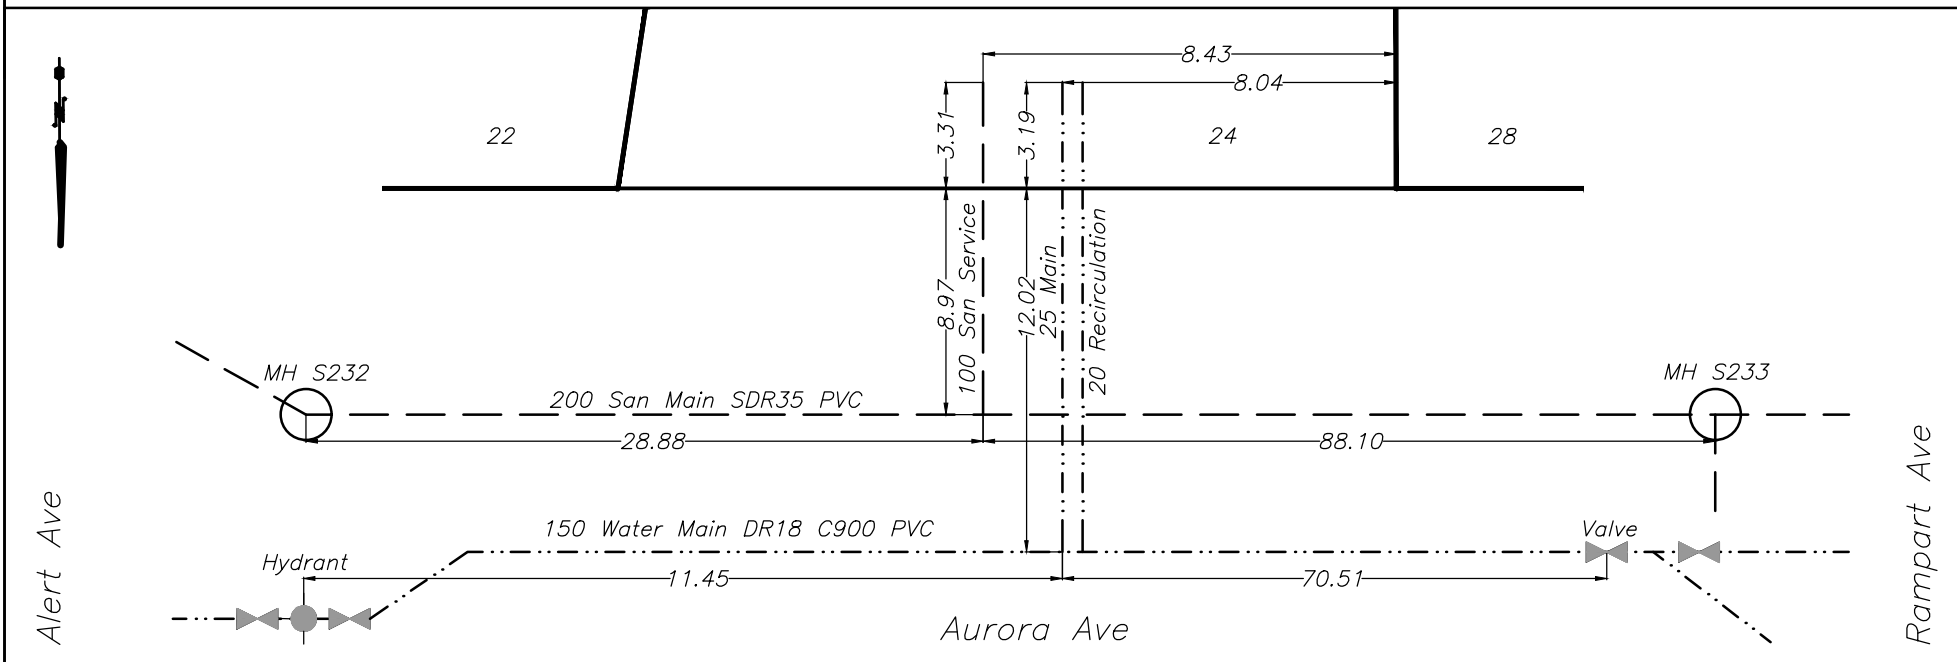




# CITY OF WHITEHORSE

## SERVICE CONNECTION RECORD

NAME P S Sidhu Trucking Ltd. ADDRESS 25 Aurora Avenue, Whistle Bend BLOCK                      LOT 1338

| DATES                   | WATER                                       | SEWER                                          |
|-------------------------|---------------------------------------------|------------------------------------------------|
| On at Main June 28 2024 | Depth at P/L: 672.80 (2.51)                 | Depth at P/L: 672.68 (2.63)                    |
| On at CC                | Depth at Main: 672.27 (2.94)                | Depth at Main: 672.29 (2.98)                   |
| Frost Plug              | Pipe Size: 50mm/20mm                        | Pipe Size: 150mm                               |
| Memo:                   | Pipe Material: HDPE Insul. <u>Yes</u> /No   | Pipe Material: SDR28 PVC Insul. <u>Yes</u> /No |
|                         | Length from Main to P/L: 6.01               | Length from Main to P/L: 9.02                  |
|                         |                                             | STORM                                          |
|                         | Squirt Test: <u>Pass</u> /Fail              | Depth at P/L:                                  |
|                         | Frost Protection: <u>Recirc</u> /Heat Trace | Depth at Main:                                 |
|                         | Continuity Test: N/A Pass/Fail              | Pipe Size:                                     |
|                         | PRV Required: Yes/ <u>No</u>                | Pipe Material:                                 |
|                         |                                             | Length from Main to P/L:                       |

CLEARLY INDICATE LOCATION OF CC AND ROUTE OF PIPES ON DRAWING BELOW

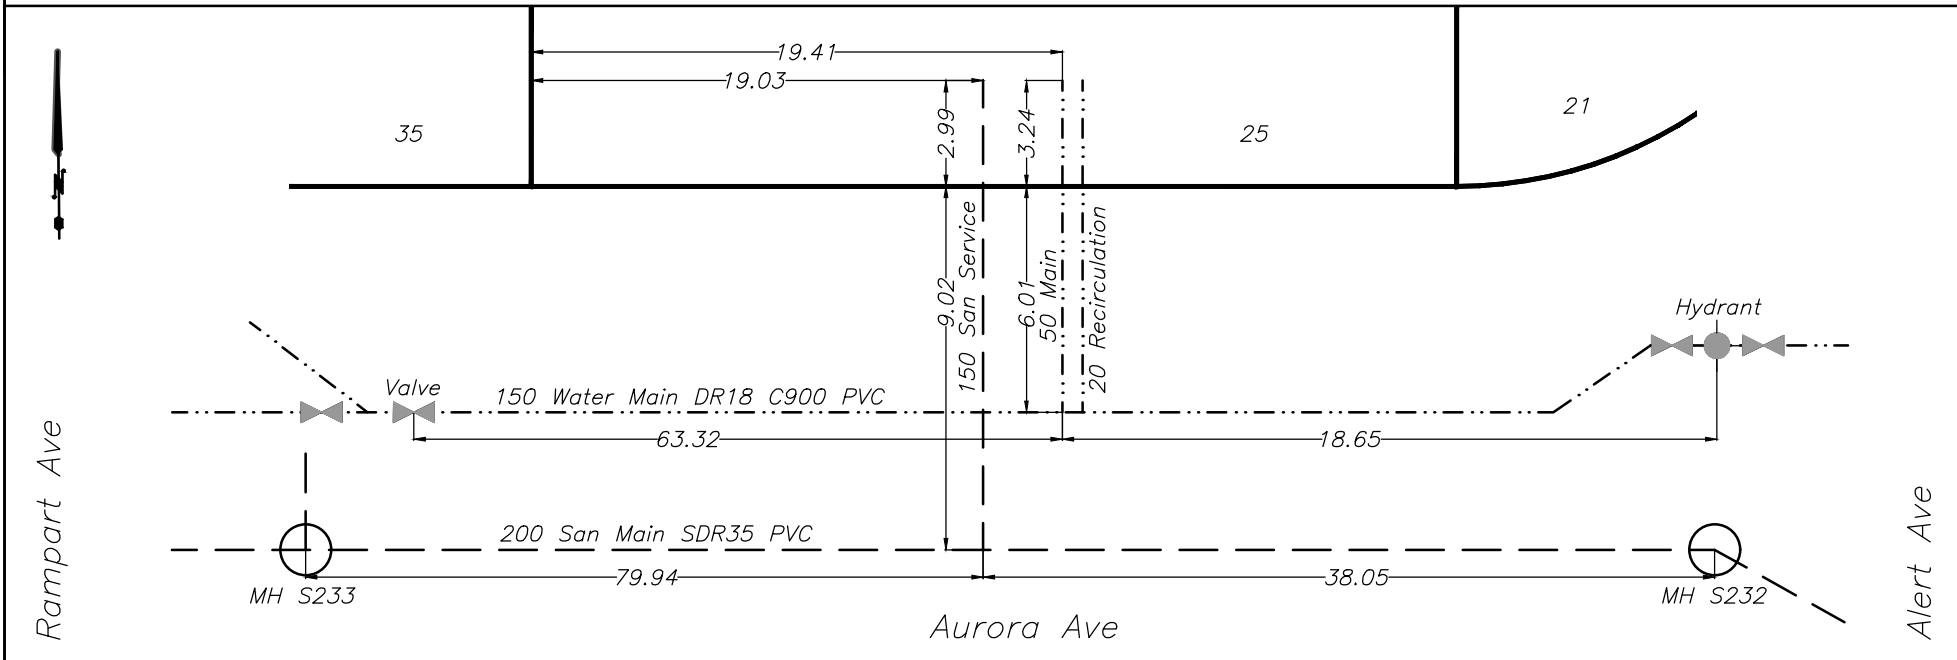




# CITY OF WHITEHORSE

## SERVICE CONNECTION RECORD

NAME P S Sidhu Trucking Ltd. ADDRESS 28 Aurora Drive, Whistle Bend BLOCK                      LOT 1323

| DATES                   | WATER                                       | SEWER                                          |
|-------------------------|---------------------------------------------|------------------------------------------------|
| On at Main June 28 2024 | Depth at P/L: 672.64 (2.57)                 | Depth at P/L: 672.57 (2.64)                    |
| On at CC                | Depth at Main: 672.18 (2.92)                | Depth at Main: 672.16 (3.00)                   |
| Frost Plug              | Pipe Size: 50mm/20mm                        | Pipe Size: 150mm                               |
| Memo:                   | Pipe Material: HDPE Insul. <u>Yes</u> /No   | Pipe Material: SDR28 PVC Insul. <u>Yes</u> /No |
|                         | Length from Main to P/L: 12.02              | Length from Main to P/L: 8.97                  |
|                         |                                             | STORM                                          |
|                         | Squirt Test: <u>Pass</u> /Fail              | Depth at P/L:                                  |
|                         | Frost Protection: <u>Recirc</u> /Heat Trace | Depth at Main:                                 |
|                         | Continuity Test: N/A Pass/Fail              | Pipe Size:                                     |
|                         | PRV Required: Yes/ <u>No</u>                | Pipe Material:                                 |
|                         |                                             | Length from Main to P/L:                       |

CLEARLY INDICATE LOCATION OF CC AND ROUTE OF PIPES ON DRAWING BELOW

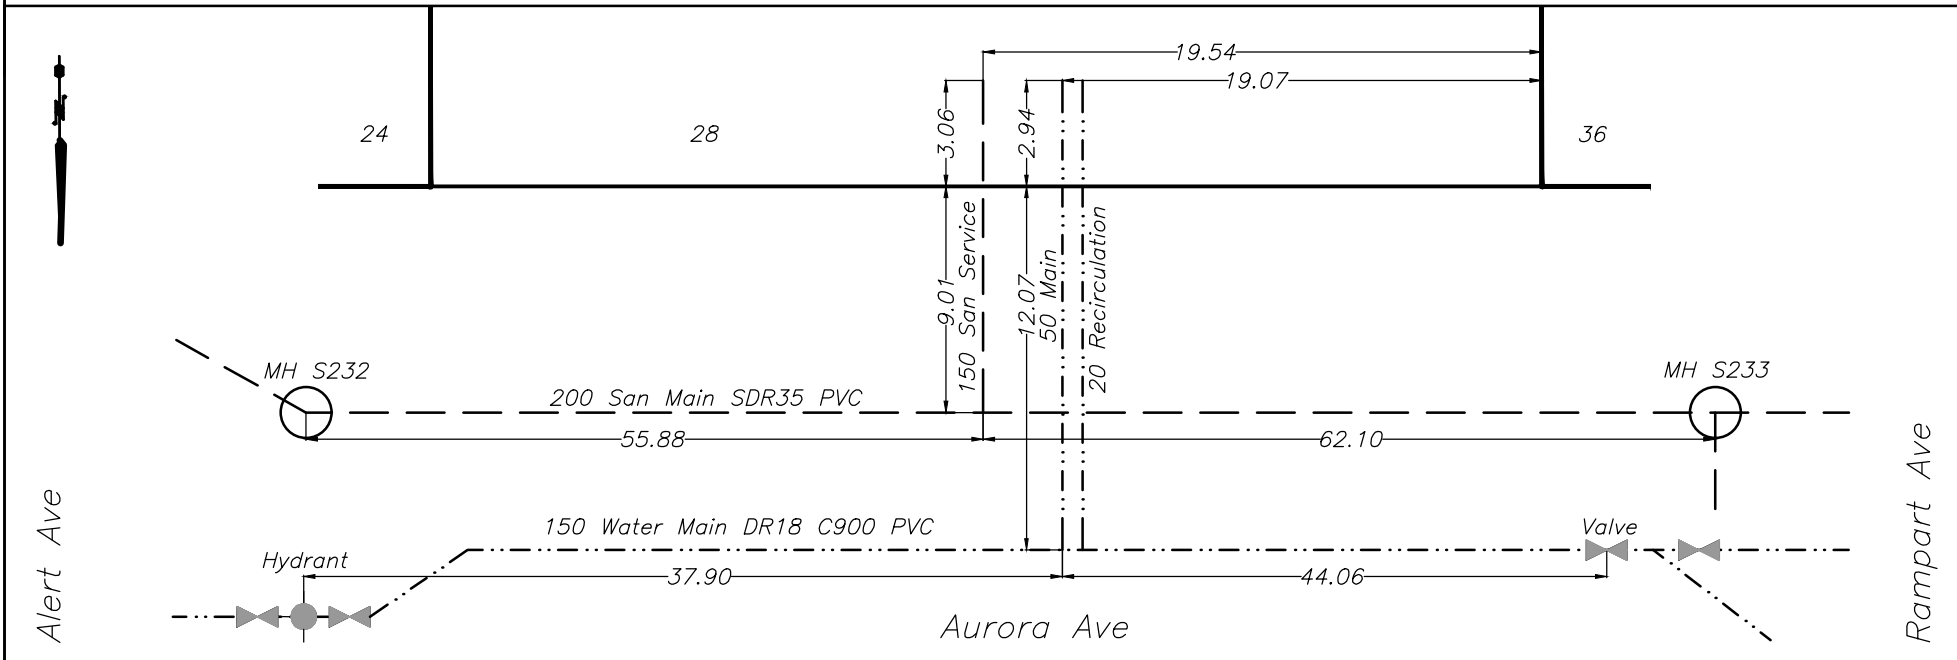




# CITY OF WHITEHORSE

## SERVICE CONNECTION RECORD

NAME P S Sidhu Trucking Ltd. ADDRESS 32 Alert Avenue, Whistle Bend BLOCK \_\_\_\_\_ LOT 1300

| DATES                   | WATER                                       | SEWER                                          |
|-------------------------|---------------------------------------------|------------------------------------------------|
| On at Main June 11 2024 | Depth at P/L: 673.30 (2.57)                 | Depth at P/L: 673.20 (2.67)                    |
| On at CC                | Depth at Main: 672.91 (2.87)                | Depth at Main: 672.30 (3.53)                   |
| Frost Plug              | Pipe Size: 25mm/20mm                        | Pipe Size: 100mm                               |
| Memo:                   | Pipe Material: HDPE Insul. <u>Yes</u> /No   | Pipe Material: SDR28 PVC Insul. Yes/ <u>No</u> |
|                         | Length from Main to P/L: 5.88               | Length from Main to P/L: 9.02                  |
|                         |                                             | STORM                                          |
|                         | Squirt Test: <u>Pass</u> /Fail              | Depth at P/L:                                  |
|                         | Frost Protection: <u>Recirc</u> /Heat Trace | Depth at Main:                                 |
|                         | Continuity Test: N/A Pass/Fail              | Pipe Size:                                     |
|                         | PRV Required: Yes/ <u>No</u>                | Pipe Material:                                 |
|                         |                                             | Length from Main to P/L:                       |

CLEARLY INDICATE LOCATION OF CC AND ROUTE OF PIPES ON DRAWING BELOW

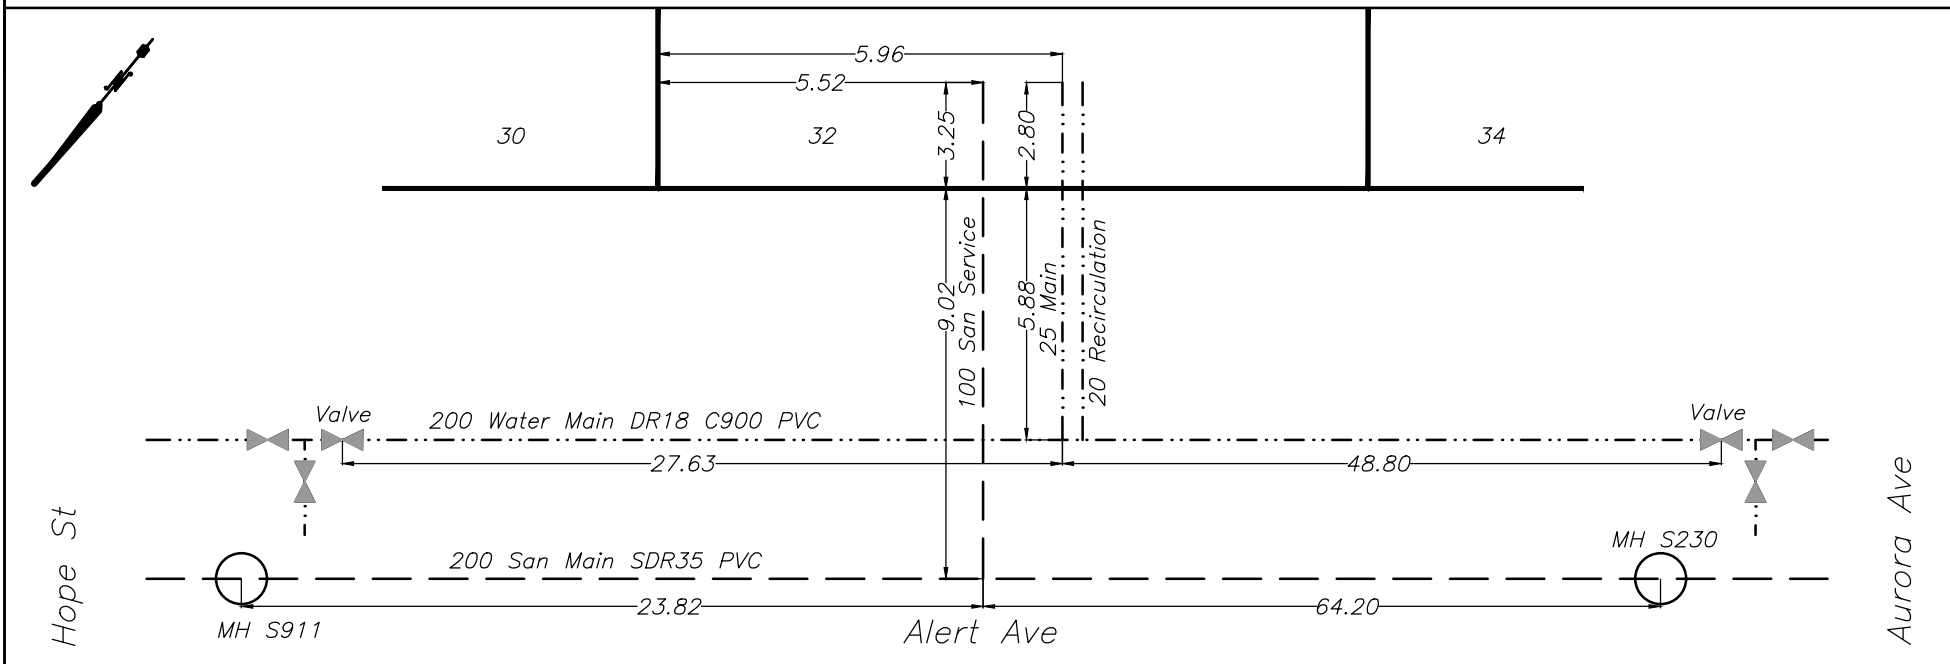




# CITY OF WHITEHORSE

## SERVICE CONNECTION RECORD

NAME P S Sidhu Trucking Ltd. ADDRESS 34 Alert Avenue, Whistle Bend BLOCK \_\_\_\_\_ LOT 1301

| DATES                   | WATER                                       | SEWER                                          |
|-------------------------|---------------------------------------------|------------------------------------------------|
| On at Main June 10 2024 | Depth at P/L: 673.34 (2.62)                 | Depth at P/L: 673.32 (2.64)                    |
| On at CC                | Depth at Main: 673.01 (2.86)                | Depth at Main: 672.38 (3.54)                   |
| Frost Plug              | Pipe Size: 25mm/20mm                        | Pipe Size: 100mm                               |
| Memo:                   | Pipe Material: HDPE Insul. <u>Yes</u> /No   | Pipe Material: SDR28 PVC Insul. Yes/ <u>No</u> |
|                         | Length from Main to P/L: 6.05               | Length from Main to P/L: 9.03                  |
|                         |                                             | STORM                                          |
|                         | Squirt Test: <u>Pass</u> /Fail              | Depth at P/L:                                  |
|                         | Frost Protection: <u>Recirc</u> /Heat Trace | Depth at Main:                                 |
|                         | Continuity Test: N/A Pass/Fail              | Pipe Size:                                     |
|                         | PRV Required: Yes/ <u>No</u>                | Pipe Material:                                 |
|                         |                                             | Length from Main to P/L:                       |

CLEARLY INDICATE LOCATION OF CC AND ROUTE OF PIPES ON DRAWING BELOW

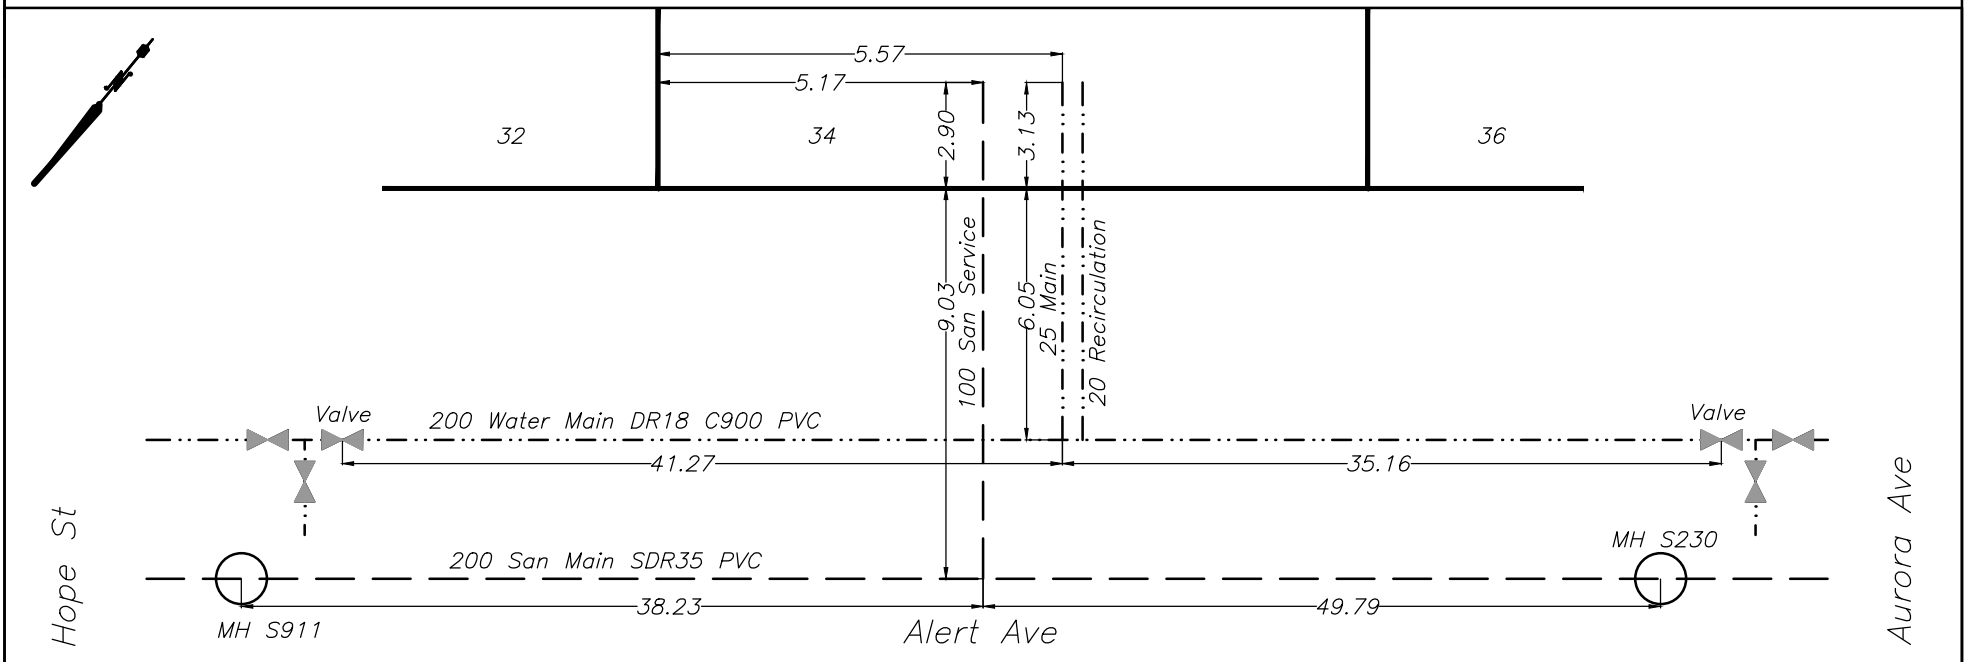




# CITY OF WHITEHORSE

## SERVICE CONNECTION RECORD

NAME P S Sidhu Trucking Ltd. ADDRESS 35 Aurora Drive, Whistle Bend BLOCK \_\_\_\_\_ LOT 1337

| DATES                   | WATER                                       | SEWER                                          |
|-------------------------|---------------------------------------------|------------------------------------------------|
| On at Main July 02 2024 | Depth at P/L: 672.60 (2.45)                 | Depth at P/L: 672.41 (2.64)                    |
| On at CC                | Depth at Main: 672.09 (2.86)                | Depth at Main: 672.01 (3.00)                   |
| Frost Plug              | Pipe Size: 50mm/20mm                        | Pipe Size: 150mm                               |
| Memo:                   | Pipe Material: HDPE Insul. <u>Yes</u> /No   | Pipe Material: SDR28 PVC Insul. <u>Yes</u> /No |
|                         | Length from Main to P/L: 6.04               | Length from Main to P/L: 9.04                  |
|                         |                                             | STORM                                          |
|                         | Squirt Test: <u>Pass</u> /Fail              | Depth at P/L:                                  |
|                         | Frost Protection: <u>Recirc</u> /Heat Trace | Depth at Main:                                 |
|                         | Continuity Test: N/A Pass/Fail              | Pipe Size:                                     |
|                         | PRV Required: Yes/ <u>No</u>                | Pipe Material:                                 |
|                         |                                             | Length from Main to P/L:                       |

CLEARLY INDICATE LOCATION OF CC AND ROUTE OF PIPES ON DRAWING BELOW

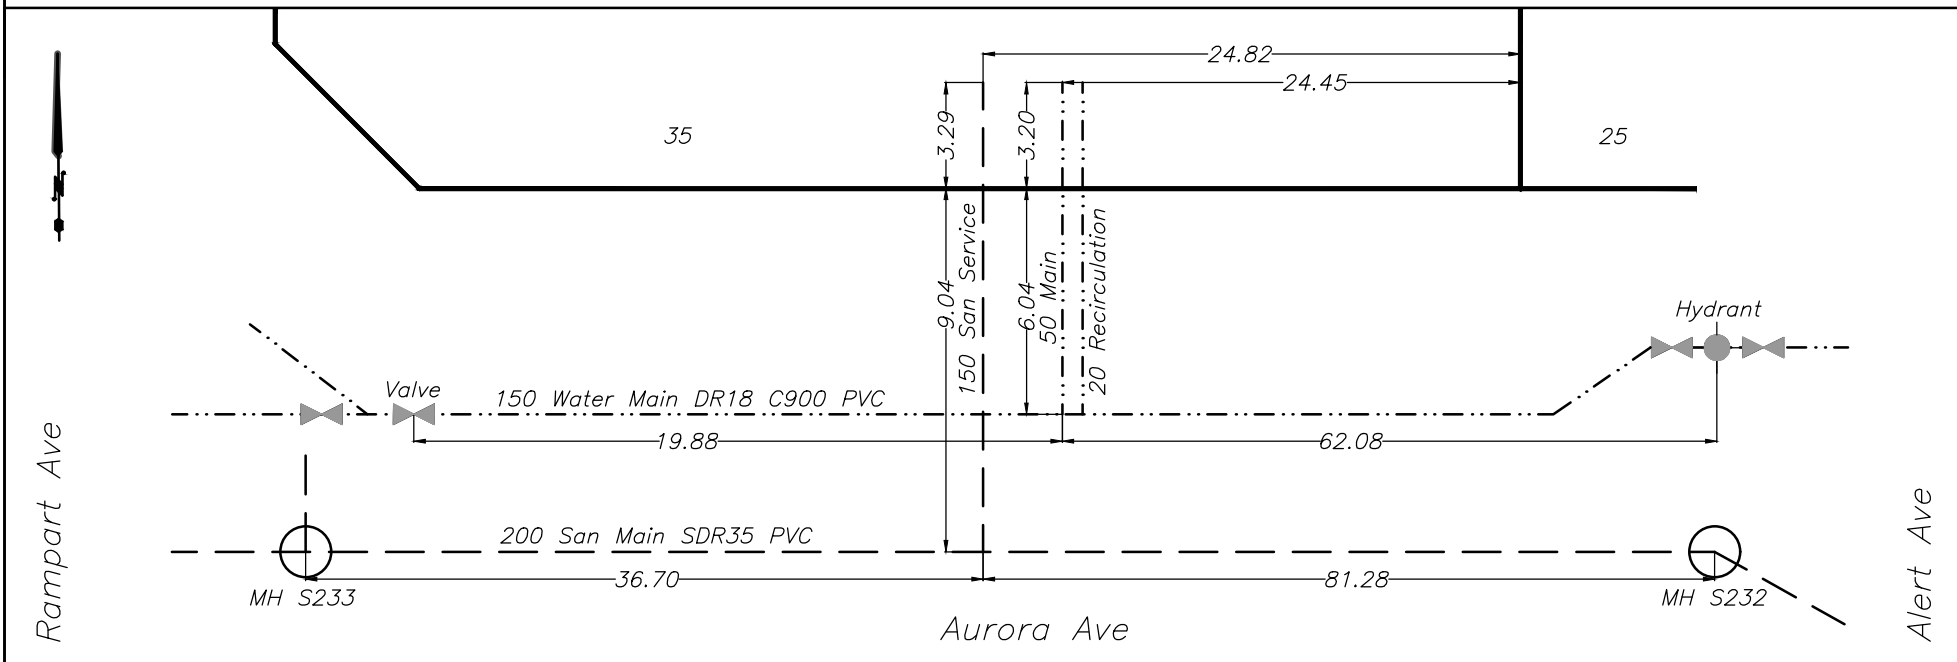




# CITY OF WHITEHORSE

## SERVICE CONNECTION RECORD

NAME P S Sidhu Trucking Ltd. ADDRESS 36 Alert Avenue, Whistle Bend BLOCK \_\_\_\_\_ LOT 1302

| DATES                   | WATER                                       | SEWER                                          |
|-------------------------|---------------------------------------------|------------------------------------------------|
| On at Main June 08 2024 | Depth at P/L: 673.47 (2.58)                 | Depth at P/L: 673.45 (2.61)                    |
| On at CC                | Depth at Main: 673.13 (2.83)                | Depth at Main: 672.48 (3.52)                   |
| Frost Plug              | Pipe Size: 25mm/20mm                        | Pipe Size: 100mm                               |
| Memo:                   | Pipe Material: HDPE Insul. <u>Yes</u> /No   | Pipe Material: SDR28 PVC Insul. Yes/ <u>No</u> |
|                         | Length from Main to P/L: 5.98               | Length from Main to P/L: 9.06                  |
|                         |                                             | STORM                                          |
|                         | Squirt Test: <u>Pass</u> /Fail              | Depth at P/L:                                  |
|                         | Frost Protection: <u>Recirc</u> /Heat Trace | Depth at Main:                                 |
|                         | Continuity Test: N/A Pass/Fail              | Pipe Size:                                     |
|                         | PRV Required: Yes/ <u>No</u>                | Pipe Material:                                 |
|                         |                                             | Length from Main to P/L:                       |

CLEARLY INDICATE LOCATION OF CC AND ROUTE OF PIPES ON DRAWING BELOW

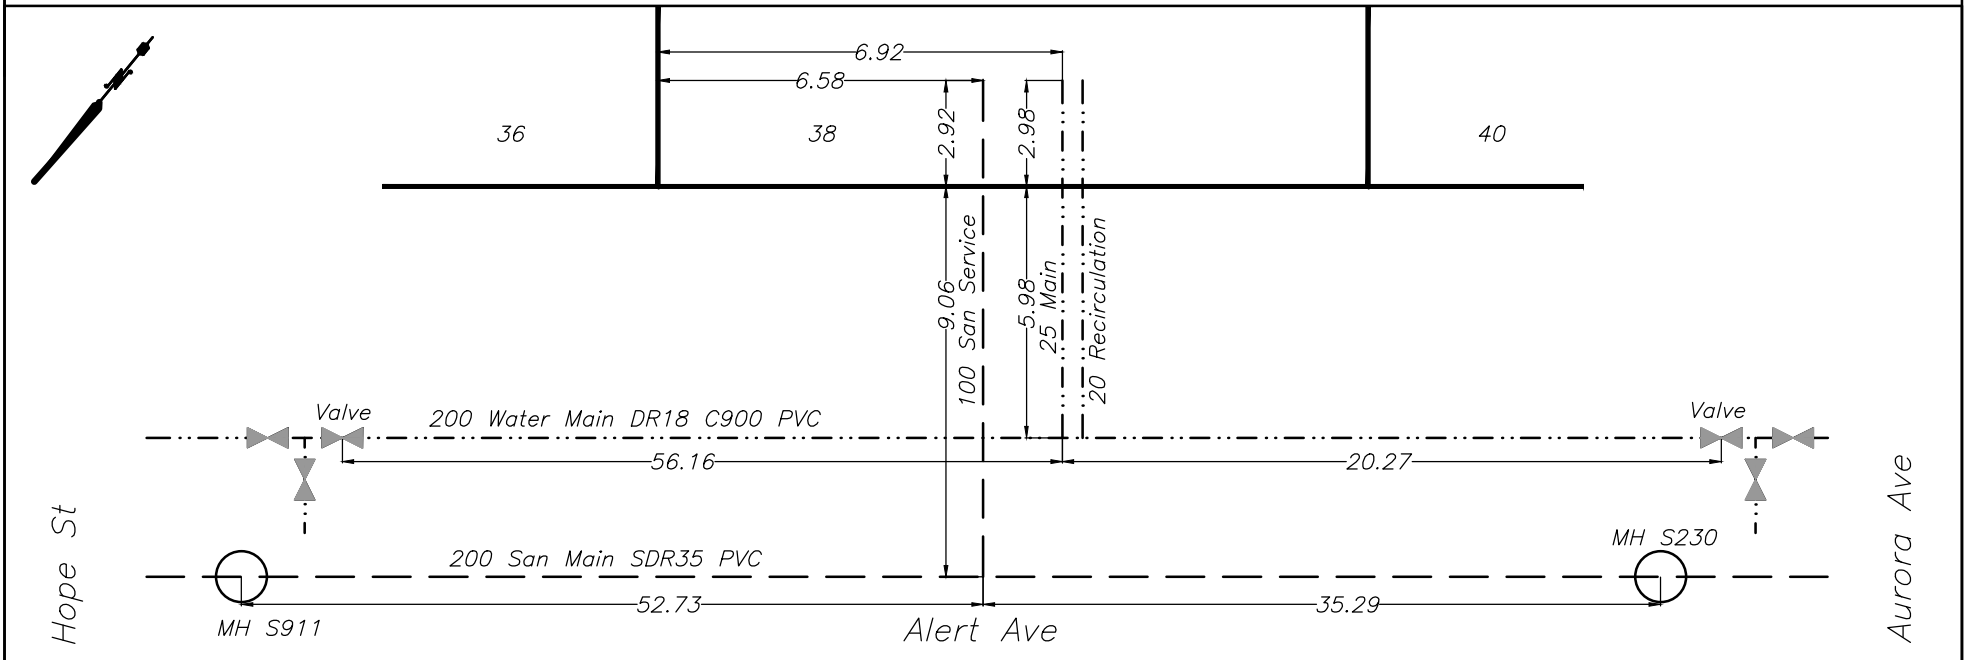




# CITY OF WHITEHORSE

## SERVICE CONNECTION RECORD

NAME P S Sidhu Trucking Ltd. ADDRESS 36 Aurora Drive, Whistle Bend BLOCK                      LOT 1324

| DATES                   | WATER                                       | SEWER                                          |
|-------------------------|---------------------------------------------|------------------------------------------------|
| On at Main July 03 2024 | Depth at P/L: 672.24 (2.72)                 | Depth at P/L: 672.26 (2.70)                    |
| On at CC                | Depth at Main: 671.99 (2.86)                | Depth at Main: 671.91 (3.01)                   |
| Frost Plug              | Pipe Size: 50mm/20mm                        | Pipe Size: 150mm                               |
| Memo:                   | Pipe Material: HDPE Insul. <u>Yes</u> /No   | Pipe Material: SDR28 PVC Insul. Yes/ <u>No</u> |
|                         | Length from Main to P/L: 12.01              | Length from Main to P/L: 8.99                  |
|                         |                                             | STORM                                          |
|                         | Squirt Test: <u>Pass</u> /Fail              | Depth at P/L:                                  |
|                         | Frost Protection: <u>Recirc</u> /Heat Trace | Depth at Main:                                 |
|                         | Continuity Test: N/A Pass/Fail              | Pipe Size:                                     |
|                         | PRV Required: Yes/ <u>No</u>                | Pipe Material:                                 |
|                         |                                             | Length from Main to P/L:                       |

CLEARLY INDICATE LOCATION OF CC AND ROUTE OF PIPES ON DRAWING BELOW

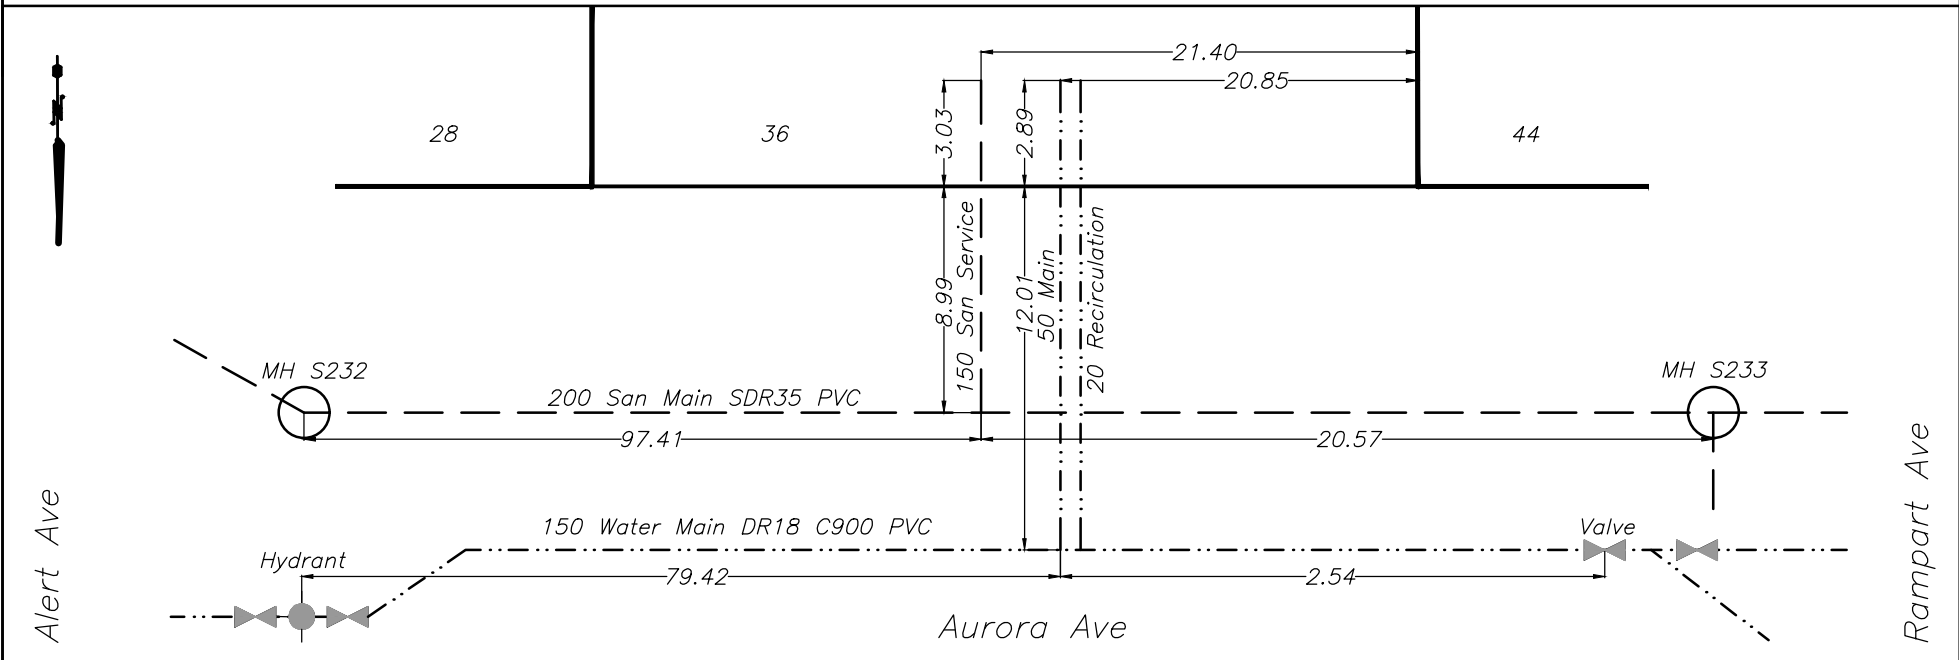




# CITY OF WHITEHORSE

## SERVICE CONNECTION RECORD

NAME P S Sidhu Trucking Ltd. ADDRESS 38 Alert Avenue, Whistle Bend BLOCK \_\_\_\_\_ LOT 1303

| DATES                   | WATER                                       | SEWER                                          |
|-------------------------|---------------------------------------------|------------------------------------------------|
| On at Main June 08 2024 | Depth at P/L: 673.49 (2.65)                 | Depth at P/L: 673.51 (2.63)                    |
| On at CC                | Depth at Main: 673.23 (2.81)                | Depth at Main: 672.58 (3.52)                   |
| Frost Plug              | Pipe Size: 25mm/20mm                        | Pipe Size: 100mm                               |
| Memo:                   | Pipe Material: HDPE Insul. <u>Yes</u> /No   | Pipe Material: SDR28 PVC Insul. Yes/ <u>No</u> |
|                         | Length from Main to P/L: 5.99               | Length from Main to P/L: 9.06                  |
|                         |                                             | STORM                                          |
|                         | Squirt Test: <u>Pass</u> /Fail              | Depth at P/L:                                  |
|                         | Frost Protection: <u>Recirc</u> /Heat Trace | Depth at Main:                                 |
|                         | Continuity Test: N/A Pass/Fail              | Pipe Size:                                     |
|                         | PRV Required: Yes/ <u>No</u>                | Pipe Material:                                 |
|                         |                                             | Length from Main to P/L:                       |

CLEARLY INDICATE LOCATION OF CC AND ROUTE OF PIPES ON DRAWING BELOW

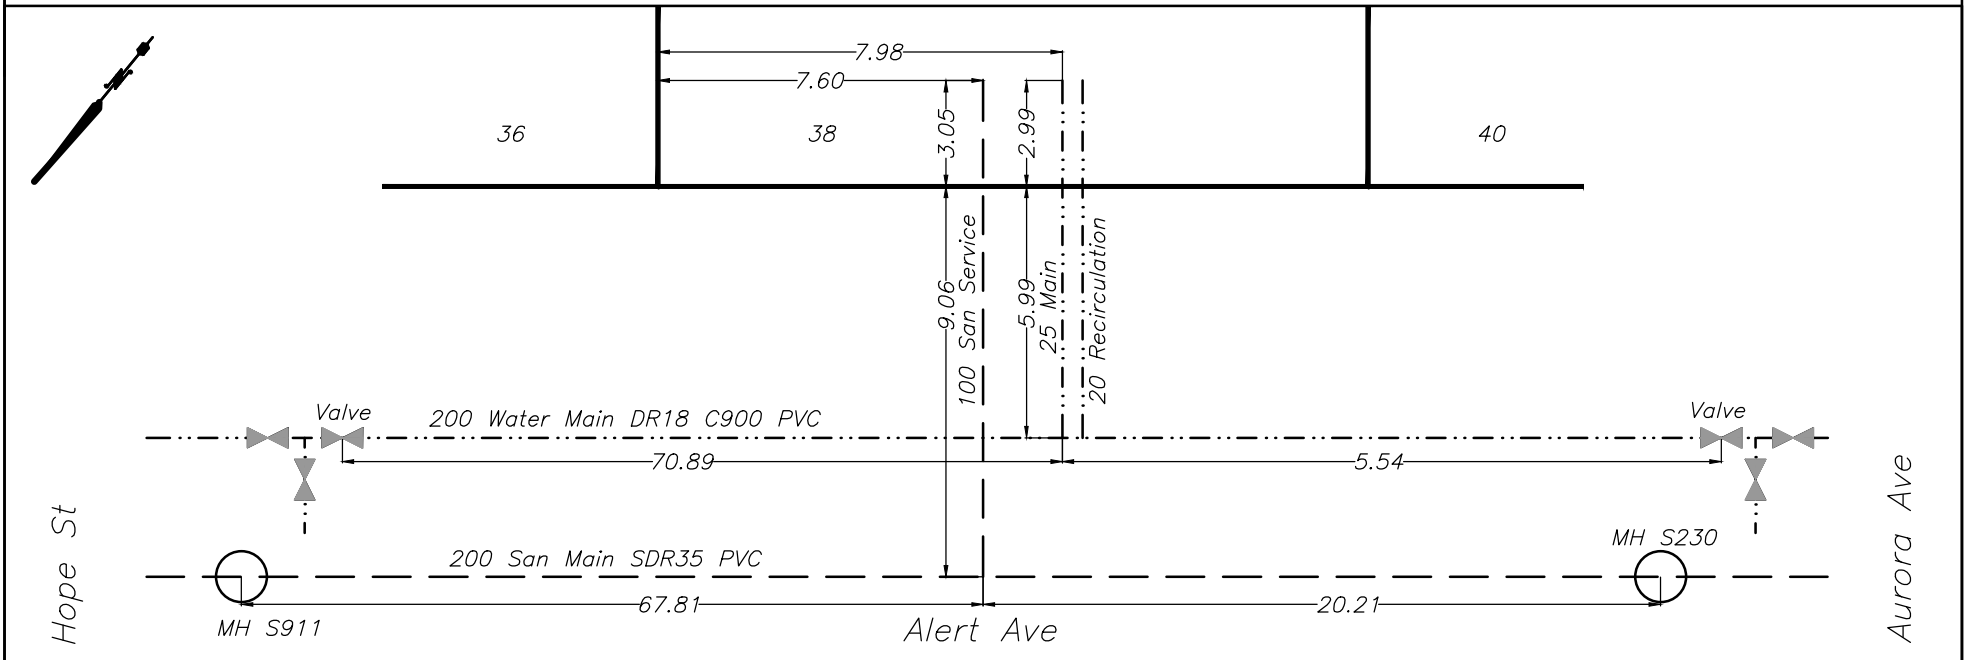




# CITY OF WHITEHORSE

## SERVICE CONNECTION RECORD

NAME P S Sidhu Trucking Ltd. ADDRESS 40 Alert Avenue, Whistle Bend BLOCK \_\_\_\_\_ LOT 1304

| DATES                   | WATER                                       | SEWER                                          |
|-------------------------|---------------------------------------------|------------------------------------------------|
| On at Main June 08 2024 | Depth at P/L: 673.69 (2.54)                 | Depth at P/L: 673.69 (2.54)                    |
| On at CC                | Depth at Main: 673.32 (2.82)                | Depth at Main: 672.66 (3.52)                   |
| Frost Plug              | Pipe Size: 25mm/20mm                        | Pipe Size: 100mm                               |
| Memo:                   | Pipe Material: HDPE Insul. <u>Yes</u> /No   | Pipe Material: SDR28 PVC Insul. Yes/ <u>No</u> |
|                         | Length from Main to P/L: 6.06               | Length from Main to P/L: 9.06                  |
|                         |                                             | STORM                                          |
|                         | Squirt Test: <u>Pass</u> /Fail              | Depth at P/L:                                  |
|                         | Frost Protection: <u>Recirc</u> /Heat Trace | Depth at Main:                                 |
|                         | Continuity Test: N/A Pass/Fail              | Pipe Size:                                     |
|                         | PRV Required: Yes/ <u>No</u>                | Pipe Material:                                 |
|                         |                                             | Length from Main to P/L:                       |

CLEARLY INDICATE LOCATION OF CC AND ROUTE OF PIPES ON DRAWING BELOW

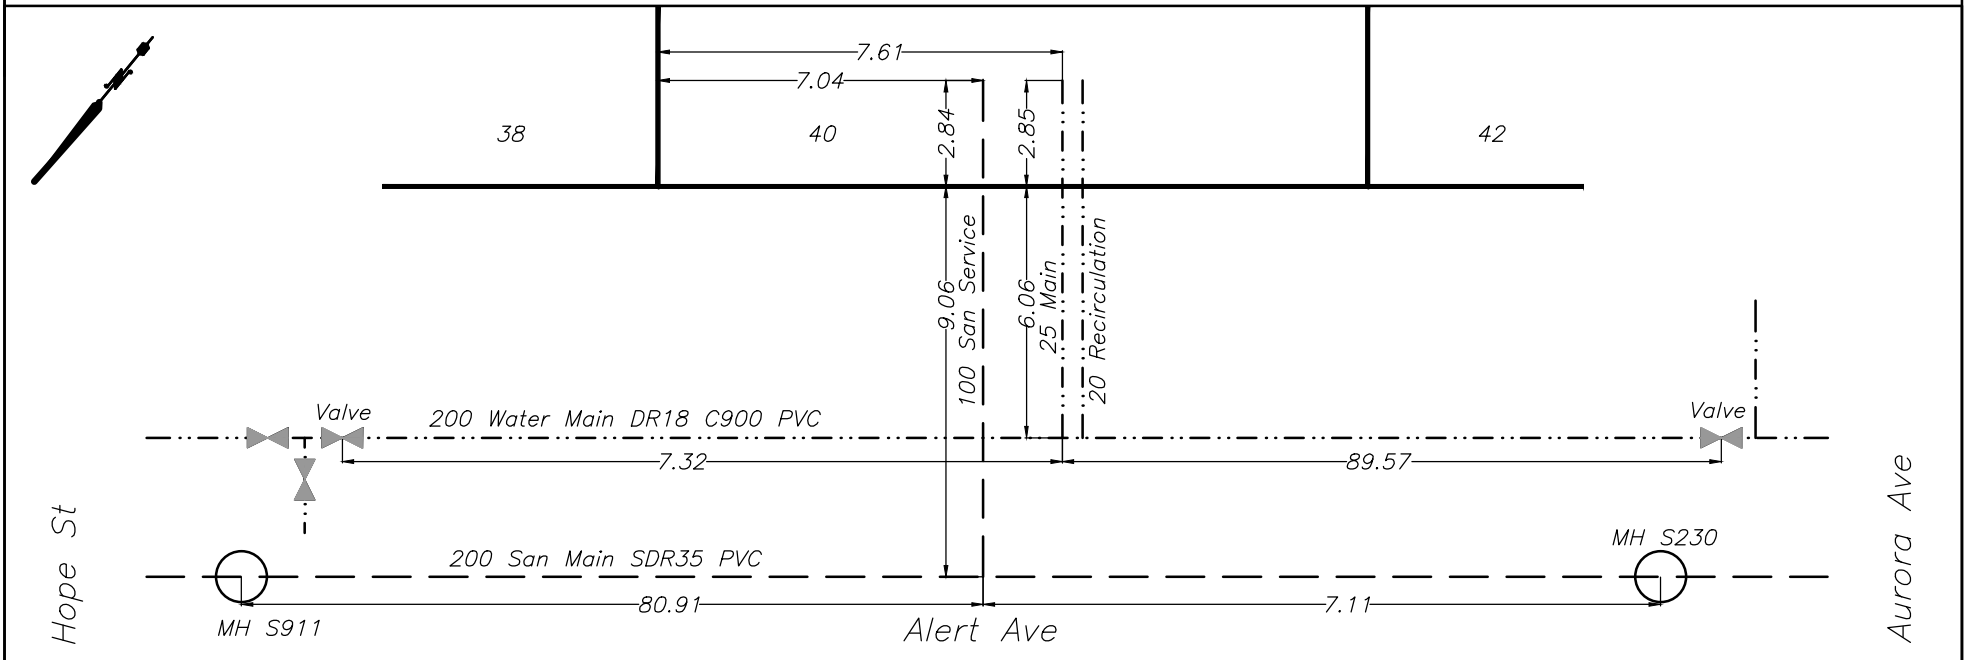




# CITY OF WHITEHORSE

## SERVICE CONNECTION RECORD

NAME P S Sidhu Trucking Ltd. ADDRESS 42 Alert Avenue, Whistle Bend BLOCK \_\_\_\_\_ LOT 1305

| DATES                   | WATER                                       | SEWER                                          |
|-------------------------|---------------------------------------------|------------------------------------------------|
| On at Main June 08 2024 | Depth at P/L: 673.69 (2.54)                 | Depth at P/L: 673.69 (2.54)                    |
| On at CC                | Depth at Main: 673.32 (2.82)                | Depth at Main: 672.66 (3.52)                   |
| Frost Plug              | Pipe Size: 25mm/20mm                        | Pipe Size: 100mm                               |
| Memo:                   | Pipe Material: HDPE Insul. <u>Yes</u> /No   | Pipe Material: SDR28 PVC Insul. Yes/ <u>No</u> |
|                         | Length from Main to P/L: 6.06               | Length from Main to P/L: 9.06                  |
|                         |                                             | STORM                                          |
|                         | Squirt Test: <u>Pass</u> /Fail              | Depth at P/L:                                  |
|                         | Frost Protection: <u>Recirc</u> /Heat Trace | Depth at Main:                                 |
|                         | Continuity Test: N/A Pass/Fail              | Pipe Size:                                     |
|                         | PRV Required: Yes/ <u>No</u>                | Pipe Material:                                 |
|                         |                                             | Length from Main to P/L:                       |

CLEARLY INDICATE LOCATION OF CC AND ROUTE OF PIPES ON DRAWING BELOW

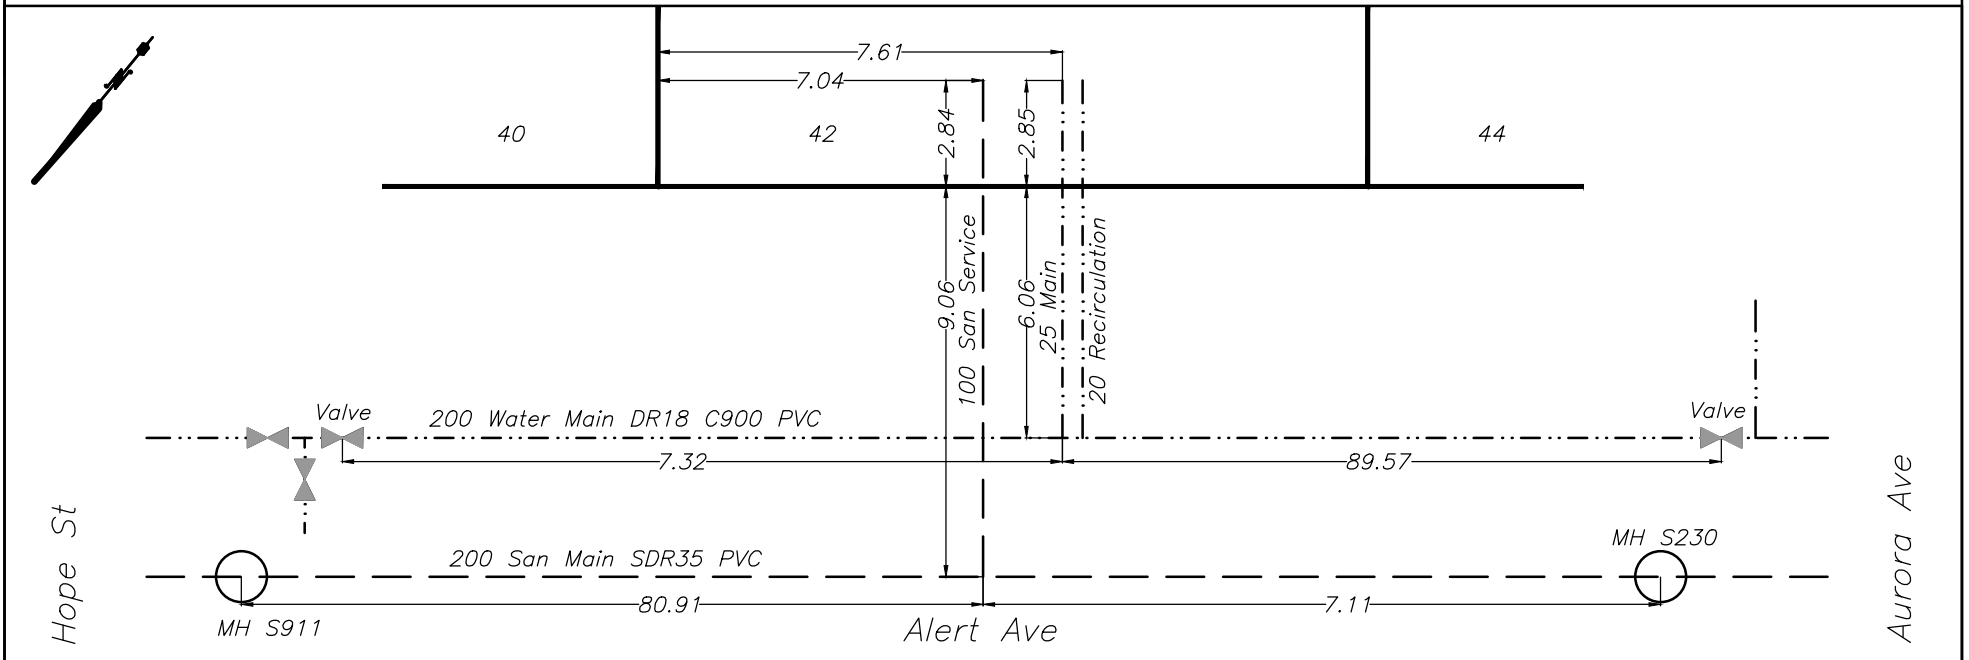




# CITY OF WHITEHORSE

## SERVICE CONNECTION RECORD

NAME P S Sidhu Trucking Ltd. ADDRESS 44 Alert Avenue, Whistle Bend BLOCK \_\_\_\_\_ LOT 1306

| DATES                   | WATER                                                                                       | SEWER                                                                    |
|-------------------------|---------------------------------------------------------------------------------------------|--------------------------------------------------------------------------|
| On at Main June 12 2024 | Depth at P/L: 673.94 (2.46)                                                                 | Depth at P/L: 673.91 (2.50)                                              |
| On at CC                | Depth at Main: 673.60 (2.71)                                                                | Depth at Main: 672.75 (3.61)                                             |
| Frost Plug              | Pipe Size: 25mm/20mm                                                                        | Pipe Size: 100mm                                                         |
| Memo:                   | Pipe Material: HDPE Insul. <input checked="" type="radio"/> Yes/ <input type="radio"/> No   | Pipe Material: SDR28 PVC Insul. Yes/ <input checked="" type="radio"/> No |
|                         | Length from Main to P/L: 6.25                                                               | Length from Main to P/L: 9.07                                            |
|                         |                                                                                             | STORM                                                                    |
|                         | Squirt Test: <input checked="" type="radio"/> Pass/ <input type="radio"/> Fail              | Depth at P/L:                                                            |
|                         | Frost Protection: <input checked="" type="radio"/> Recirc/ <input type="radio"/> Heat Trace | Depth at Main:                                                           |
|                         | Continuity Test: N/A Pass/Fail                                                              | Pipe Size:                                                               |
|                         | PRV Required: Yes/ <input checked="" type="radio"/> No                                      | Pipe Material:                                                           |
|                         |                                                                                             | Length from Main to P/L:                                                 |

CLEARLY INDICATE LOCATION OF CC AND ROUTE OF PIPES ON DRAWING BELOW

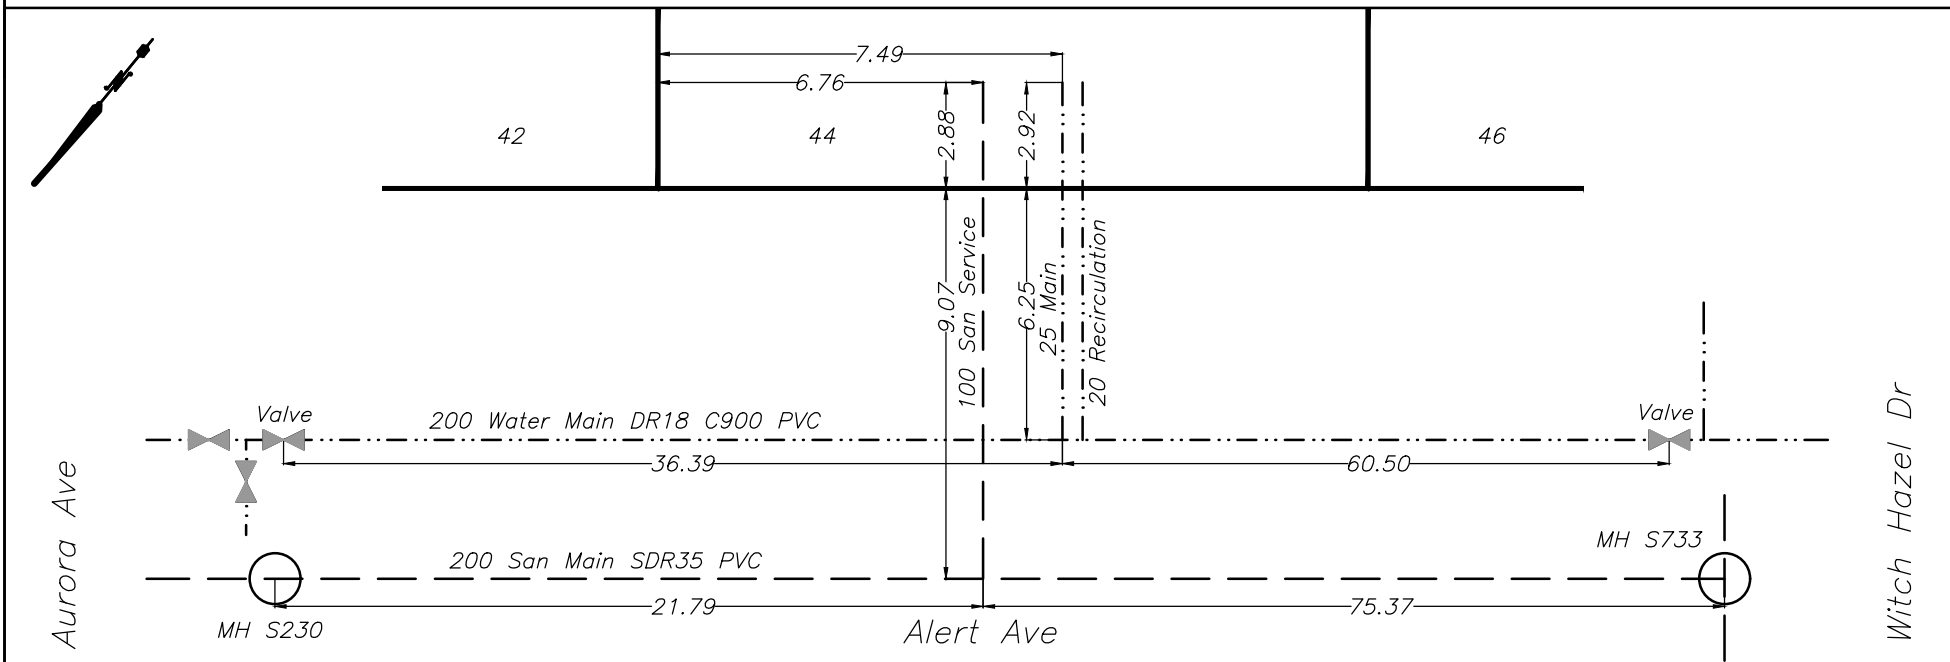




# CITY OF WHITEHORSE

## SERVICE CONNECTION RECORD

NAME P S Sidhu Trucking Ltd. ADDRESS 44 Aurora Drive, Whistle Bend BLOCK \_\_\_\_\_ LOT 1325

| DATES                   | WATER                                       | SEWER                                          |
|-------------------------|---------------------------------------------|------------------------------------------------|
| On at Main June 14 2024 | Depth at P/L: 672.11 (2.61)                 | Depth at P/L: 672.03 (2.68)                    |
| On at CC                | Depth at Main: 671.46 (3.14)                | Depth at Main: 671.55 (3.12)                   |
| Frost Plug              | Pipe Size: 50mm/20mm                        | Pipe Size: 150mm                               |
| Memo:                   | Pipe Material: HDPE Insul. <u>Yes</u> /No   | Pipe Material: SDR28 PVC Insul. <u>Yes</u> /No |
|                         | Length from Main to P/L: 12.04              | Length from Main to P/L: 9.02                  |
|                         |                                             | STORM                                          |
|                         | Squirt Test: <u>Pass</u> /Fail              | Depth at P/L:                                  |
|                         | Frost Protection: <u>Recirc</u> /Heat Trace | Depth at Main:                                 |
|                         | Continuity Test: N/A Pass/Fail              | Pipe Size:                                     |
|                         | PRV Required: Yes/ <u>No</u>                | Pipe Material:                                 |
|                         |                                             | Length from Main to P/L:                       |

CLEARLY INDICATE LOCATION OF CC AND ROUTE OF PIPES ON DRAWING BELOW

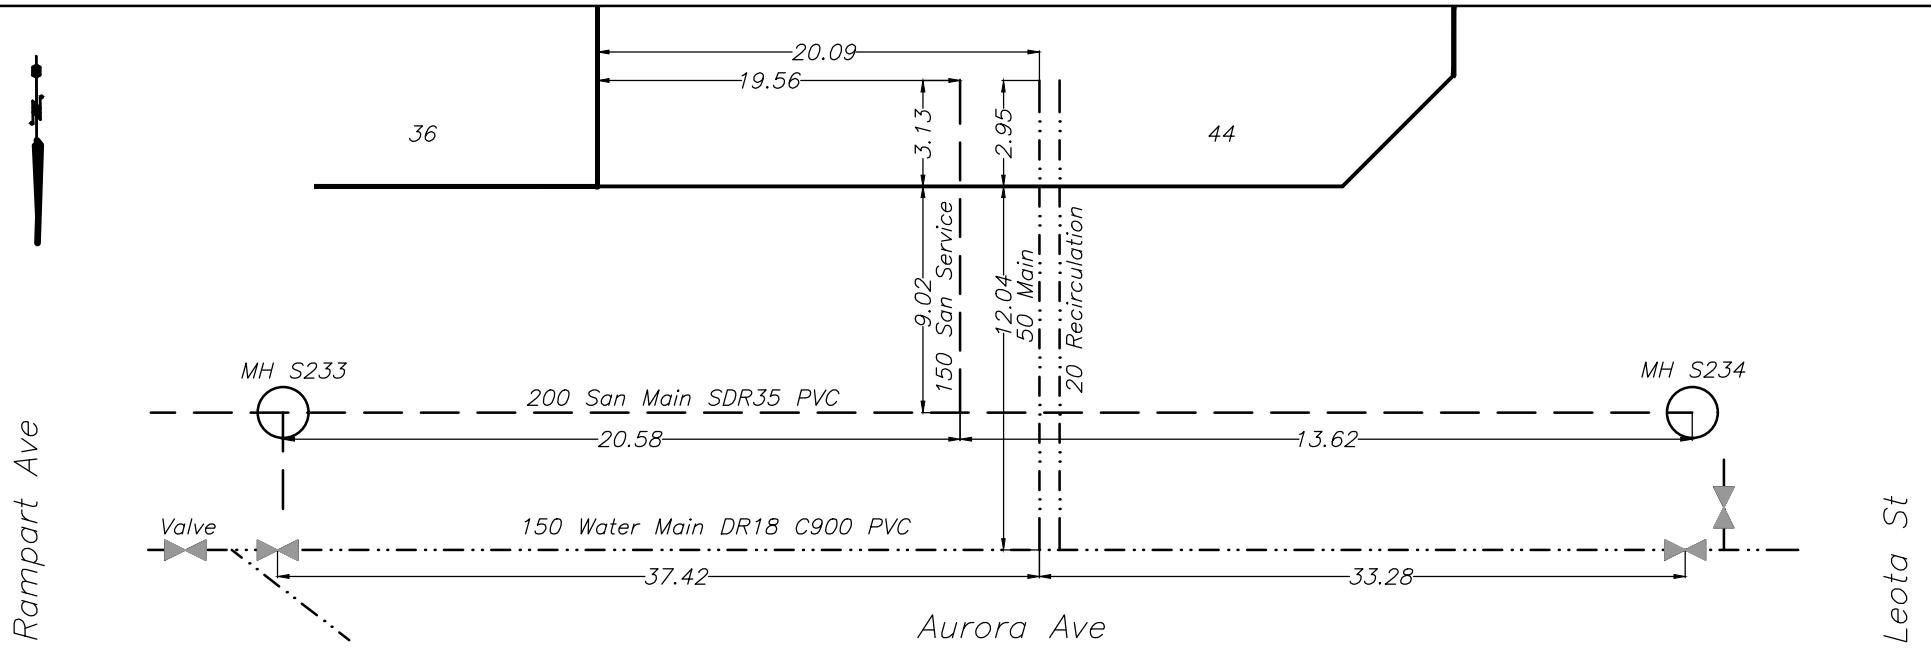




# CITY OF WHITEHORSE

## SERVICE CONNECTION RECORD

NAME P S Sidhu Trucking Ltd. ADDRESS 46 Alert Avenue, Whistle Bend BLOCK \_\_\_\_\_ LOT 1307

| DATES                   | WATER                                       | SEWER                                          |
|-------------------------|---------------------------------------------|------------------------------------------------|
| On at Main June 05 2024 | Depth at P/L: 673.93 (2.56)                 | Depth at P/L: 673.89 (2.60)                    |
| On at CC                | Depth at Main: 673.64 (2.75)                | Depth at Main: 672.60 (3.85)                   |
| Frost Plug              | Pipe Size: 25mm/20mm                        | Pipe Size: 100mm                               |
| Memo:                   | Pipe Material: HDPE Insul. <u>Yes</u> /No   | Pipe Material: SDR28 PVC Insul. Yes/ <u>No</u> |
|                         | Length from Main to P/L: 6.28               | Length from Main to P/L: 9.06                  |
|                         |                                             | STORM                                          |
|                         | Squirt Test: <u>Pass</u> /Fail              | Depth at P/L:                                  |
|                         | Frost Protection: <u>Recirc</u> /Heat Trace | Depth at Main:                                 |
|                         | Continuity Test: N/A Pass/Fail              | Pipe Size:                                     |
|                         | PRV Required: Yes/ <u>No</u>                | Pipe Material:                                 |
|                         |                                             | Length from Main to P/L:                       |

CLEARLY INDICATE LOCATION OF CC AND ROUTE OF PIPES ON DRAWING BELOW

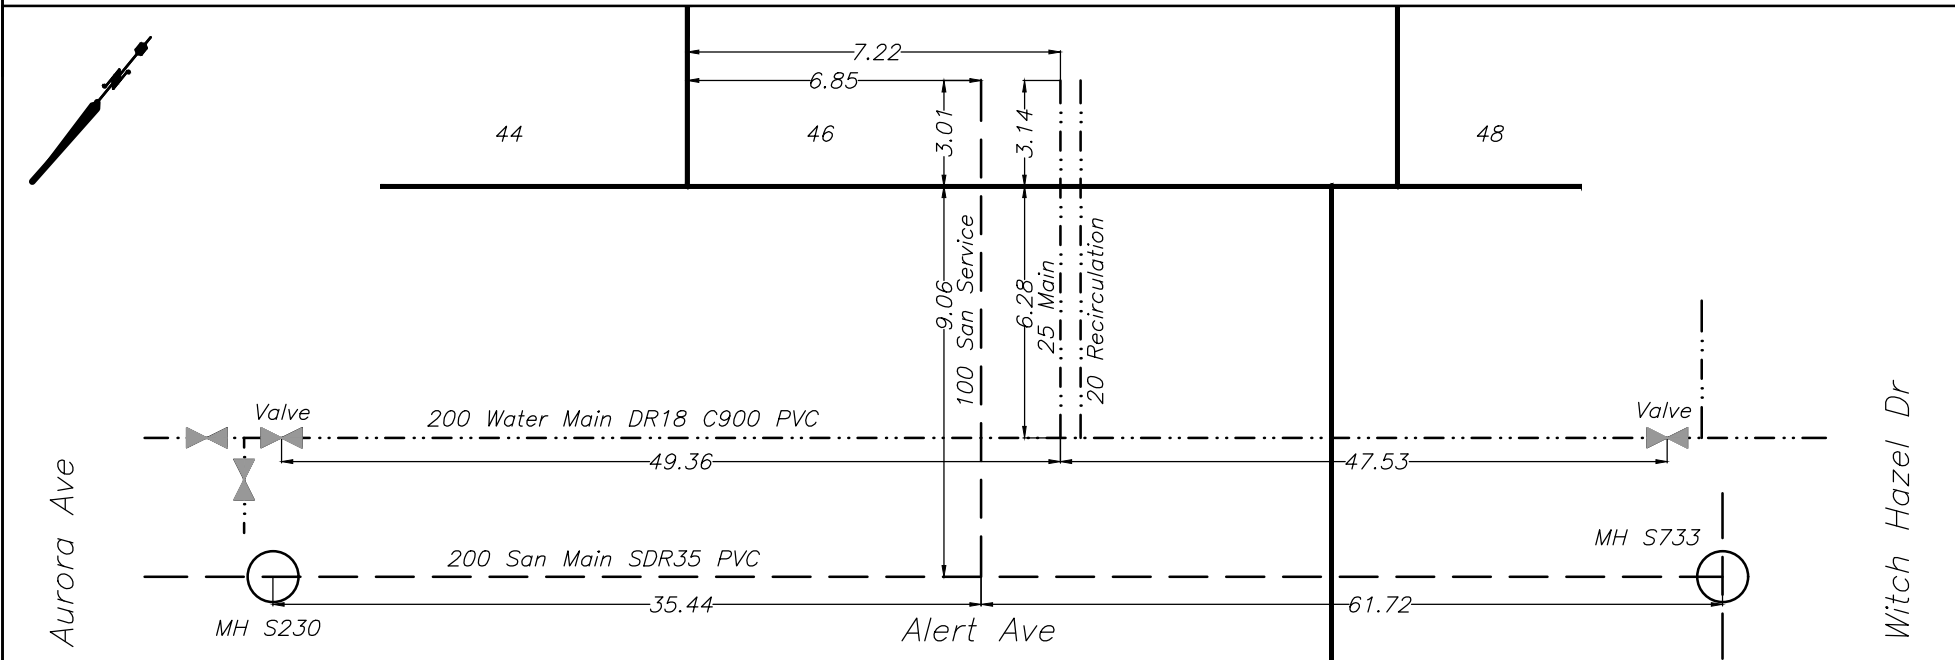




# CITY OF WHITEHORSE

## SERVICE CONNECTION RECORD

NAME P S Sidhu Trucking Ltd. ADDRESS 48 Alert Avenue, Whistle Bend BLOCK \_\_\_\_\_ LOT 1308

| DATES                   | WATER                                       | SEWER                                          |
|-------------------------|---------------------------------------------|------------------------------------------------|
| On at Main June 05 2024 | Depth at P/L: 674.27 (2.34)                 | Depth at P/L: 674.20 (2.41)                    |
| On at CC                | Depth at Main: 673.79 (2.71)                | Depth at Main: 672.50 (4.05)                   |
| Frost Plug              | Pipe Size: 25mm/20mm                        | Pipe Size: 100mm                               |
| Memo:                   | Pipe Material: HDPE Insul. <u>Yes</u> /No   | Pipe Material: SDR28 PVC Insul. Yes/ <u>No</u> |
|                         | Length from Main to P/L: 6.28               | Length from Main to P/L: 9.18                  |
|                         |                                             | STORM                                          |
|                         | Squirt Test: <u>Pass</u> /Fail              | Depth at P/L:                                  |
|                         | Frost Protection: <u>Recirc</u> /Heat Trace | Depth at Main:                                 |
|                         | Continuity Test: N/A Pass/Fail              | Pipe Size:                                     |
|                         | PRV Required: Yes/ <u>No</u>                | Pipe Material:                                 |
|                         |                                             | Length from Main to P/L:                       |

CLEARLY INDICATE LOCATION OF CC AND ROUTE OF PIPES ON DRAWING BELOW

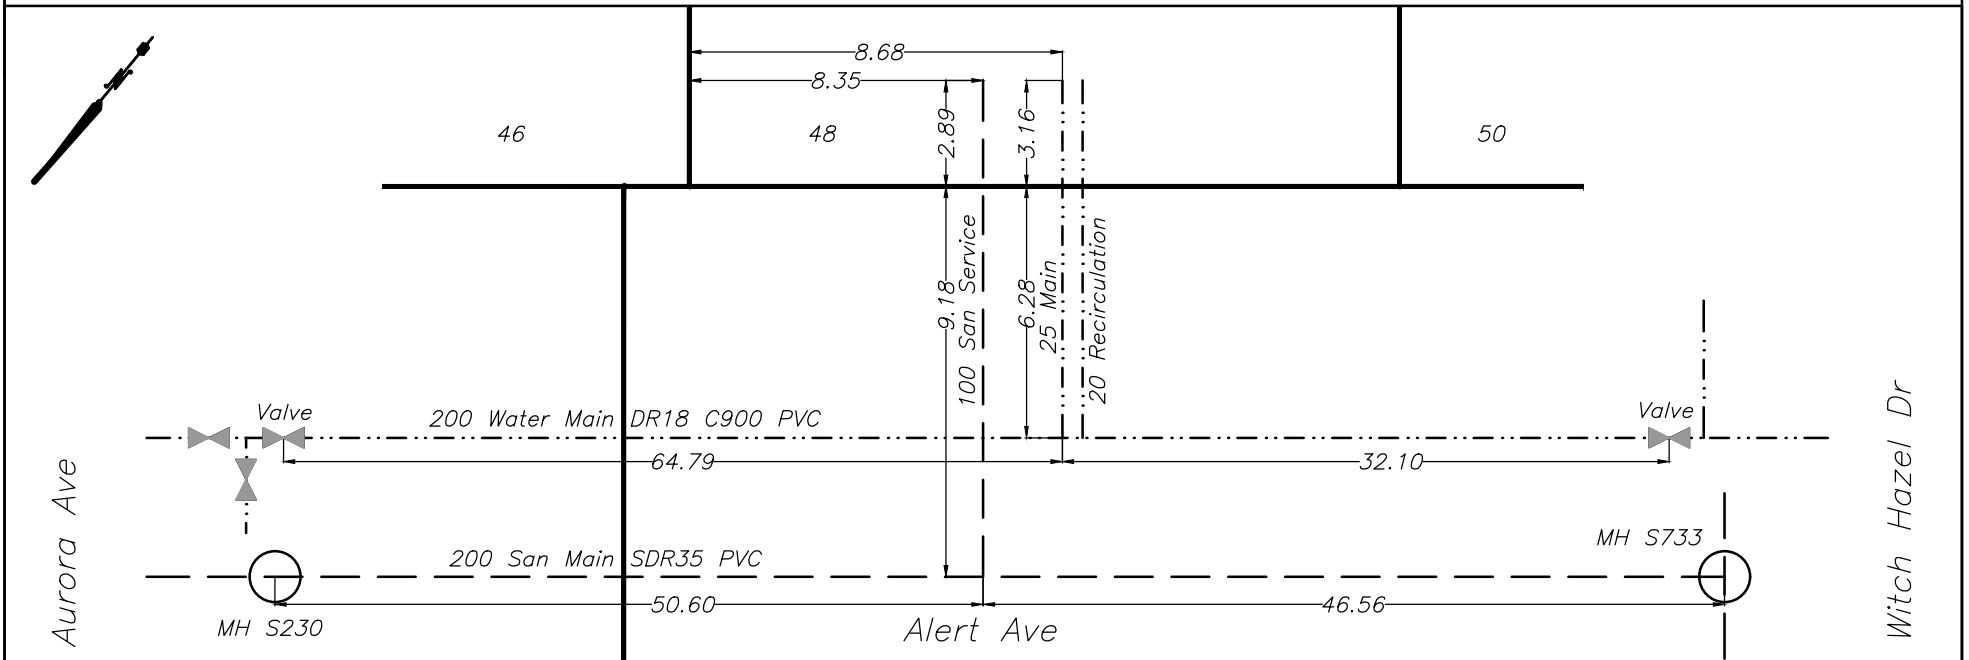




# CITY OF WHITEHORSE

## SERVICE CONNECTION RECORD

NAME P S Sidhu Trucking Ltd. ADDRESS 50 Alert Avenue, Whistle Bend BLOCK \_\_\_\_\_ LOT 1309

| DATES                   | WATER                                                                                            | SEWER                                                                                               |
|-------------------------|--------------------------------------------------------------------------------------------------|-----------------------------------------------------------------------------------------------------|
| On at Main June 04 2024 | Depth at P/L: 674.38 (2.36)                                                                      | Depth at P/L: 674.27 (2.48)                                                                         |
| On at CC                | Depth at Main: 673.84 (2.80)                                                                     | Depth at Main: 672.28 (4.40)                                                                        |
| Frost Plug              | Pipe Size: 25mm/20mm                                                                             | Pipe Size: 100mm                                                                                    |
| Memo:                   | Pipe Material: HDPE Insul. <input checked="" type="checkbox"/> Yes <input type="checkbox"/> No   | Pipe Material: SDR28 PVC Insul. Yes <input checked="" type="checkbox"/> No <input type="checkbox"/> |
|                         | Length from Main to P/L: 6.73                                                                    | Length from Main to P/L: 9.44                                                                       |
|                         |                                                                                                  | STORM                                                                                               |
|                         | Squirt Test: <input checked="" type="checkbox"/> Pass <input type="checkbox"/> Fail              | Depth at P/L:                                                                                       |
|                         | Frost Protection: <input checked="" type="checkbox"/> Recirc <input type="checkbox"/> Heat Trace | Depth at Main:                                                                                      |
|                         | Continuity Test: N/A Pass/Fail                                                                   | Pipe Size:                                                                                          |
|                         | PRV Required: Yes <input checked="" type="checkbox"/> No <input type="checkbox"/>                | Pipe Material:                                                                                      |
|                         |                                                                                                  | Length from Main to P/L:                                                                            |

CLEARLY INDICATE LOCATION OF CC AND ROUTE OF PIPES ON DRAWING BELOW

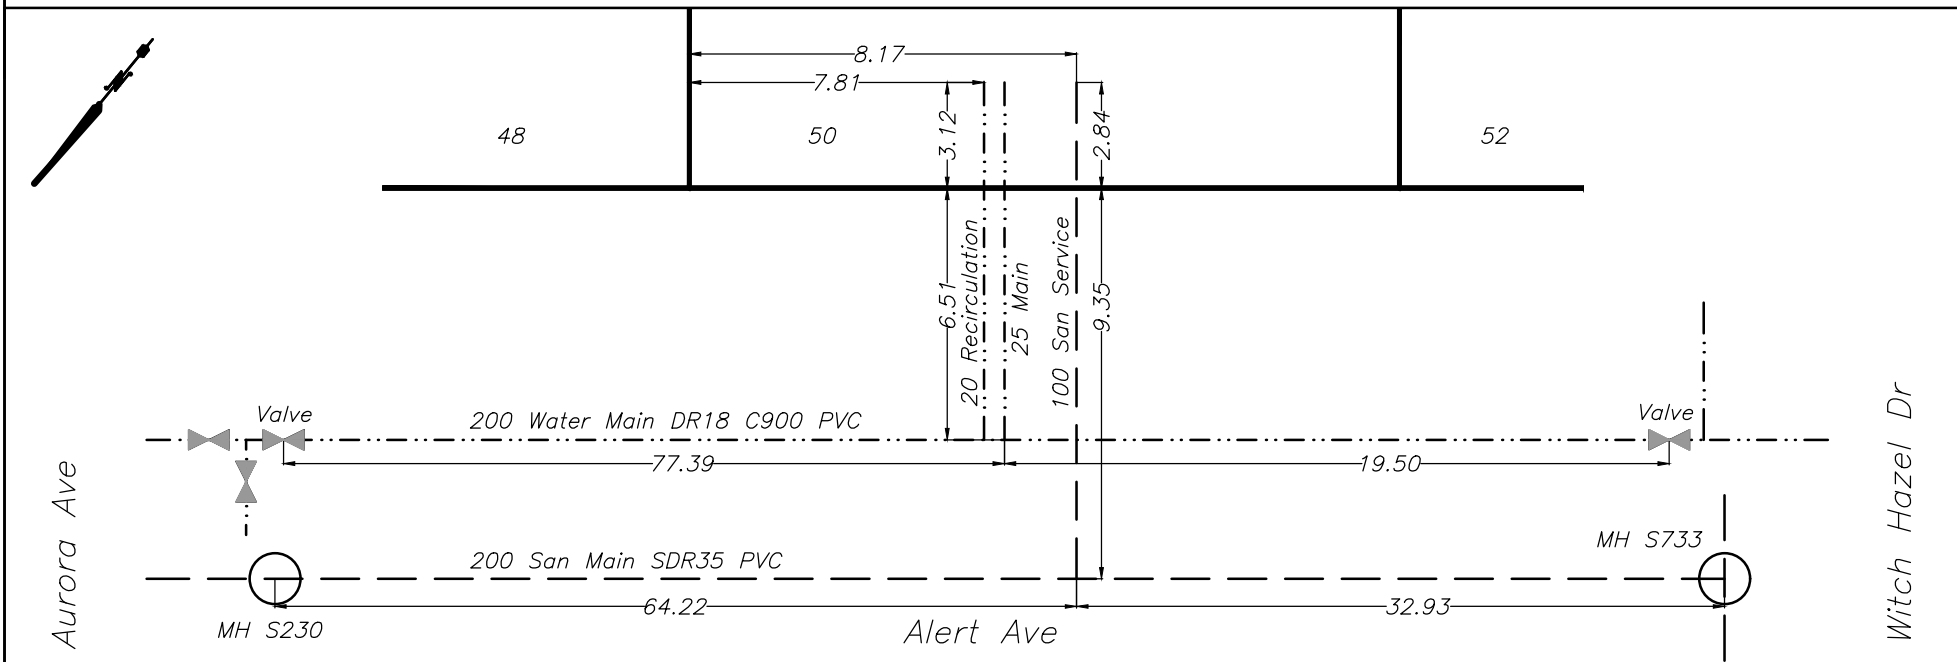




# CITY OF WHITEHORSE

## SERVICE CONNECTION RECORD

NAME P S Sidhu Trucking Ltd. ADDRESS 52 Alert Avenue, Whistle Bend BLOCK \_\_\_\_\_ LOT 1310

| DATES                   | WATER                                       | SEWER                                          |
|-------------------------|---------------------------------------------|------------------------------------------------|
| On at Main June 04 2024 | Depth at P/L: 674.36 (2.53)                 | Depth at P/L: 674.30 (2.59)                    |
| On at CC                | Depth at Main: 673.91 (2.89)                | Depth at Main: 672.06 (4.78)                   |
| Frost Plug              | Pipe Size: 25mm/20mm                        | Pipe Size: 100mm                               |
| Memo:                   | Pipe Material: HDPE Insul. <u>Yes</u> /No   | Pipe Material: SDR28 PVC Insul. Yes/ <u>No</u> |
|                         | Length from Main to P/L: 6.73               | Length from Main to P/L: 9.44                  |
|                         |                                             | STORM                                          |
|                         | Squirt Test: <u>Pass</u> /Fail              | Depth at P/L:                                  |
|                         | Frost Protection: <u>Recirc</u> /Heat Trace | Depth at Main:                                 |
|                         | Continuity Test: N/A Pass/Fail              | Pipe Size:                                     |
|                         | PRV Required: Yes/ <u>No</u>                | Pipe Material:                                 |
|                         |                                             | Length from Main to P/L:                       |

CLEARLY INDICATE LOCATION OF CC AND ROUTE OF PIPES ON DRAWING BELOW

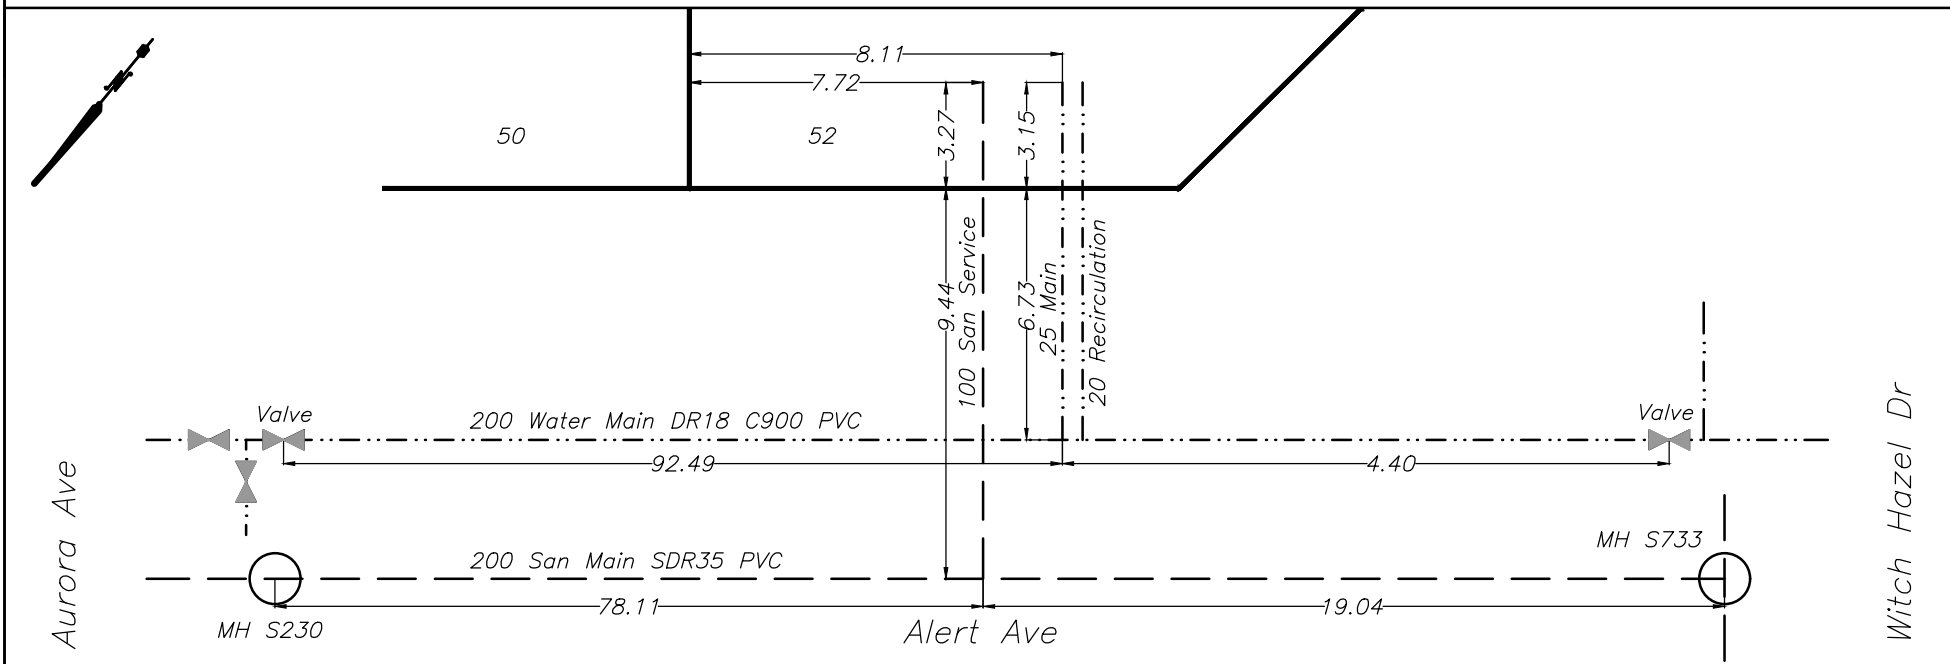




# CITY OF WHITEHORSE

## SERVICE CONNECTION RECORD

NAME P S Sidhu Trucking Ltd. ADDRESS 249 Rampart Avenue, Whistle Bend BLOCK \_\_\_\_\_ LOT 1330

| DATES                    | WATER                                                                                      | SEWER                                                                                         |
|--------------------------|--------------------------------------------------------------------------------------------|-----------------------------------------------------------------------------------------------|
| On at Main June 17, 2024 | Depth at P/L: 671.08 (2.80)                                                                | Depth at P/L: 671.03 (2.85)                                                                   |
| On at CC                 | Depth at Main: 670.15 (3.62)                                                               | Depth at Main: 670.54 (3.29)                                                                  |
| Frost Plug               | Pipe Size: 25mm/20mm                                                                       | Pipe Size: 100mm                                                                              |
| Memo:                    | Pipe Material: HDPE Insul. <input checked="" type="radio"/> Yes <input type="radio"/> No   | Pipe Material: SDR28 PVC Insul. Yes <input checked="" type="radio"/> No <input type="radio"/> |
|                          | Length from Main to P/L: 11.99                                                             | Length from Main to P/L: 8.99                                                                 |
|                          |                                                                                            | STORM                                                                                         |
|                          | Squirt Test: <input checked="" type="radio"/> Pass <input type="radio"/> Fail              | Depth at P/L:                                                                                 |
|                          | Frost Protection: <input checked="" type="radio"/> Recirc <input type="radio"/> Heat Trace | Depth at Main:                                                                                |
|                          | Continuity Test: N/A Pass/Fail                                                             | Pipe Size:                                                                                    |
|                          | PRV Required: Yes <input checked="" type="radio"/> No <input type="radio"/>                | Pipe Material:                                                                                |
|                          |                                                                                            | Length from Main to P/L:                                                                      |

CLEARLY INDICATE LOCATION OF CC AND ROUTE OF PIPES ON DRAWING BELOW

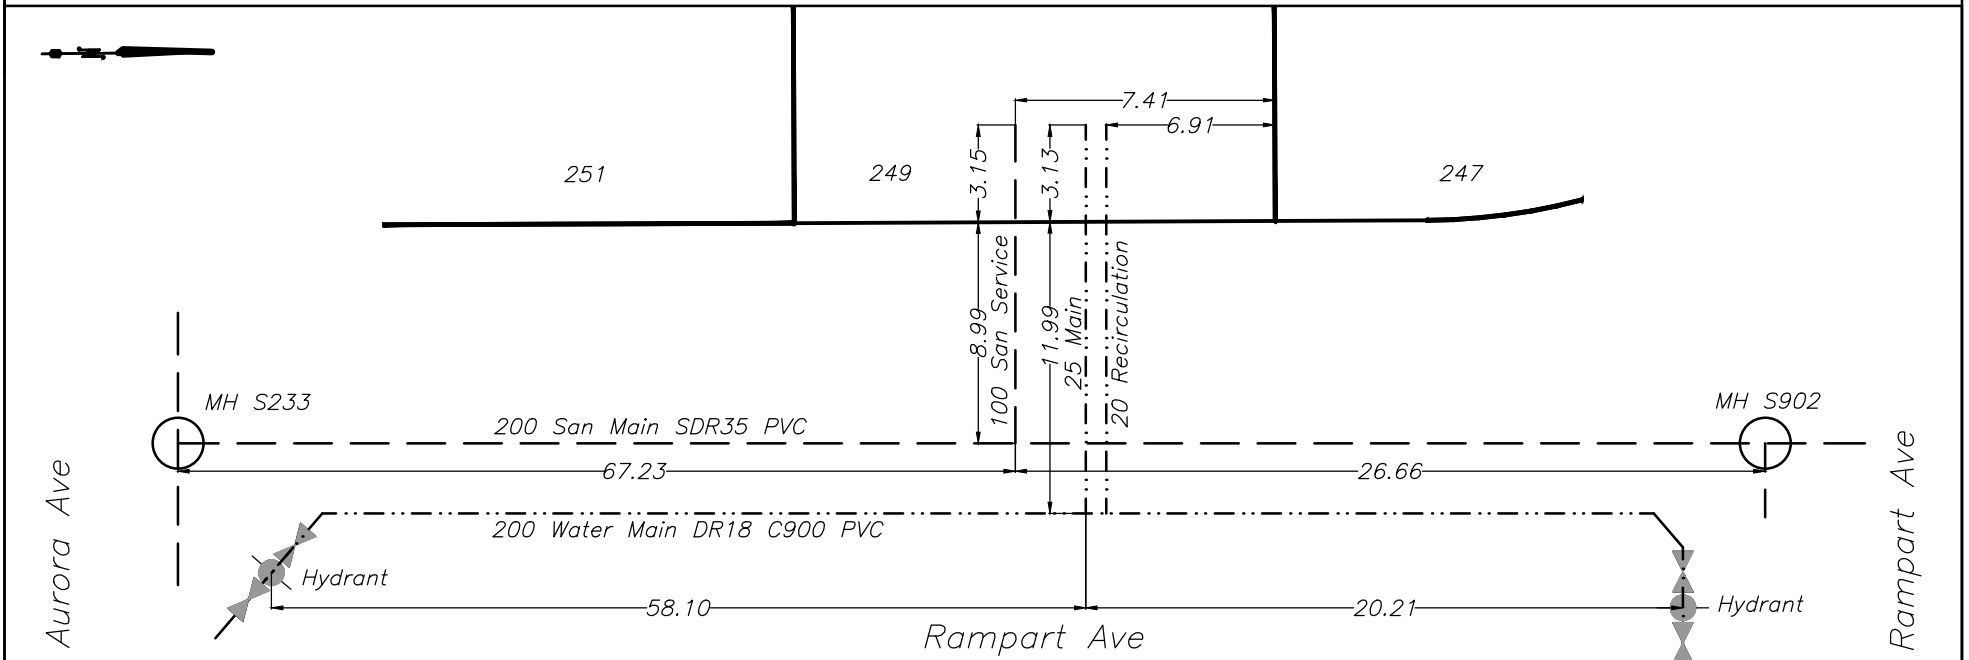




# CITY OF WHITEHORSE

## SERVICE CONNECTION RECORD

NAME P S Sidhu Trucking Ltd. ADDRESS 251 Rampart Avenue, Whistle Bend BLOCK \_\_\_\_\_ LOT 1329

| DATES                    | WATER                                                                                      | SEWER                                                                                             |
|--------------------------|--------------------------------------------------------------------------------------------|---------------------------------------------------------------------------------------------------|
| On at Main June 16, 2024 | Depth at P/L: 671.25 (2.83)                                                                | Depth at P/L: 671.20 (2.87)                                                                       |
| On at CC                 | Depth at Main: 670.50 (3.51)                                                               | Depth at Main: 670.73 (3.31)                                                                      |
| Frost Plug               | Pipe Size: 25mm/20mm                                                                       | Pipe Size: 100mm                                                                                  |
| Memo:                    | Pipe Material: HDPE Insul. <input checked="" type="radio"/> Yes <input type="radio"/> No   | Pipe Material: SDR28 PVC Insul. Yes <input checked="" type="radio"/> No <input type="radio"/> Yes |
|                          | Length from Main to P/L: 12.01                                                             | Length from Main to P/L: 8.97                                                                     |
|                          |                                                                                            | STORM                                                                                             |
|                          | Squirt Test: <input checked="" type="radio"/> Pass <input type="radio"/> Fail              | Depth at P/L:                                                                                     |
|                          | Frost Protection: <input checked="" type="radio"/> Recirc <input type="radio"/> Heat Trace | Depth at Main:                                                                                    |
|                          | Continuity Test: N/A Pass/Fail                                                             | Pipe Size:                                                                                        |
|                          | PRV Required: Yes <input checked="" type="radio"/> No <input type="radio"/> Yes            | Pipe Material:                                                                                    |
|                          |                                                                                            | Length from Main to P/L:                                                                          |

CLEARLY INDICATE LOCATION OF CC AND ROUTE OF PIPES ON DRAWING BELOW

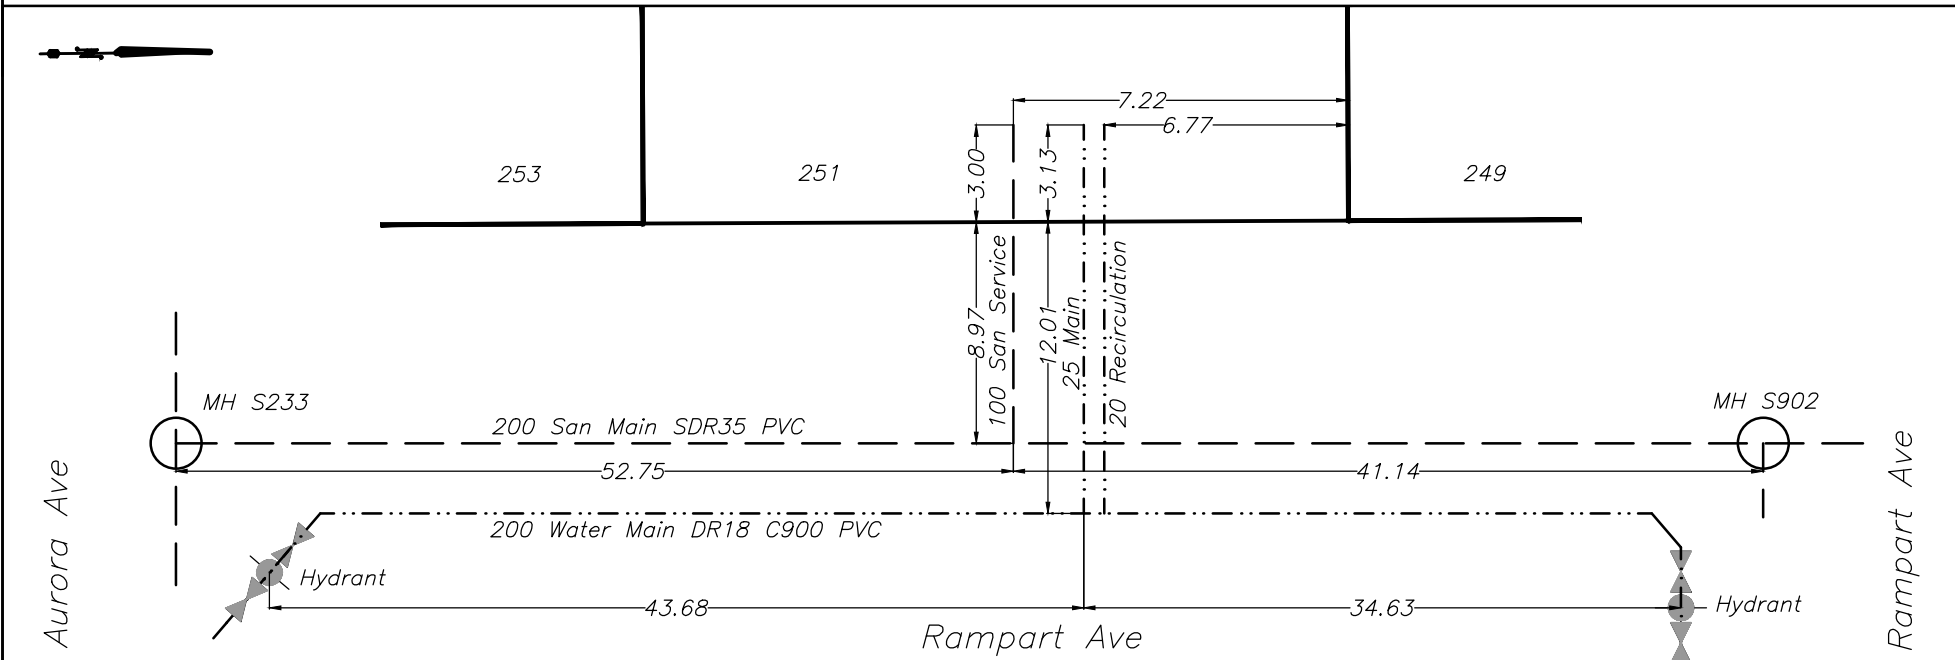




# CITY OF WHITEHORSE

## SERVICE CONNECTION RECORD

NAME P S Sidhu Trucking Ltd. ADDRESS 253 Rampart Avenue, Whistle Bend BLOCK \_\_\_\_\_ LOT 1328

| DATES                    | WATER                                                                                      | SEWER                                                                                         |
|--------------------------|--------------------------------------------------------------------------------------------|-----------------------------------------------------------------------------------------------|
| On at Main June 14, 2024 | Depth at P/L: 671.25 (3.04)                                                                | Depth at P/L: 671.26 (3.03)                                                                   |
| On at CC                 | Depth at Main: 670.80 (3.37)                                                               | Depth at Main: 670.93 (3.30)                                                                  |
| Frost Plug               | Pipe Size: 25mm/20mm                                                                       | Pipe Size: 100mm                                                                              |
| Memo:                    | Pipe Material: HDPE Insul. <input checked="" type="radio"/> Yes <input type="radio"/> No   | Pipe Material: SDR28 PVC Insul. Yes <input checked="" type="radio"/> No <input type="radio"/> |
|                          | Length from Main to P/L: 12.02                                                             | Length from Main to P/L: 8.92                                                                 |
|                          |                                                                                            | STORM                                                                                         |
|                          | Squirt Test: <input checked="" type="radio"/> Pass <input type="radio"/> Fail              | Depth at P/L:                                                                                 |
|                          | Frost Protection: <input checked="" type="radio"/> Recirc <input type="radio"/> Heat Trace | Depth at Main:                                                                                |
|                          | Continuity Test: N/A Pass/Fail                                                             | Pipe Size:                                                                                    |
|                          | PRV Required: Yes <input checked="" type="radio"/> No <input type="radio"/>                | Pipe Material:                                                                                |
|                          |                                                                                            | Length from Main to P/L:                                                                      |

CLEARLY INDICATE LOCATION OF CC AND ROUTE OF PIPES ON DRAWING BELOW

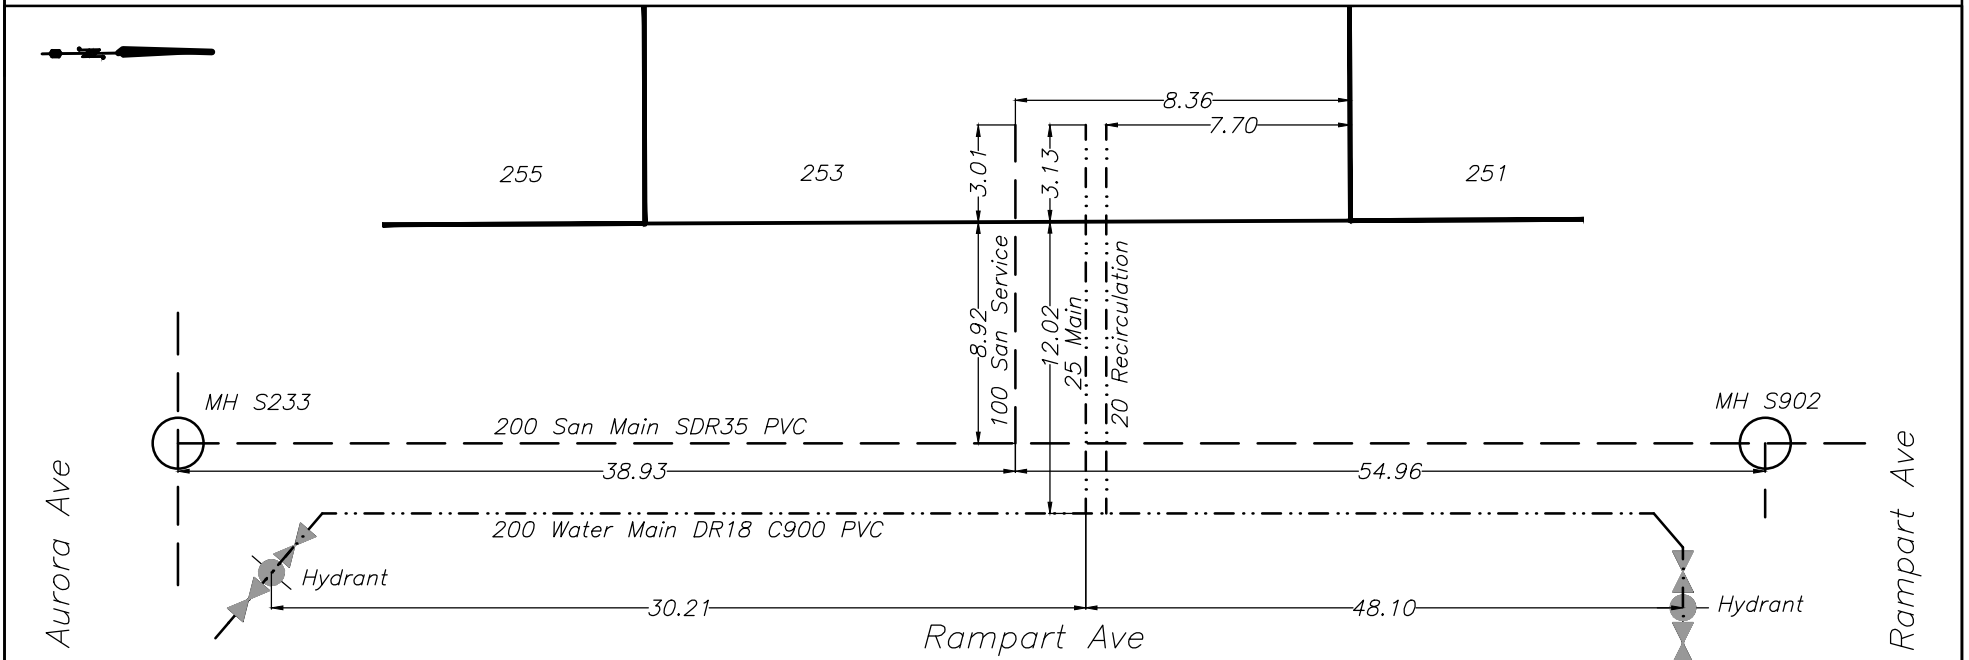




# CITY OF WHITEHORSE

## SERVICE CONNECTION RECORD

NAME P S Sidhu Trucking Ltd. ADDRESS 255 Rampart Avenue, Whistle Bend BLOCK \_\_\_\_\_ LOT 1327

| DATES                    | WATER                                                                                      | SEWER                                                                                         |
|--------------------------|--------------------------------------------------------------------------------------------|-----------------------------------------------------------------------------------------------|
| On at Main June 17, 2024 | Depth at P/L: 671.44 (3.01)                                                                | Depth at P/L: 671.46 (3.00)                                                                   |
| On at CC                 | Depth at Main: 671.13 (3.20)                                                               | Depth at Main: 671.10 (3.30)                                                                  |
| Frost Plug               | Pipe Size: 25mm/20mm                                                                       | Pipe Size: 100mm                                                                              |
| Memo:                    | Pipe Material: HDPE Insul. <input checked="" type="radio"/> Yes <input type="radio"/> No   | Pipe Material: SDR28 PVC Insul. Yes <input checked="" type="radio"/> No <input type="radio"/> |
|                          | Length from Main to P/L: 11.98                                                             | Length from Main to P/L: 9.00                                                                 |
|                          |                                                                                            | STORM                                                                                         |
|                          | Squirt Test: <input checked="" type="radio"/> Pass <input type="radio"/> Fail              | Depth at P/L:                                                                                 |
|                          | Frost Protection: <input checked="" type="radio"/> Recirc <input type="radio"/> Heat Trace | Depth at Main:                                                                                |
|                          | Continuity Test: N/A Pass/Fail                                                             | Pipe Size:                                                                                    |
|                          | PRV Required: Yes <input checked="" type="radio"/> No <input type="radio"/>                | Pipe Material:                                                                                |
|                          |                                                                                            | Length from Main to P/L:                                                                      |

CLEARLY INDICATE LOCATION OF CC AND ROUTE OF PIPES ON DRAWING BELOW

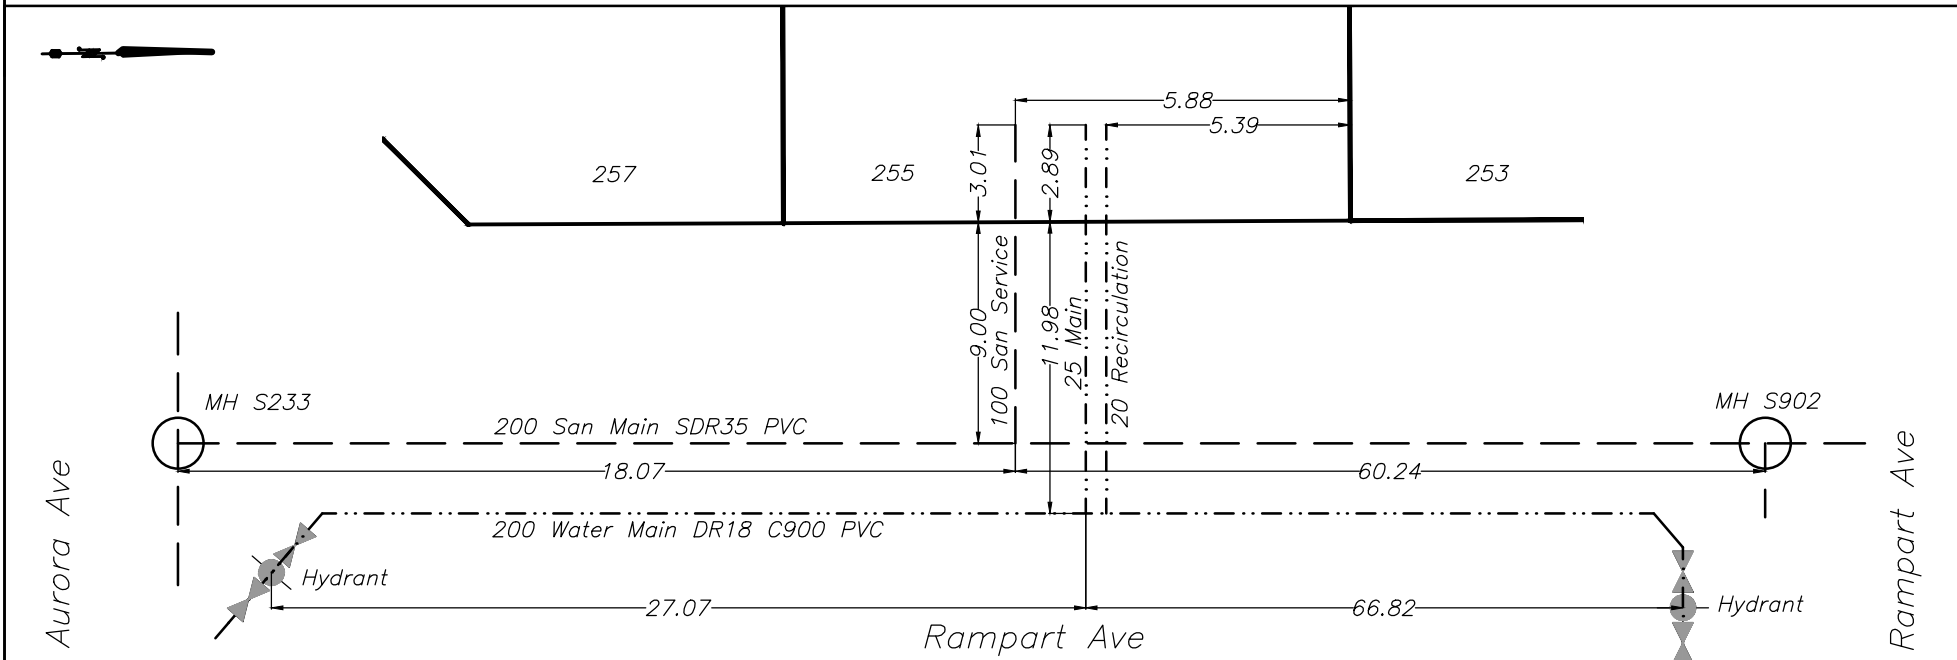



# CITY OF WHITEHORSE

## SERVICE CONNECTION RECORD

NAME P S Sidhu Trucking Ltd. ADDRESS 257 Rampart Avenue, Whistle Bend BLOCK \_\_\_\_\_ LOT 1326

| DATES                    | WATER                                                                                      | SEWER                                                                                         |
|--------------------------|--------------------------------------------------------------------------------------------|-----------------------------------------------------------------------------------------------|
| On at Main June 18, 2024 | Depth at P/L: 671.59 (3.04)                                                                | Depth at P/L: 671.60 (3.03)                                                                   |
| On at CC                 | Depth at Main: 671.44 (3.04)                                                               | Depth at Main: 671.24 (3.34)                                                                  |
| Frost Plug               | Pipe Size: 25mm/20mm                                                                       | Pipe Size: 100mm                                                                              |
| Memo:                    | Pipe Material: HDPE Insul. <input checked="" type="radio"/> Yes <input type="radio"/> No   | Pipe Material: SDR28 PVC Insul. Yes <input checked="" type="radio"/> No <input type="radio"/> |
|                          | Length from Main to P/L: 11.98                                                             | Length from Main to P/L: 9.00                                                                 |
|                          |                                                                                            | STORM                                                                                         |
|                          | Squirt Test: <input checked="" type="radio"/> Pass <input type="radio"/> Fail              | Depth at P/L:                                                                                 |
|                          | Frost Protection: <input checked="" type="radio"/> Recirc <input type="radio"/> Heat Trace | Depth at Main:                                                                                |
|                          | Continuity Test: N/A Pass/Fail                                                             | Pipe Size:                                                                                    |
|                          | PRV Required: Yes <input checked="" type="radio"/> No <input type="radio"/>                | Pipe Material:                                                                                |
|                          |                                                                                            | Length from Main to P/L:                                                                      |

CLEARLY INDICATE LOCATION OF CC AND ROUTE OF PIPES ON DRAWING BELOW

